

# GENERAL NOTES:

- The Contractor shall comply with all applicable safety regulations. All construction shall be completed following current City Standard Specifications and Special Provisions.
  - Maintain a minimum of 10-foot horizontal separation between all water lines (mains, services, and fire hydrants) and all sanitary sewer lines (mains, services, and manholes). All separation distances are to be measured from edge-to-edge, at the closest point.
  - Maintain a minimum of 2-foot vertical separation between all water lines (mains and services) and all gravity sanitary sewer lines (mains, services, and manholes) at crossings. All separation distances are to be measured from edge-to-edge, at the closest point.
  - Maintain a minimum of 2-foot vertical separation between all water lines (mains and services) and all pressurized sanitary sewer lines (force mains and services) at crossings. Waterlines must always be placed above pressurized sanitary sewer lines where they cross. All separation distances are to be measured from edge-to-edge, at the closest point.
- Contractor will be required to provide notice to utility companies a minimum of seventy-two (72) hours prior to any excavation, as follows:
 

Kansas One-Call 687-2470

The Contractor must notify the following in case of an emergency:

AT&T	1-800-246-8464
Black Hills Energy	1-800-694-8989
City of Wichita Water & Sewer	1-316-219-8921
City of Wichita Stormwater	1-316-268-4090
City of Wichita Traffic	1-316-268-4034
Cox Communications	1-888-249-3530
Kansas Gas Service	1-888-482-4950
Evergy	1-800-544-4857
- Utility service lines, poles, etc. are to be adjusted as necessary by others prior to construction unless the plans specifically call for their adjustment by the Contractor or unless the plans specifically identify a utility to be adjusted by its owner during construction. Existing utilities and their location, as shown on the plans, represent the best information obtainable for design. The Contractor will be required to work around existing utilities within the right-of-way which do not conflict with proposed construction.
- Rubble from the removal of miscellaneous structures and excess excavation which is to be wasted shall be disposed of on sites to be provided by the Contractor. These sites shall be approved by the Engineer as to suitability, appearance and site location. Locations, in the opinion of the Engineer, that will leave an unsightly appearance will not be approved. All disposal sites must be approved by the Kansas Department of Health and Environment. Material either stockpiled or disposed of in a flood plain will require a Kansas State Board of Agriculture permit. Any material dumped in waters of the United States or wetlands is subject to U.S. Corps of Engineers permitting regulations. Any material buried or stockpiled beyond approved construction limits will require additional archaeological investigations unless buried in a previously approved borrow location.
- Trees and shrubs in public right-of-way which are in direct conflict with proposed new construction shall be removed by the Contractor with the City Engineer's approval. Trees and shrubs which are not in direct conflict with proposed new construction shall be saved and protected from damage.
- The Contractor shall give all property owners and/or tenants of developed property abutting the construction of this project a minimum of ten (10) days notice prior to start of construction.
- The Contractor shall be responsible for preserving property irons. The Contractor will be required to re-establish any property irons which are damaged or destroyed by his construction operations. Such irons shall be re-established by a licensed land surveyor in accordance with state laws.
- The Engineering Division shall field locate water valve one time during construction when requested by the Contractor. It shall be the Contractor's responsibility to preserve such field locations during the construction process. Water valves, valve boxes or fire hydrants damaged during construction shall be repaired by Contractor at his own expense. Valve boxes and water meters within the project limits shall be adjusted to match field grades by the contractor.
- The Contractor shall notify the consultant engineer and Dawnita Reinhardt at 316-650-0740 with the City of Wichita with the anticipated construction start date and notify them of project completion. Staking and inspection for this project will be the responsibility of the Contractor.

- If traffic will be impacted by construction, a traffic control plan must be submitted and approved by the City Traffic Engineer at [traffic@wichita.gov](mailto:traffic@wichita.gov) before construction can begin. The Contractor shall be responsible for all traffic control measures to facilitate construction. All construction zone markings and signage shall conform to the latest version of Manual on Uniform Traffic Control Devices (MUTCD) as published by the US Dept. of Transportation, Federal Highway Administration. All costs associated with construction markings and signage shall be the Contractors responsibility.
- All elevations shown are NAVD88.
- All areas disturbed during construction that will not be under proposed pavement shall be restored to match existing conditions per City specifications.
- All applicable fees (tap, equity, in lieu of & main benefit) must be paid before any work on this project can commence. Quotes can be obtained on fees by calling 316-268-4555.
- City maintenance of water mains ends within two feet of vault.
- Opening and closing of water valves shall be done slowly to prevent damage to the water distribution system from water hammer. All valves closed by the contractor must be reopened as new construction permits. The project inspector must ascertain that any valve closed by the Contractor is reopened. The contractor will be permitted to operate water valves only when the project inspector assigned to the project is present.
- The Contractor shall lay a Tracer Wire and Set Test Stations along all water pipe installed in accordance with City Specifications and Tracer Wire Detail on detail sheet WL-101, cost is subsidiary to pipe installation.
- The contractor shall provide materials for temporary blowoff of waterlines. Connections to the existing waterline(s) shall be made with clean, swabbed pipe and flushed upon completion of tie-ins.
- Requests for short term water interruptions shall be made to the City Water Distribution Division and will be subject to their approval. The Contractor shall give written notice to any property owner, business, and/or tenants that will have water service interrupted at least 5 days in advance. Such notifications should indicate the time and date that the water will be turned off and when the service will be restored. No business, property owner, and/or tenants shall be without water service for more than 8 hours. Proposed tie in locations which will affect water service to property owners shall be performed during non-peak hours.
- The Contractor must schedule the connections to the existing main with the City such that there is a minimum disruption of service. Connections shall be made during periods of low water usage. The Contractor shall submit his proposed schedule for completing work for City approval at least 10 days prior to beginning construction.
- Deflections at pipe joint or couplings shall not exceed the pipe manufacturers recommended maximum. Where deflections are greater than the maximum allowed, the contractor shall utilize fittings.
- Any existing joint replaced if within
- Valves 12 inches City Water Distrib notice is required
- All wet taps shall Contractor will re to tap being ma
- The Contractor st existing utilities t the utility owner expense.
- Contractor shall limit the extent of trench openings overnight and weekends to less than 50 feet.
- Wichita Fire Department inspections may be scheduled by calling Dawnita Reinhardt at 316-650-0740.

- All existing and proposed erosion control measures including silt fencing, erosion control mat, straw bales, inlet barriers, and const. entrance shall be maintained throughout construction by the contractor and until project is accepted by the City of Wichita. The on-site engineer shall complete weekly reports on the status of erosion control measures. The contractor shall be required to comply with maintenance and/or replacement of erosion control measures as determined by the on-site engineer until project is accepted by City of Wichita. Maintenance and/or replacement of erosion control measures to be paid by L.S. bid item "Maintain Existing BMPs".
- All excess excavation shall remain on-site and shall be spread or stockpiled at a location to be determined by developer.
- All of 127th St. E. R/W disturbed during construction shall be seeded and mulched as follows:
 

Seed -- Kansas Premium Fescue Blend; 8 lbs. PLS/1000 Sq. Ft.

**Fire Hydrants = Clow**  
**Valves = Clow**  
**Fittings = Sigma**  
**4" DICI Pipe = McWane Ductile**  
**6" DICI Pipe = McWane Ductile**  
**8" DICI Pipe = McWane Ductile**  
**4" RJPVC Pipe = Westlake**  
**4" SCH40 Pipe = Charlotte**  
**6" SCH40 Pipe = Charlotte**  
**8" PVC Pipe = Sanderson Pipe**  
**2 - 6' x 6' x 6" Stainless Steel Riser Pipes = Zurn.**

## Benchmarks

BM #1: "□" chiseled on top of headwall, east side of 127th Street, north of site. Elevation = 1330.04 (NAVD 88)

BM #2: Mag nail in asphalt, west side of 127th Street, north of cul-de-sac. Elevation = 1344.42 (NAVD 88)

**Utility Contractor = McCullough Excavating**  
**Inspector = Fred Smith - Baughman Company, P.A.**  
**As-Built Plans By = FES & Larry Powell**  
**1-6-2025**  
**As-Built Plans Revised: 1-10-2025**  
**2-13-2025**

**Double Check Detector Valve Assembly:**  
**Water Meter = Badger**  
**Water Meter # = 211688217**  
**Final Water Meter Reading = 0000.0000 Cu.Ft.**  
**ERT # = 74534702**

# AS-BUILT PLANS

## WATER DISTRIBUTION SYSTEM


to serve

# MEADOWLAND ADD. UNION AT PURPLE HEART TRAIL

## 127TH ST. E.

### CITY OF WICHITA, KANSAS

Paul Gunzelman, P.E. City Engineer  
 2024-005075PPW  
 54030980

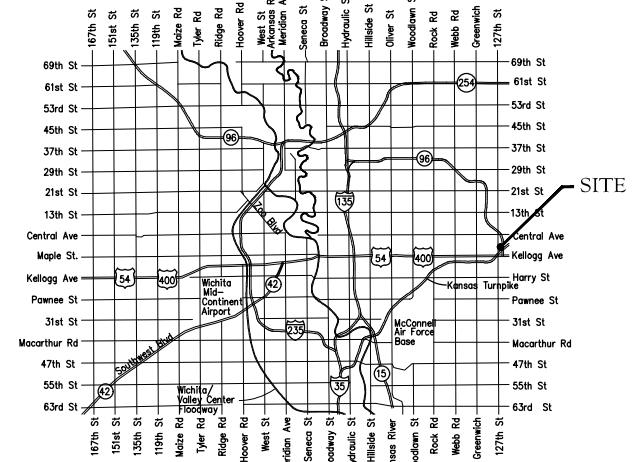

## Vicinity Map

**Construction Began = August 2024**  
**Construction End = September 2024**

APPROVED AS NOTED  
 BY WICHITA PUBLIC WORKS  
 ENGINEERING DIVISION  
 & BY WICHITA FIRE DEPARTMENT


Engineering Approved by Shawn Mellies, P.E. (06/19/2024)  
 Utilities Approved by Greg Lalley, (06/19/2024)  
 Fire Dept. Approved by Battalion Chief Jose Ocadiz. (06/19/2024)  
 Approved by Captain Ake (06/19/2024)

NOTE TO CONTRACTORS

Public Property:  
 Inspection and testing for the waterline is to be provided by a Licensed Consulting Engineering Firm under contract with the Owner/Developer. Said Inspection is to be in accordance with the City of Wichita standard construction engineering practices and certified by a Professional Engineer Licensed in the state of Kansas. No work shall be performed in dedicated easements or public right-of-way by the Contractor without such inspection nor shall any work be commenced without written authorization by City Engineering. All Construction and Materials shall comply with the City of Wichita Specifications and Standards and Special Provisions (on file and available in the City Engineer's Office) or on the City's Website.


Private Property:  
 Installation and testing for the fire protection line is to be performed by a City of Wichita licensed fire protection contractor in accordance with the fire codes as adopted by the City of Wichita. All material and construction practices for the fire protection line shall comply with the fire codes as adopted by the City of Wichita (available from the City of Wichita Fire Department). The Contractor shall not commence work without notification and approval of the Wichita Fire Department. Inspection of the fire protection line is to be provided by a licensed Engineering Firm under contract with the Owner/Developer and the Fire Department. The contractor shall not start work until the project inspector is assigned to the project and present on the site. Any work done without inspection will be required to be uncovered for inspection.

An approved copy of these plans signed by City staff are required on-site.

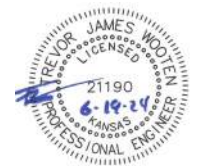

June 19, 2024

**BAUGHMAN COMPANY**  
 315 Ellis St. Wichita, KS 67211 316-262-7271  
 BaughmanCo.com

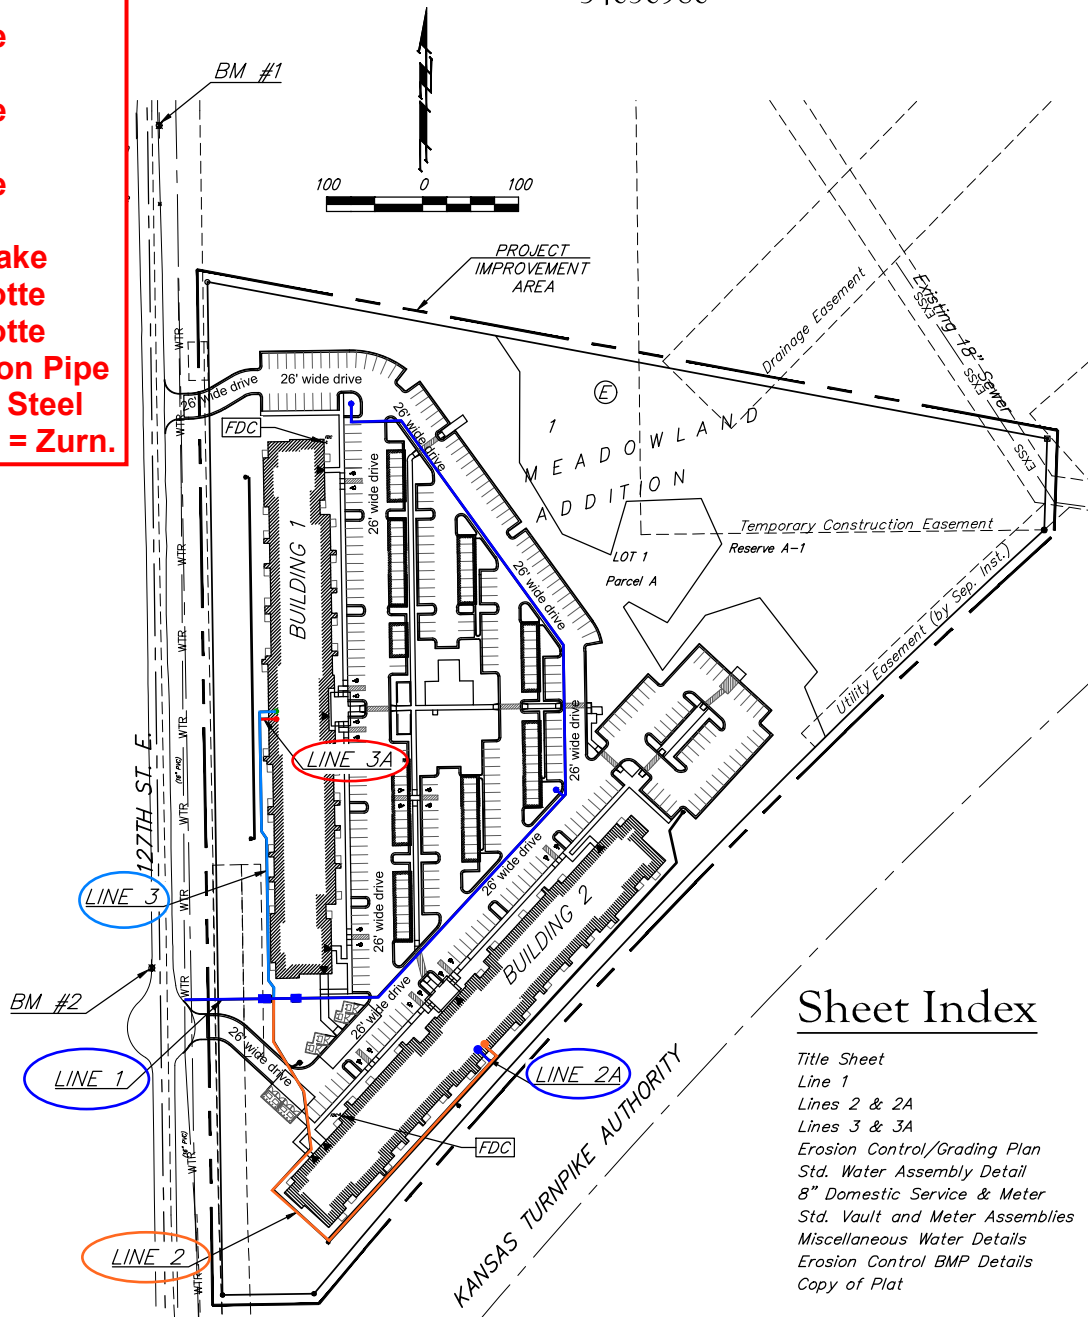

## Sheet Index

Title Sheet	1
Line 1	2-3
Lines 2 & 2A	4
Lines 3 & 3A	5
Erosion Control/Grading Plan	6
Std. Water Assembly Detail	7
8" Domestic Service & Meter	8
Std. Vault and Meter Assemblies	9
Miscellaneous Water Details	10
Erosion Control BMP Details	11-15
Copy of Plat	16

**Baughman Job No.: 24-03-E752**

**BENCHMARKS:**  
 BM #1: "□" chiseled on top of headwall, east side of 127th Street, north of site.  
 Elevation = 1330.04 (NAVD 88)  
 BM #2: Mag nail in asphalt, west side of 127th Street, north of cul-de-sac.  
 Elevation = 1344.42 (NAVD 88)

Pipe layout is shown with horizontal and vertical deflections. Contractor to use short pipe lengths, high deflection couplers, and manufacturer recommended pipe deflections to meet planned alignment.

Contractor to maintain a minimum of 10' of horizontal separation (O.D.-O.D.) between sanitary sewer and water line.

**Water LINE 1 Installed on Plan Alignment.**

**Northings (N) and Eastings (E): State Plane Coordinates - Kansas Grid South - NAD83.**  
 Elevations: NAVD88.  
 Survey GPS Shots By: Fred Smith - Baughman Company, P.A.

From CL's of Douglas Ave. and S.127th St. E.:  
 16" SADDLE = 1,464' S. & 22' E.  
 8" TAP VALVE = 1,464' S. & 24' E.  
 45° BEND (V) = 1,465' S. & 26' E.  
 45° BEND (V) = 1,465' S. & 31' E.

ADDED:  
 Sta. 0+04 - 45° Bend (V)  
 Sta. 0+08 - 45° Bend (V)



Sta. 0+00.00, Begin Line 1  
 1 - 16"x8" Tapping Saddle  
 1 - 8" Tapping Valve & Valve Box  
 Tapping saddle, tapping valve & valve box to be furnished and installed by the City of Wichita Water Dept. Contractor to set valve box to grade. Contractor to reimburse City of Wichita for water tap.  
 Valve Box Elev. = 1344.40 1344.45  
 N=1,684,923.97 E=1,691,574.30

From CL's of Douglas Ave. and S.127th St. E.:  
 8" x 8" CROSS = 1,466' S. & 118' E.

From CL's of Douglas Ave. and S.127th St. E.:  
 WATER METER LID = 1,465' S. & 102' E.

From CL's of Douglas Ave. and S.127th St. E.:  
 FIRE SERVICE VAULT LID 16" = 1,466' S. & 118' E


From CL's of Douglas Ave. and S.127th St. E.:  
 TEE = 1,260' S. & 423' E.  
 FH 6" VALVE = 1,258' S. & 423' E.  
 FIRE HYDRANT = 1,253' S. & 416' E.  
 FH VALVE = 10' SE OF FIRE HYDRANT.

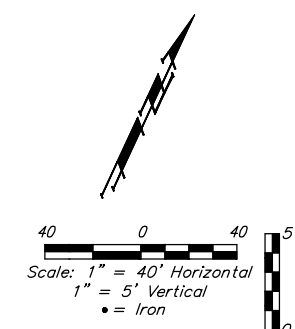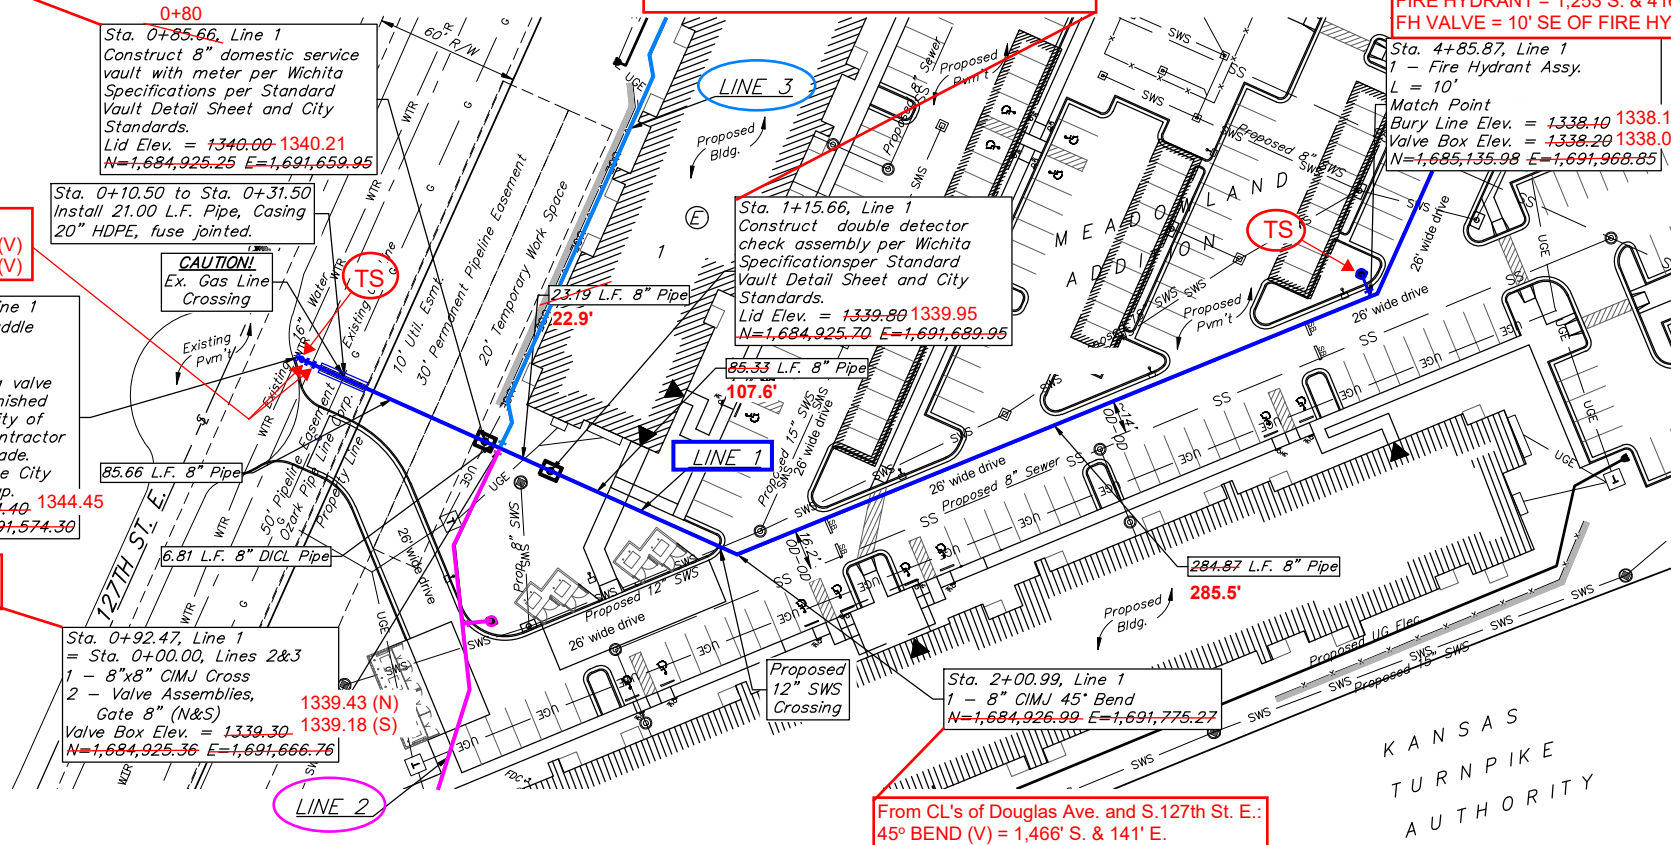

**LEGEND**  
 CL's = Centerlines.  
 TS = Test Stations



Contractor to verify depth and location of existing utilities. Contractor to relocate any existing utilities as necessary for construction.

Contact utility companies 3 weeks prior to construction to coordinate temporary removal/replacement.  
 Heide Bryan, Every, (316) 261-6354  
 Shannan Brinkmeyer, AT&T (316) 268-2931  
 Travis Taylor, Cox Comm., Travis.taylor@cox.com

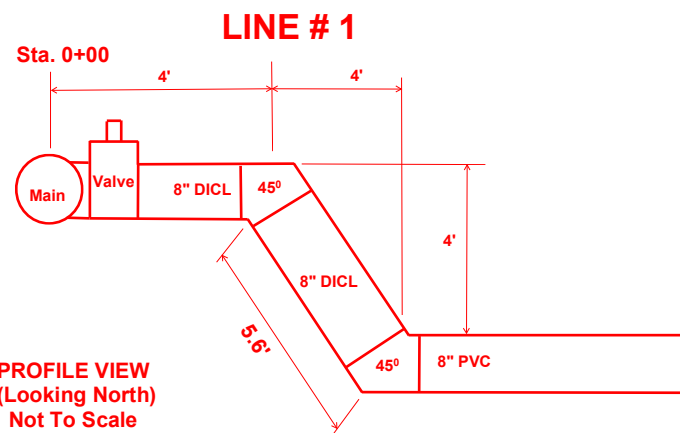

WATER LINE FITTING COORDINATES					
LINE	STA.	ITEM	NORTHING	EASTING	ELEV.
1	0+00	Saddle	1,684,923.32	1,691,573.17	1338.40
1	0+02	8" TAP Valve	1,684,924.48	1,691,575.16	1344.45
1	0+04	45° Bend (V)	1,684,923.87	1,691,579.77	1338.00
1	0+08	45° Bend (V)	1,684,923.90	1,691,584.01	1334.15
1	0+85	WM Vault	1,684,924.55	1,691,651.30	1340.21
1 / 2 / 3	0+92	Cross	1,684,924.29	1,691,667.34	1334.98
1	1+15	Fire Vault Lid	1,684,925.06	1,691,690.21	1339.95
1	2+00	45° Bend (H)	1,684,925.86	1,691,774.97	1335.46
1	4+85	Tee	1,685,135.19	1,691,969.17	1334.16
1	4+85	6" FH Valve	1,685,136.72	1,691,969.00	1338.07
1	4+85	Fire Hydrant	1,685,141.86	1,691,961.89	1338.15
VALVE ELEV. = TOP OF BOX			FIRE HYD ELEV. = BURY LINE		

**DEPTH UNKNOWN**  
 Contractor to Verify Depth & Location of Existing Water Line Prior to Construction.

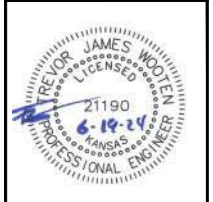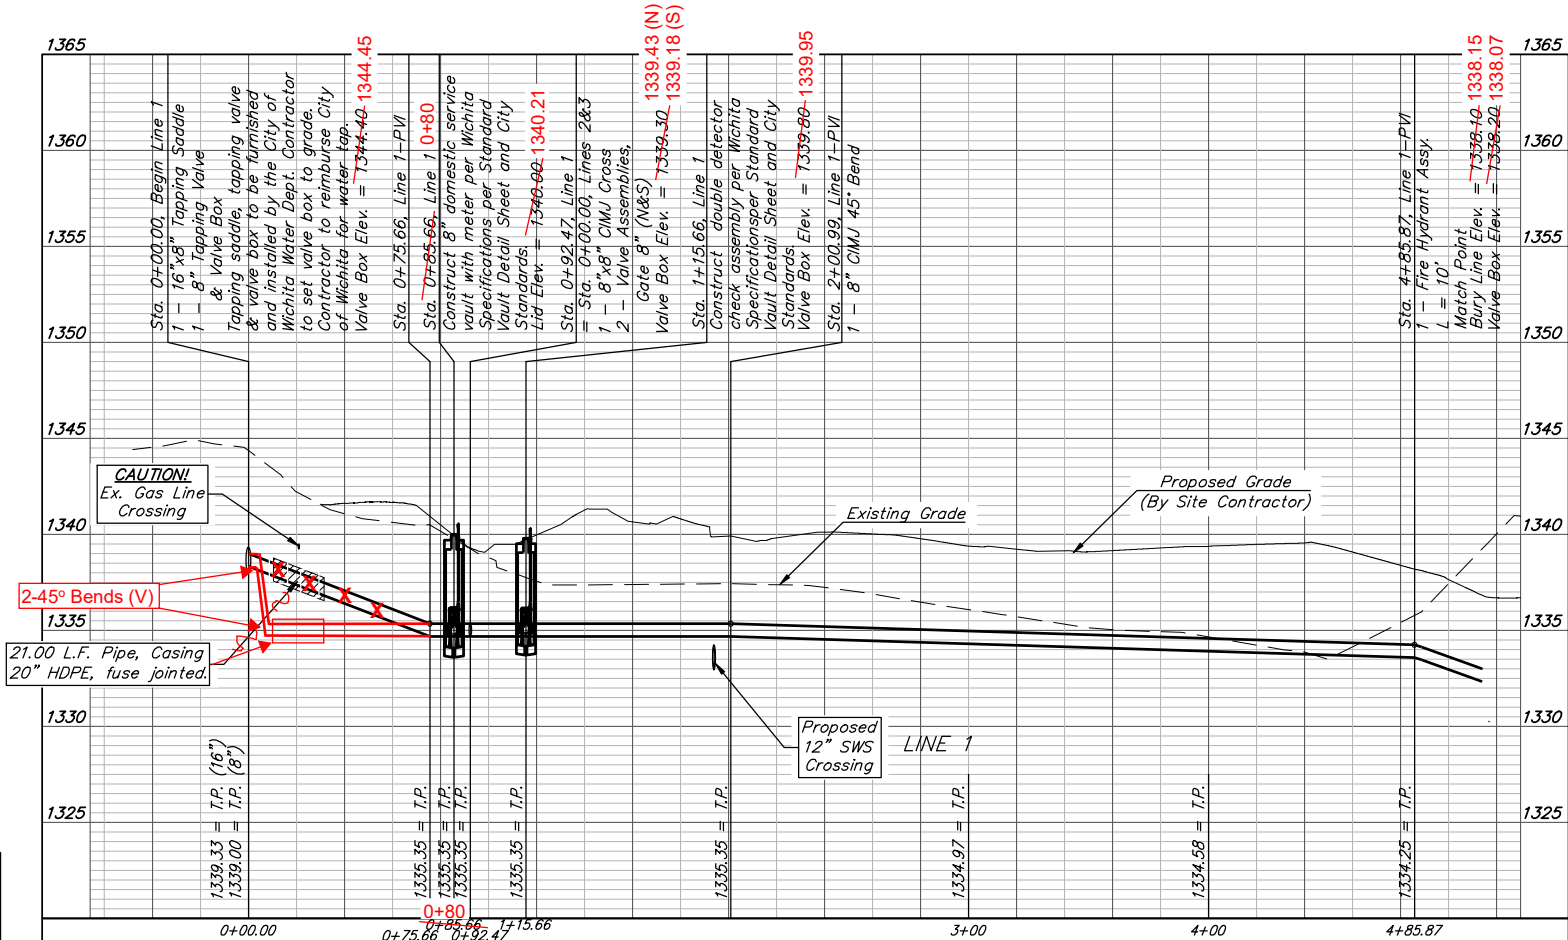

**BAUGHMAN COMPANY**  
 315 Ellis St.  
 Wichita, KS 67211  
 316-262-7271  
 BaughmanCo.com

MEADOWLAND ADDITION  
 Union at Purple Heart Trail

**LINE 1**

WATER DISTRIBUTION SYSTEM

PROJECT NUMBER:  
22-06-E228

DESIGN: AH DRAWN: TMS

DATE: June 19, 2024

SHEET OF  
**2 16**

**BENCHMARKS:**

BM #1: "□" chiseled on top of headwall, east side of 127th Street, north of site.  
Elevation = 1330.04 (NAVD 88)

BM #2: Mag nail in asphalt, west side of 127th Street, north of cul-de-sac.  
Elevation = 1344.42 (NAVD 88)

Pipe layout is shown with horizontal and vertical deflections. Contractor to use short pipe lengths, high deflection couplers, and manufacturer recommended pipe deflections to meet planned alignment.

Contractor to maintain a minimum of 10' of horizontal separation (O.D.-O.D.) between sanitary sewer and water line.

From CL's of Douglas Ave. and S.127th St. E.:  
45° BEND (H) = 1,258' S. & 416' E.

From CL's of Douglas Ave. and S.127th St. E.:  
45° BEND (V) = 1,231' S. & 426' E.

From CL's of Douglas Ave. and S.127th St. E.:  
45° BEND (V) = 1,228' S. & 425' E.

From CL's of Douglas Ave. and S.127th St. E.:  
45° BEND (V) = 1,208' S. & 426' E.

From CL's of Douglas Ave. and S.127th St. E.:  
45° BEND (V) = 1,211' S. & 425' E.



From CL's of Douglas Ave. and S.127th St. E.:  
22.5° BEND (H) = 1,101' S. & 426' E.  
11.25° BEND (H) = 1,100' S & 425' E.

From CL's of Douglas Ave. and S.127th St. E.:  
45° BEND (H) = 862' S. & 254' E.  
11.25° BEND (H) = 862' S. & 255' E.

From CL's of Douglas Ave. and S.127th St. E.:  
TEE = 866' S. & 208' E.  
6" FH VALVE = 865' S. & 207' E.  
FIRE HYDRANT = 847' S. & 208' E.  
6" FH VALVE = 19' S. OF FIRE HYDRANT.

Contractor to verify depth and location of existing utilities. Contractor to relocate any existing utilities as necessary for construction.

Contact utility companies 3 weeks prior to construction to coordinate temporary removal/replacement.  
Heide Bryan, Evergy, (316) 261-6354  
Shannon Brinkmeyer, AT&T (316) 268-2931  
Travis Taylor, Cox Comm., Travis.taylor@cox.com

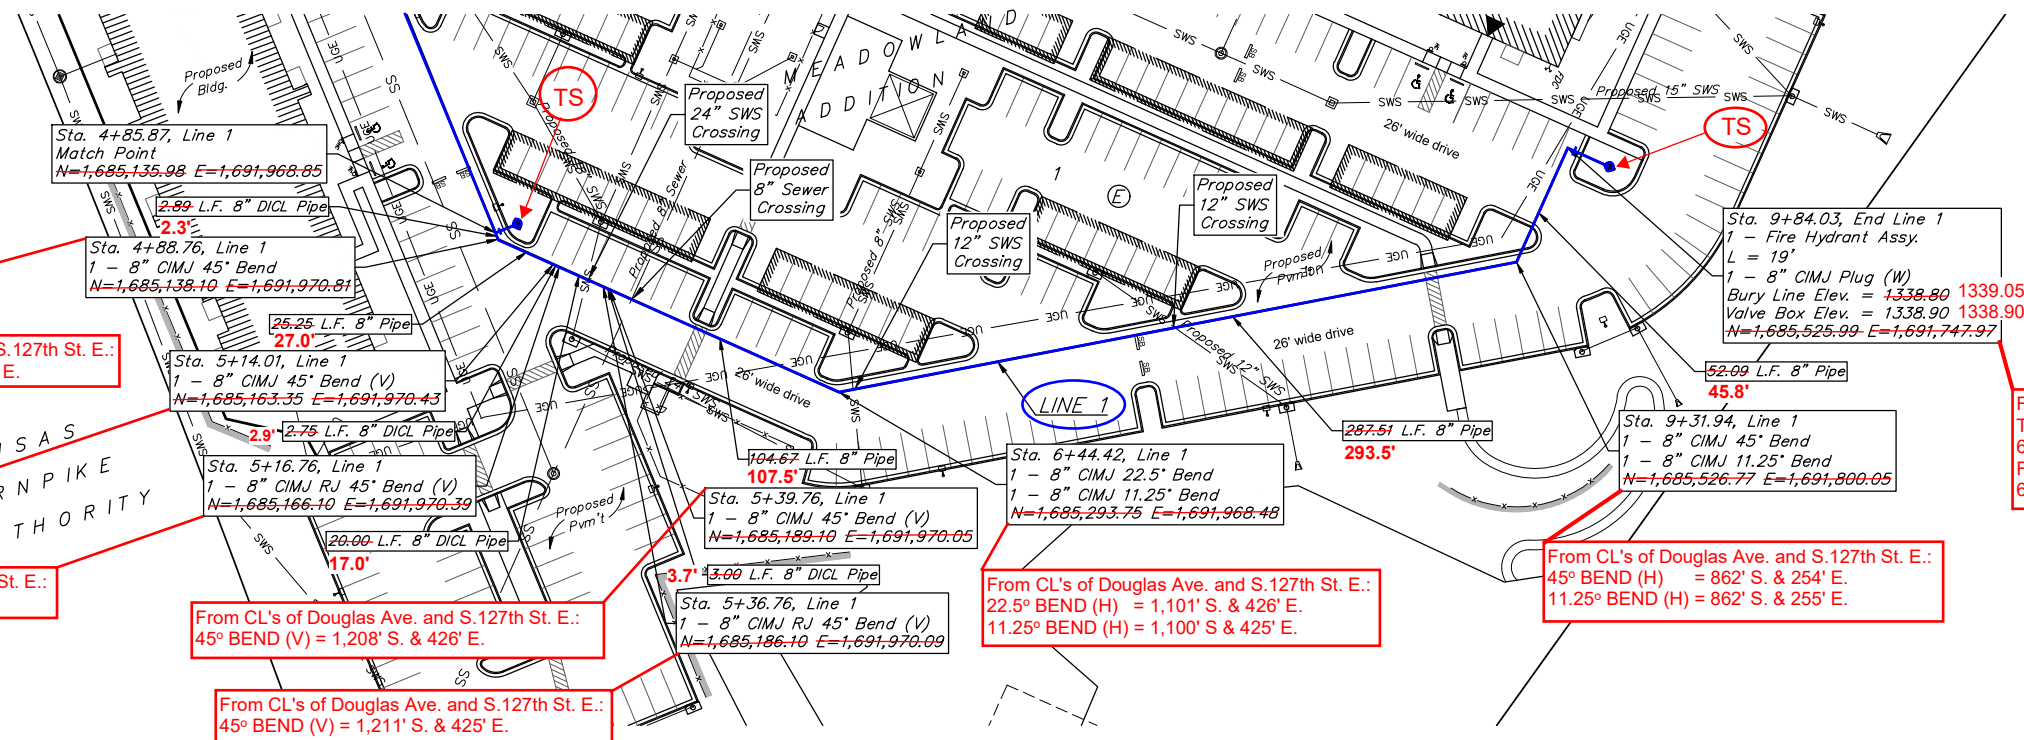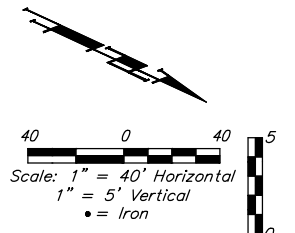


**LEGEND**

CL's = Centerlines.

TS = Test Stations

WATER LINE FITTING COORDINATES					
LINE	STA.	ITEM	NORTHING	EASTING	ELEV.
1	4+88	45° Bend (H)	1,685,136.93	1,691,971.27	1333.89
1	5+14	45° Bend (V)	1,685,163.90	1,691,970.97	1332.78
1	5+16	45° Bend (V)	1,685,166.66	1,691,970.09	1330.57
1	5+36	45° Bend (V)	1,685,183.64	1,691,970.37	1330.75
1	5+39	45° Bend (V)	1,685,187.28	1,691,970.77	1333.07
1	6+44	22.5° Bend (H)	1,685,294.79	1,691,969.14	1331.69
1	6+44	11.25° Bend (H)	1,685,293.30	1,691,969.39	1331.73
1	9+31	45° Bend (H)	1,685,530.48	1,691,794.25	1334.79
1	9+31	11.25	1,685,530.26	1,691,795.01	1334.79
1	9+84	Tee	1,685,526.13	1,691,748.62	1334.81
1	9+84	6" FH Valve	1,685,526.93	1,691,747.36	1338.90
1	9+84	FIRE HYDRANT	1,685,544.92	1,691,747.77	1339.05
VALVE ELEV. = TOP OF BOX			FIRE HYD ELEV. = BURY LINE		

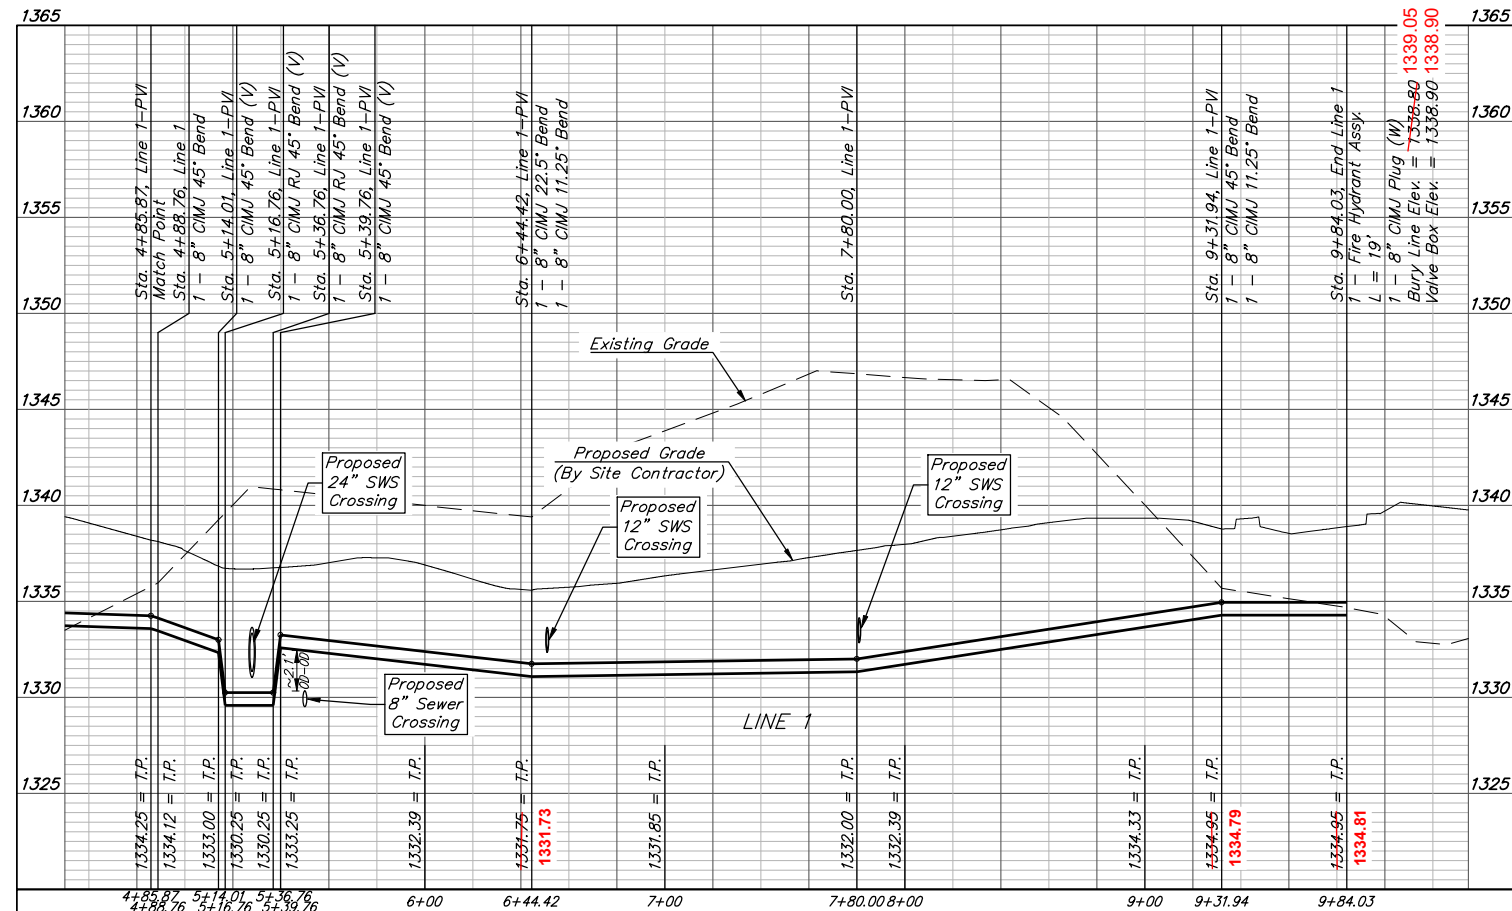

**BAUGHMAN COMPANY**

315 Ellis St.  
Wichita, KS 67211  
316-262-7271  
BaughmanCo.com

MEADOWLAND ADDITION  
Union at Purple Heart Trail

**LINE 1**

WATER DISTRIBUTION SYSTEM

PROJECT NUMBER:  
22-06-E228

DESIGN: AH    DRAWN: TMS

DATE: June 19, 2024

SHEET **3** OF **16**

**BENCHMARKS:**  
 BM #1: "□" chiseled on top of headwall, east side of 127th Street, north of site.  
 Elevation = 1330.04 (NAVD 88)

BM #2: Mag nail in asphalt, west side of 127th Street, north of cul-de-sac.  
 Elevation = 1344.42 (NAVD 88)

Pipe layout is shown with horizontal and vertical deflections. Contractor to use short pipe lengths, high deflection couplers, and manufacturer recommended pipe deflections to meet planned alignment.

Contractor to maintain a minimum of 10' of horizontal separation (O.D.-O.D.) between sanitary sewer and water line.

WATER LINE FITTING COORDINATES					
LINE	STA.	ITEM	NORTHING	EASTING	ELEV.
2	0+02	8" Valve	1,684,922.25	1,691,667.61	1339.18
2	0+44	22.5° Bend (H)	1,684,882.49	1,691,665.92	1335.76
2	0+77	8"x6" Tee	1,684,851.67	1,691,684.81	1336.21
2	0+77	6" FH Valve	1,684,852.80	1,691,686.11	1339.87
2	0+77	FIRE HYDRANT	1,684,858.21	1,691,694.26	1339.95
2	1+04	22.5° Bend (H)	1,684,829.94	1,691,697.42	1336.27
2	1+65	45° Bend (H)	1,684,768.75	1,691,704.97	1337.32
2	2+23	90° Bend (H)	1,684,727.18	1,691,667.65	1337.27
2	3+00	90° Bend (H)	1,684,674.08	1,691,723.10	1337.26
2/2A	5+52	8"x4" Tee	1,684,863.17	1,691,898.41	1338.32
2A	0+02	4" Valve	1,684,865.17	1,691,895.76	1341.10
2	5+60	90° Bend (H)	1,684,865.09	1,691,899.65	1338.49
2	5+61	8"x6" Reducer	1,684,866.32	1,691,899.10	1338.61
2	5+74.6	Top Fire Riser	1,684,873.74	1,691,891.78	1344.45

VALVE ELEV. = TOP OF BOX      FIRE HYD ELEV. = BURY LINE

From CL's of Douglas Ave. and S.127th St. E.:  
 22.5° BEND (H) = 1,508' S. & 116' E.

From CL's of Douglas Ave. and S.127th St. E.:  
 TEE = 1,539' S. & 132' E.  
 6" FH VALVE = 1,539' S. & 134' E.  
 FIRE HYDRANT = 1,538' S. & 144' E.  
 6" FH VALVE = 10' SW of FIRE HYDRANT.

From CL's of Douglas Ave. and S.127th St. E.:  
 22.5° BEND (H) = 1,532' S. & 136' E.





From CL's of Douglas Ave. and S.127th St. E.:  
 45° BEND (H) = 1,561' S. & 144' E.

From CL's of Douglas Ave. and S.127th St. E.:  
 90° BEND (H) = 1,622' S. & 147' E.

From CL's of Douglas Ave. and S.127th St. E.:  
 90° BEND (H) = 1,663' S. & 154' E.


From CL's of Douglas Ave. and S.127th St. E.:  
 8" x 4" TEE = 1,531' S. & 349' E.  
 4" GATE VALVE (NW) = 1,529' S. & 346' E.

From CL's of Douglas Ave. and S.127th St. E.:  
 90° BEND (H) = 1,529' S. & 350' E.  
 8" x 6" REDUCER (NW) = 1,527' S. & 349' E.

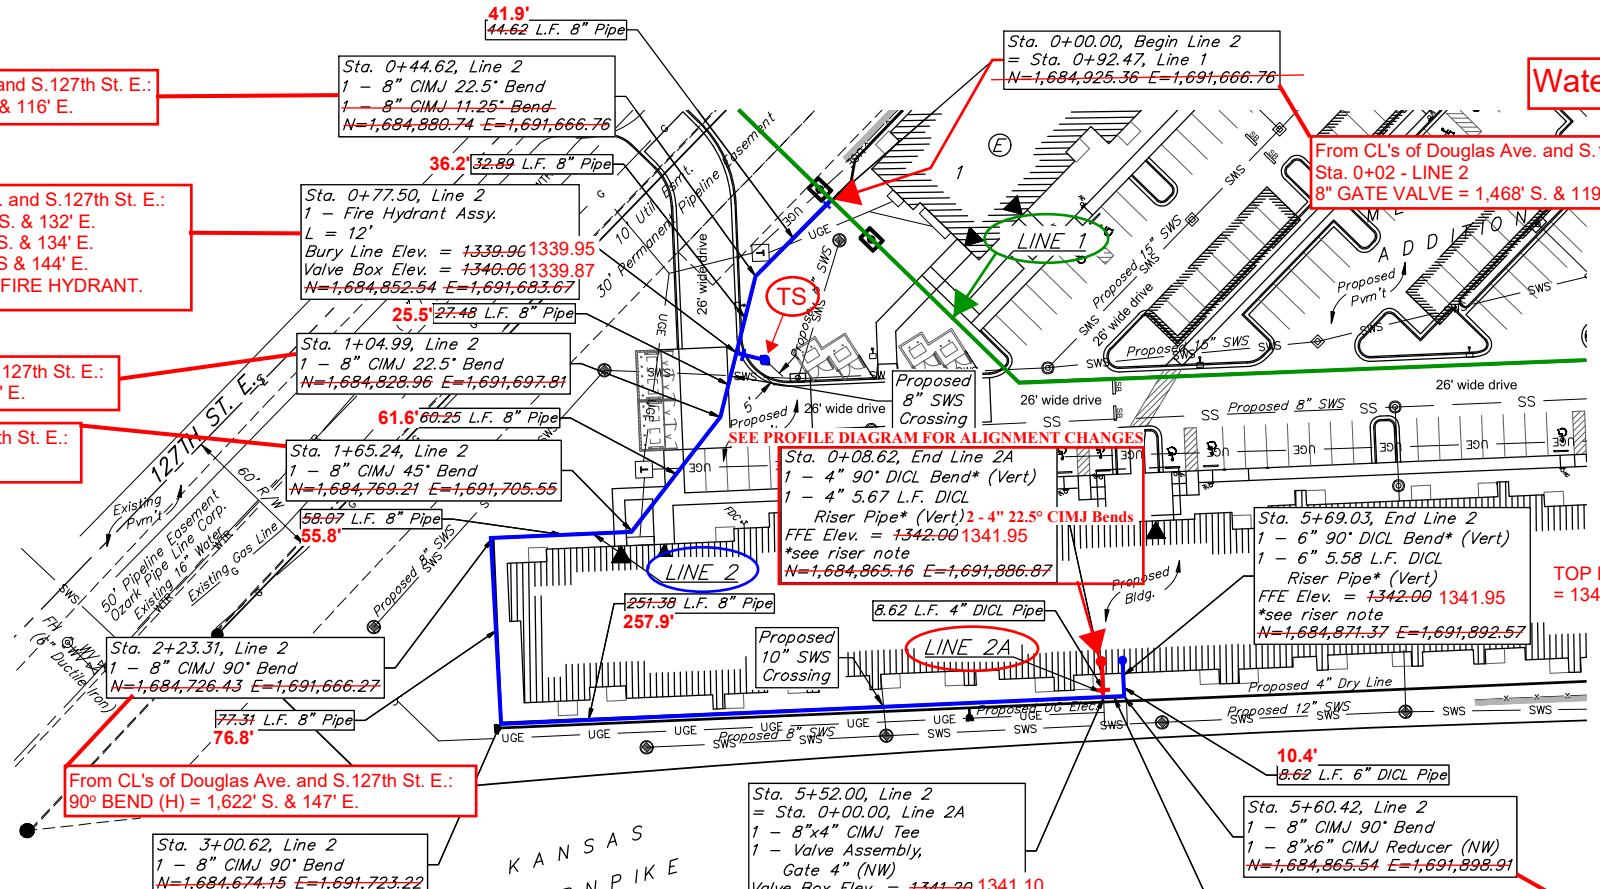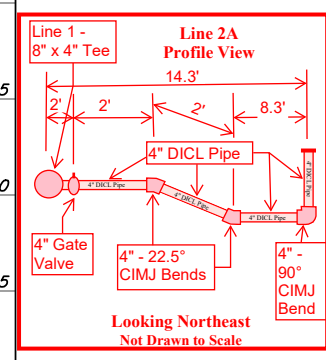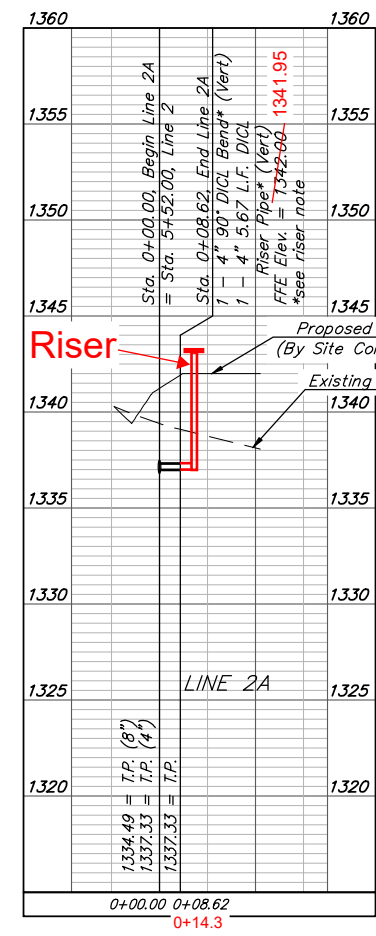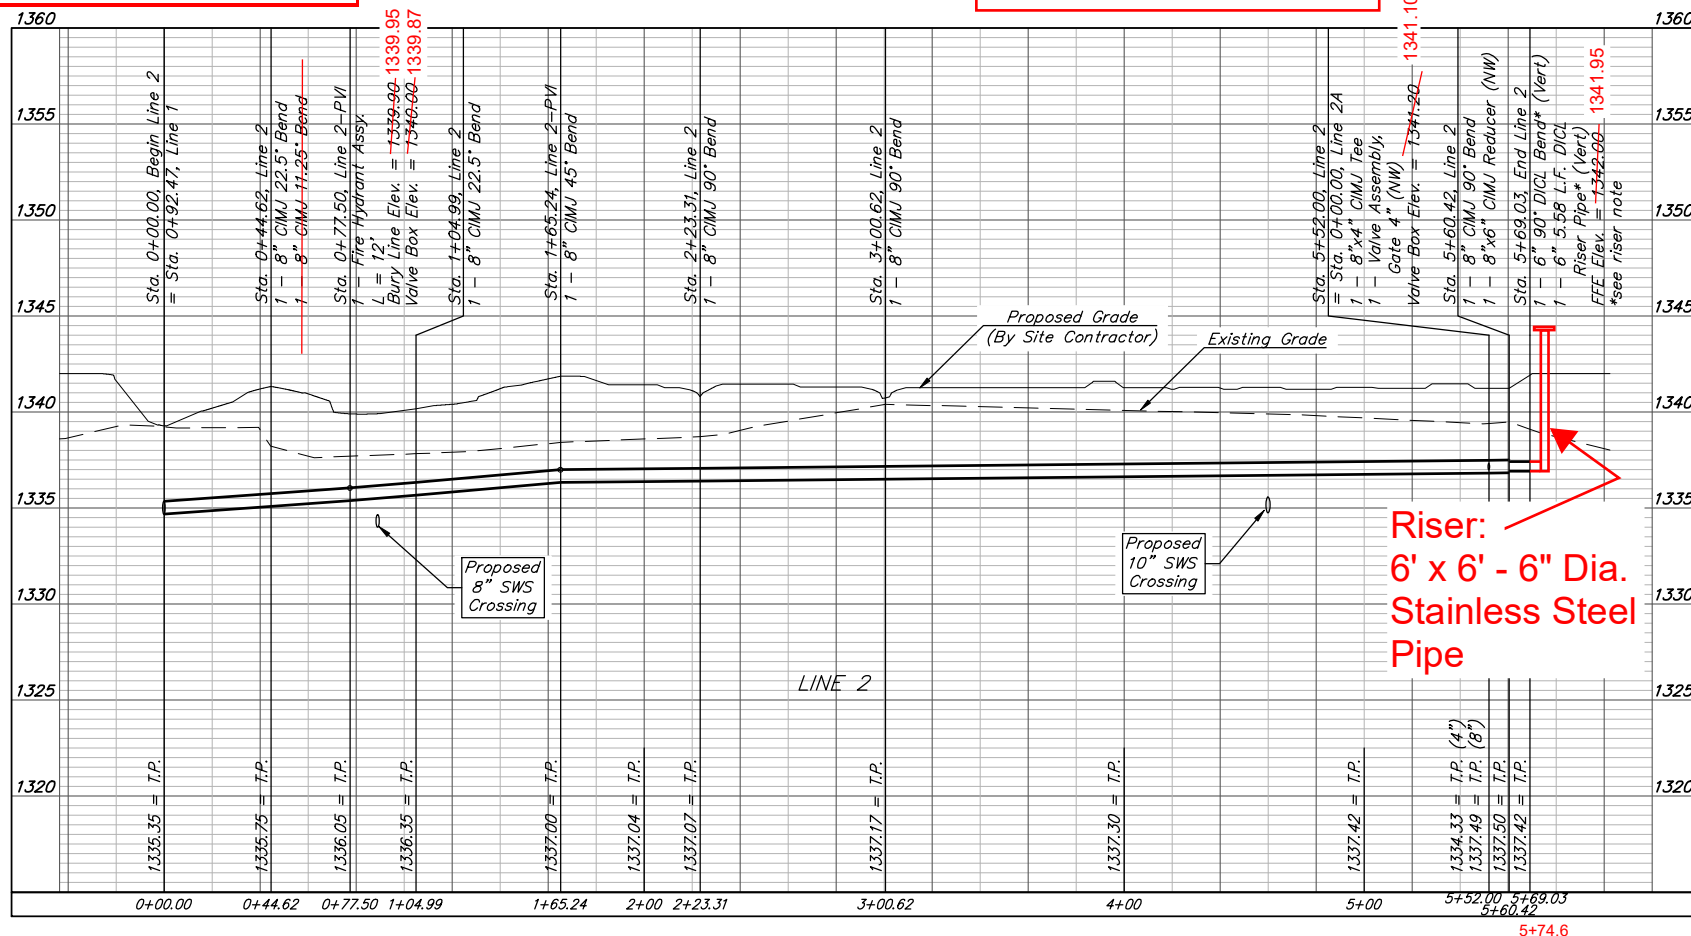

Water LINE 2 Installed on Plan Alignment.

From CL's of Douglas Ave. and S.127th St. E.:  
 Sta. 0+02 - LINE 2  
 8" GATE VALVE = 1,468' S. & 119' E.

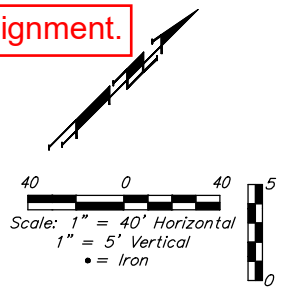

**LEGEND**  
 CL's = Centerlines.  
 (TS) = Test Stations

Contractor to verify depth and location of existing utilities. Contractor to relocate any existing utilities as necessary for construction.

Contact utility companies 3 weeks prior to construction to coordinate temporary removal/replacement.  
 Heide Bryan, Evergy, (316) 261-6354  
 Shannon Brinkmeyer, AT&T (316) 268-2931  
 Travis Taylor, Cox Comm., Travis.taylor@cox.com

\* Riser Note:  
 Contractor to install DICL pipe a minimum 5' outside Building. DICL riser pipe, CIMJ Bend, & DICL horizontal section exiting building foundation wall are to be mega-lugged together and riser is to be extended 12" above Building FFE. Riser location is approximate, building GC is required to locate Riser location per the foundation requirements. Contractor to install blind flange with 2" tap for testing. Remove flange & tap upon acceptance.



**BAUGHMAN COMPANY**  
 315 Ellis St.  
 Wichita, KS 67211  
 316-262-7271  
 BaughmanCo.com

MEADOWLAND ADDITION  
 Union at Purple Heart Trail

**LINES 2 & 2A**

WATER DISTRIBUTION SYSTEM

PROJECT NUMBER:  
 22-06-E228

DESIGN: AH      DRAWN: TMS

DATE: June 19, 2024

SHEET 4 OF 16

File: E:\Projects\Meadowland Addition\JupHIT\_22-06-E228\Engineering\Phase 1\PPWPWPW.dwg

**BENCHMARKS:**  
 BM #1: "□" chiseled on top of headwall, east side of 127th Street, north of site.  
 Elevation = 1330.04 (NAVD 88)

BM #2: Mag nail in asphalt, west side of 127th Street, north of cul-de-sac.  
 Elevation = 1344.42 (NAVD 88)


Pipe layout is shown with horizontal and vertical deflections. Contractor to use short pipe lengths, high deflection couplers, and manufacturer recommended pipe deflections to meet planned alignment.

Contractor to maintain a minimum of 10' of horizontal separation (O.D.-O.D.) between sanitary sewer and water line.


**LEGEND**

CL's = Centerlines.

TS = Test Stations

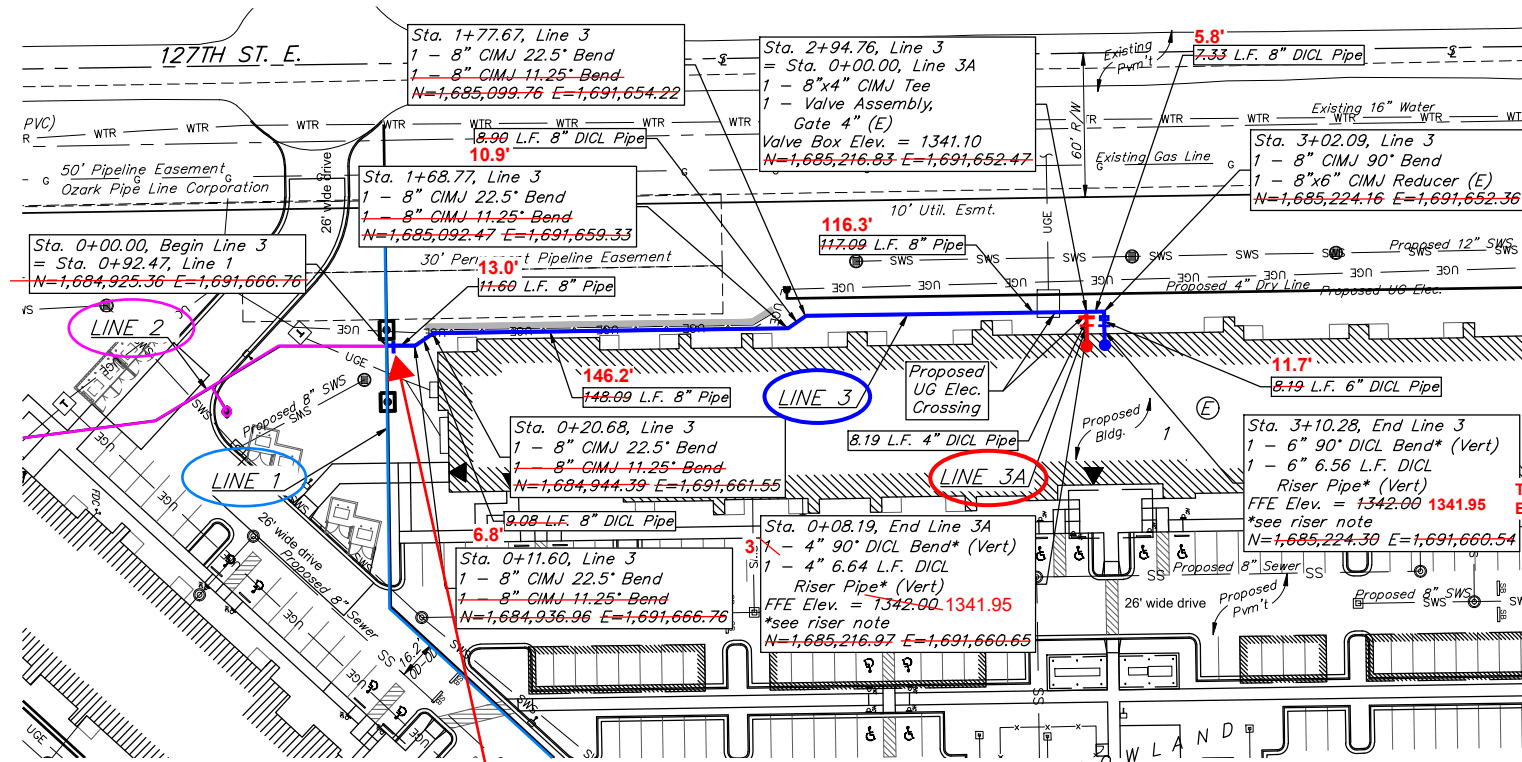

From CL's of Douglas Ave. and S.127th St. E.:  
 Sta. 0+02 - LINE 3  
 8" GATE VALVE = 1,463' S. & 119' E.

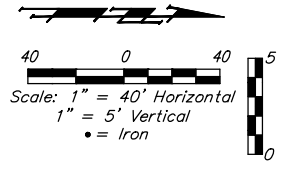


**Water LINE 3 Installed on Plan Alignment.**

Contractor to verify depth and location of existing utilities. Contractor to relocate any existing utilities as necessary for construction.



Contact utility companies 3 weeks prior to construction to coordinate temporary removal/replacement.  
 Heide Bryan, Evergy, (316) 261-6354  
 Shannon Brinkmeyer, AT&T (316) 268-2931  
 Travis Taylor, Cox Comm., Travis.taylor@cox.com

**\* Riser Note:**  
 Contractor to install DICL pipe a minimum 5' outside Building. DICL riser pipe, CIMJ Bend, & DICL horizontal section exiting building foundation wall are to be mega-lugged together and riser is to be extended 12" above Building FFE. Riser location is approximate, building GC is required to locate Riser location per the foundation requirements. Contractor to install blind flange with 2" tap for testing. Remove flange & tap upon acceptance.

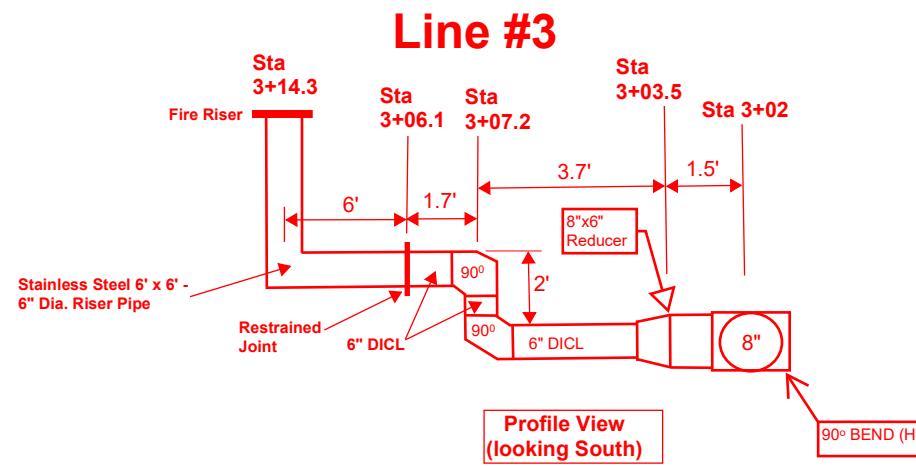

WATER LINE FITTING COORDINATES					
LINE	STA.	ITEM	NORTHING	EASTING	ELEV.
3	0+02	8" Valve	1,684,926.78	1,691,667.58	1339.43
3	0+11	22.5° Bend (H)	1,684,939.70	1,691,665.96	1335.24
3	0+20	22.5° Bend (H)	1,684,944.77	1,691,661.37	1335.90
3	1+68	22.5° Bend (H)	1,685,090.90	1,691,657.73	1336.55
3	1+77	22.5° Bend (H)	1,685,101.00	1,691,653.58	1336.48
3 / 3A	2+94	8"x4" Tee	1,685,217.27	1,691,651.18	1336.67
3	3+02	90° Bend (H)	1,685,223.68	1,691,651.37	1336.38
3	3+03.5	8"x6" Reducer	1,685,224.28	1,691,652.69	1336.40
3	3+07.2	90° Bend (V)	1,685,224.54	1,691,656.59	1336.40
3	3+07.2	90° Bend (V)	1,685,224.54	1,691,656.59	1338.59
3	3+14.3	Top Fire Riser	1,685,224.45	1,691,663.65	1344.38
3A	0+02	4" Valve	1,685,218.37	1,691,653.66	1341.10

VALVE ELEV. = TOP OF BOX      FIRE HYD ELEV. = BURY LINE

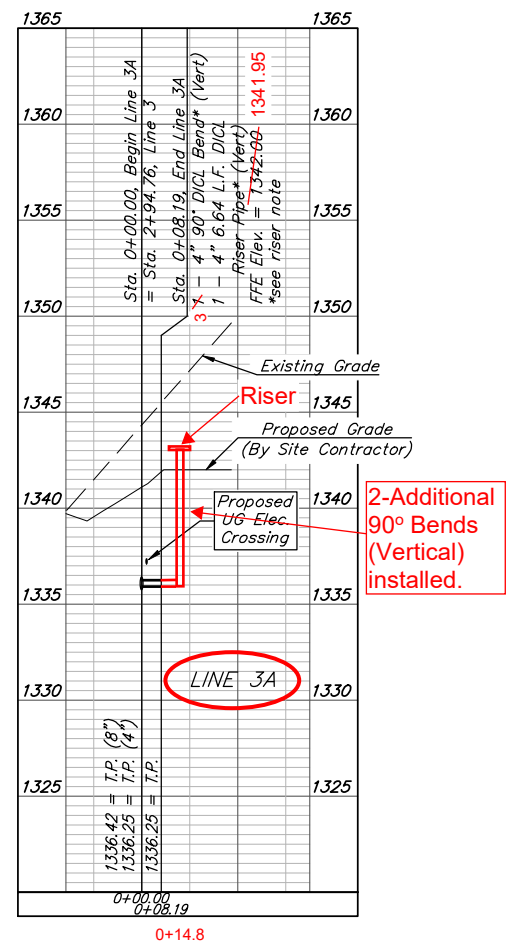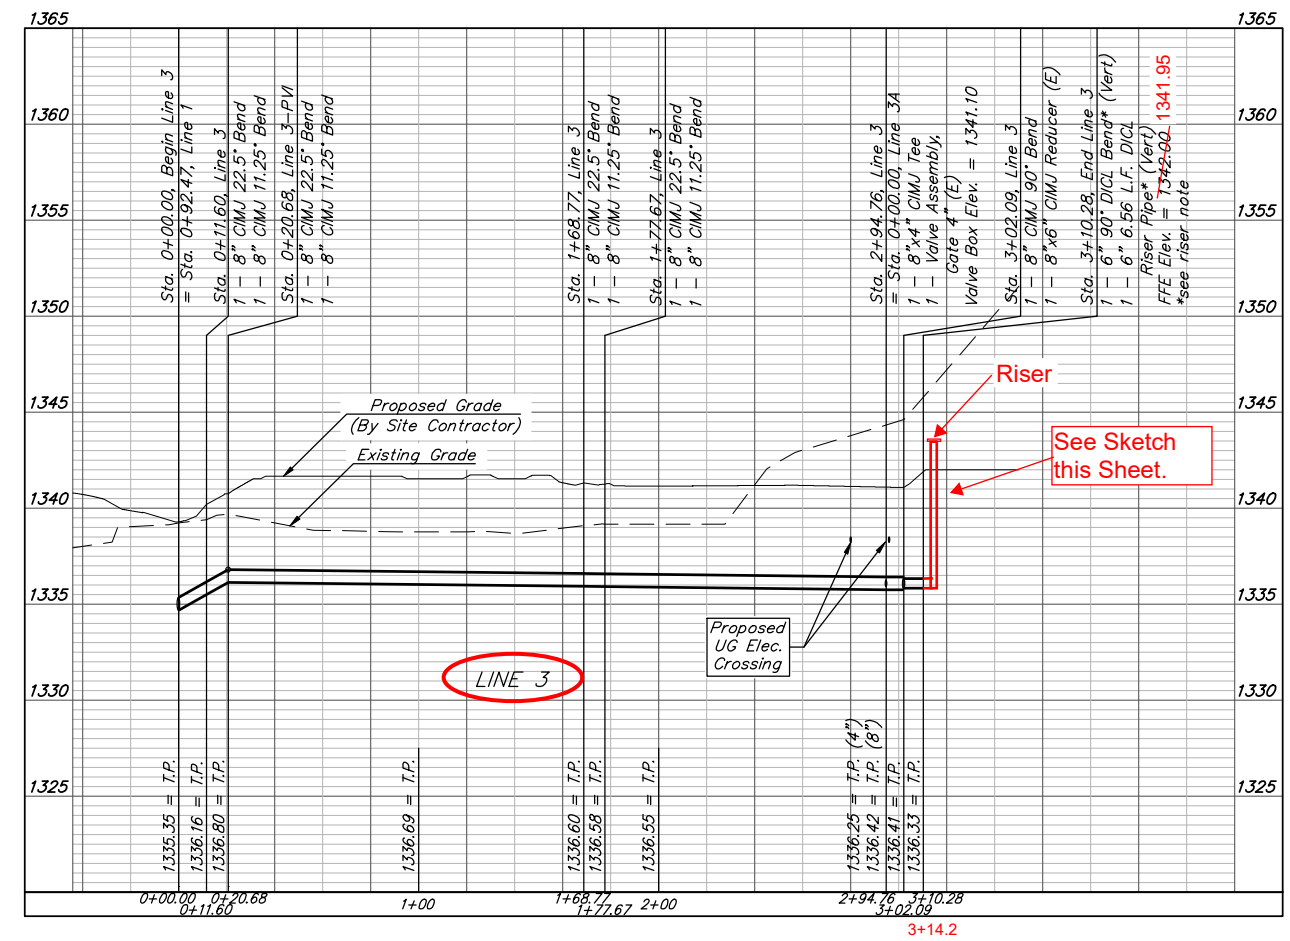

**BAUGHMAN COMPANY**  
 315 Ellis St.  
 Wichita, KS 67211  
 316-262-7271  
 BaughmanCo.com

MEADOWLAND ADDITION  
 Union at Purple Heart Trail

**LINES 3 & 3A**


WATER DISTRIBUTION SYSTEM

PROJECT NUMBER:  
 22-06-E228

DESIGN: AH      DRAWN: TMS

DATE: June 19, 2024

SHEET **5** OF **16**

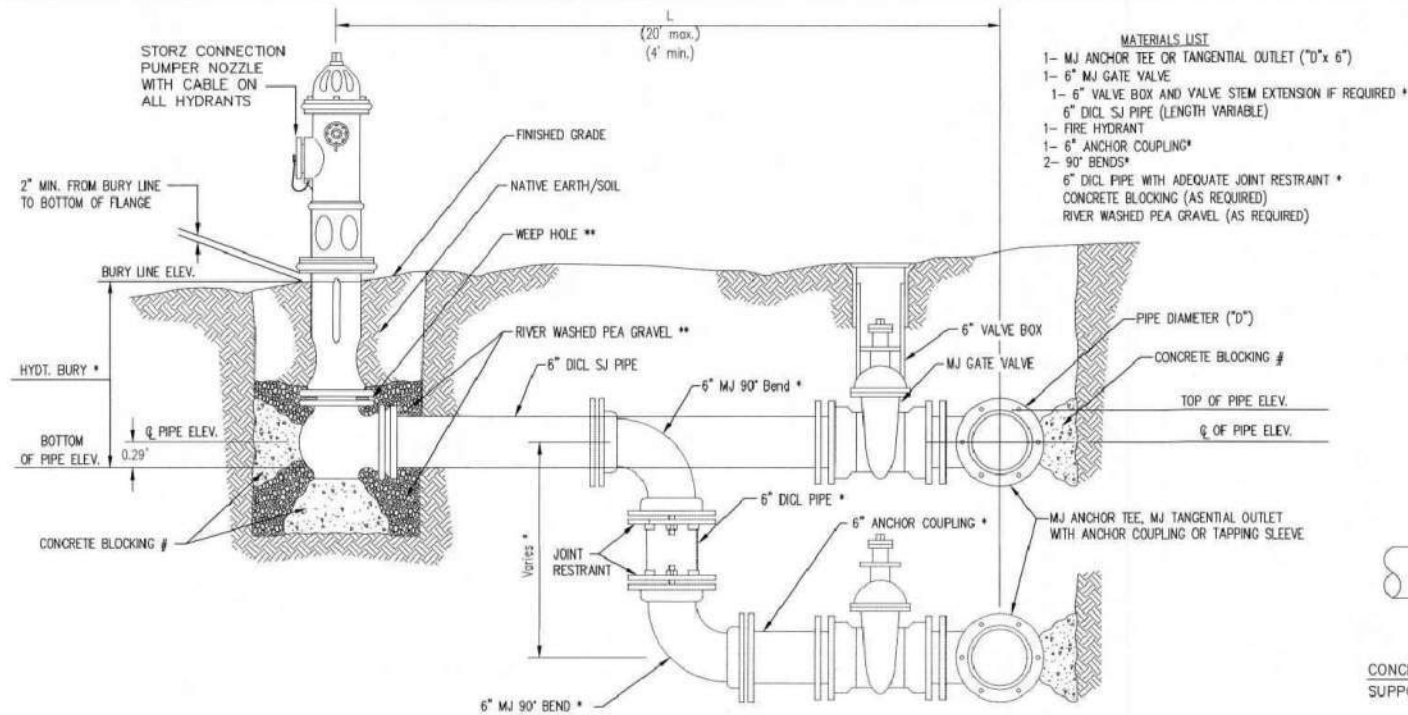


- MATERIALS LIST**
- 1- MJ ANCHOR TEE OR TANGENTIAL OUTLET (10" x 6")
  - 1- 6" MJ GATE VALVE
  - 1- 6" VALVE BOX AND VALVE STEM EXTENSION IF REQUIRED \*
  - 6" DI CL SJ PIPE (LENGTH VARIABLE)
  - 1- FIRE HYDRANT
  - 1- 6" ANCHOR COUPLING\*
  - 2- 90° BENDS\*
  - 6" DI CL PIPE WITH ADEQUATE JOINT RESTRAINT \*
  - CONCRETE BLOCKING (AS REQUIRED)
  - RIVER WASHED PEA GRAVEL (AS REQUIRED)

\* IF THE REQUIRED HYDRANT BURY IS IN EXCESS OF 5', BUT LESS THAN 7', CONTRACTOR SHALL USE STANDARD 5" HYDRANT BURY AND HYDRANT BARREL EXTENSIONS AS NECESSARY. IF THE REQUIRED HYDRANT BURY IS GREATER THAN 7', CONTRACTOR SHALL USE 5" HYDRANT BURY, 2-MJ 90° BENDS, 6" ANCHOR COUPLING AND 6" DI CL PIPE AS NECESSARY FOR VERTICAL ADJUSTMENT. THE CONTRACTOR SHALL PROVIDE ADEQUATE THRUST BLOCKING AT HYDRANT AND MEGALUGS, OR SIMILAR RESTRAINT BETWEEN 90° BENDS TO SECURE ALL FITTINGS DURING TESTING AND OPERATION. THE CONTRACTOR SHALL PROVIDE A VALVE STEM EXTENSION PER DETAIL THIS SHEET.

\*\* CAUTION: WEEP HOLES TO BE KEPT CLEAR DURING CONSTRUCTION AND BACKFILL. CONCRETE FOR THRUST BLOCKING SHALL NOT OBSTRUCT WEEP HOLES. PLACE 1 CUBIC FOOT OF RIVER WASHED PEA GRAVEL AROUND EACH WEEP HOLE.

# CONCRETE THRUST BLOCKING SHALL BE KEPT CLEAR OF BOLTS, NUTS, AND MJ ACCESSORIES.

**FIRE HYDRANT ASSEMBLY**  
PER CITY OF WICHITA SPECIFICATIONS

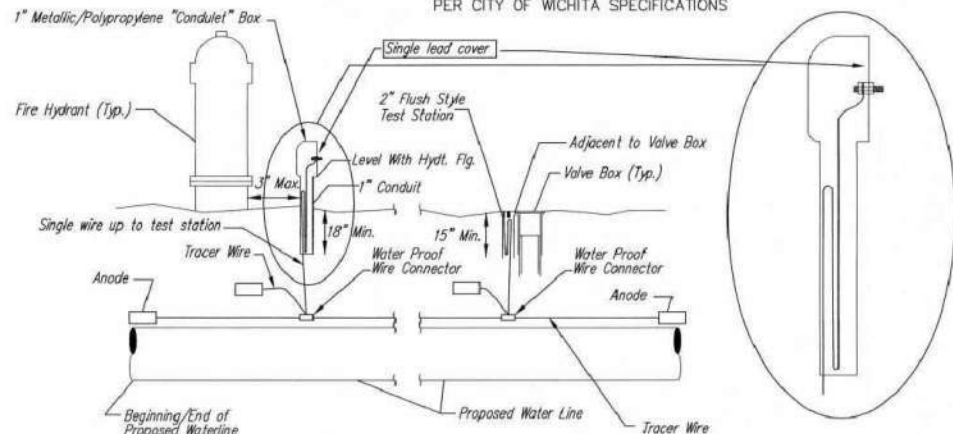

**TRACER WIRE**  
Conductive type pipe locator/tracer wire shall be installed to locate all waterline pipe regardless of pipe material. The wire shall extend the entire length of the proposed pipe. The wire shall be taped to the waterline and pulled with the pipe. A waterproof connector shall be used at splice locations. A complete list of approved tracer wire and waterproof connectors can be found on the City of Wichita's website at [www.wichita.gov](http://www.wichita.gov).

**WIRES**  
The tracer wire shall be Blue No. 12 AWG CCS with 45 mil HDPE insulation. To allow for grade adjustment, a minimum of 12" of excess wire shall be coiled at the bottom of the test station for all wires. Wire connectors shall be installed per manufacturer recommendations. Contractor shall attach wire being installed with proposed water main to any tracer wire installed with adjacent waterline projects.


**TEST STATIONS**  
The test station for fire hydrant application shall be a 1" "conduit" style station as manufactured by AGRA Industries with a removable solid cover having a single lead extending from the face or approved equal. The "conduit" style test station shall be attached to a 1" rigid galvanized conduit with a minimum length of 36" and plastic end bushing. The flush style shall have the word "WATER" stamped or molded into the lid. The test station for valve applications shall be a 2" flush style test station with wire connector on lid. Model # T2PH7B1LP Handley Industries or CD14\*TP SnakePit as manufactured by Copperhead Industries or approved equal. The flush style shall have the word "WATER" stamped or molded into the lid. All test stations shall be manufactured using molded blue tops or sufficiently coated with blue enamel paint. The tracer wire and the anode wire shall be installed to allow 12" of wire within the test station. The location of all test stations shall be recorded, and shown in the as-built drawings. Flush style test stations shall not be installed in pavement or sidewalk unless approved by the Engineer. Contractor shall extend tracer wire & move flush mount test station to nearest location out of pavement or sidewalk.

**ANODES**  
The anodes shall be 3 lb. bare zinc or magnesium. The anodes shall be buried at the same elevation as the waterline at each test station. The anodes shall be connected to 12 AWG CCS which shall be extended to the test station.


**TRACER WIRE DETAIL**  
COST IS SUBSIDIARY TO PIPE INSTALLATION

**BURY LINE ELEVATION**


STATION	BURY LINE ELEVATION	TOP OF PIPE ELEVATION	FIRE HYDRANT BURY REQUIRED*	VALVE STEM EXT. REQUIRED (ft)*
4+85.87	1338.10	1334.25	4.5'	No.
9+84.03	1338.80	1334.95	4.5'	No.
0+77.50	1339.90	1336.05	4.5'	No.

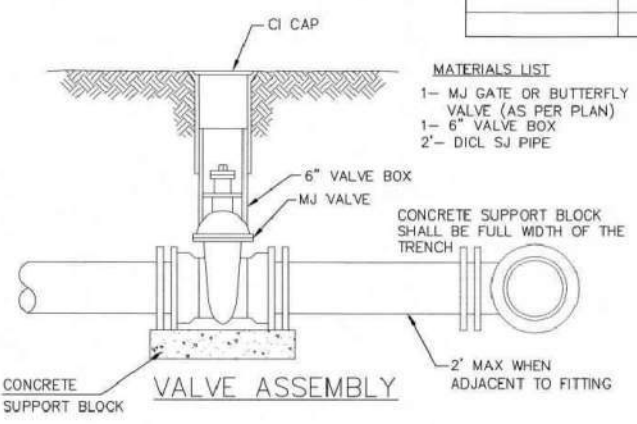

- MATERIALS LIST**
- 1- MJ GATE OR BUTTERFLY VALVE (AS PER PLAN)
  - 1- 6" VALVE BOX
  - 2"- DI CL SJ PIPE

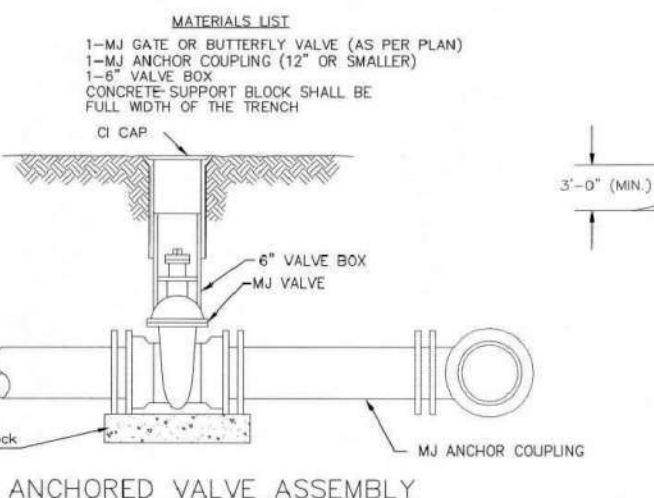


- MATERIALS LIST**
- 1- MJ GATE OR BUTTERFLY VALVE (AS PER PLAN)
  - 1- CIMJ CAP WHEN NECESSARY
  - 1- 6" VALVE BOX
  - 20' OF PIPE (BID WITH PIPE)
  - 2 - #6 REINF. BARS
  - CONCRETE SUPPORT BLOCK SHALL BE FULL WIDTH OF THE TRENCH

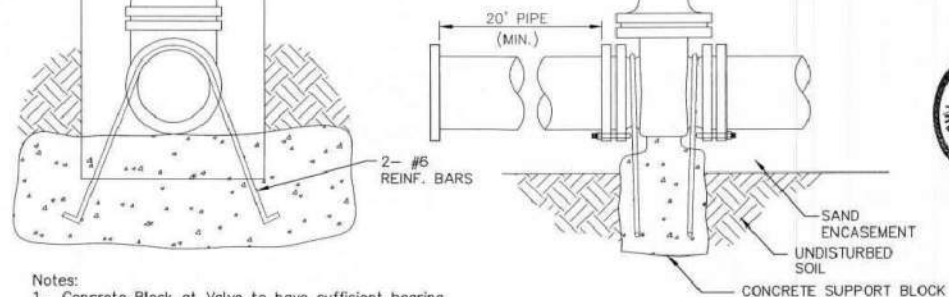


- Notes:**
- Concrete Block at Valve to have sufficient bearing in undisturbed soil to prevent thrust movement as shown in table at right. Field Engineer to determine thrust loading of undisturbed soil and final size of thrust block.
  - The thrust block shall be constructed such that bolts, nuts, and other MJ accessories are kept clear of concrete.
  - All valves at dead ends and at other locations as called out on the plans shall be blocked as shown here.

VALVE	THRUST AT 150 #/sq
4"	1809 lbs.
6"	4245 lbs.
8"	7540 lbs.
12"	16965 lbs.


**ANCHORED VALVE ASSEMBLY, SPECIAL**

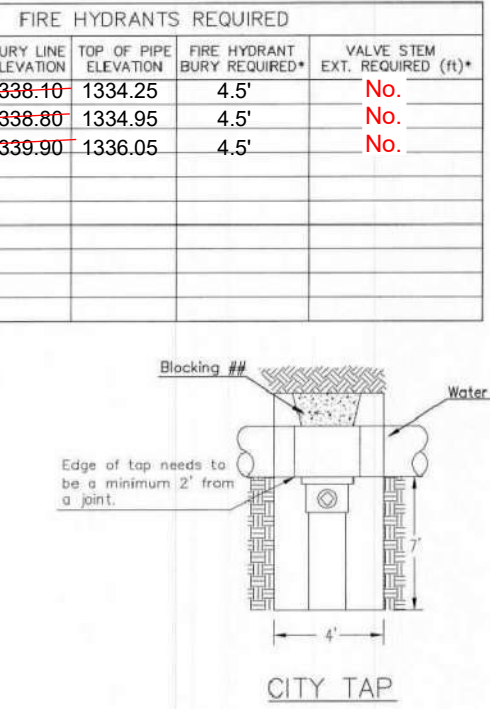

- MATERIALS LIST**
- 1- MJ GATE OR BUTTERFLY VALVE (AS PER PLAN)
  - 1- 6" VALVE BOX
  - 2"- DI CL SJ PIPE

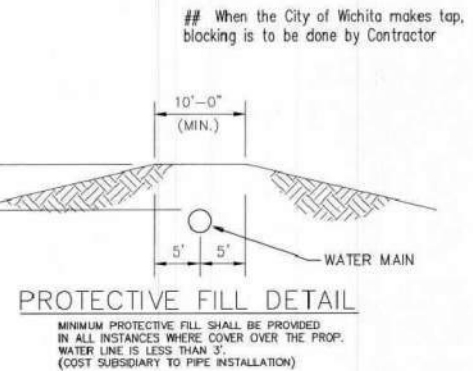


**PROTECTIVE FILL DETAIL**  
MINIMUM PROTECTIVE FILL SHALL BE PROVIDED IN ALL INSTANCES WHERE COVER OVER THE PROP. WATER LINE IS LESS THAN 5'. (COST SUBSIDIARY TO PIPE INSTALLATION)

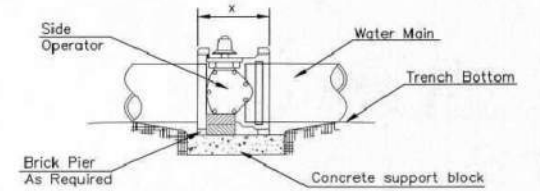


- NOTES**
- This detail covers Butterfly Valve installation, inclusive, regardless of type of pipe or joint used. 24" and larger lines to be detailed on plans.
  - 6" Valve Box and Cover required per City of Wichita Std. Specifications.
  - Conc. Support Block to be full width of trench.

**CONCRETE SUPPORT BLOCKING FOR BUTTERFLY VALVE INSTALLATION**

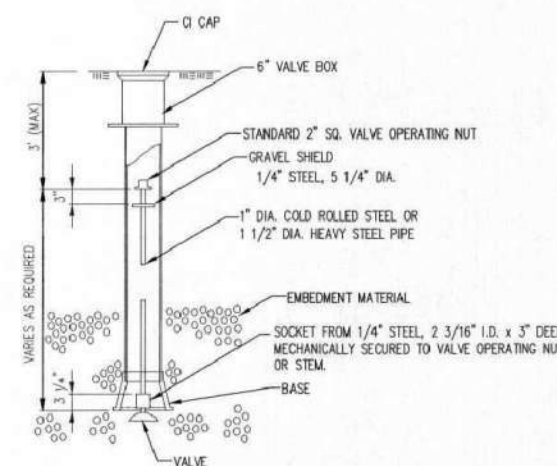

**VALVE STEM EXTENSION DETAIL**  
NOTE: ONE VALVE STEM EXTENSION FOR EACH VALVE BURIED GREATER THAN 5'.

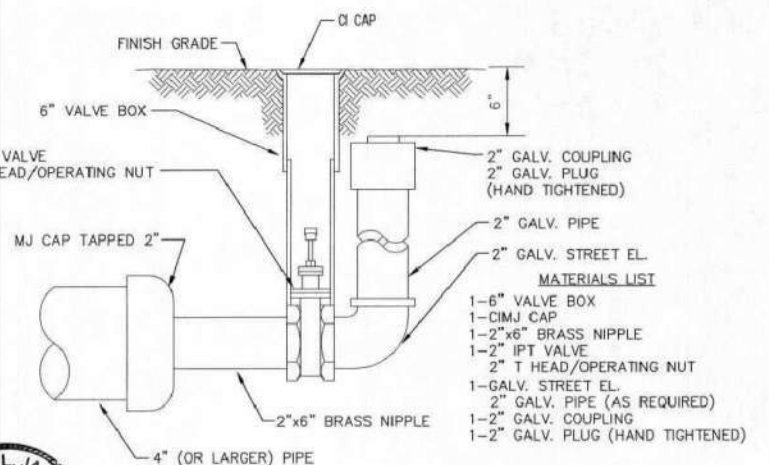

- MATERIALS LIST**
- 1- 6" VALVE BOX
  - 1- CIMJ CAP
  - 1- 2"x6" BRASS NIPPLE
  - 1- 2" IPT VALVE
  - 2" T HEAD/OPERATING NUT
  - 1- GALV. STREET EL.
  - 2" GALV. PIPE (AS REQUIRED)
  - 1- 2" GALV. COUPLING
  - 1- 2" GALV. PLUG (HAND TIGHTENED)



**2" BLOWOFF ASSEMBLY**

STANDARD WATER ASSEMBLY DETAIL

CITY ENGINEER  
**GARY JANZEN, P.E.**

PROJECT NUMBER: OCA NUMBER: DATE:

CITY ENGINEER'S OFFICE  
CITY HALL - SEVENTH FLOOR  
455 NORTH MAIN STREET  
WICHITA, KANSAS 67202-1620  
(316) 268-4501

SHEET  
**7 of 16**

REVISED: OCTOBER 2016



# MEADOWLAND ADDITION WICHITA, SEDGWICK COUNTY, KANSAS

PC 134-5B

LOT	BLOCK	ELEVATION
1	0	1171.00
2	0	1171.00
3	0	1171.00
4	0	1171.00
5	0	1171.00
6	0	1171.00
7	0	1171.00
8	0	1171.00
9	0	1171.00
10	0	1171.00
11	0	1171.00
12	0	1171.00

NOTE: CITY AND ANCHOR EASEMENTS (MISC. BOOK 221, PAGE 302), AS SHOWN ON THIS PLAN, ARE UNLINED WITH LENGTH AND DIRECTION. THE SYMBOLS REPRESENTED ON THIS PLAN ARE TO BE USED TO LOCATE THE POINTS OF THE CITY AND ANCHOR EASEMENTS. (MISC. BOOK 221, PAGE 302).


NOTE: CITY AND ANCHOR EASEMENTS (MISC. BOOK 221, PAGE 302), AS SHOWN ON THIS PLAN, ARE UNLINED WITH LENGTH AND DIRECTION. THE SYMBOLS REPRESENTED ON THIS PLAN ARE TO BE USED TO LOCATE THE POINTS OF THE CITY AND ANCHOR EASEMENTS. (MISC. BOOK 221, PAGE 302).

NOTE: CITY AND ANCHOR EASEMENTS (MISC. BOOK 221, PAGE 302), AS SHOWN ON THIS PLAN, ARE UNLINED WITH LENGTH AND DIRECTION. THE SYMBOLS REPRESENTED ON THIS PLAN ARE TO BE USED TO LOCATE THE POINTS OF THE CITY AND ANCHOR EASEMENTS. (MISC. BOOK 221, PAGE 302).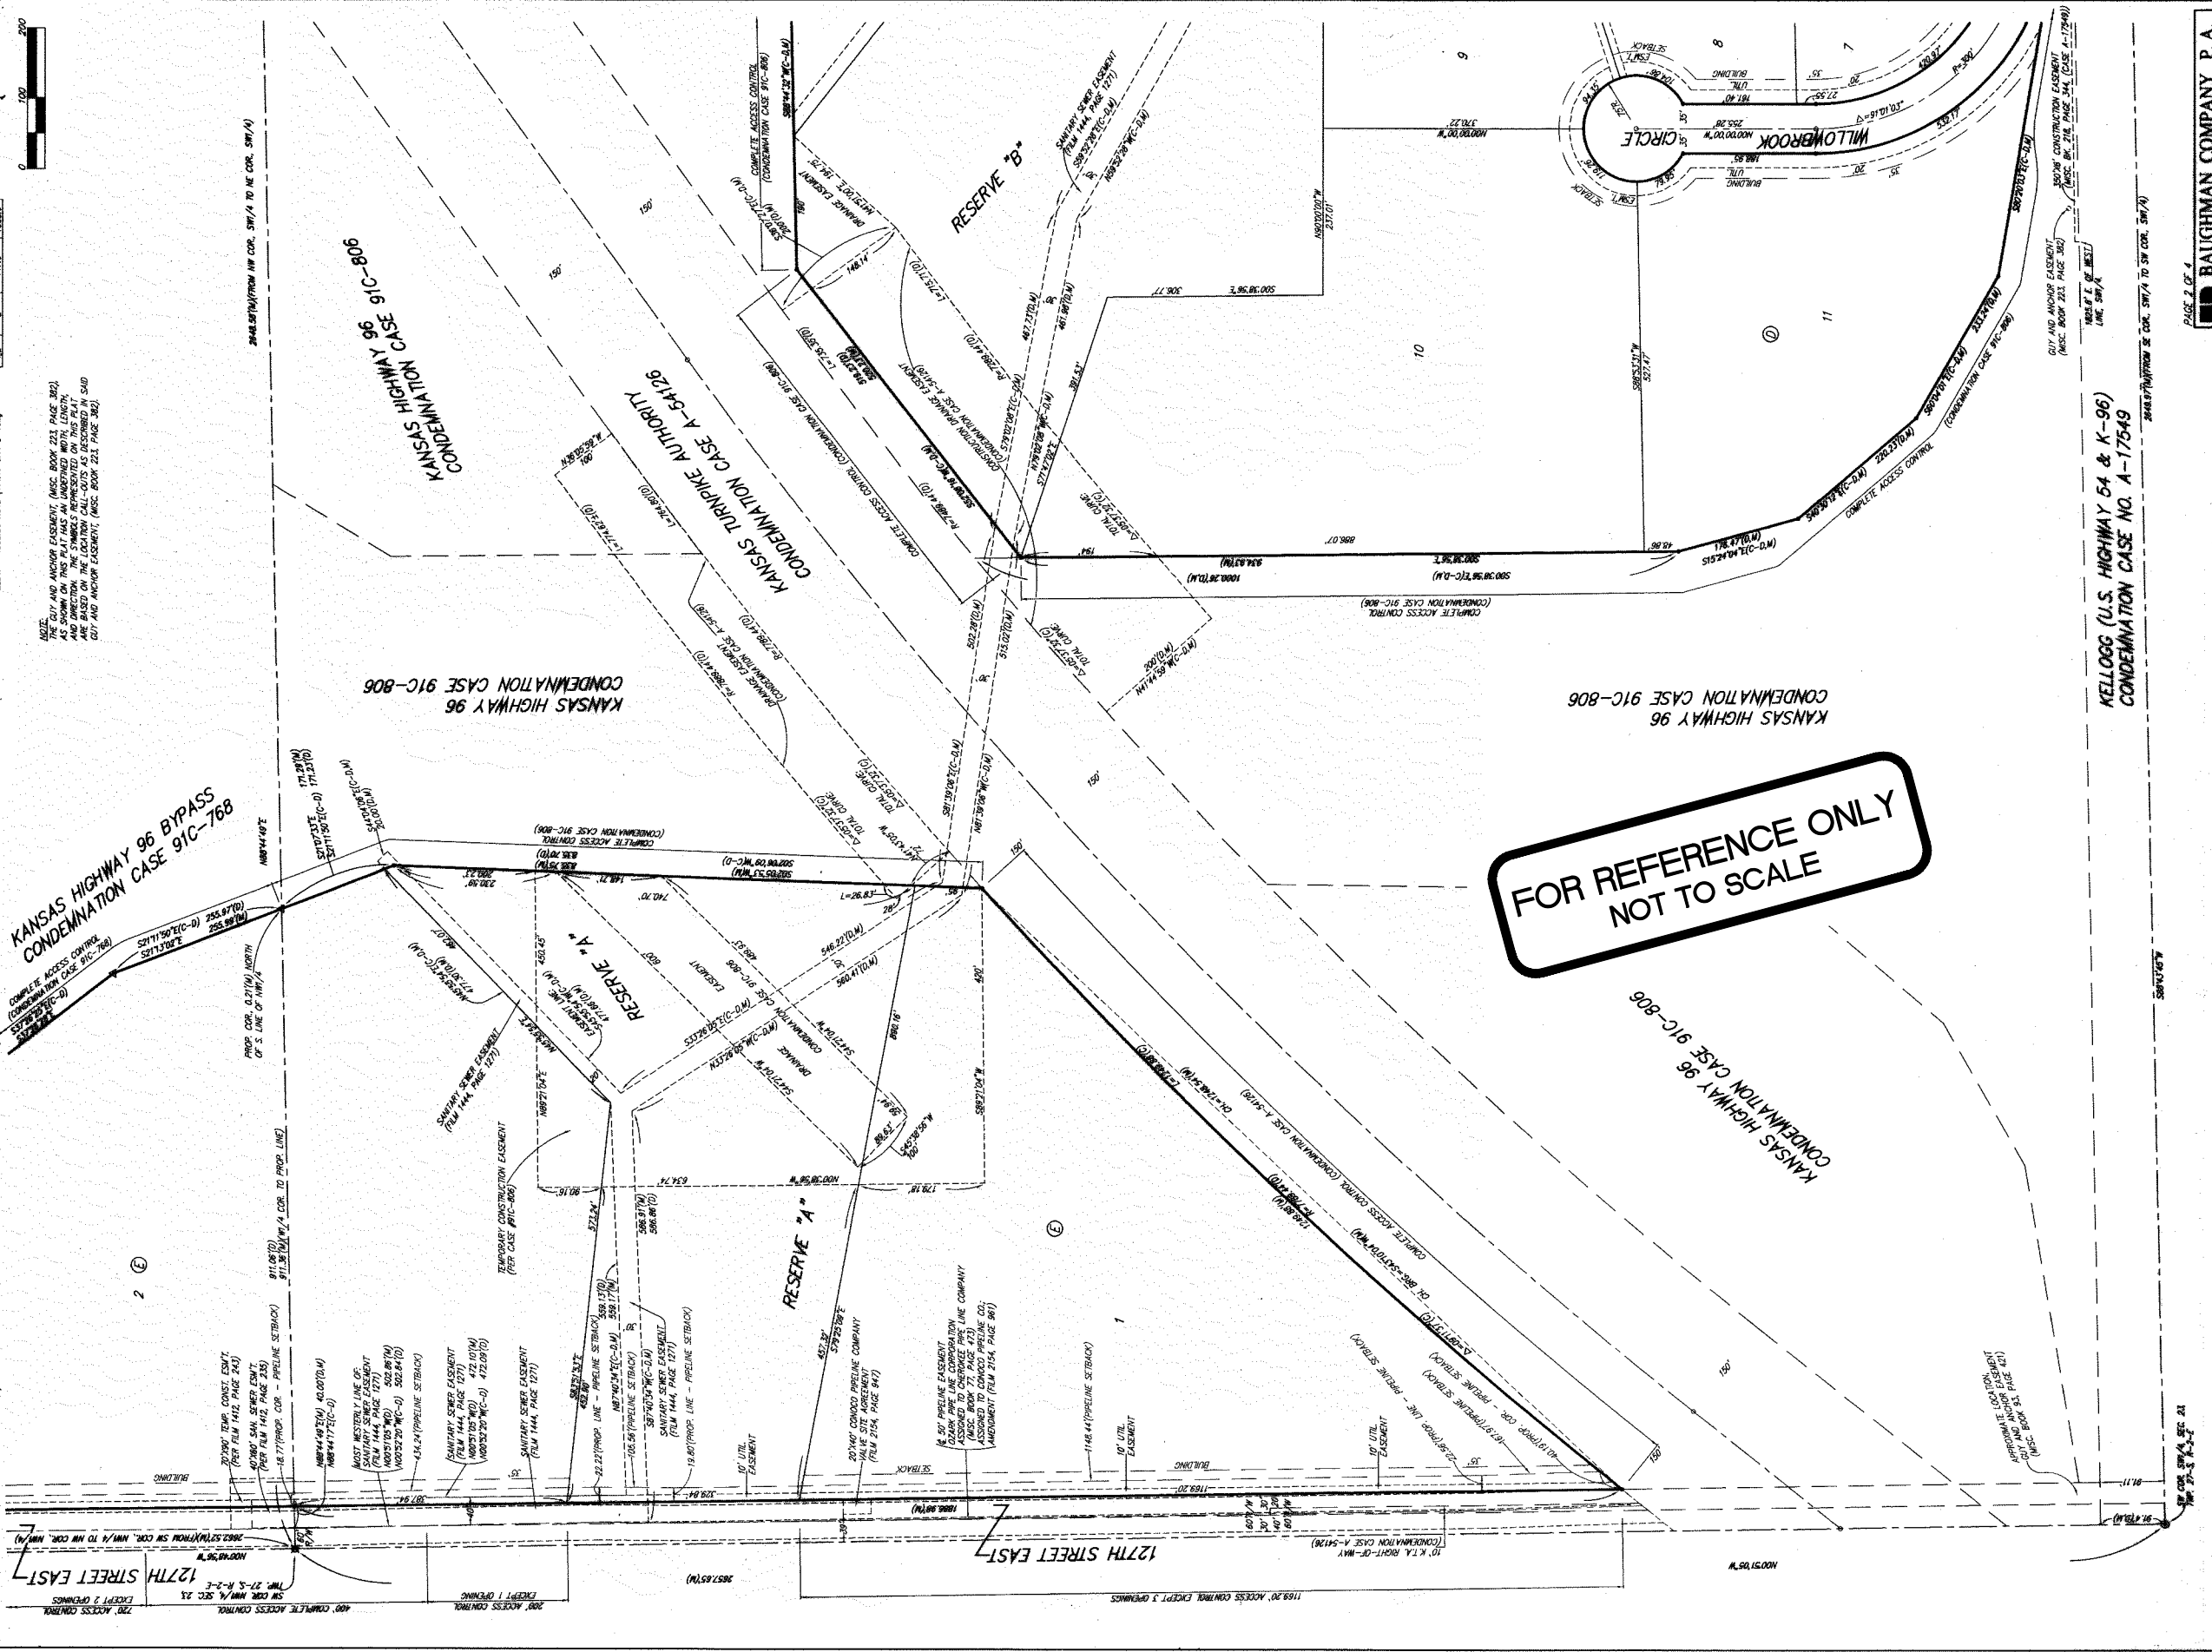

**FOR REFERENCE ONLY  
NOT TO SCALE**

PC 134-5B

**BAUGHMAN COMPANY P. A.**  
ENGINEERING, SURVEYING & PLANNING

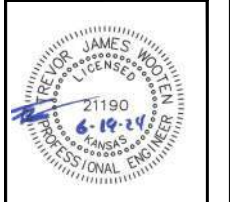

**BAUGHMAN COMPANY**  
315 Ellis St.  
Wichita, KS 67211  
316-262-7271  
BaughmanCo.com

MEADOWLAND ADDITION  
Union at Purple Heart Trail

**COPY OF  
PLAT**

WATER DISTRIBUTION SYSTEM  
PROJECT NUMBER:  
22-06-E228  
DESIGN: AH DRAWN: TMS  
DATE: June 19, 2024  
SHEET 16 OF 16

File: E:\Projects\Meadowland Addition\UspHt\_22-06-E228\Engineering\Phase 1\PPW\PPRW.dwg