


Private Project  
 Median Modification - 81 Ft of Median on Maple West of West Street  
 472-76-245-80000-000-000-008

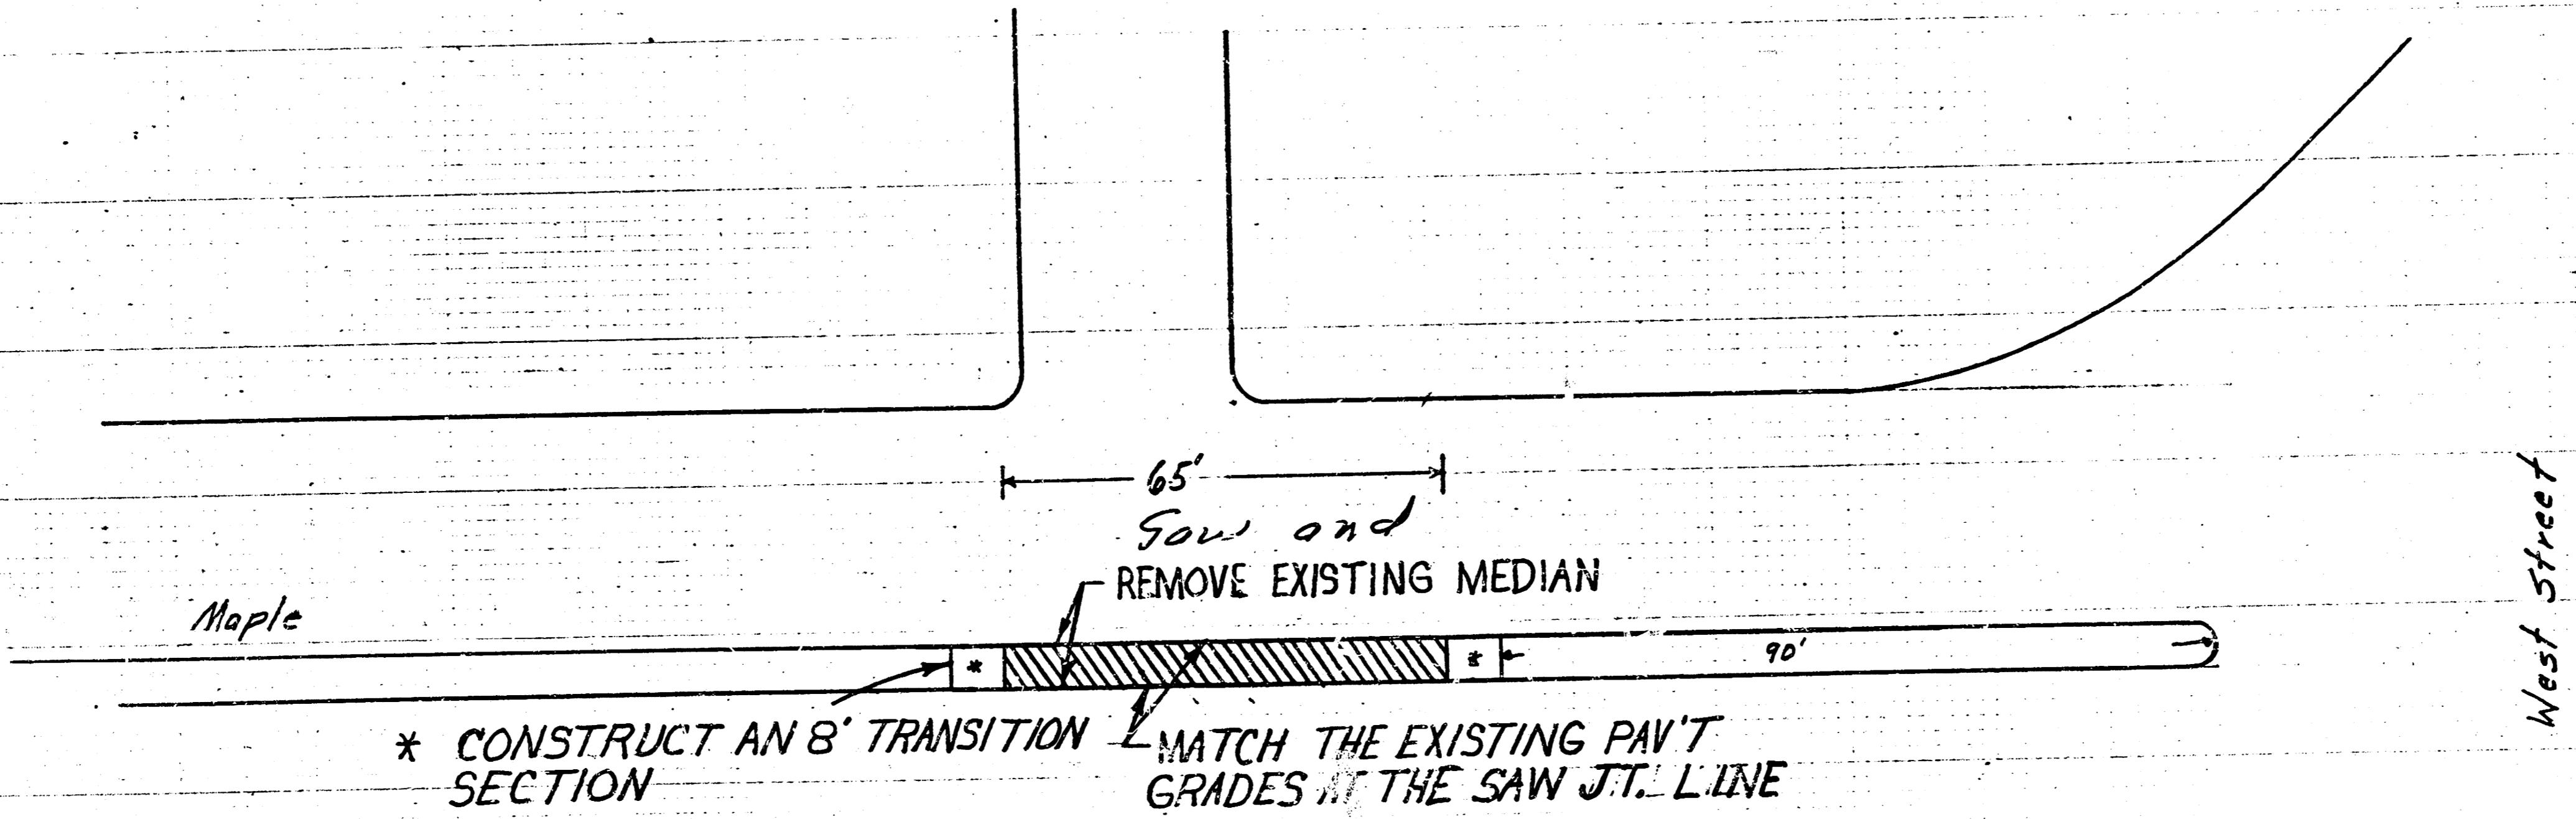

- \* Construct 8" Conc Pavement Reinf. With 6" x 12" W4x4 W.W.F.
- Contractor shall provide adequate traffic control
- Maintain one lane traffic in each direction
- Concrete joints to match existing pavement joints
- Compact existing subgrade
- Utilize existing steel to tie new pavement to existing pavement
- Lump Sum

\* If present island is on concrete pavement  
 Removal of island, patch holes & construct transitions will complete this project

NO SCALE - Wichita Kansas  
 1984

NOTE TO CONTRACTOR  
 This project will be constructed under the supervision of the CITY ENGINEER and conforming to the SPECIFICATIONS of the CITY OF WICHITA. THE CONTRACTOR shall be responsible for all costs of inspection.

11-9-84  
 APPROVED AS NOTED  
 By CITY ENGINEER OF WICHITA  
 Sanitary Sewers  
 Storm Sewers  
 Pavement  
 Utility Approaches P.C.D.