

Market - S.E. Corner - S.E. English

New Section - Remains Hypothesis

Point A on
Continued Work

Market

New Section

Remains Hypothesis

420

Remains
Hypothesis

Elm
75

50

15' R

50

70

10
11
12

THIRD ST

CENTRAL AVE

New gutter
Downspout removed

600'

Part Street

Remove
curb
install new
curb
Burlington

Take out
base

70'

SECOND 54.

New butter remove old ~~stone~~ butter

600

225 - Case 111111
10/1/11

Use G.R.

THIRD ST.

Received
by the
Attorney
General

Close Drive
North Hotel
Kensington
No. 100

New South

~~SECRET~~ *SECRET*

About half (100)

James Leonard Brown
and Sumner
Howard Brown.
Part 1.

WILLIAM

130'

36'

120'

DOUGLAS

Hard Rock

Hard Rock

8"

Crown Exposed
Boulder Layer
Pavement


150'


16'

120'

DOUGLAS

FIRST ST.

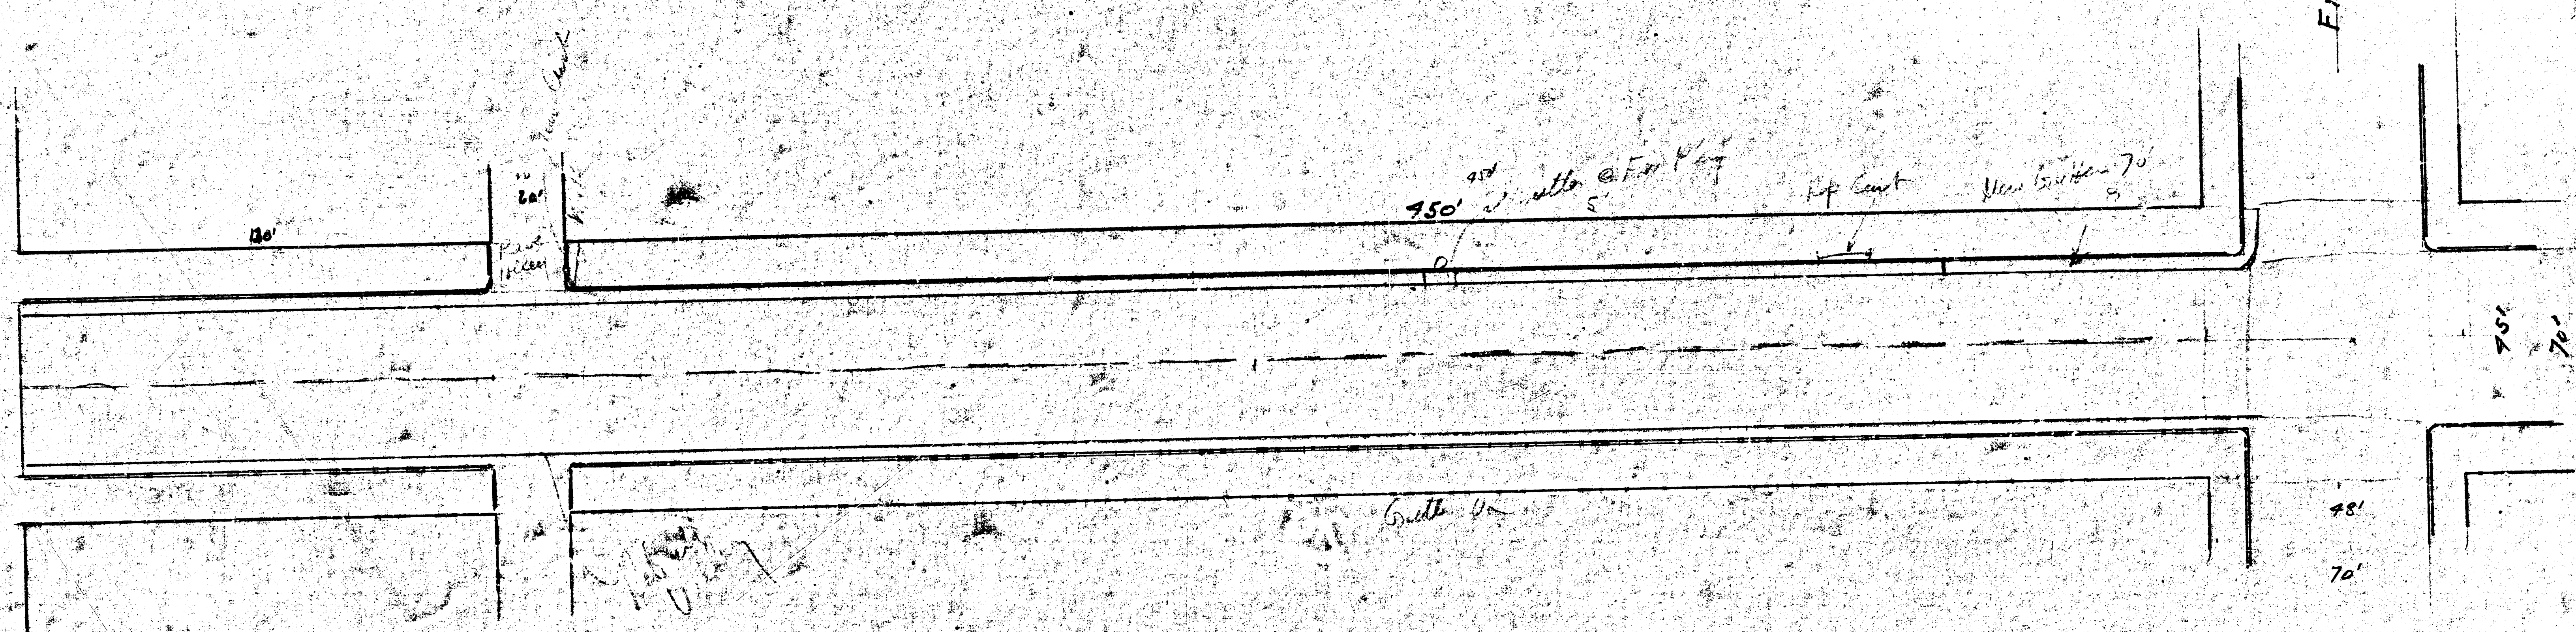

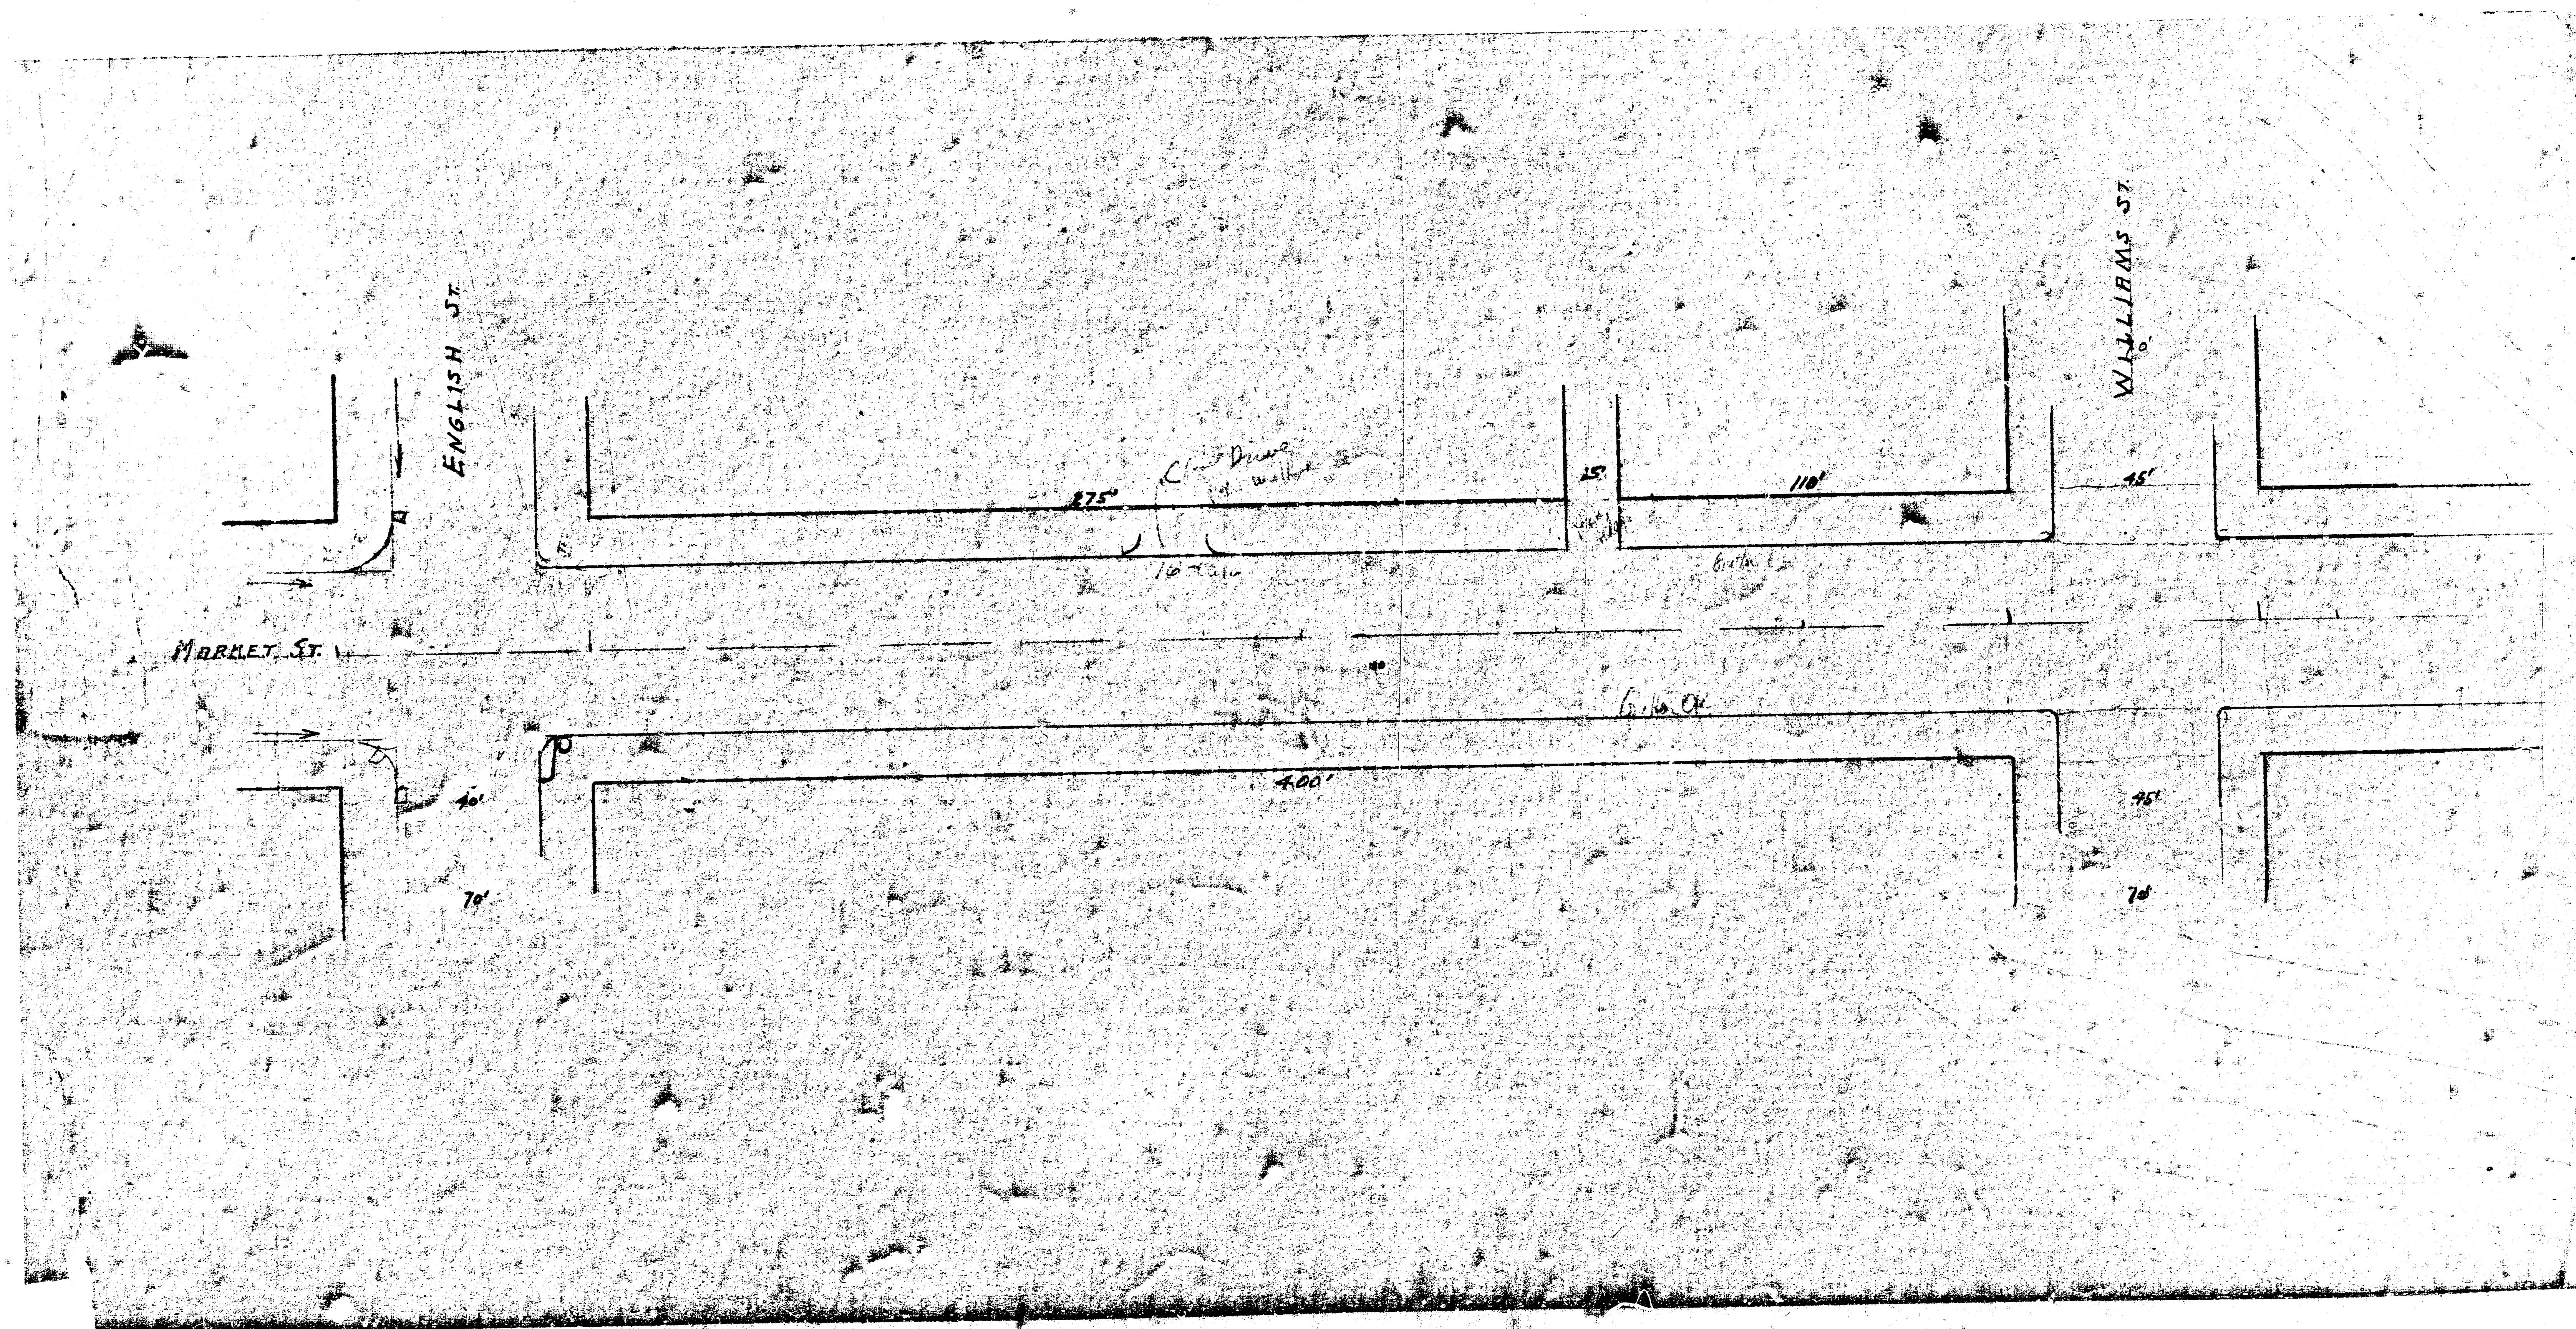

FIRST ST

Grade Road

80' x 6'

600' 600' New curb except 75' in front of Peckham house

Settling tank & oil separator removed to front of lot - replace

SECOND ST

New gutter removed Replace by 20' curb & lawn with

236

Eliminate raised crossing in Markers & eliminate old C.C.