

Market - S.E. Corner - S.E. English

New Section - Remains Hyperbolic

Point Curve of
Continuing Work

Market

New Section

Remains Hyperbolic

420

Remains
Hyperbolic

Elm
75

50

15' R

50

70

10' 11'
681

THIRD ST

CENTRAL AVE

600'

New gutter

Downspout removed

25'

45' 80'

Part Street curb

New gutter

downspout removed

Remove

curb

install new

downspout

downspout

70'

Take out

base

base

SECOND 54.

New letter remove old Stone letter

600

225 - Case 111111
10/1/11

Use G.R.

THIRD ST.

Received
by the
Attorney
General

Close Drive
North Hotel
Kensington
No. 100

New South

~~SECRET~~ *SECRET*

About half (100)

James Leonard Brown
and Sumner
Howard Brown.
Part 1.

WILLIAM

130'

36'

120'

DOUGLAS

Hard Rock

Hard Rock

8"

Crown Exposed
Boulder Layer
Pavement


150'


16'

120'

DOUGLAS

FIRST ST.

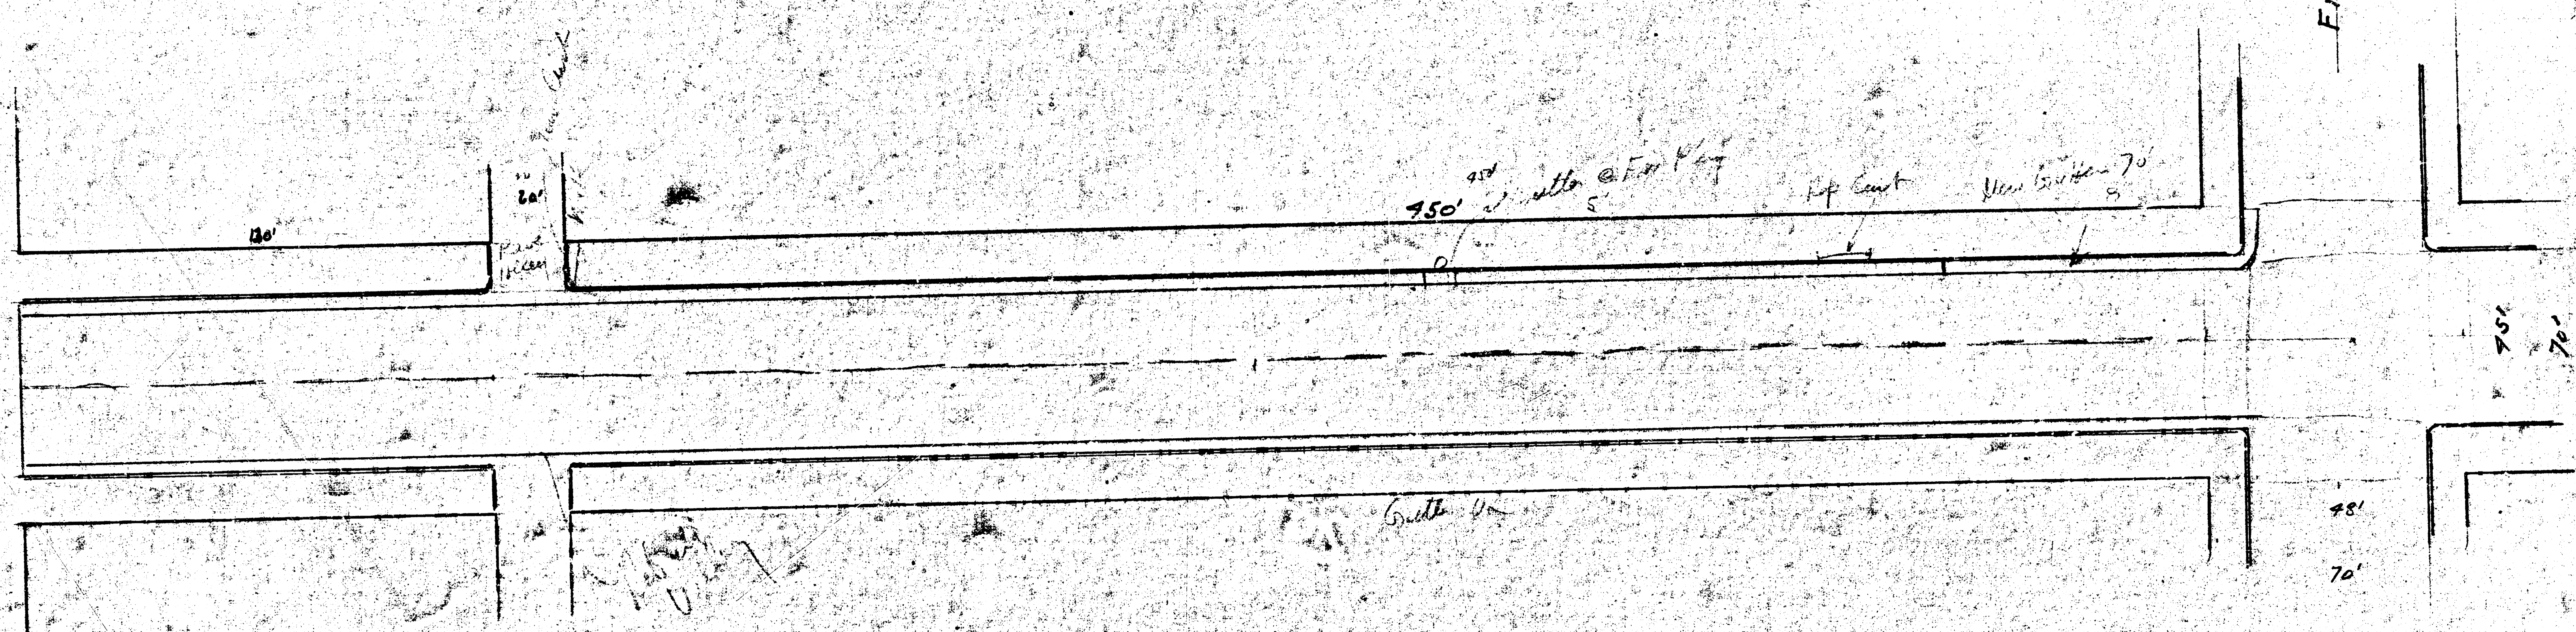

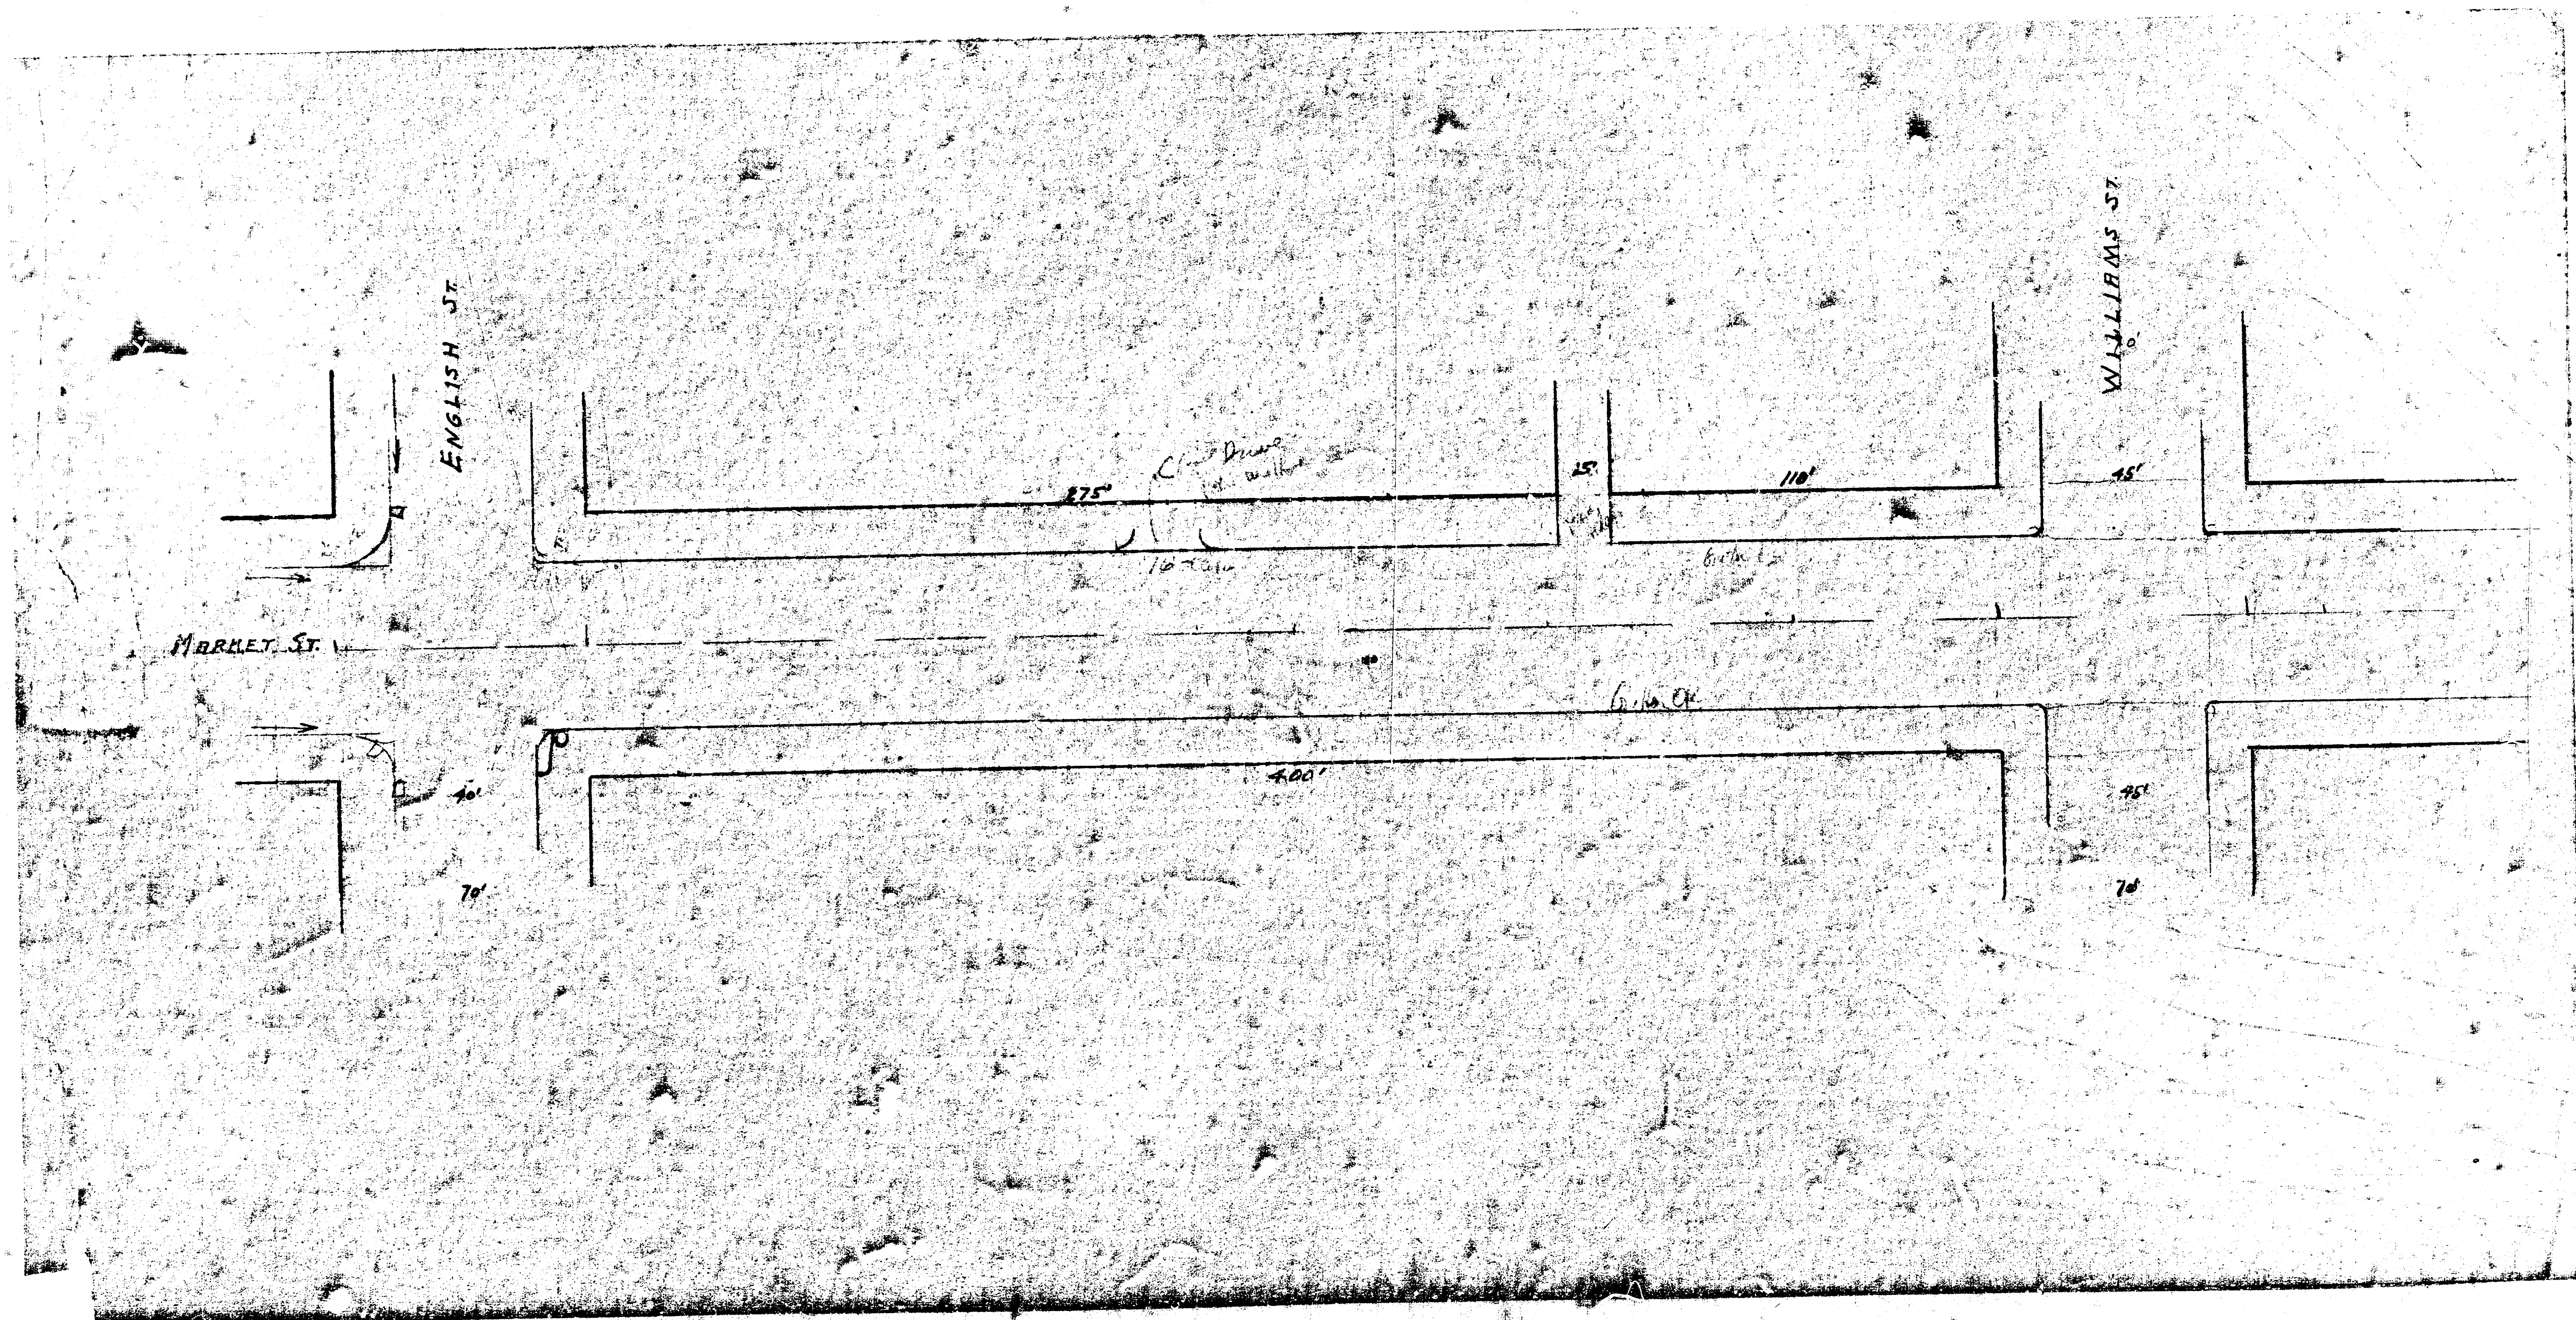

FIRST ST

Grade Road

80' x 6'

600' 600' New curb except 75' in front of Peckham house

Settling tank & oil separator removed to front of lot - replace

SECOND ST

New gutter removed Replace by 20' curb & lawn with

236

Eliminate raised crossing in Markers & eliminate old C.C.