



B.M. 109.92 S.E. COR. CONC. PDR. HQ #1657 NW. COR. MERTON & GORDON
BASE LINE ON E

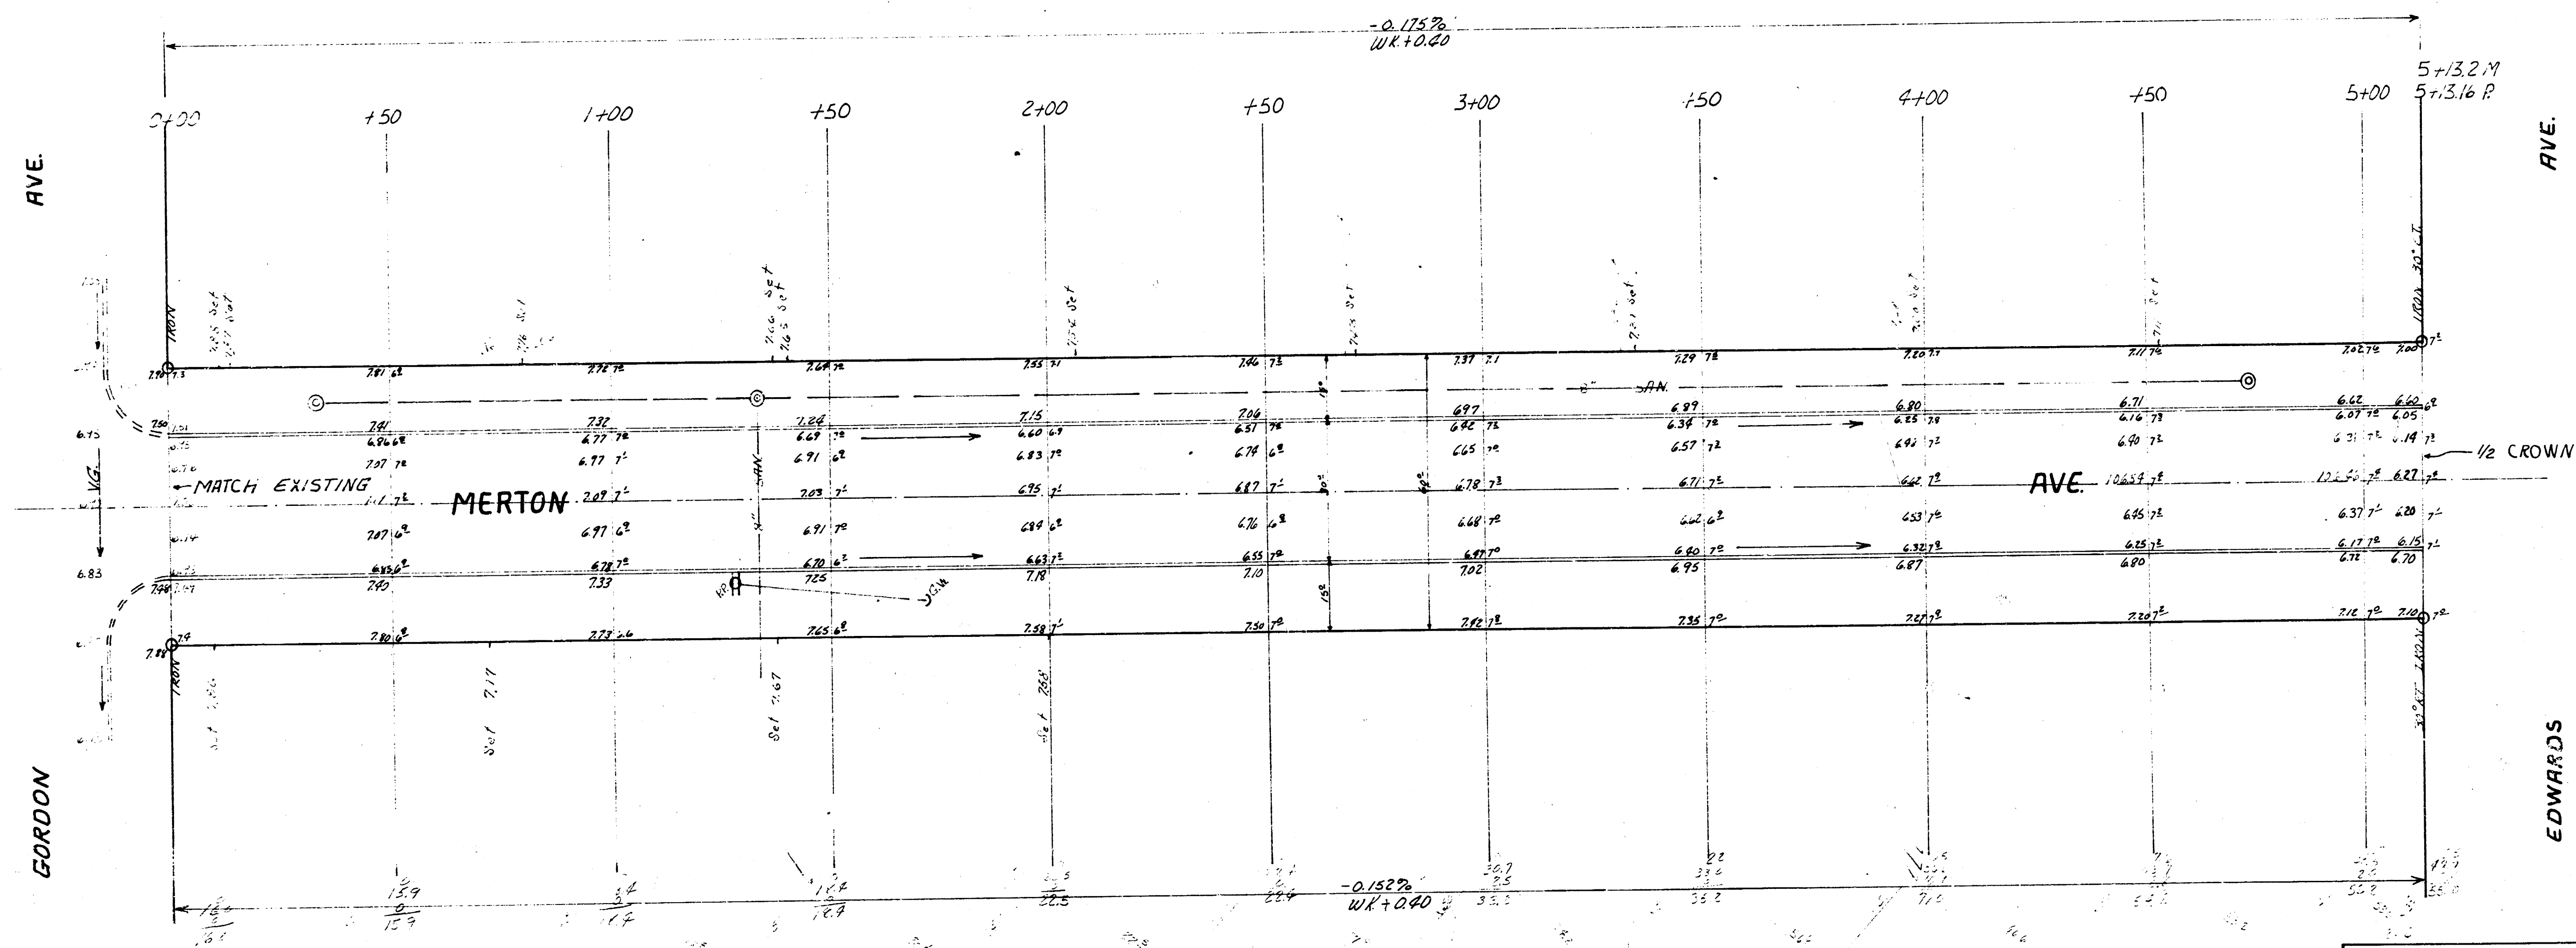

MERTON AVE.
E.L. GORDON W.L. EDWARDS
30' CONC. & CB.
CITY OF WICHITA, KANS.
B.E. SMITH CITY ENGINEER
DATE APRIL 1959 PROJ. NO. C-18-194

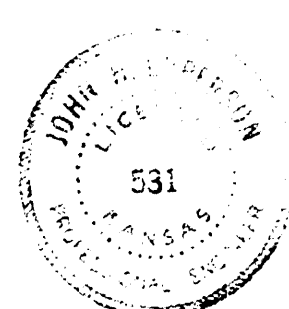

7' AL EXCAV.
PROP
S.D.
APR 1959
B.E.S.