



B.M. 16124 "T" IN TROY FIRE HYD. 30' W. OF WL. ELPYCO & N.E. KELLOGG

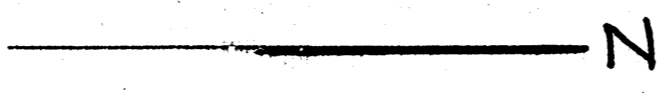

Note:
Make actual grade
at above curb grade
R.L.S.

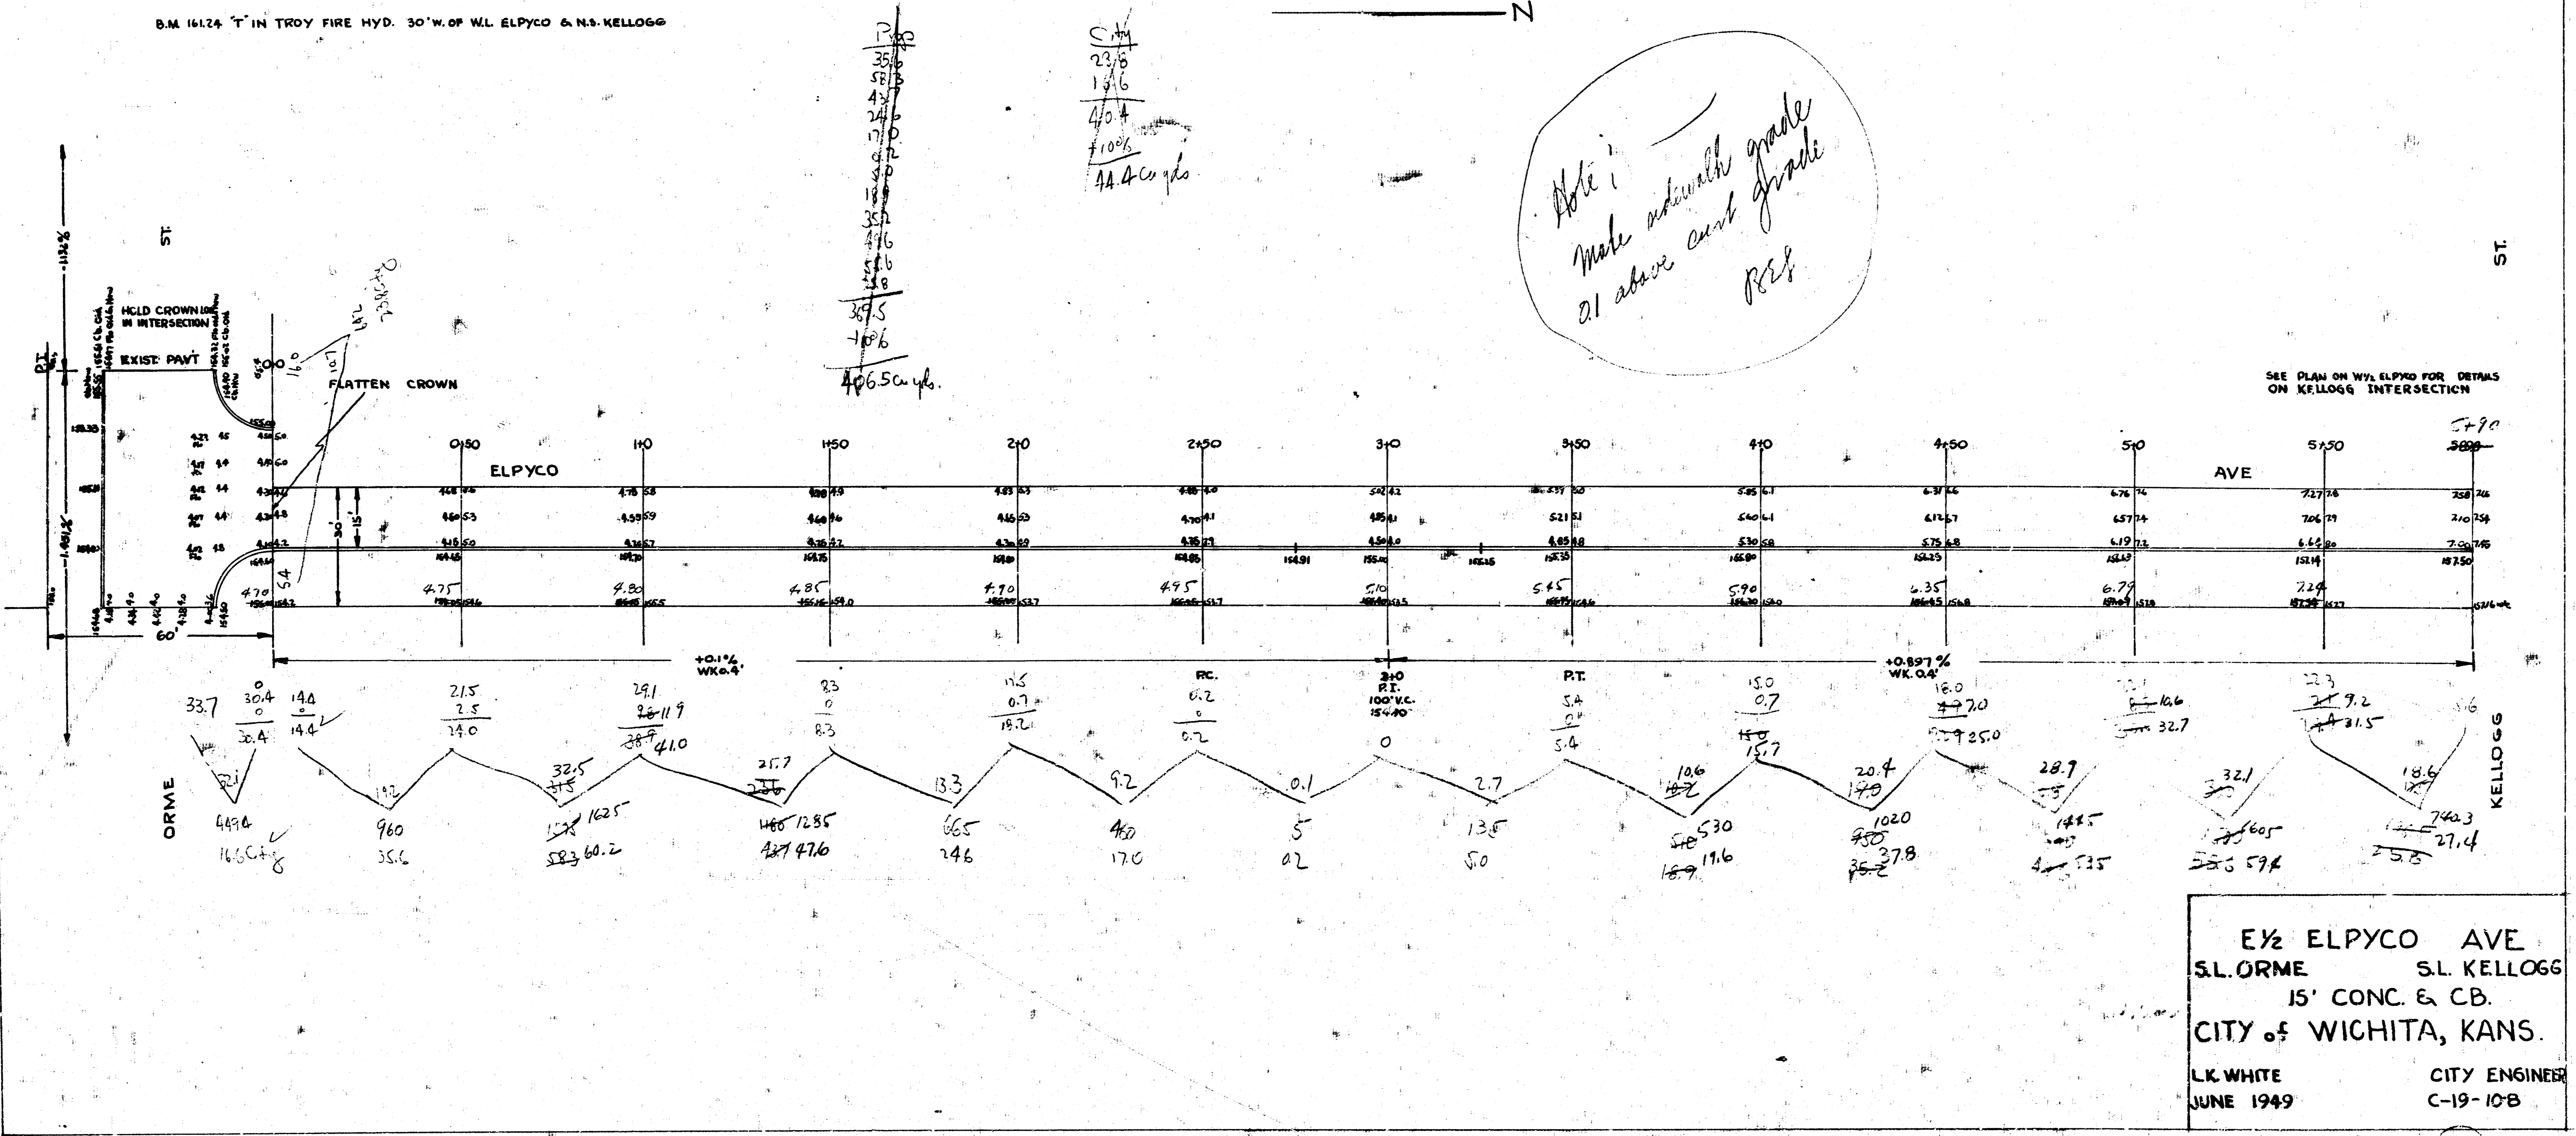

E 1/2 ELPYCO AVE
S.L. ORME S.L. KELLOGG
15' CONC. & CB.
CITY OF WICHITA, KANS.
L.K. WHITE CITY ENGINEER
JUNE 1949 C-19-10B

B.M. 16124 "T" in Troy fire plug 30' W. of W.L. Elpyco & N.S. Kellogg.

Prop.	City
46.5	2.2
60.7	1.0
46.9	
28.3	24.0
14.0	
8.1	
1.5	
6.9	
30.7	
91.1	
49.1	
60.7	
31.8	
128.7	
+107.6	
711.8	64 yds.

