
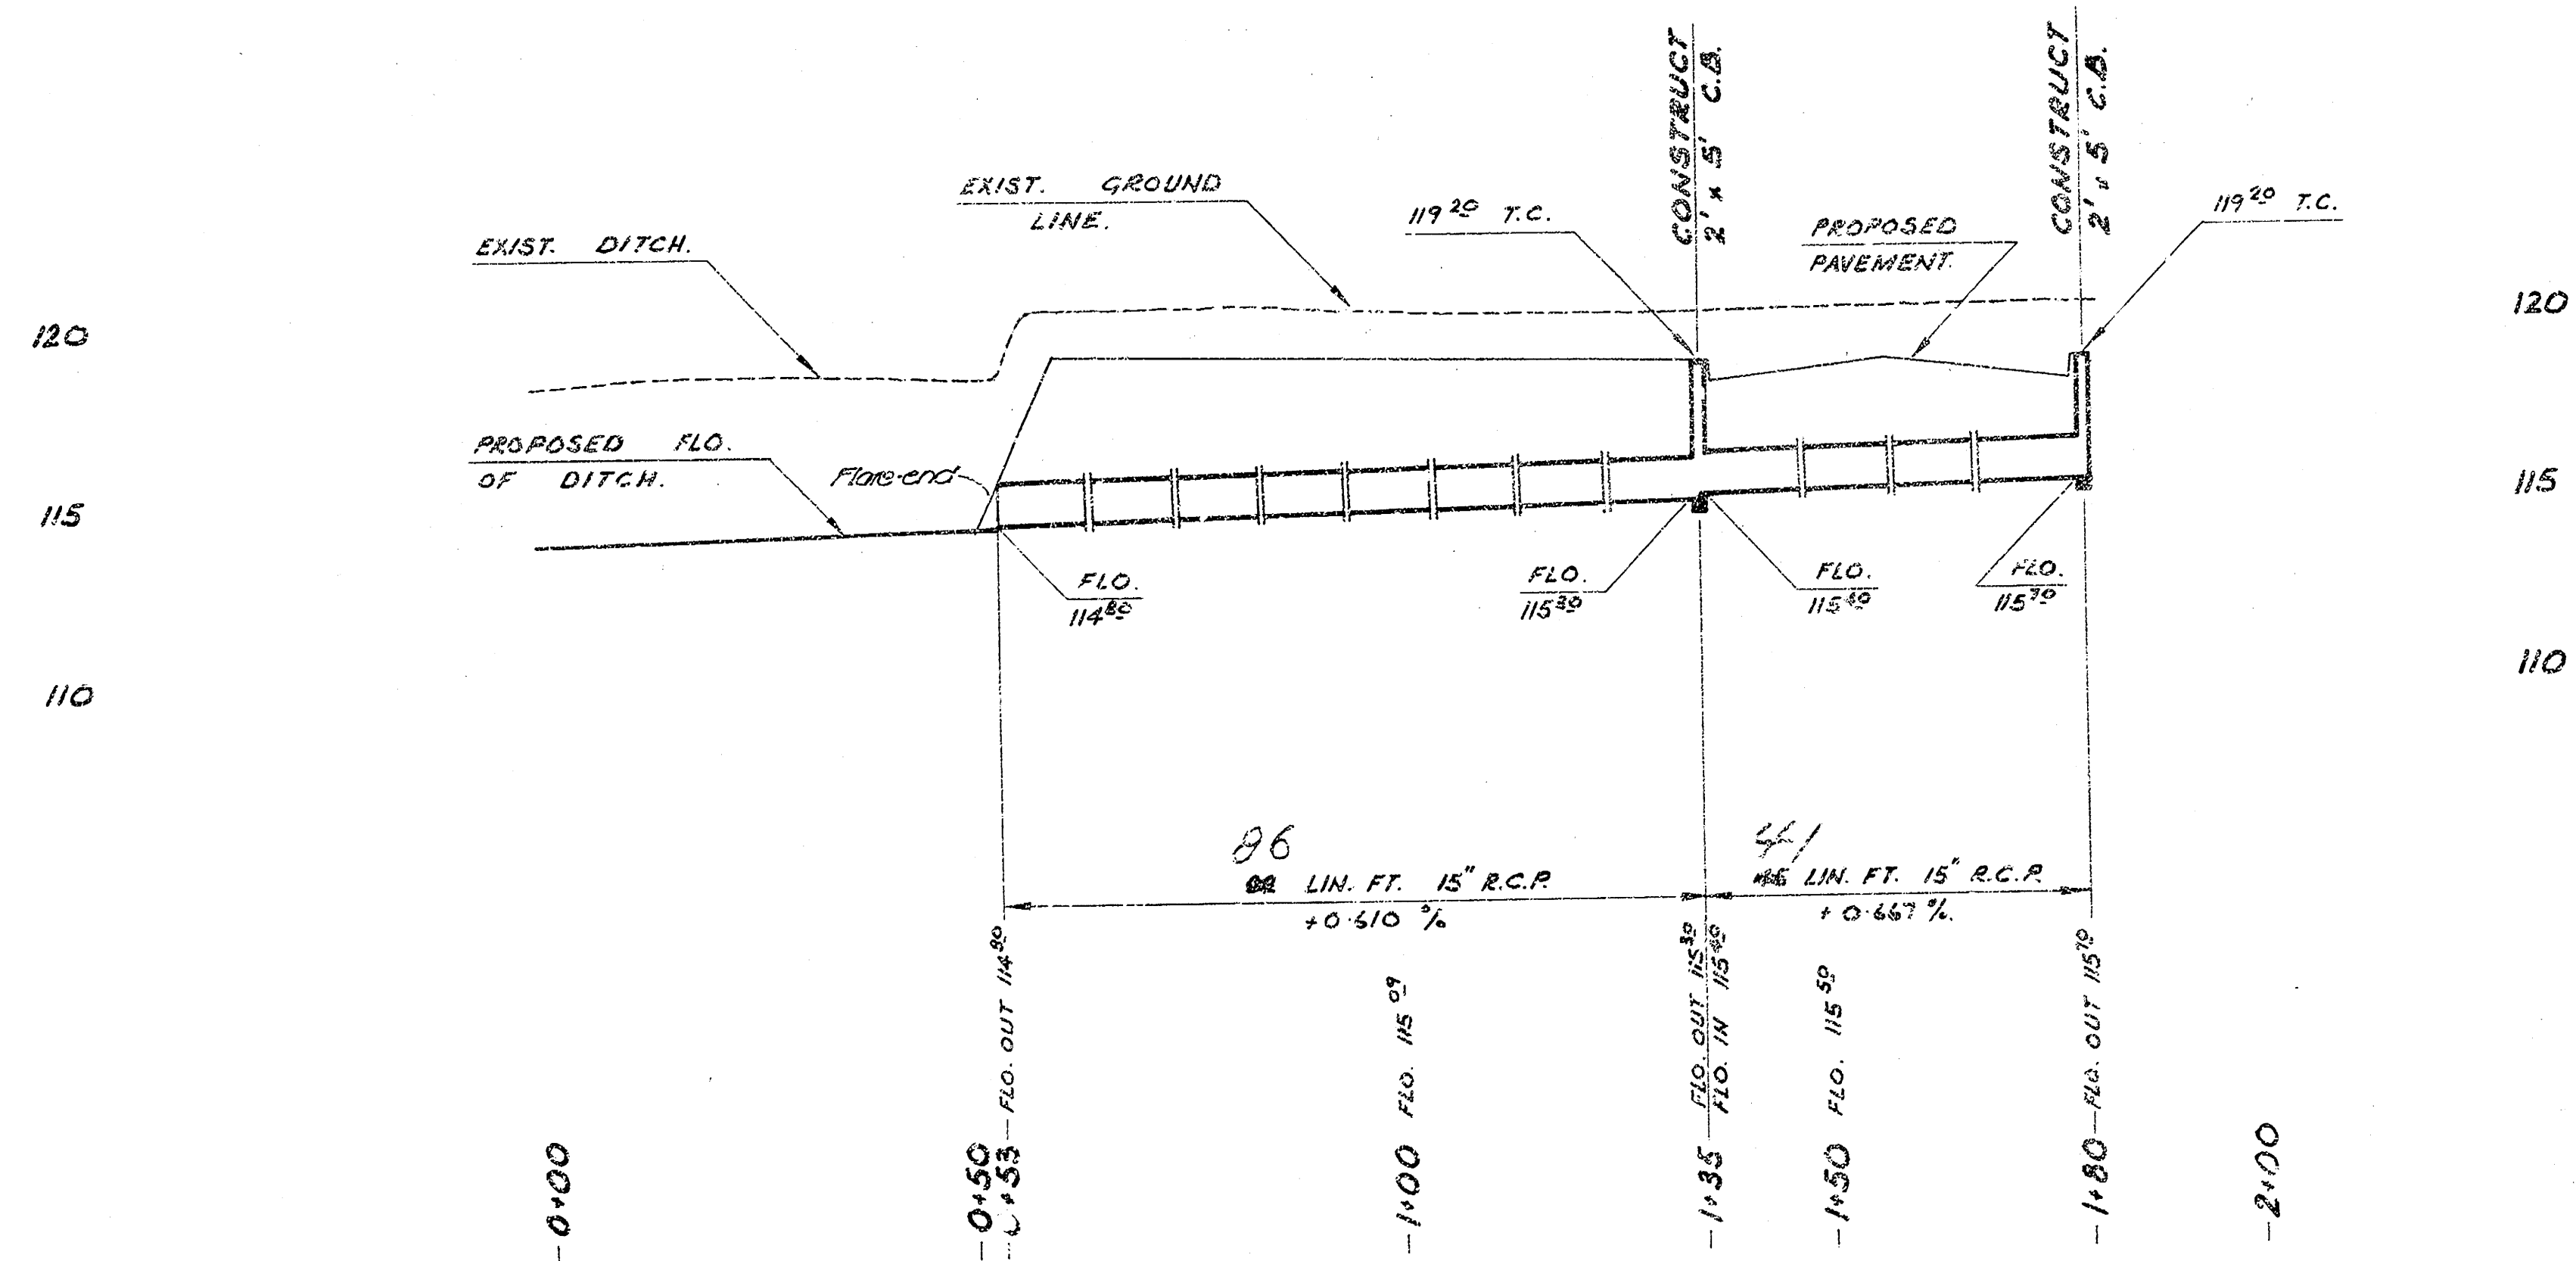


SCALES.
PLAN. 1" = 20'
PROFILE 1" = 20'
HORIZ. 1" = 20'
VERT. 1" = 5'

B.M. 120.60 - R.R. SPIKE EAST
FACE POWER POLE S.W.
COR. DUGAN & IRVING.

D.L. KRUG, C.E.
J. BOYD WILFIELD, S.D.

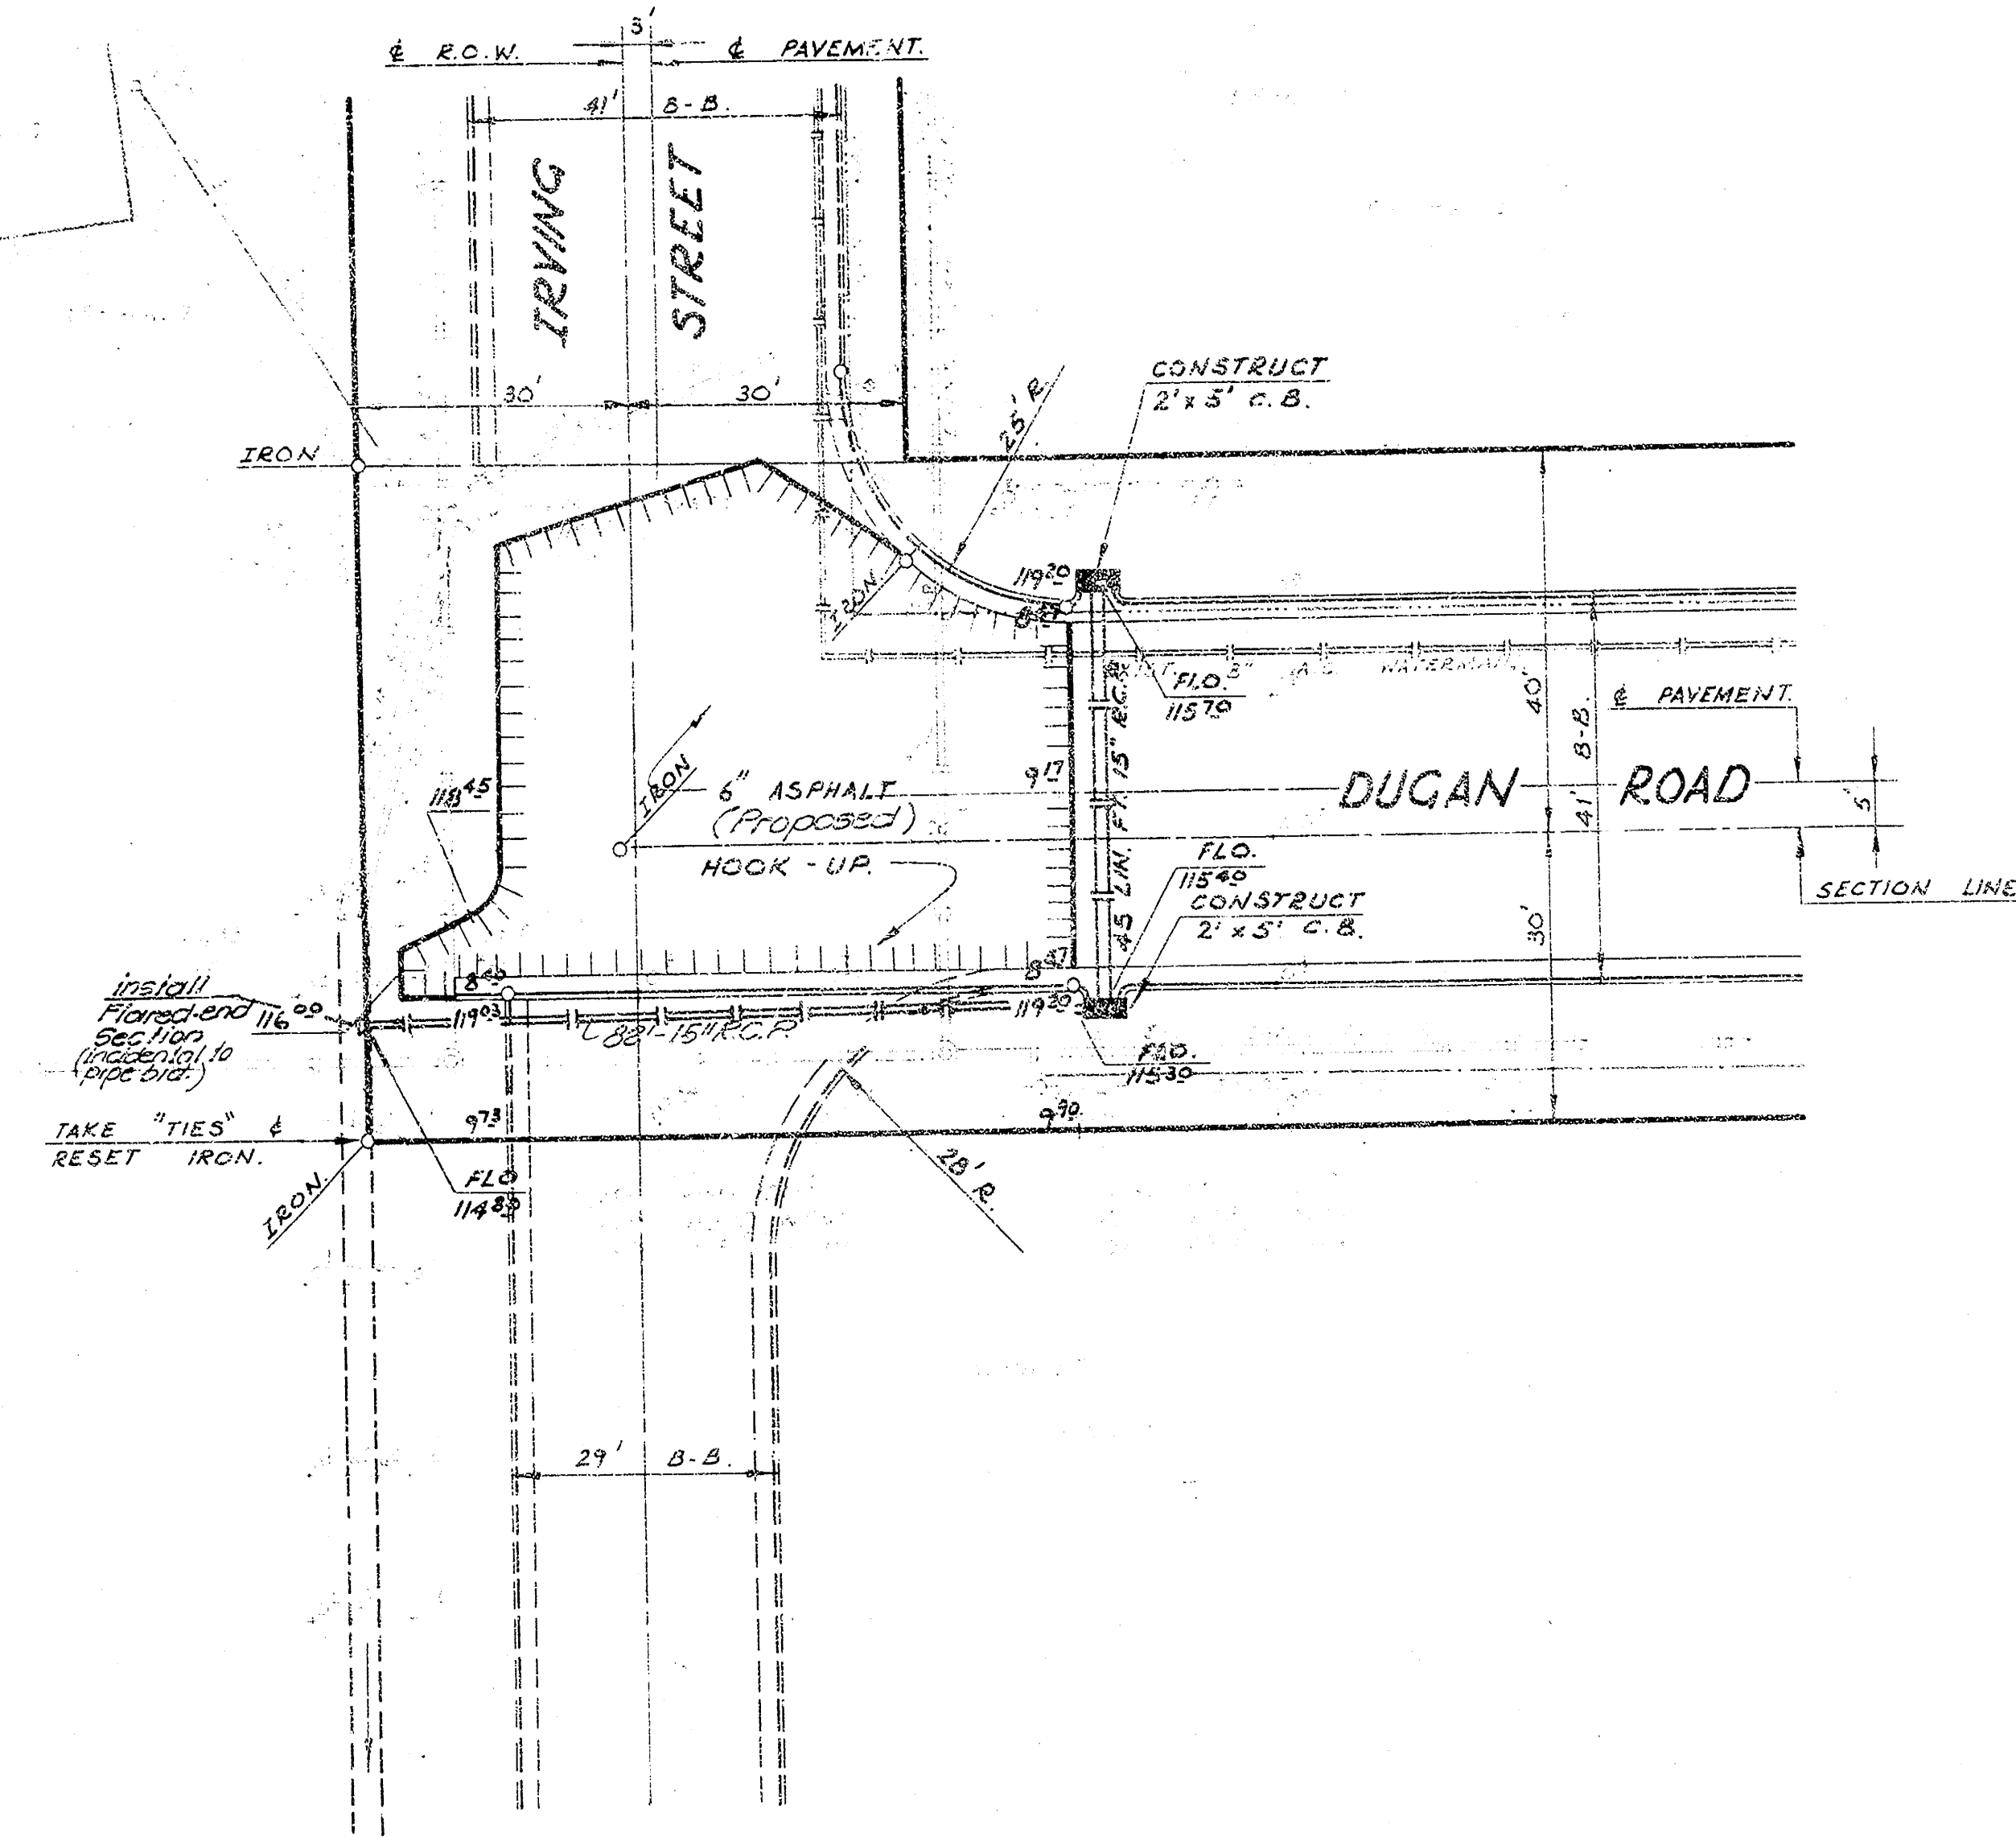


As Built 4-8-76

"DRAINAGE" IN CONNECTION WITH PAVING OF	
DUGAN RD. FROM S.L. IRVING TO S.L. KELLOGG.	
CITY OF WICHITA, KANSAS.	
R. W. LINN.	CITY ENGINEER.
DATE.	PROJ. NO. DAKO 574131.

PLAN
 D.L. KRUG,
 J. BUTTERFIELD & SONS
 NOTE BOOK NO. 146

B.M. = 120.60 - R.R. SPIKE EAST
 FACE POWER POLE S.W.
 COR. DUGAN & IRVING.

SCALES.
 PLAN 1" = 20'
 PROFILE 1" = 20'
 HORIZ. 1" = 20'
 VERT. 1" = 5'

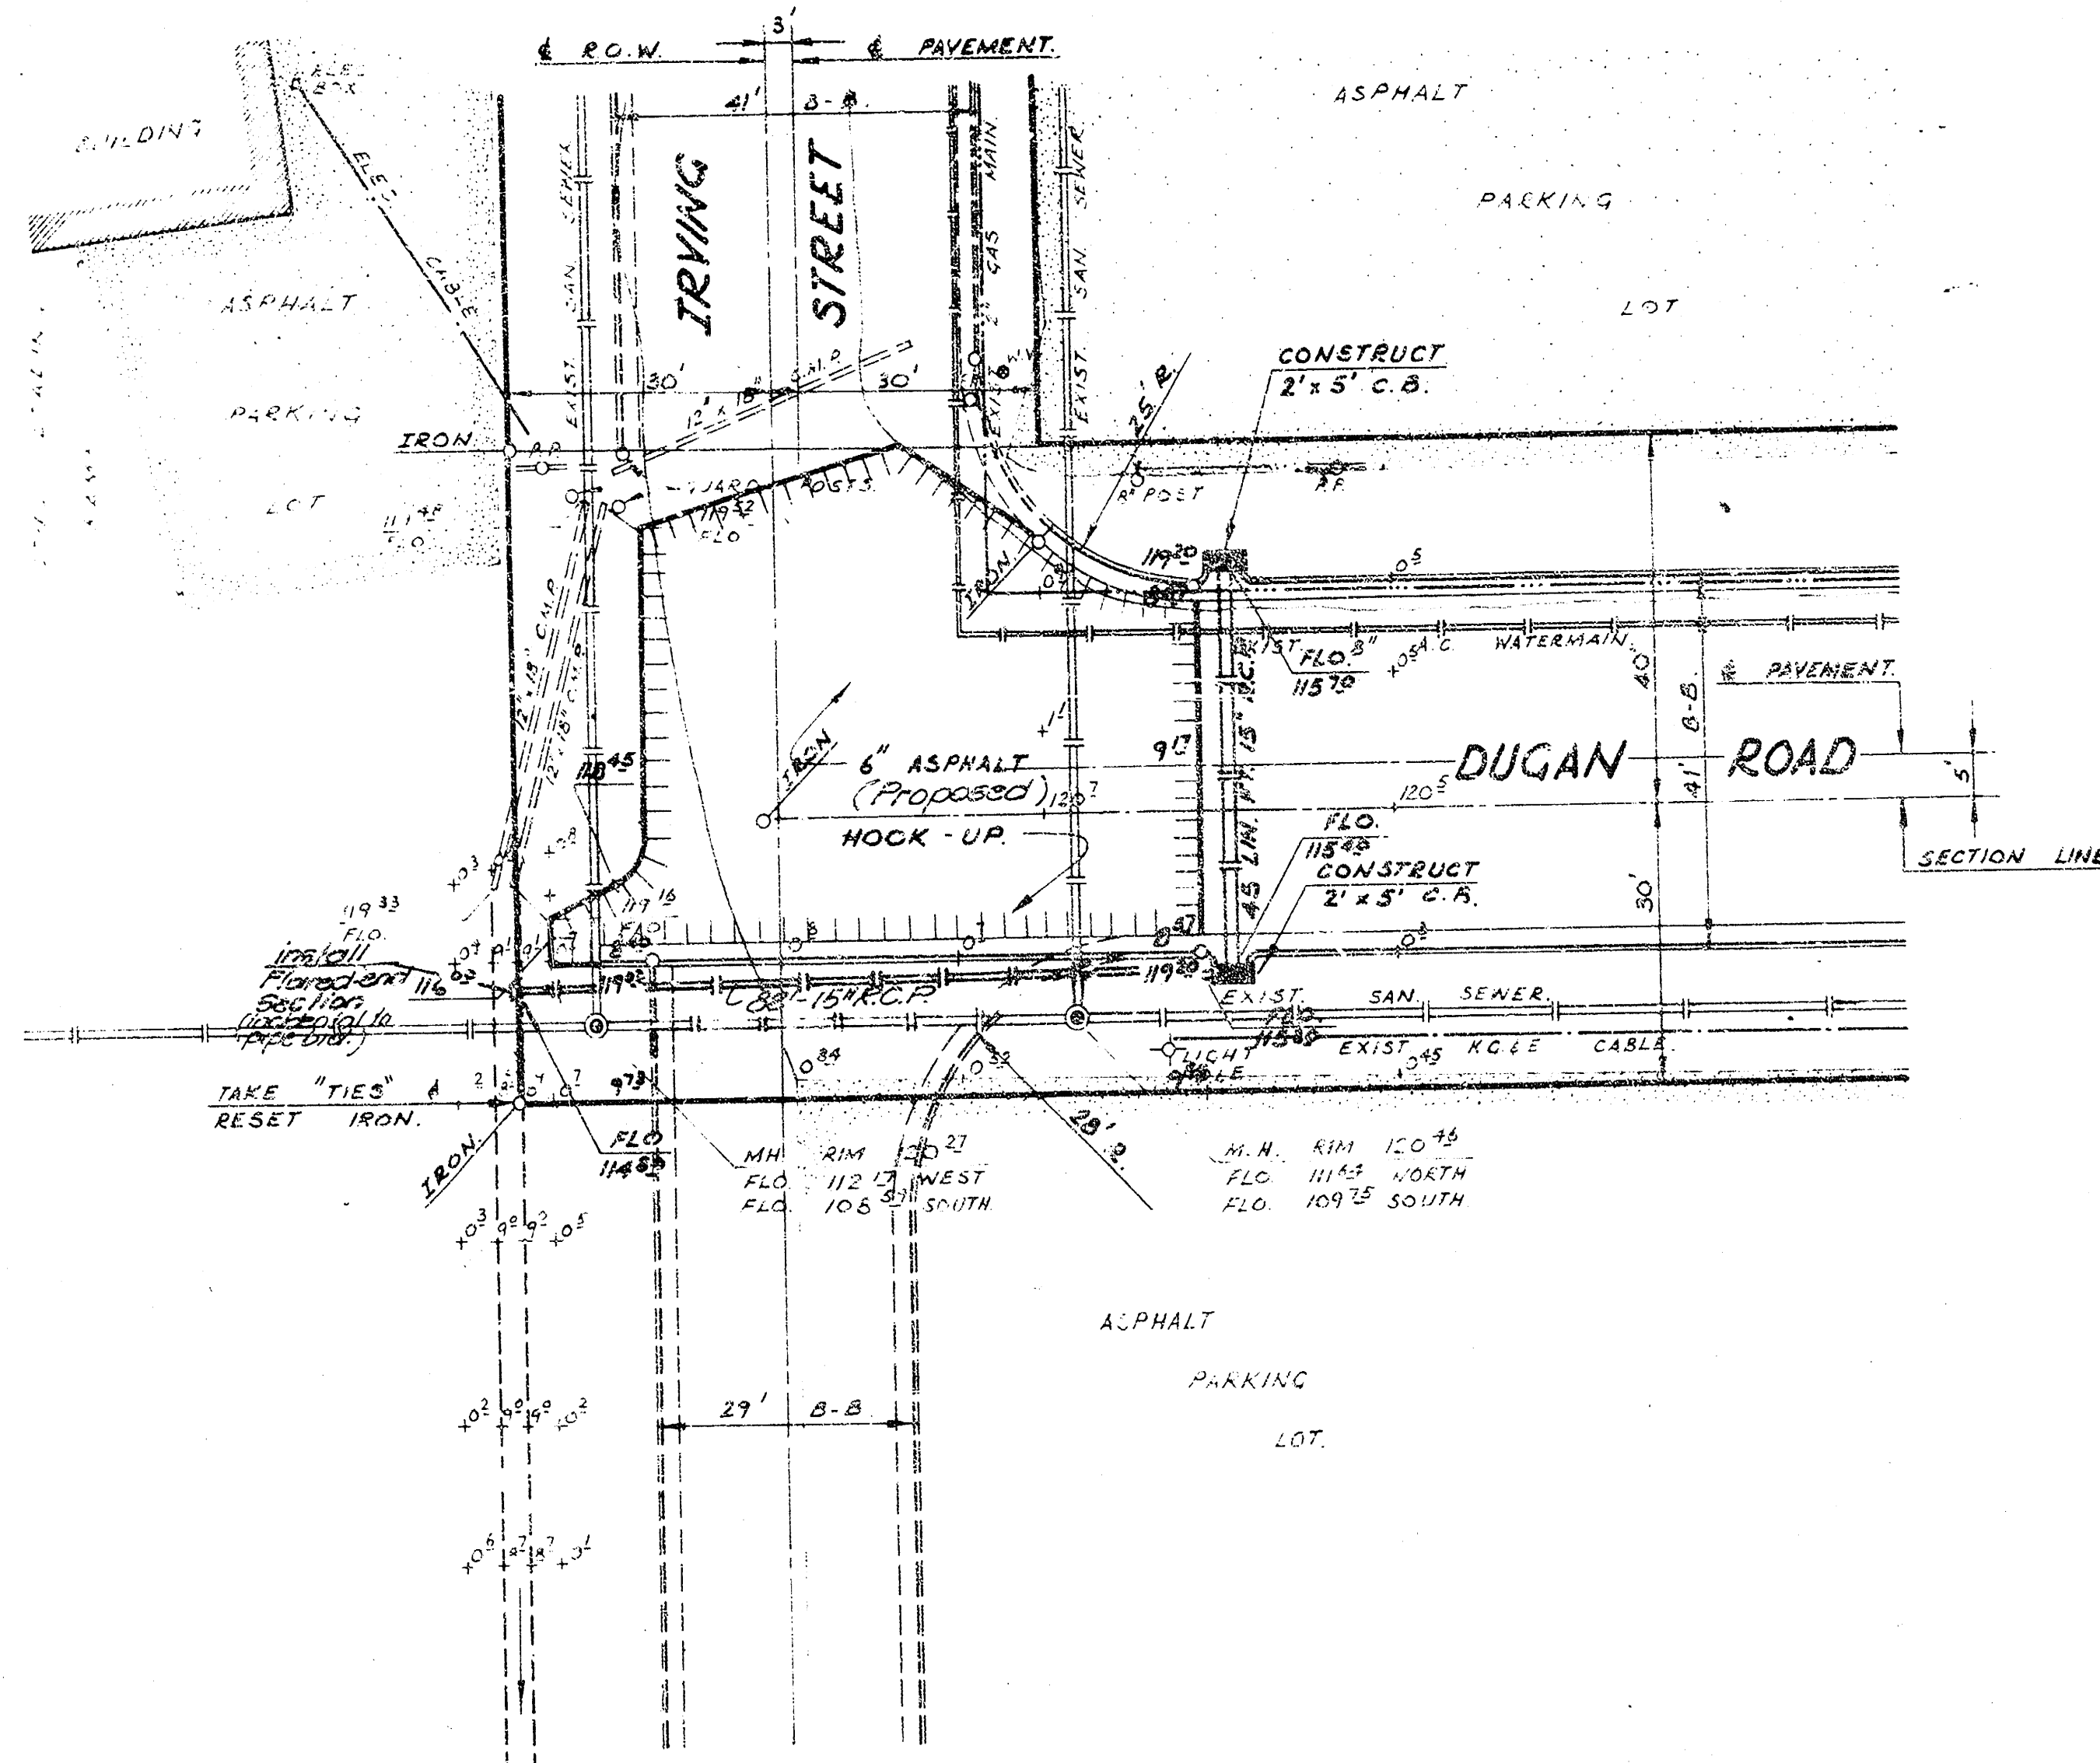

PROFILE
 D.L. KRUG,
 J. BUTTERFIELD & SONS
 NOTE BOOK NO. 146

