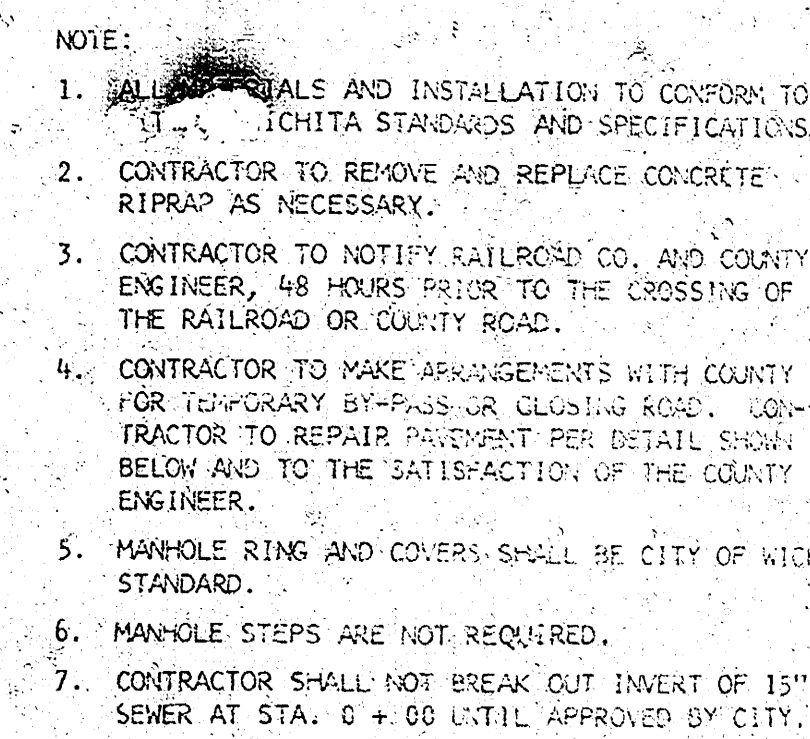


TENANT SANITARY SEWER PLAN SHEET TITLE	
TENANT NUMBER	SHEET NUMBER SU 2 OF _____ SHEETS

AS BUILT 3-1-72
BANKED 3-3-72
© I-45 BY W.D.U.

SHEET TITLE	
TENANT NUMBER	SHEET NUMBER
	1
OF _____ SHEETS	