

1987 ARTERIAL SIDEWALK

PROJ. NO. 472-76-245-81693000-000-001

CITY OF WICHITA, KANSAS
M. E. LINDEBAK - CITY ENGINEER

LOCATIONS

BASE

CONTRACT

SIDEWALK Where Missing on the NORTH SIDE of PAWNEE AVENUE Between ROCK ROAD and Proposed School Crossing on PAWNEE 170th Southeasterly of Southerly Line of CHERRY CREEK DRIVE.

SIDEWALK on the SOUTH SIDE of PAWNEE Between Existing Driveway 130th Southeasterly of Southerly Line of CHERRY CREEK DRIVE and Proposed School Crossing on PAWNEE 170th Southeasterly of Southerly Line of CHERRY CREEK DR.

CROSSWALK and WHEELCHAIR RAMPS for Proposed School Crosswalk on PAWNEE Located 170th Southeasterly of Southerly Line of CHEERY CREEK DR.

WEST SIDE of ROCK ROAD. North of 13TH ST. To Existing Walk.

NORTH SIDE 13TH ST. West of ROCK RD. To Existing Walk.

EAST SIDE of HYDRAULIC AVE. Between LINCOLN and WATERMAN (Where Missing).

WEST SIDE of RIDGE ROAD. Between 12TH and 13TH STREET.

EAST SIDE of RIDGE ROAD. Between 12TH and 13TH STREET.

ADD ALTERNATE No. 1

WEST SIDE WACO AVE. From 3rd Street To Central Ave.

ADD ALTERNATE No. 2

SOUTH SIDE HARRY STREET. From Oliver St To Elpyco St.

NOTE: NO ADD ALTERNATE IS TO BE CONSTRUCTED WITHOUT WRITTEN APPROVAL OF THE CITY ENGINEER.

• GENERAL NOTES •

1. INFORMATION SHOWN ON PLANS NOT DIRECTLY RELATED TO THE CONSTRUCTION OF SIDEWALKS & WHEELCHAIR RAMPS IS NOT A PART OF THIS CONTRACT AND SHALL BE CONSIDERED AS DELETED.


2. EXACT LOCATION AND GRADE TO BE DETERMINED BY THE FIELD ENGINEER AT TIME OF CONSTRUCTION.

3. ALL EARTHWORK AND SUBGRADE COMPACTION NECESSARY TO COMPLETE THIS PROJECT IS TO BE SUBSIDIARY TO OTHER BID ITEMS.

4. ALL AREAS DISTURBED BY THE CONTRACTOR SHALL BE RESTORED TO A CONDITION ACCEPTABLE TO THE ENGINEER. THIS WORK SHALL BE SUBSIDIARY TO OTHER BID ITEMS.


• INDEX OF SHEETS • SHEET NO. DESCRIPTION

1. _____ COVER SHEET
2. _____ LOCATION MAP
3. _____ WHEELCHAIR RAMP DETAILS
4. _____ PLAN, PAWNEE AVE

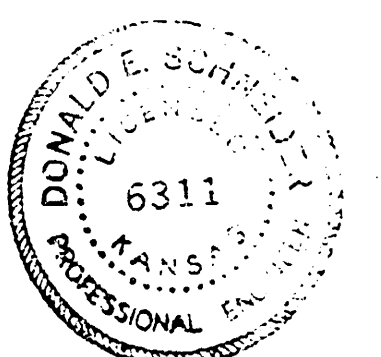


THE COST OF ALL WORK INDICATED ON THIS SHEET, SHALL BE INCLUDED IN THE UNIT PRICE BID FOR WHEEL CHAIR RAMP WHICH PRICE SHALL INCLUDE ALL COSTS OF REMOVING AND RECONSTRUCTING EXISTING COMBINED CURB AND GUTTER, MONOLITHIC CURB, PAVEMENT, COMPACTION OF SUBGRADE AND/OR NECESSARY AREA GRADING.


STANDARD WHEELCHAIR RAMP CONSTRUCTION DETAIL FOR STREETS WITH COMBINED CURB & GUTTER AND FULL WALK

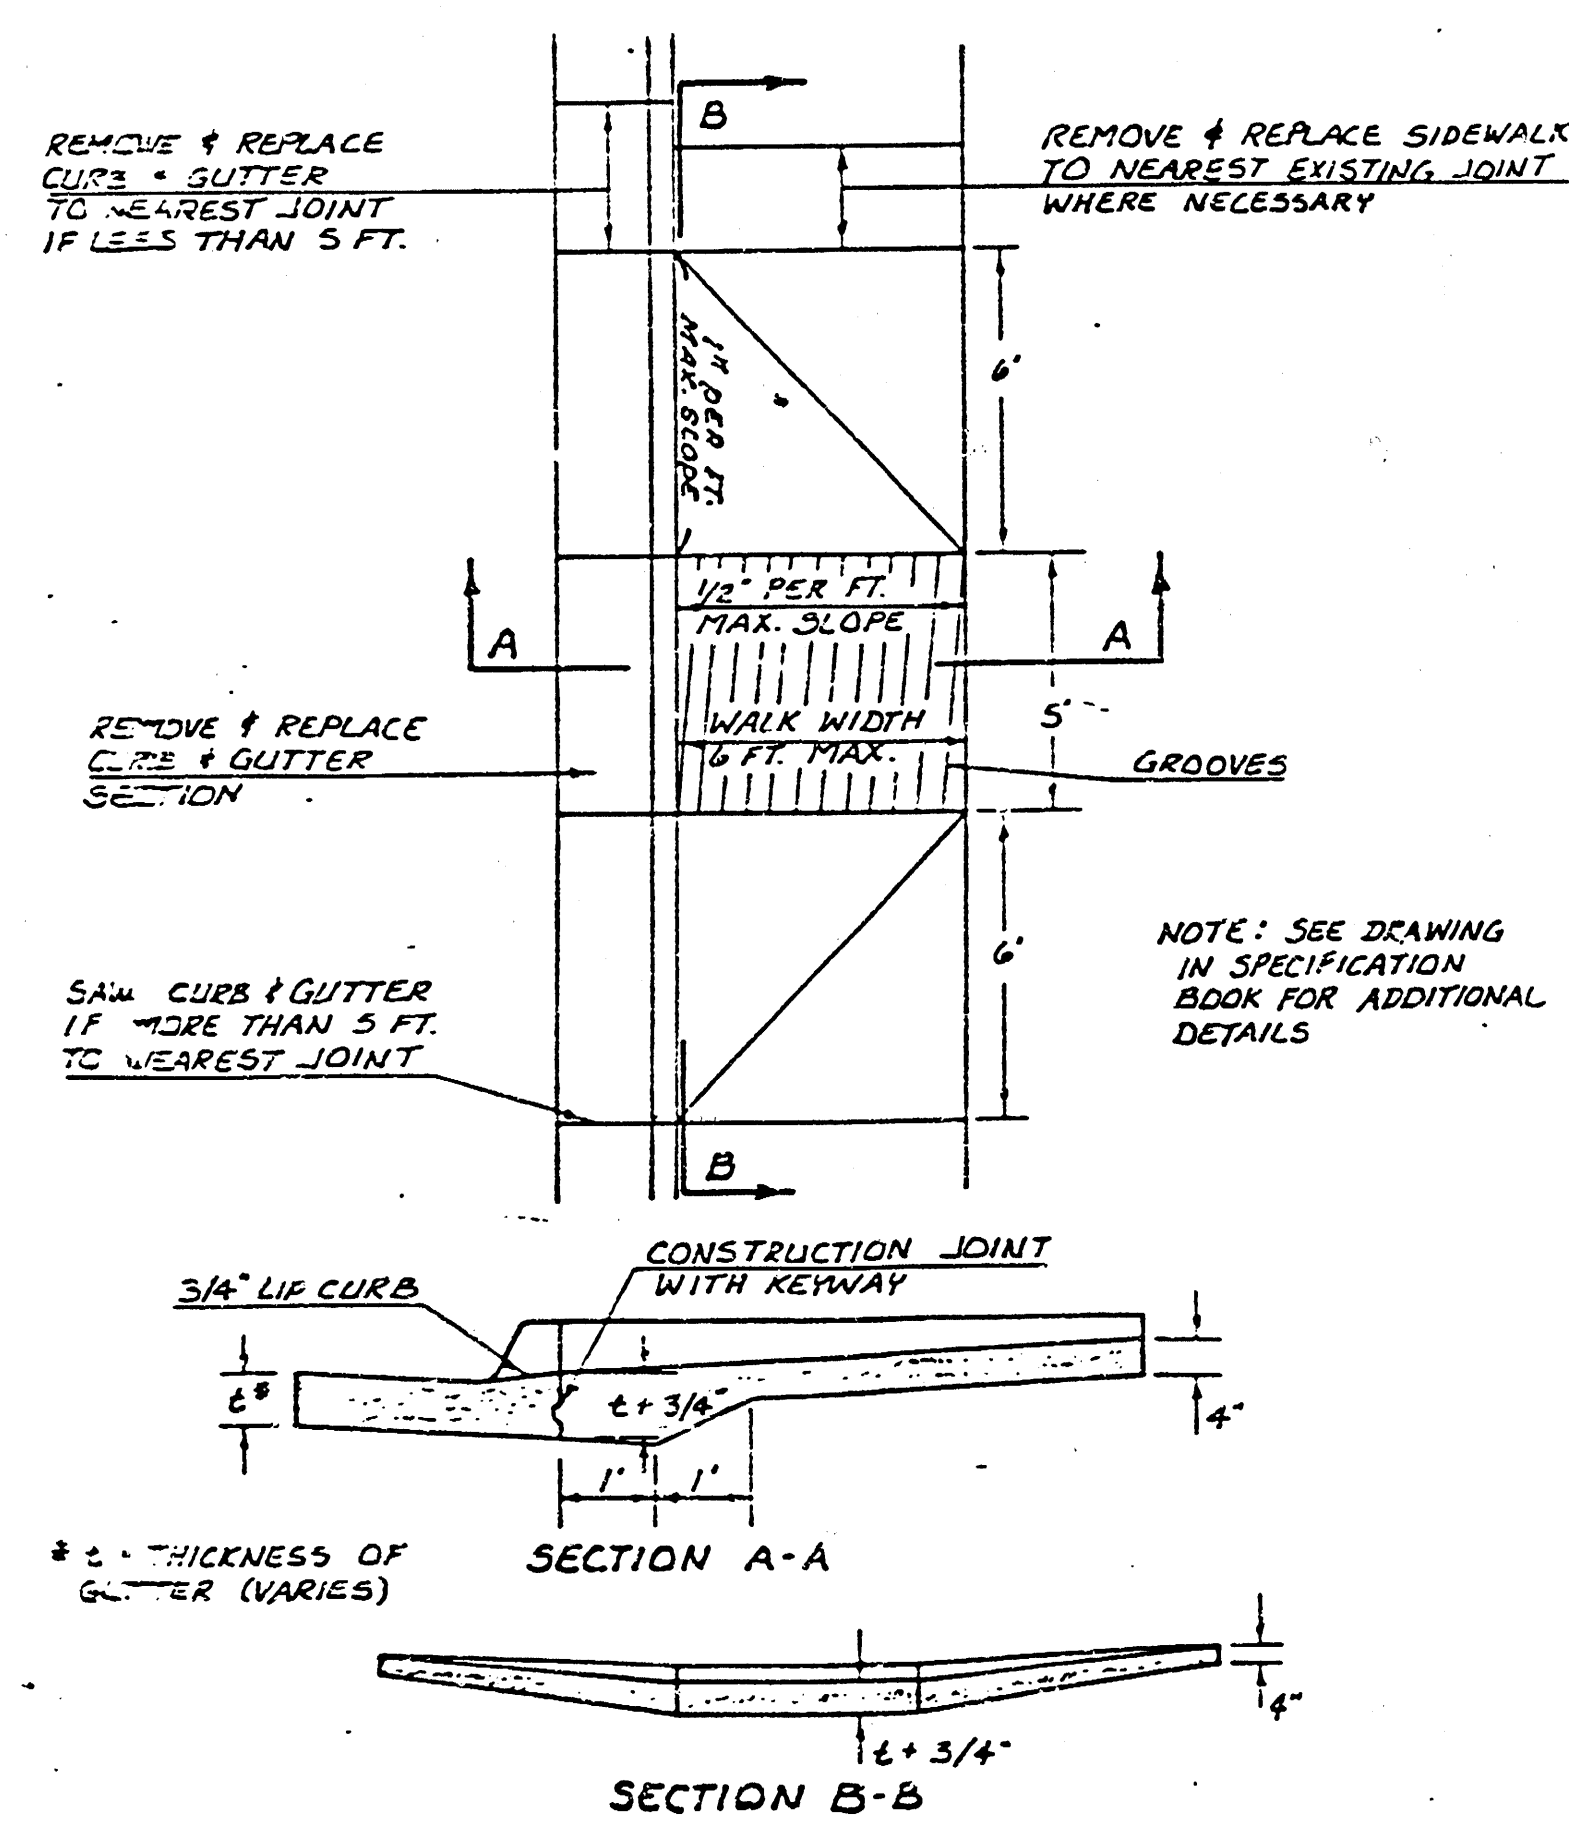


STANDARD WHEELCHAIR RAMP CONSTRUCTION DETAIL FOR CONCRETE STREETS WITH MONOLITHIC CURB

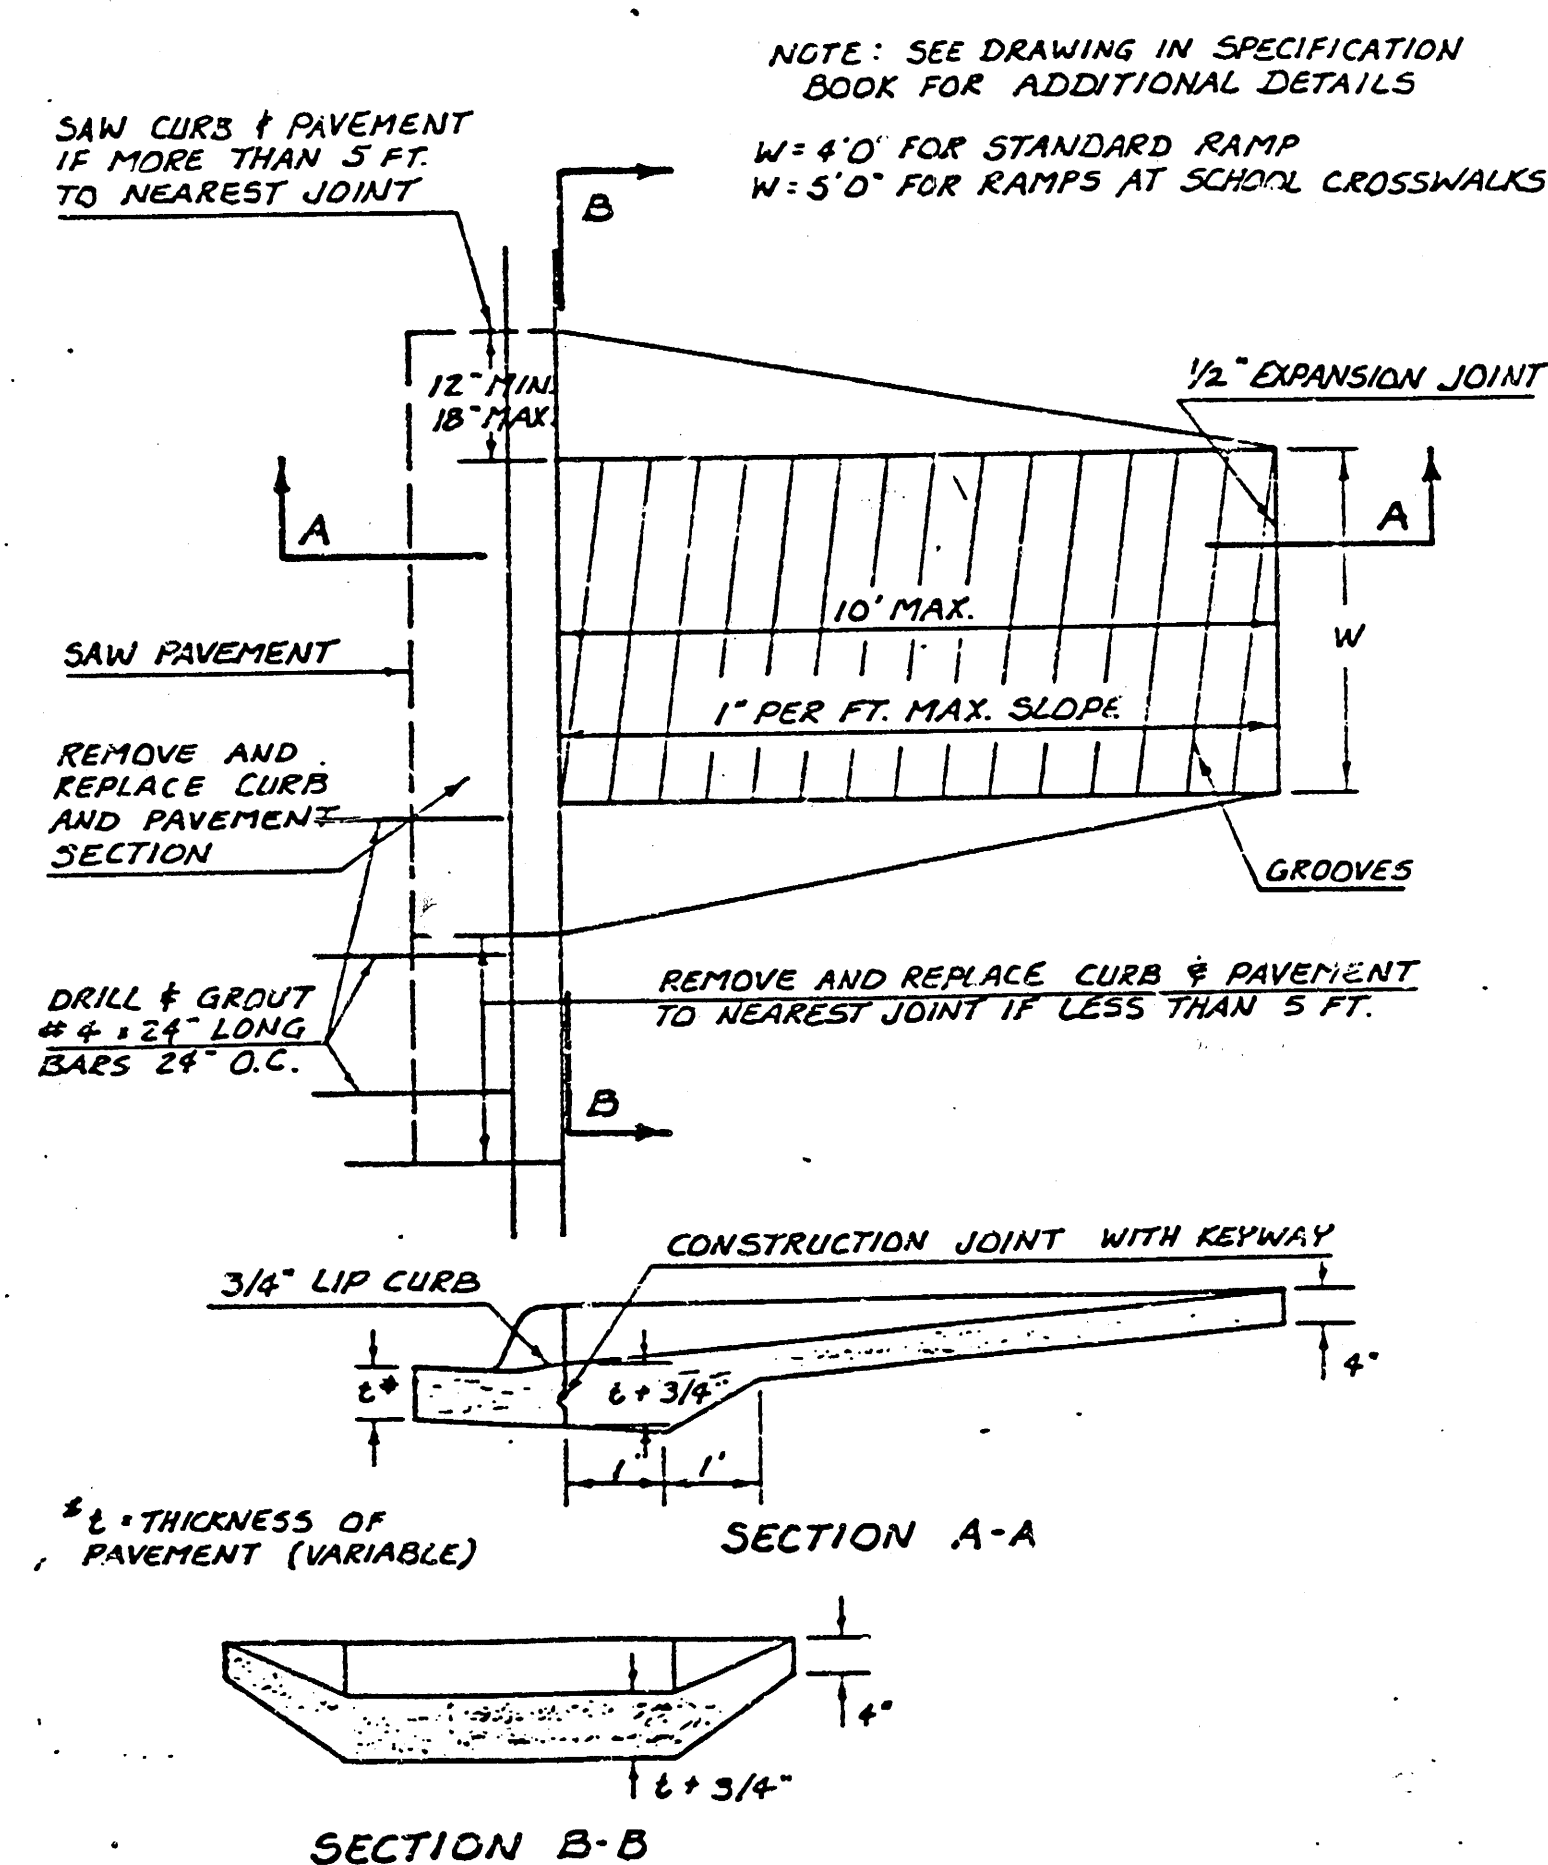


STANDARD WHEELCHAIR RAMP CONSTRUCTION DETAIL FOR CONCRETE STREETS WITH MONOLITHIC CURB AND FULL WALK

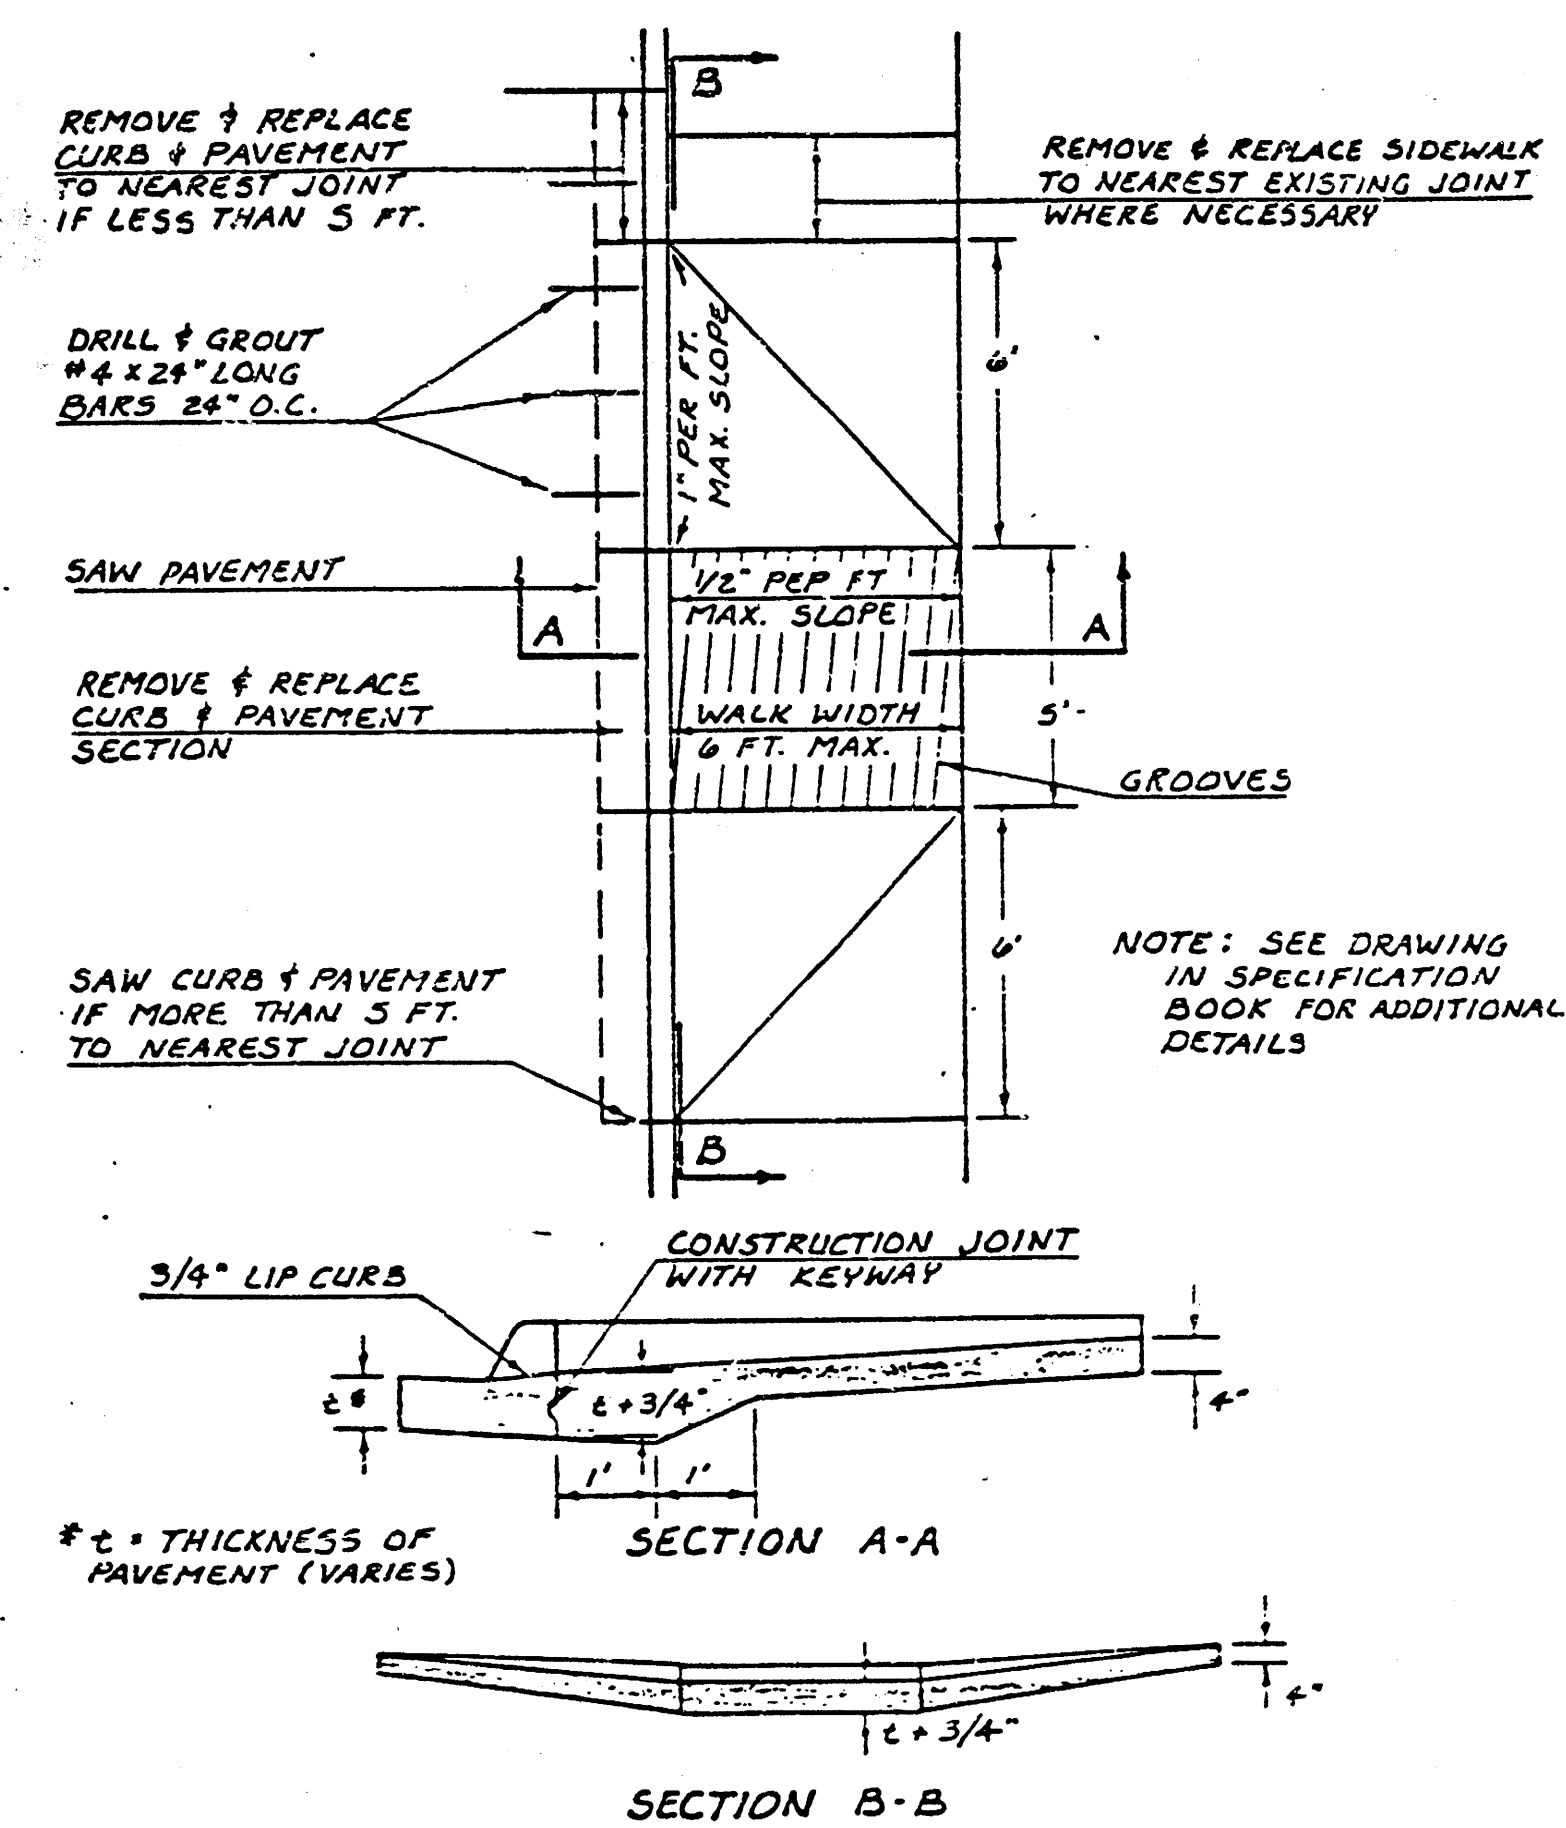


STANDARD WHEELCHAIR RAMP CONSTRUCTION DETAIL FOR STREETS WITH COMBINED CURB & GUTTER

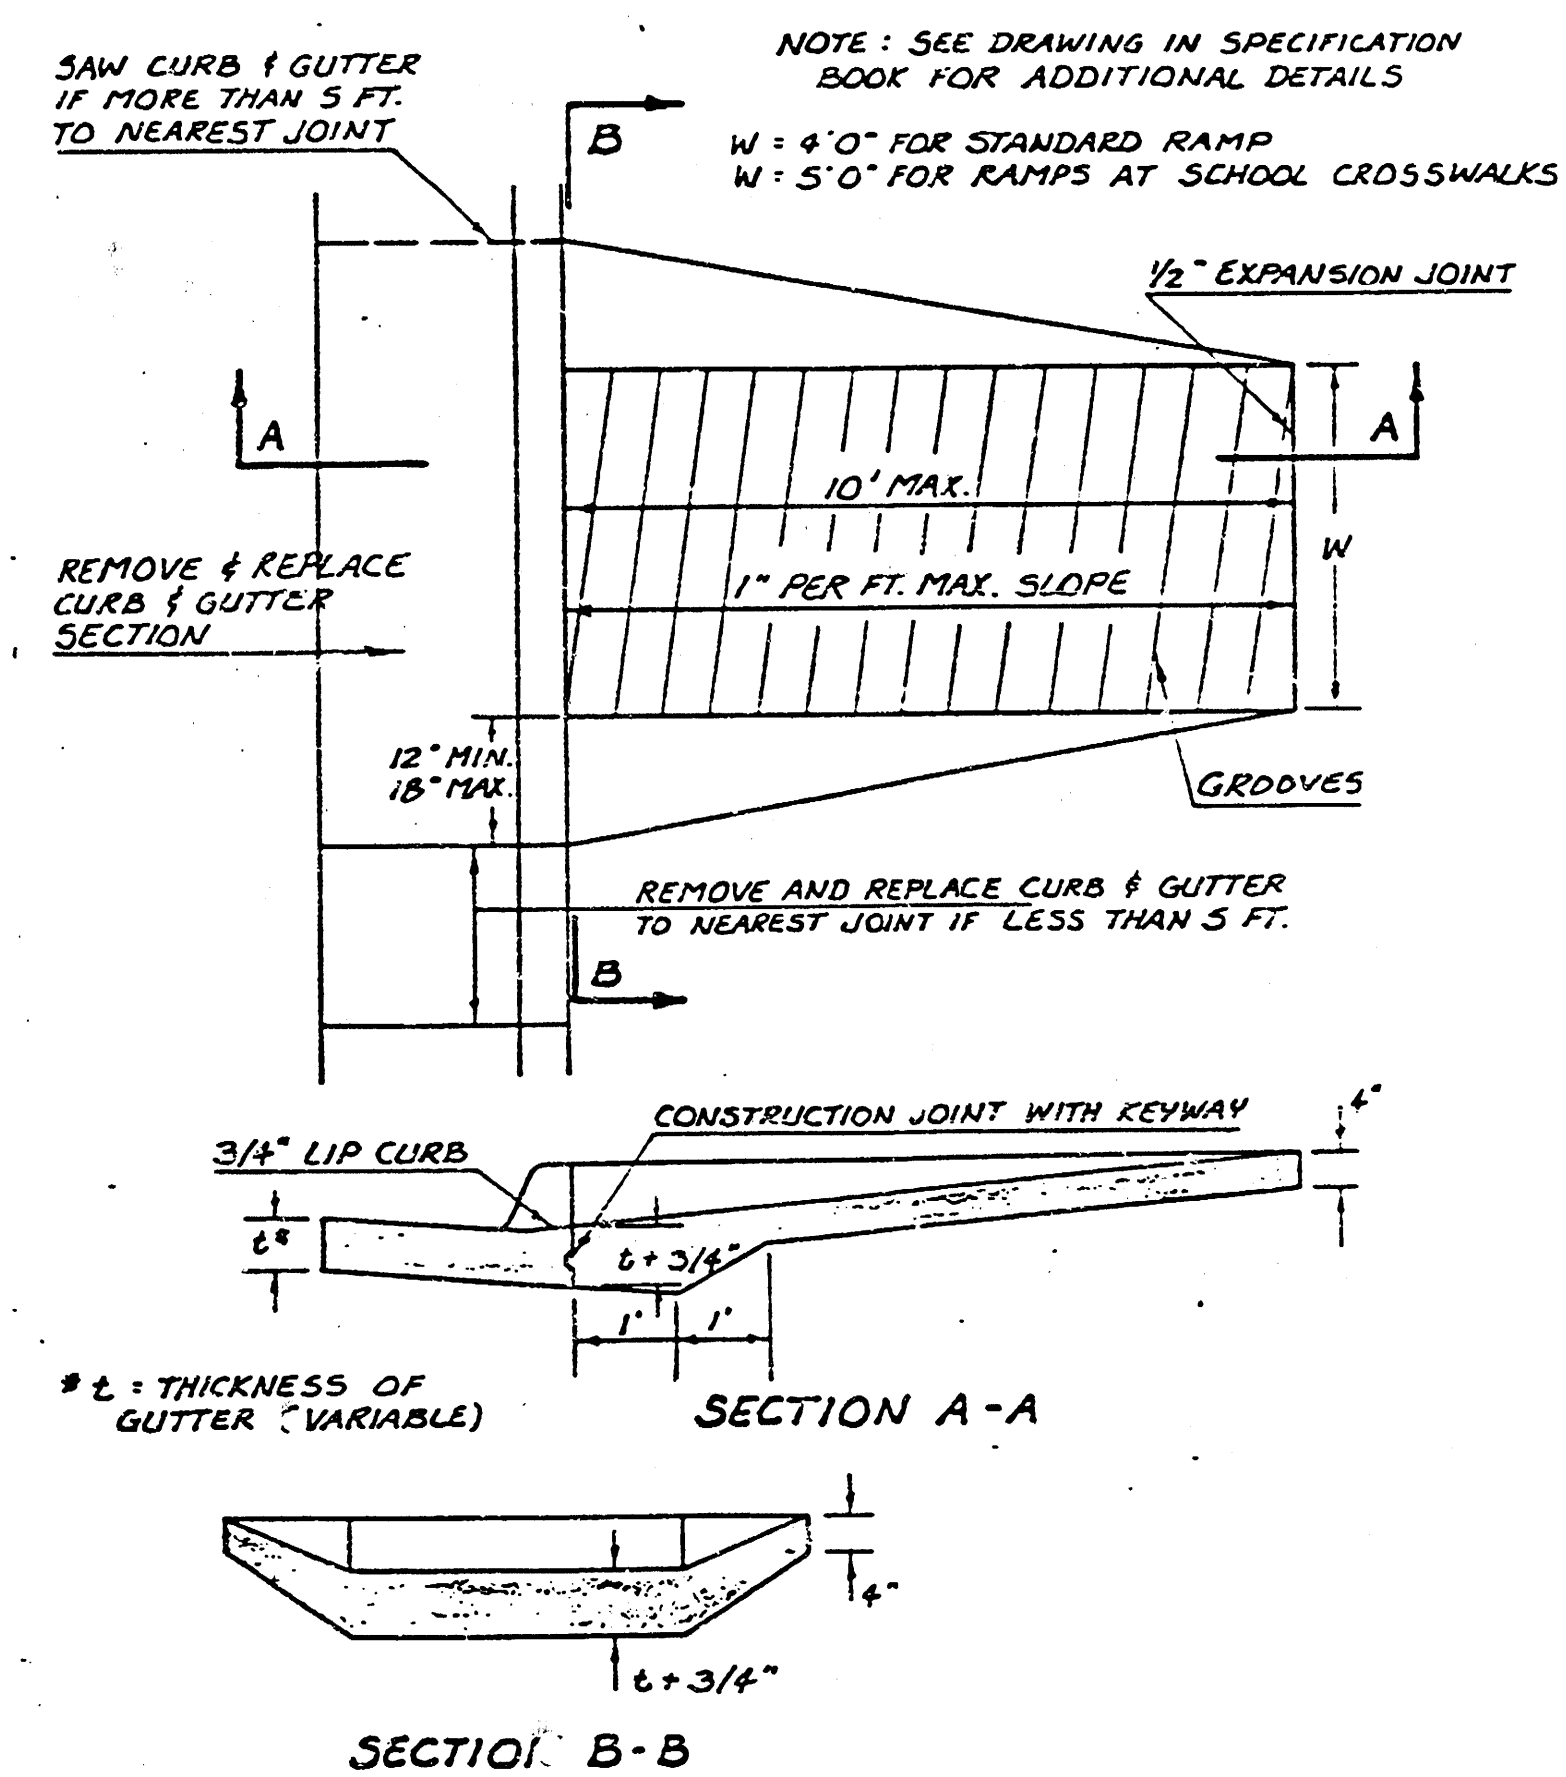

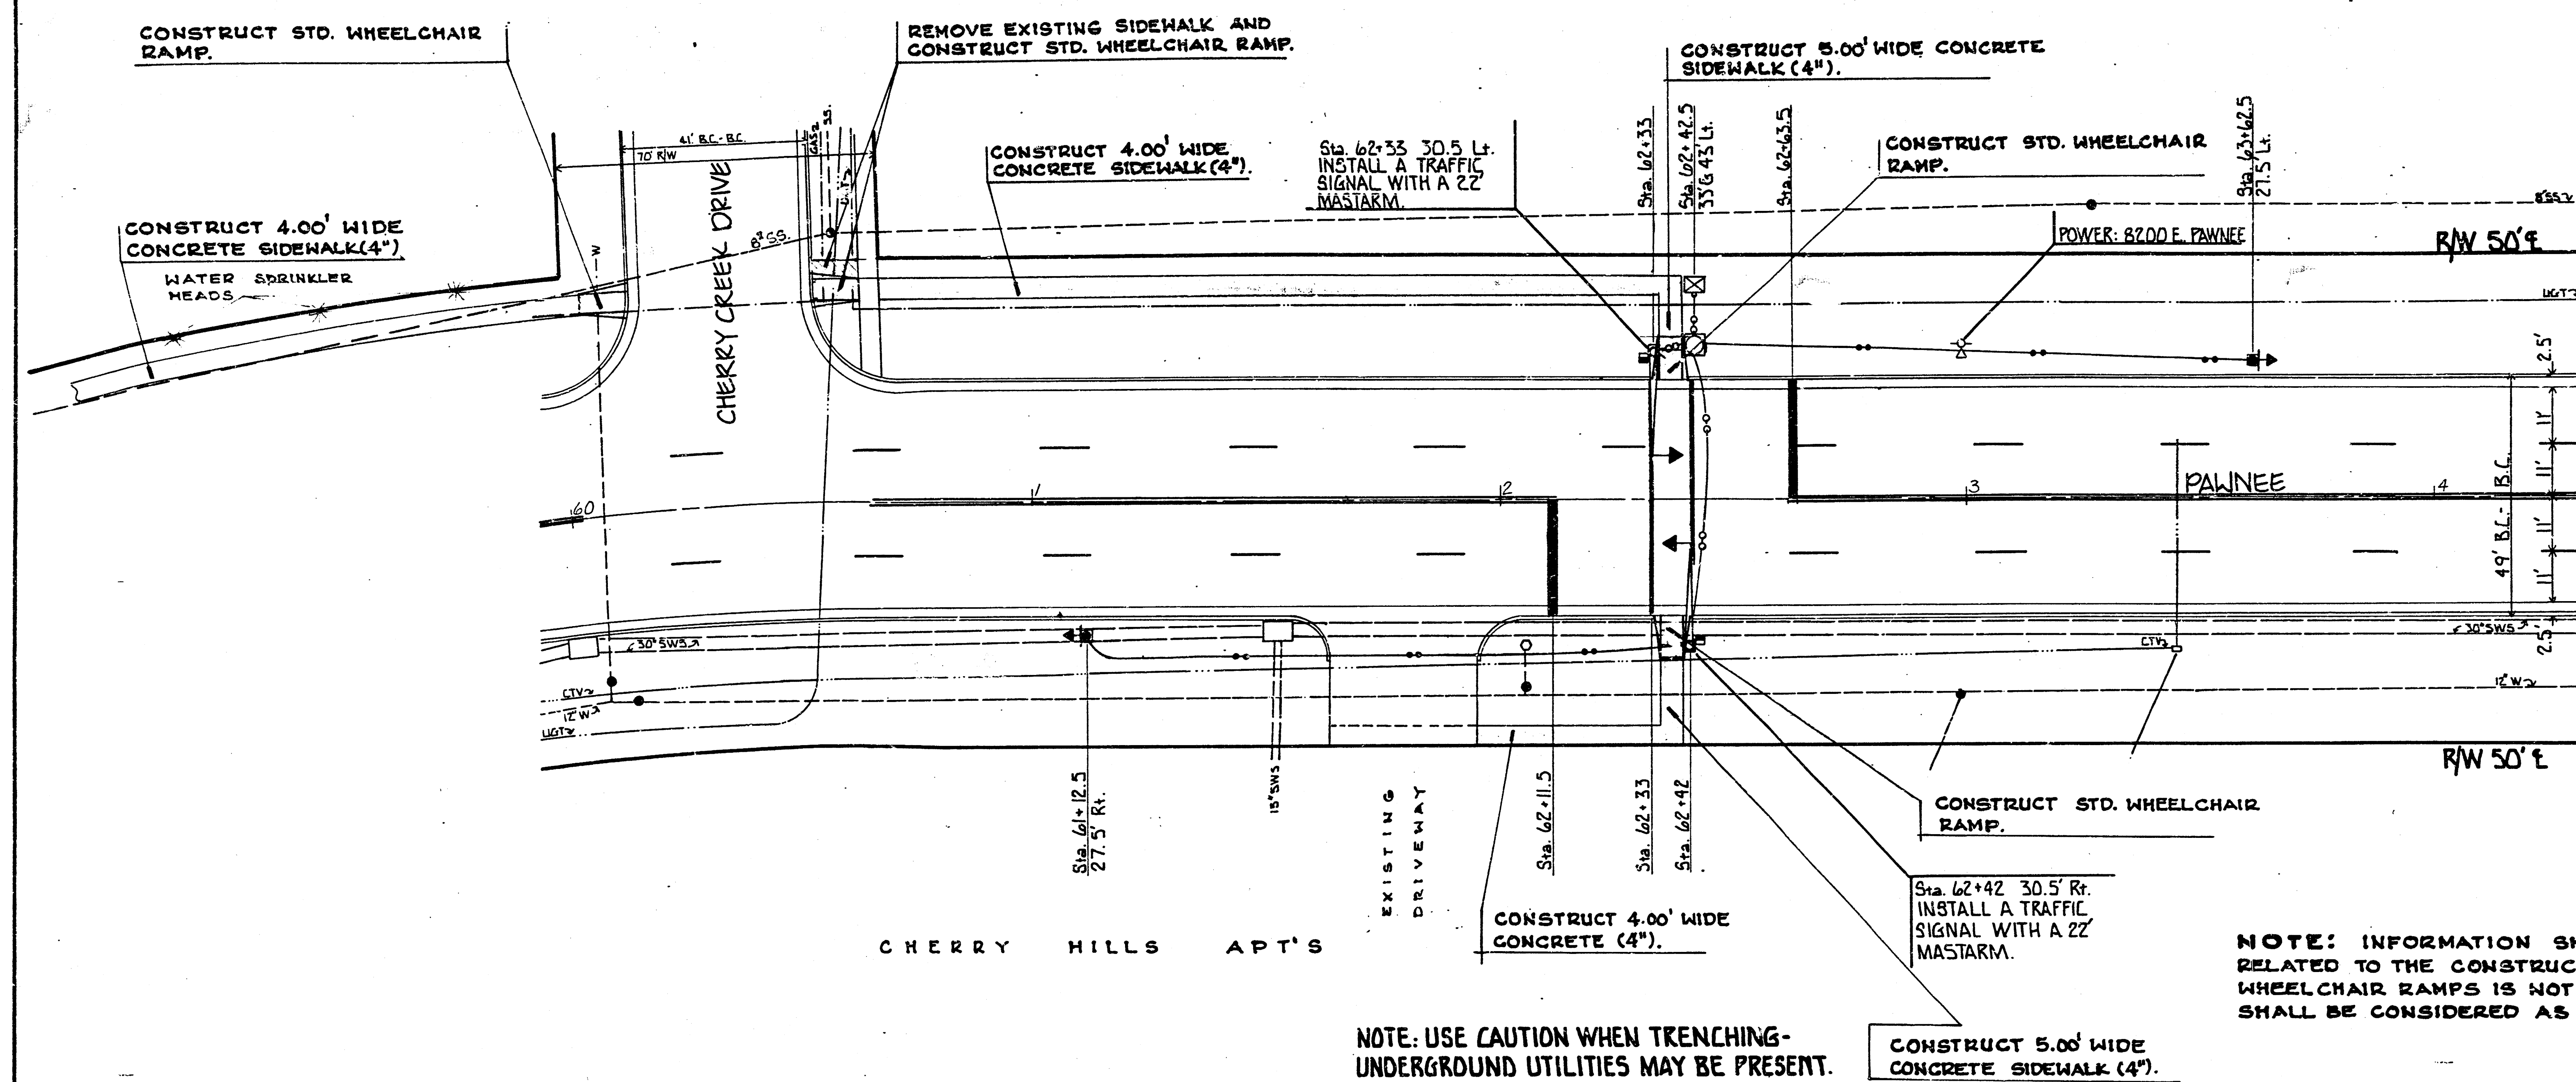

~~GENERAL~~ NOTES:

1. ~~CONTACT THE TRAFFIC ENGINEERING DIVISION, DEPT. OF OPERATIONS AND MAINTENANCE, PRIOR TO RECOGNITION OF ANY SIGNAL, POLE, CONTROLLER, SIGNAL, SERVICE BOXES, AND/OR CONDUIT.~~
2. ~~CONDUIT TO BE RUN OR JOCKED UNDER EXISTING PAVEMENT INCLUDING SIDEWALK, DRIVE APPROACHES, ETC. UNLESS OTHERWISE NOTED.~~
3. ~~TRAFFIC TO BE CARRIED THROUGH CONSTRUCTION.~~
4. ~~STANDARD CONSTRUCTION SIGNING, AS OUTLINED IN THE BASIC-CODE MANUAL OF THE CITY OF WICHITA, AND THE MANUAL ON UNIFORM TRAFFIC CONTROL DEVICES, SHALL BE INSTALLED AND MAINTAINED THROUGHOUT ALL PHASES OF CONSTRUCTION ON THIS PROJECT.~~
5. ~~THE CONTRACTOR FOR FIELD ENGINEER SHALL CONTACT ALL UTILITY COMPANIES WHICH MIGHT BE AFFECTED BY THE INSTALLATION OF THE TRAFFIC SIGNALIZATION PRIOR TO ANY UNDERGROUND INSTALLATION, AND REQUEST THEIR ASSISTANCE IN LOCATING UNDERGROUND PLANT.~~
6. ~~THE CITY OF WICHITA SHALL REMOVE EXISTING TRAFFIC SIGNAL EQUIPMENT. (EXCEPT AS OTHERWISE NOTED.)~~
7. ~~SIGNAL INSTALLATION, INTER-CHANGING, WALK SECTIONS, ETC. TO BE INSTALLED AS PER ENGINEERING SPECIFICATIONS.~~

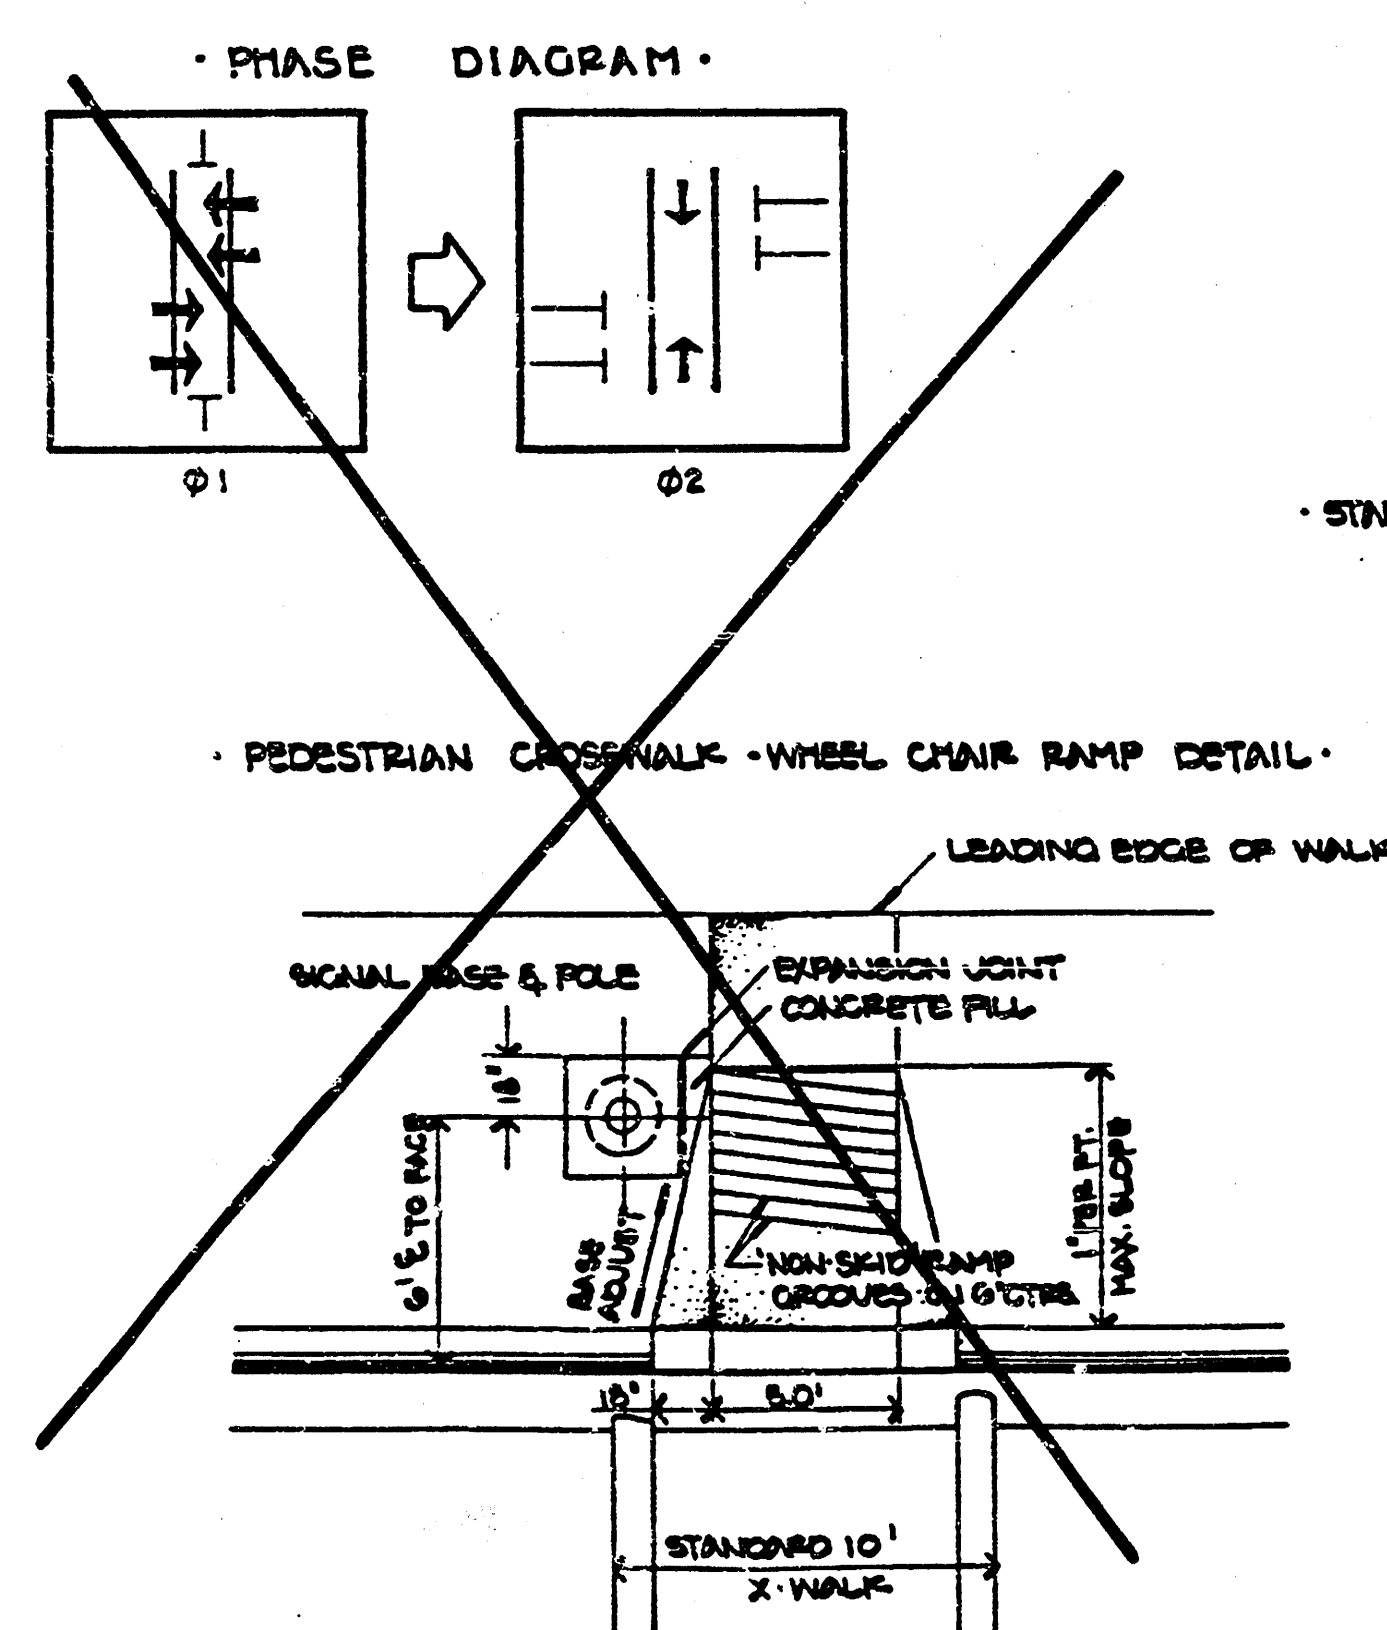

LEGEND:

-  SIGNAL INSTALLATION (BASE, POLE, MOUNTING)
 TRAFFIC SIGNAL
 PEDESTRIAN INDICATION
 V.M.S. INSTALLATION
 SERVICE BOX
 CONTROLLER - PEDESTRIAN MOUNT
 3/4" CONDUIT
 1 1/4" CONDUIT
 2.0" CONDUIT
 JUNCTION BOX
 PROPOSED CONSTRUCTION
 PROPOSED REMOVAL

• SIDEWALK •

PROJECT DESCRIPTION
PAWNEE between CHERRY CREEK & TURON
SCHOOL X-WALK SIGNALIZATION:
•BEECH ELEMENTARY•

PROJECT NUMBER
472 76 355 80760000 000 001

BOOK NO.	APPROVED BY	DATE JULY 8
DRAWN BY 10		RE-VISED

DRAWN BY <u>JD</u>		PLANT NUMBER
CITY OF WICHITA DEPARTMENT OF OPERATIONS MAINTENANCE		
TRAFFIC ENGINEER WM. G. WICKINLEY		SCALE $1" = 20'$