



PLAN
 SECTION 25.07
 CHISHOLM CREEK DIVERSION
 CITIES SERVICE 10" GAS LINE
 10-19-56

Notes:
 1. Composition of backfill equal to
 surrounding natural ground.
 2. 3" min. cover in R/W.
 3. Water table elevation 1307.4 10-19-56

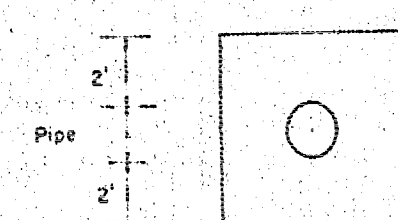

Detail of Sewer Ring

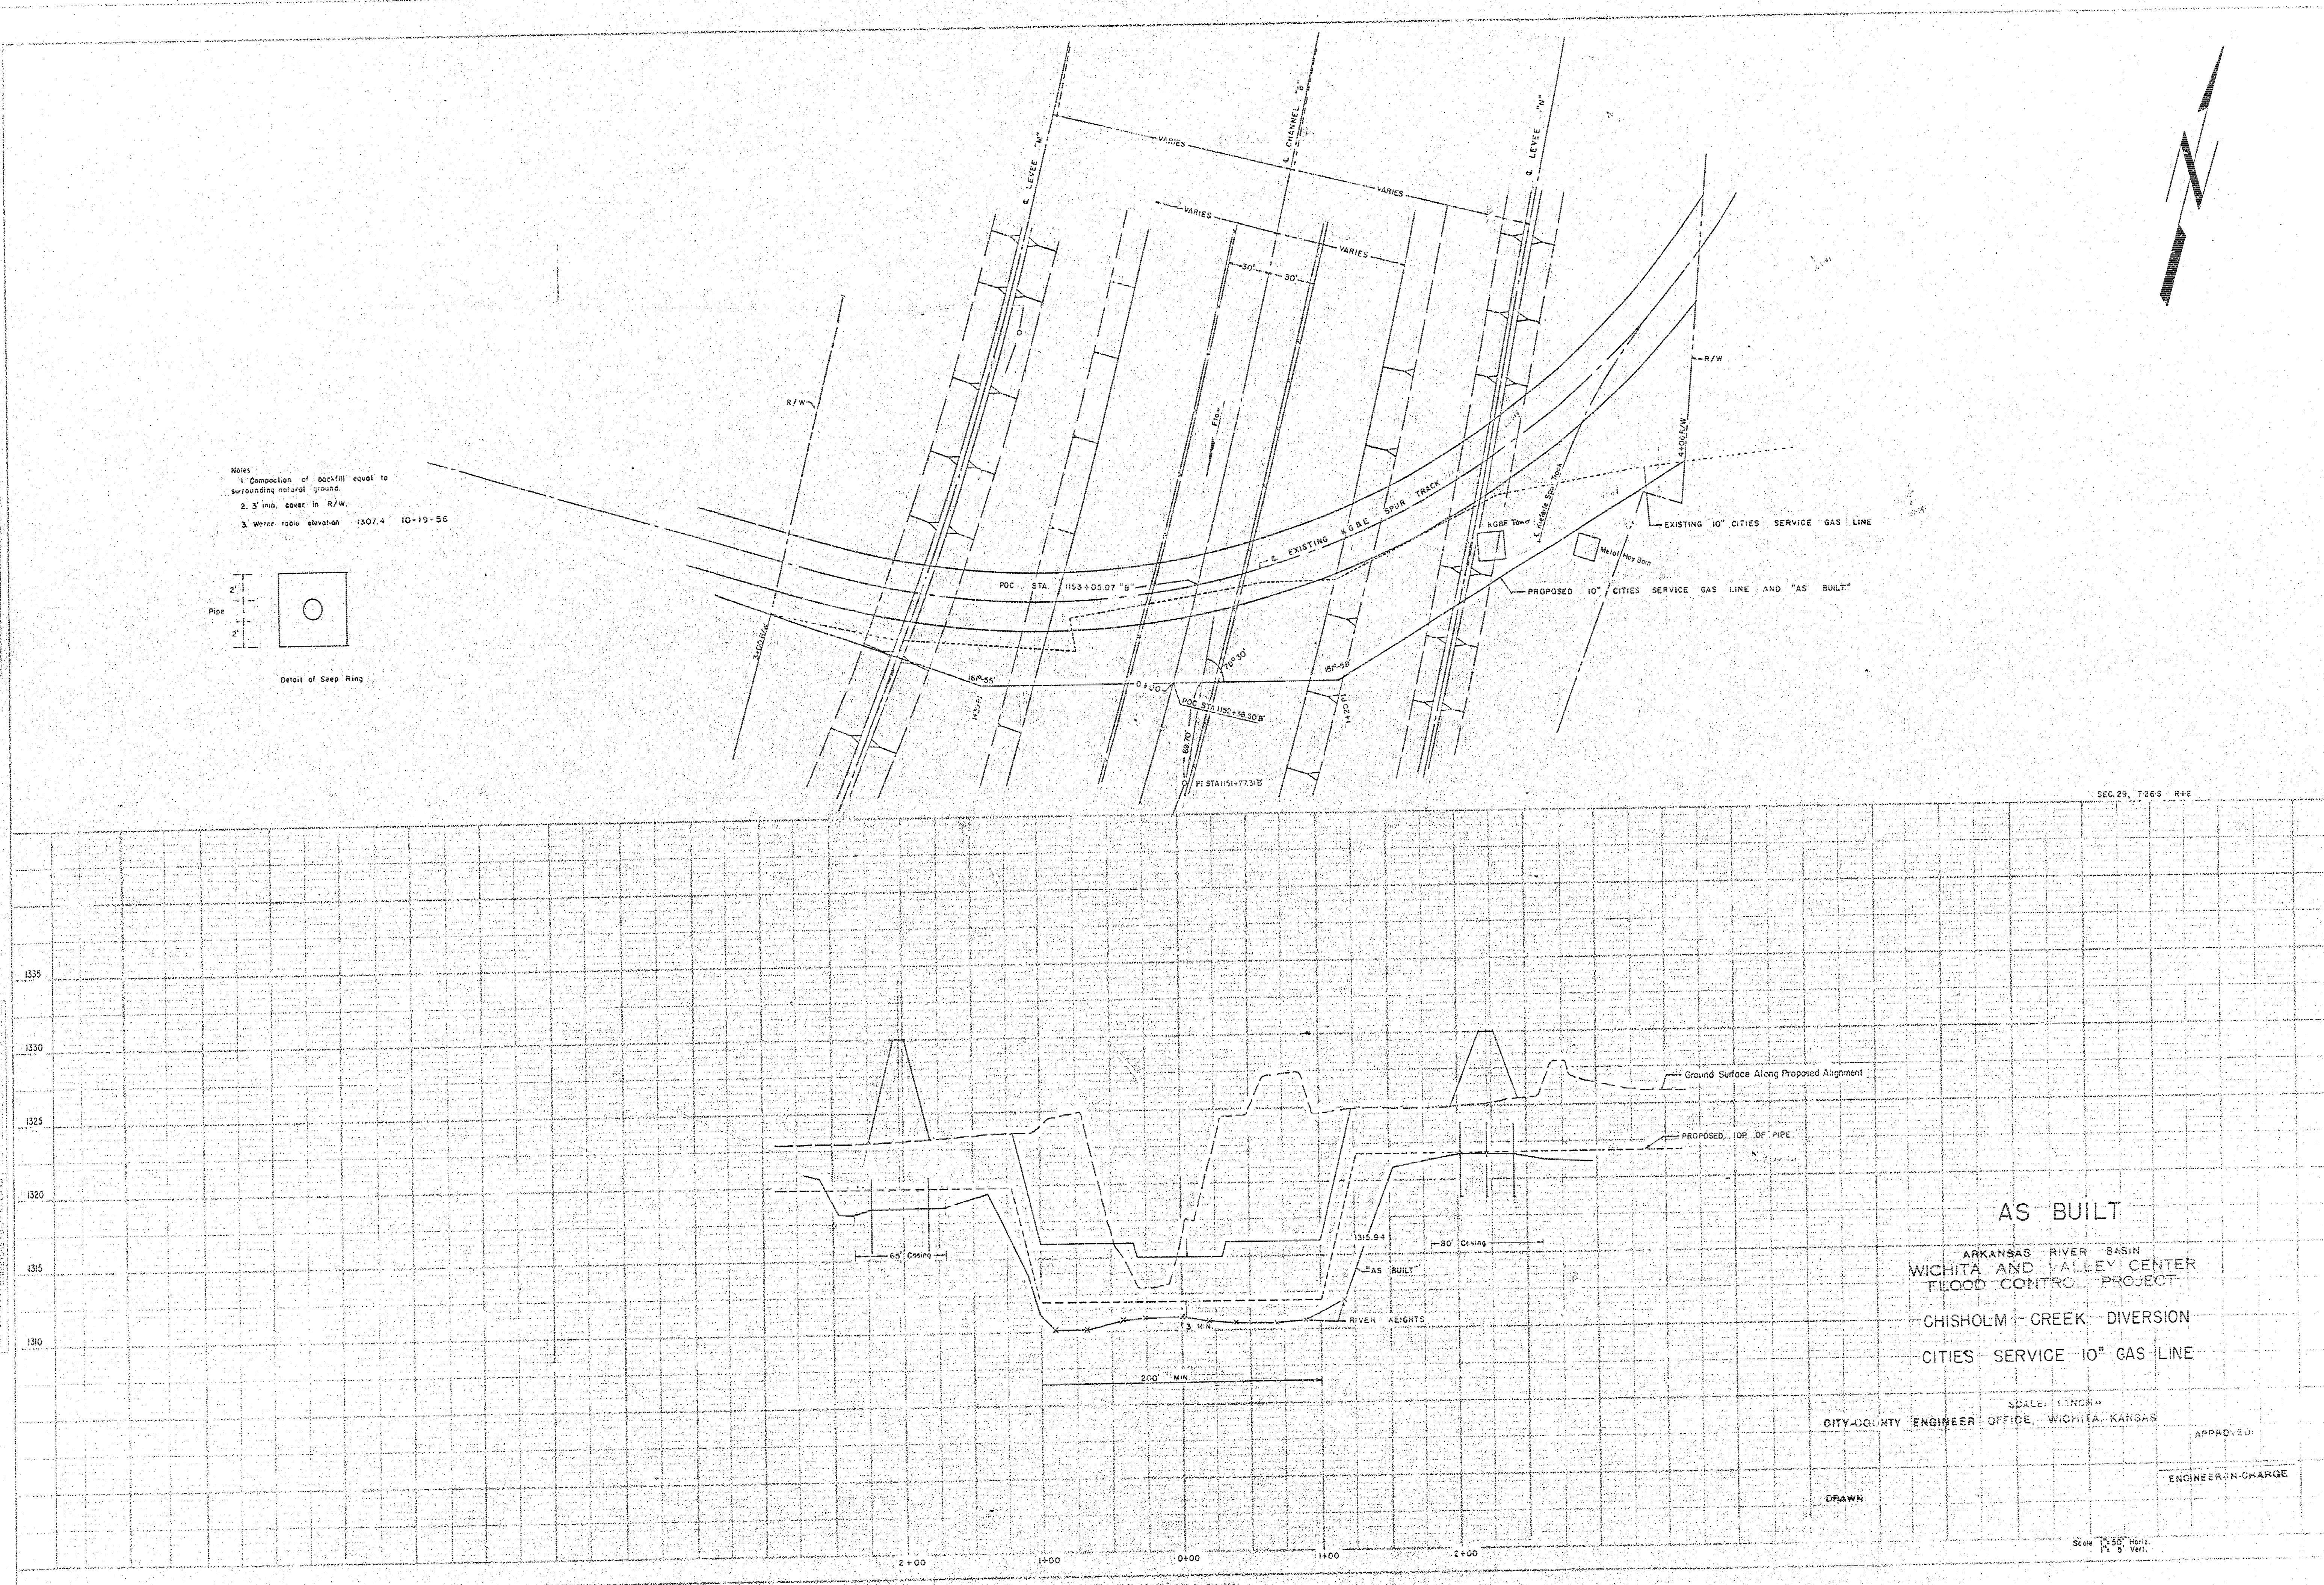

AS BUILT
 ARKANSAS RIVER BASIN
 WICHITA AND VALLEY CENTER
 FLOOD CONTROL PROJECT
 CHISHOLM CREEK DIVERSION
 CITIES SERVICE 10" GAS LINE

SCALE: 1"=20'
 CITY/COUNTY ENGINEER OFFICE, WICHITA, KANSAS

DRAWN

APPROVED
 ENGINEER-IN-CHARGE

10-19-56
 10-19-56