



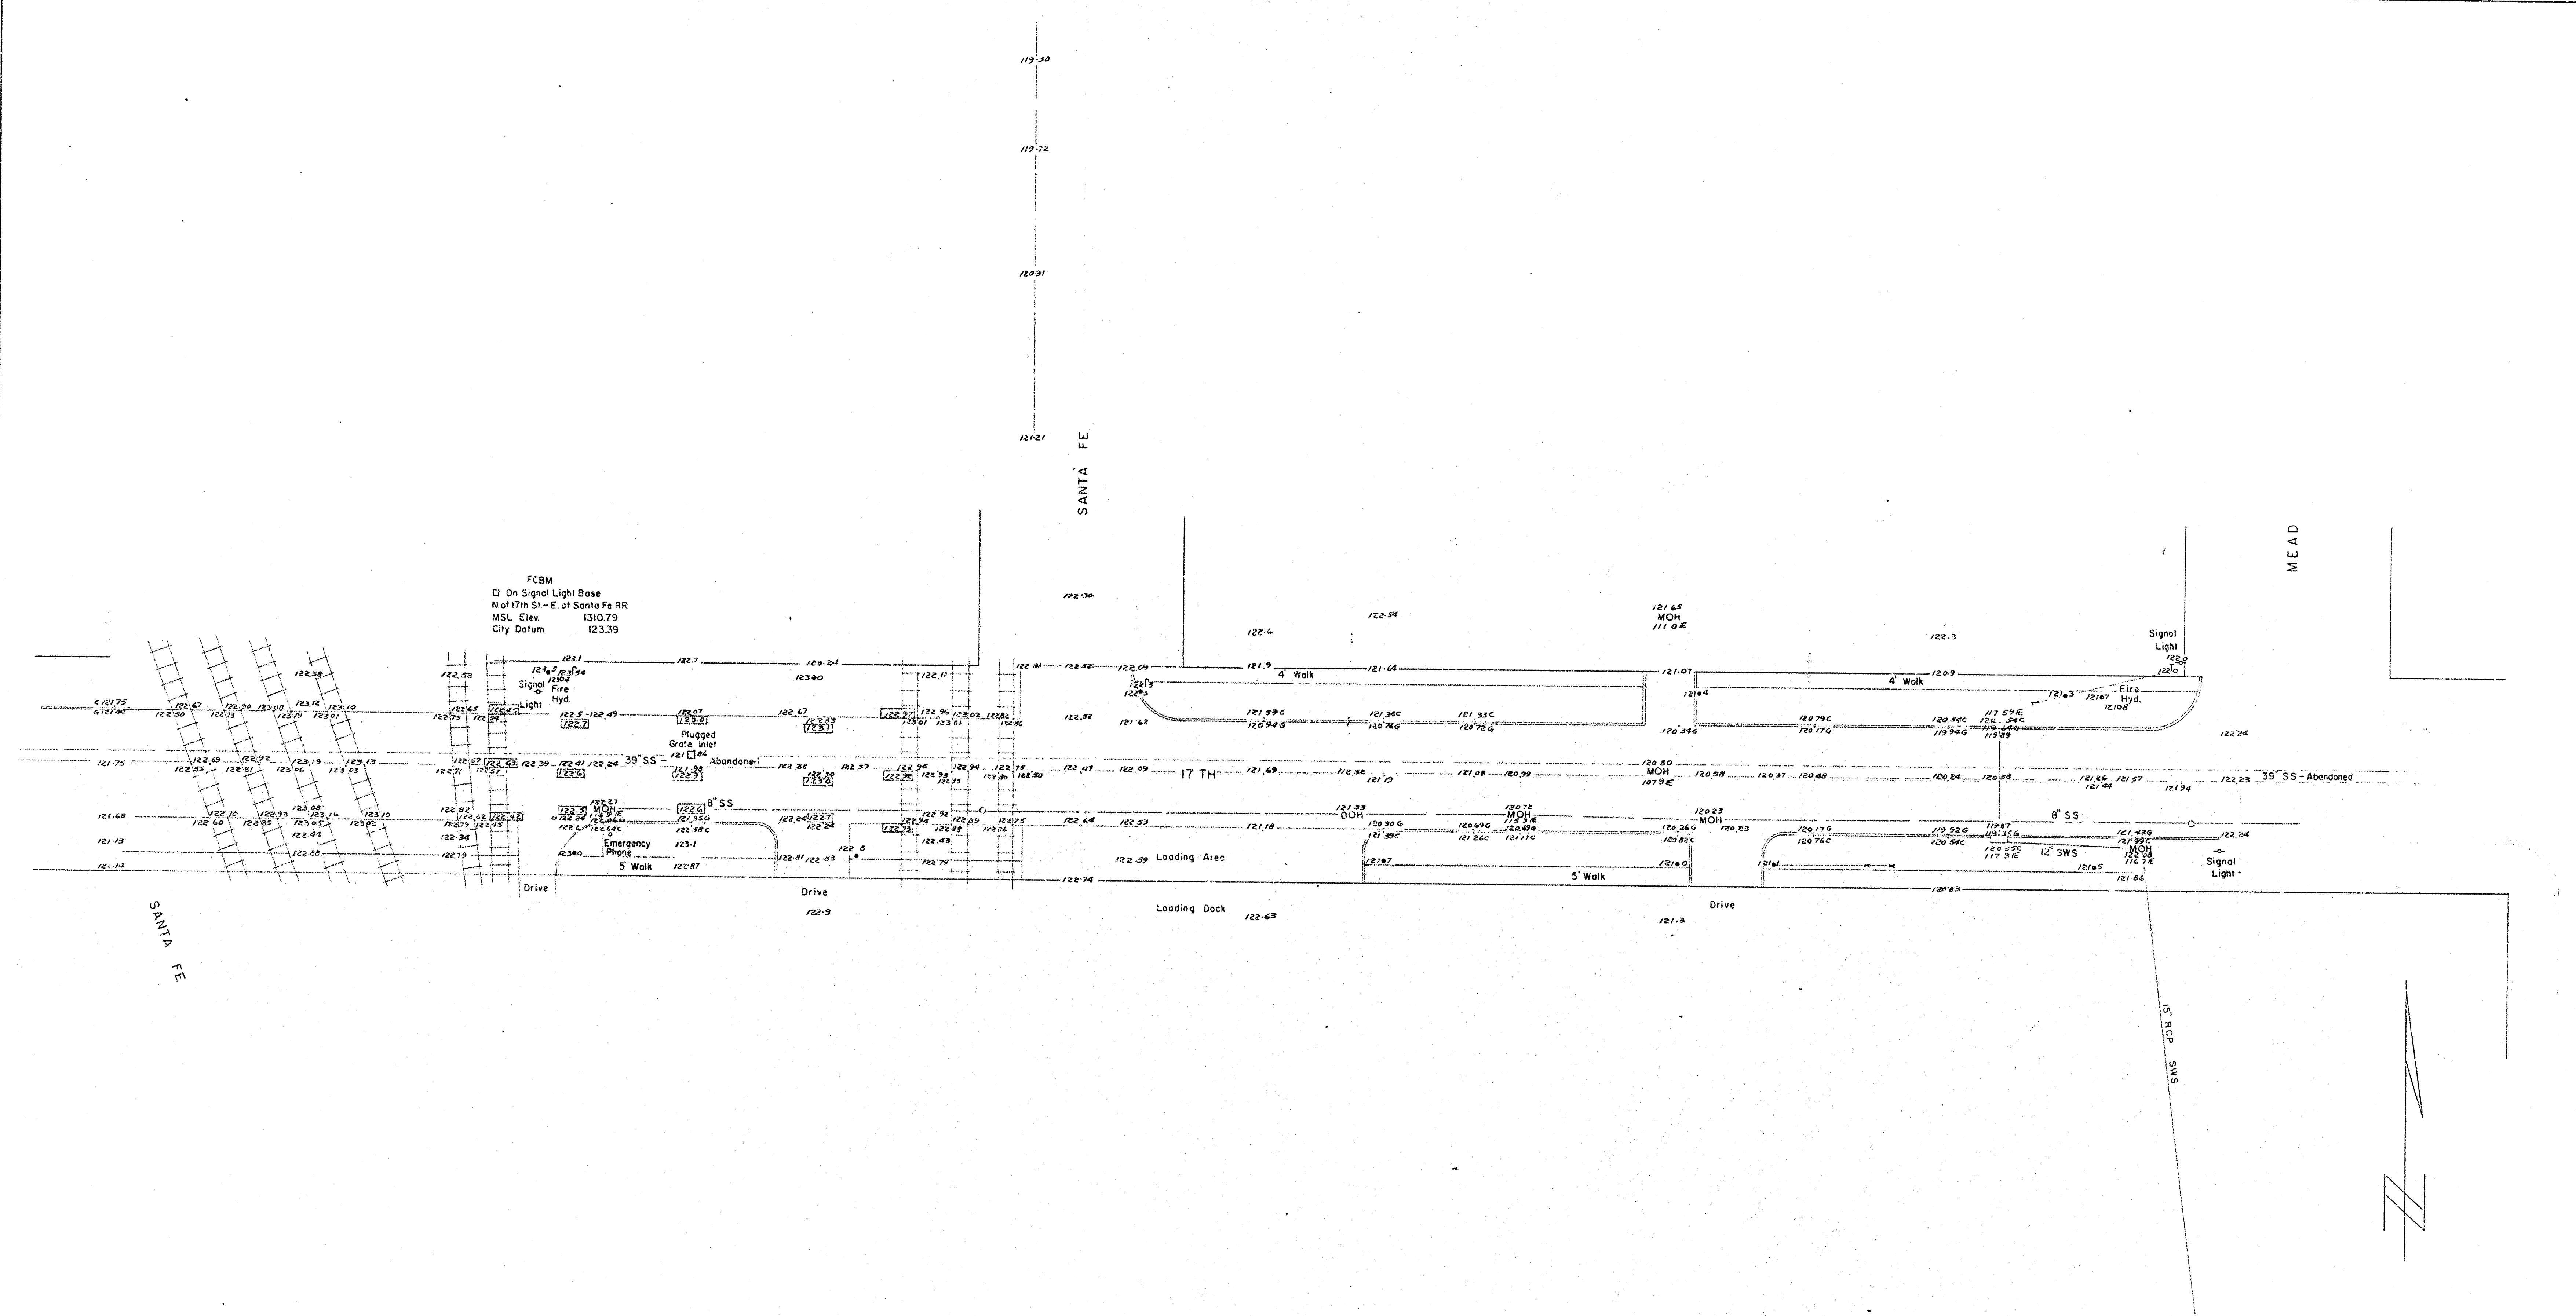

SEVENTEENTH ST. NG.
 AT&SF R.R. TO MEAD
 SEC. 9: T-27-S: R-1-E

SCALE 1" = 20'
 DATE SEPT. 1967
 DRAWN WDI

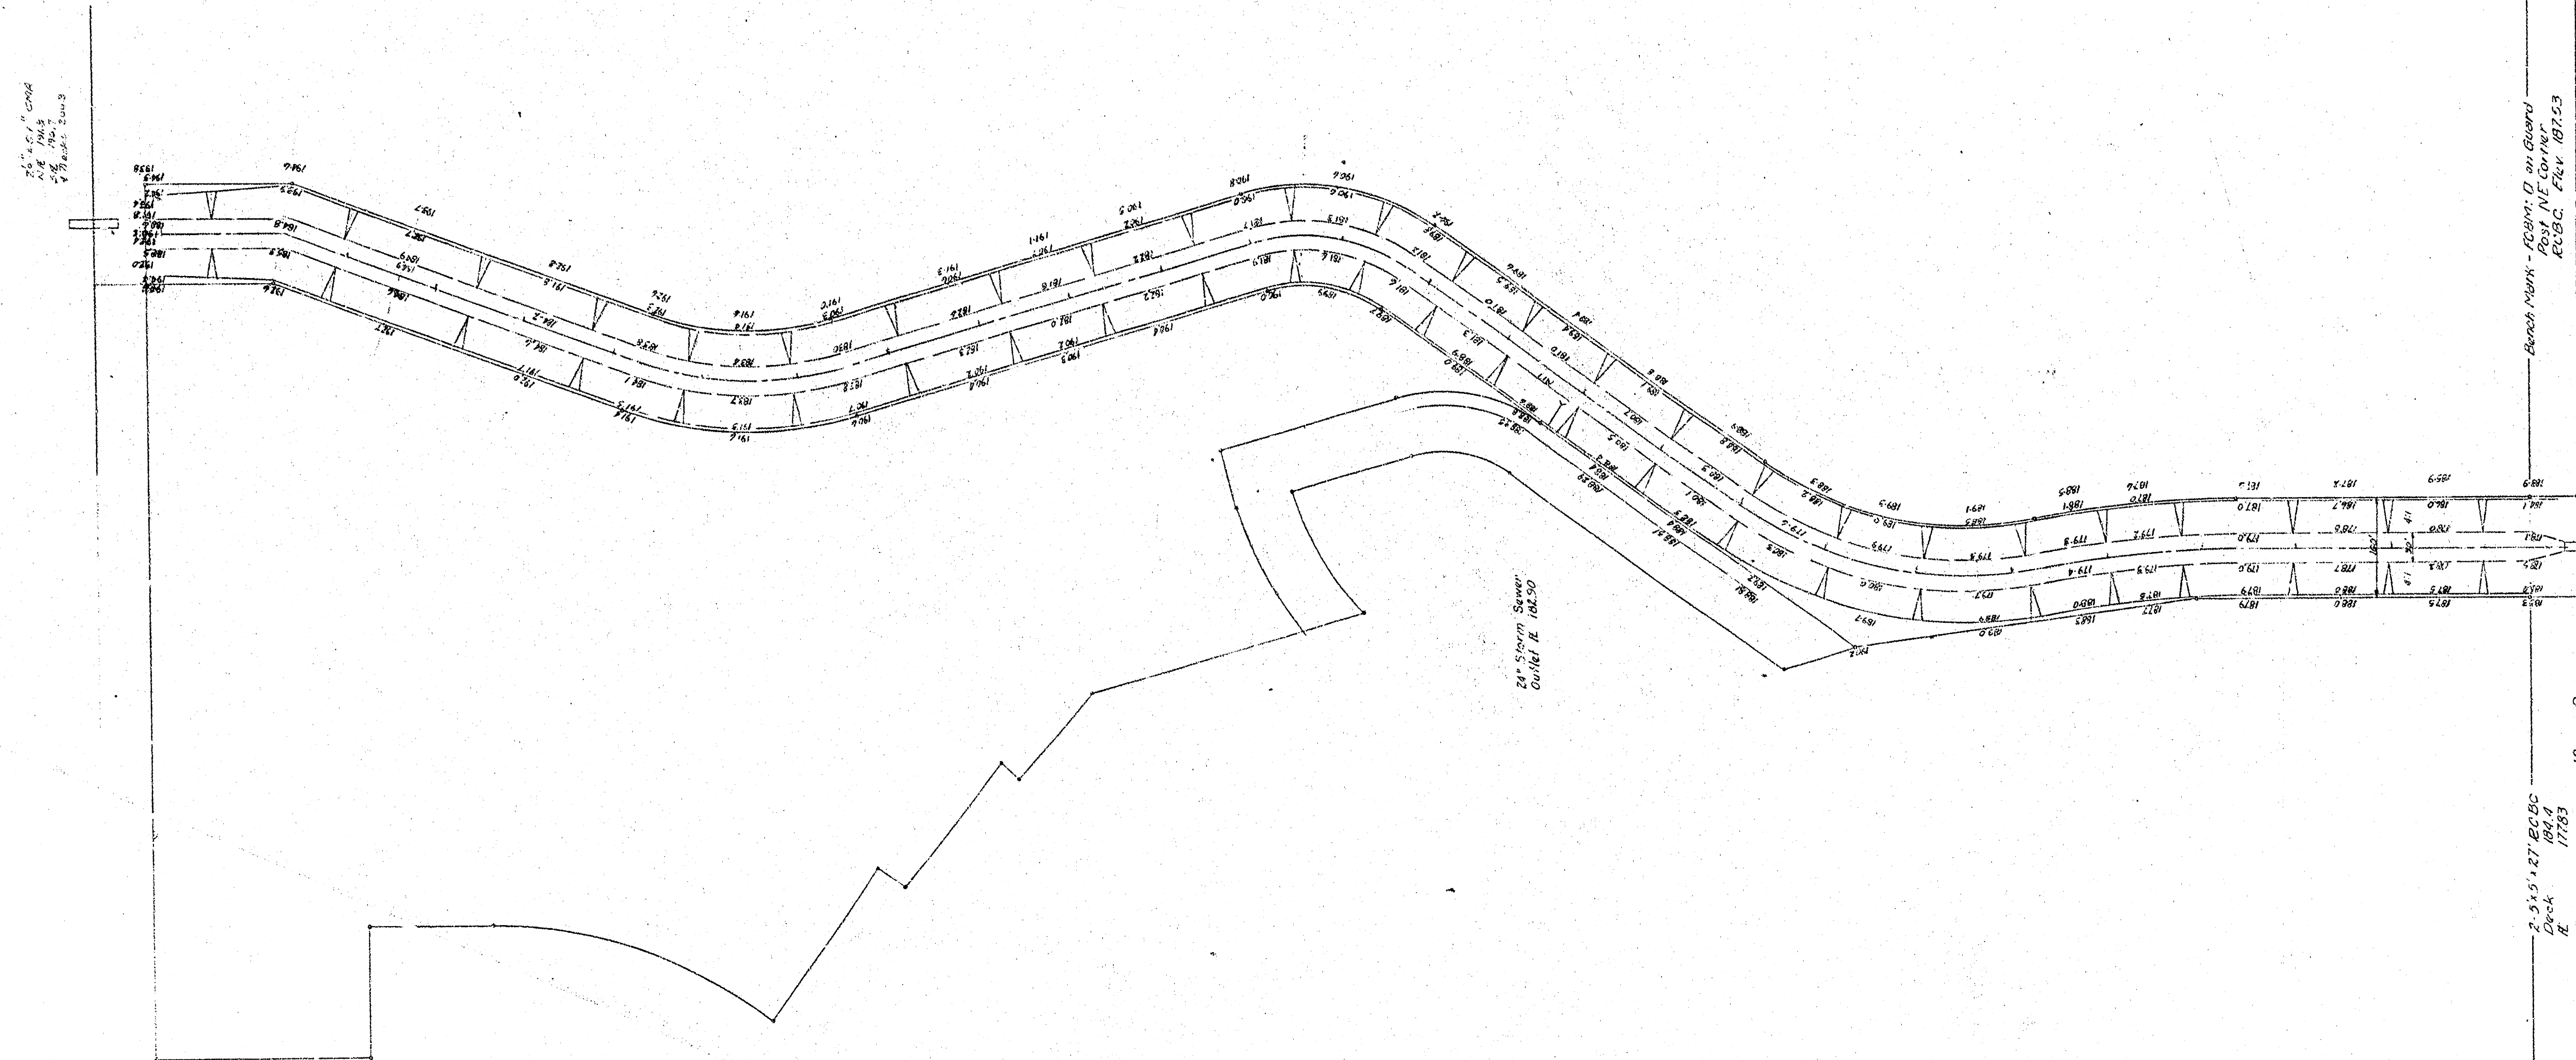

CROSS SECTIONS - AS BUILT
 McLENNAN 9TH ADDITION DRAINAGE
 SCALE 1" = 100'
 DATE 11/1/83

BOUNDARY - RIGHT OF WAY
 ELEV. 101.23

13TH ST

WEST BRANCH
 GYP CREEK