




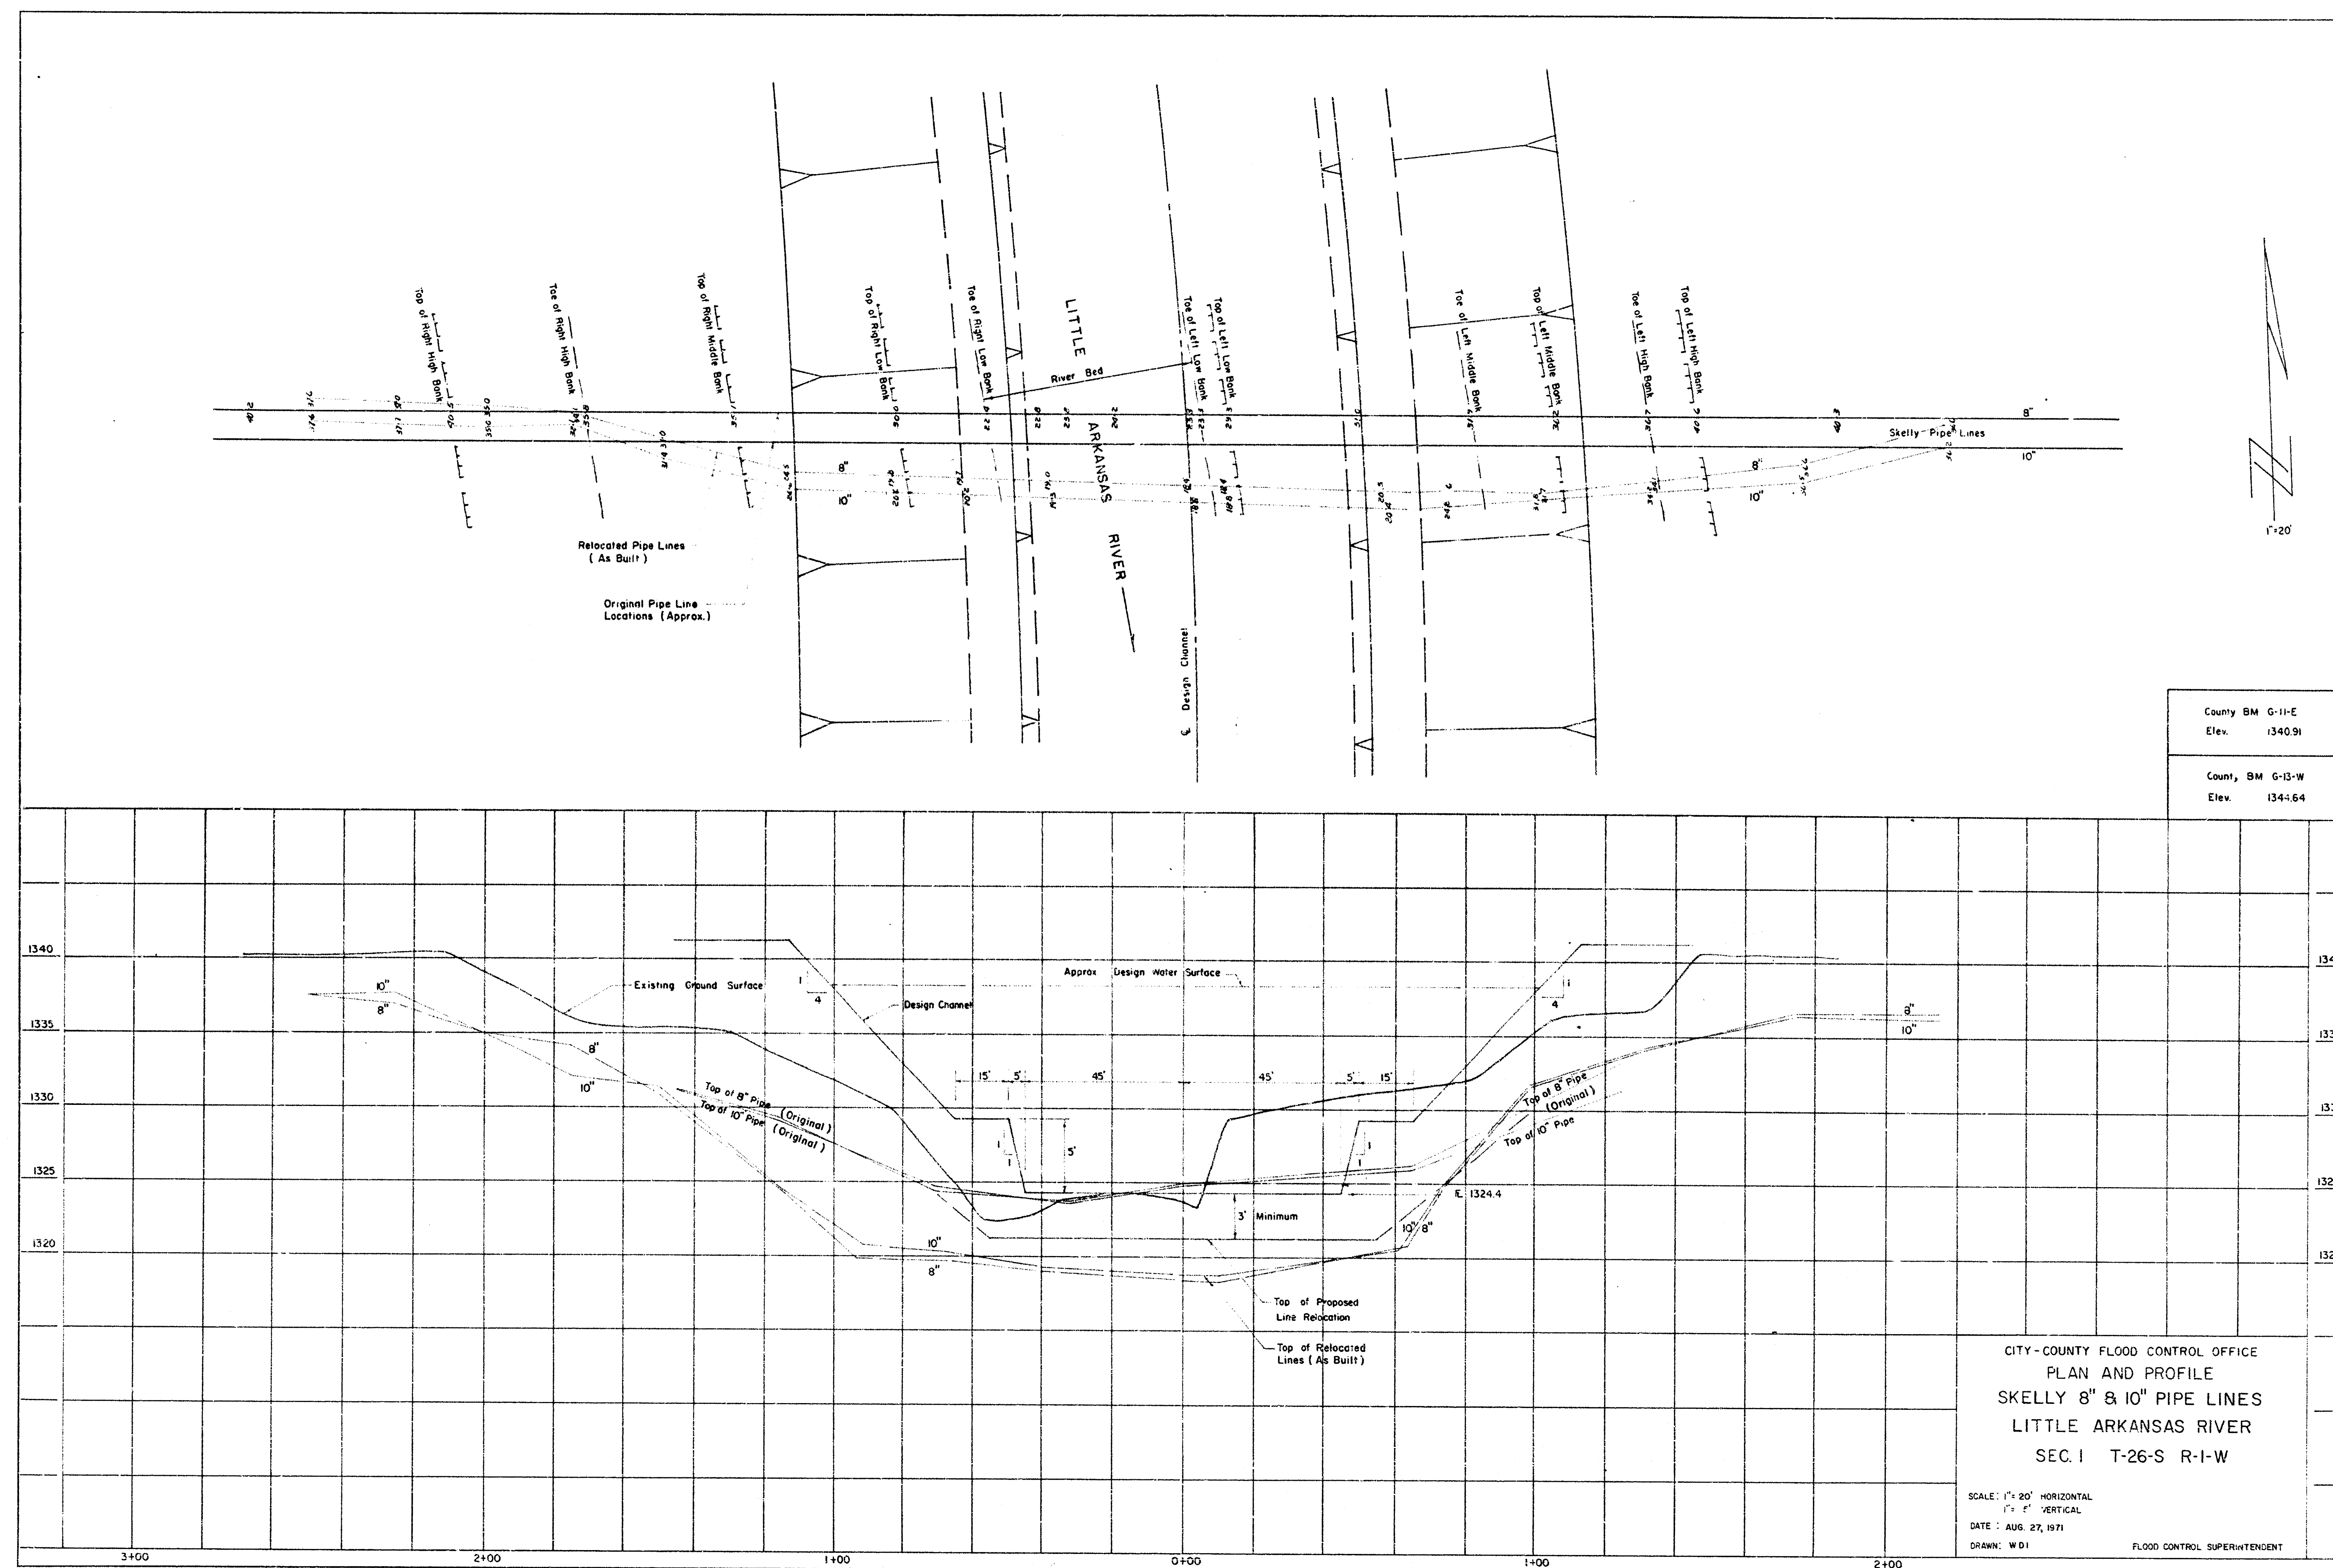



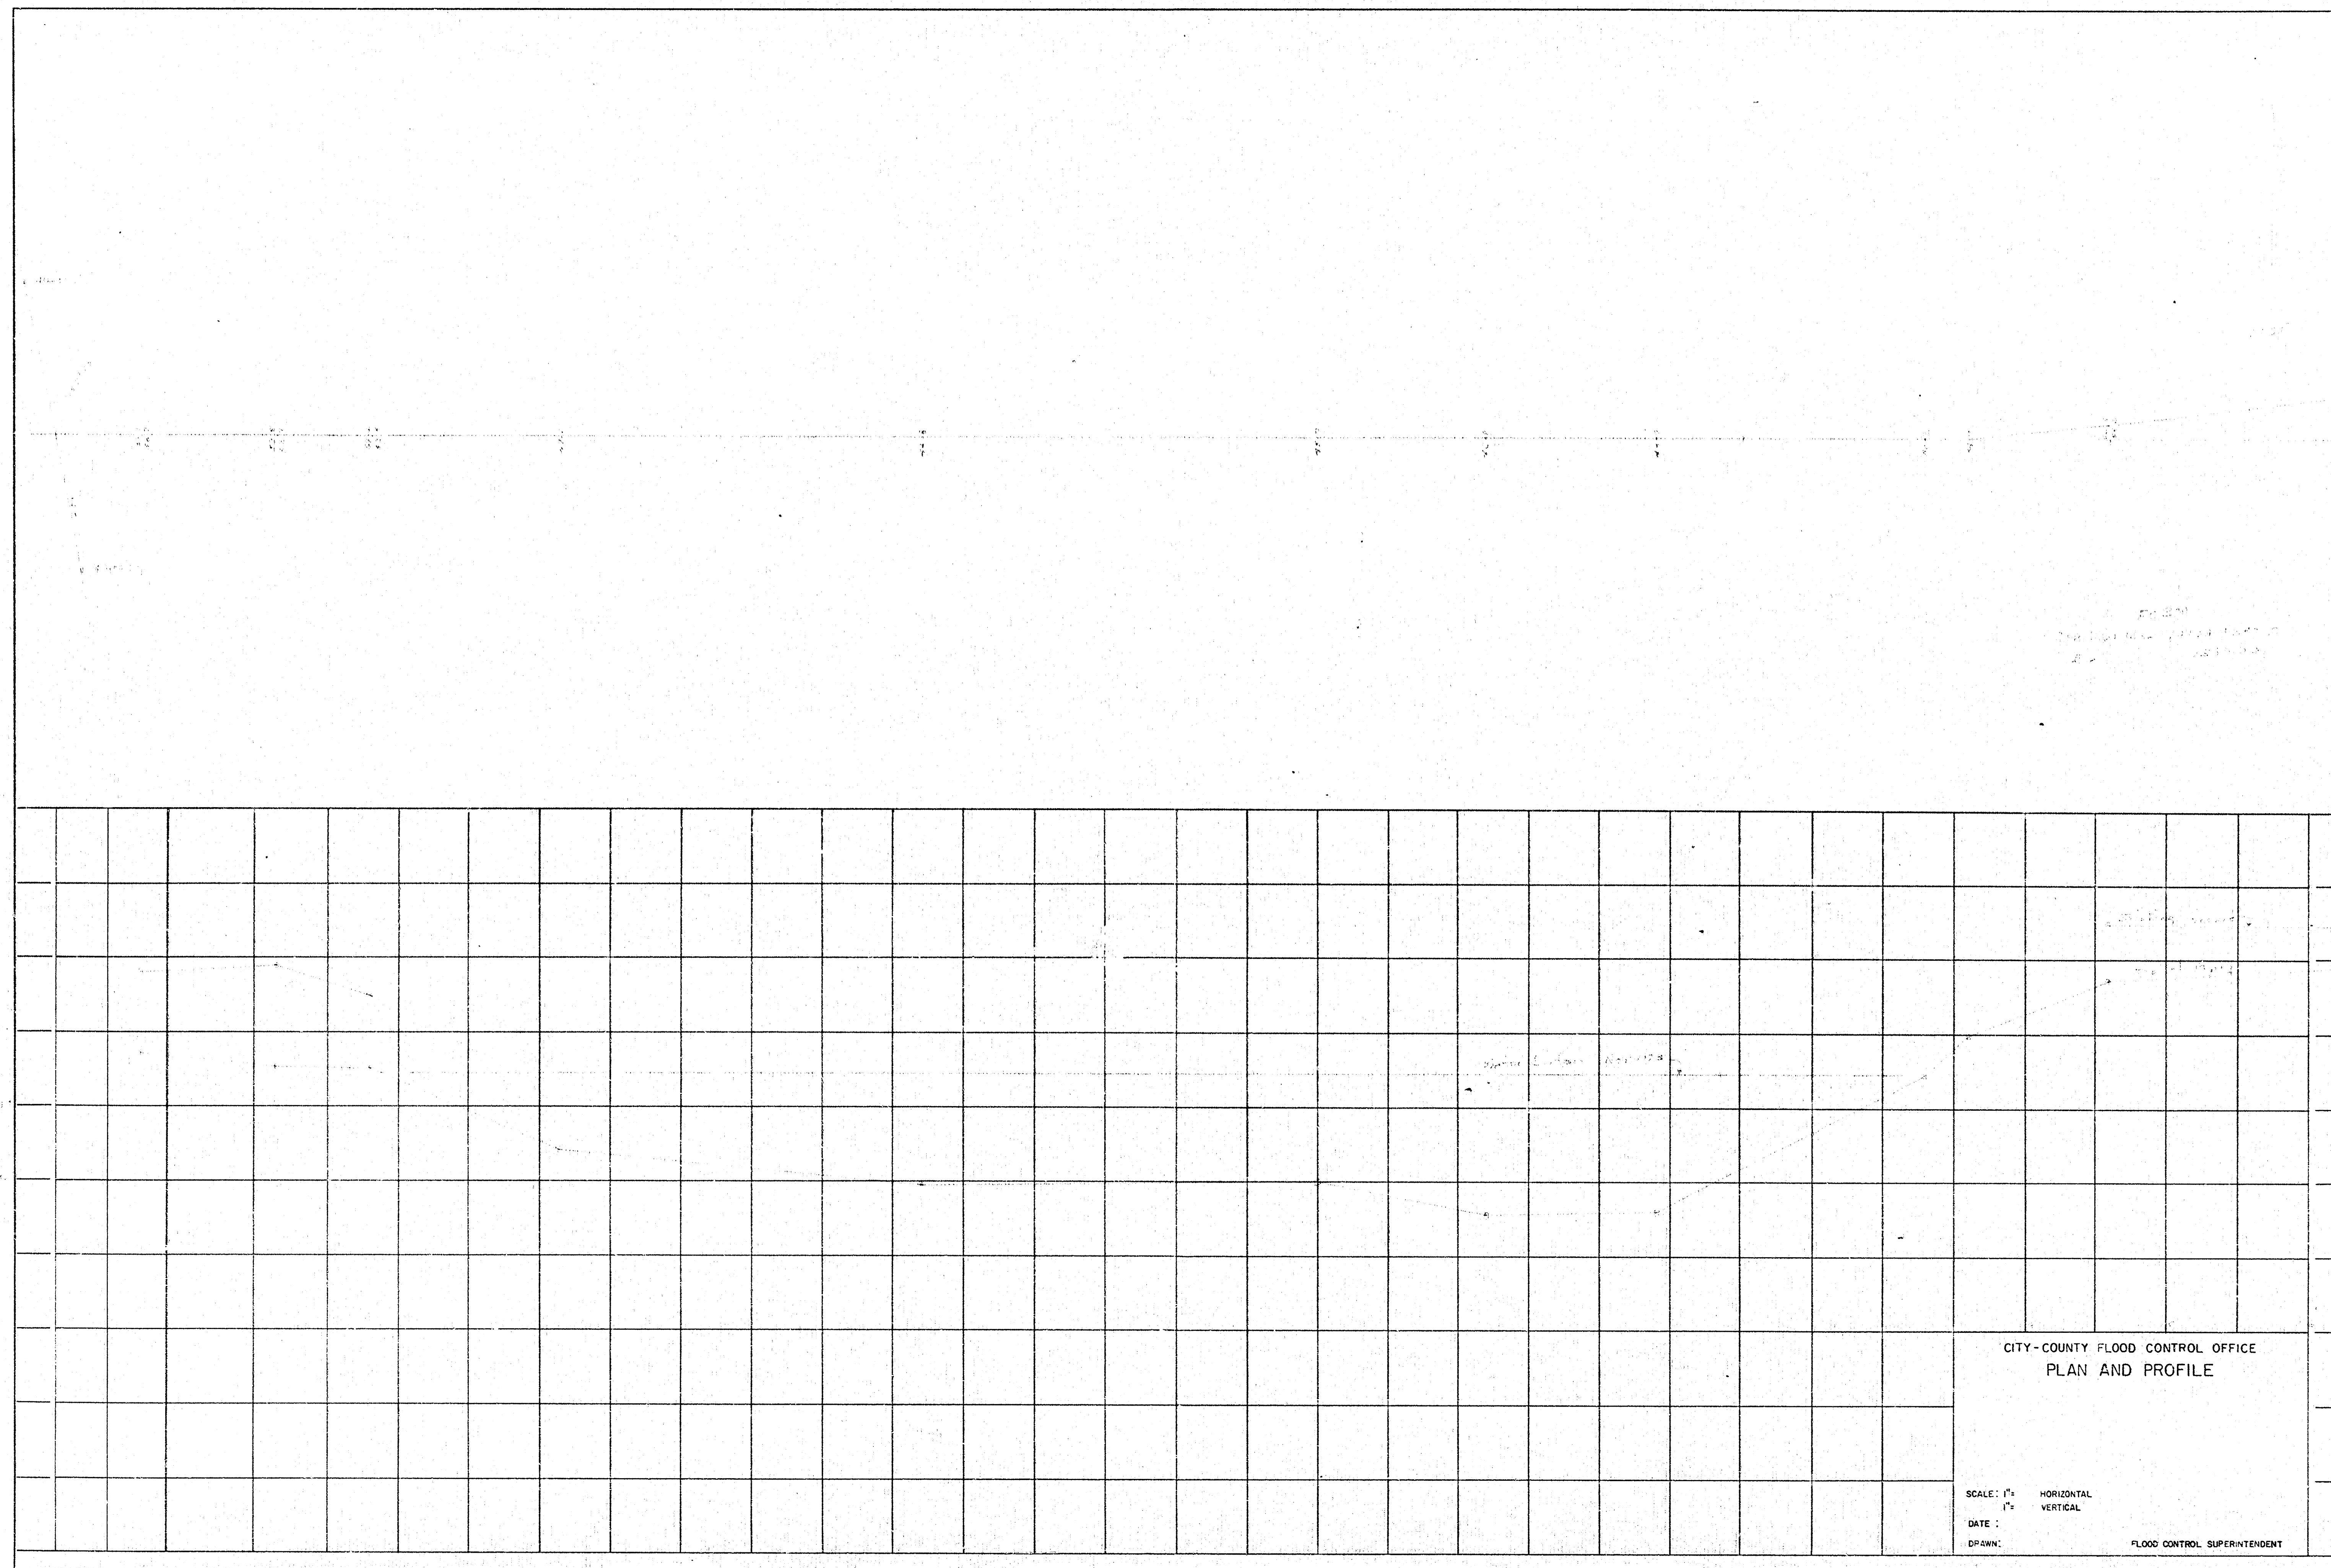


NR 12 Sec 31 T89N R10W A14 R. (Gully) 10/27/73 L-100
1/27/73

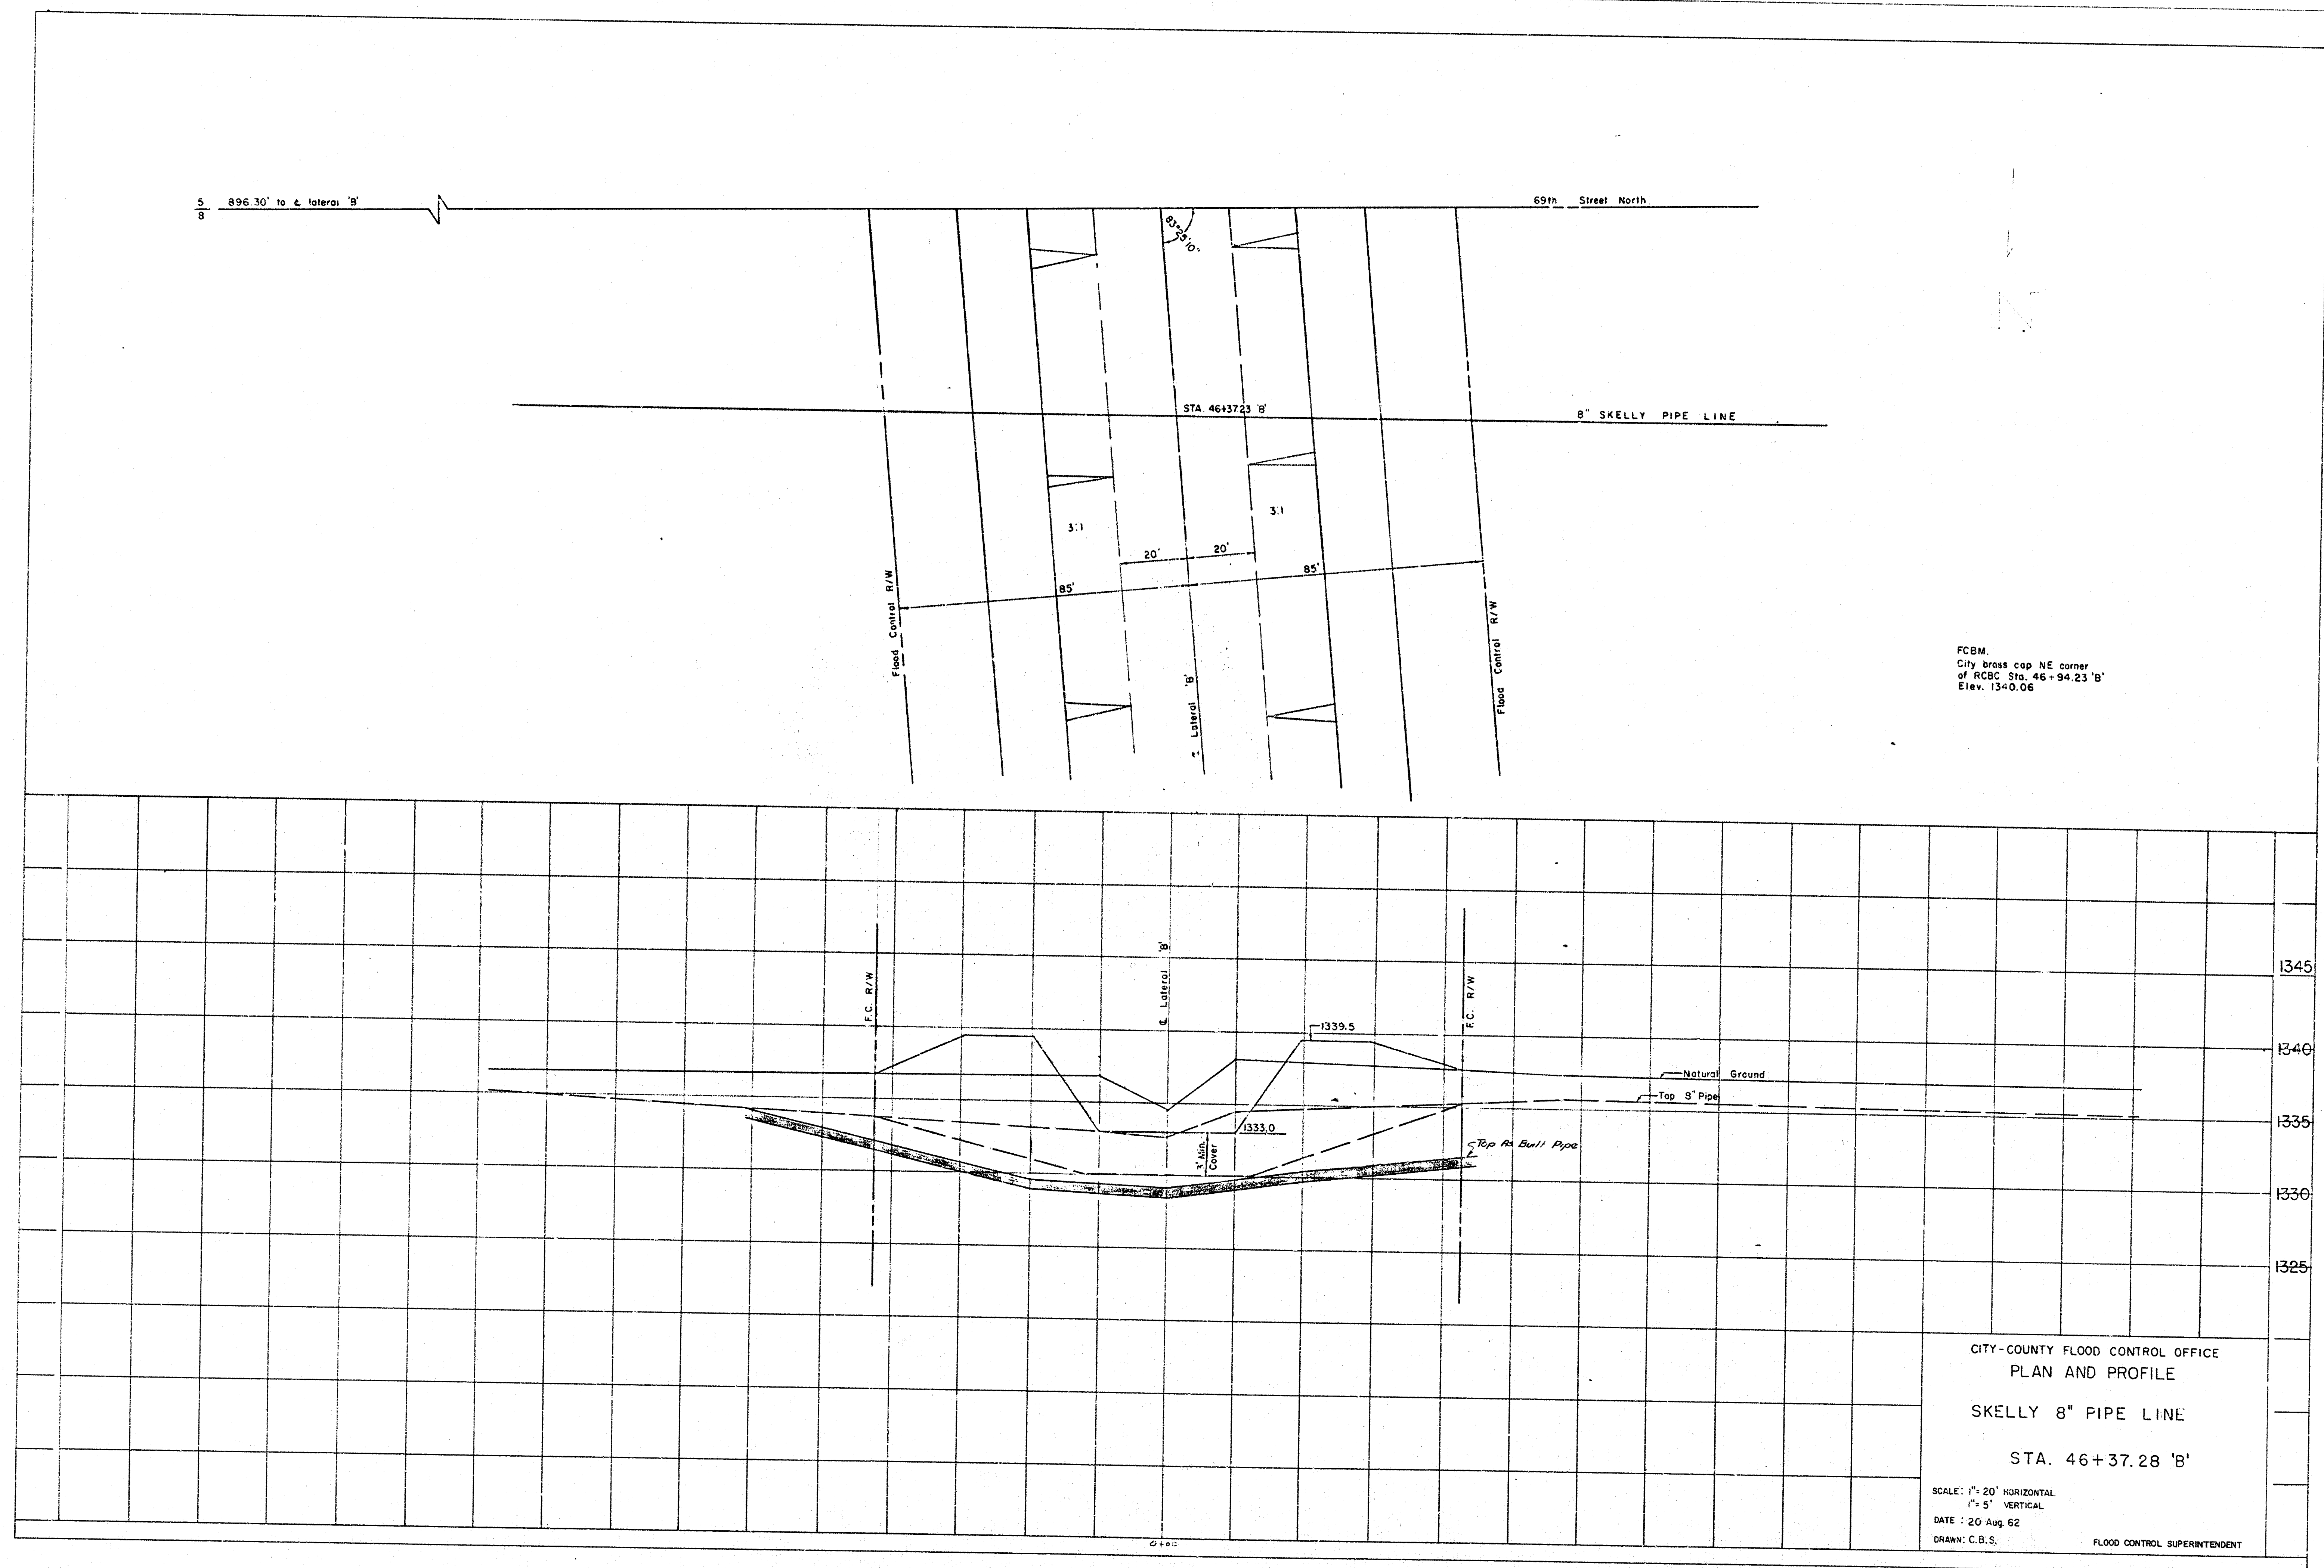

RELOCATION NOT
REQUIRED


BENCH MARK:
R.R. spike in guardrail post
NE corner of bridge, 30' S
8' 30" E of section corner
24.19
25.30 T-25-S, R-I-W & R-I-E
Elev. 1356.37

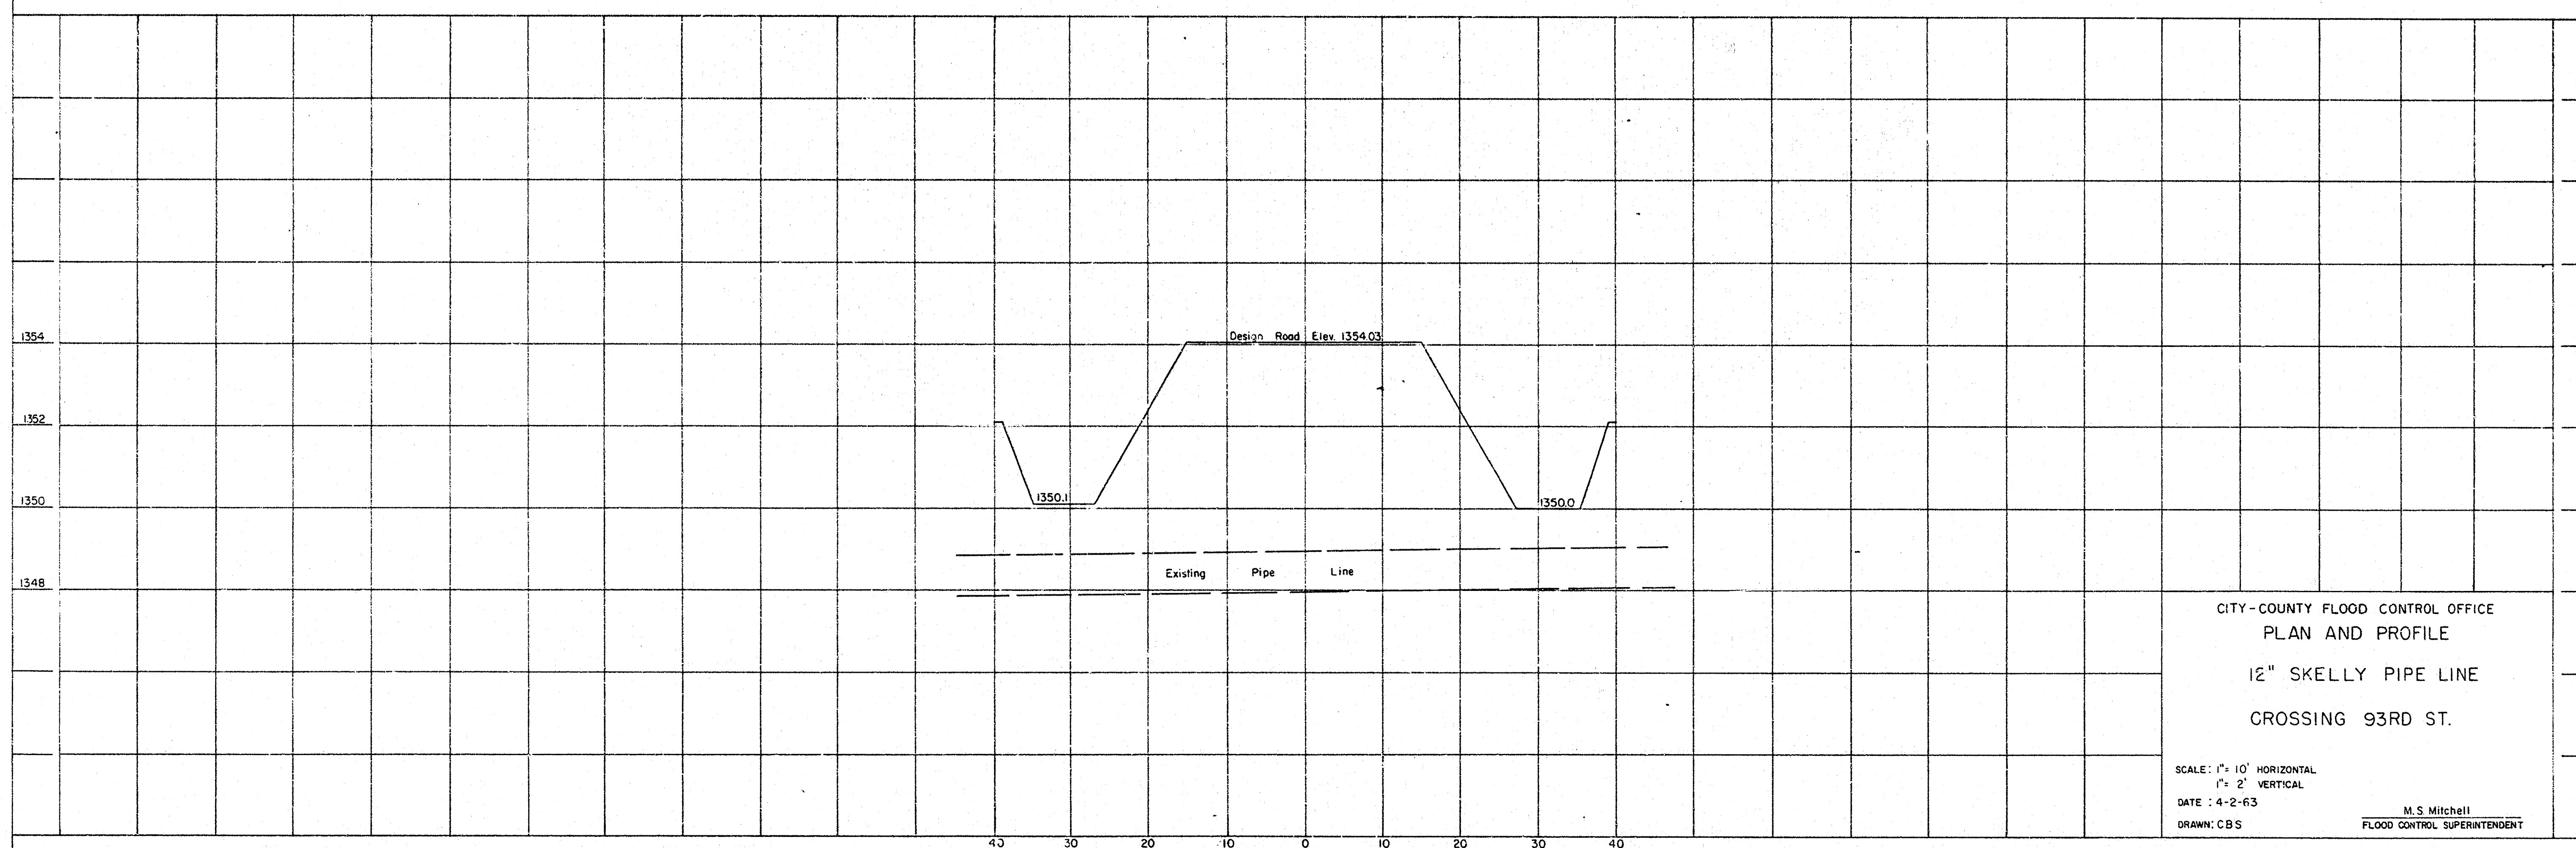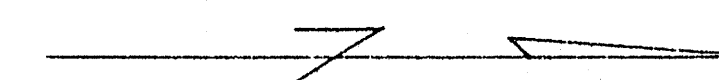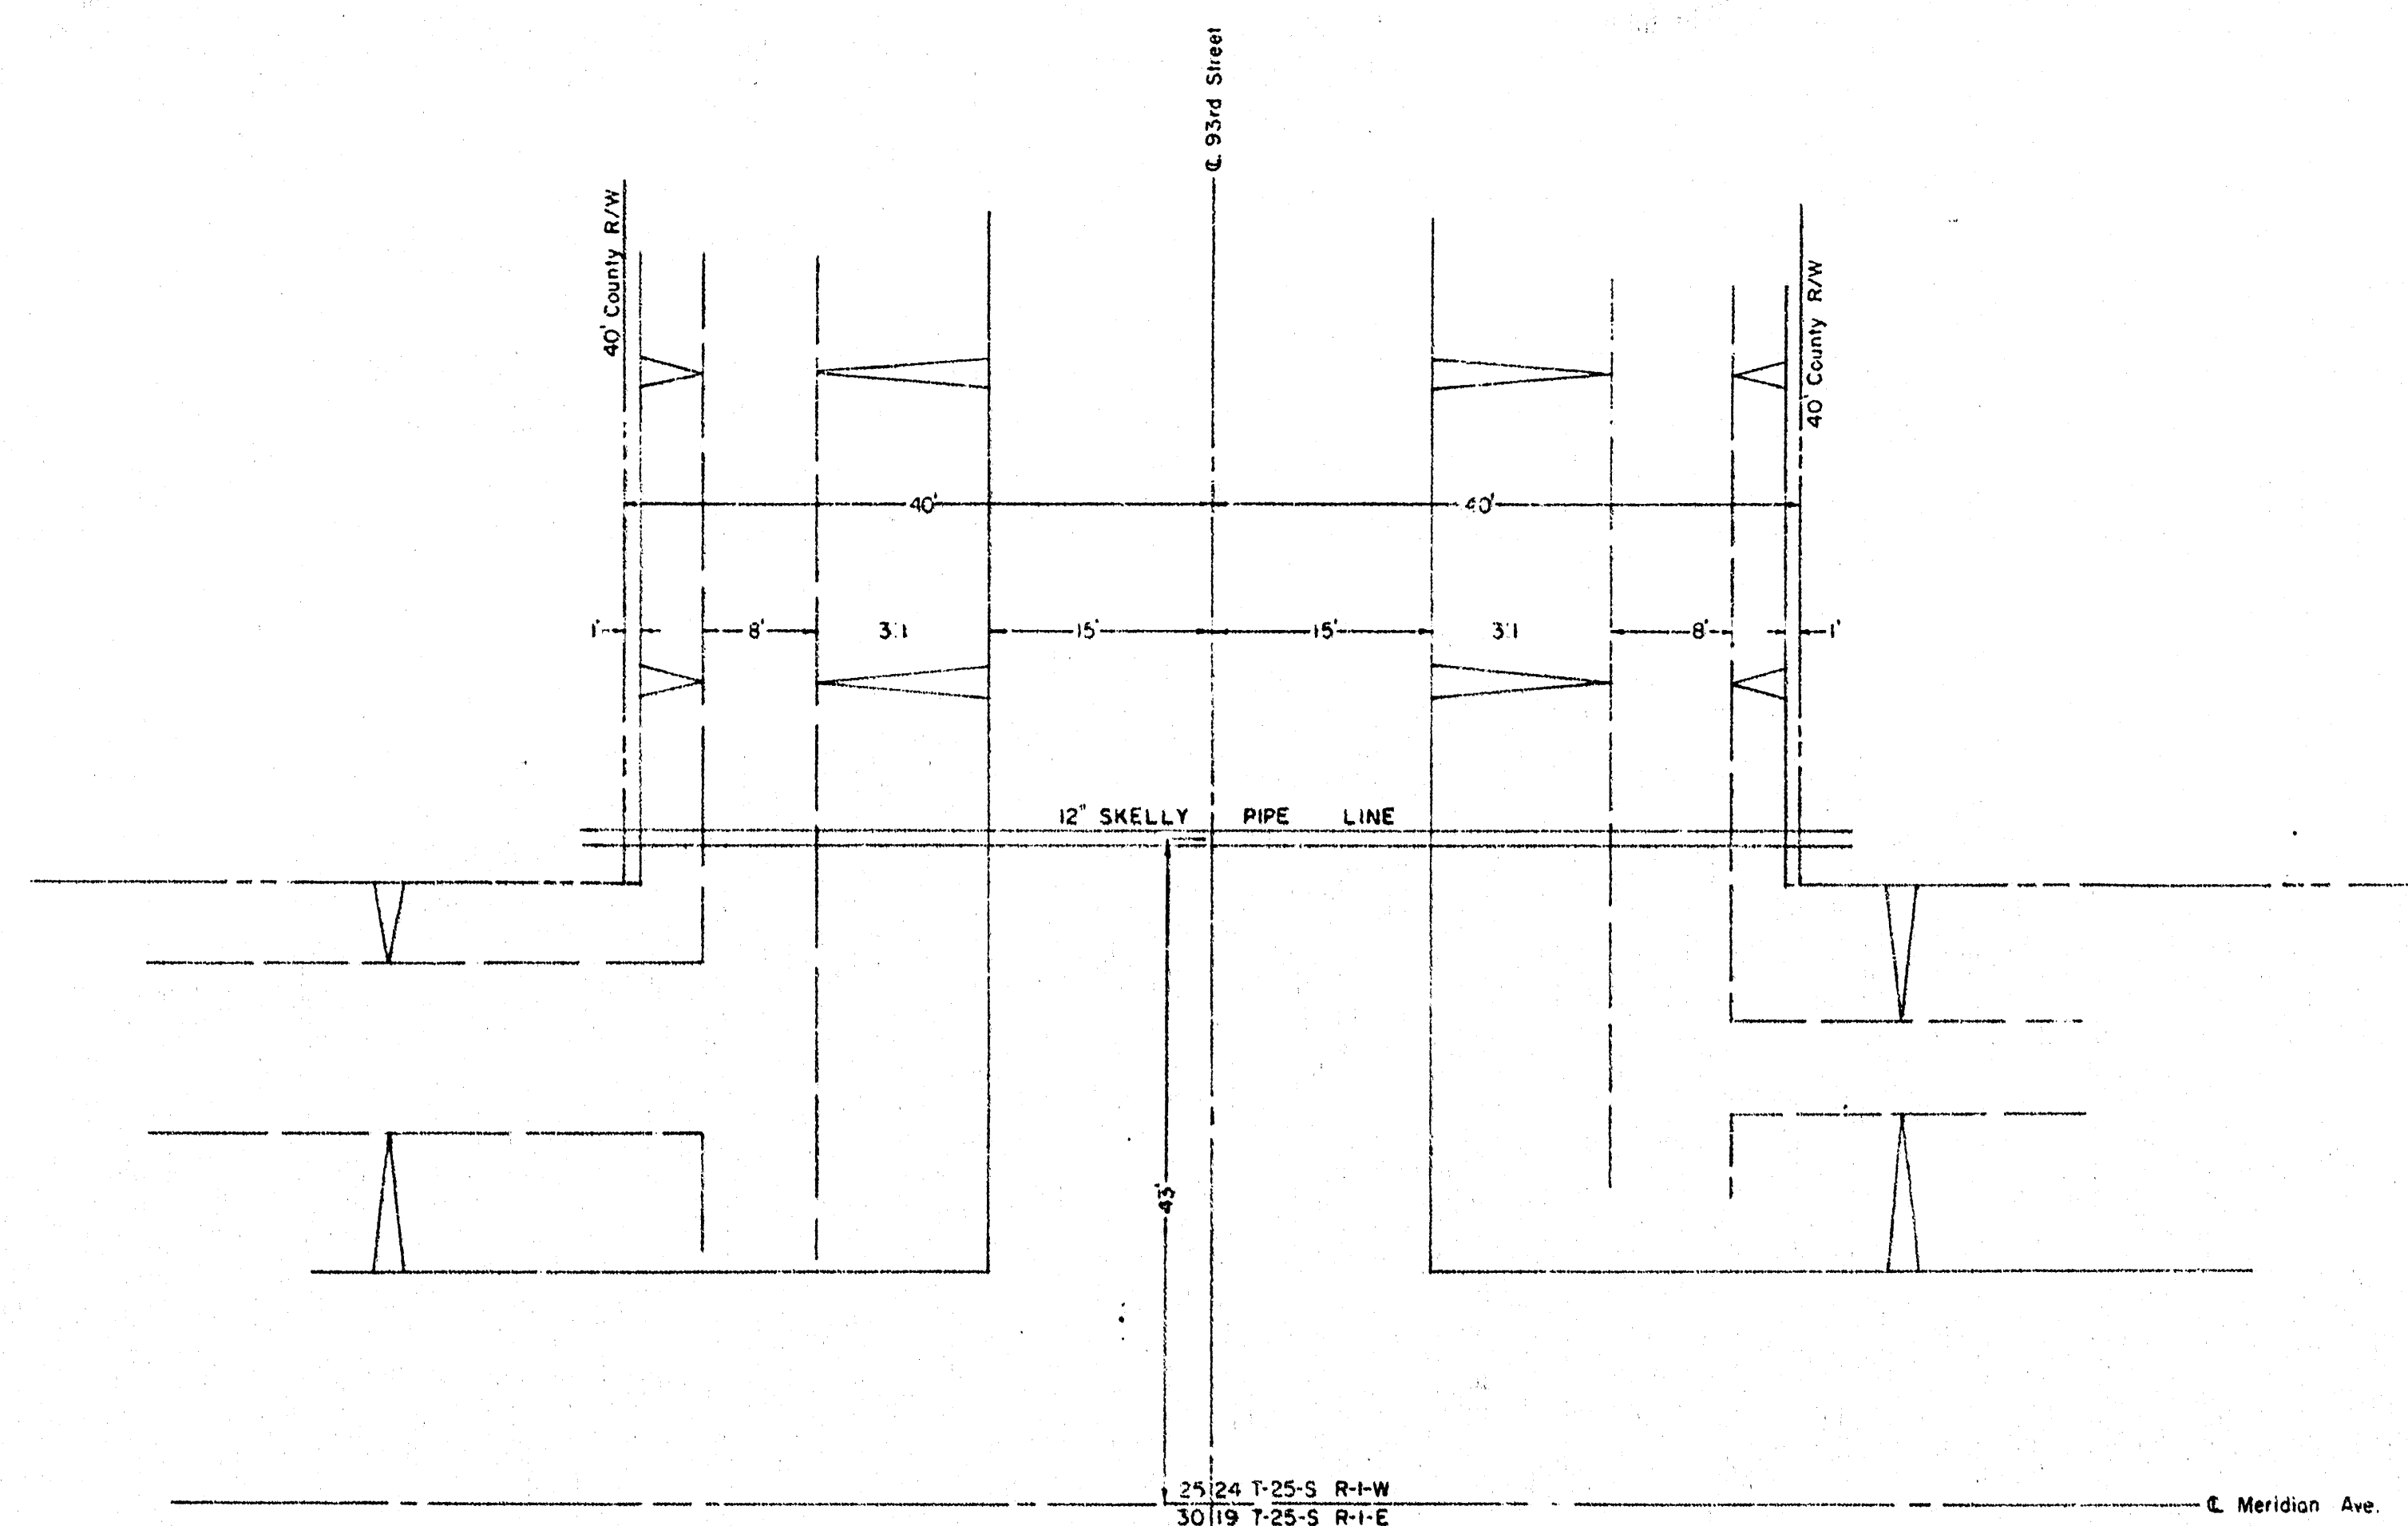

CITY-COUNTY FLOOD CONTROL OFFICE
PLAN AND PROFILE
12" SKELLY PIPE LINE
CROSSING 93RD ST.

SCALE: 1" = 10' HORIZONTAL
1" = 2' VERTICAL
DATE: 4-2-63
DRAWN: C.B.S.

M.S. Mitchell
FLOOD CONTROL SUPERINTENDENT

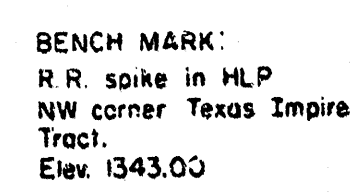




CITY-COUNTY FLOOD CONTROL OFFICE
PLAN AND PROFILE
PROPOSED RELOCATION
10" SKELLY PIPE LINE
CROSSING 77TH ST.

SCALE: 1" = 10' HORIZONTAL
1" = 2' VERTICAL
DATE: 4-4-63
DRAWN: CBS

M. S. Mitchell
FLOOD CONTROL SUPERINTENDENT

BENCH MARK:
R.R. Spike in R.L.P.
NW corner Texas Impire
tract.
Elev. 1343.00

NOTE:
Pipe line crosses 77th
street 875.72' west of
the north 1/4 corner
Section 6, T-26-S R-1-E

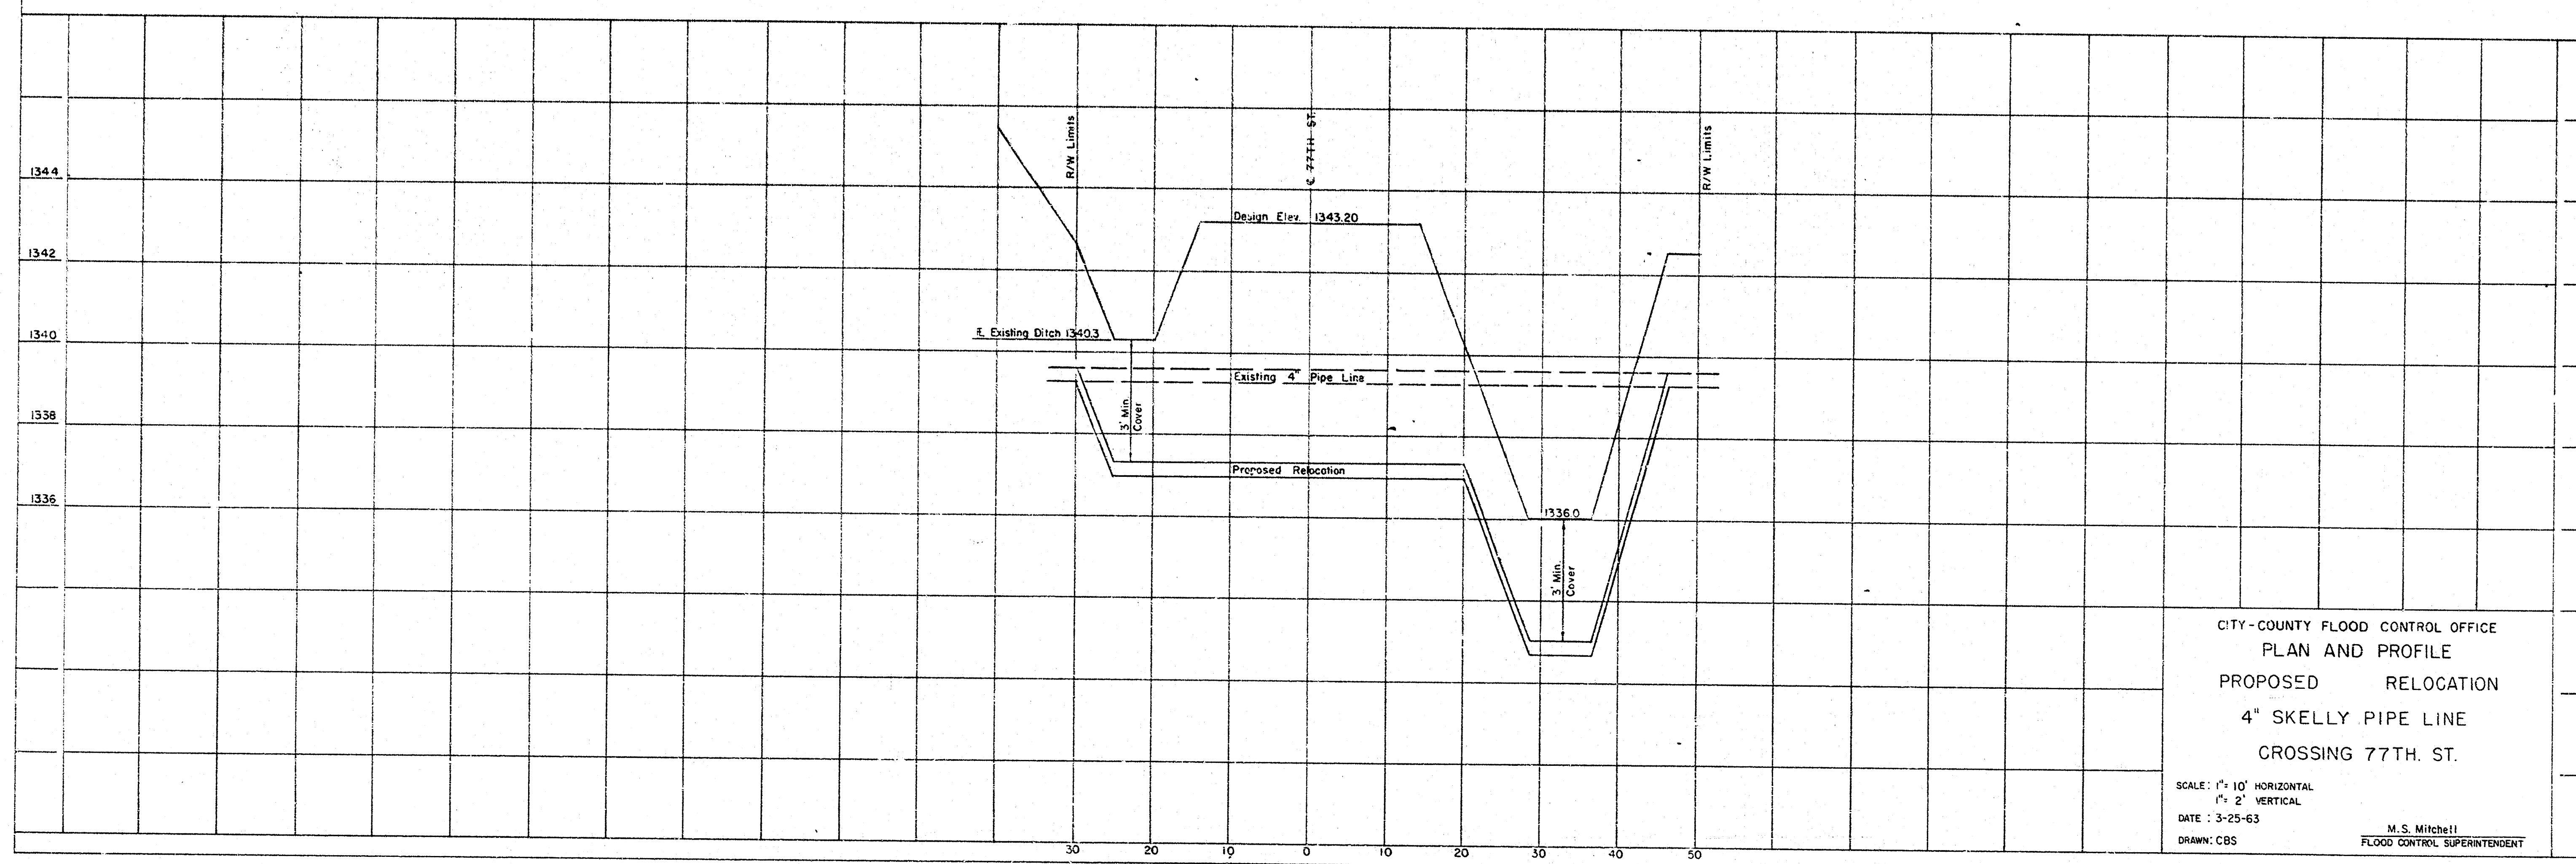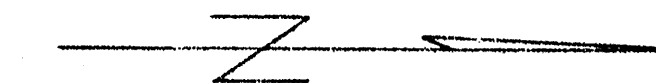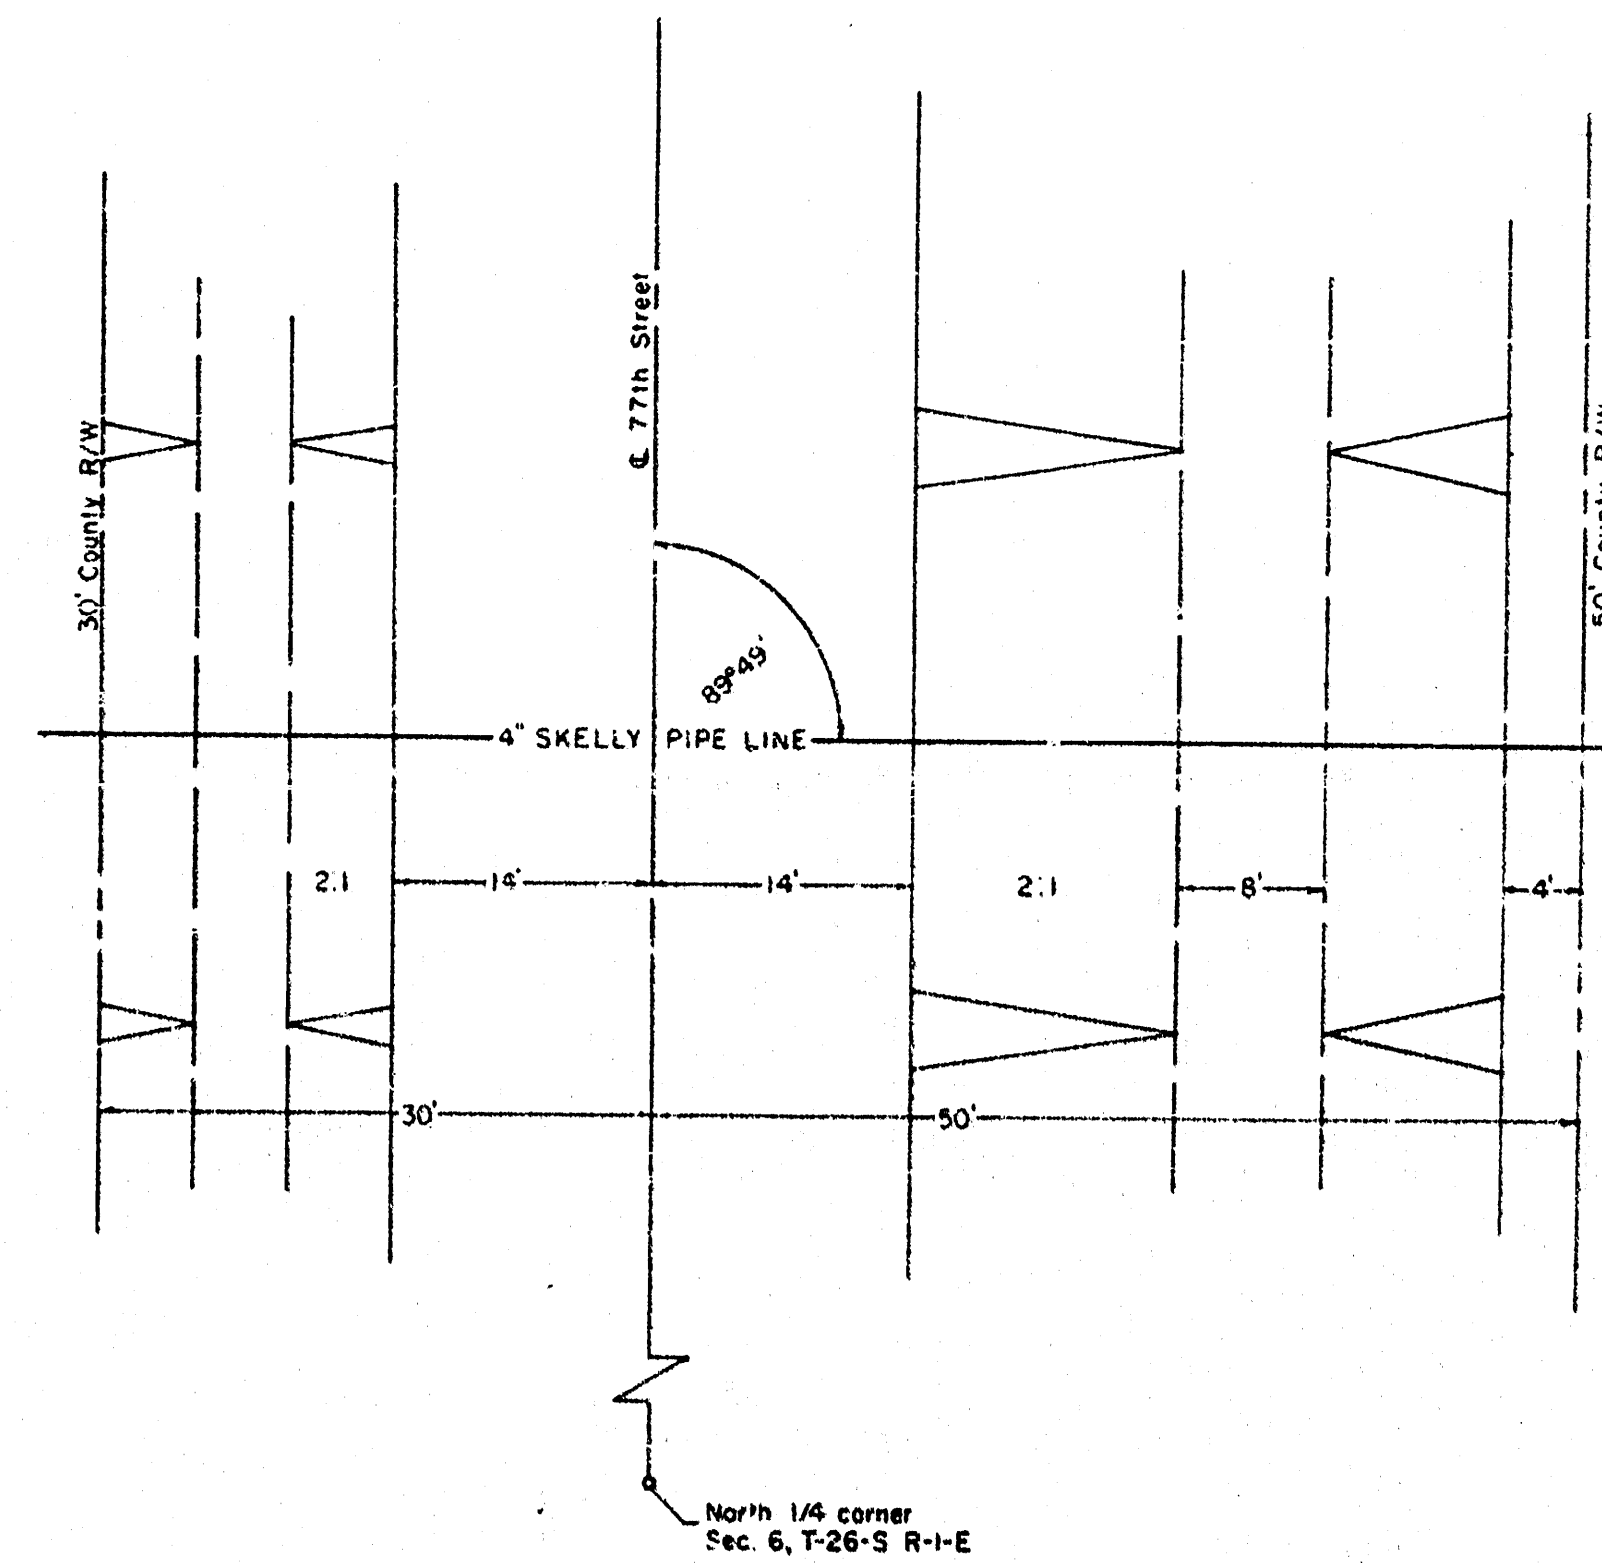

CITY-COUNTY FLOOD CONTROL OFFICE
PLAN AND PROFILE
PROPOSED RELOCATION
4" SKELLY PIPE LINE
CROSSING 77TH ST.

SCALE: 1" = 10' HORIZONTAL
1" = 2' VERTICAL
DATE: 3-25-63
DRAWN: CBS

M. S. Mitchell
FLOOD CONTROL SUPERINTENDENT

