



PLAN
 1. Scale
 2. Date
 3. Name
 4. Title
 5. Location
 6. Notes

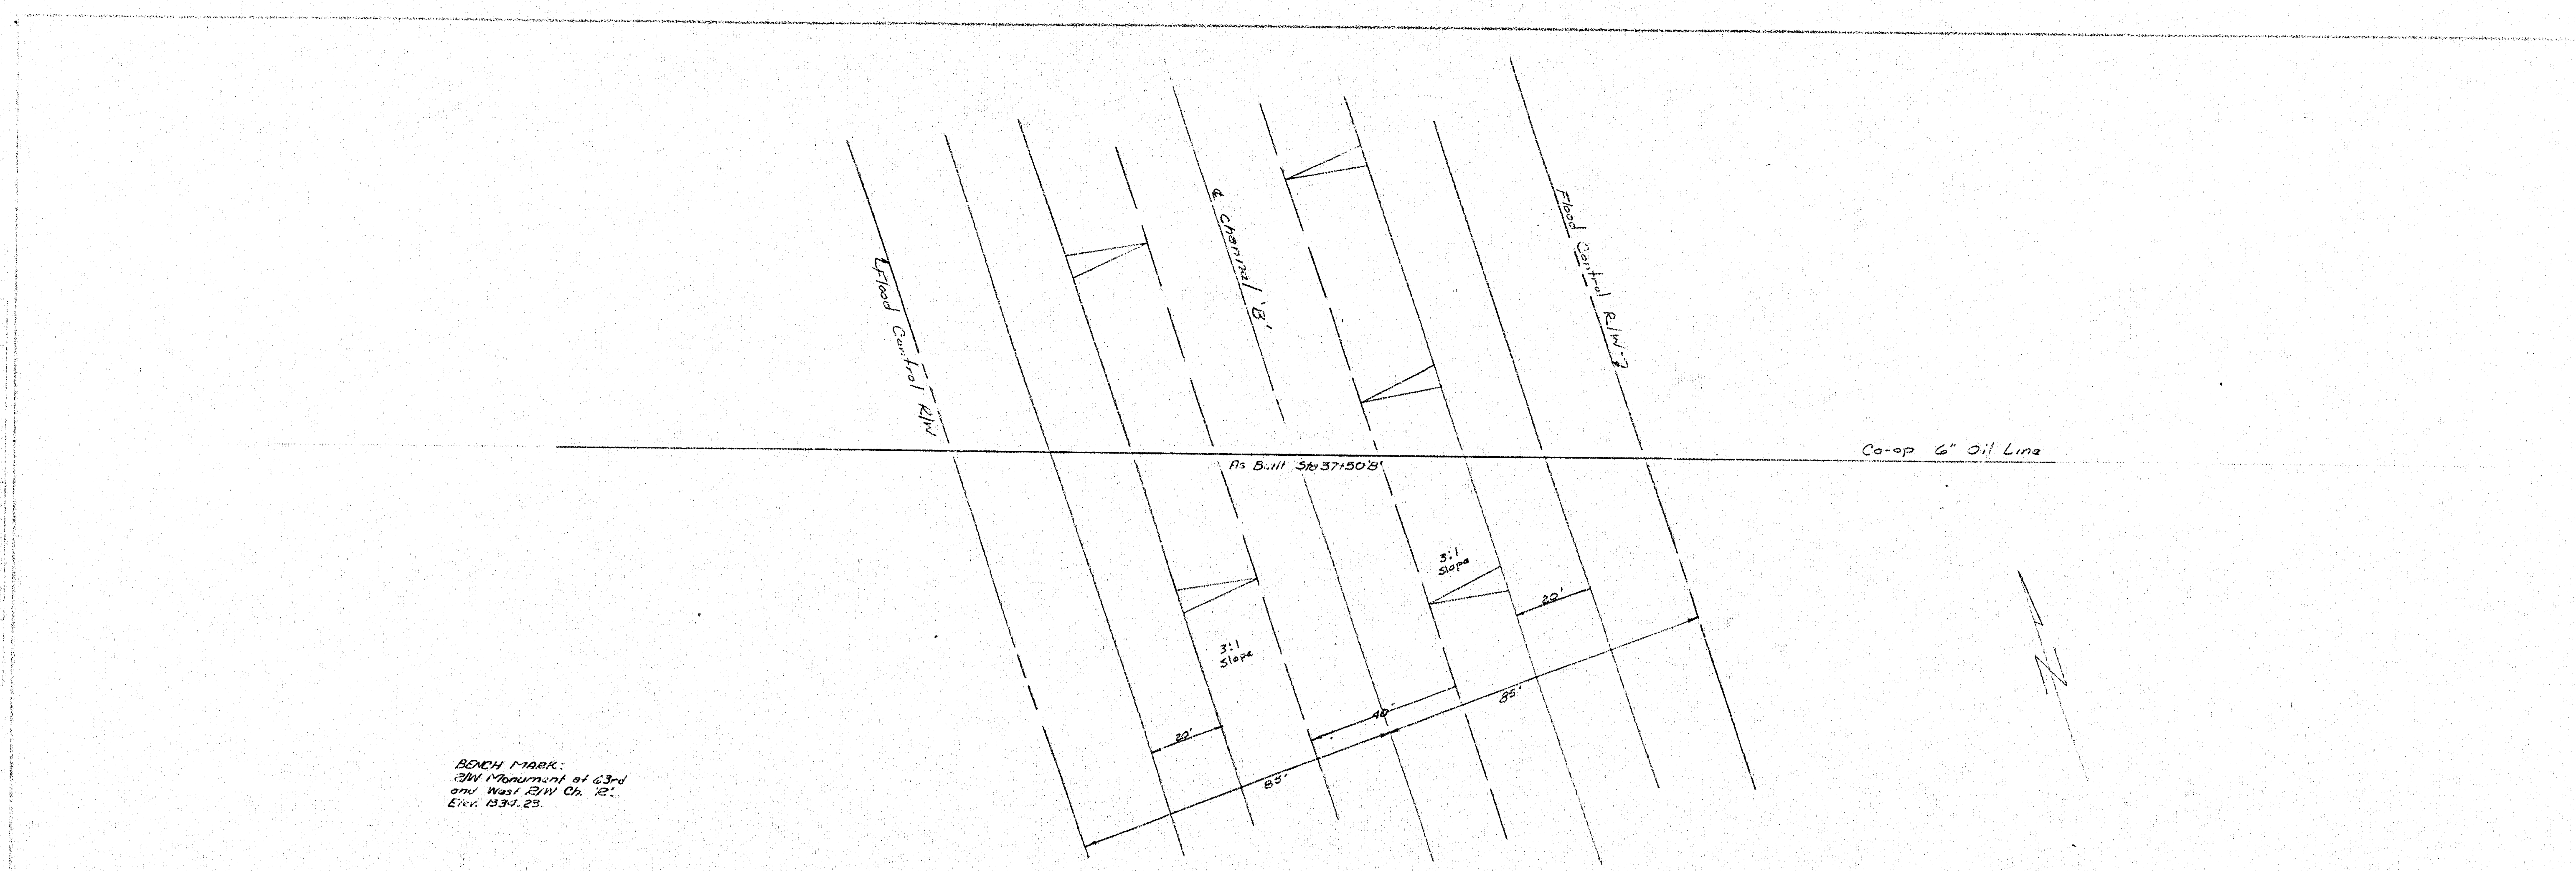



BENCH MARK:
 2nd Monument at 63rd
 and West 2nd St. 12.
 Elev. 1331.25

PROFILE
 1. Scale
 2. Date
 3. Name
 4. Title
 5. Location
 6. Notes

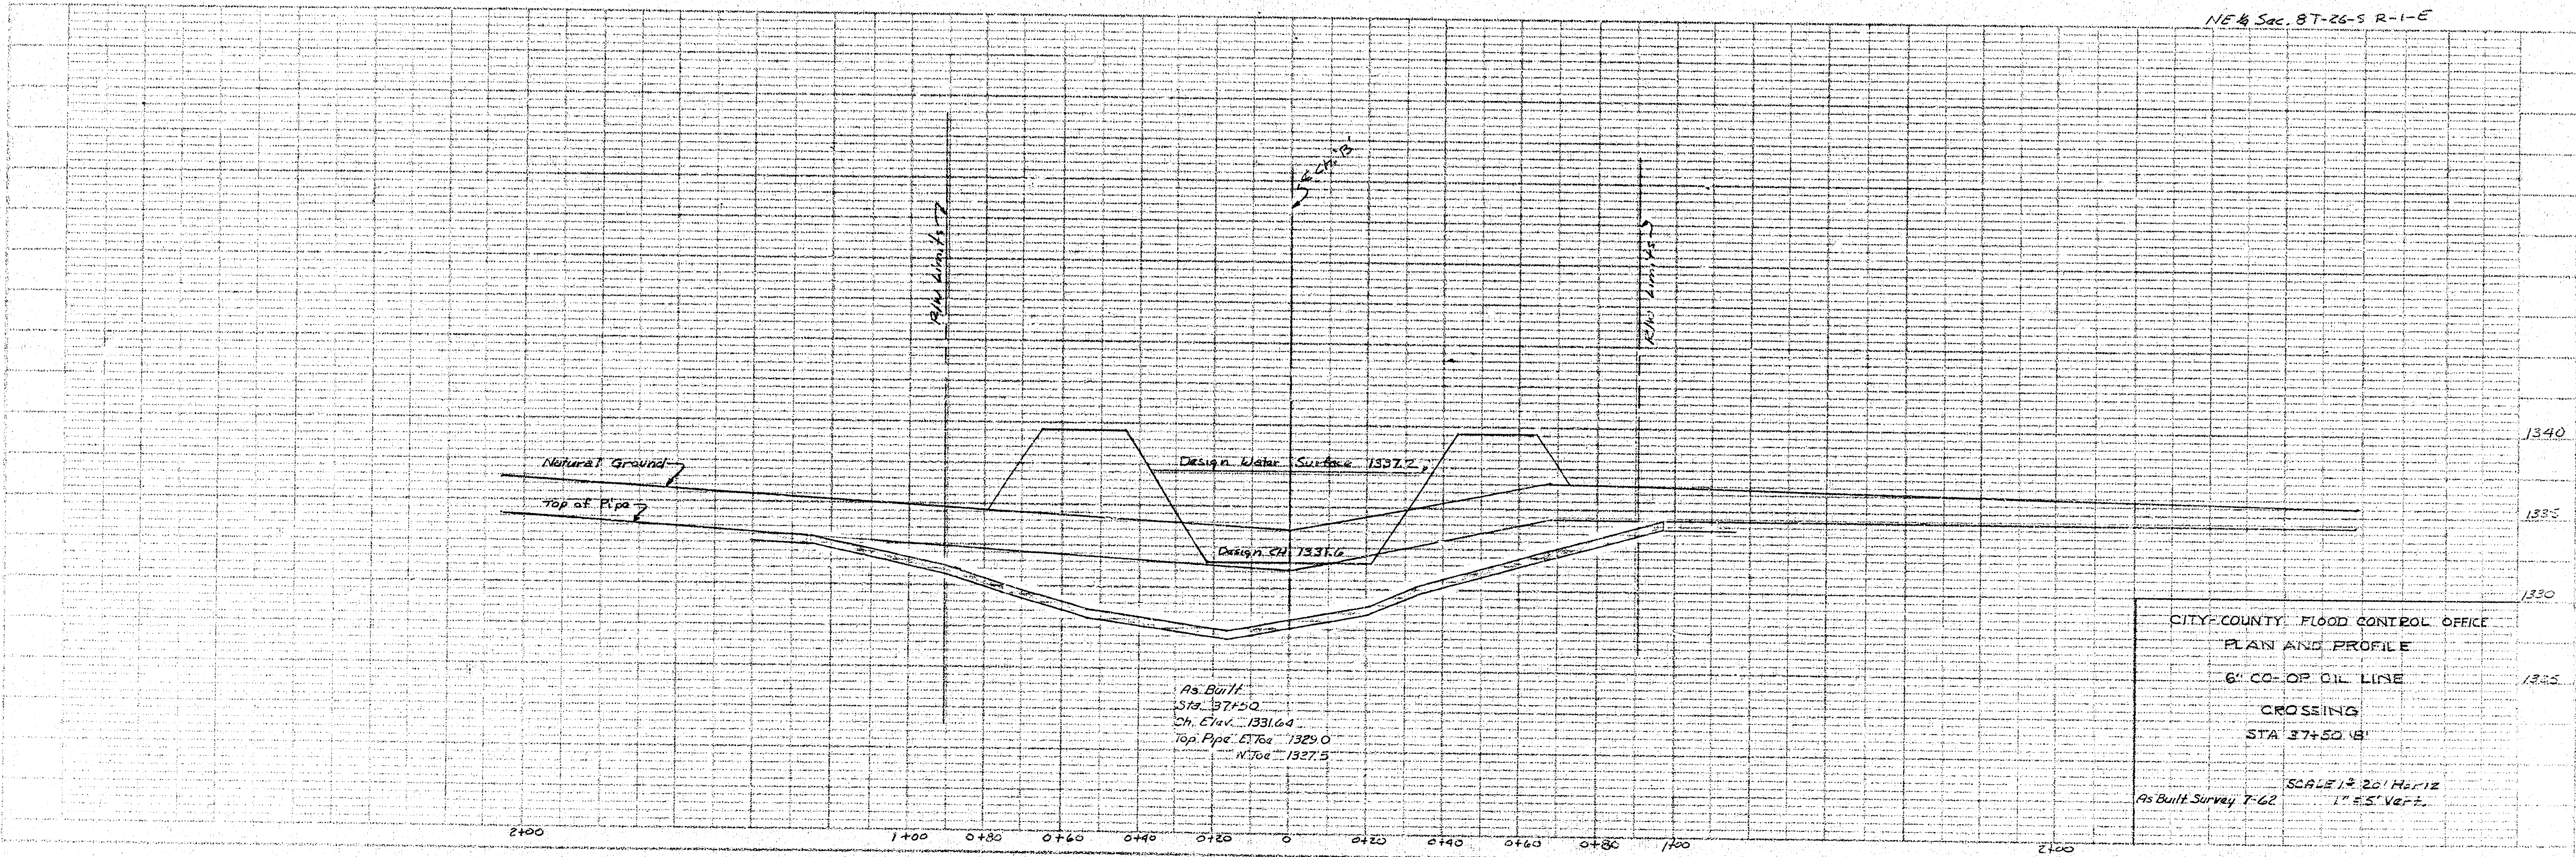

CITY-COUNTY FLOOD CONTROL OFFICE
 PLAN AND PROFILE
 6" CO-OP OIL LINE
 CROSSING
 STA 37+50.18'
 SCALE: 1" = 20' Horiz
 1" = 5' Vert.
 As Built Survey T-62

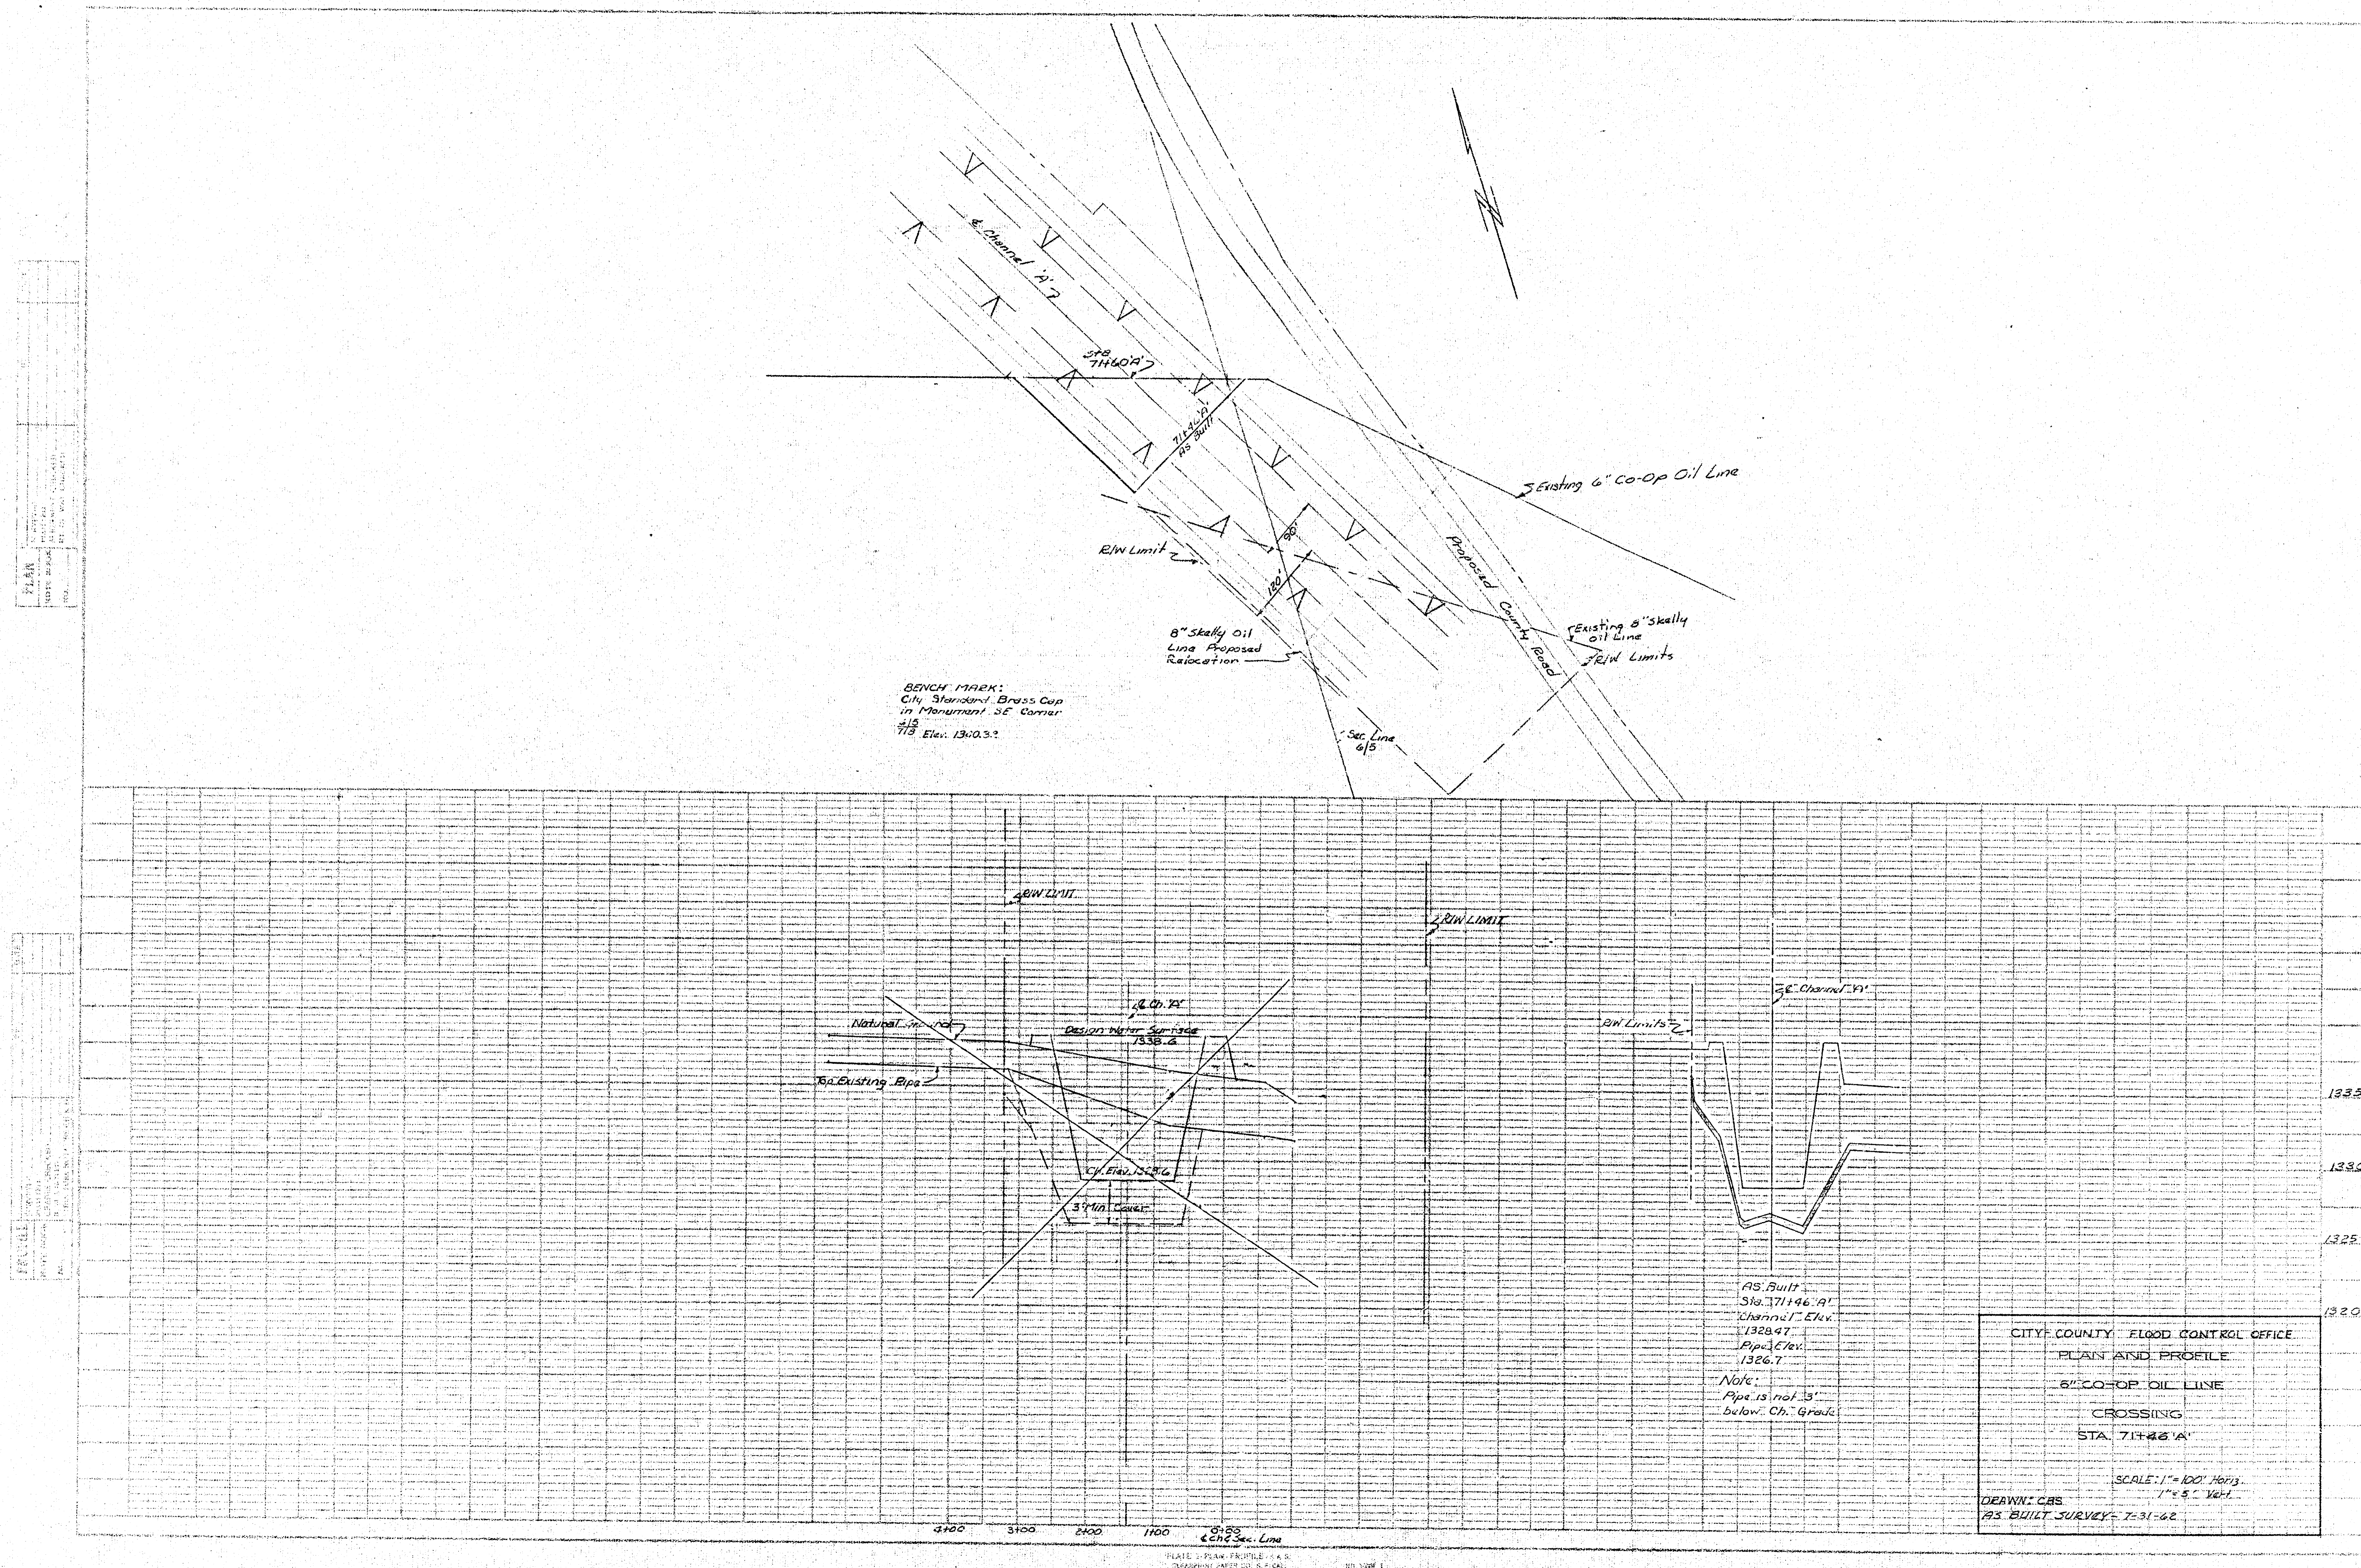

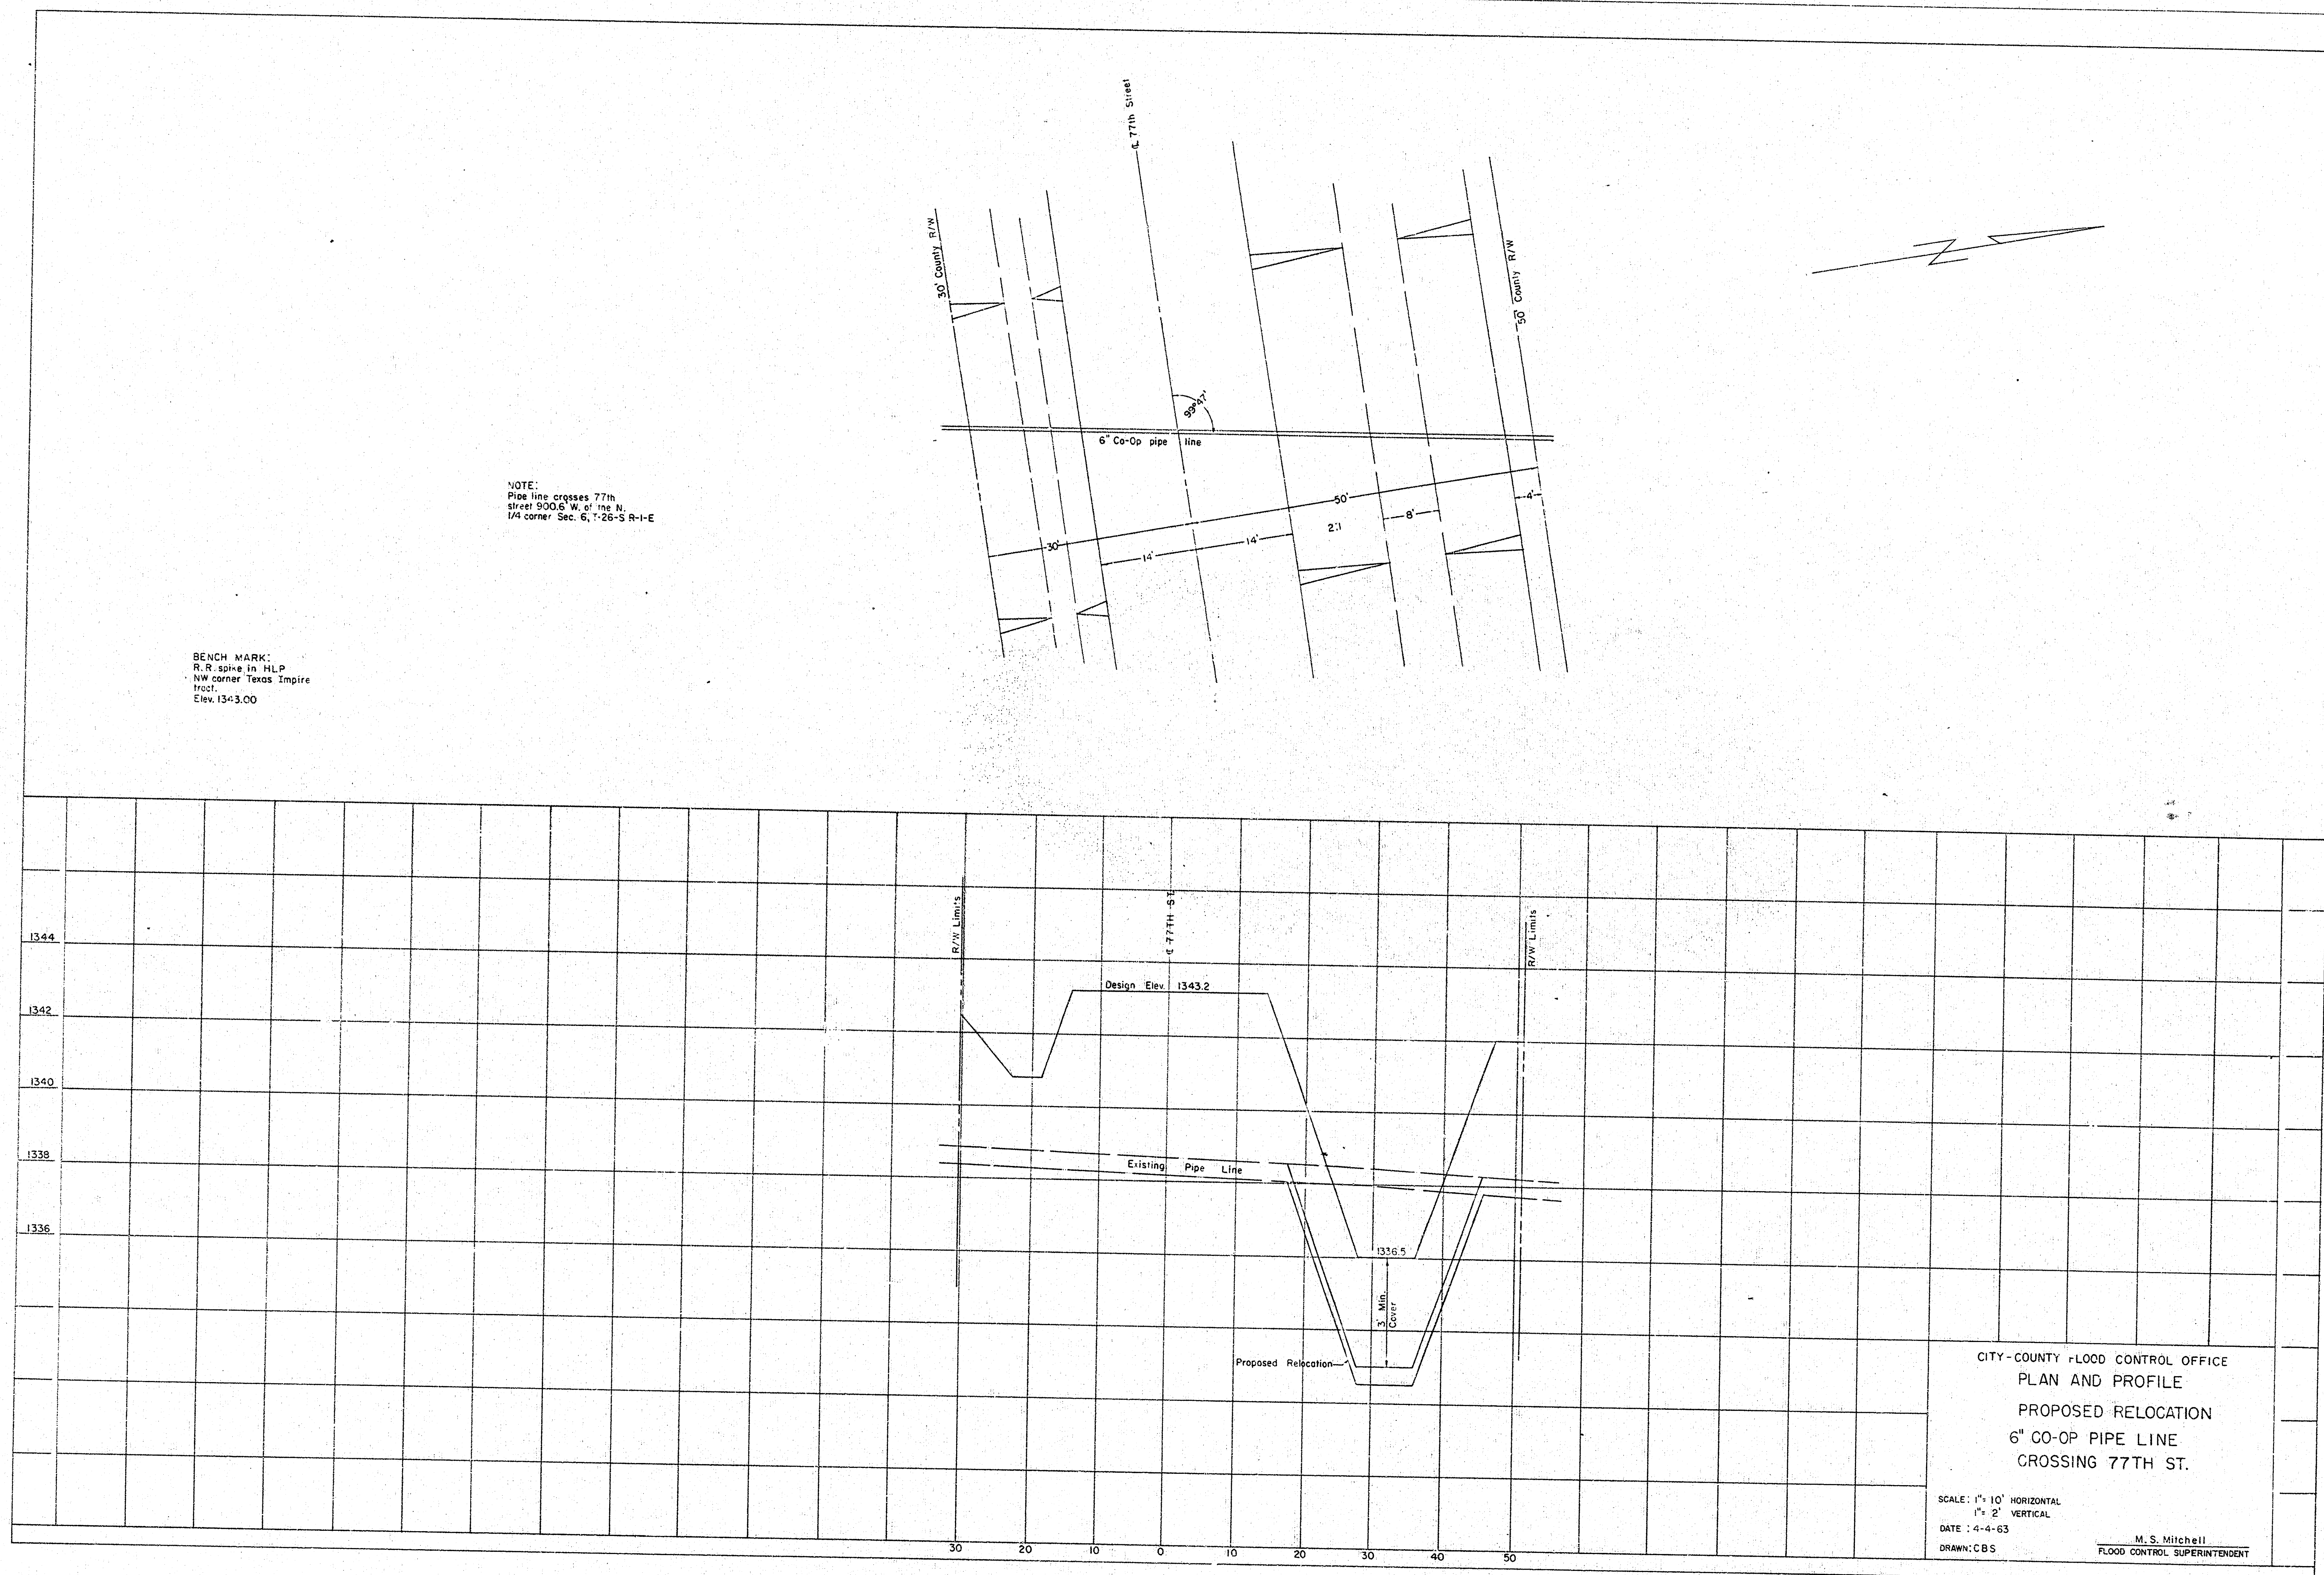

PLAN	DATE	BY
	3/12/54	W.H. HARRIS
NOTE BOOK	ALIGNED CURVE	
	PT. OF WAY CURVE	
NO. 16		

PROFILE	DATE	BY
	3/12/54	W.H. HARRIS
NOTE BOOK	ALIGNED CURVE	
	PT. OF WAY CURVE	
NO. 16		

