


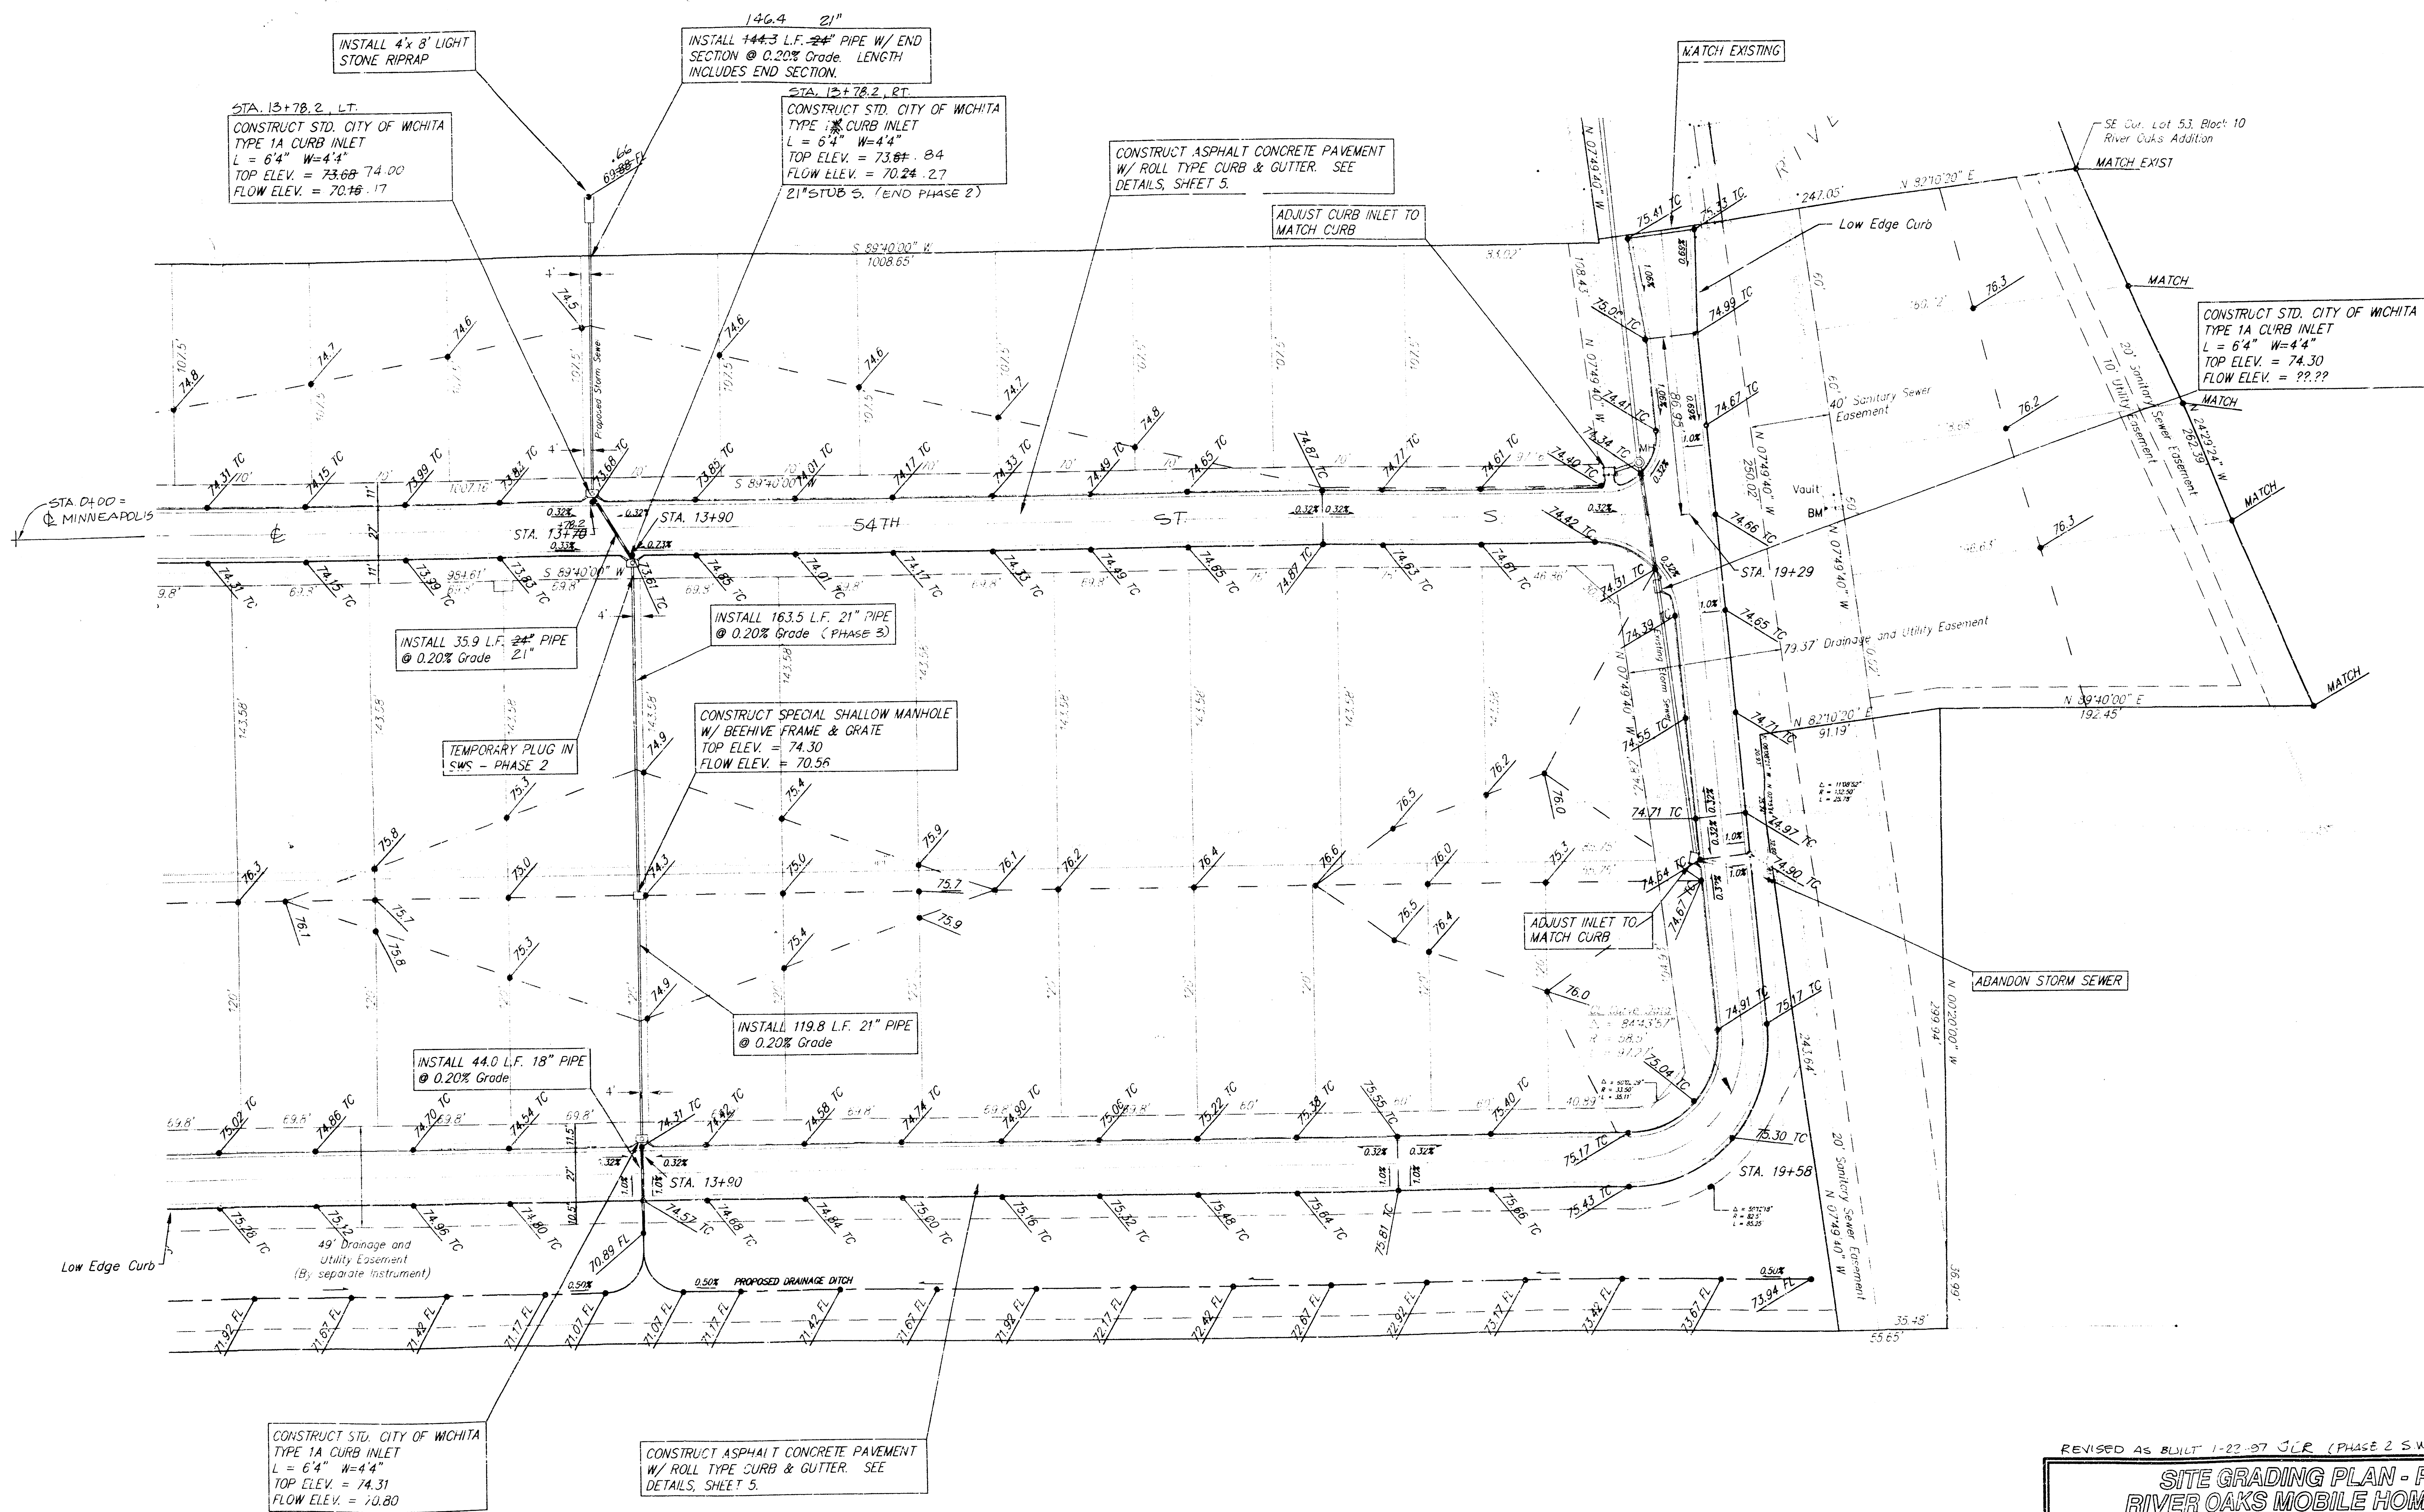

NOTE: Low edge curb to be constructed on the south side of
Campus and east side of Spruce. See detail, Sheet 5.

REVISED AS BUILT 1-22-97 J.L.P. (PHASE 2 SWS ONLY)					
SITE GRADING PLAN - PHASE II RIVER OAKS MOBILE HOME PARK WICHITA, KANSAS					
SRB		315-284-3308 FAX 315-284-4621		REVISED	
SAVOY, RUGGLES & BOHM, P.A.		ENGINEERING & SURVEYING		2	
PROJECT NUMBER					
DRAWN K.M.	DESIGN K.M.	REVIEW	DATE 7-12-95	UTILITY	SHEET NO. 5312
					5