

**GENERAL NOTES:**

**CHANNEL CHANNEL EXCAVATIONS:** ALL COMMON EXCAVATION SHALL BE UNCLASSIFIED. THE CONTRACTOR SHALL REMOVE ALL SUBSTANCES ENCOUNTERED IN EXCAVATING TO THE REQUIRED ELEVATION AND GRADE. NO SEPARATE PAYMENT WILL BE MADE FOR UNCLASSIFIED EXCAVATION REGARDLESS OF THE NATURE OR CONDITION OF THE CHANNEL.

**EMBANKMENT ENHANCEMENTS:** THE CONTRACTOR SHALL CONSTRUCT THE EMBANKMENTS TO THE DESIGN AT THE ABUTMENTS AS SHOWN ON SHEET NO. 3 AND ON THE CONTRACT DRAWINGS PRIOR TO CONSTRUCTION OF THE BRIDGE.

**EXCAVATION:** ALL BRIDGE EXCAVATION SHALL BE CLASS III. SEE SHEET NO. 3 FOR LIMITS OF EXCAVATION.

**GENERAL INFORMATION:** INFORMATION SHOWN ON SHEET NO. 3 IS AS OBTAINED FROM SURVEYS MADE IN THE FIELD BY ENGINEERING TESTING COMPANY, AND REPRESENTS THE BEST INFORMATION AVAILABLE TO THE CITY OF WICHITA.

**PILE PILES:** SHALL BE 12" PRESTRESSED CONCRETE PILES IN PIERS AND 10" PILES IN ABUTMENTS AS DESCRIBED AND DETAILED ON SHEET NO. 8. PILES SHALL BE DRIVEN TO THE PENETRATION SHOWN UNLESS IN THE OPINION OF THE ENGINEER SUCH PENETRATION CANNOT BE SECURED WITHOUT INJURY TO THE PILES. ALL PILES SHALL BE DRIVEN TO A MINIMUM COMPUTED BEARING CAPACITY OF 40 TONS PER PILE IN ABUTMENTS, 35 TONS PER PILE IN PIERS.

**PILE DRIVING:** ALL PILES SHALL BE DRIVEN WITH A STEAM OR DIESEL HAMMER. IF A PORTABLE HAMMER IS USED, SUFFICIENT HAMMER DATA SHALL BE PROVIDED TO THE ENGINEER BY THE ENGINEER BEFORE DRIVING STARTS.

**CONCRETE:** CLASS AAA(AE) CONCRETE SHALL BE USED IN THE BRIDGE AND APPROACH SLABS. CLASS A(AE) CONCRETE SHALL BE USED IN RETAINING WALLS, SIDEWALKS AND CONCRETE RIPRAP. BEVEL ALL EXPOSED EDGES WITH A 3/4" TRIANGULAR MOLDING UNLESS OTHERWISE NOTED.

**REINFORCING STEEL:** ALL DIMENSIONS RELATIVE TO REINFORCING STEEL PLACEMENT ARE TO CENTERLINE OF BARS UNLESS OTHERWISE NOTED. ALL DIMENSIONS SHOWN IN BENDING DIAGRAMS ARE OUT TO OUT OF BARS.

**DECK TREATMENT:** SIDEWALKS, RIPRAP AND APPROACH SLABS SHALL BE CURED WITH LINSEED OIL EMULSION, IN ACCORDANCE WITH THE SUPPLEMENTAL SPECIFICATIONS. BRIDGE DECK SHALL RECEIVE A WEARING COURSE CONSISTING OF LATEX MODIFIED CONCRETE. THICKNESS TO BE 1 1/4 INCHES. (SEE SUPPLEMENTAL SPECIFICATIONS.)

**FALSEWORK AND FORMING:** FALSEWORK UNDER SUPERSTRUCTURE, INCLUDING THE SIDEWALK SLABS, SHALL BE LEFT IN PLACE UNTIL THE CONCRETE SHALL HAVE ATTAINED ITS DESIGN STRENGTH; BUT IN NO CASE SHALL THE FALSEWORK BE REMOVED BEFORE 14 DAYS AFTER PLACING CONCRETE. TRAFFIC RAILS MAY BE PLACED AFTER FALSEWORK IS REMOVED. CAMBER SHALL BE PROVIDED IN THE AMOUNTS SHOWN ON THE DEAD-LOAD CAMBER DIAGRAM.

**APPROACH SLABS:** THE ITEM "APPROACH SLAB" INCLUDES FINE GRADING, AND BURNISHING, FORMING, PLACING AND FINISHING ALL CONCRETE AND REINFORCING STEEL REQUIRED FOR ONE APPROACH SLAB AT EACH END OF THE BRIDGE, AS DETAILED ON SHEET NO. 6.

**STEEL HANDRAIL:** STEEL FOR HANDRAIL SHALL CONFORM TO ASTM A-501, STRUCTURAL STEEL TUBING; BASE PLATES AND CLIP ANGLES TO BE ASTM A-36 STEEL. PAY LENGTH FOR HANDRAIL IS CENTER TO CENTER OF END POSTS. POSTS SHALL SET VERTICALLY IN THE TRANSVERSE DIRECTION, AND PERPENDICULAR TO THE GRADE LONGITUDINALLY. STEEL HANDRAIL SHALL BE MAINTAINED IN ACCORDANCE WITH THE STANDARD SPECIFICATIONS (LEAD SILICO-CHROMATE SYSTEM).

**SPECIAL CONCRETE FINISH:** SEE THE SUPPLEMENTAL SPECIFICATIONS FOR DETAILS AND LIMITS OF THE SPECIAL CONCRETE FINISH.


**QUANTITIES:** ALL QUANTITIES SHOWN ON THESE PLANS SHALL BE USED AS FINAL PAY QUANTITIES EXCEPT THAT MEASUREMENT OF PILING, COMMON EXCAVATION AND COMPACTION OF EARTHWORK SHALL BE IN ACCORDANCE WITH THE SPECIFICATIONS.

**GENERAL REQUIREMENTS:** IT IS THE INTENTION OF THESE PLANS AND SPECIFICATIONS THAT CONSTRUCTION OF THE BRIDGE SHALL BE IN ACCORDANCE WITH APPLICABLE STANDARD SPECIFICATIONS AND REQUIREMENTS OF THE KANSAS DEPARTMENT OF TRANSPORTATION AND THAT MATERIALS SHALL CONFORM TO THESE SPECIFICATIONS UNLESS OTHERWISE NOTED.

**DESIGN LOADING:** HS20-44 A.A.S.H.T.O. SPEC. (1973 EDITION)

**UNIT STRESSES**  
 f'c - 4,000 P.S.I. CLASS AAA(AE)  
 f'c - 3,000 P.S.I. CLASS A(AE)  
 f'c - 1,600 P.S.I. CLASS AA(AE)  
 f'c - 1,200 P.S.I. CLASS A(AE)  
 f's - 20,000 P.S.I. (REINFORCING)


**DESIGN PILE LOADING:** 35 TONS PER PILE (ABUT.)  
 40 TONS PER PILE (PIER)

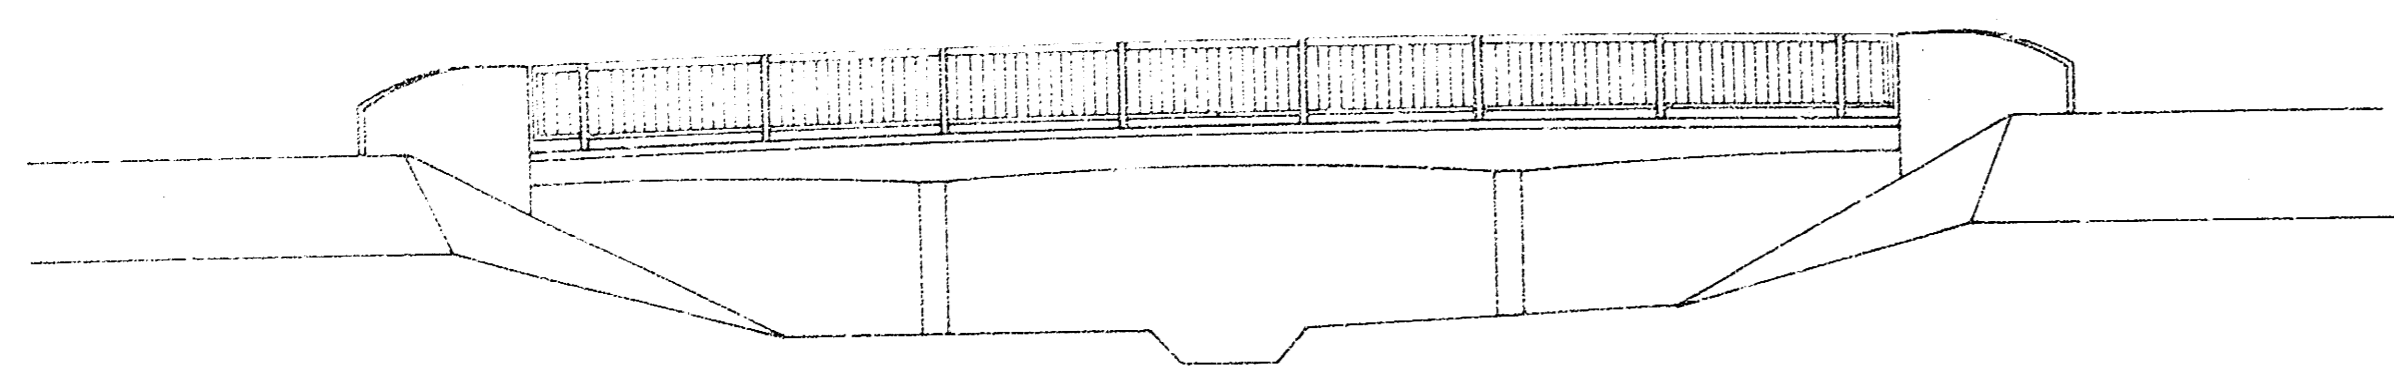

19'-26'-19' R.C. SLAB SPANS

SUMMARY OF PROJECT QUANTITIES		
BRIDGE QUANTITIES		
ITEM	QUANTITY	UNIT
CLASS III EXCAVATION	105	Cu. Yds.
CLASS AAA(AE) CONCRETE	198.2	Cu. Yds.
REINFORCING STEEL	43,820	LBS.
STEEL PILING (10")	<del>280</del> 296.9	LIN. FT.
PRESTRESSED CONCRETE PILING (12")	<del>300</del> 311.8	LIN. FT.
STEEL HANDRAIL	114	LIN. FT.
APPROACH SLABS	2	EACH
ELECTRIC LIGHTING	LUMP SUM	L.S.
SPECIAL CONCRETE FINISH	<del>111</del> 121.6	Sq. Yds.
LATEX SURFACE COURSE (1 1/4")	325.1	Sq. Yds.
GRADING QUANTITIES		
ITEM	QUANTITY	UNIT
REMOVAL OF EXISTING STRUCTURES	LUMP SUM	L.S.
LARGE TREES	20	EACH
COMMON EXCAVATION (CH.CH.)	1,040	Cu. Yds.
COMMON EXCAV. (CONTR. FURN.)	1,520	Cu. Yds.
COMPACTION OF EARTHWORK	2,020	Cu. Yds.
CLASS A(AE) CONCRETE	9.9	Cu. Yds.
REINFORCING STEEL	720	LBS.
CHAIN LINK FENCE	60	LIN. FT.
CONCRETE RIPRAP (5")	<del>587</del> 577.8	Sq. Yds.
GROUTED STONE DITCH LINING	61	Sq. Yds.
12" STORM SEWER (B.C.C.M.P.)	22	LIN. FT.

VASSAR STREET BRIDGE  
 OVER  
 SLEEPY HOLLOW CREEK  
 PROJECT NO. DAKS 574105

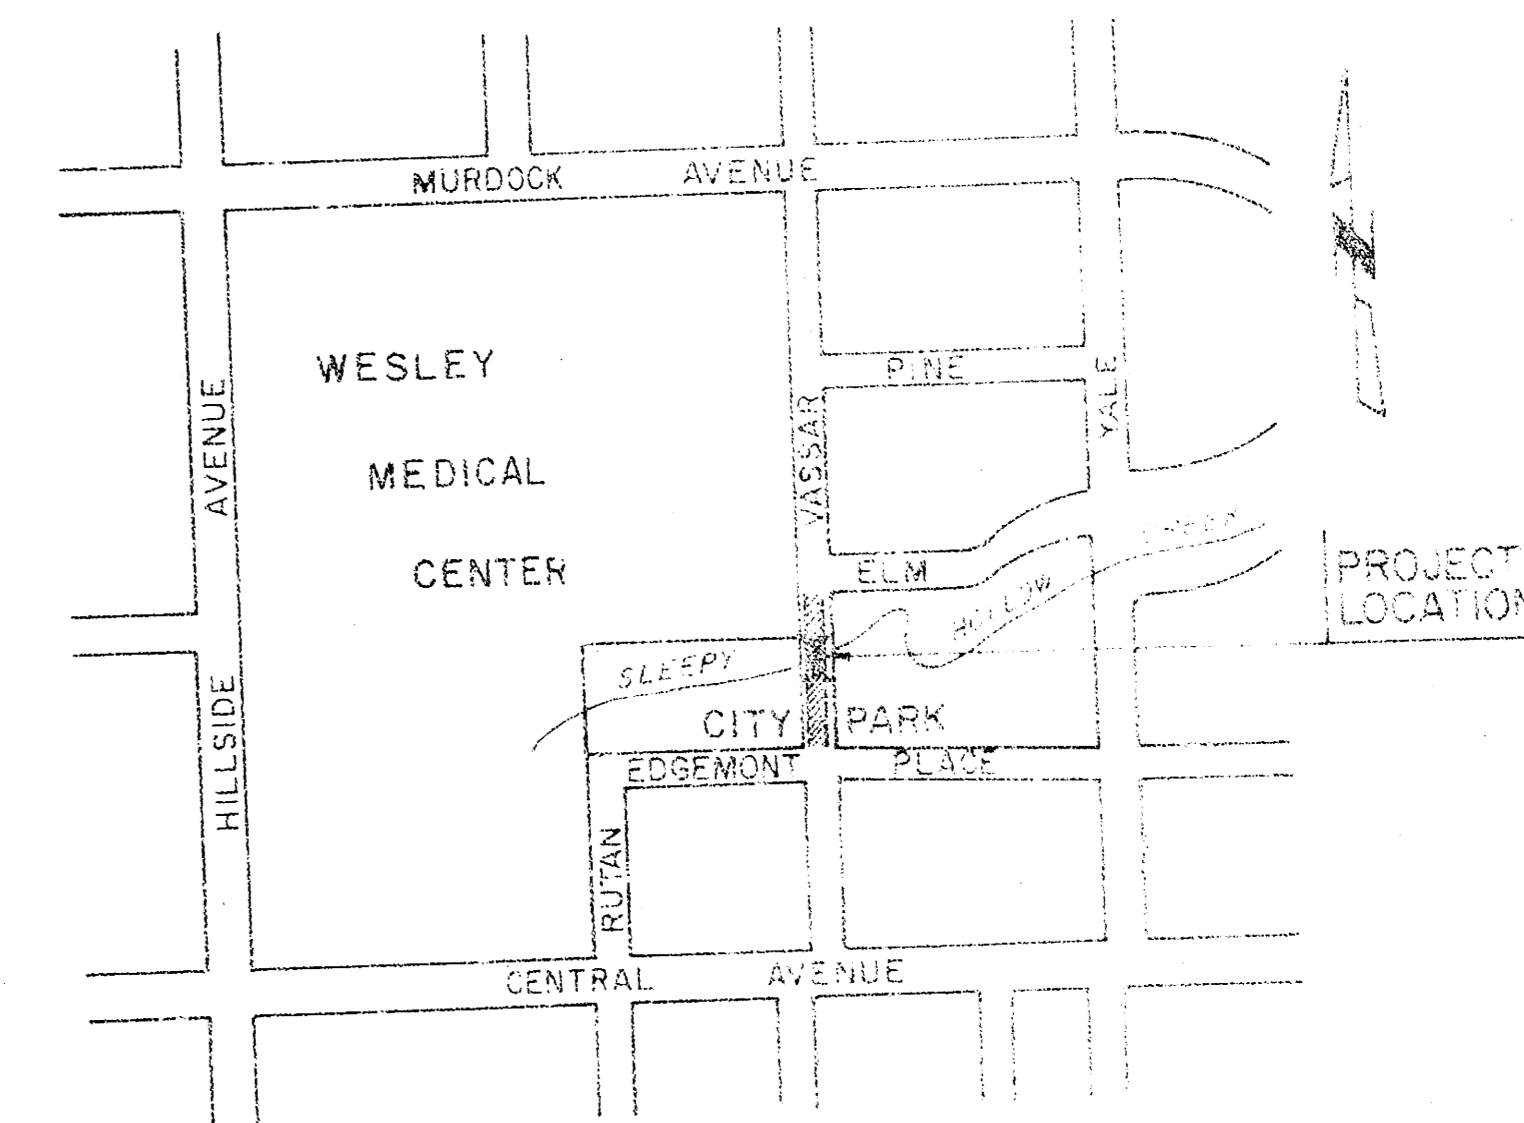


VICINITY MAP

CITY OF WICHITA  
 DEPARTMENT OF PUBLIC WORKS  
 R.W. BRUGGEMAN, P.E. DIRECTOR OF PUBLIC WORKS  
 R.W. LINN, P.E. CITY ENGINEER

DELAMATER, FREUND & SCHERER, P.A.  
 ENGINEERS & ARCHITECTS  
 WICHITA, KANSAS  
 DECEMBER, 1975

**INDEX OF SHEETS**

1. GENERAL NOTES AND SUMMARY OF QUANTITIES
2. CONTOUR MAP AND PROFILE
3. CONSTRUCTION LAYOUT
4. ABUTMENT AND PIER DETAILS
5. SUPERSTRUCTURE DETAILS
6. APPROACH SLAB, RAILS AND RETAINING WALL
7. BAR LIST AND BENDING DIAGRAMS
8. PILE DETAILS
9. BAR SUPPORTS, BRIDGE EXCAVATION AND ELECTRIC LIGHTING

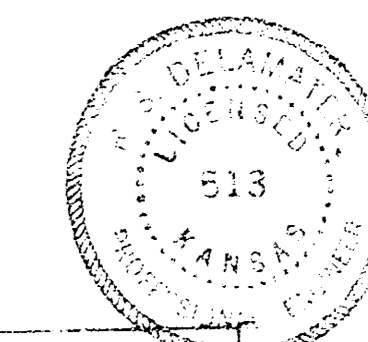

P.O.T. Sta 2+97.93  
 2" Iron Pipe @ P.O.T.  
 North Property Line, Edgemont Place

P.O.T. Sta. 6+60.88  
 2" Iron Pipe @ P.O.T.  
 Iron on E

Sta. 5+23.60 Construct 6.5 Lin Ft  
 Concrete Retaining Wall & Chain Link  
 Fence, Left. See Sheet No. 6

Scale: 1"=20'

**SUMMARY OF GRADING QUANTITIES**

Channel Excavation (Chg. Change)	1,040 Cu. Yds.
Channel Excavation (Contn. Furnish)	1,820 Cu. Yds.
Channel Excavation	2,860 Cu. Yds.
Compacted Fill Required:	
South Side	1,070 Cu. Yds.
North Side	850 Cu. Yds.
Total	1,920 Cu. Yds.
Uncompacted Fill Required:	
Channel Fill, St. Sta. 5+55:	30 Cu. Yds.




The total of compacted fill includes all compaction of whatever type within limits indicated. Approximate quantities are as follows:

Type A (MR-5)	1,540 Cu. Yds.
Type B (MR-90)	480 Cu. Yds.

(Shrinkage allowance of 2% provided)




Sta. 4+84, Construct 19'-26'-19"  
 Continuous RC. Slab Span Bridge  
 Pile Bent Type Abutments & Piers.  
 43'-8" Roadway & 4'-4" Side Walks.

**CURVE DATA**  
 (Channel Change)  
 $\Delta = 60^\circ$   
 $D = 57'17"-45"$   
 $R = 100.00'$   
 $L = 104.72'$

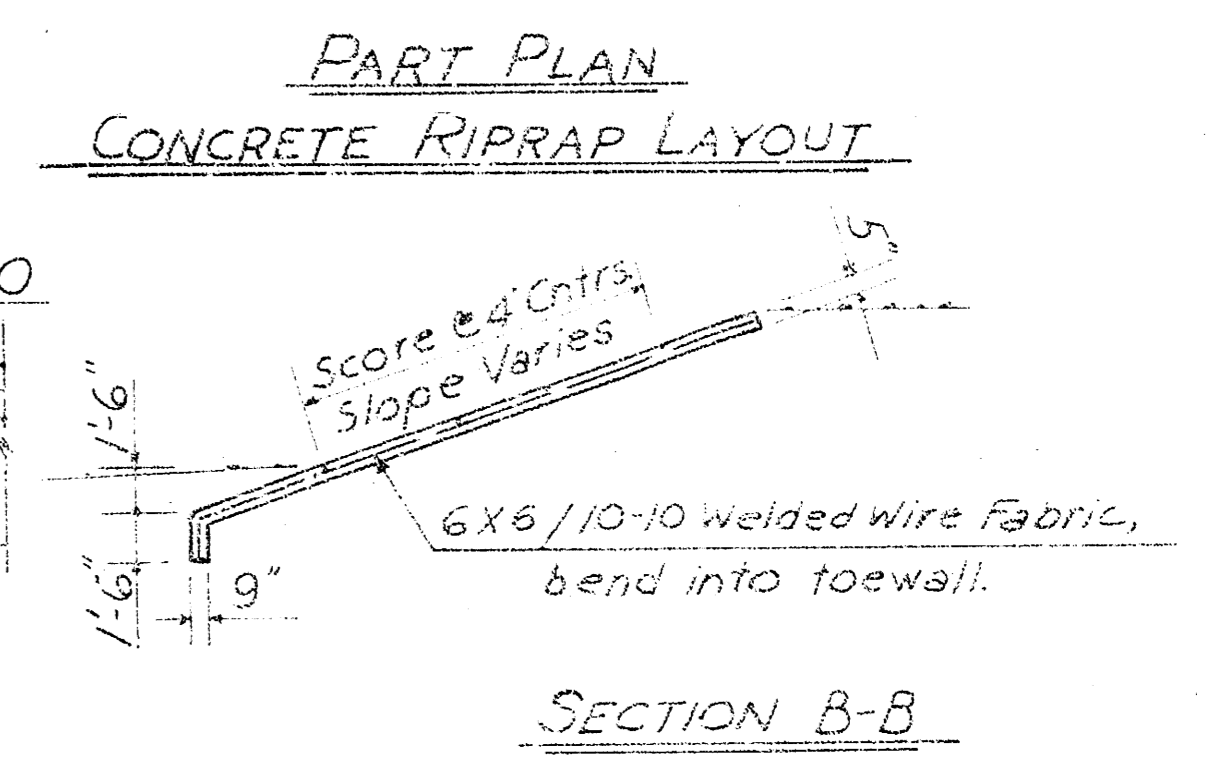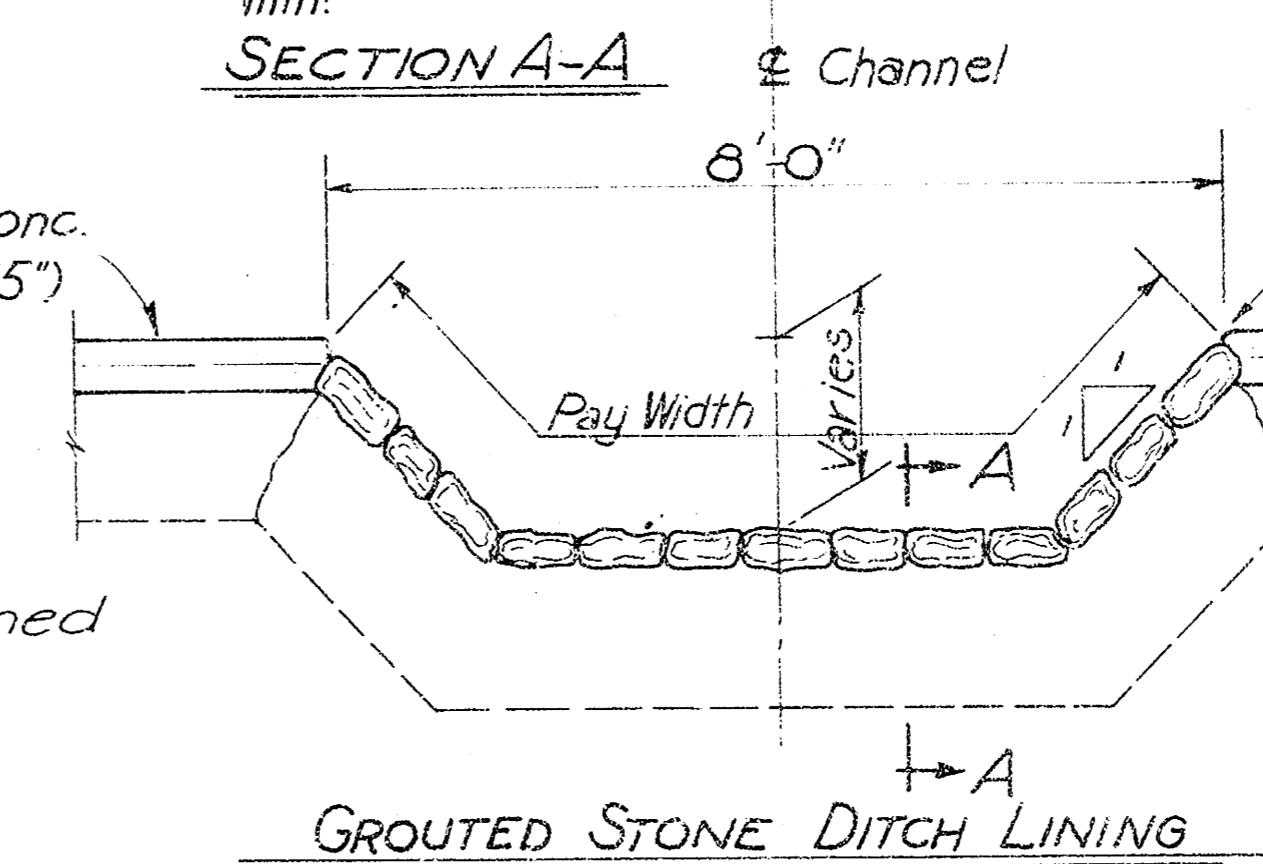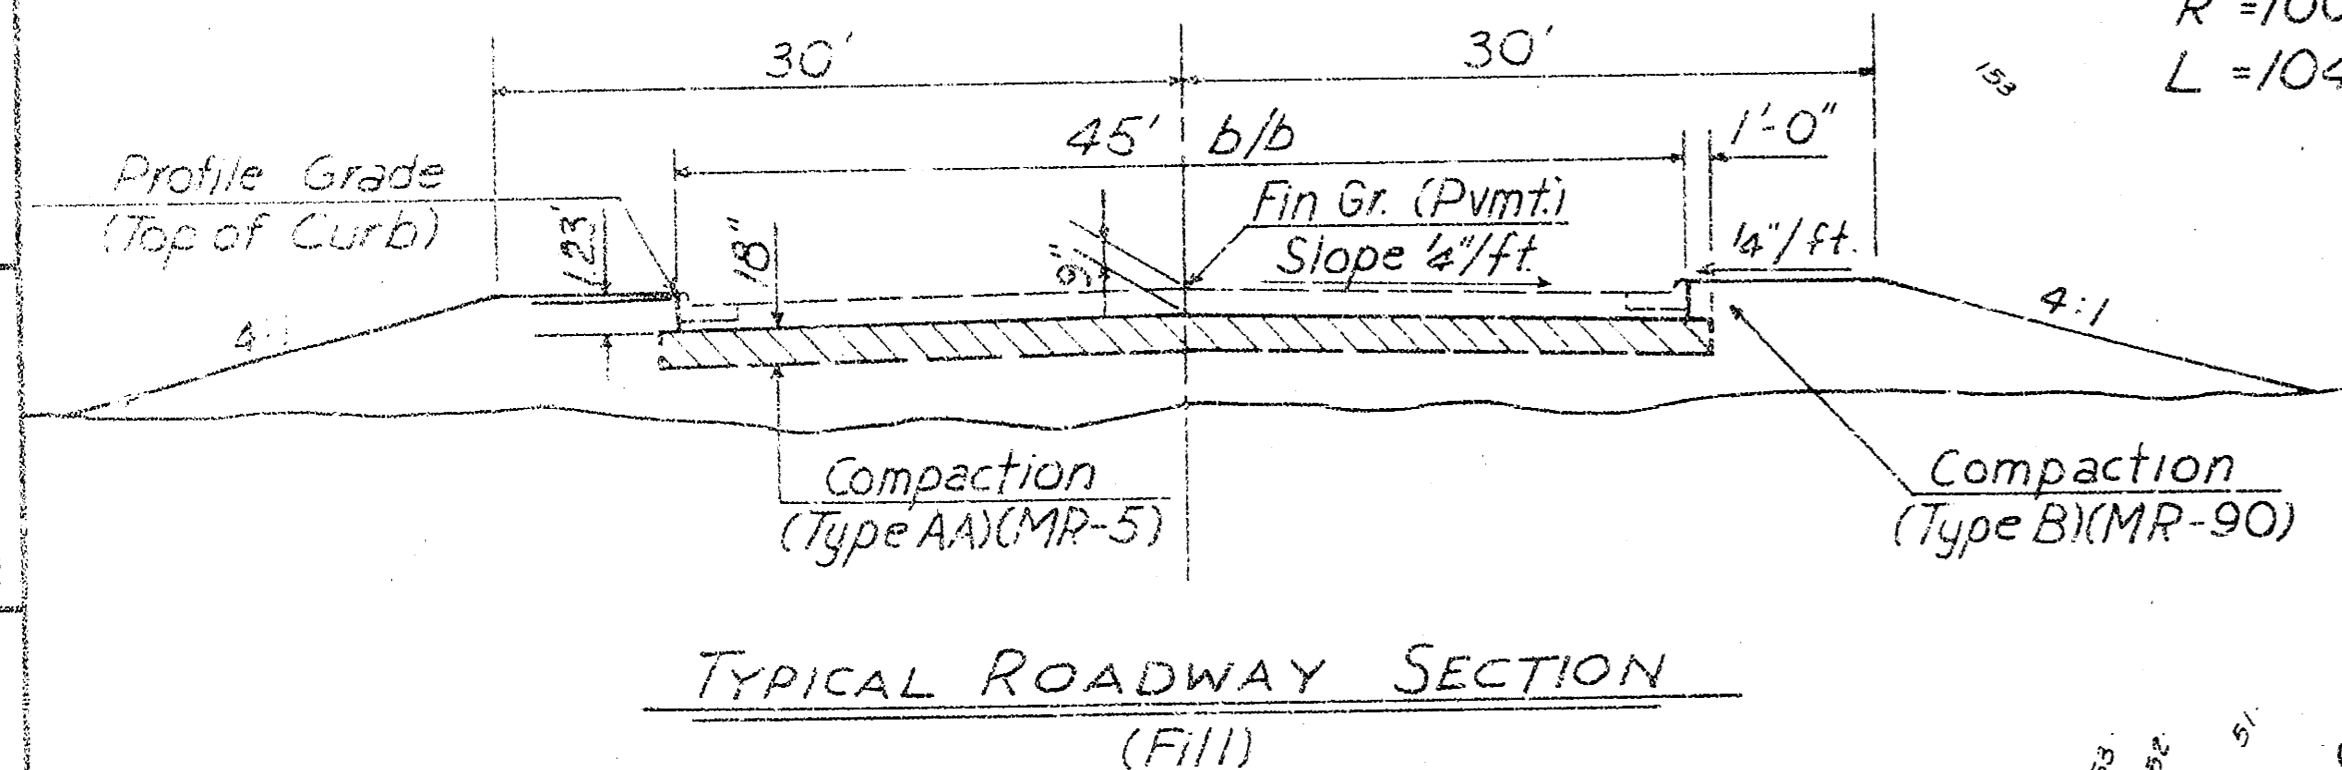


NOTE: Plug ends of abandoned Sanitary Sewer Pipes.

NOTE: RIPRAP: REINFORCED CONCRETE RIPRAP SHALL BE OF CLASS "A" CONCRETE. WIRE REINFORCING MESH SHALL BE COMPOSED OF NO. 3/4 STEEL WIRE SPACED AT 8" CENTERS EACH WAY. REINFORCEMENT AS SHOWN IS INCLUDED IN UNIT PRICE BID FOR "REINFORCED CONCRETE RIPRAP (5)". MEASUREMENT OF CONCRETE SHALL BE IN SQ. YDS. AND SHALL BE THE OUTSIDE SURFACE AREA, INCLUDING THE TOE WALL, REGARDLESS OF THE THICKENING SHOWN ON THE PLANS.

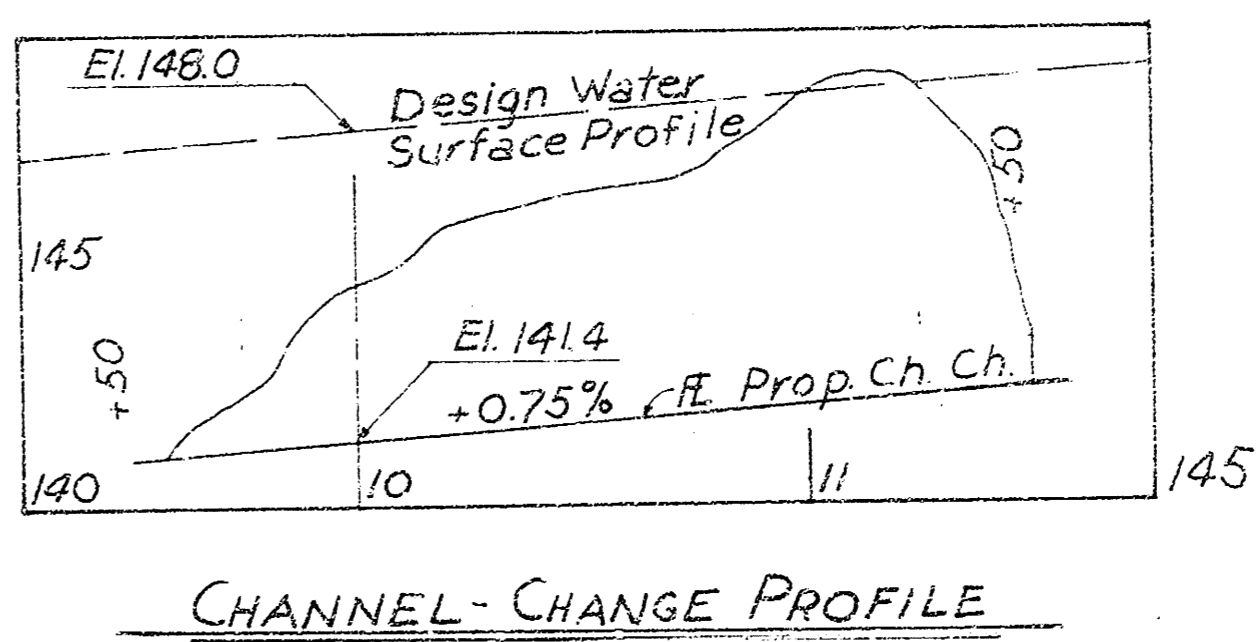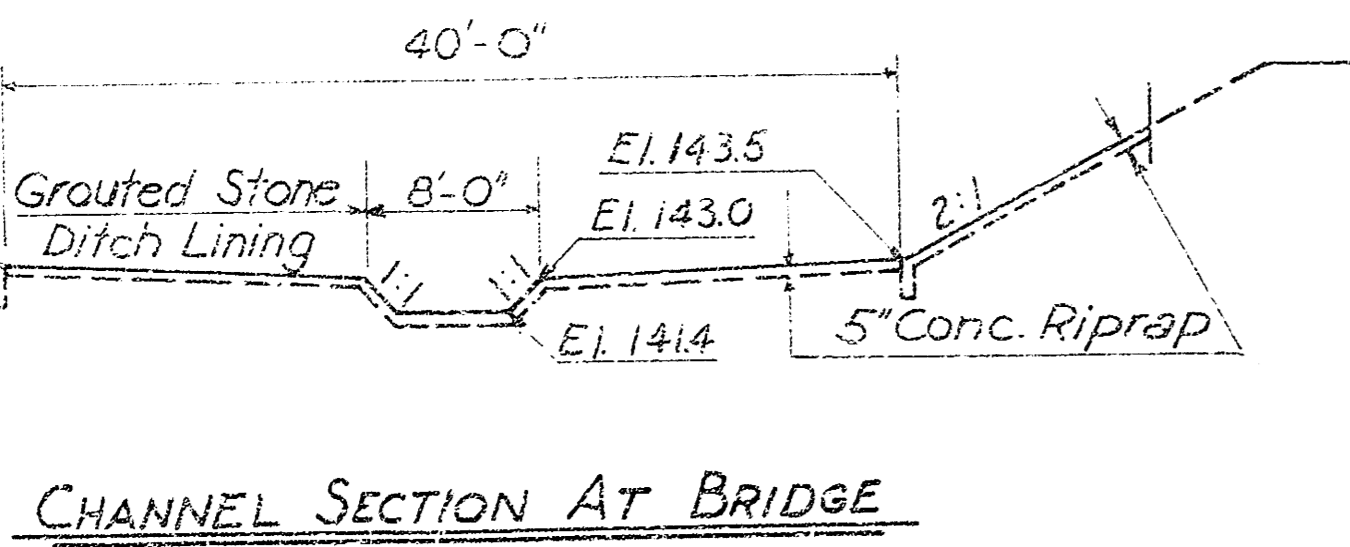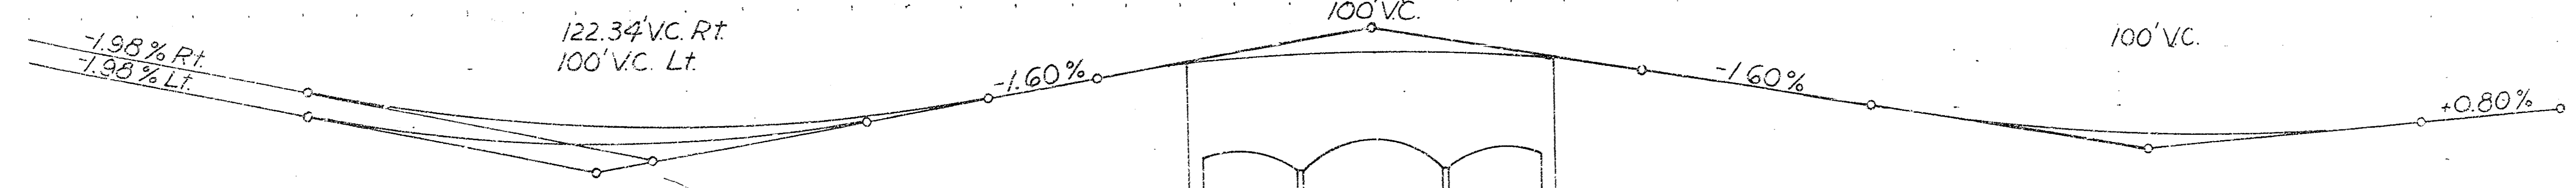


NOTE: Top of Curb Profile = Crown Gr. on Bridge.

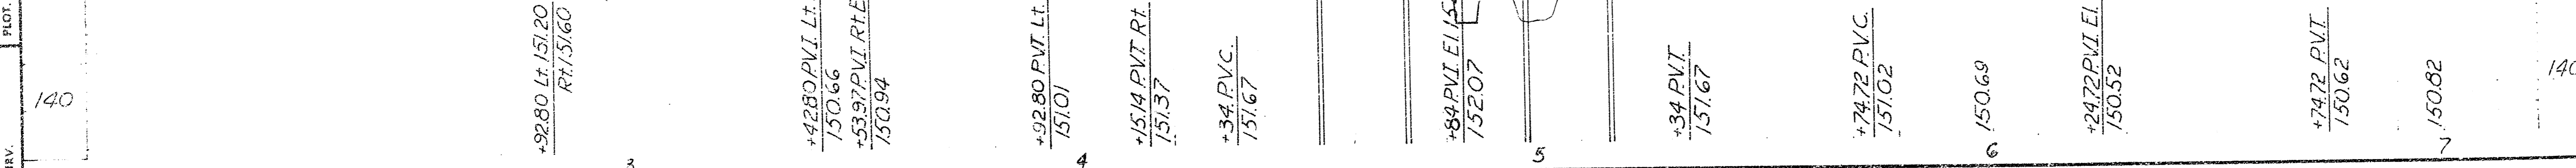


CS	1-11-77	As Built
CITY OF WICHITA, KANSAS R.W. LINN, PE, CITY ENGINEER		
VASSAR STREET BRIDGE OVER SLEEPY HOLLOW CREEK CONTOUR MAP & PROFILE		
DELAMATER, FREUND & SCHERER, P.A. ENGINEERS & ARCHITECTS WICHITA, KANSAS		
SCALE	DATE December, 1975	DWG. NO. 79-R-2






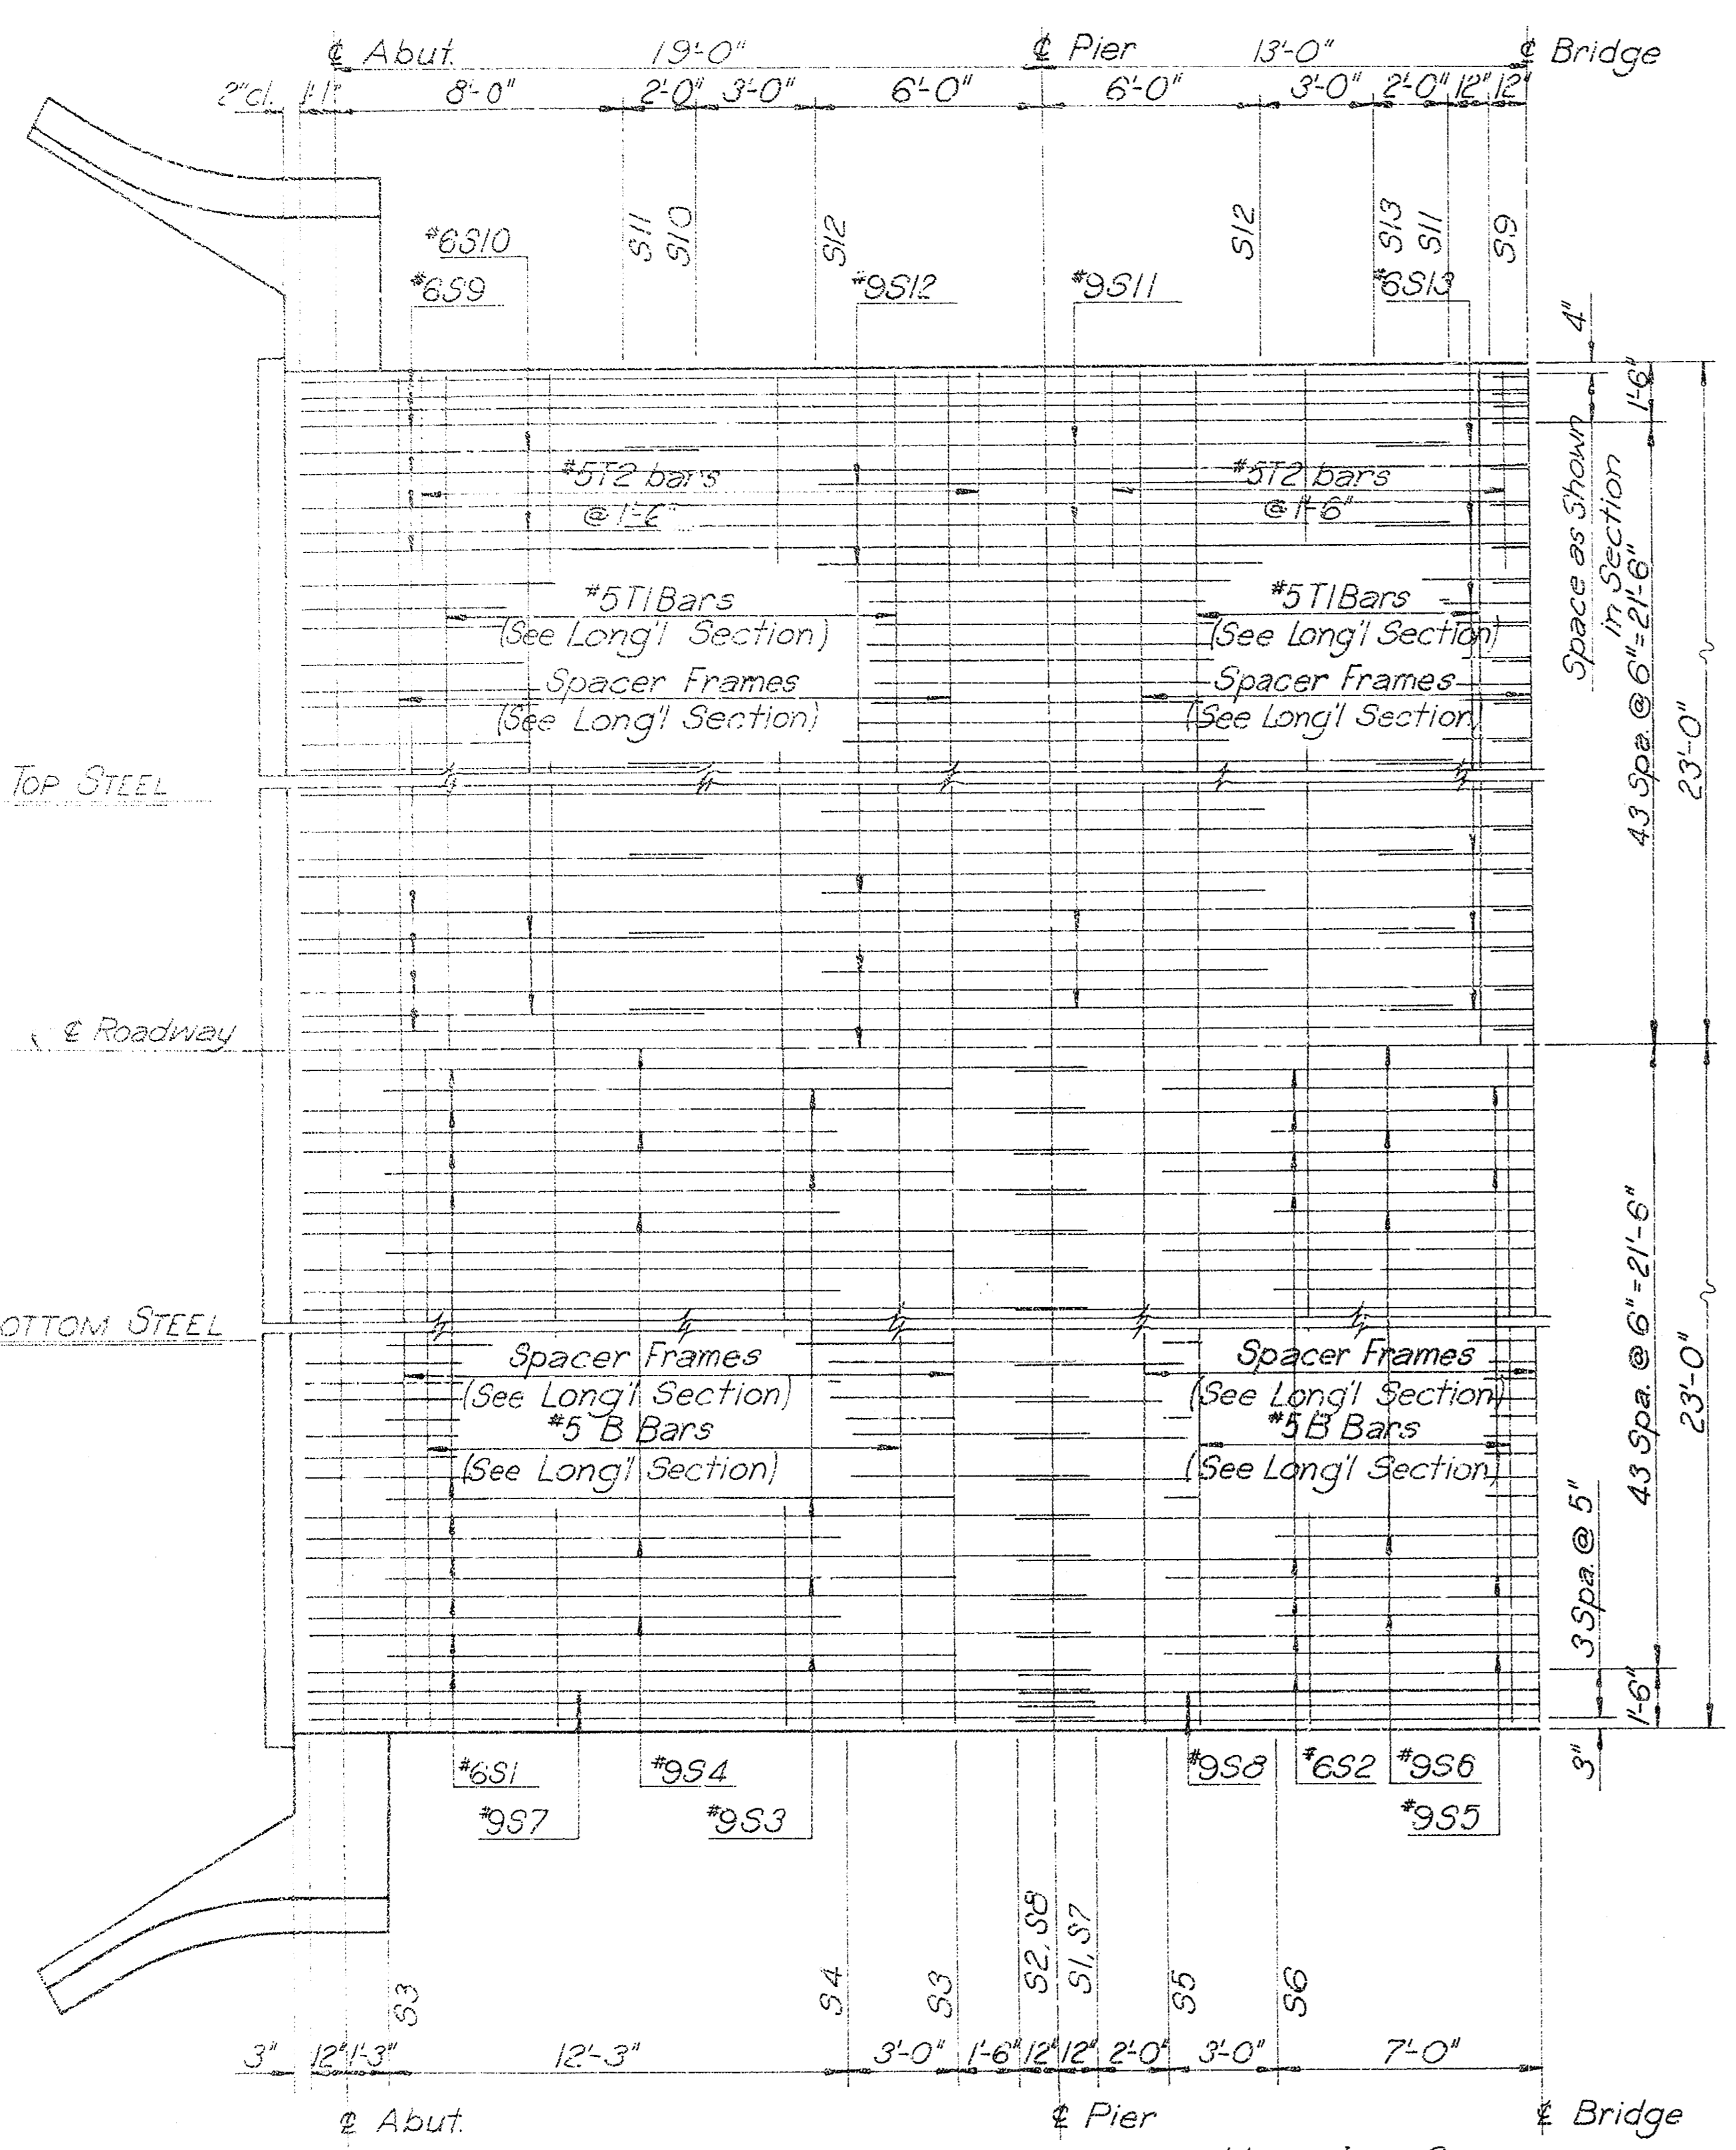


END SPAN HALF INT. SPAN  
HALF PLAN SHOWING REINFORCEMENT

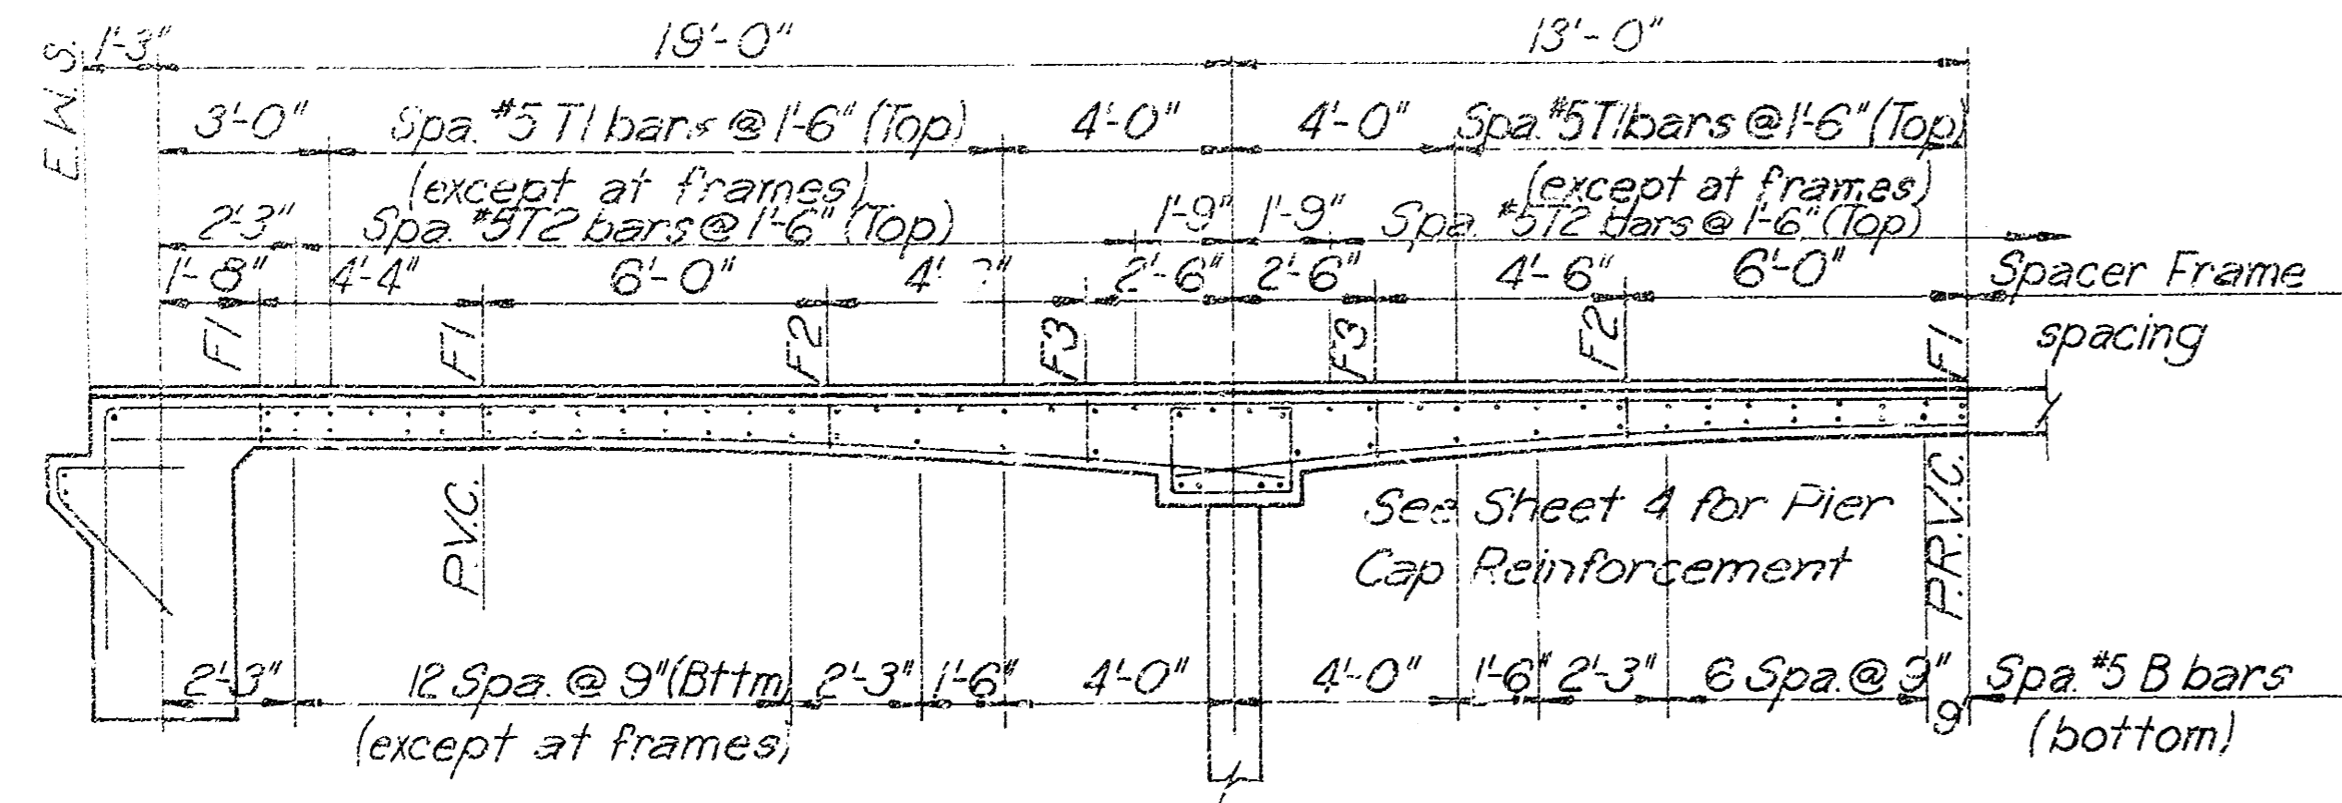


HALF LONGITUDINAL SECTION

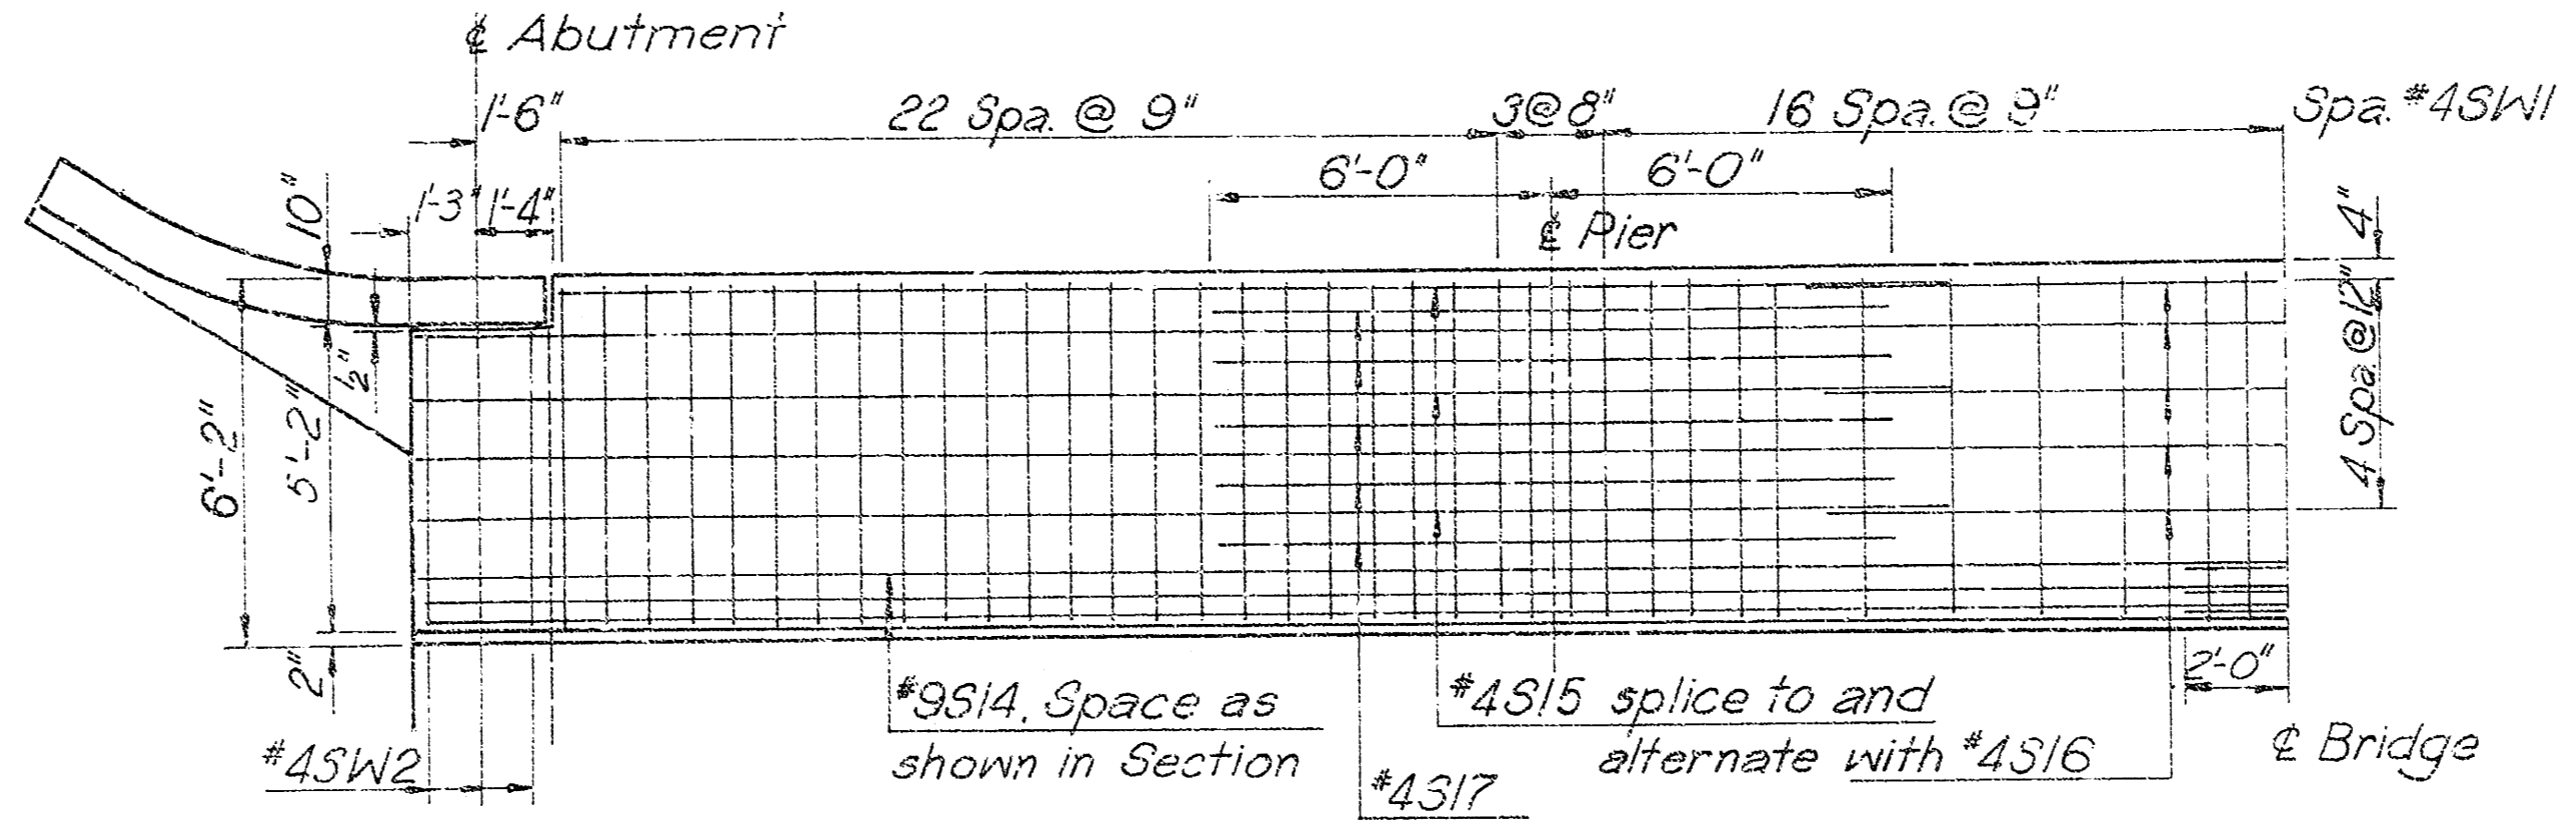

PART PLAN OF SIDEWALK  
NOTE: See Sheet No. 6 for Rail Details

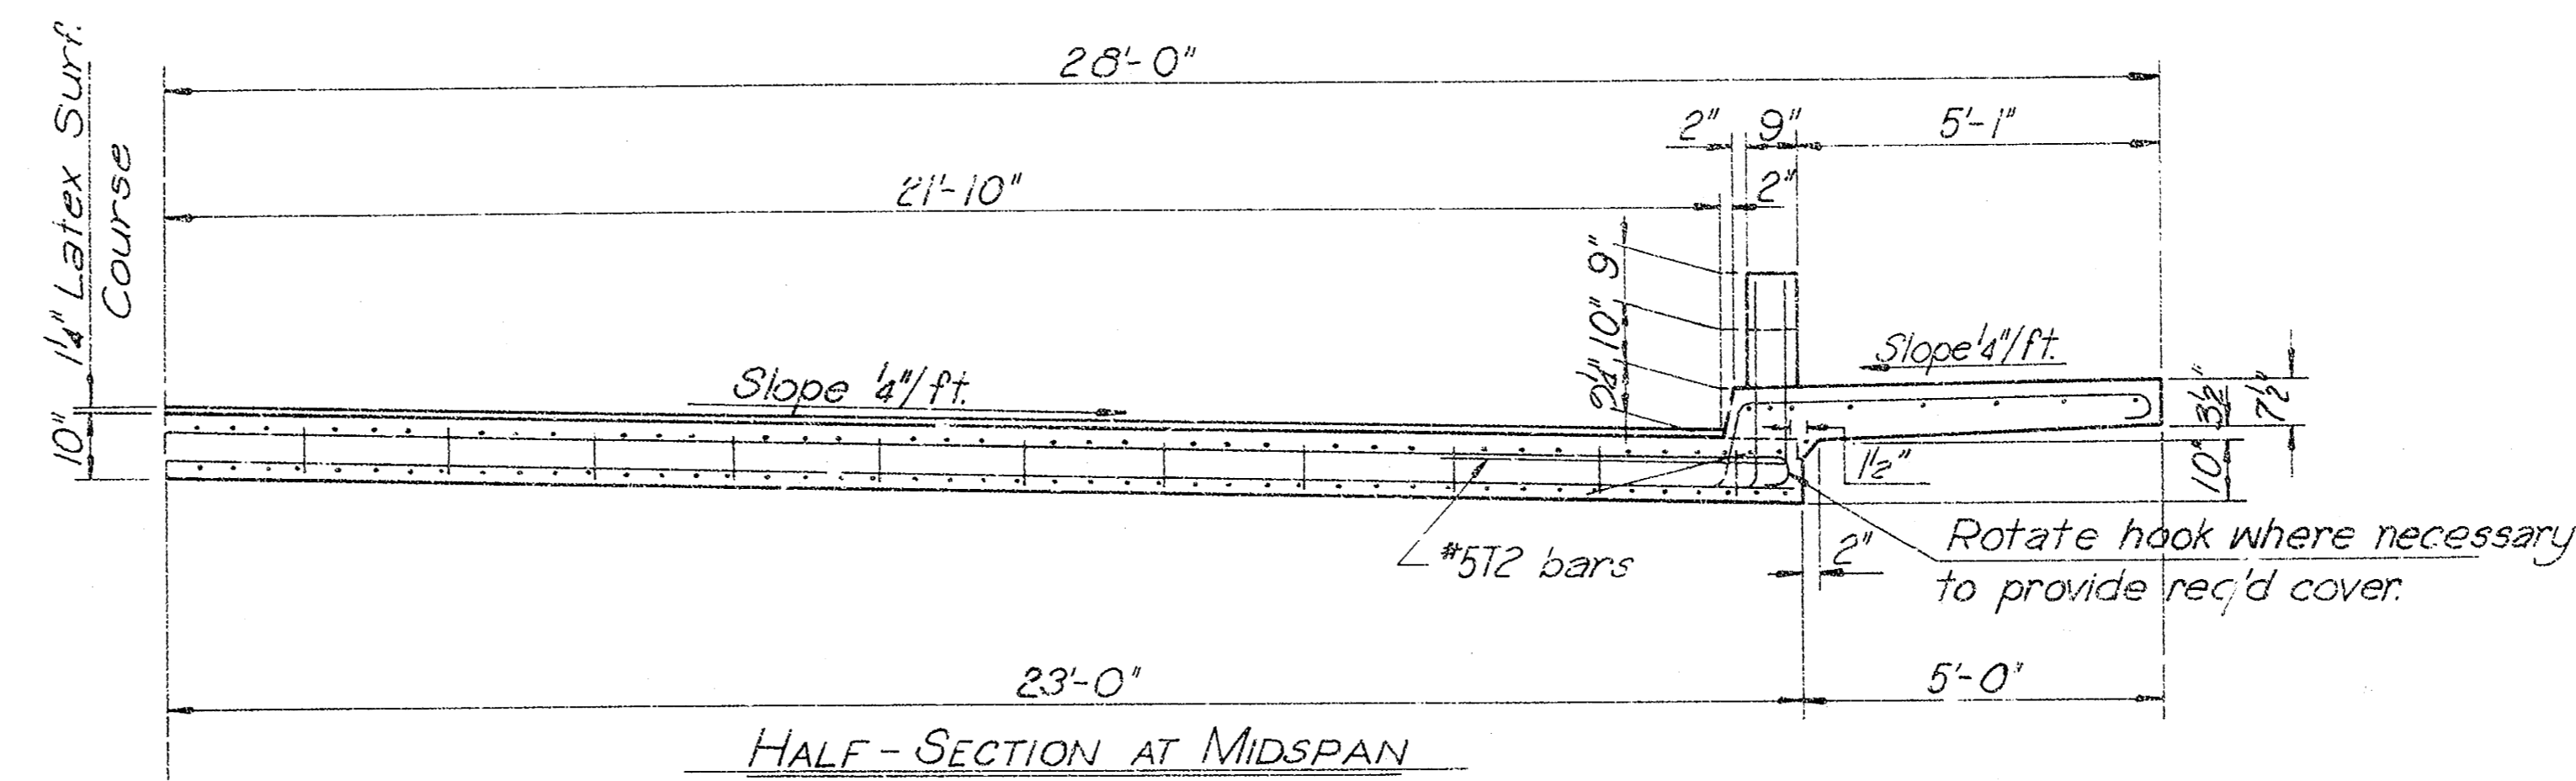


HALF-SECTION AT MIDSPAN

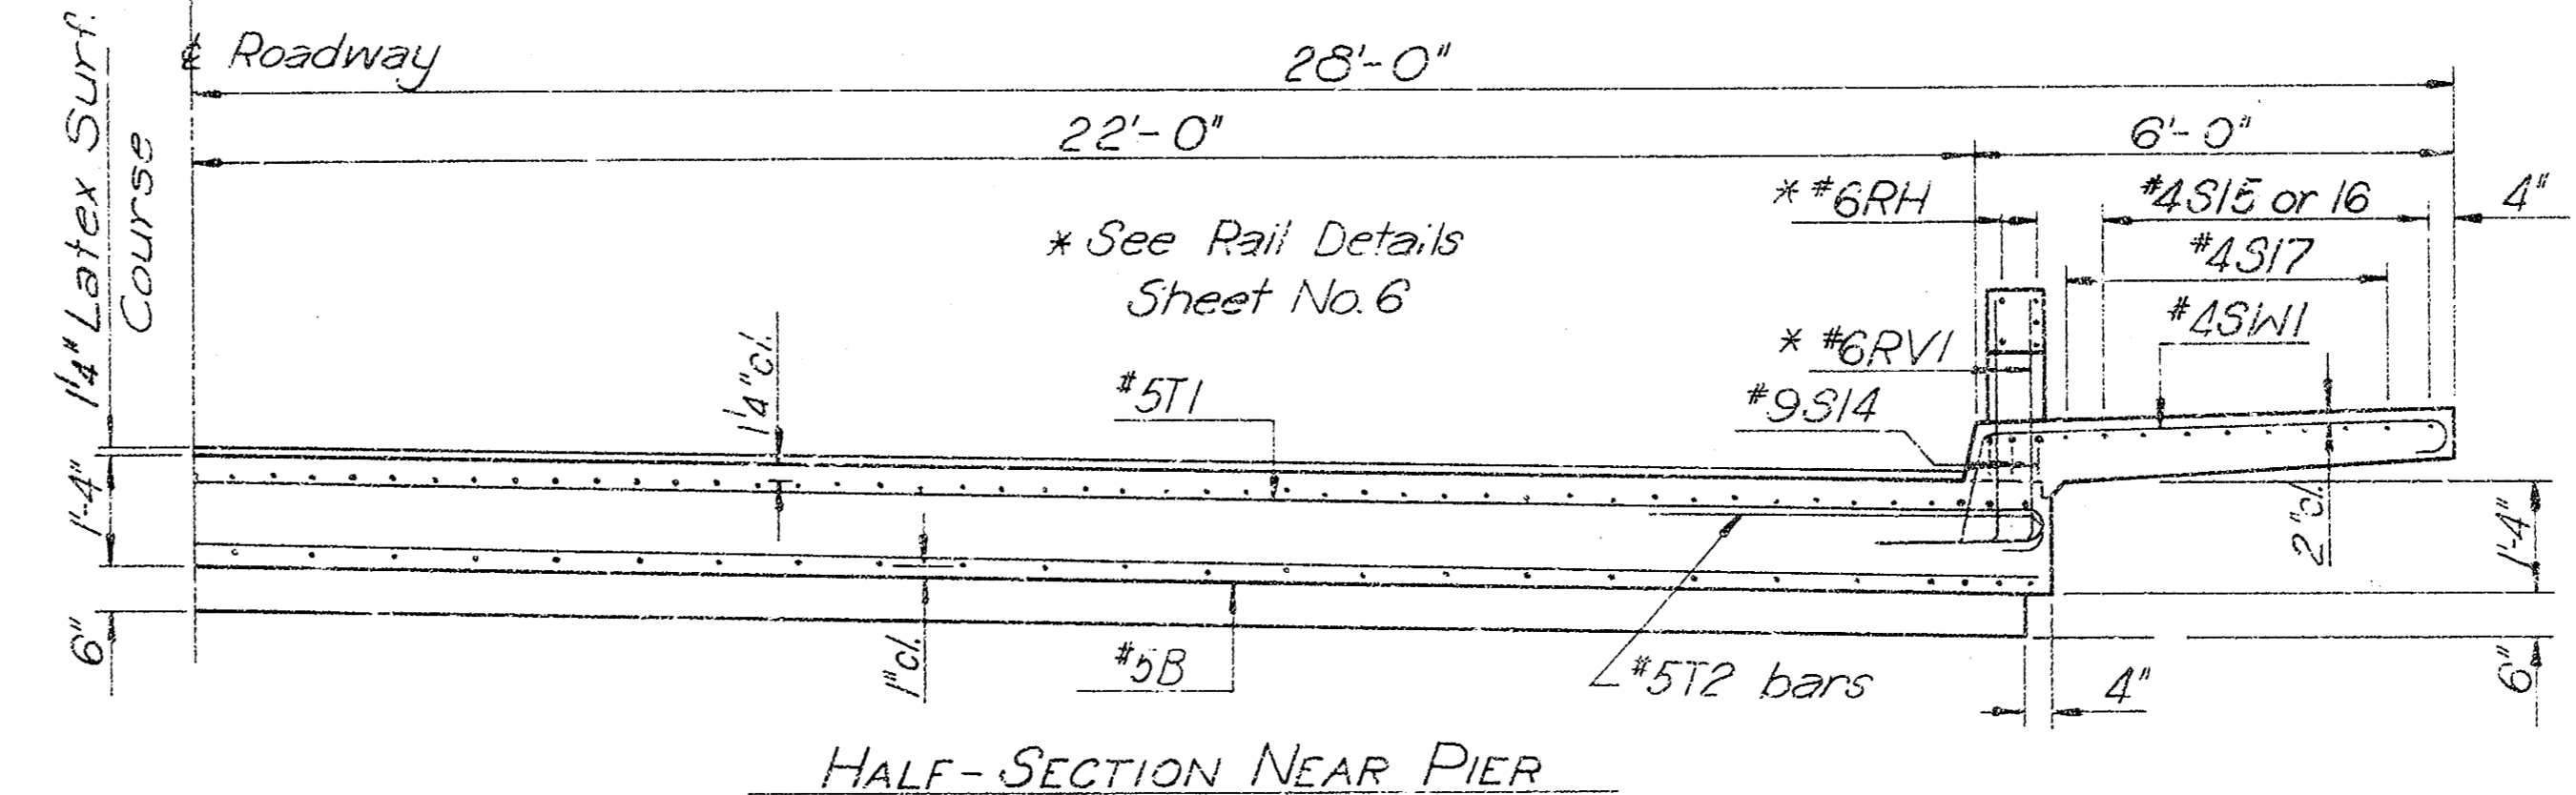


HALF-SECTION NEAR PIER

NOTES:  
All concrete shall be Class AAA(AE).  
Bevel all exposed edges with 3/4" triangular molding unless otherwise noted.  
Dimensions relative to placement of reinforcing are to centerline of bars unless otherwise noted.  
See Sheet No. 1 for General Notes.  
See Sheet No. 7 for Bar List and Bending Diagrams.  
DESIGN LOADING - HS20-44 A A.S.H.T.O. Spec. (1975 Edition)  
UNIT STRESSES:  $f_c$ -1,600 p.s.i. Class AAA(AE)  
 $f_c$ -4,000 p.s.i. Class AAA(AE)  
 $f_s$ -20,000 p.s.i. (Reinf.)
















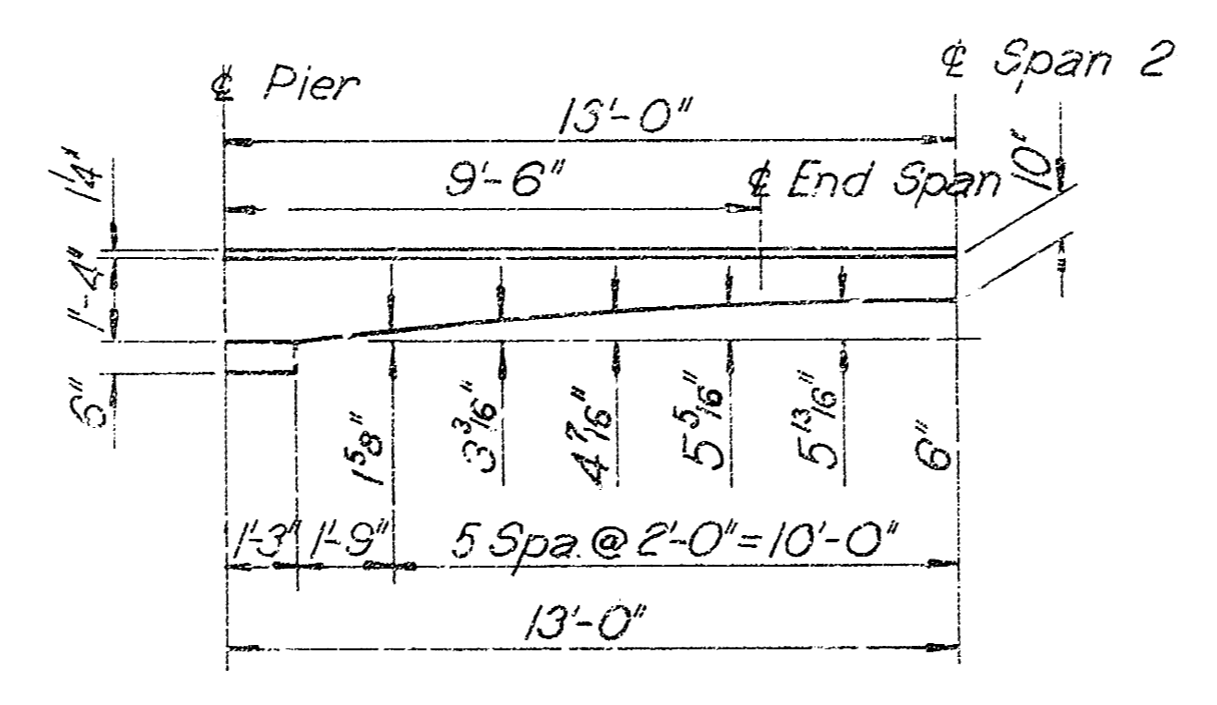


HAUNCH ORDINATES

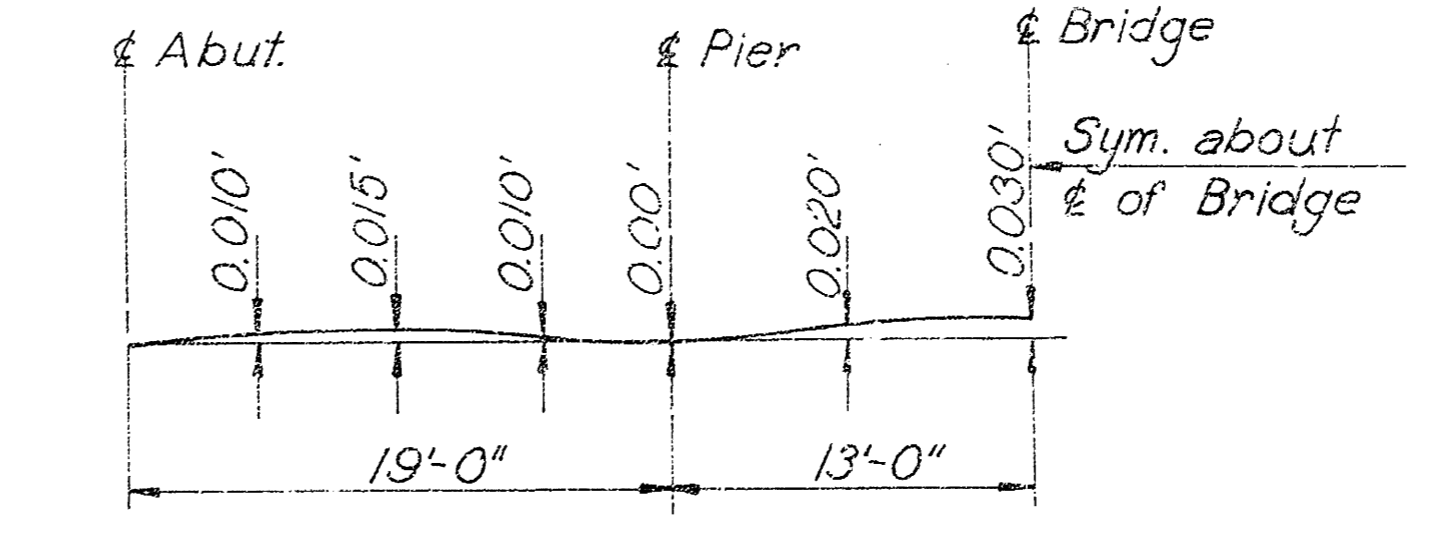

DEAD LOAD DEFLECTIONS AT QUARTER POINTS

REV.	BY	DATE	DESCRIPTION
C.S.		1-11-77	As Built
CITY OF WICHITA, KANSAS R.W. LINN, P.E., CITY ENGINEER			
VASSAR STREET BRIDGE OVER SLEEPY HOLLOW CREEK			
SUPER STRUCTURE LAYOUT & DETAILS			
DELAMATER, FREUND & SCHERER, P.A. ENGINEERS & ARCHITECTS WICHITA, KANSAS			
SCALE	DATE	D.W.G. NO.	
	December, 1975	79-R-5	

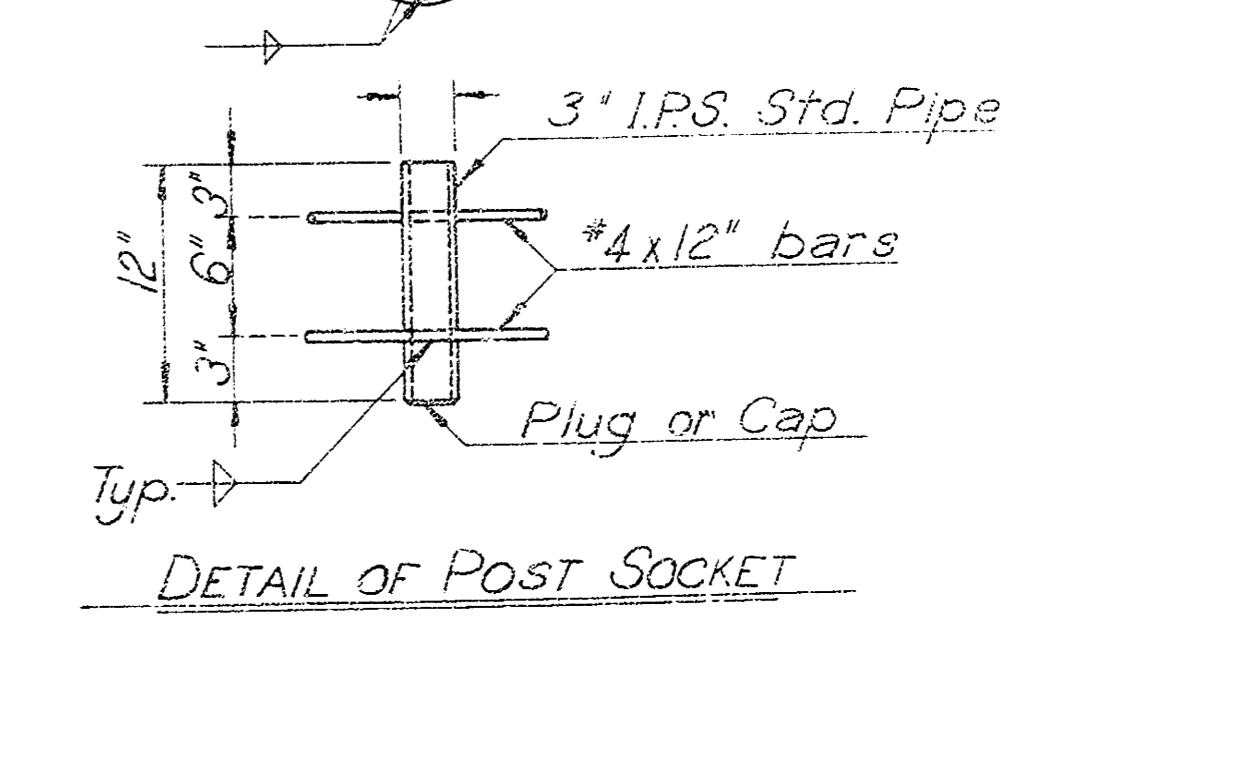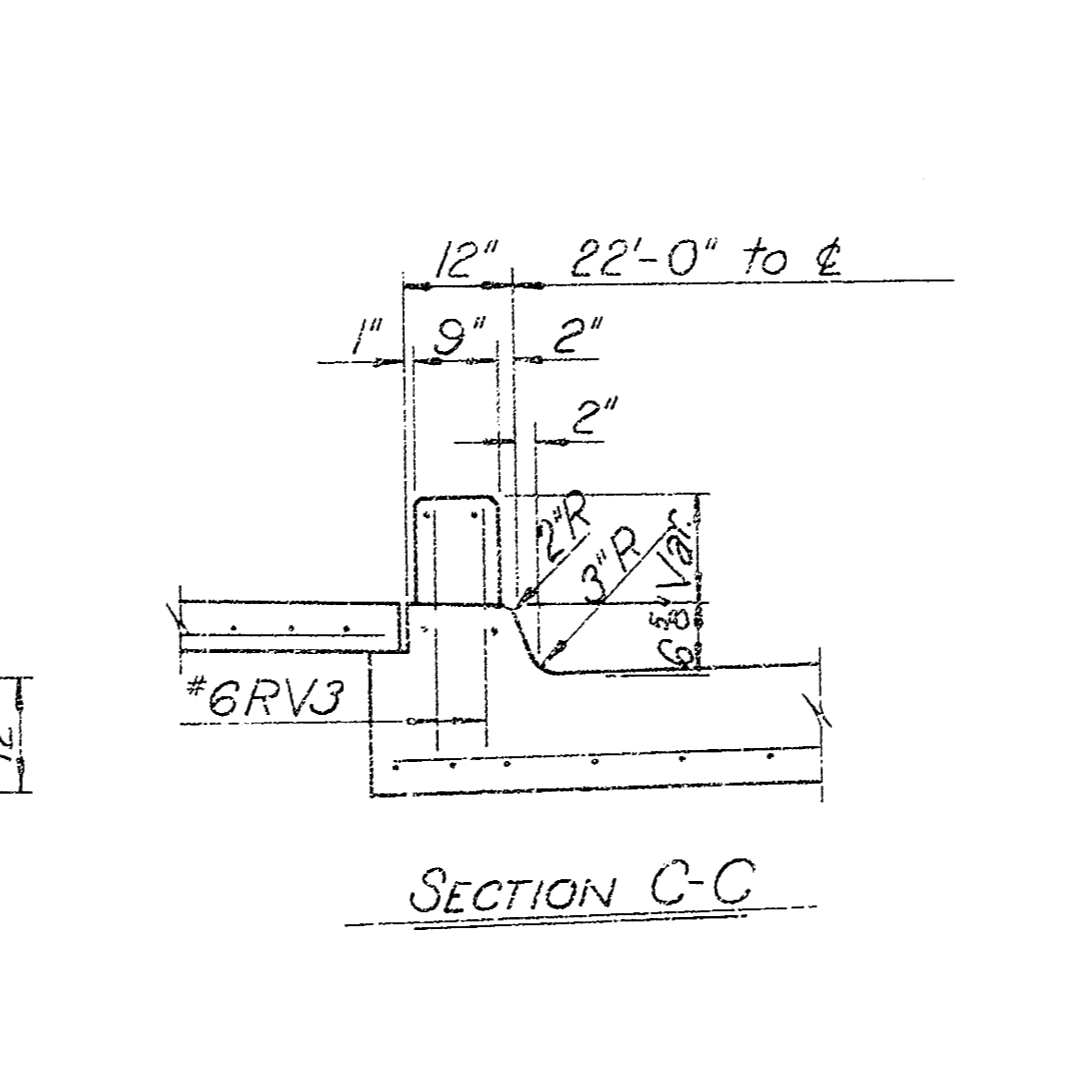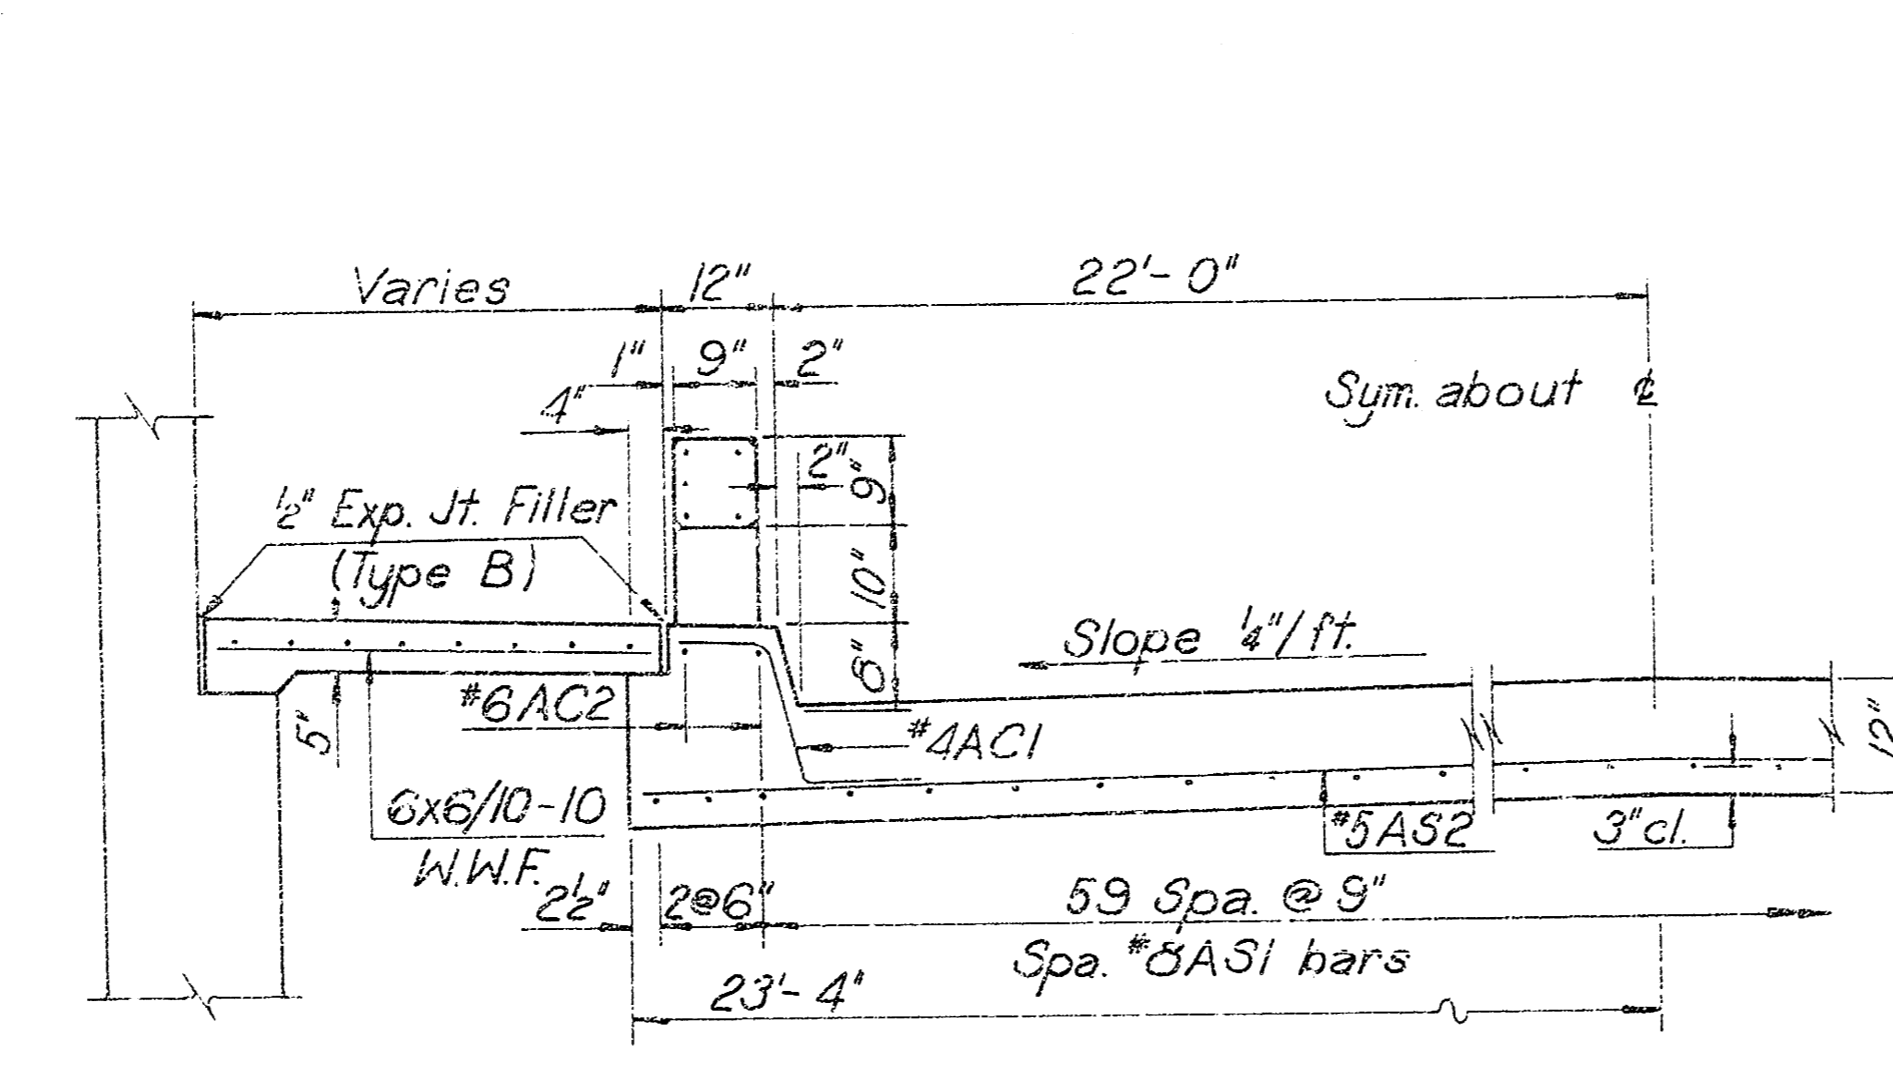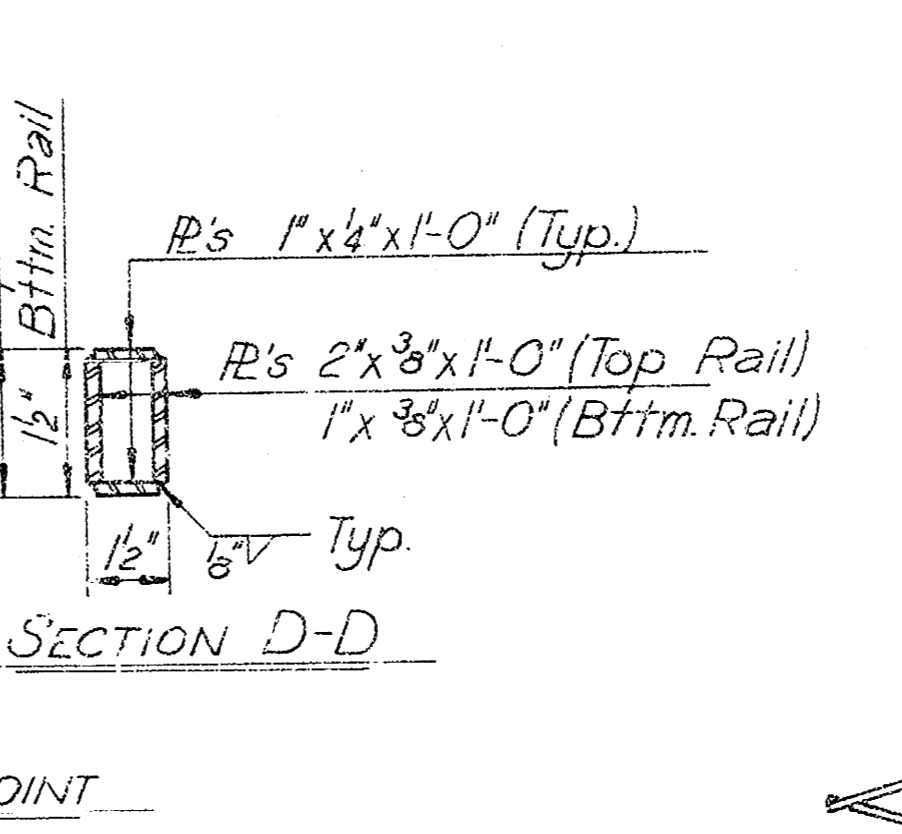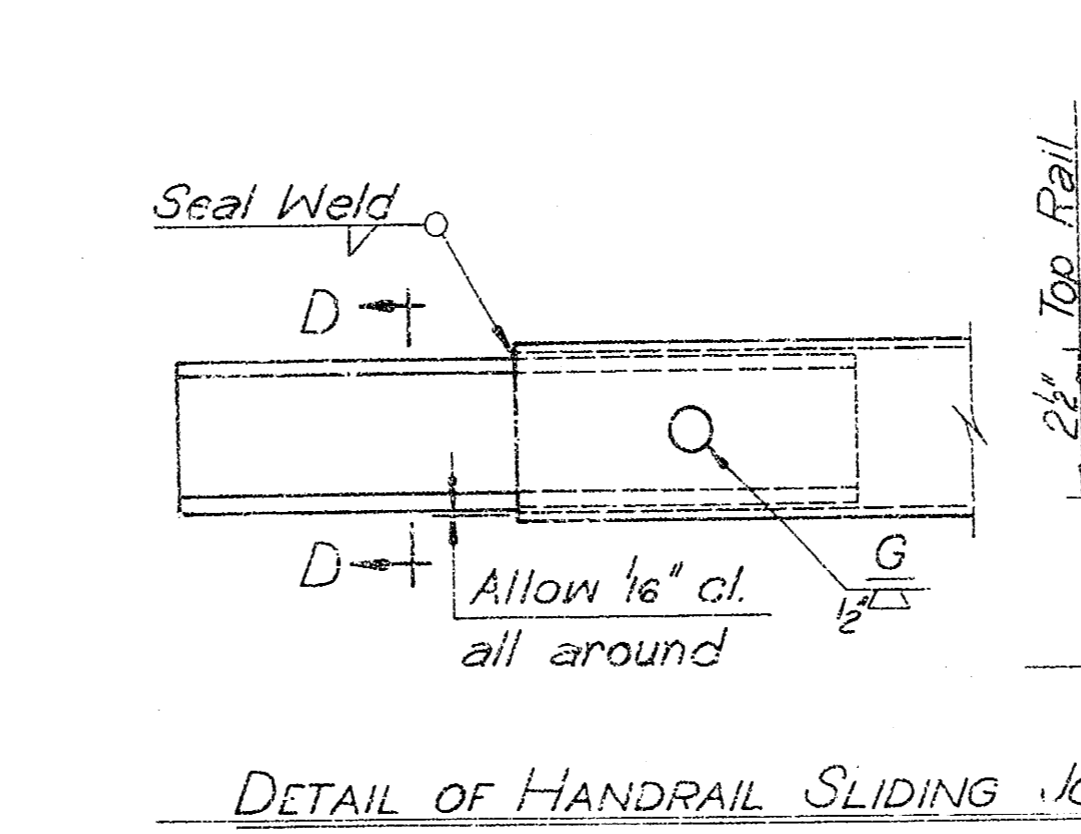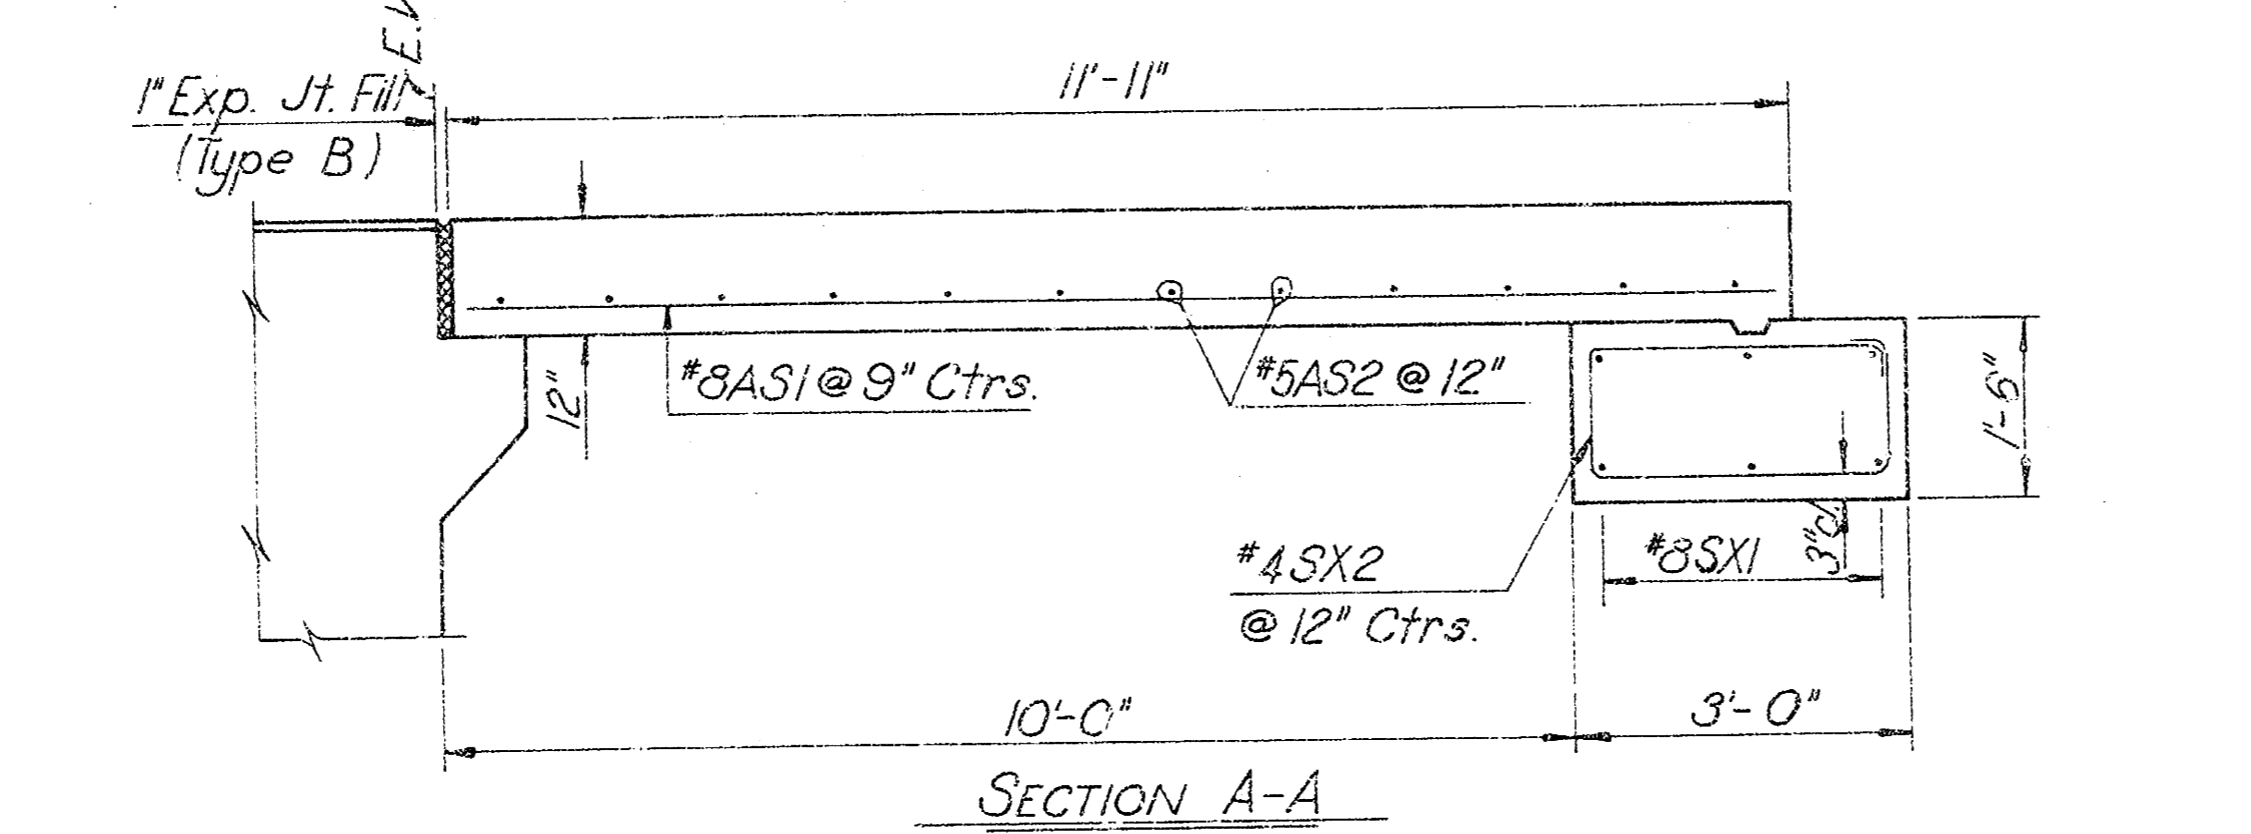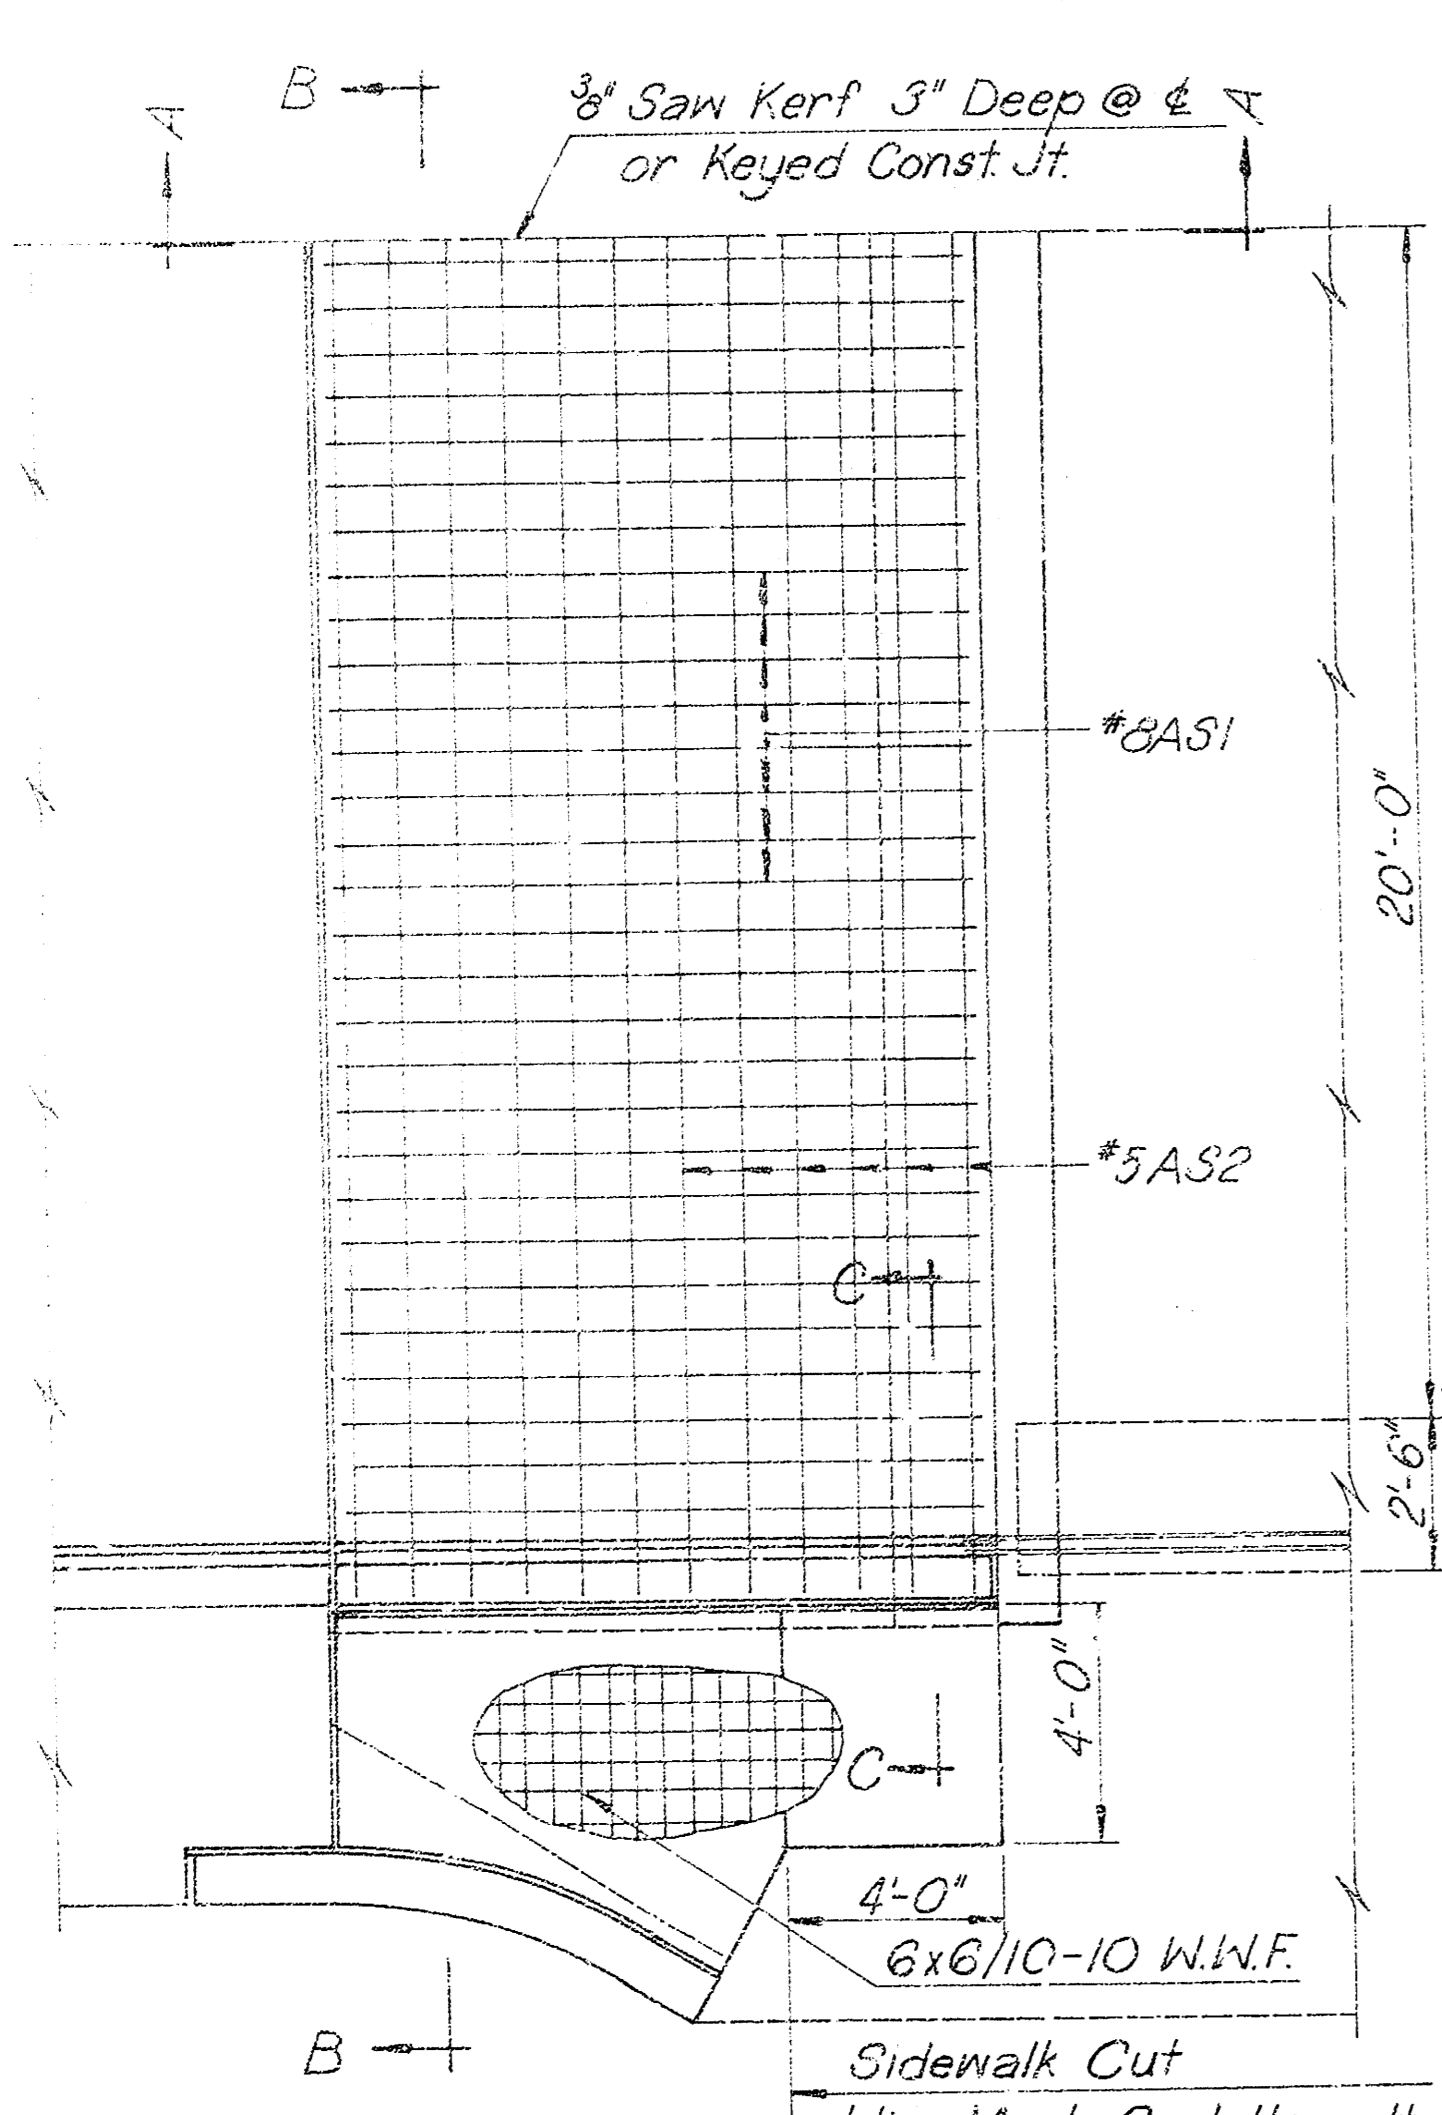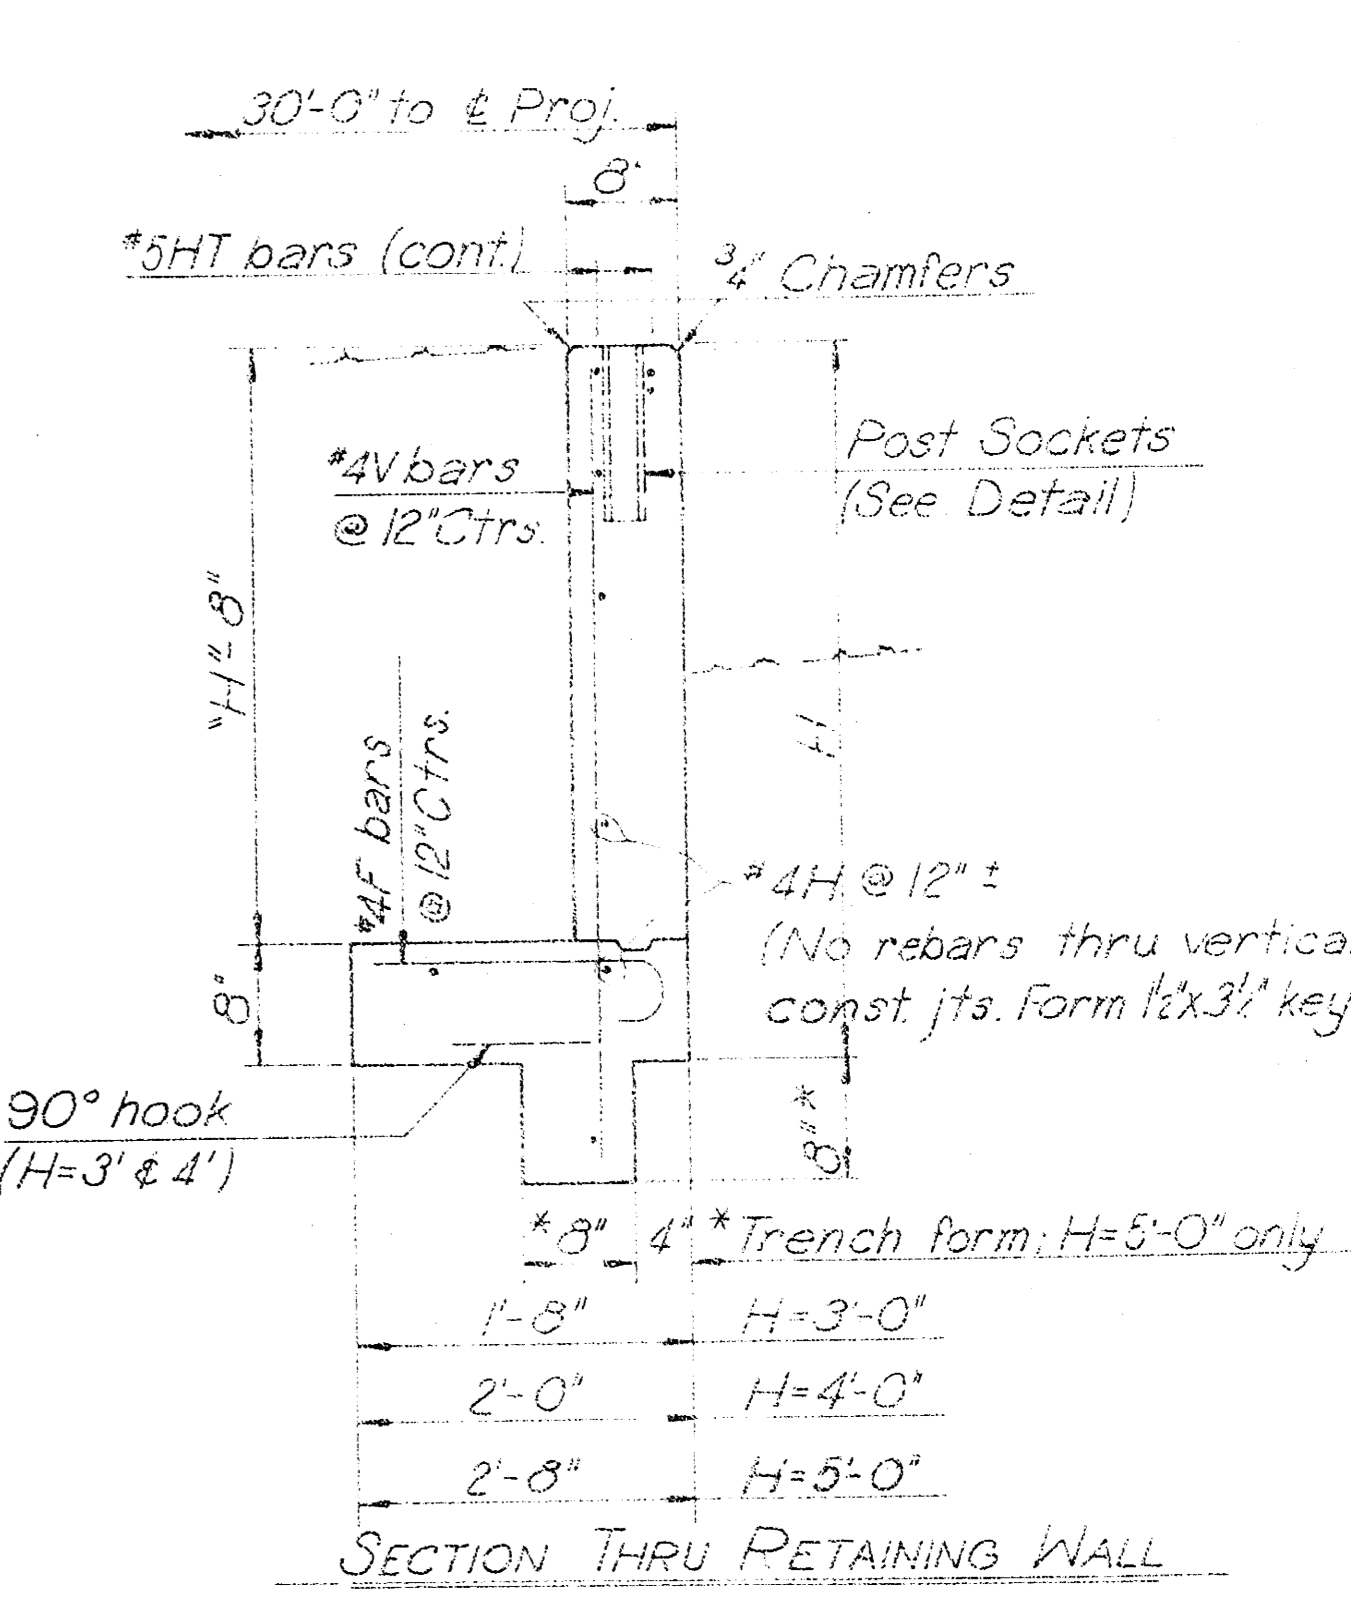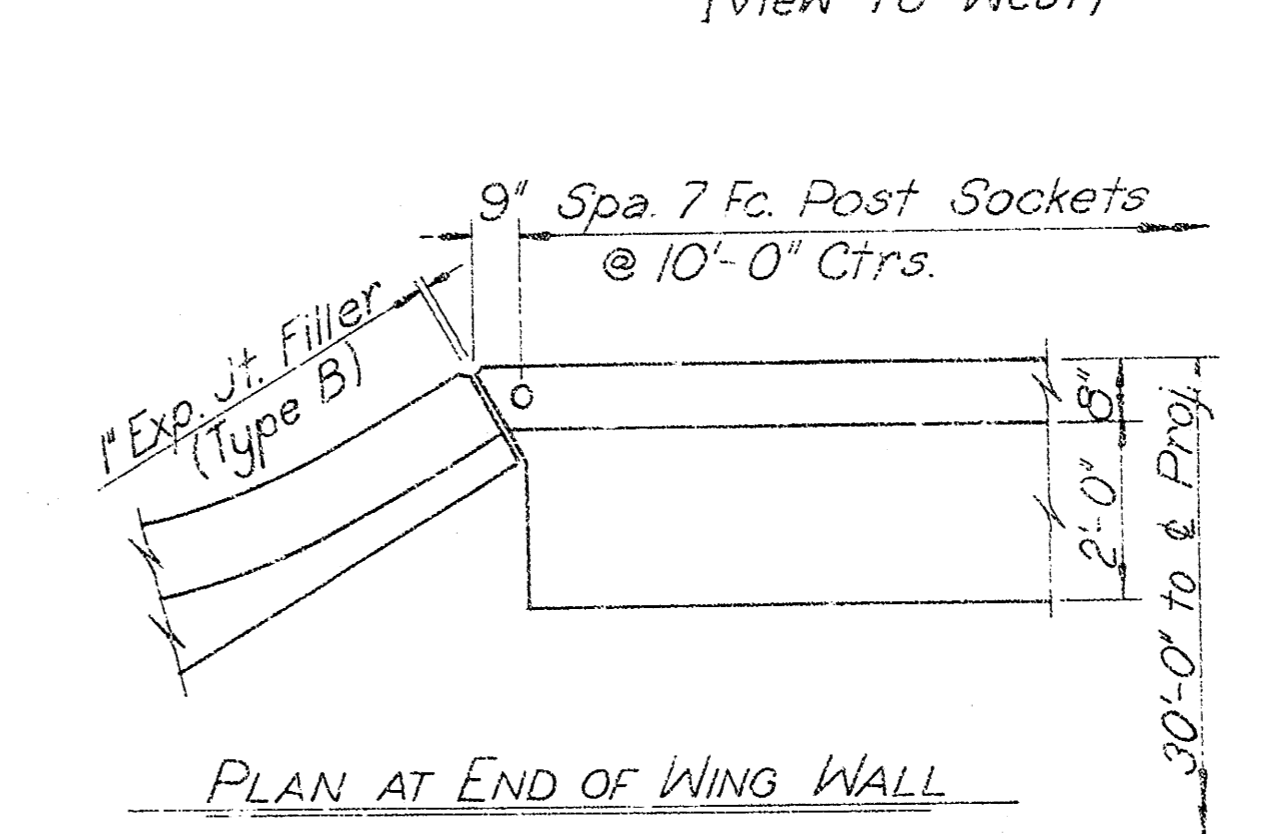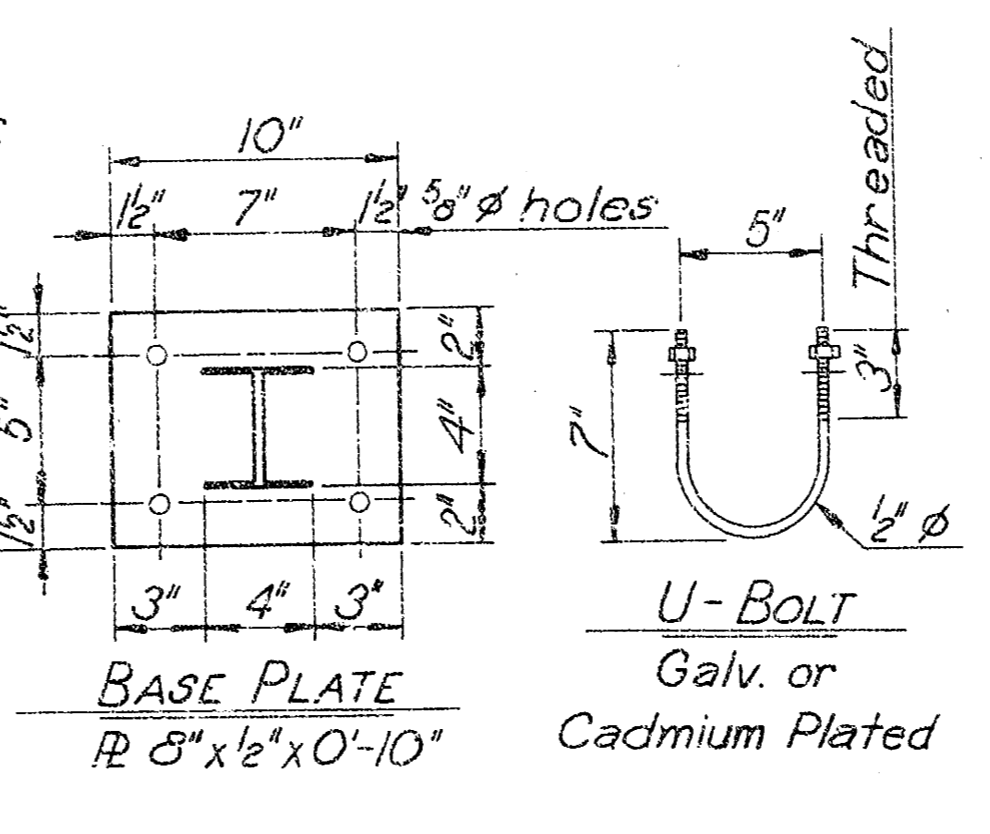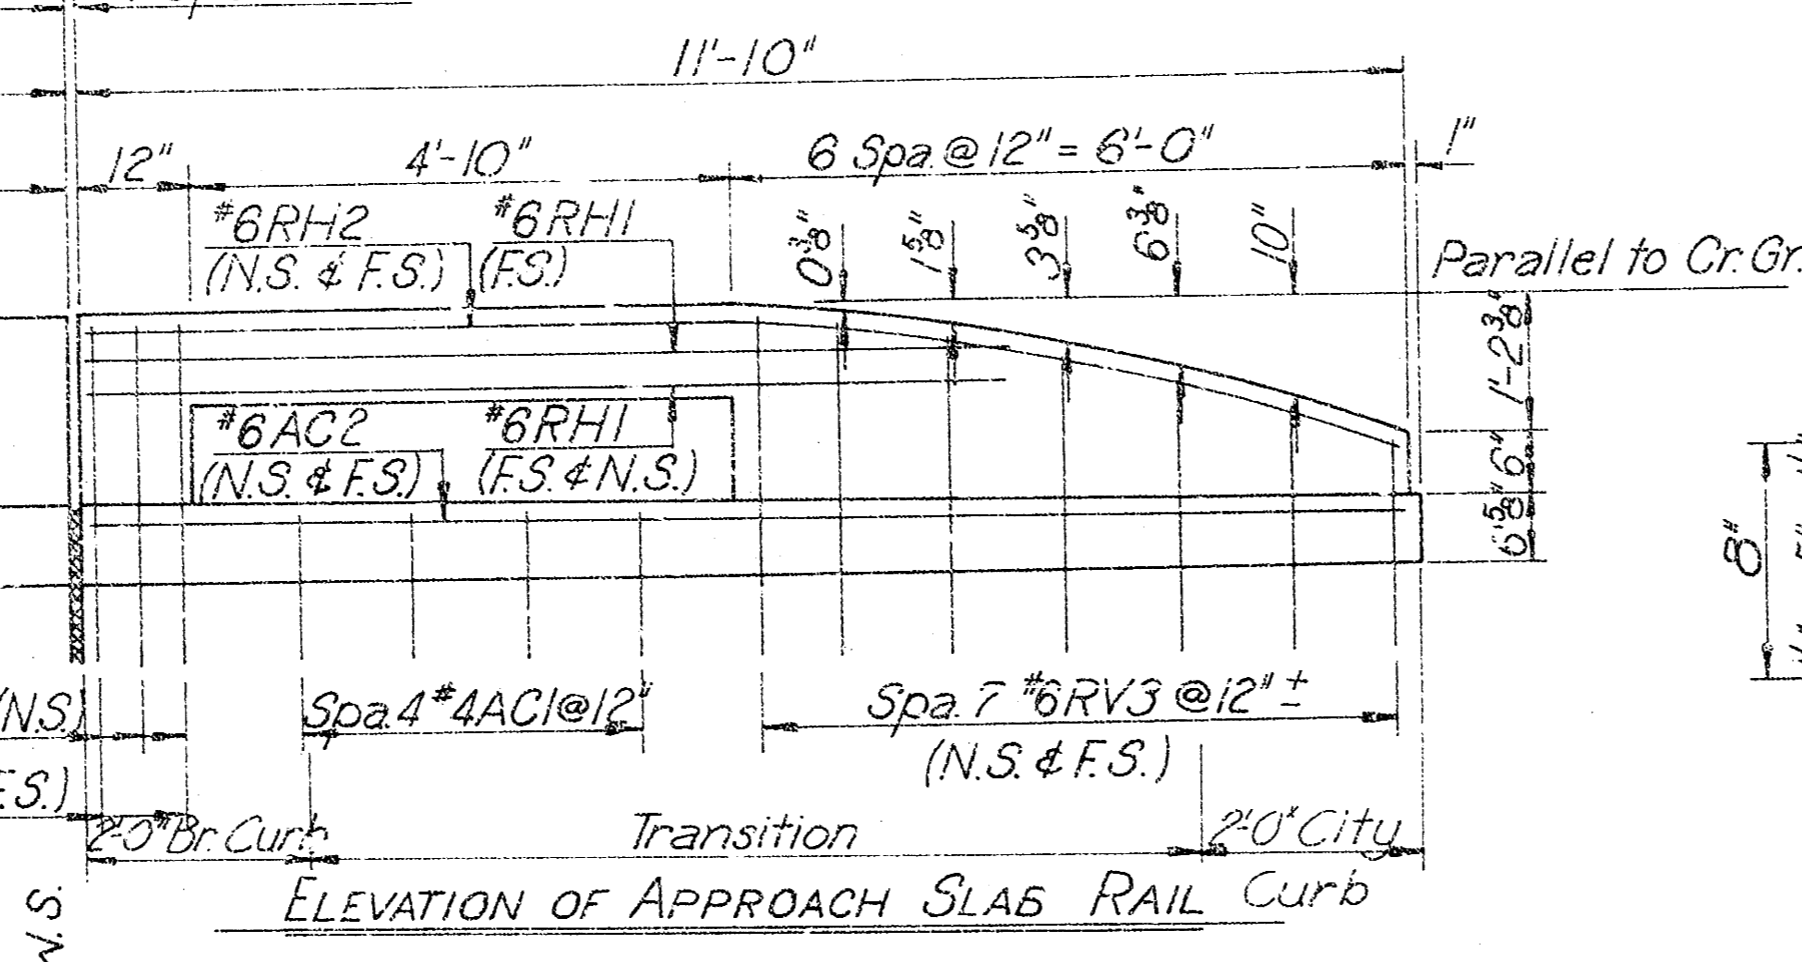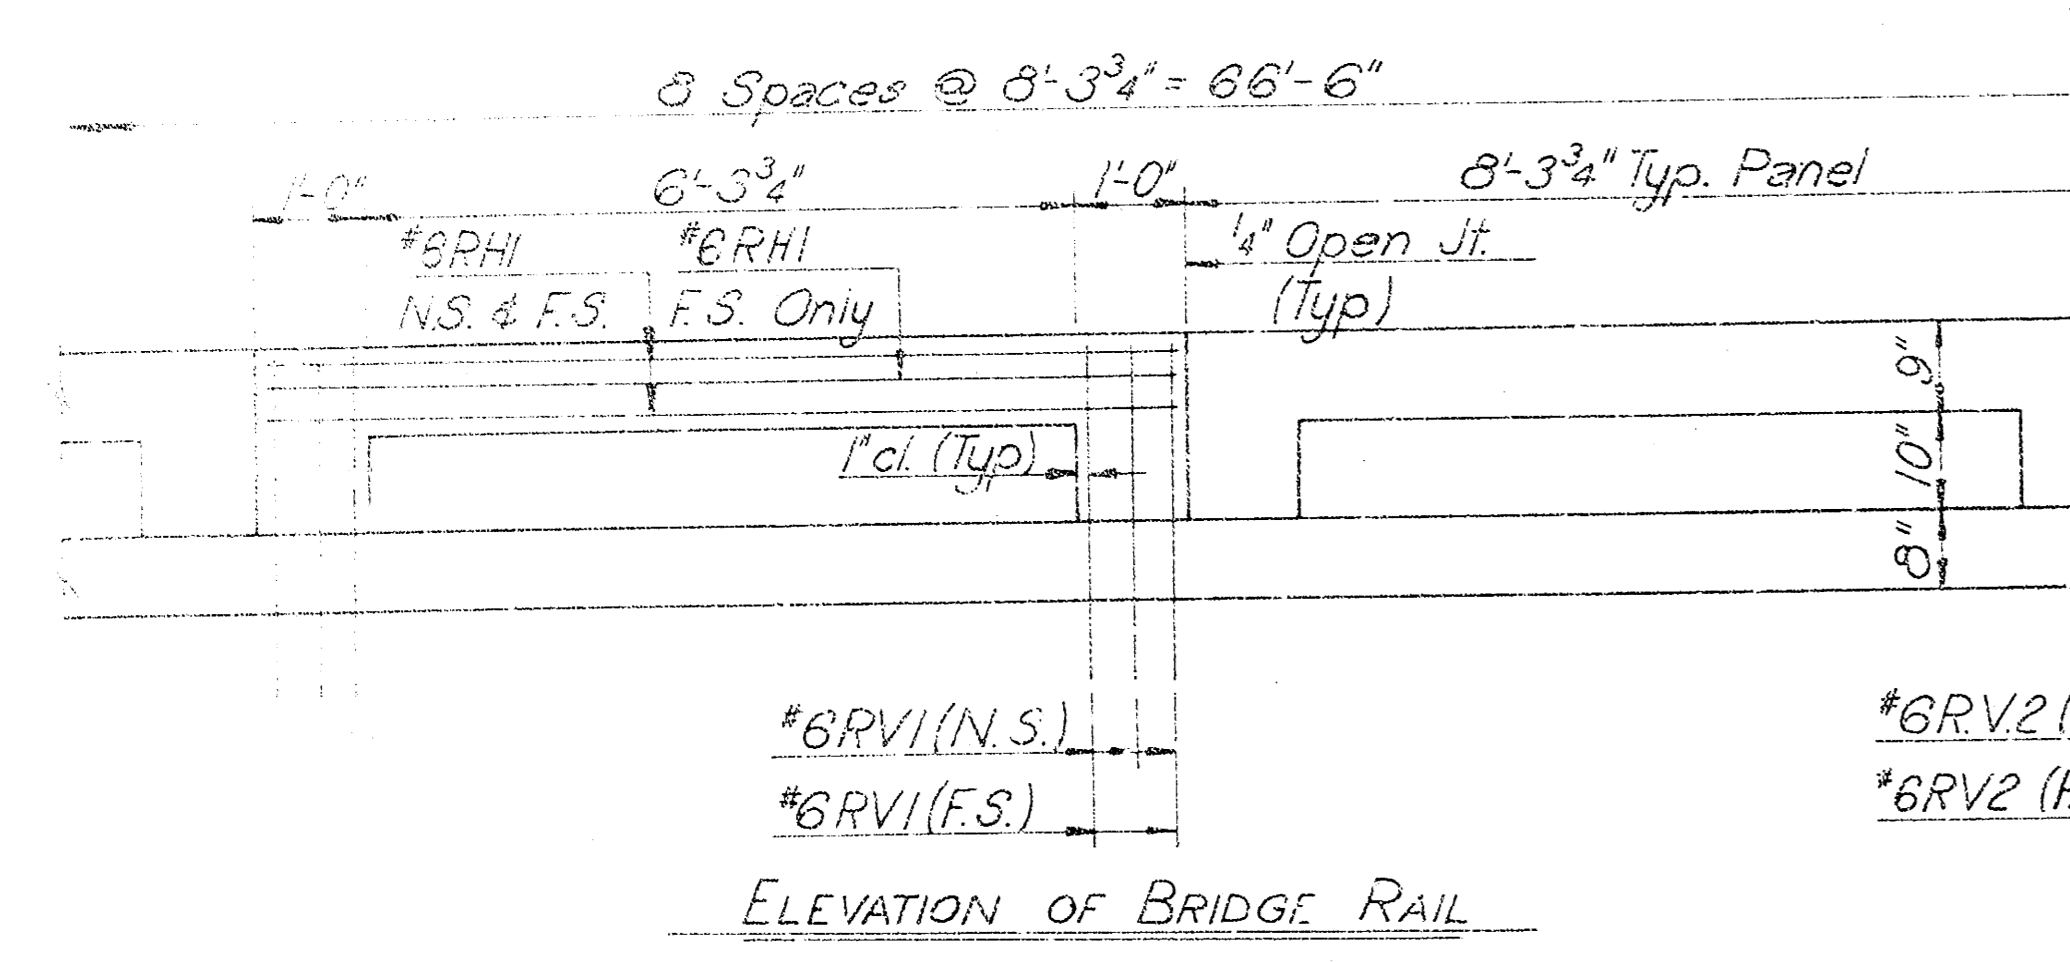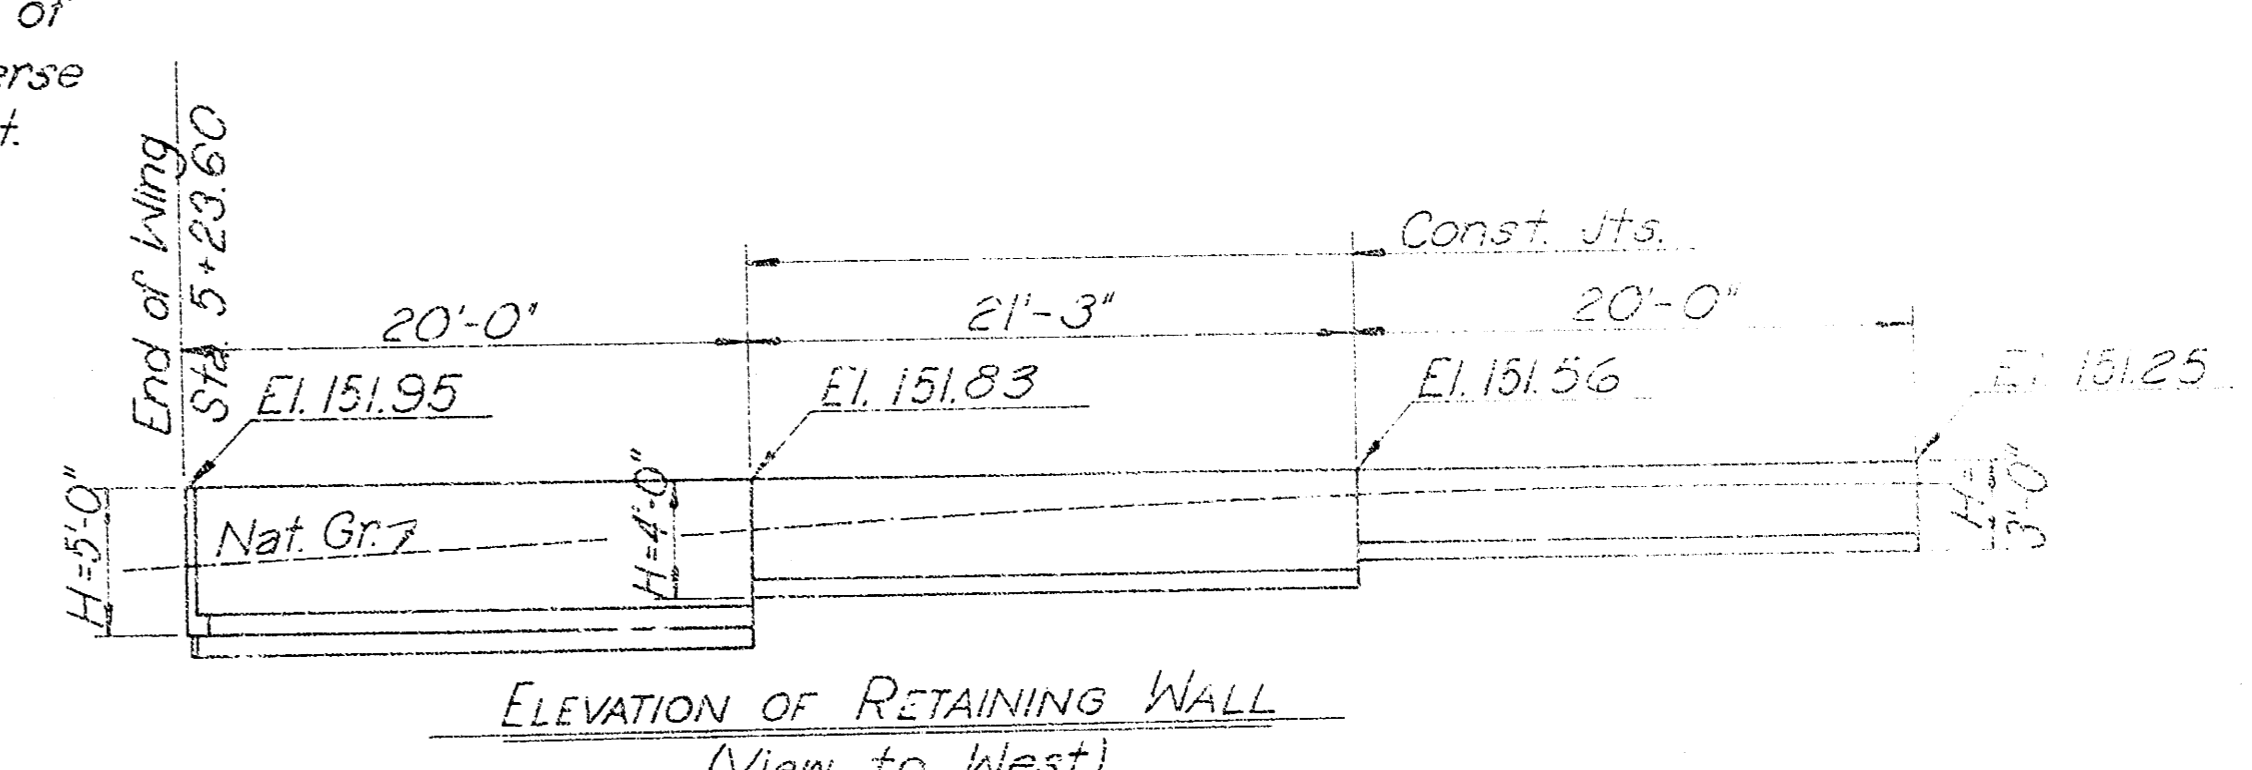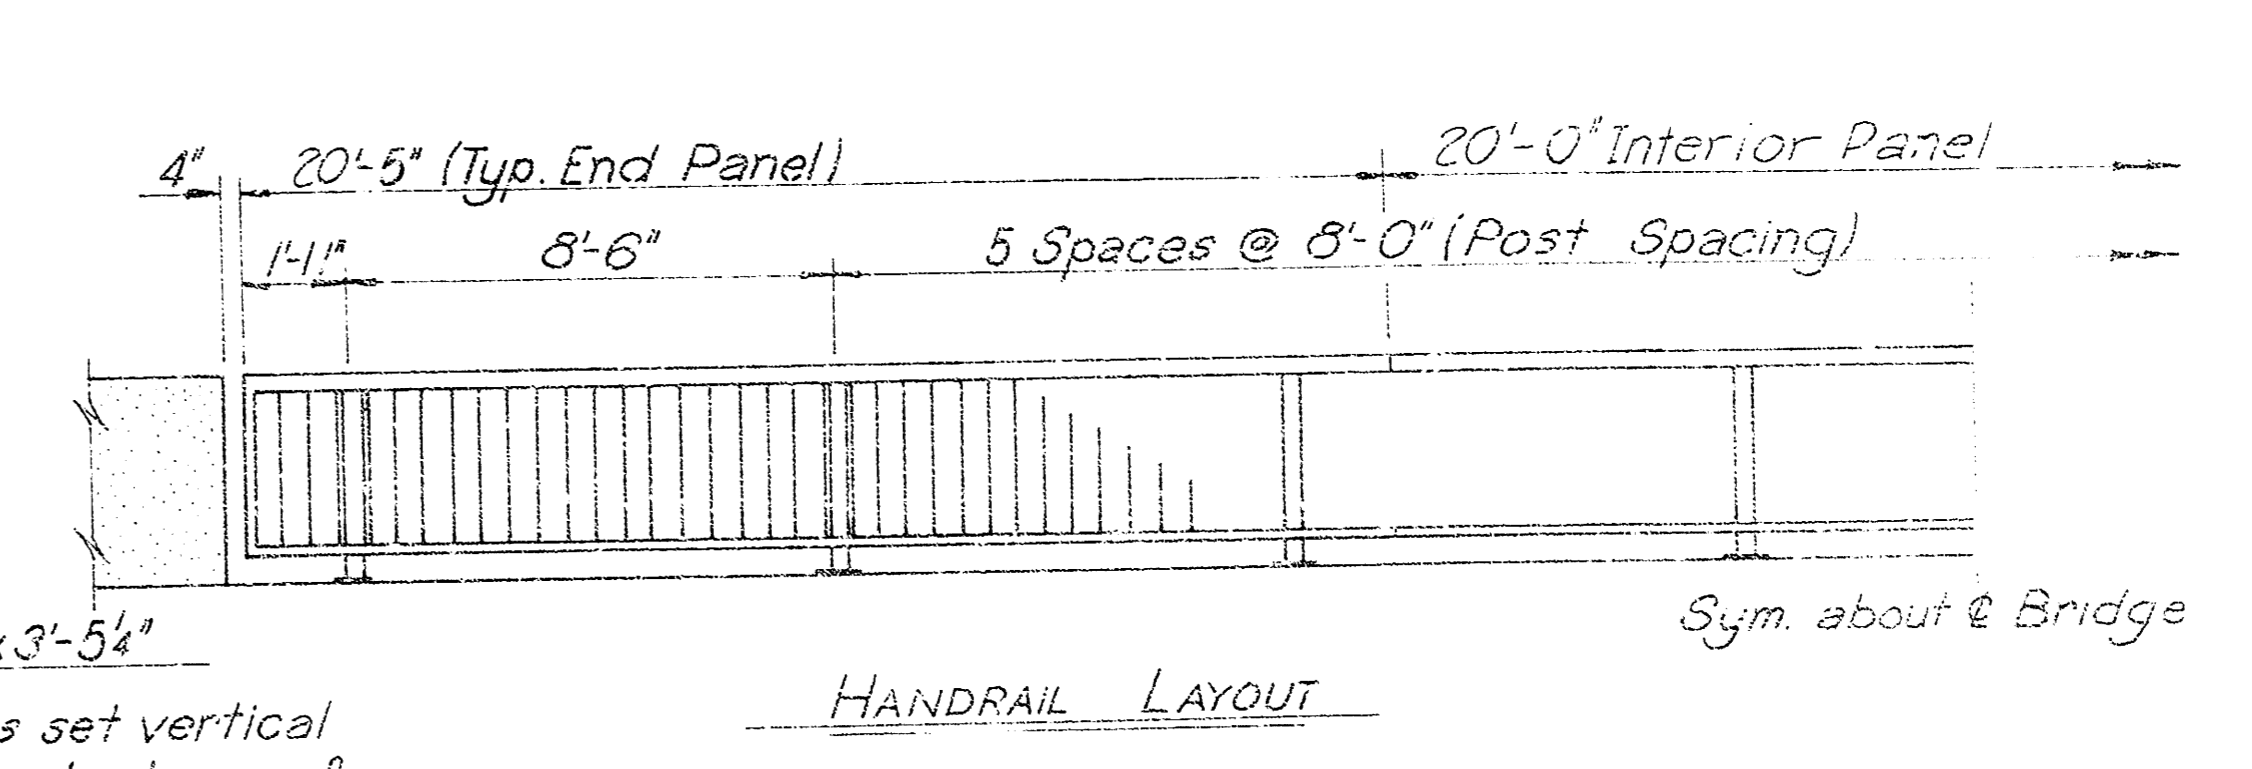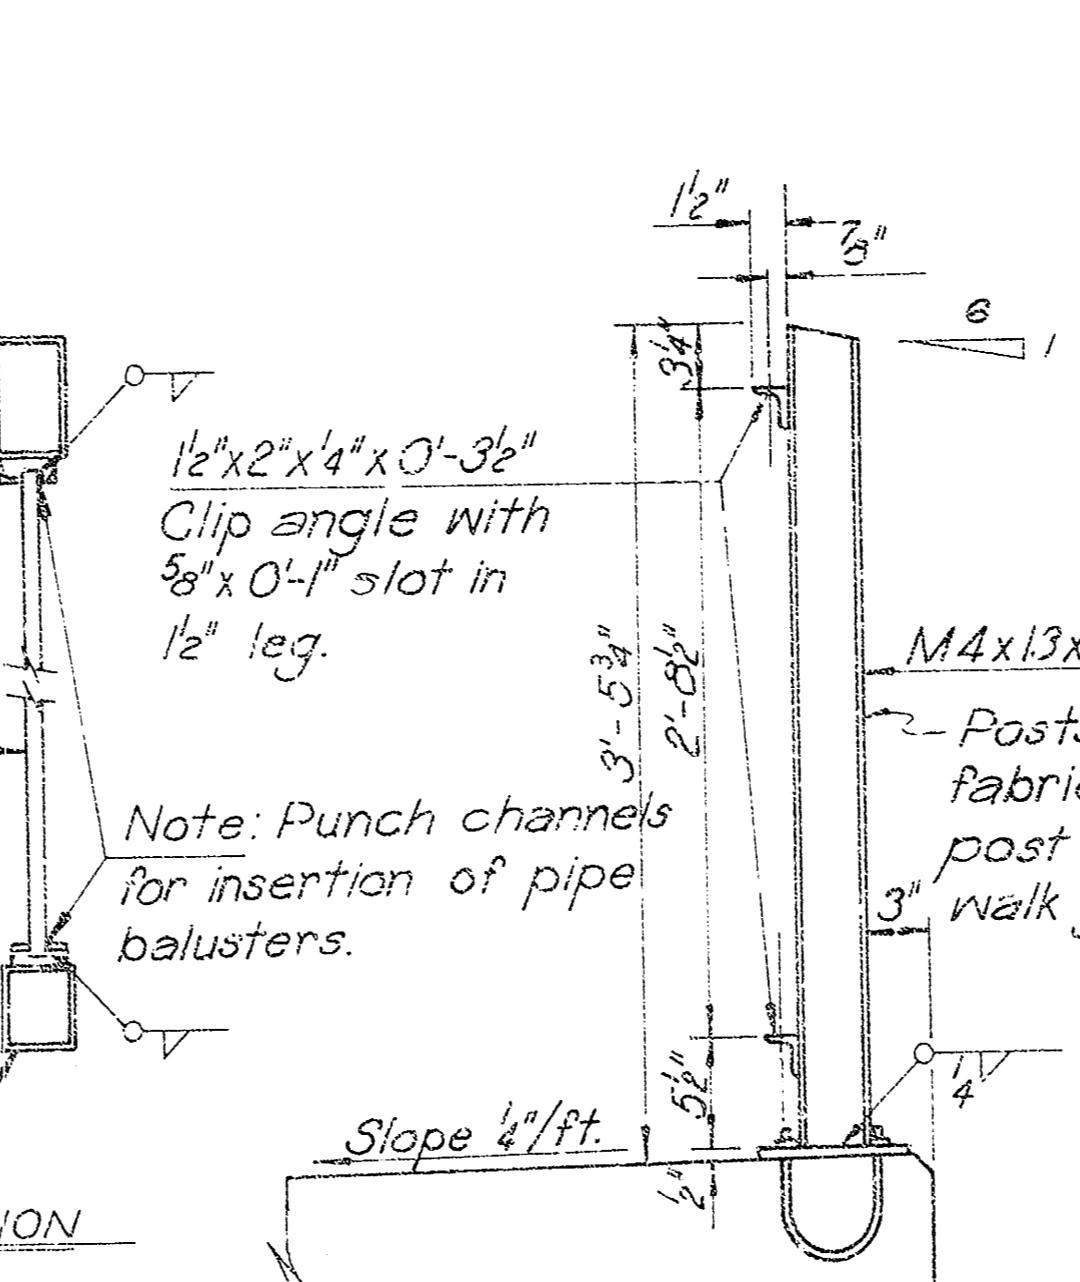
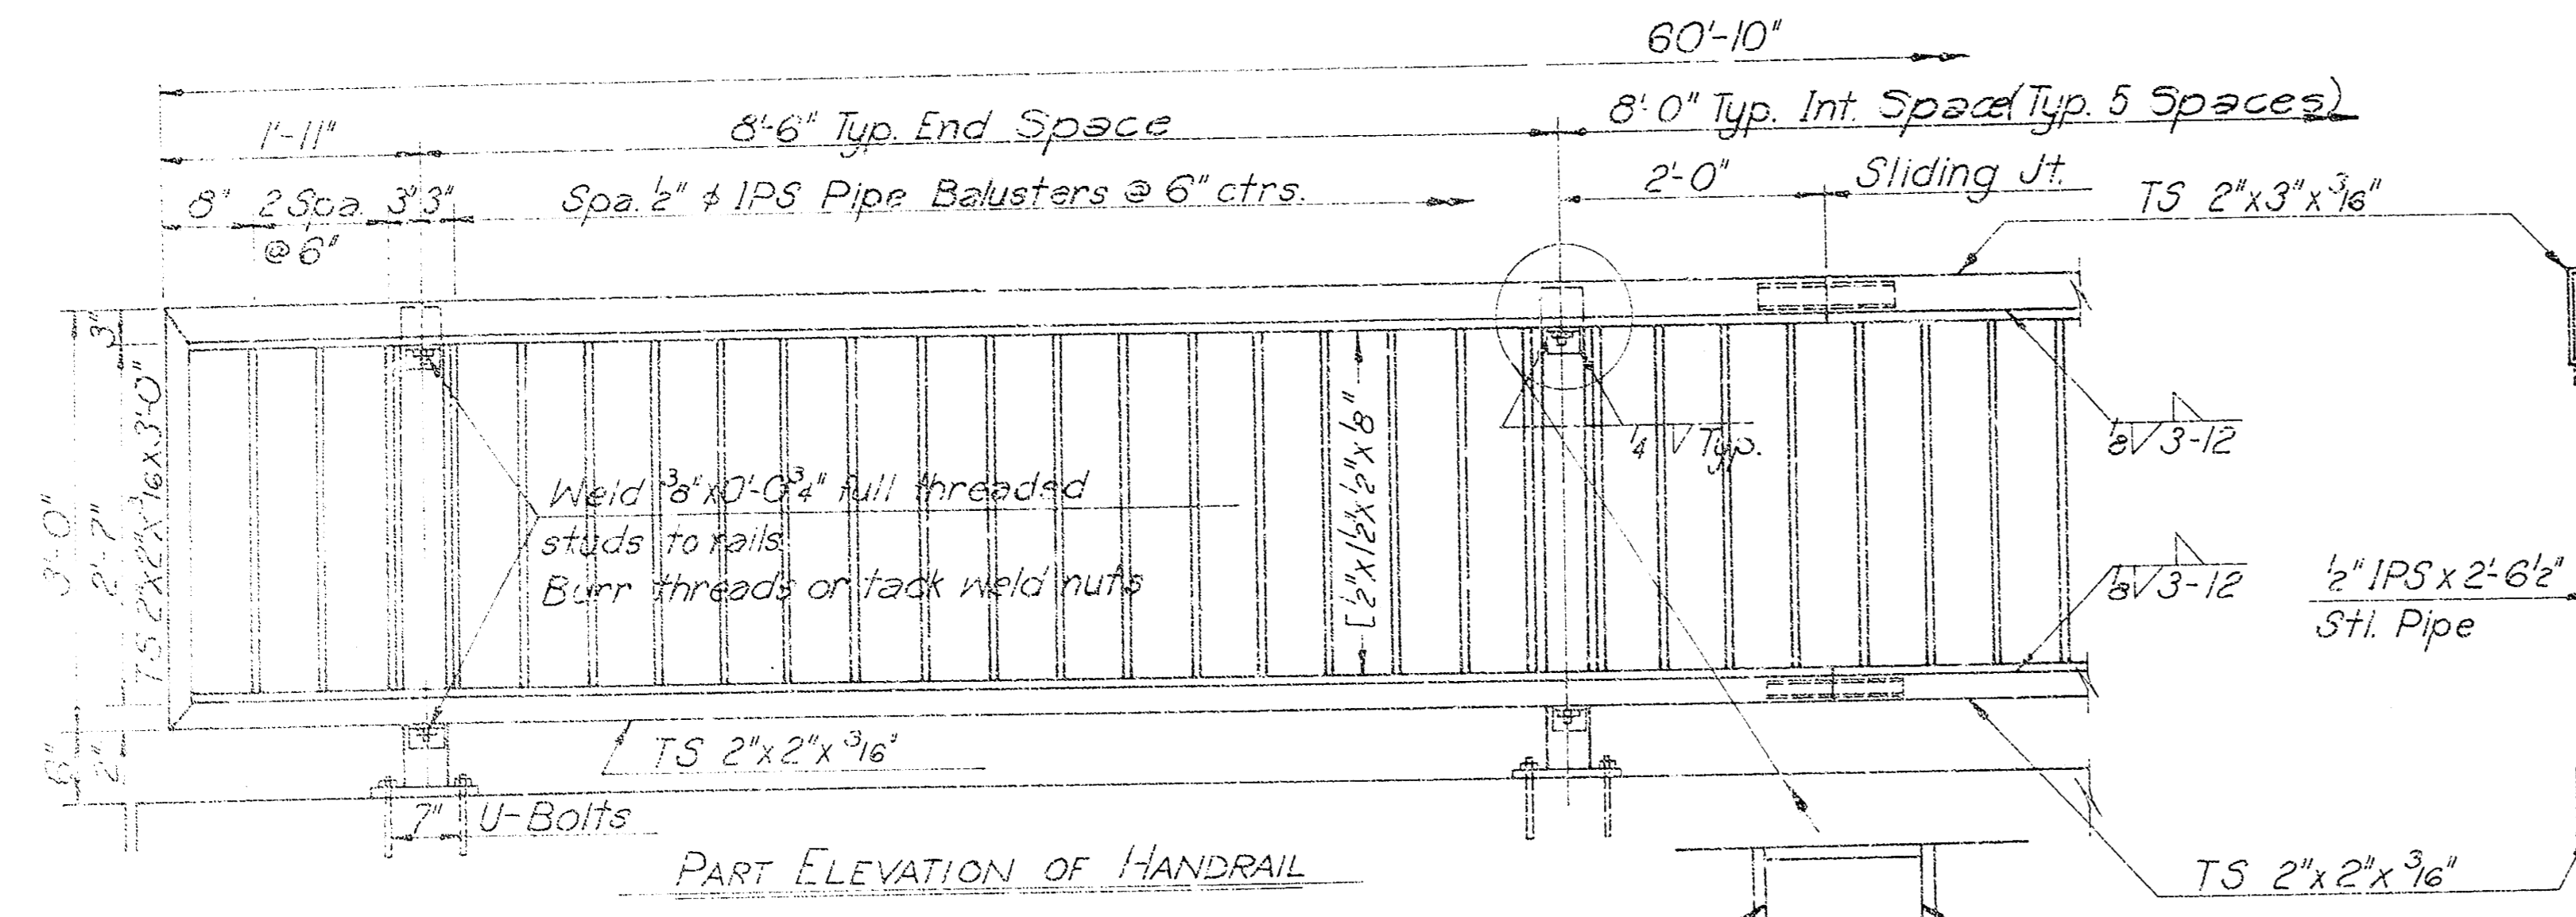


**NOTE:**  
 Class AAA (AE) Concrete shall be used in approach slabs, including sidewalks and rails. Cure the concrete as provided for bridge deck. Approximate quantities, each slab (two thus); Class AAA (AE) Concrete: 31.5 Cu. Yds. Reinforcing Steel: 3,960 Lbs.\*  
 \*Includes 25 Lbs. welded wire mesh.

Class A (AE) Concrete shall be used in retaining walls. Post sockets will not be paid for directly, but shall be subsidiary to the item "Chain Link Fence". Excavation for retaining wall shall not be paid for directly, but shall be considered subsidiary to the item "Class A (AE) Concrete". See Sheet No. 1 for General Notes. See Sheet No. 7 for Bar List and Bending Diagrams.

CS. 1-11-74	As Built	
REV. 57	2212	DESCRIPTION
CITY OF WICHITA, KANSAS R. W. LINN, P. E., CITY ENGINEER		
VASSAR STREET BRIDGE OVER SLEEPY HOLLOW CREEK APPROACH SLAB, RAILS, RETAINING WALL		
		DELAMATER, FRUND & SCHERER, P.A. ENGINEERS & ARCHITECTS WICHITA, KANSAS
SCALE	DATE December, 1975	DWG. NO. 79-R-6



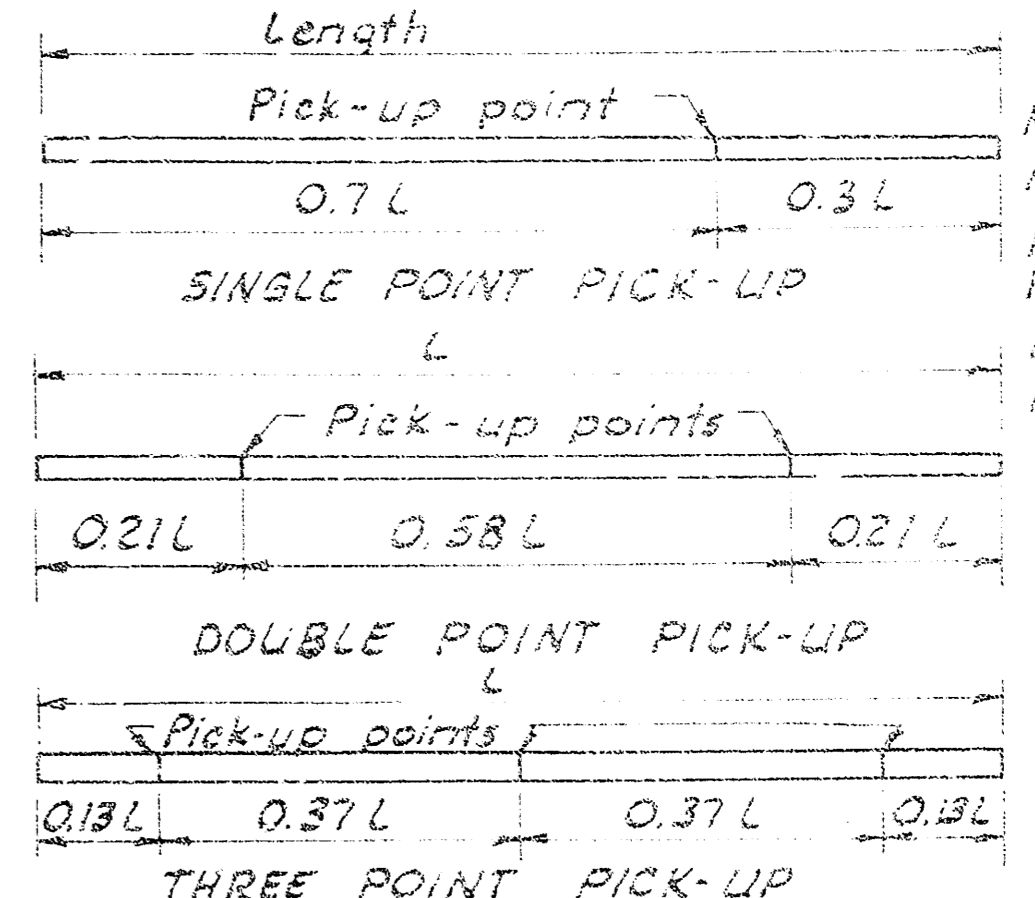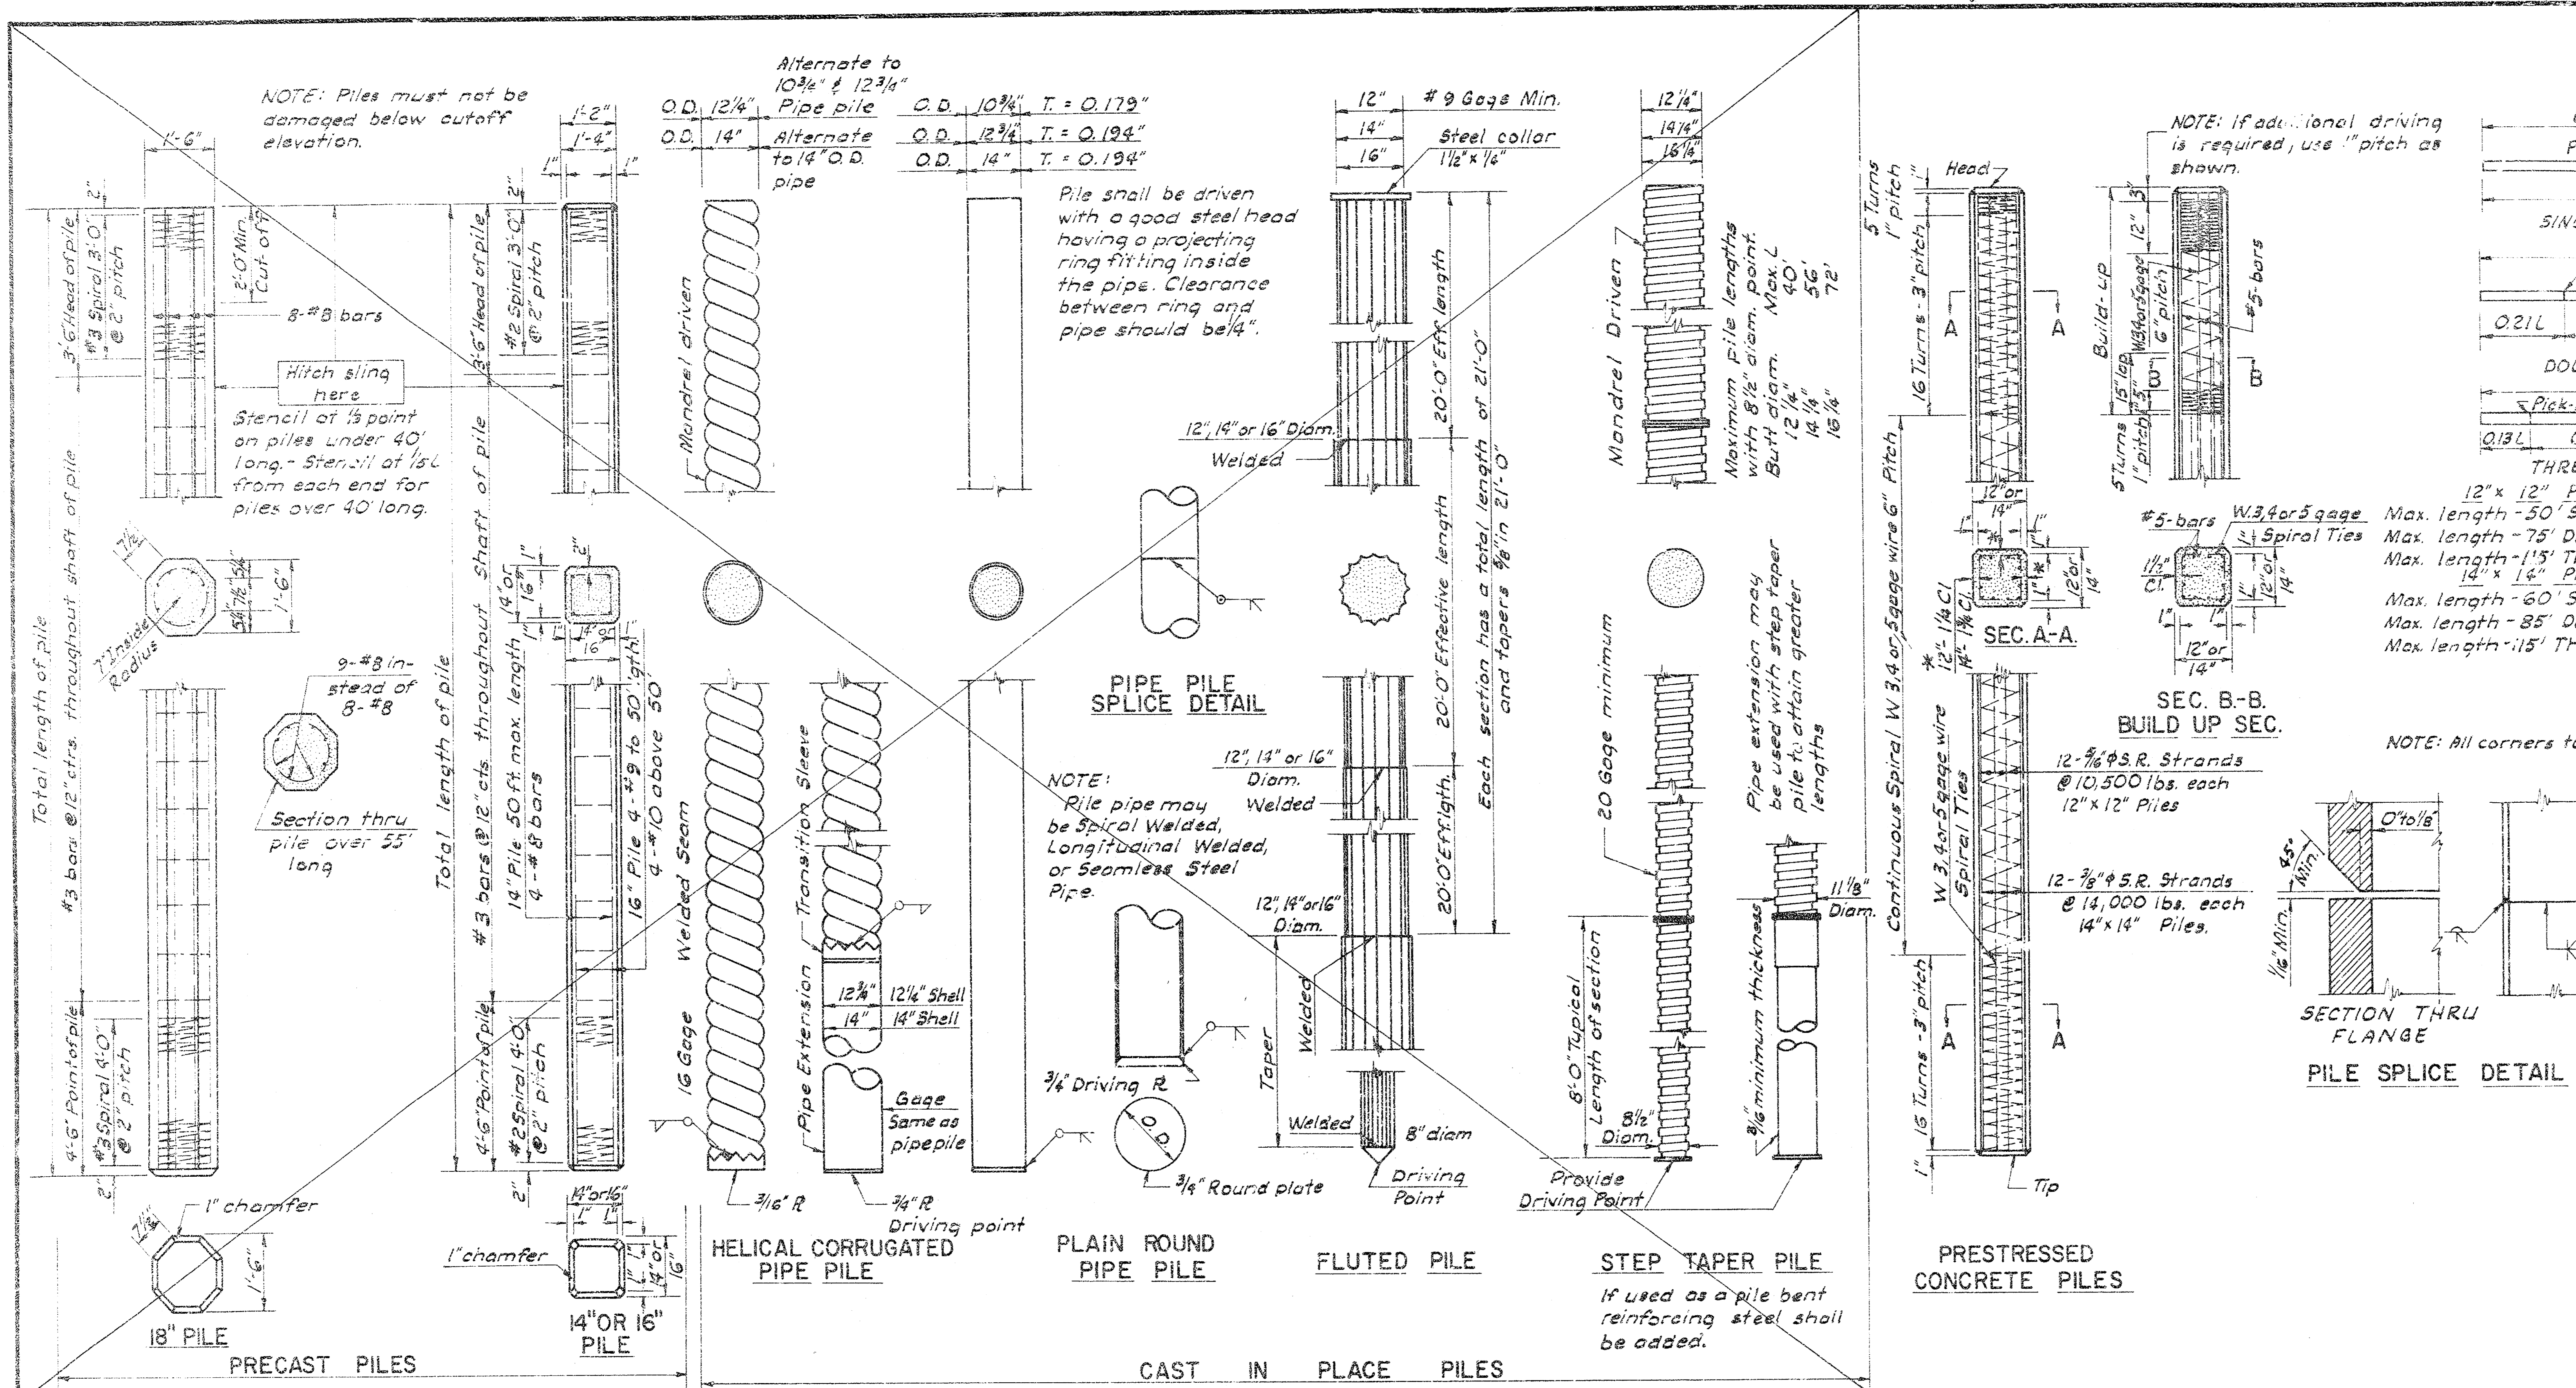

12" x 12" Piles  
 Max. length - 50' Single point pick-up  
 Max. length - 75' Double point pick-up  
 Max. length - 115' Three point pick-up (Prestress only)  
 12" x 14" Piles  
 Max. length - 60' Single point pick-up  
 Max. length - 85' Double point pick-up (Precast only)  
 Max. length - 115' Three point pick-up (Precast only)

FOR INFORMATION ONLY

STEEL PILES		EQUIVALENT CONCRETE PILES					
PIPE	PRECAST	FLUTED	STEP TAPER	PRESTRESSED	FLUTED	STEP TAPER	PRESTRESSED
HP10x33	14"	10 3/4"	12"	12 1/4"	12"	12 1/4"	12"
HP12x33	16"	12 3/4"	14"	14 1/4"	14"	14 1/4"	14"
HP14x33	18"	14"	16"	16 1/4"	16"	16 1/4"	16"


PIPE		EQUIVALENT CONCRETE PILES					
PIPE	PRECAST	FLUTED	STEP TAPER	PRESTRESSED	FLUTED	STEP TAPER	PRESTRESSED
10 3/4"	14"	12"	12 1/4"	12"	12 1/4"	12"	12 1/4"
12 3/4"	16"	14"	14 1/4"	14"	14 1/4"	14"	14 1/4"
14"	18"	16"	16 1/4"	16"	16 1/4"	16"	16 1/4"

GENERAL NOTES

- Specifications: Standard Specifications for State Road and Bridge Construction as currently used by the State Highway Commission of Kansas. (Ed. 1973).
- Concrete: Concrete for cast-in-place shall be Class A concrete,  $f'_c = 3,000$  p.s.i. See Sub-Article 703.07 (f)(2) Standard Specifications. Concrete for Precast and for Prestressed shall be Class AAA concrete  $f'_c = 4,000$  p.s.i. See Article 703.07 (a) Standard Specifications.
- Reinforcement: Reinforcing bars shall be new billet steel ASTM, Designation A-615 grade 40 without exception. Hoops and spirals may be either plain or deformed bars. See Sub-Section 1006.01 Standard Specifications.
- Precast Piles: Precast piles shall conform to the requirements of Article 703.07 (a)(b)(c)(d) Standard Specifications.
- Cast-in-Place Shells: Steel shells for Cast-in-Place Concrete Piles shall conform to the requirements of Sub-Section 1006.06 Standard Specifications. All piles driven without mandrel shall be of the minimum gages or thicknesses shown above, except Fluted pile use No. 9 gage minimum. Piles driven with mandrel shall be of sufficient strength and thickness to withstand driving without injury and to resist harmful distortion and/or buckling due to soil pressure after the mandrel is removed. Improperly driven, broken or otherwise defective shells shall be removed and replaced or otherwise corrected to the satisfaction of the Engineer, or the driving of an additional pile at no extra cost.






- The contractor shall maintain on the job at all times prior to and during the filling of the shells, a light suitable for visual inspection of the pile.
- Steel Pile: Steel pile shall conform to requirements of Article 1006.04 (e) Standard Specifications.
- Pile Points: Pile points shall conform to the dimensions shown and requirements of Sub-Article 1006.06 (b)(3) Standard Specification. Pile points shall be mill welded to pile.
- Welding: All field welding shall meet the requirements of Sub-Section 703.06 Standard Specifications.
- Point: All point shall comply with Sub-Section 1008.06 Standard Specifications, or as specified on the plans.
- Test Piles: Test Piles shall be driven where called for on the Bridge plans. The test piles located within the limits of the substructure will become a part of the Bridge Pile System.
- Splices: Splices for Steel Piles and Shell Piling shall be in accordance with details shown on this sheet and shall comply with Sub-Section 703.06 Standard Specifications. Precast Concrete Pile splices shall comply with Sub-Article 703.07 (g)(1) Standard Specifications.

- Prestressed Concrete Pile splices shall be made in accordance with the manufacturers recommendations subject to the approval of the Engineer.
- Driving Formula: Driving formula shall conform to Sub-Article 703.04 (d)(3) Standard Specifications.
- Mill Test Reports: Steel Piles test reports shall comply with Sub-Article 1006.04 (e)(3) Standard Specifications. Steel Shells test reports for cast-in-place piles shall comply with Article 1006.06 (d) Standard Specifications.
- Measurement and Payment: Measurement for all piles shall comply with Sub-Section 703.08 Standard Specifications. Payment for all piles shall comply with Sub-Section 703.09 Standard Specifications.

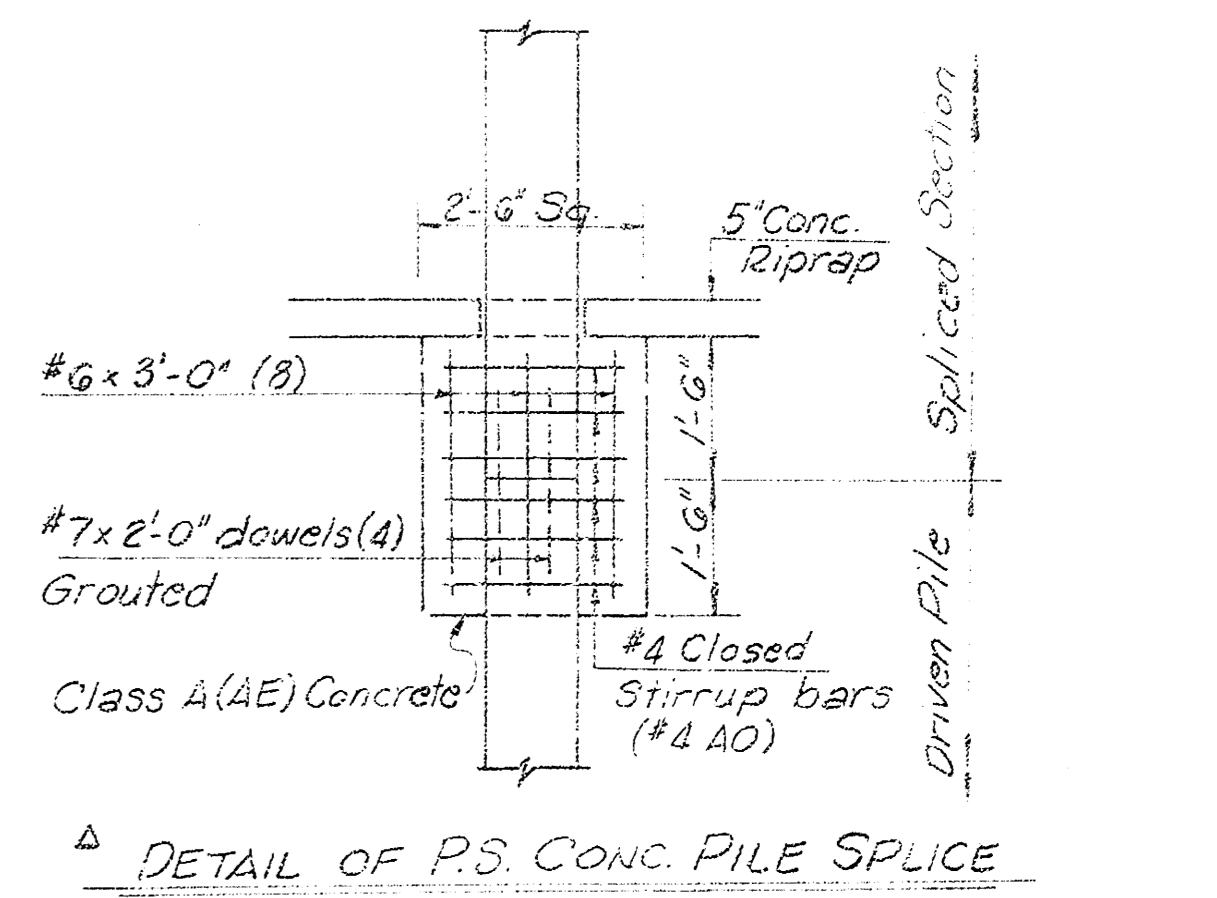

NO.	DATE	REVISIONS	BY	APP'D.
1	1-11-77	79-2 As Built	J.C.L.	T.W.O.
2	2-4-78	Revised for 1973 Const. Spec.	J.C.L.	E.E.W.
3	8-26-66	Revise Entire Gen. Note	J.C.L.	E.E.W.
4	4-8-64	Add Longitudinal/Welded Pipe Pile	J.C.L.	T.W.O.
5	4-4-61	Revise Choice of Pile Note/Note	J.C.L.	T.W.O.
6	3-27-61	Revise Pipe Pile General Note	J.C.L.	T.W.O.
7	1-24-61	Remove hole in Prestressed Conc. Pile	J.C.L.	T.W.O.

STATE	PROJECT NO.	FISCAL YEAR	SHEET NO.	TOTAL SHEETS
KANSAS		1978	9	9

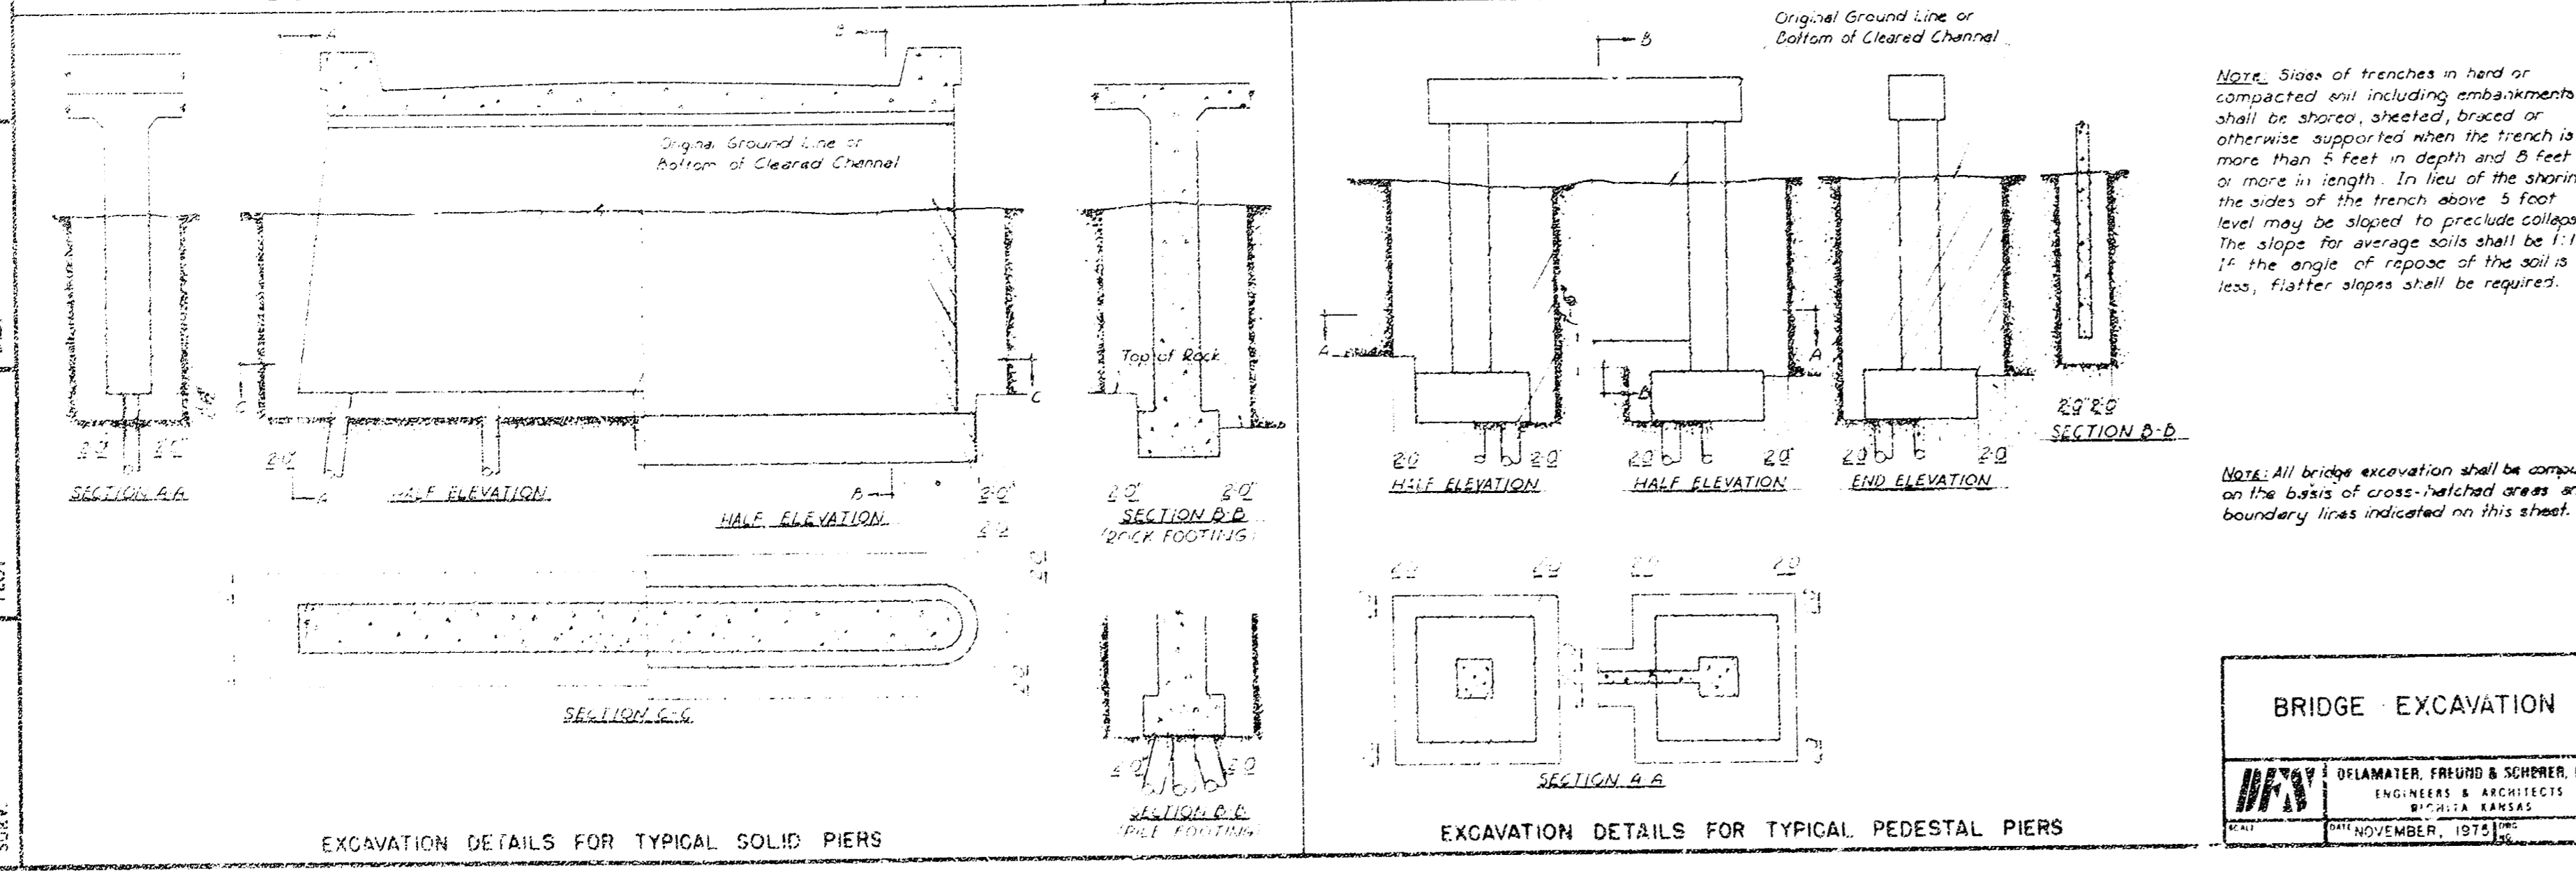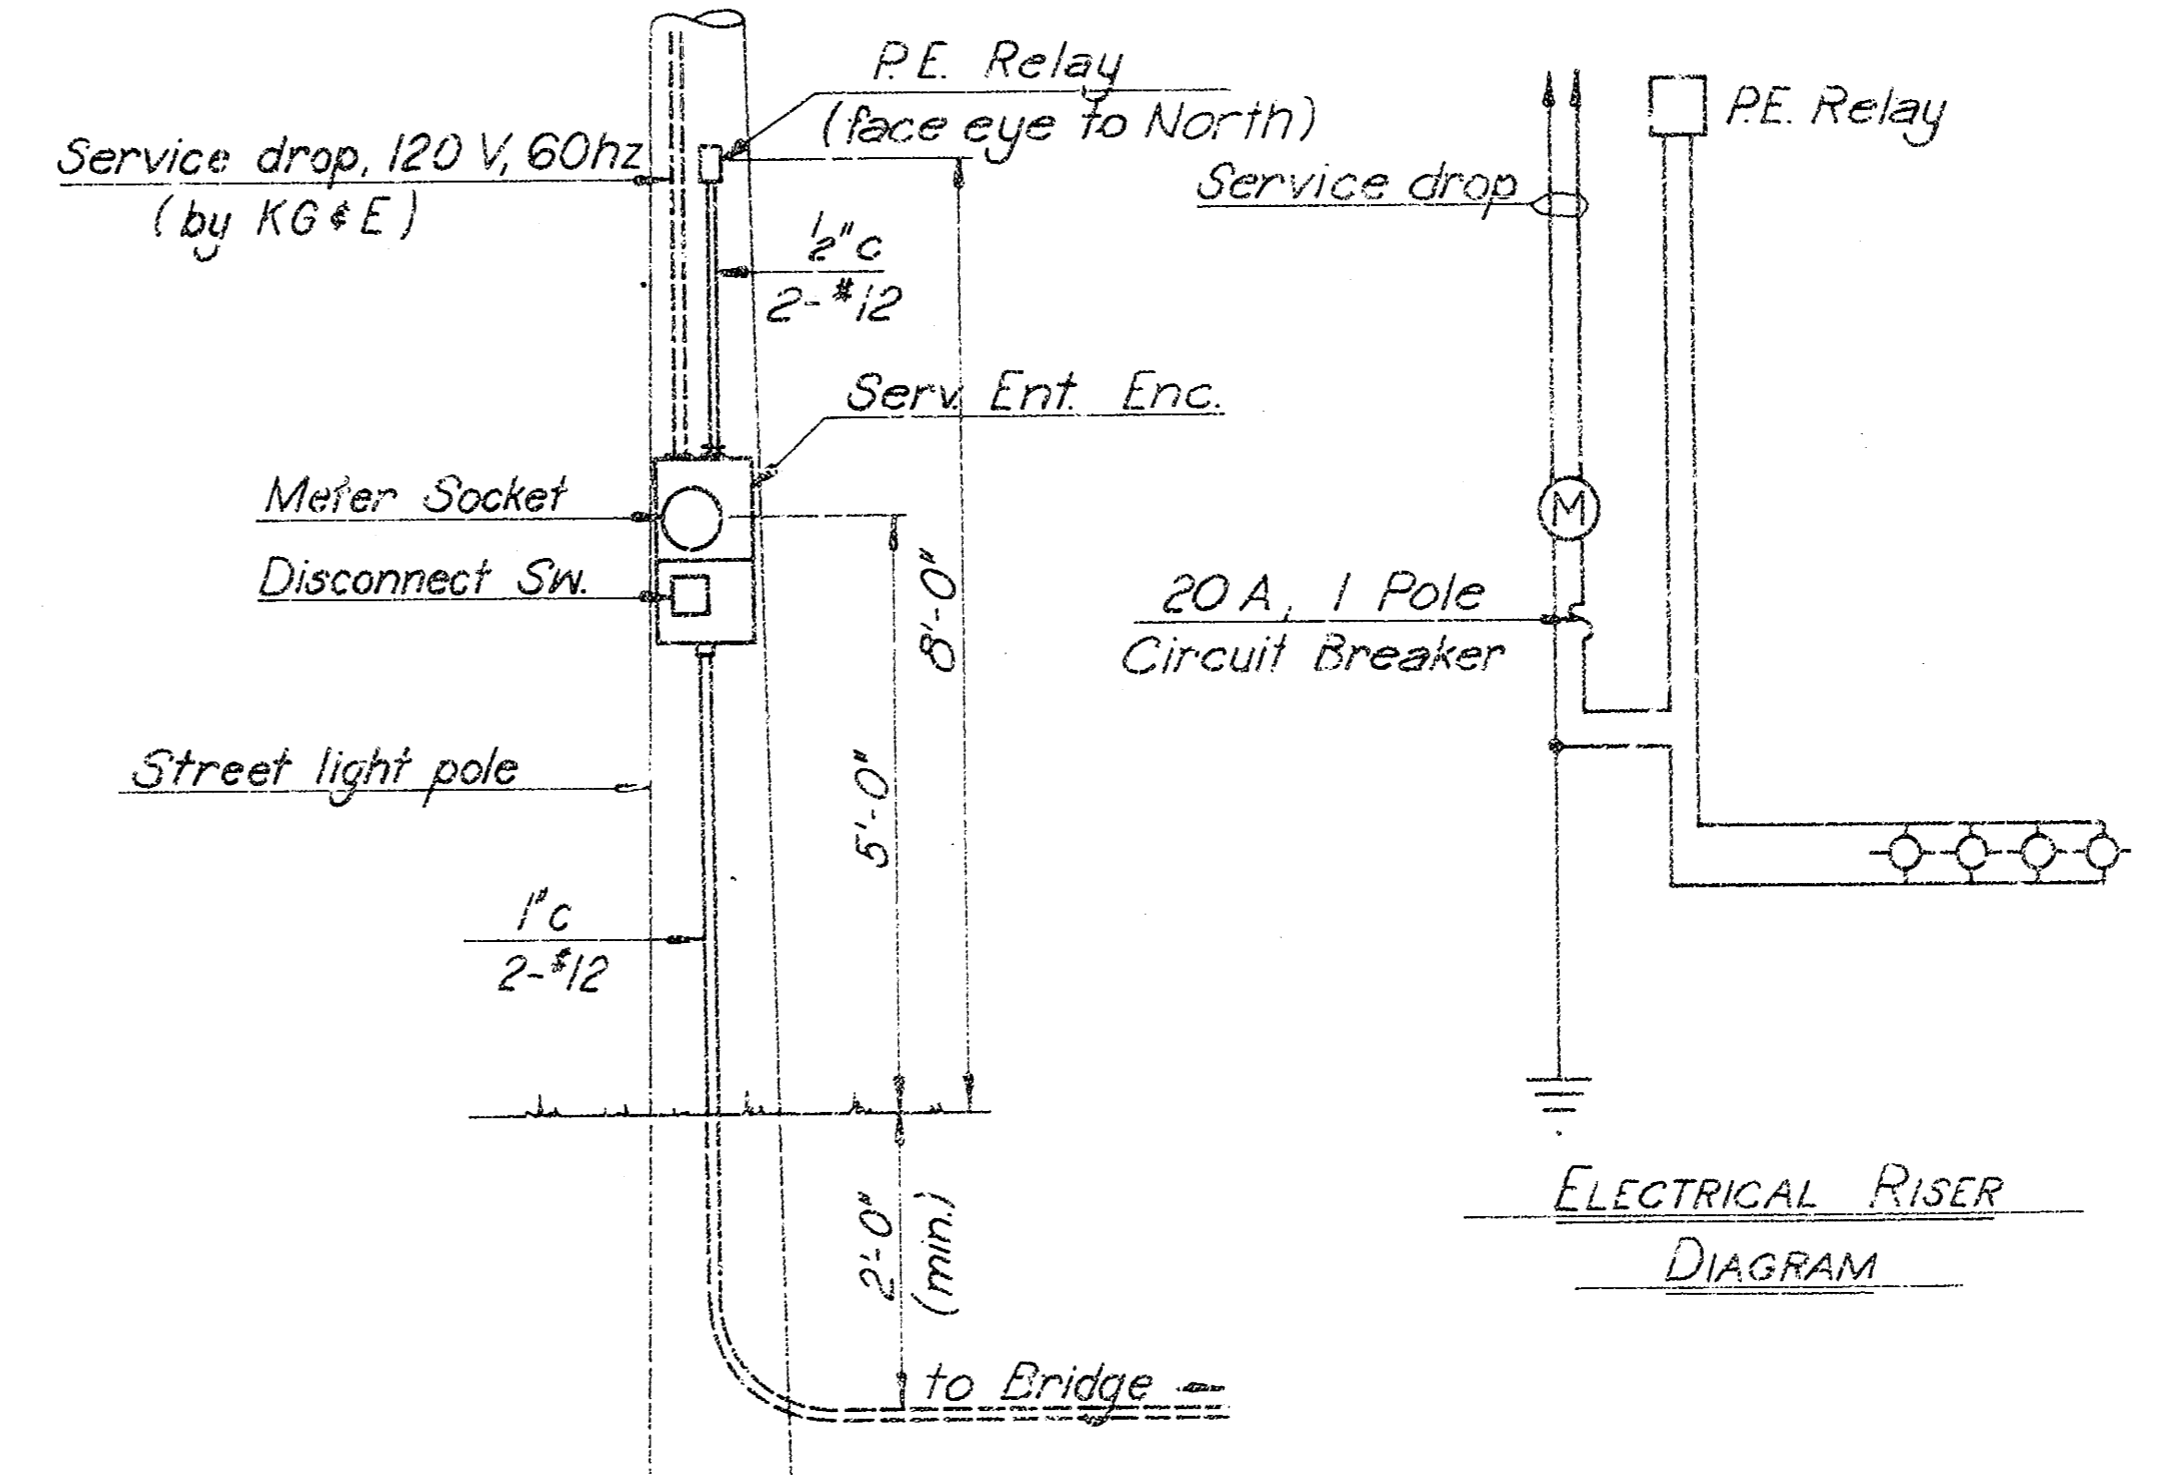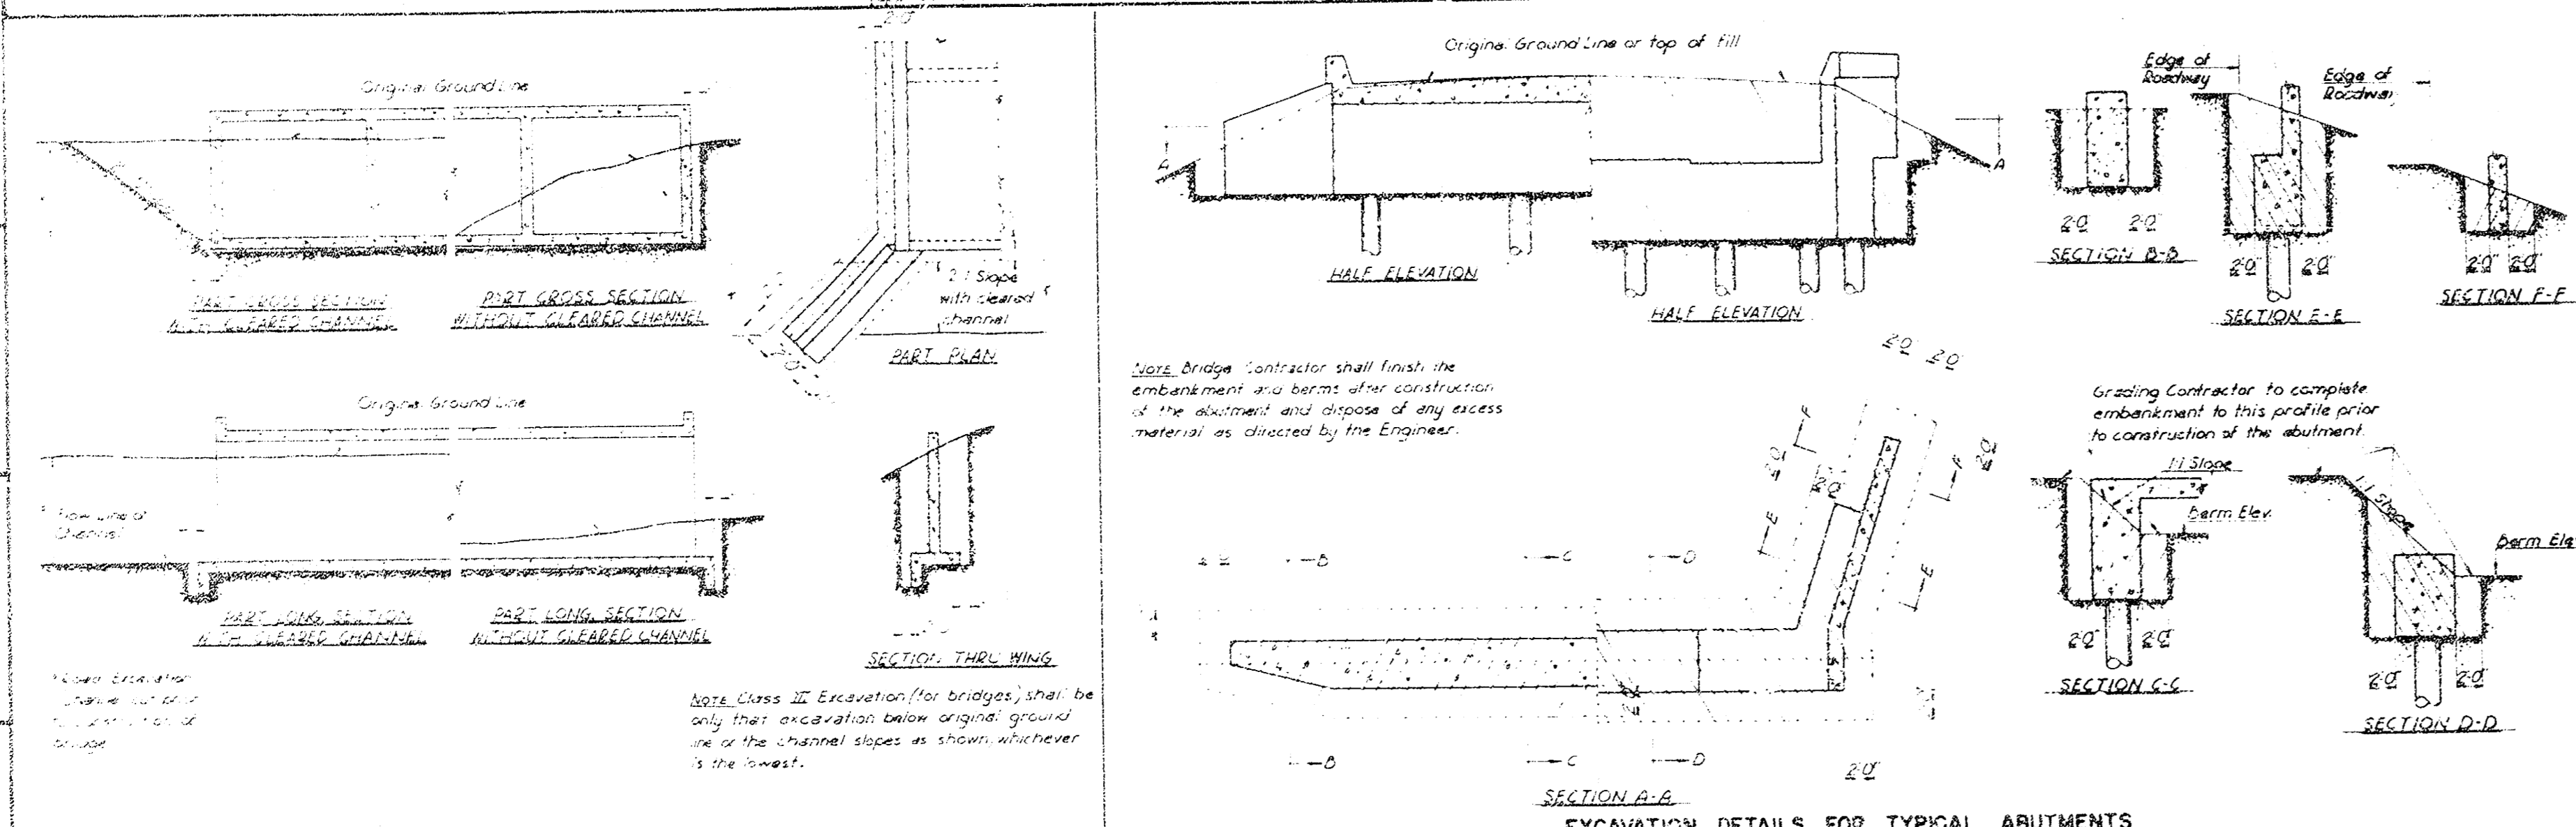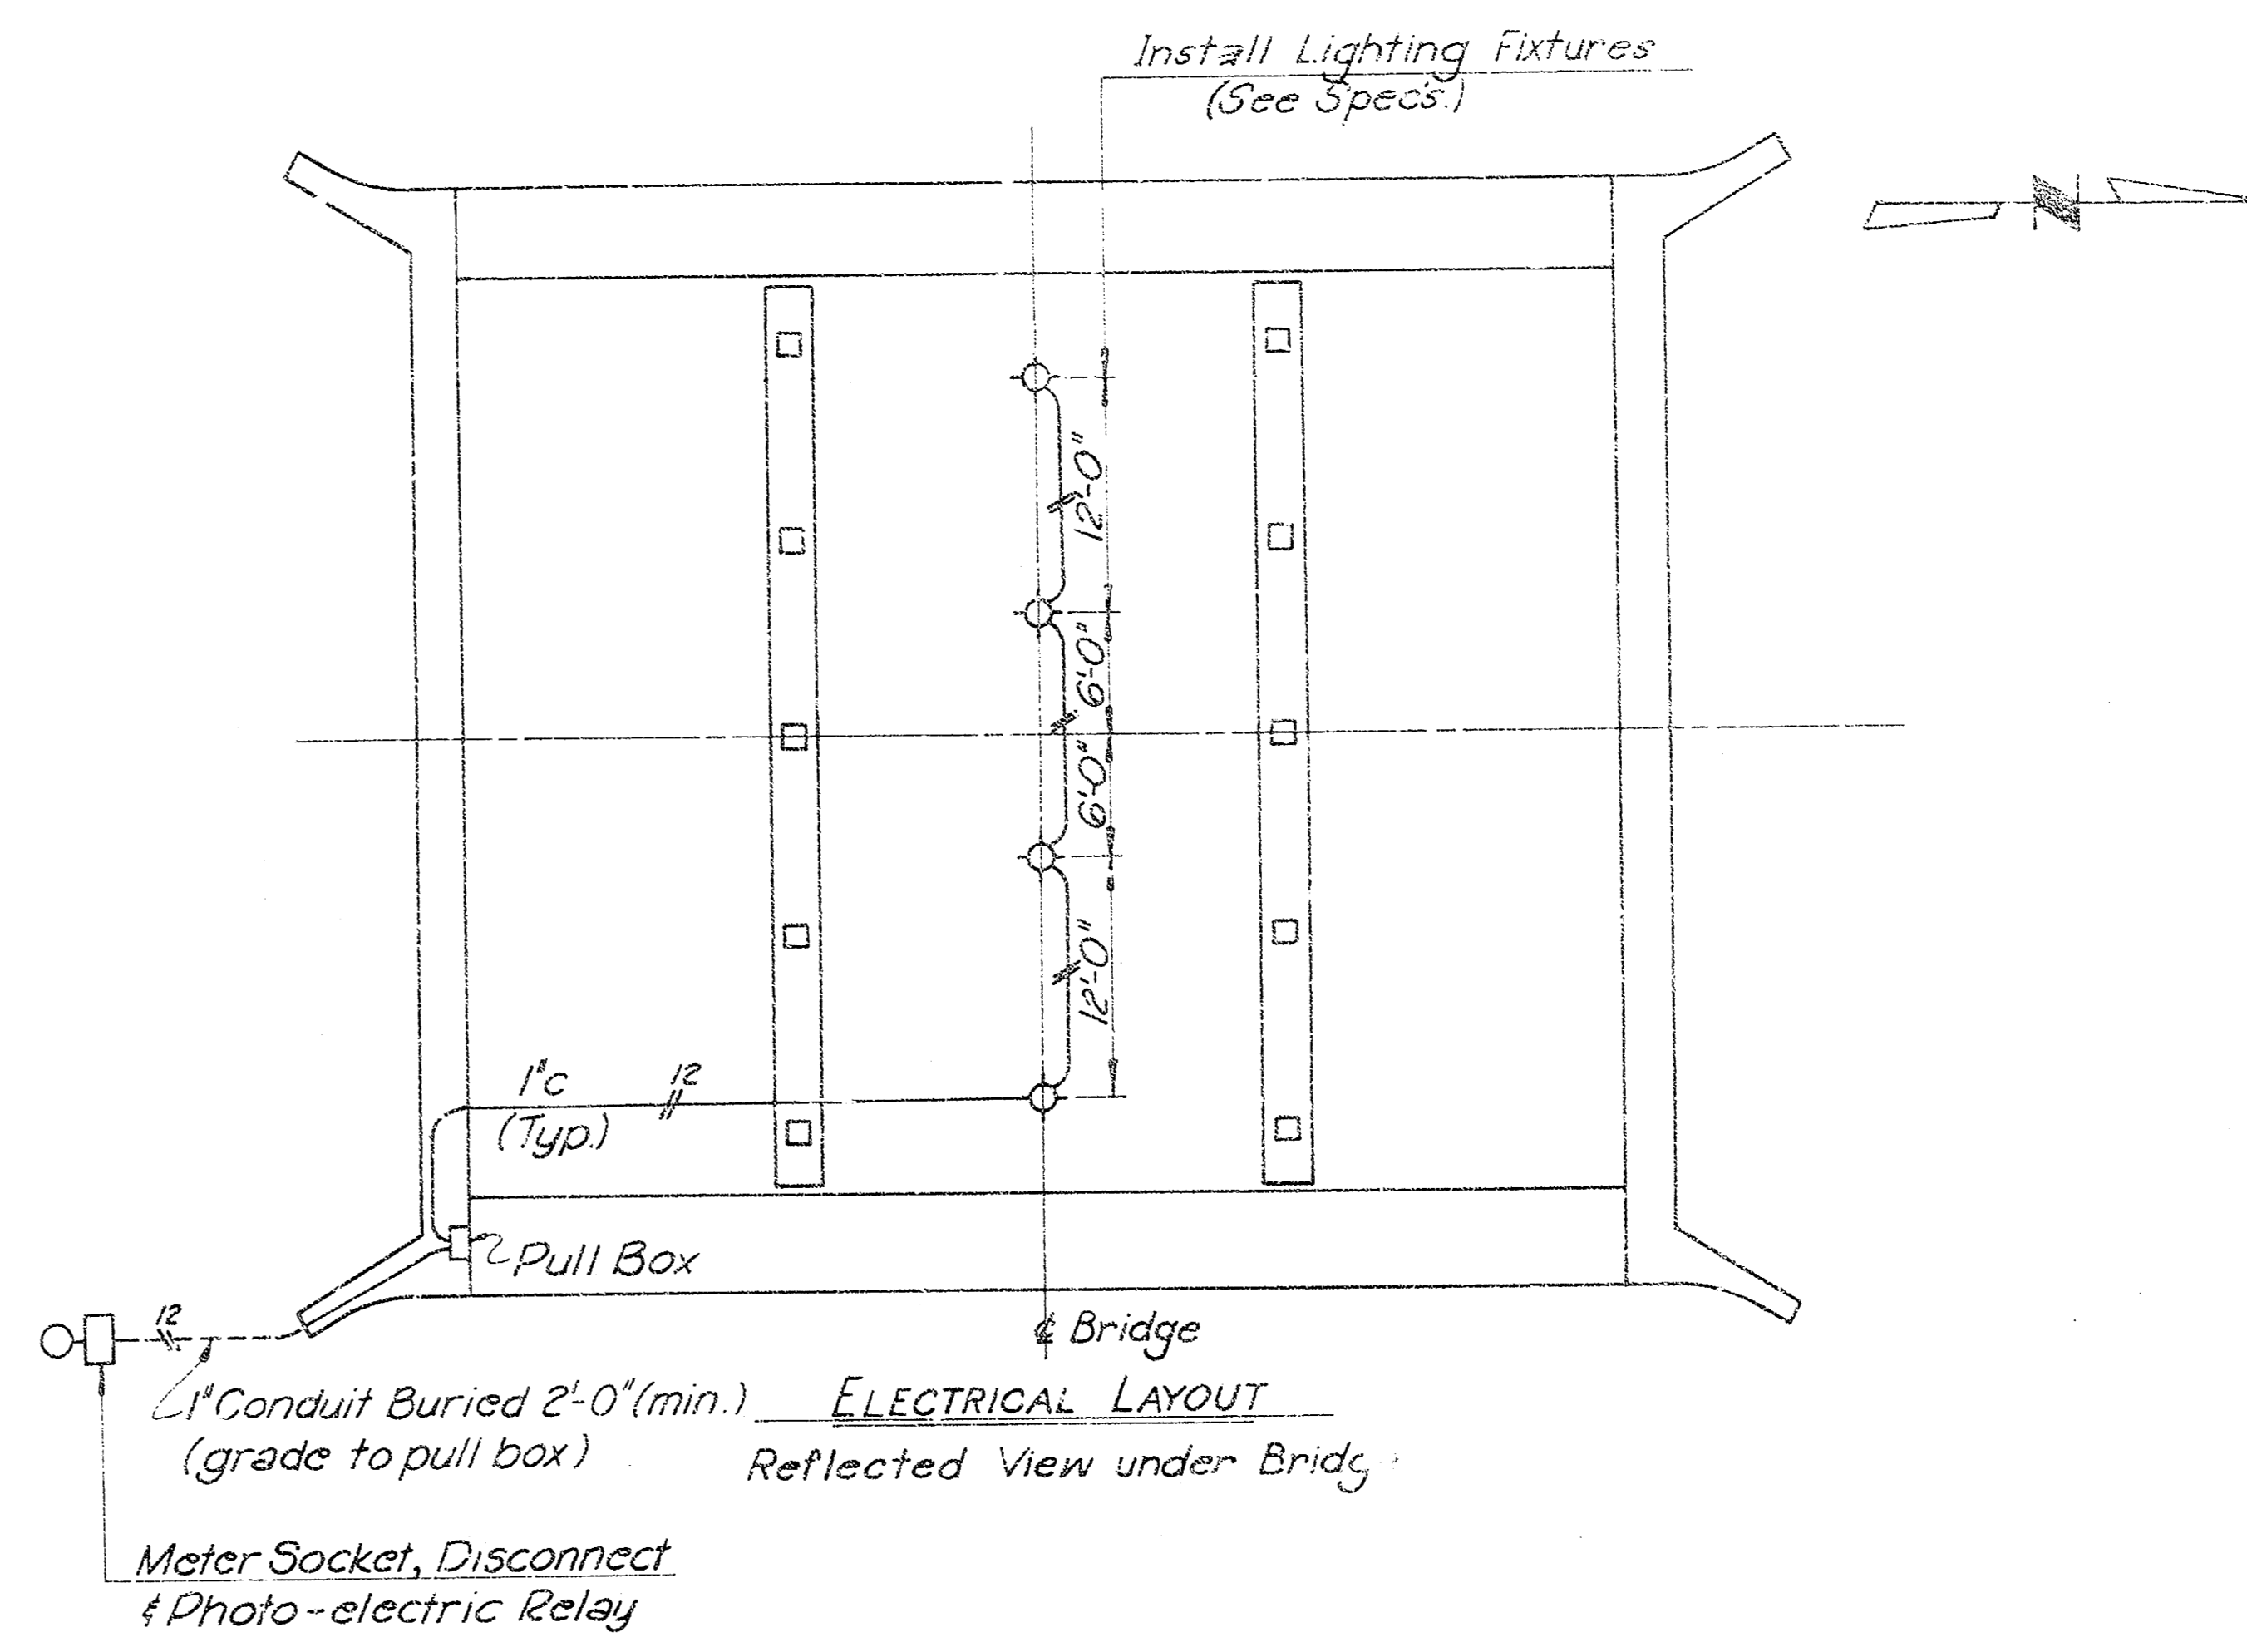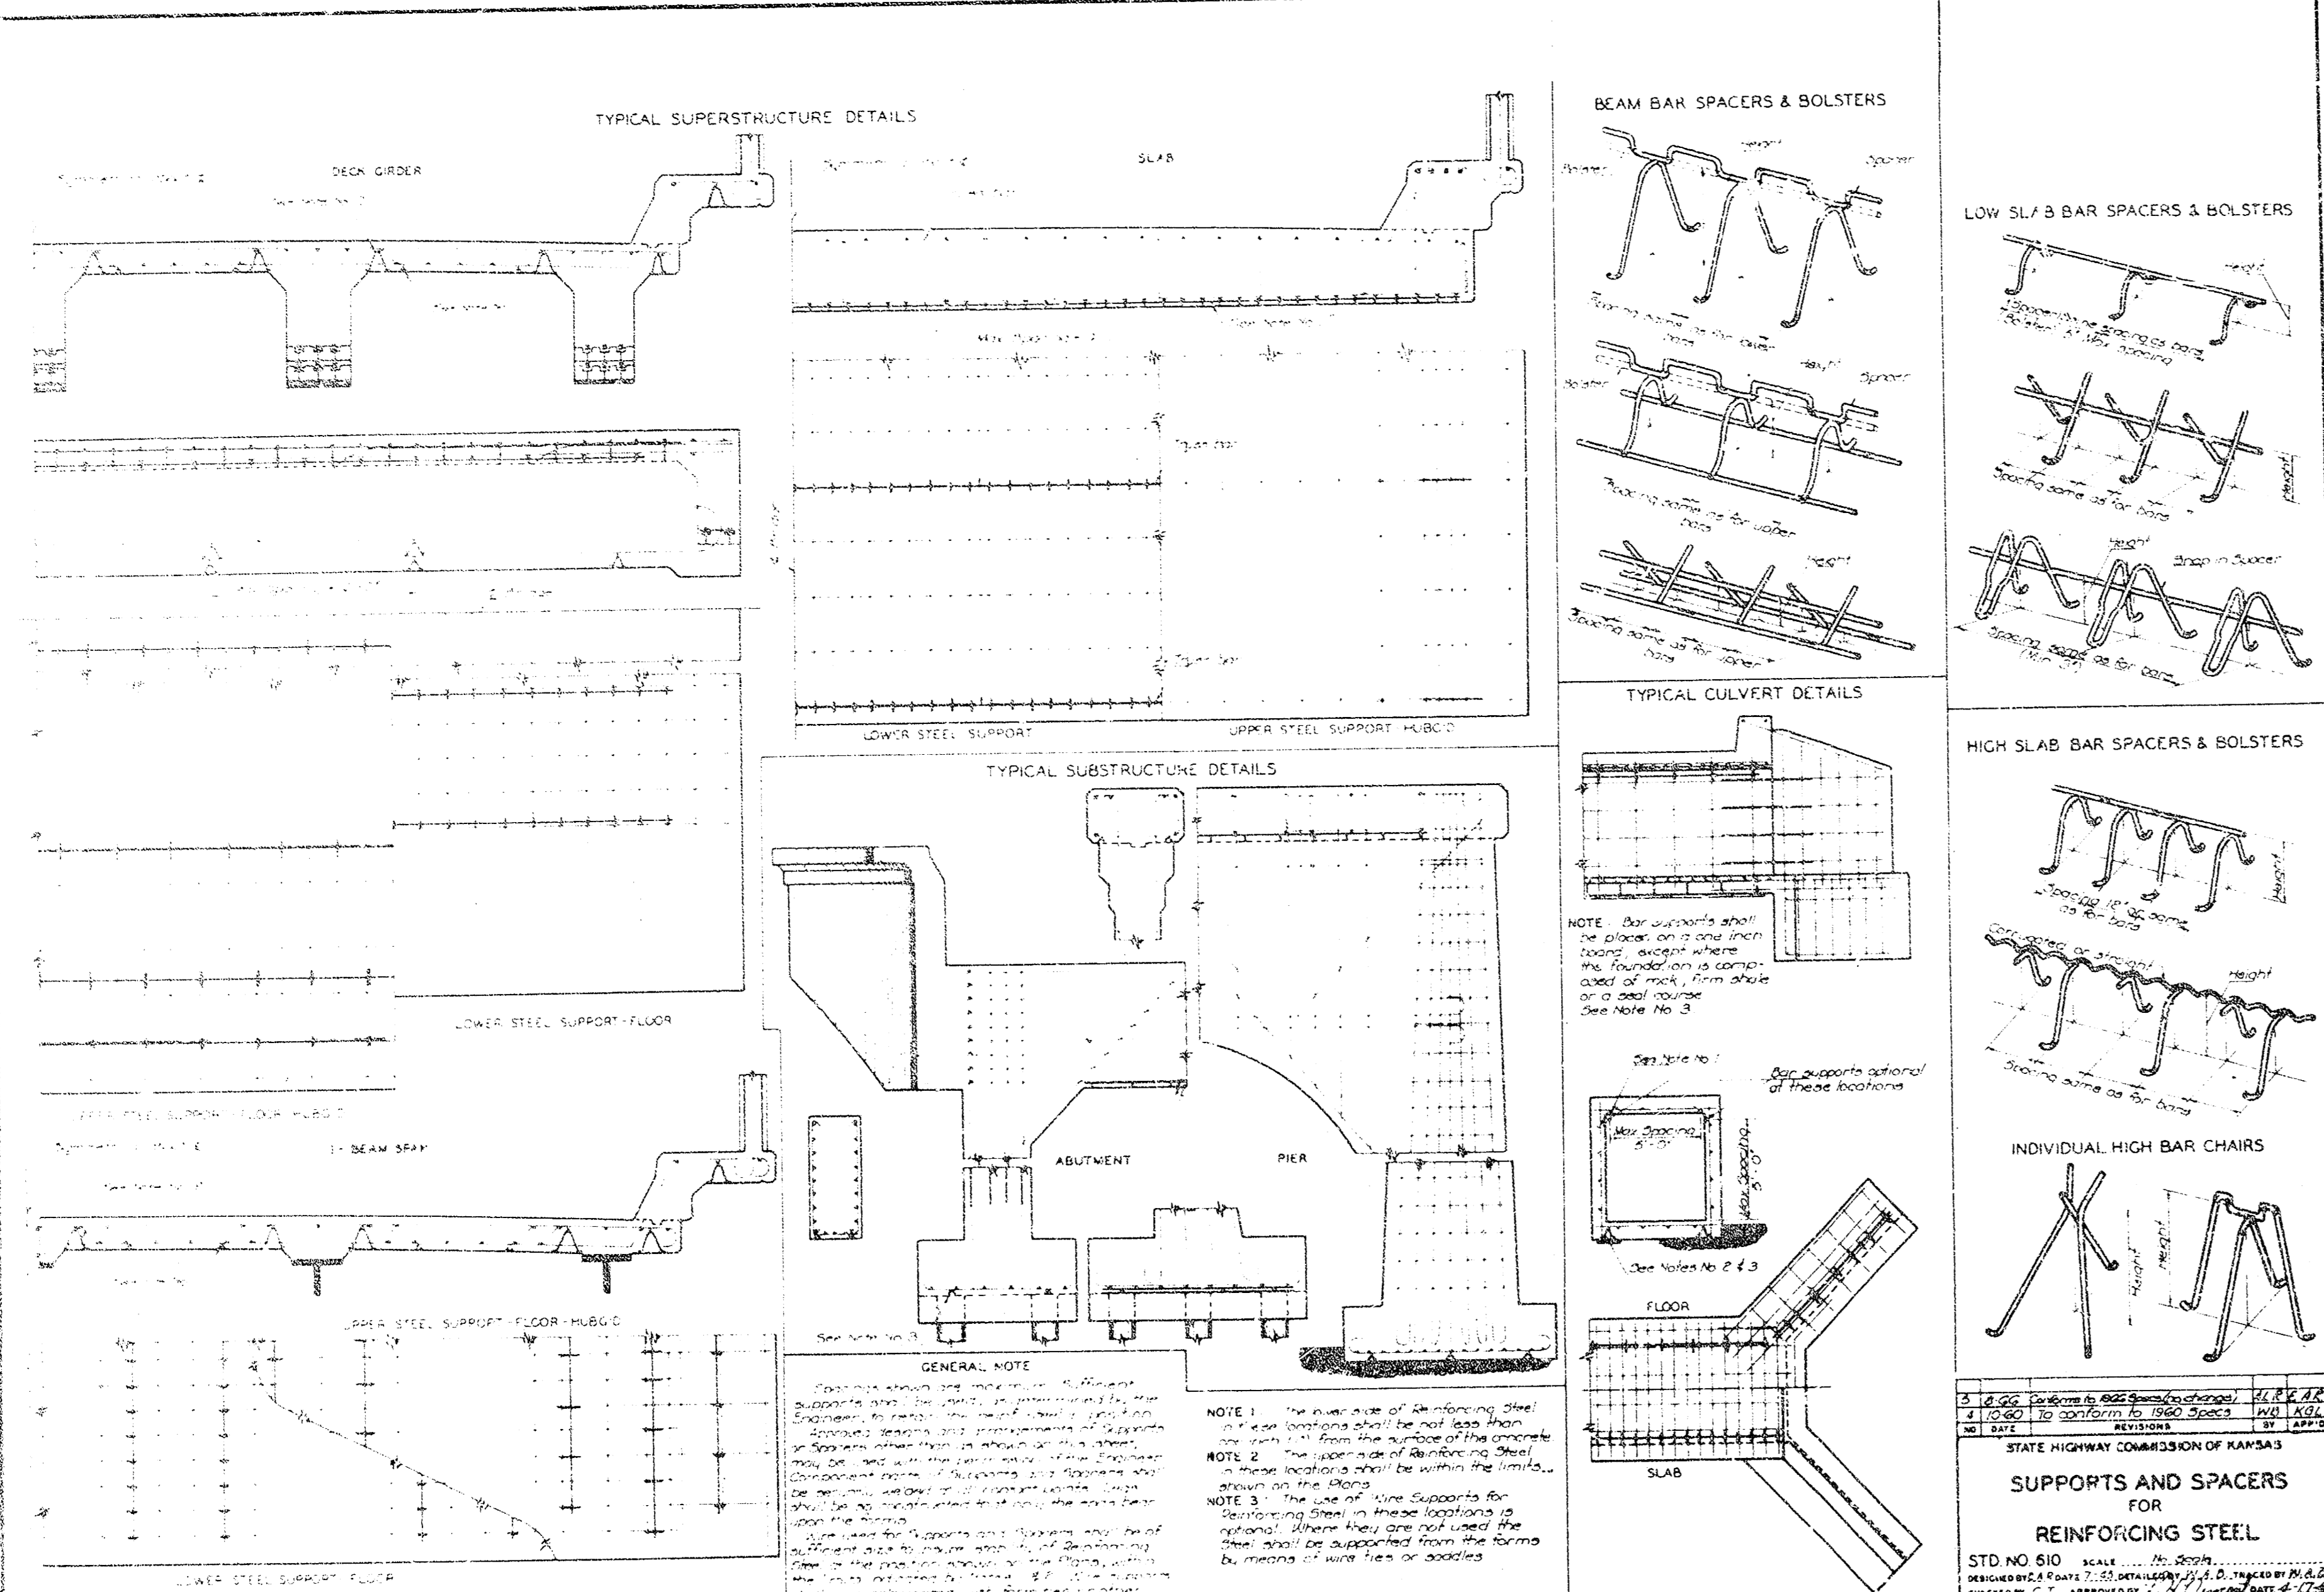

**BRIDGE EXCAVATION**

DELAMATER, FREUND & SCHERER, P.A.  
ENGINEERS & ARCHITECTS  
WICHITA, KANSAS

DATE: December, 1975  
DWG. NO. 79-R-9

C.S.	1-11-77	As Built	
REV.	BY	DATE	DESCRIPTION
			CITY OF WICHITA, KANSAS R.W. LINN, P.E., CITY ENGINEER
			VASSAR STREET BRIDGE OVER SLEEPY HOLLOW CREEK BAR SUPPORTS, BRIDGE EXCAVATION & ELECTRIC LIGHTING
			DELAMATER, FREUND & SCHERER, P.A. ENGINEERS & ARCHITECTS WICHITA, KANSAS
SCALE	DATE	DWG. NO.	NO.
	December, 1975	79-R-9	9