


PRIVATE STORM WATER SEWER SYSTEM NORTH INDUSTRIAL PARK 4TH ADDITION WICHITA, SEDGWICK COUNTY, KANSAS

1991

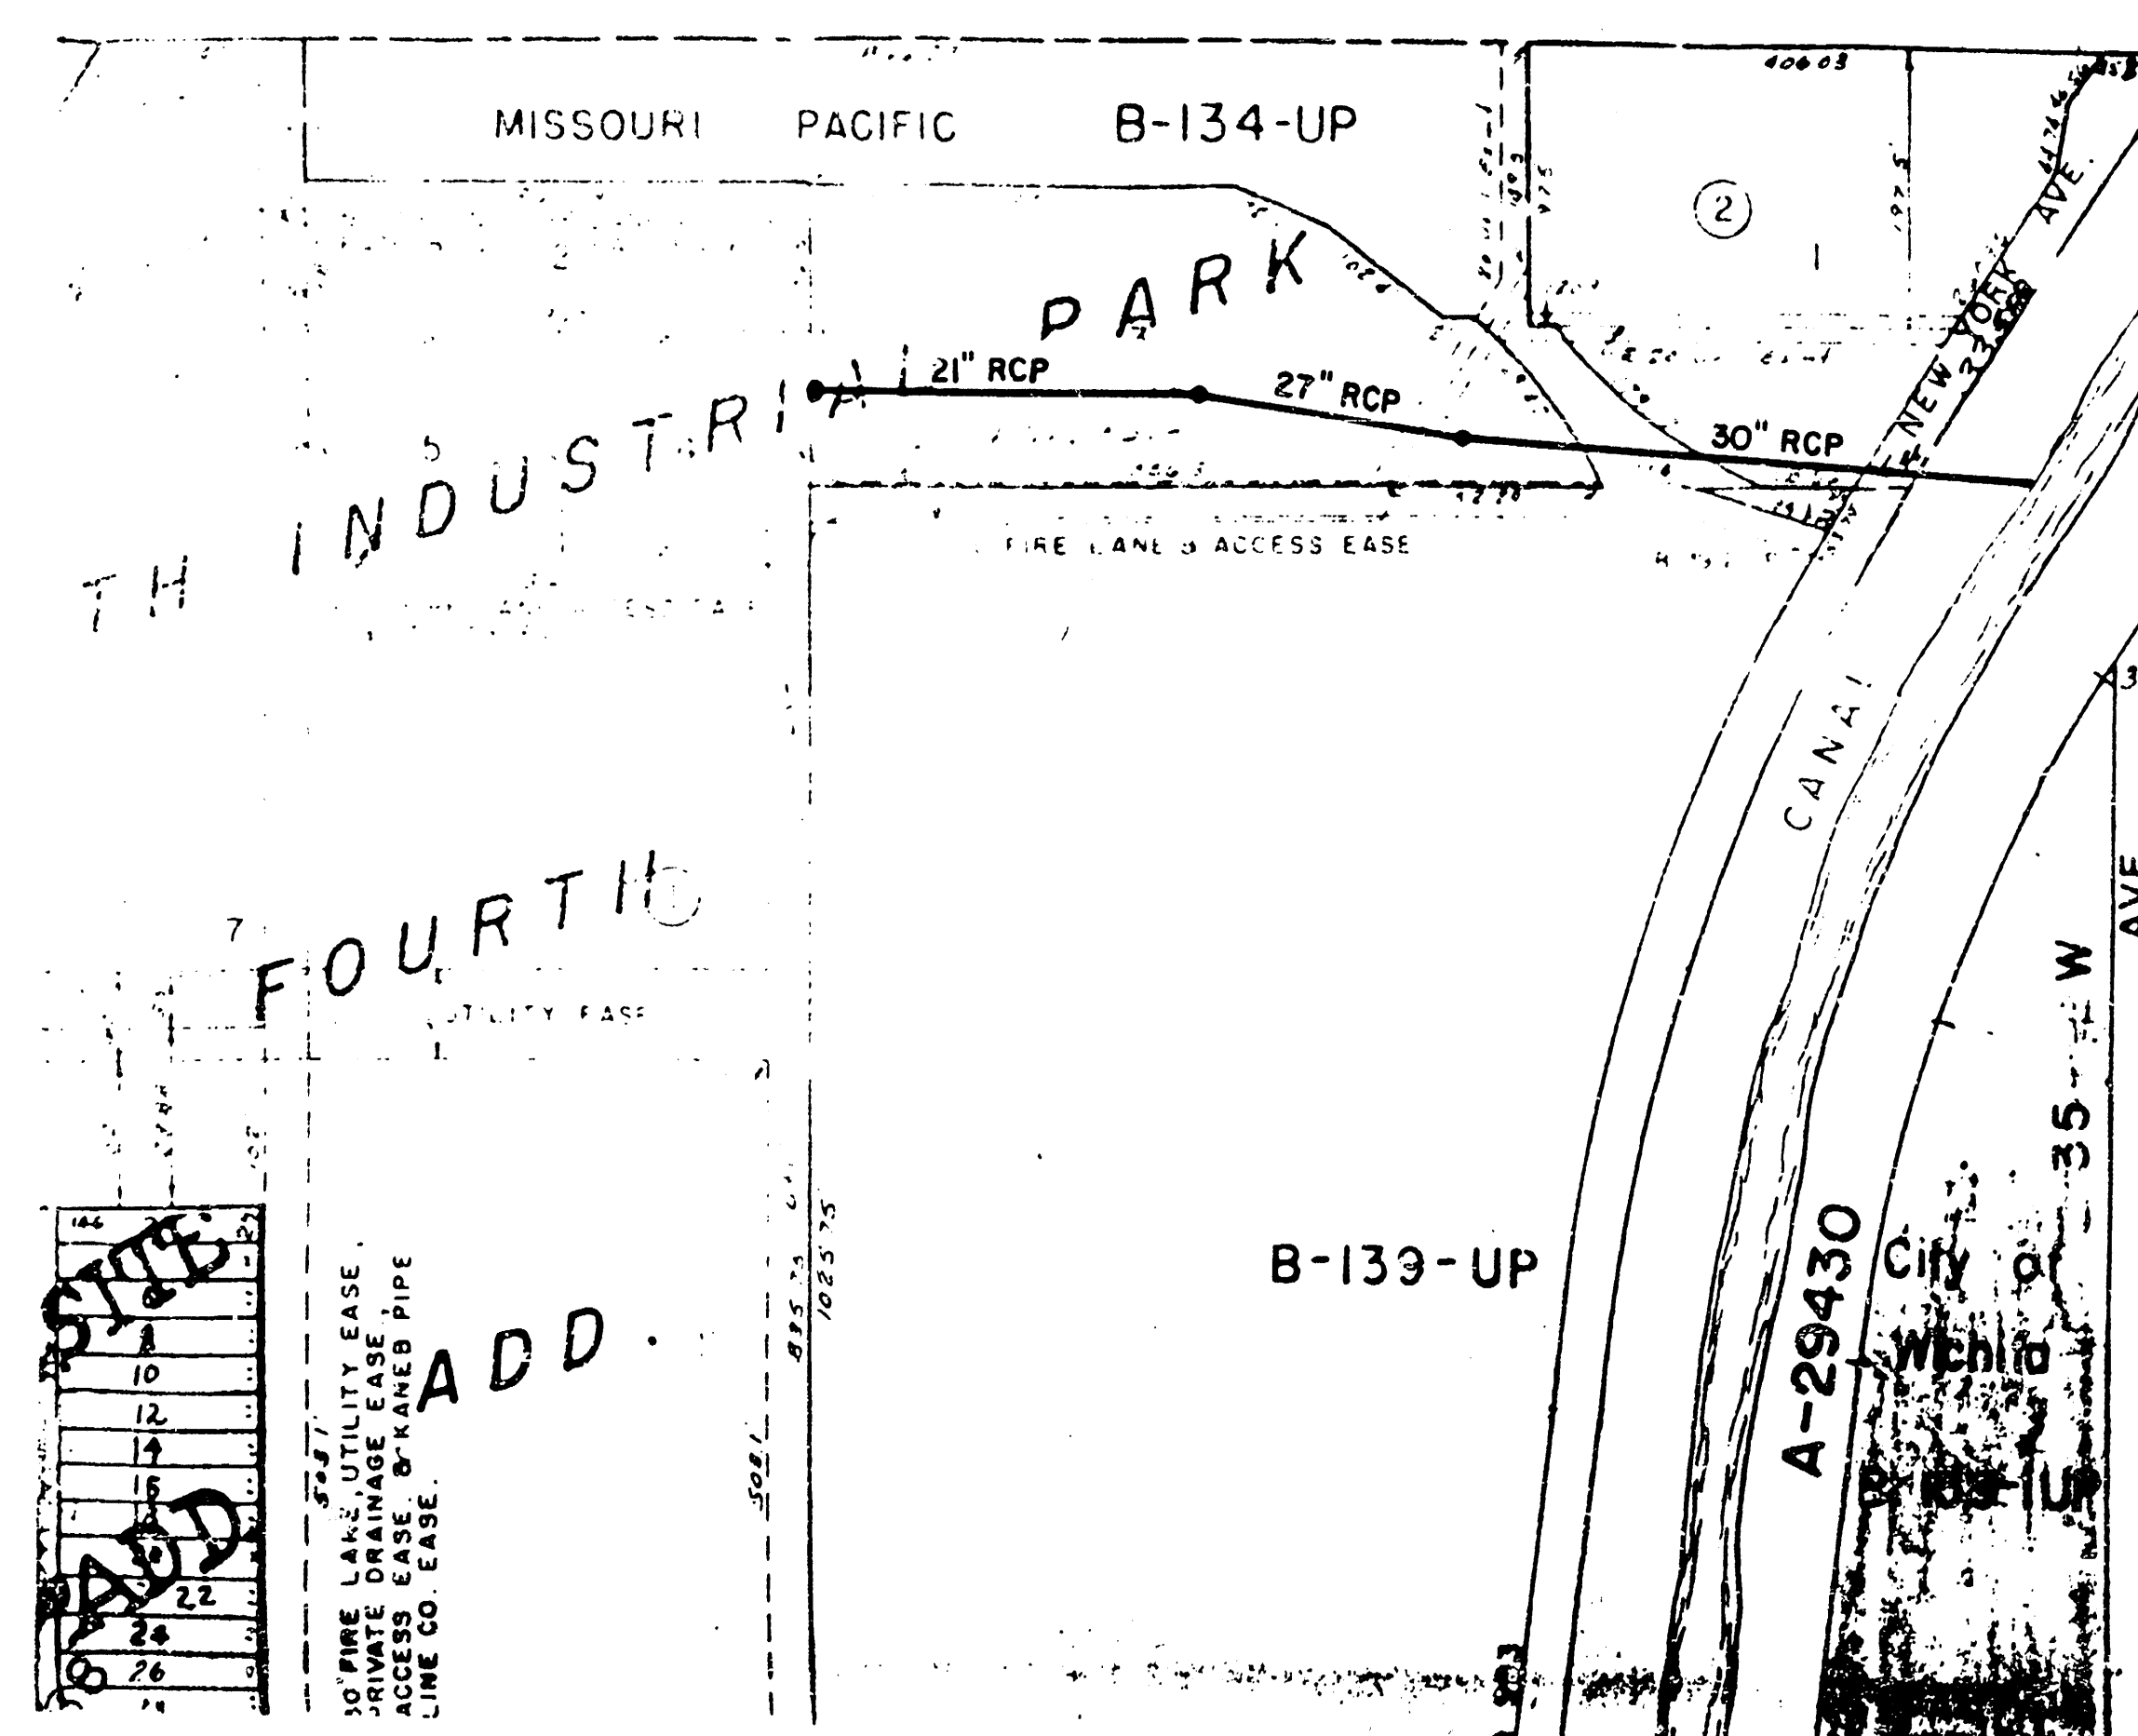

VICINITY MAP
1" = 150'

As Constructed
Sept. 1991

BENCH MARK: RAILROAD SPIKE IN LIGHT POLE
BY ADMINISTRATIVE BUILDING.
ELEVATION 128.30
CITY OF WICHITA DATUM

GENERAL NOTES

1. Contractors will be required to provide a minimum advance notice of twenty-four (24) hours to utility companies prior to starting any excavation as follows:

Kansas One-Call 687-2470

The Contractor must notify the following in case of an emergency:

Cablevision	262-4270 or 263-2061
K. P. & L. Gas Service Company	263-7511
Kansas Gas & Electric	264-1141
Kaneb Pipeline Company	262-1408
Southwestern Bell Telephone Company	1-571-2611
City of Wichita Water Department	268-4908
City of Wichita Sewer Maintenance	268-4071

2. Underground utility service lines and overhead utility pole lines are to be adjusted as necessary by others prior to construction unless the plans specifically call for their adjustment by the Contractor or unless the plans specifically identify a utility to be adjusted by its Owner during construction. Existing utilities and their location, as shown on the plans, represent the best information obtainable for design. Location information has been obtained from various utility companies and is either from company record drawings or company provided field locations. The Contractor will be required to work around existing utilities within the right-of-way which do not conflict with proposed construction.

3. Rubble from the removal of miscellaneous structures and excess excavation which is to be wasted shall be disposed of on sites to be provided by the Contractor. These sites shall be approved by the Engineer as to suitability, appearance and site location. Location that, in the opinion of the Engineer, will leave an unsightly appearance will not be approved.

All disposal sites must be approved by the Kansas Department of Health and Environment. Materials either stockpiled or disposed of in a flood plain would require a Kansas State Board of Agriculture permit. Any material dumped in waters of the United States or wetlands is subject to U.S. Corps of Engineers permit regulations. Any materials buried or stockpiled beyond approved construction limits would require additional archaeological investigations unless buried in a previously approved borrow location.

4. The Engineer shall take field ties to all quarter section corners. The Contractor shall set a City survey monument in the required location where such quarter section corners fall within the limits of pavement construction. Survey monuments will be furnished by the City. The Engineer will accurately locate and install the iron at the quarter section corner. This work will not be paid for directly, but shall be considered subsidiary to the other pay items of work in the contract.

5. The Contractor shall notify pipeline companies at least twenty-four (24) hours in advance of any work being performed across and/or adjacent to pipelines.

6. The Contractor shall give all property owners and/or tenants of developed property directly abutting the construction of this project a minimum of ten (10) days advance notice prior to the start of construction.

7. This is a private storm water sewer project. Since it outlets into the Wichita Drainage Canal, it will be constructed according to City of Wichita Storm Sewer and Drainage Specifications.

8. Construction staking and on-site inspection shall be provided by Reiss & Goodness Engineers at the expense of the Owner.

9. The Contractor shall be required to obtain a Right-of-Way Permit from the City of Wichita for the crossing of New York Avenue.

10. The Contractor shall execute a "Contractor's Right-of-Entry Agreement" with the Union Pacific Railroad during the construction phase of this project.

INDEX OF DRAWINGS

SHEET 2-3	PLAN/PROFILE
SHEET 3	DETAILS
SHEET 4	DROP INLET DETAIL

APPROVED AS NOTED
BY CITY ENGINEER OF WICHITA

Sanitary Sewers

Storm Sewers: *VRH 3/11/91 for permit cross New York to Canal*

Driveway Approaches


Water Mains

Paving



BOOKED
D-290
MG

REISS & GOODNESS ENGINEERS
4150 WEST 21ST STREET
WICHITA, KANSAS 67203
(316) 832-0213


REVISION	DRAWN BY	CHECKED BY	DESIGNED BY	PROJECT NO.	DATE	SHEET	OF
	DEJ		RP	12-3-90	4-1-91	1	4

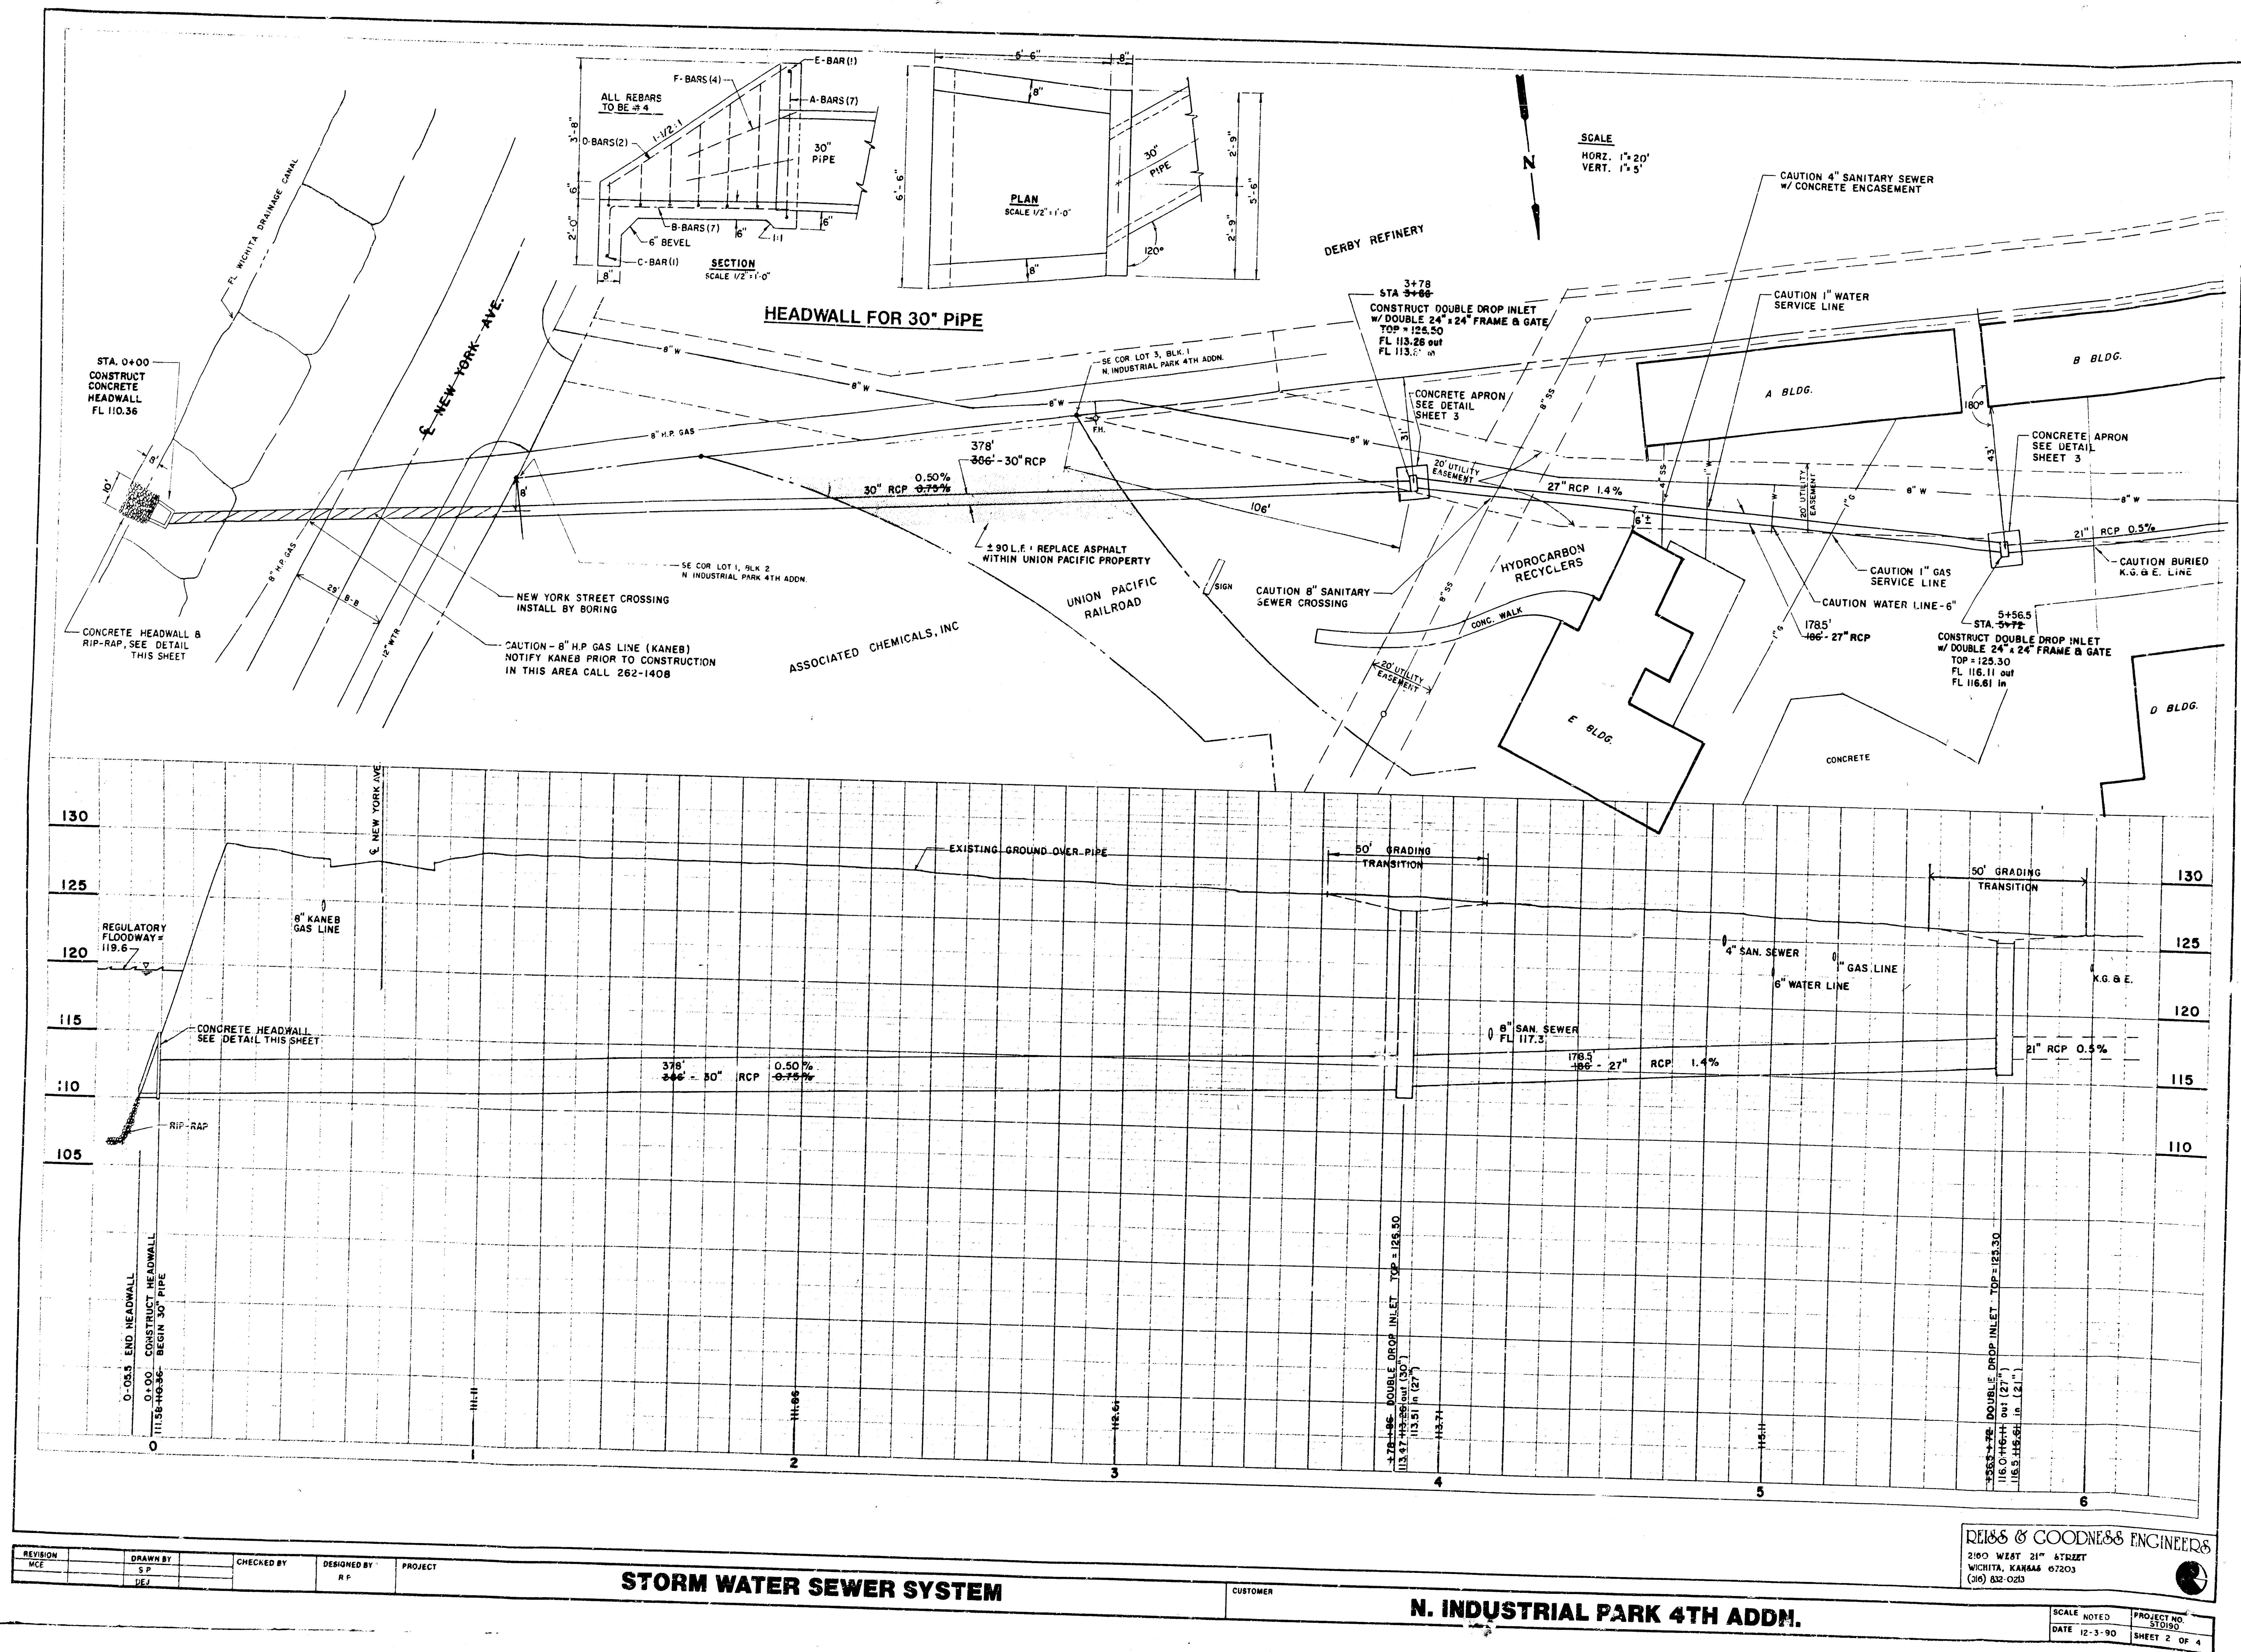




NOTE: Grates shall be imprinted on the top surface with "CITY OF WICHITA" using letters at least 1" in height. Other marking methods may be used only if approved by the engineer.

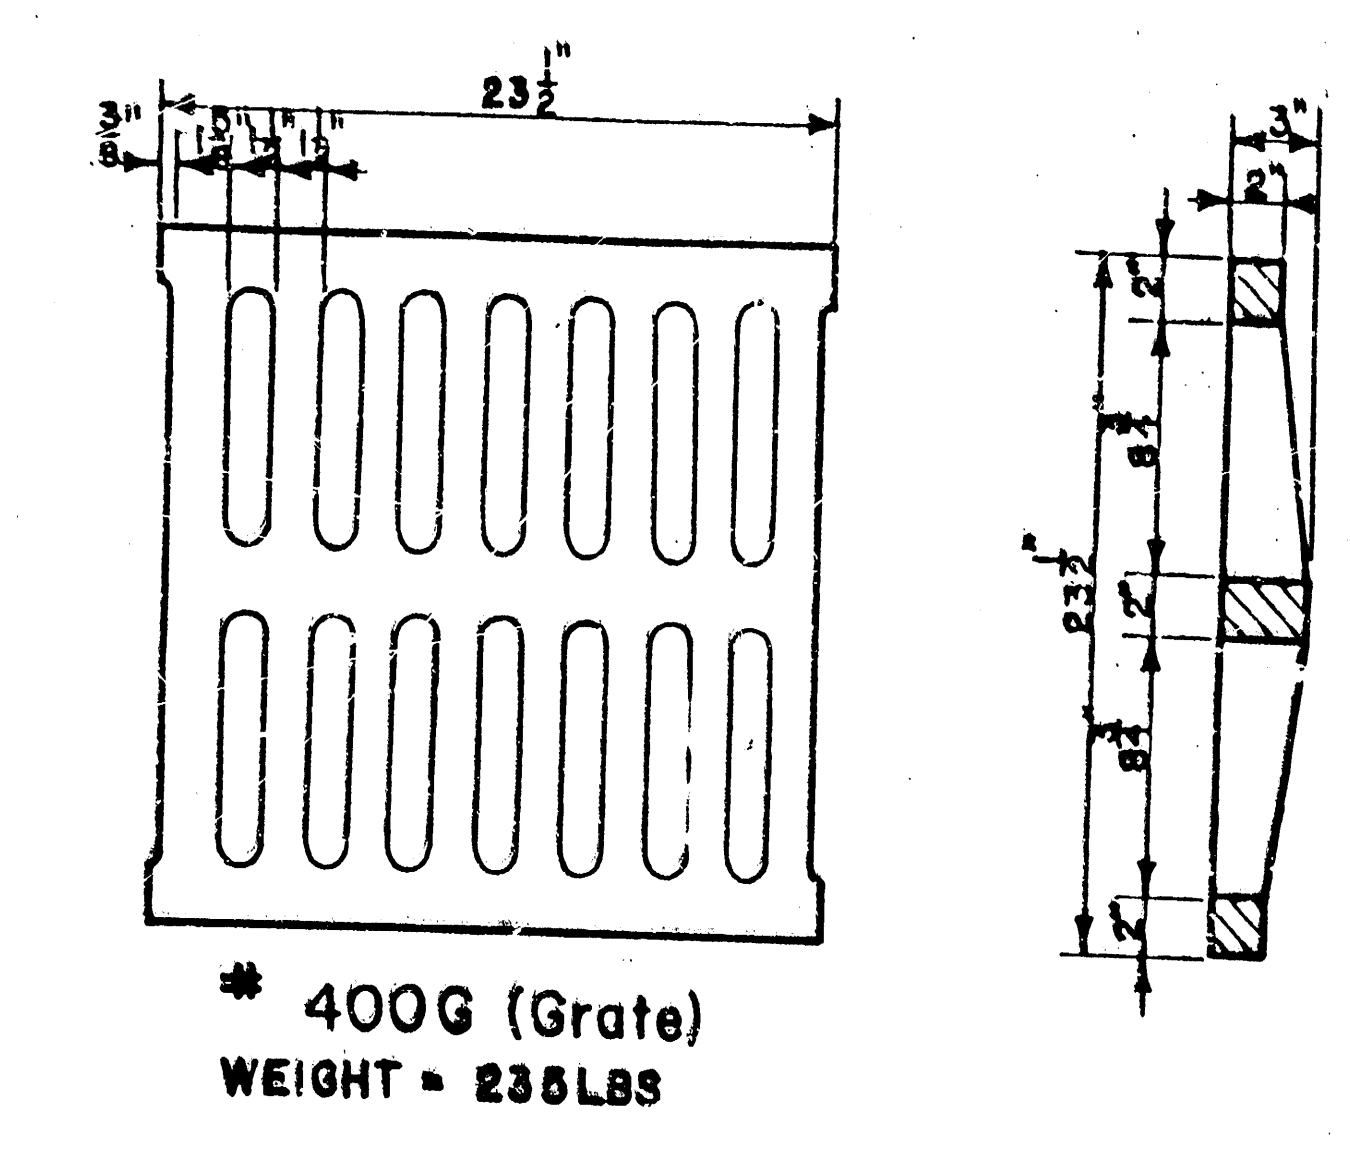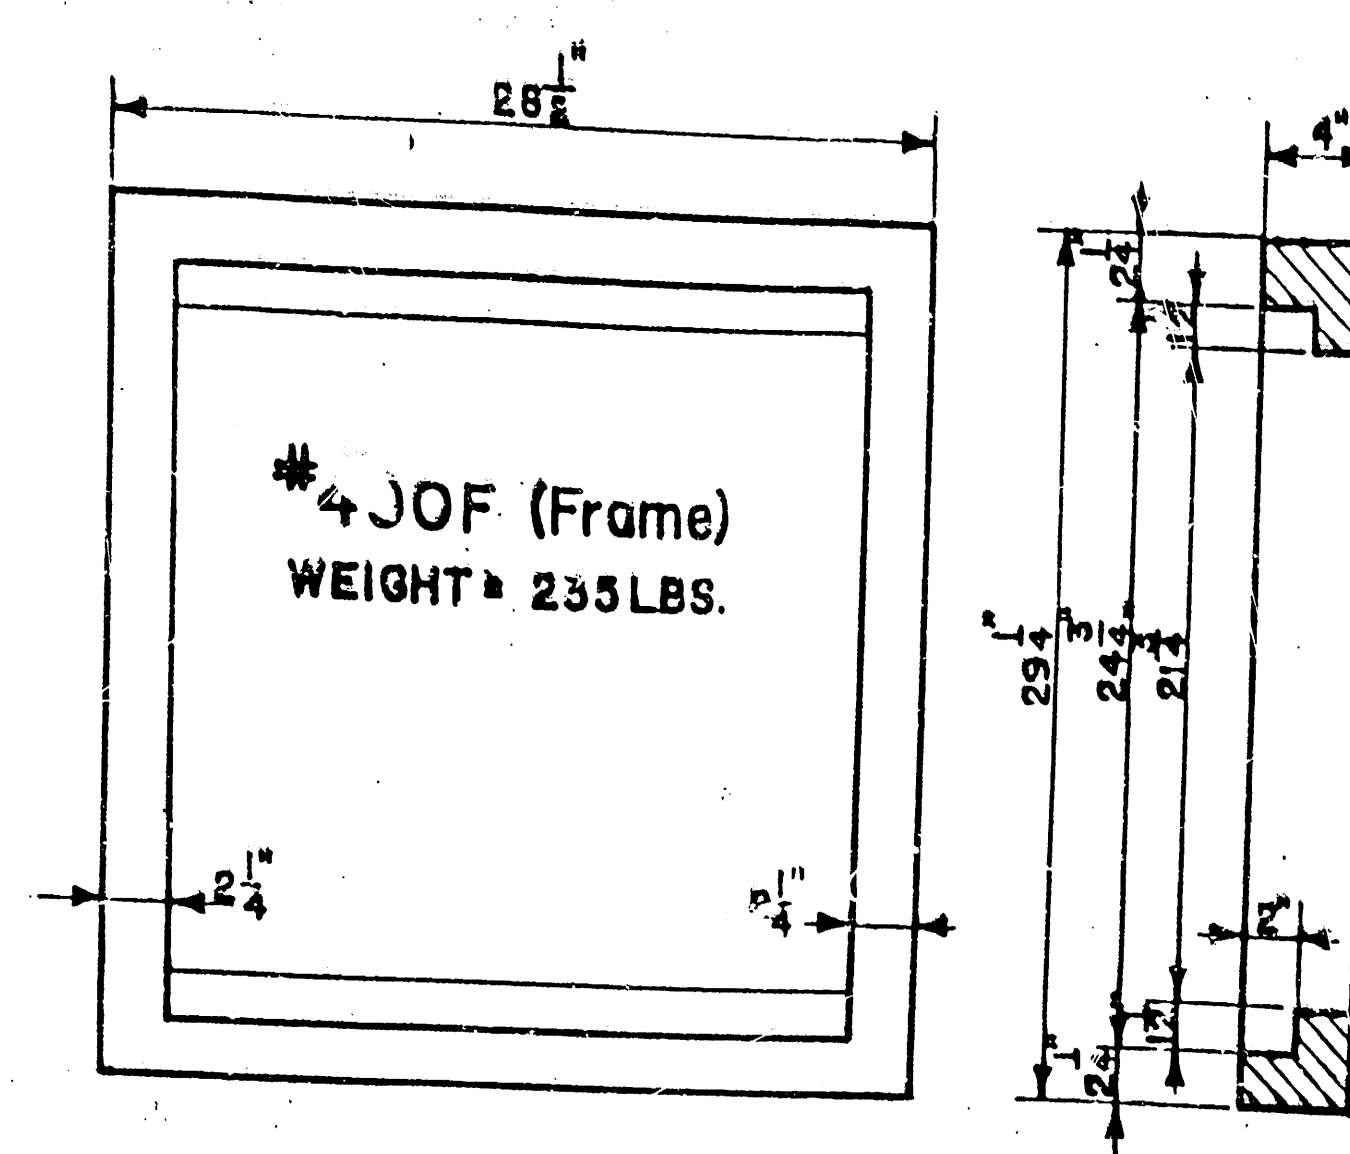

24"x24" Frame & Grate Detail

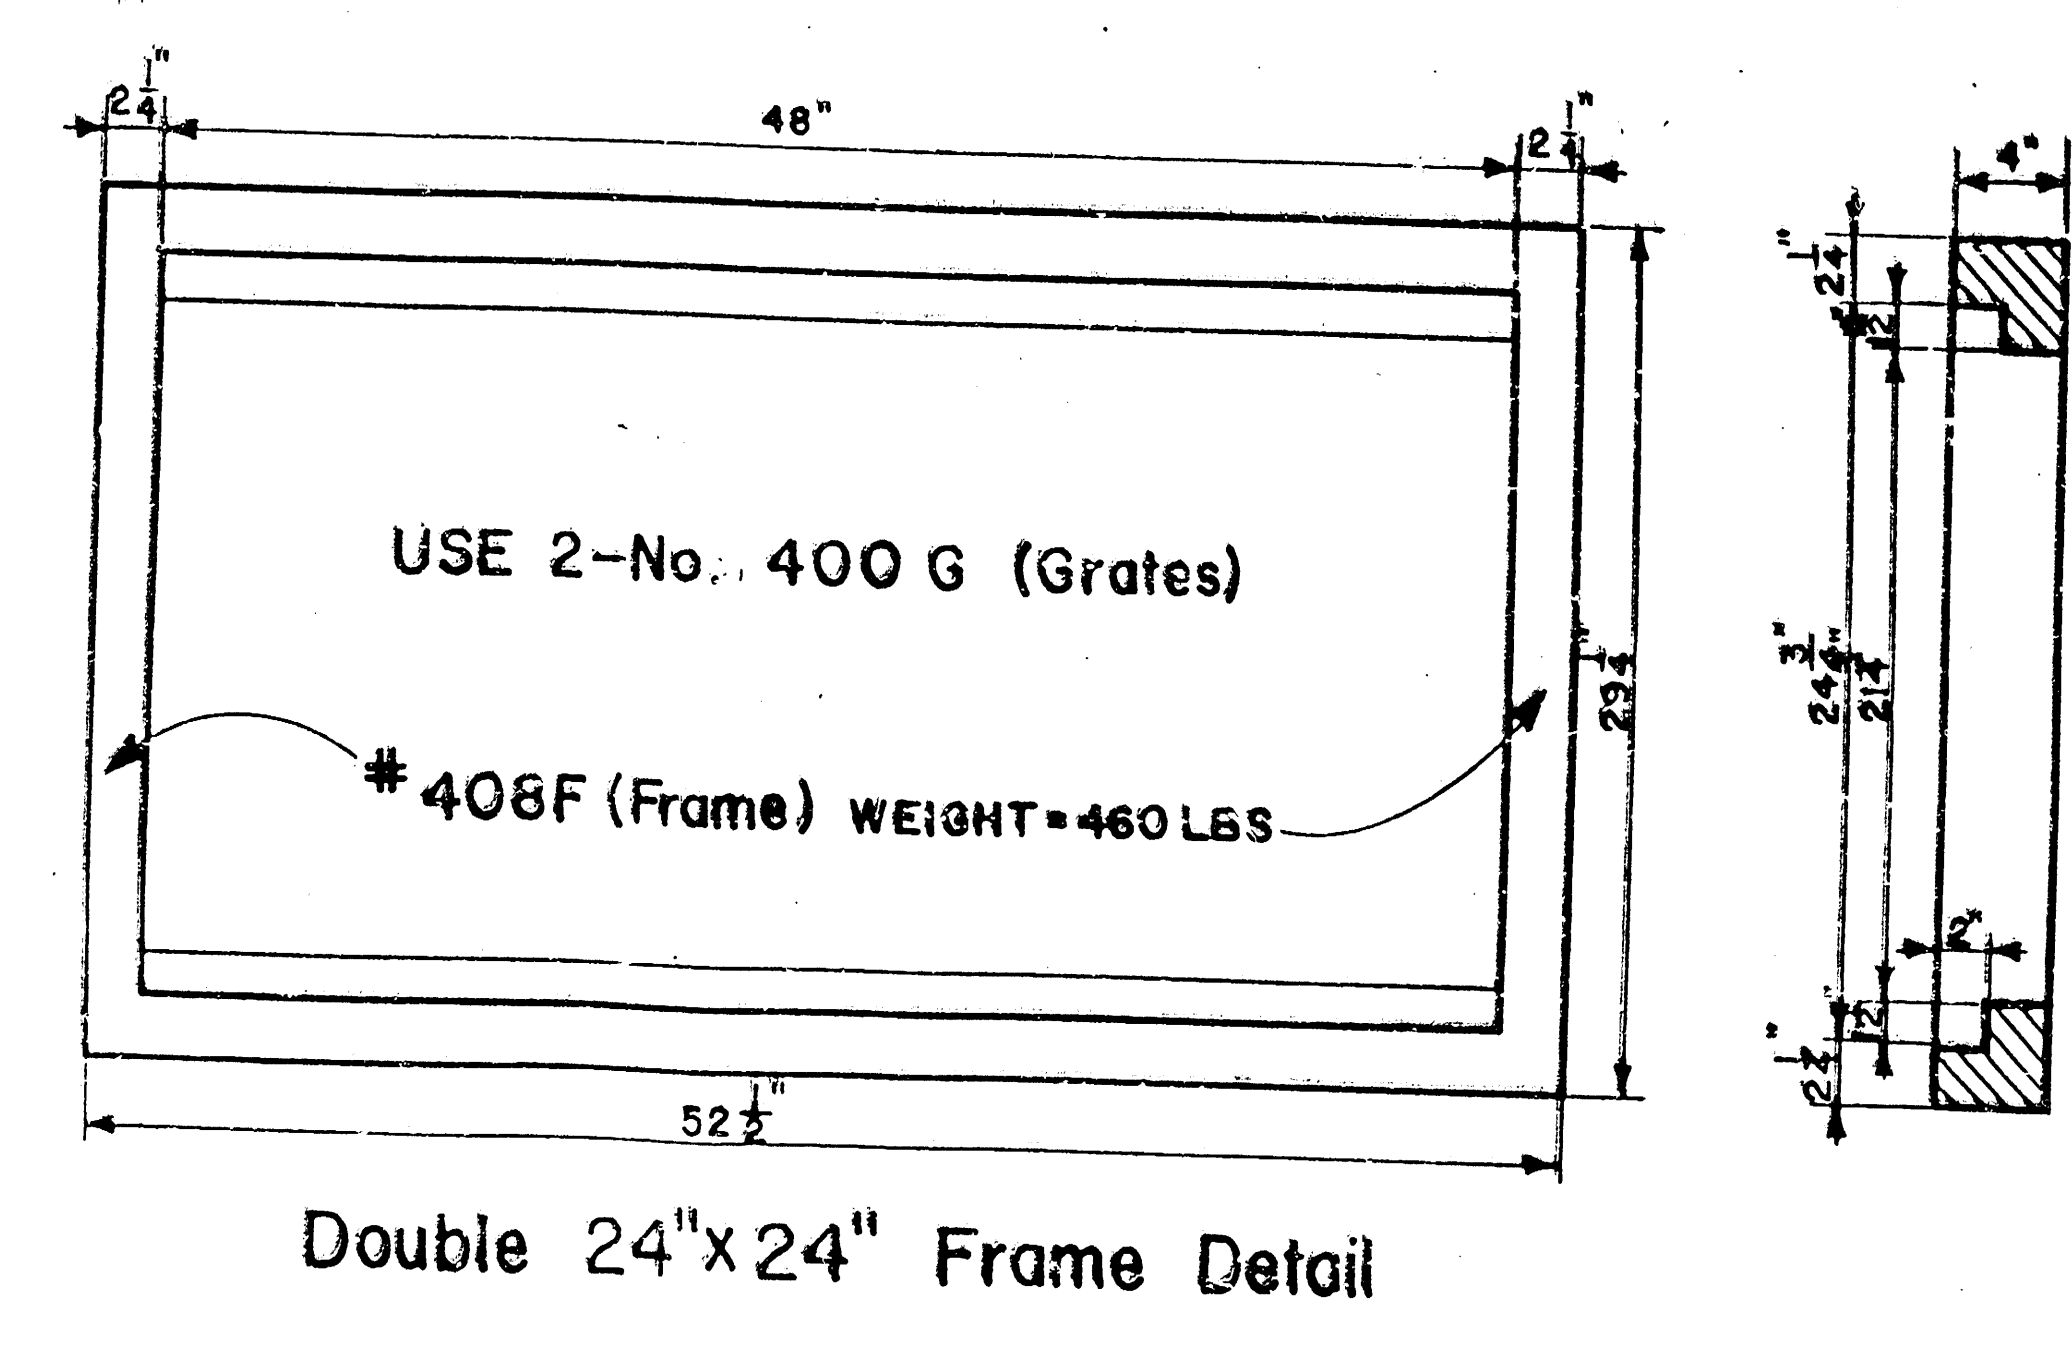

Double 24"x24" Frame Detail

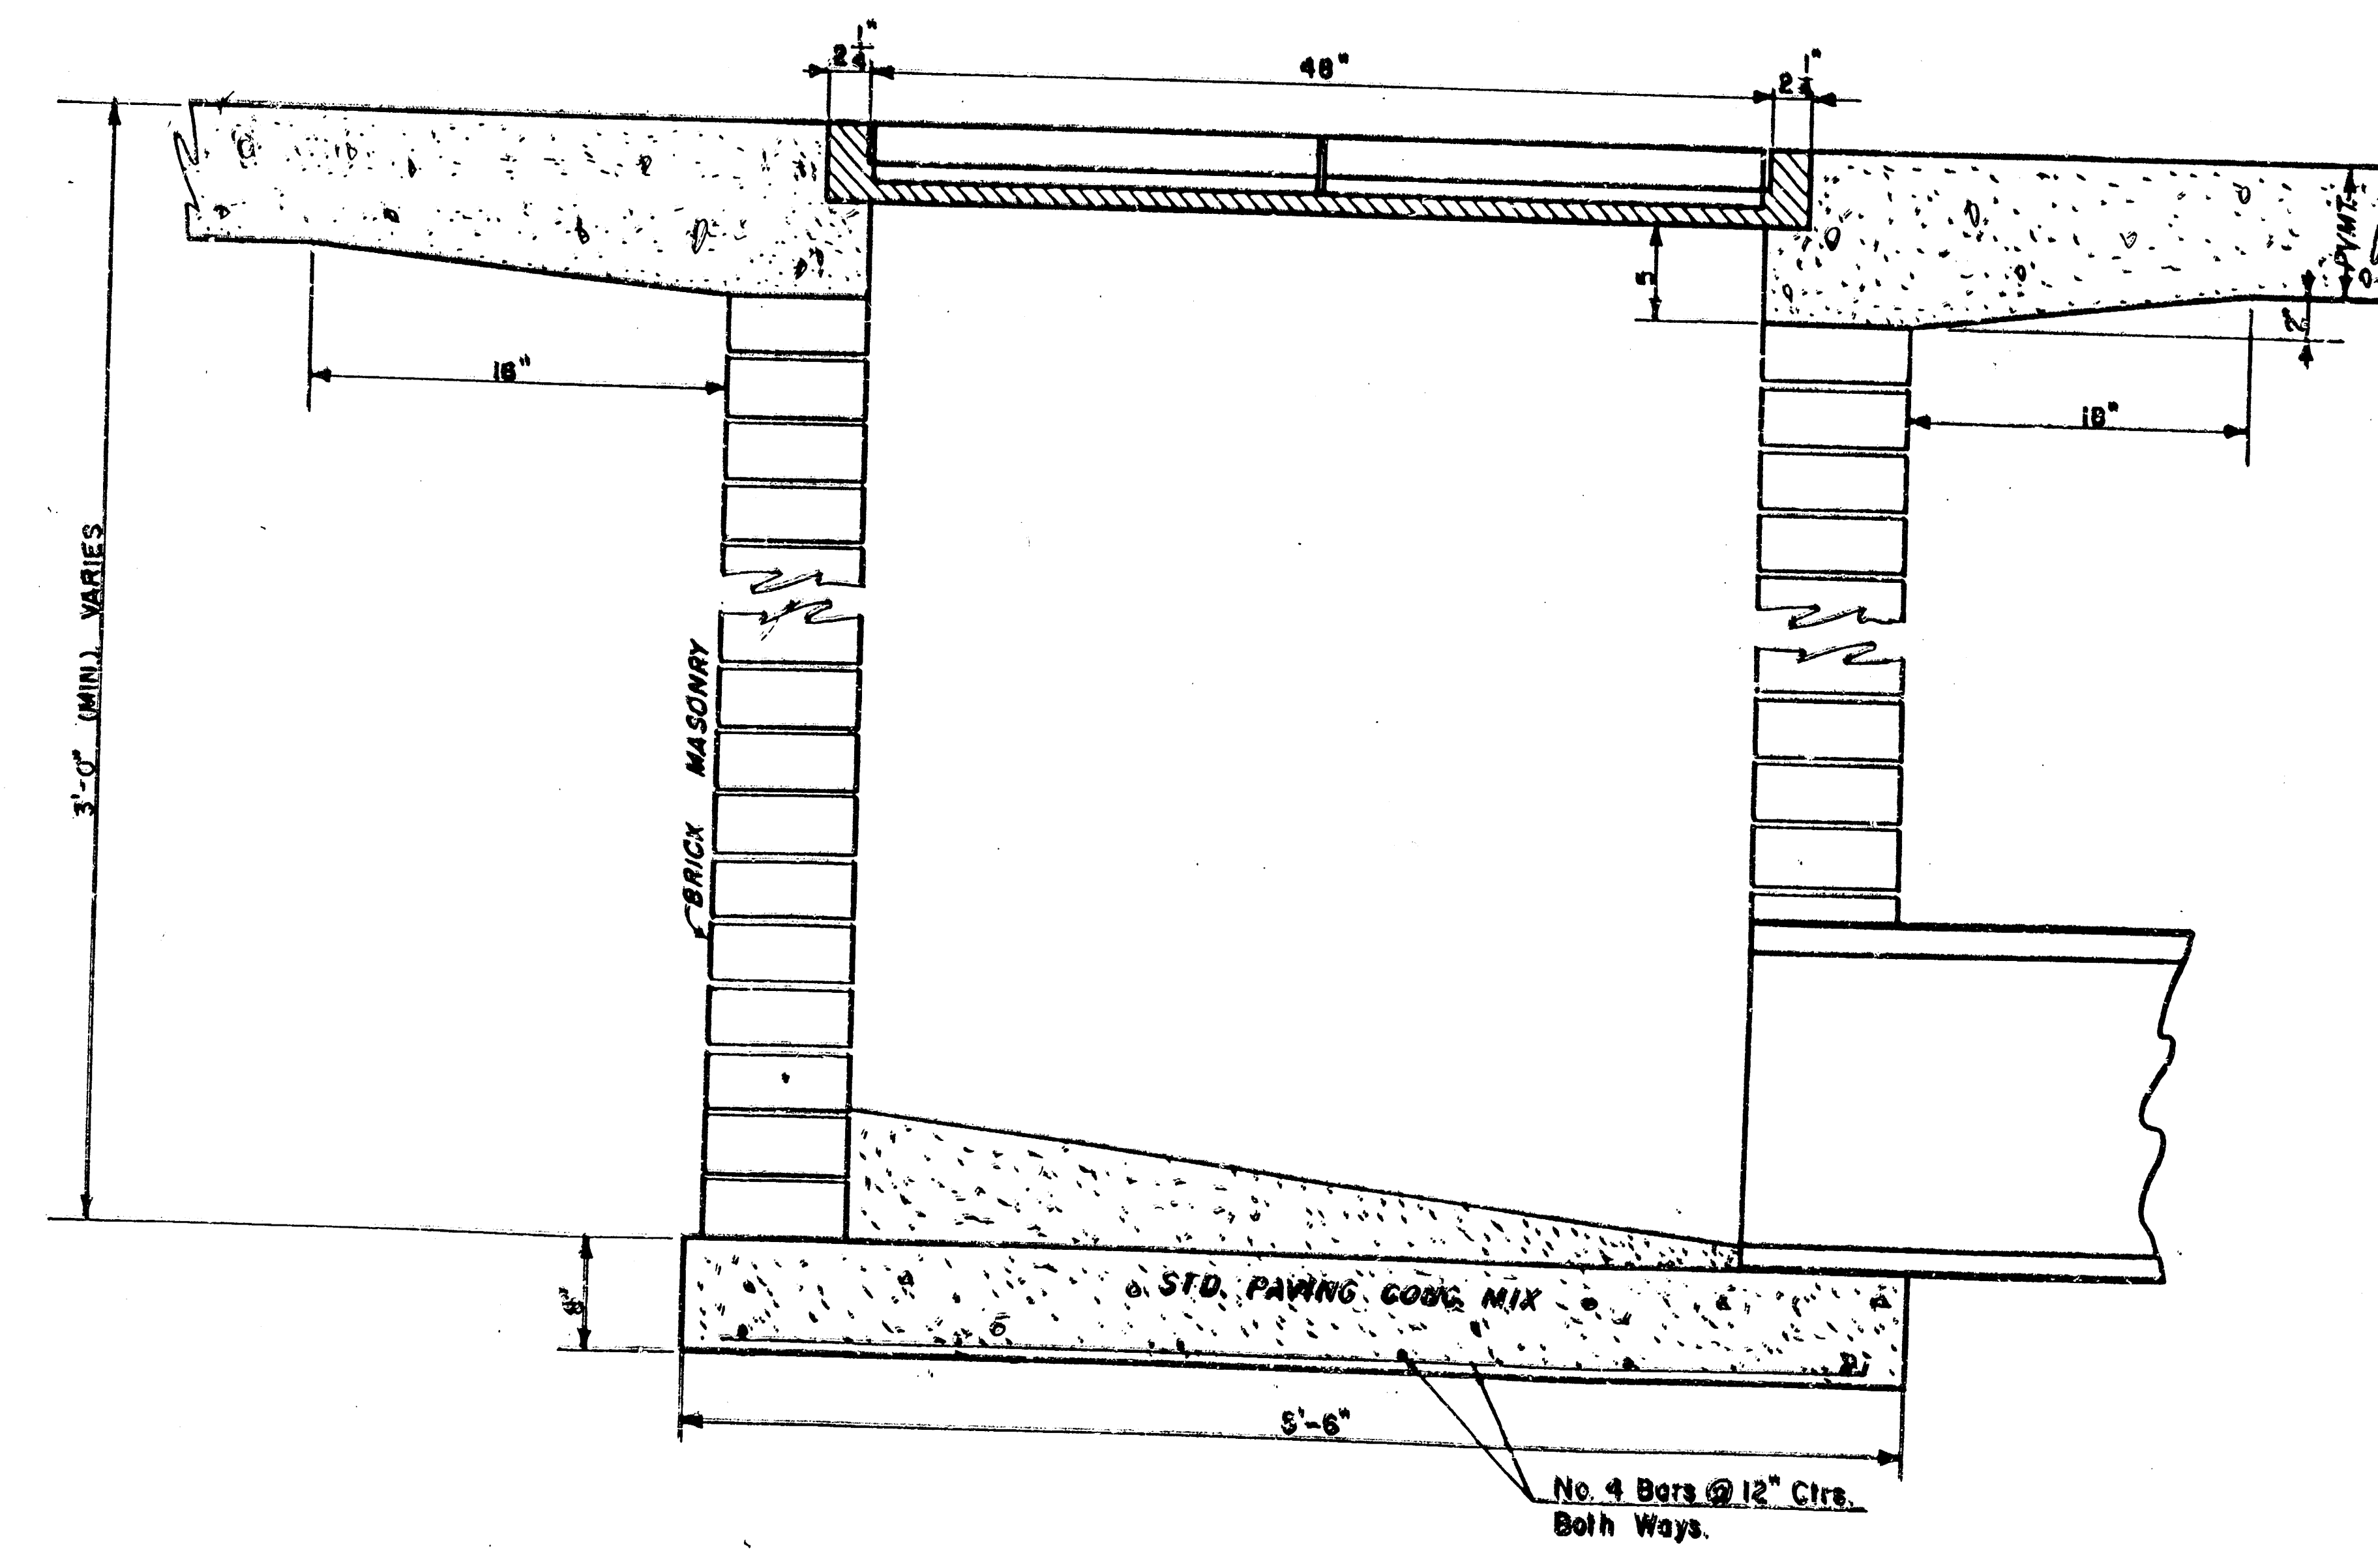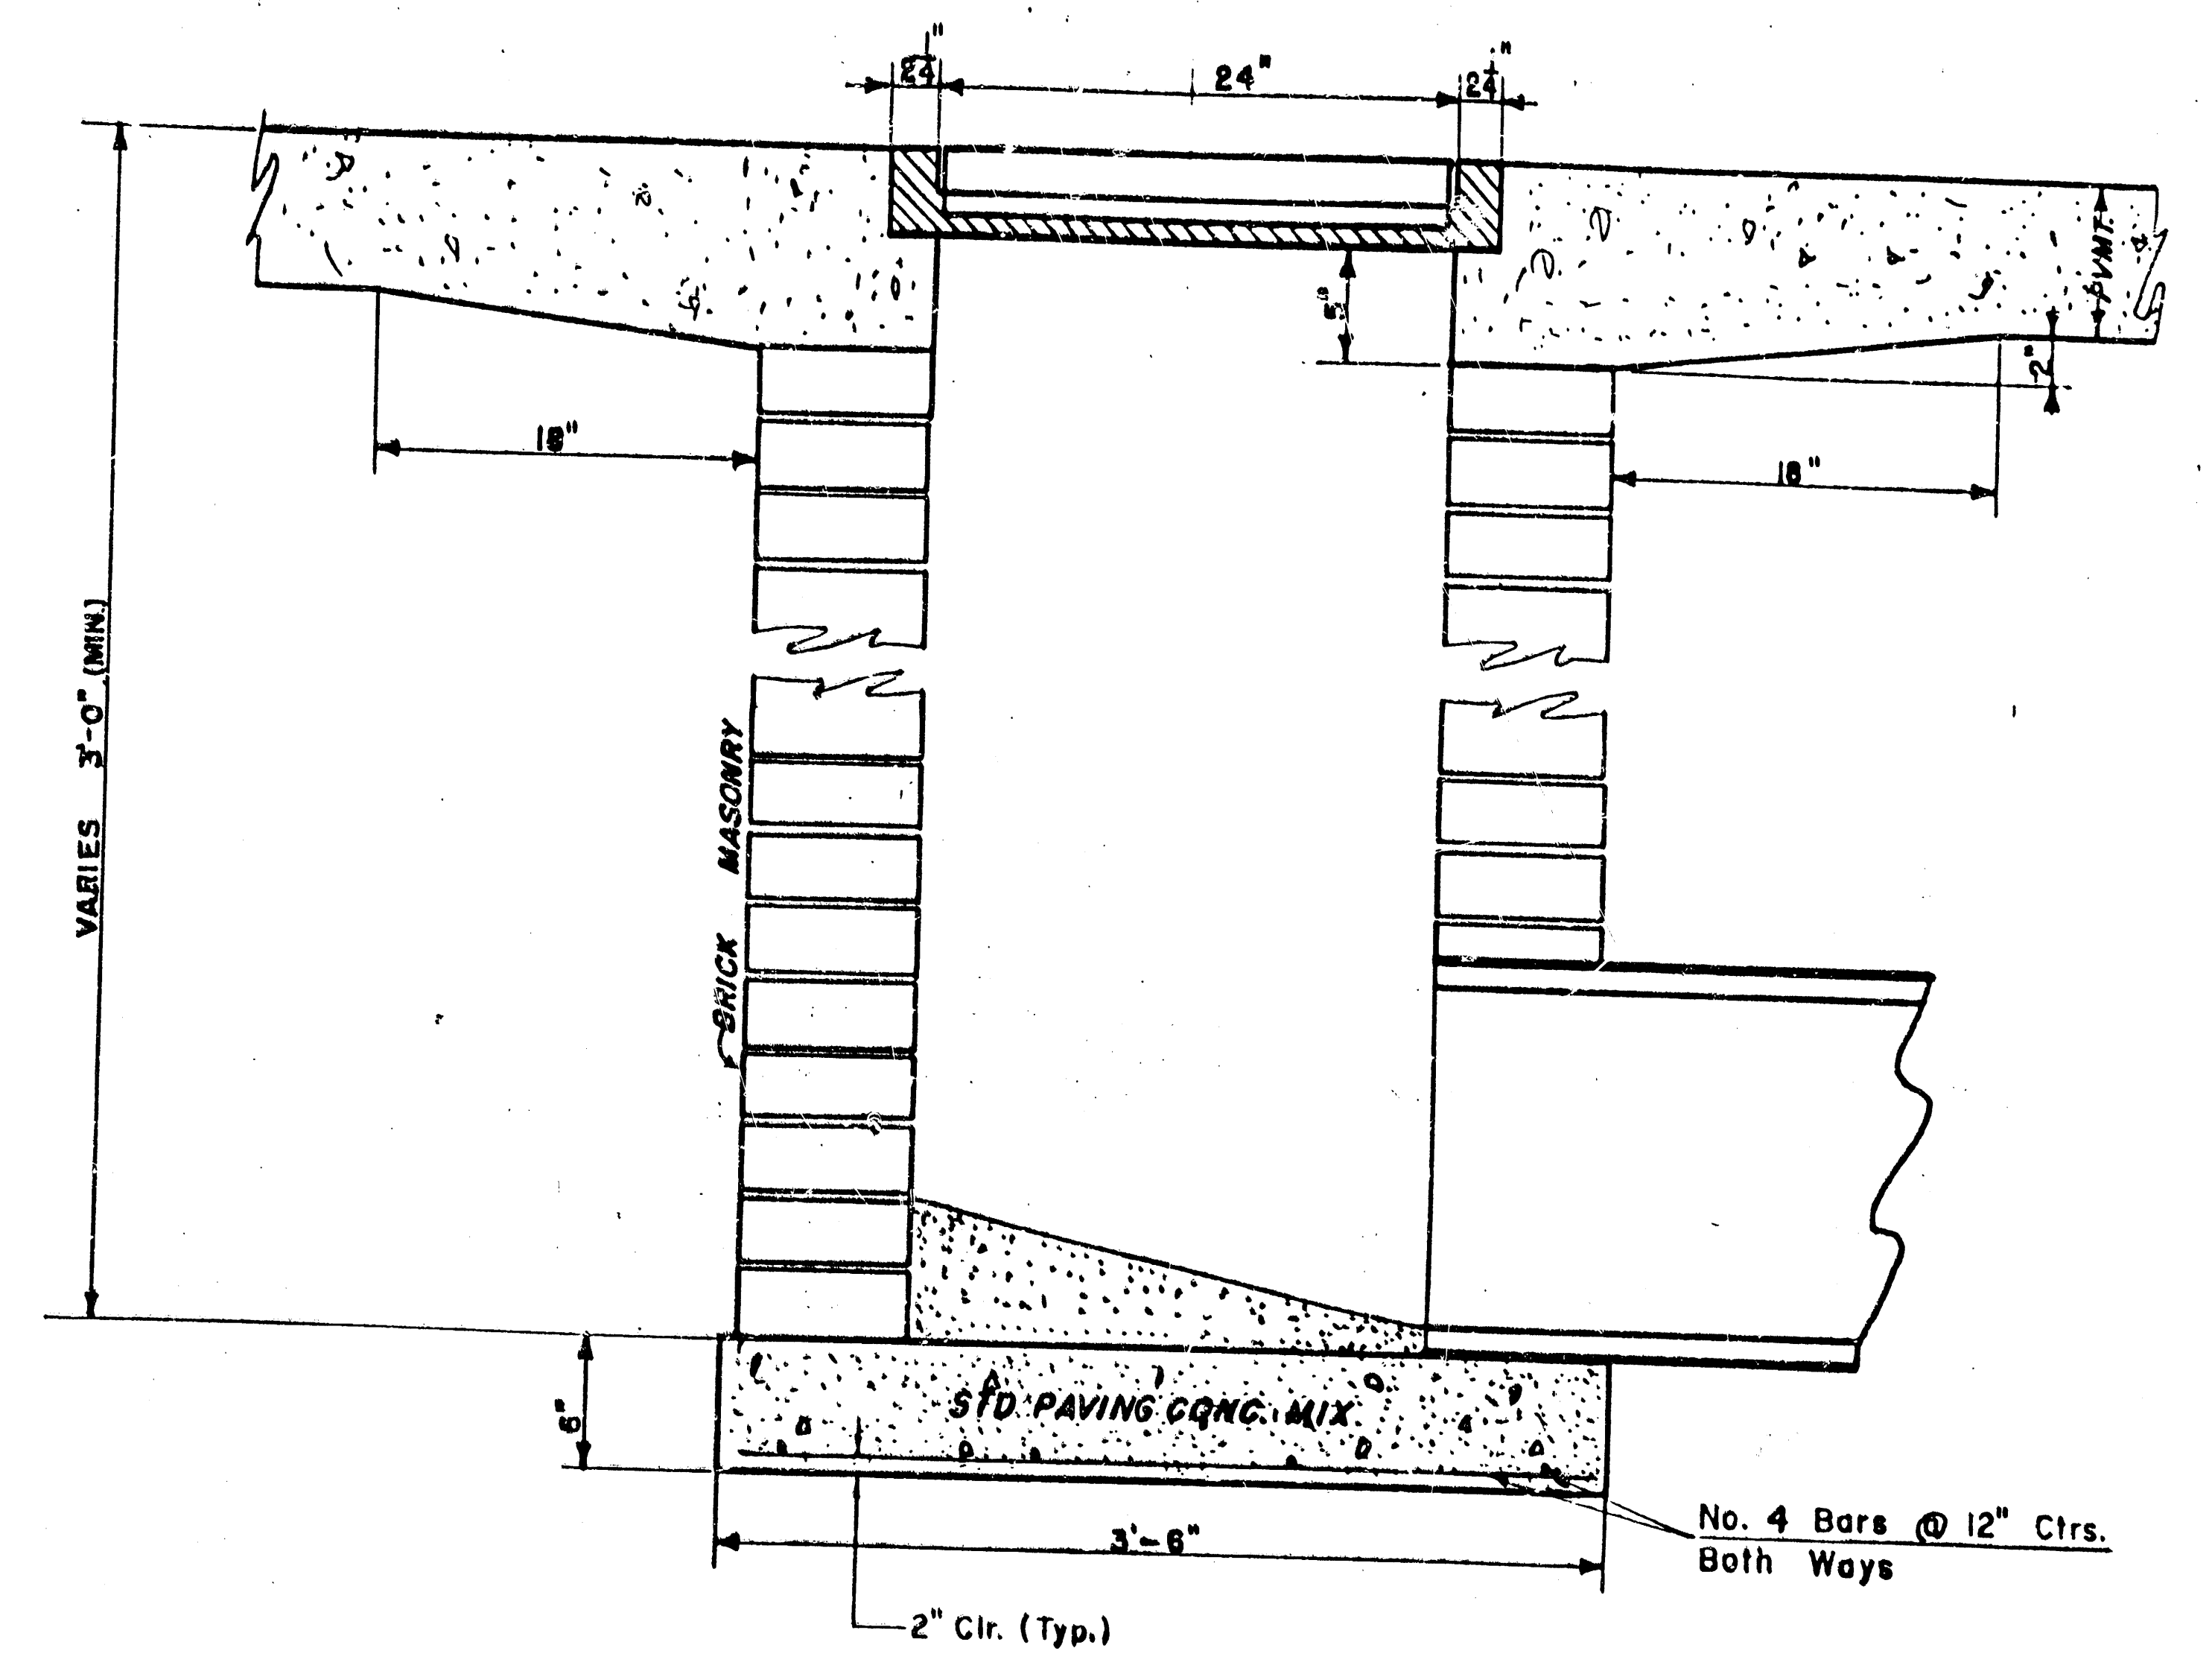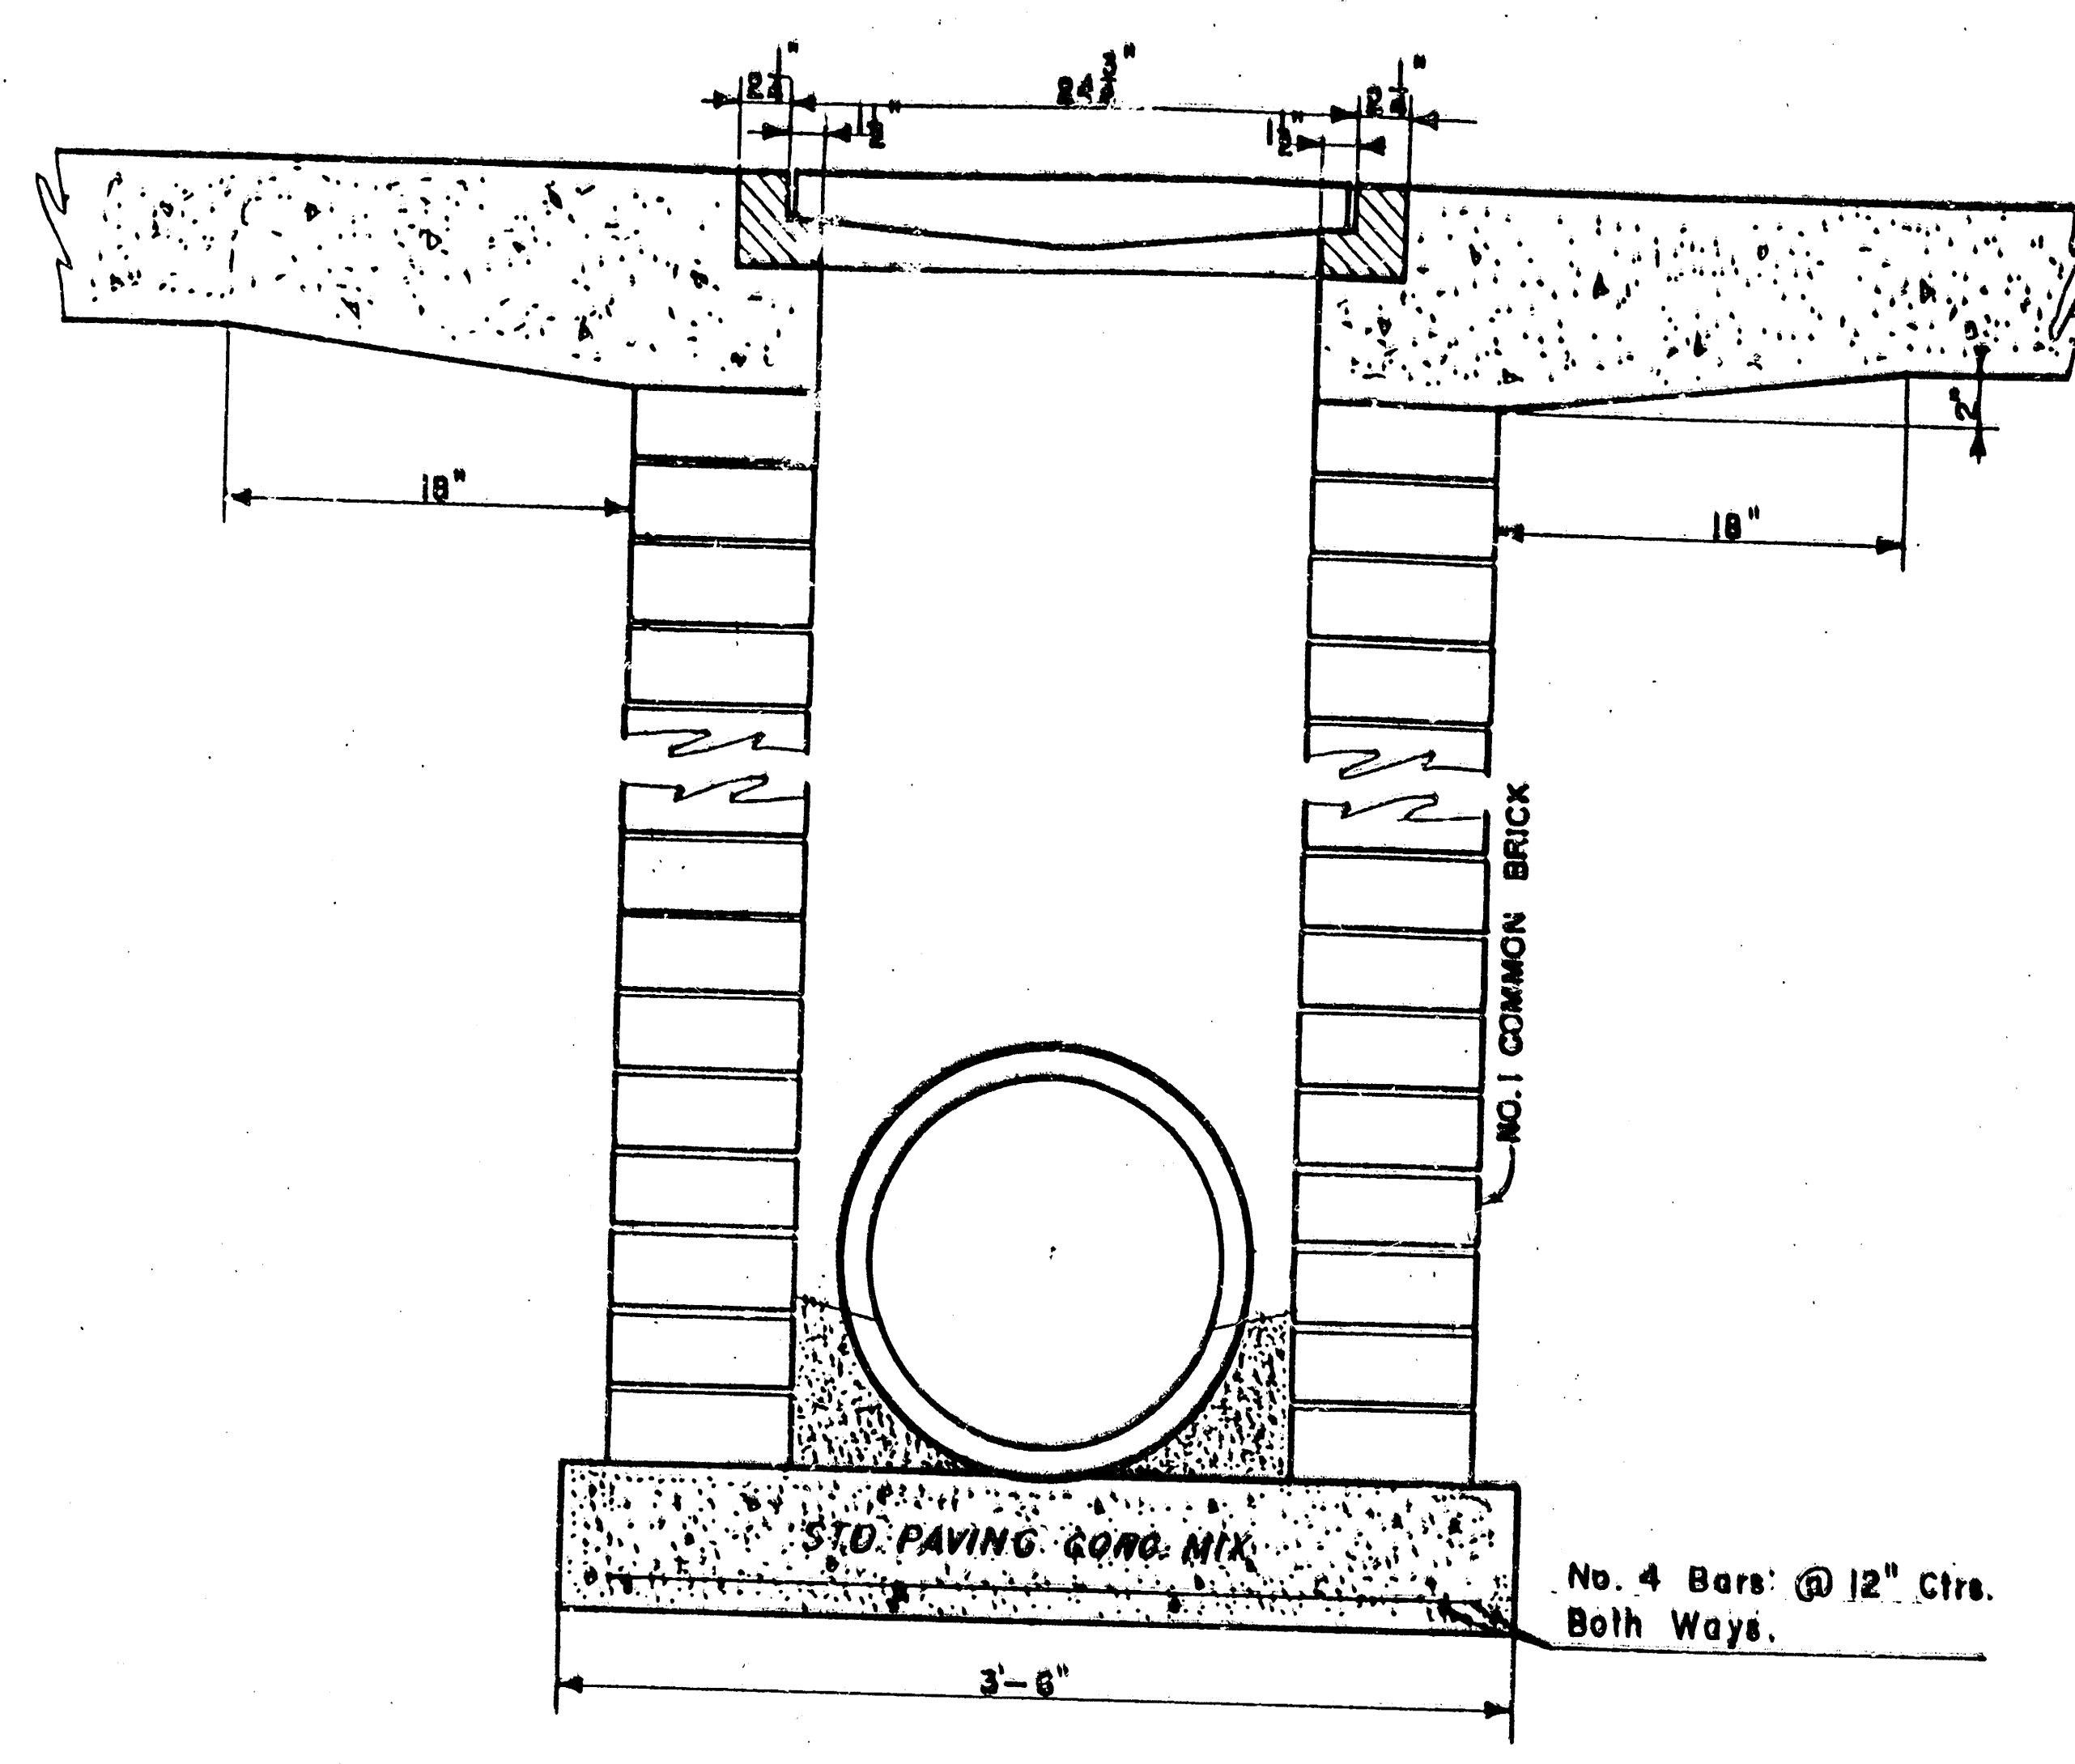

DROP INLET DETAILS
M.E. Lindebak, City Engineer
City of Wichita, Kansas
Project
Project No.
Date:
Scale: 1-1/2" = 1'-0"

REVISED 12-26-90