


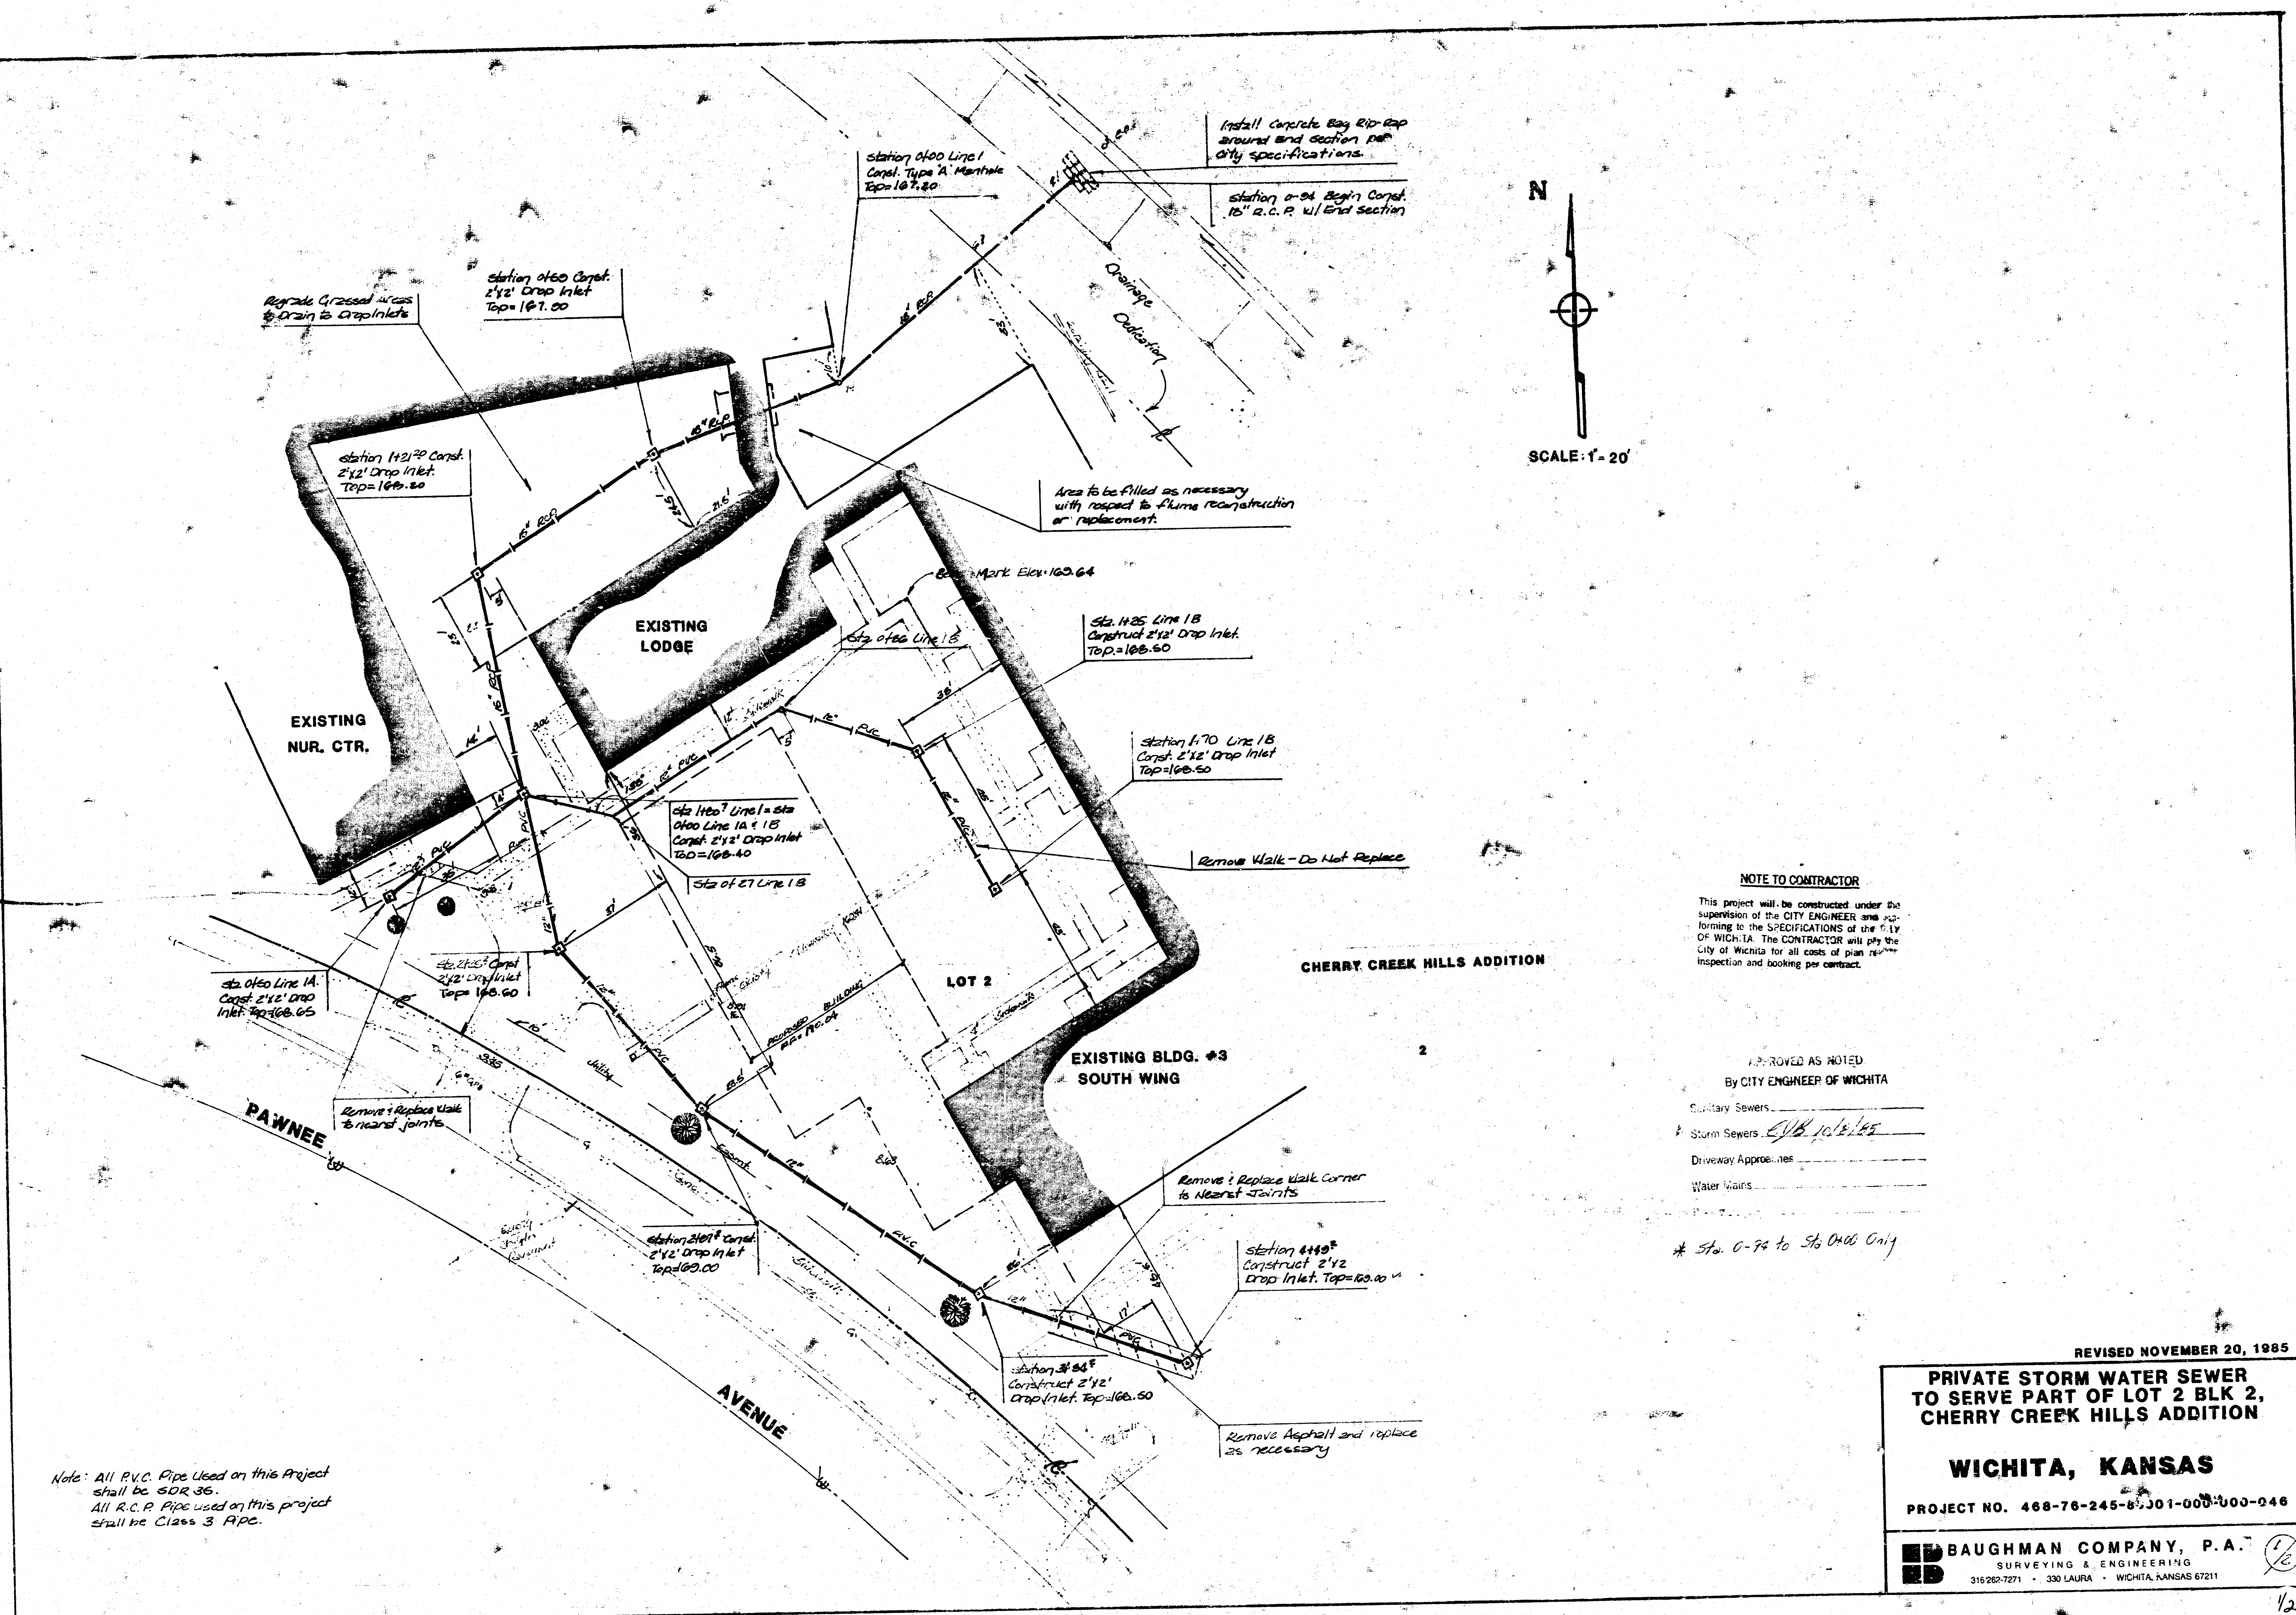

NOTE TO CONTRACTOR
This project will be constructed under the supervision of the CITY ENGINEER and conforming to the SPECIFICATIONS of the CITY OF WICHITA. The CONTRACTOR will pay the City of Wichita for all costs of plan review, inspection and booking per contract.

APPROVED AS NOTED
By CITY ENGINEER OF WICHITA
Sanitary Sewers _____
Storm Sewers EVB jole/85
Driveway Approaches _____
Water Mains _____

* Sta. 0+94 to Sta. 0+00 Only

Note: All P.V.C. Pipe Used on this Project shall be SDR 36.
All R.C.P. Pipe used on this project shall be Class 3 Pipe.

REVISED NOVEMBER 20, 1985


**PRIVATE STORM WATER SEWER
TO SERVE PART OF LOT 2 BLK 2,
CHERRY CREEK HILLS ADDITION**

WICHITA, KANSAS

PROJECT NO. 468-76-245-8 J01-000-000-046

BAUGHMAN COMPANY, P.A.
SURVEYING & ENGINEERING
316-262-7271 • 330 LAURA • WICHITA, KANSAS 67211

FILMED FROM THE BEST
AVAILABLE COPY

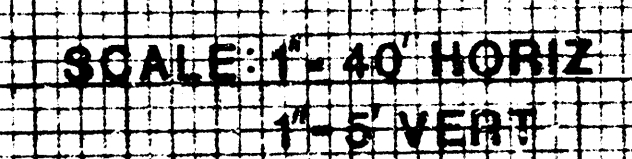

FILMED FROM THE BEST
AVAILABLE COPY