
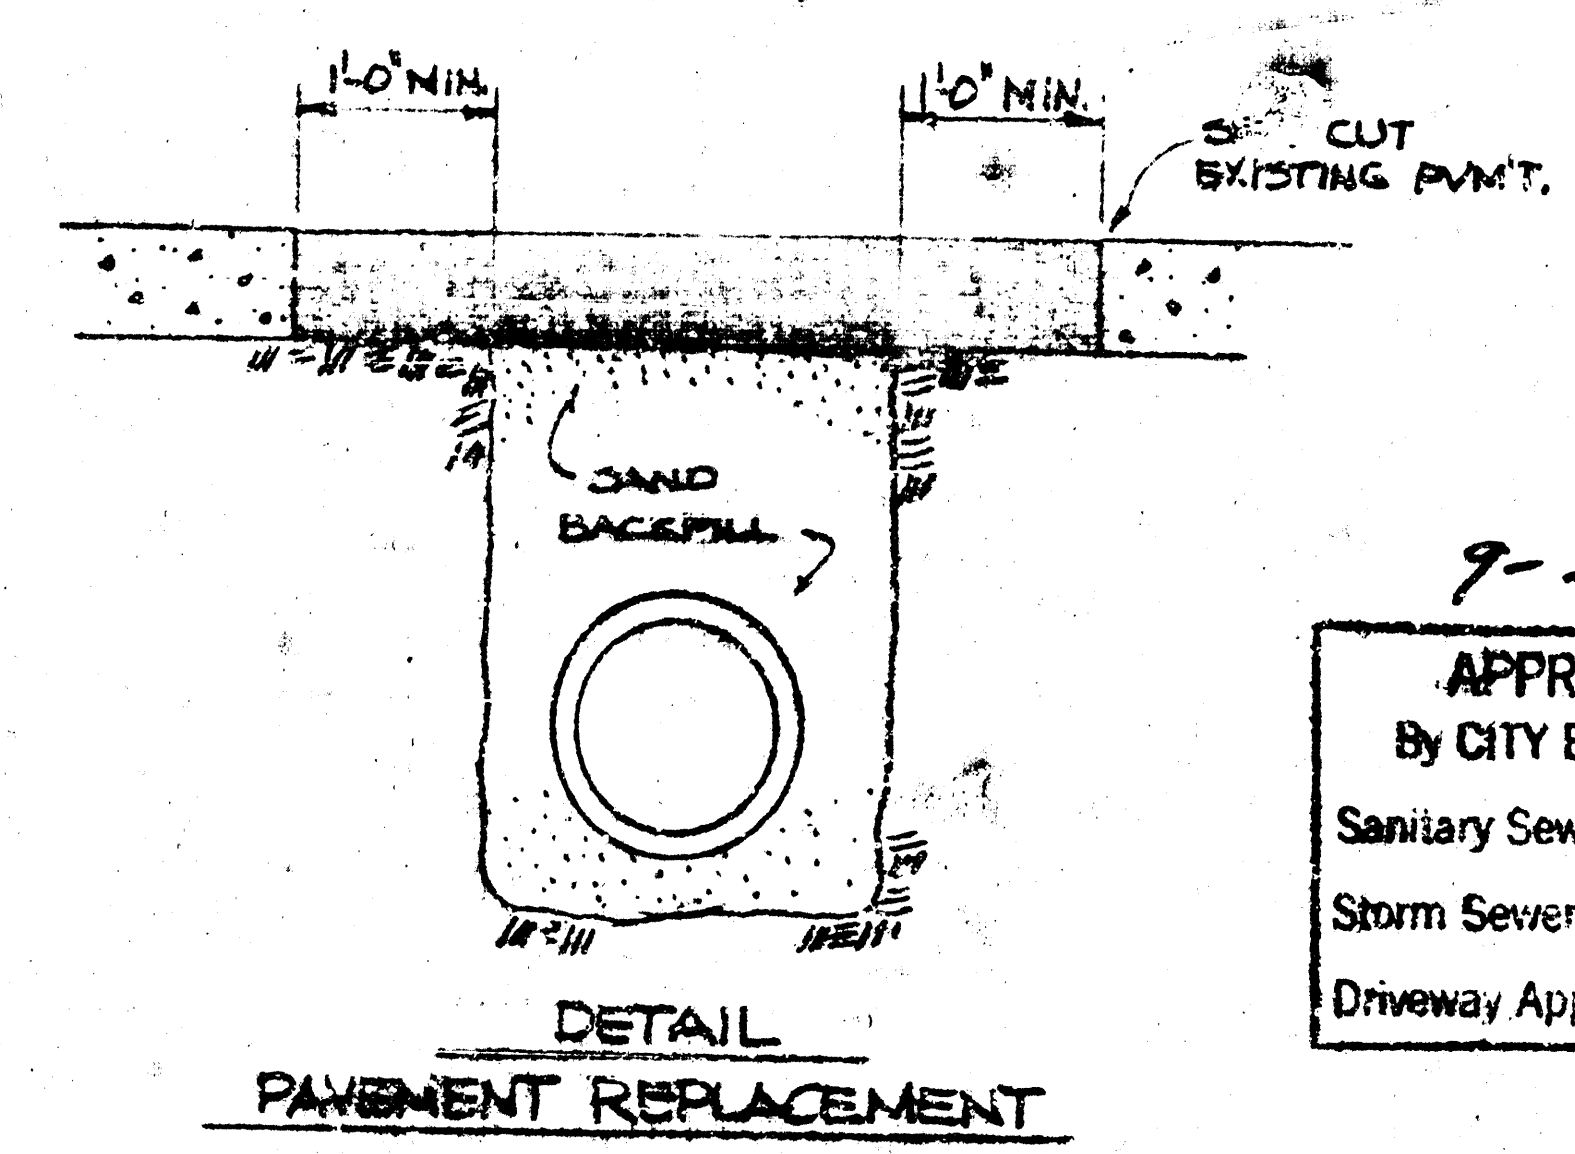
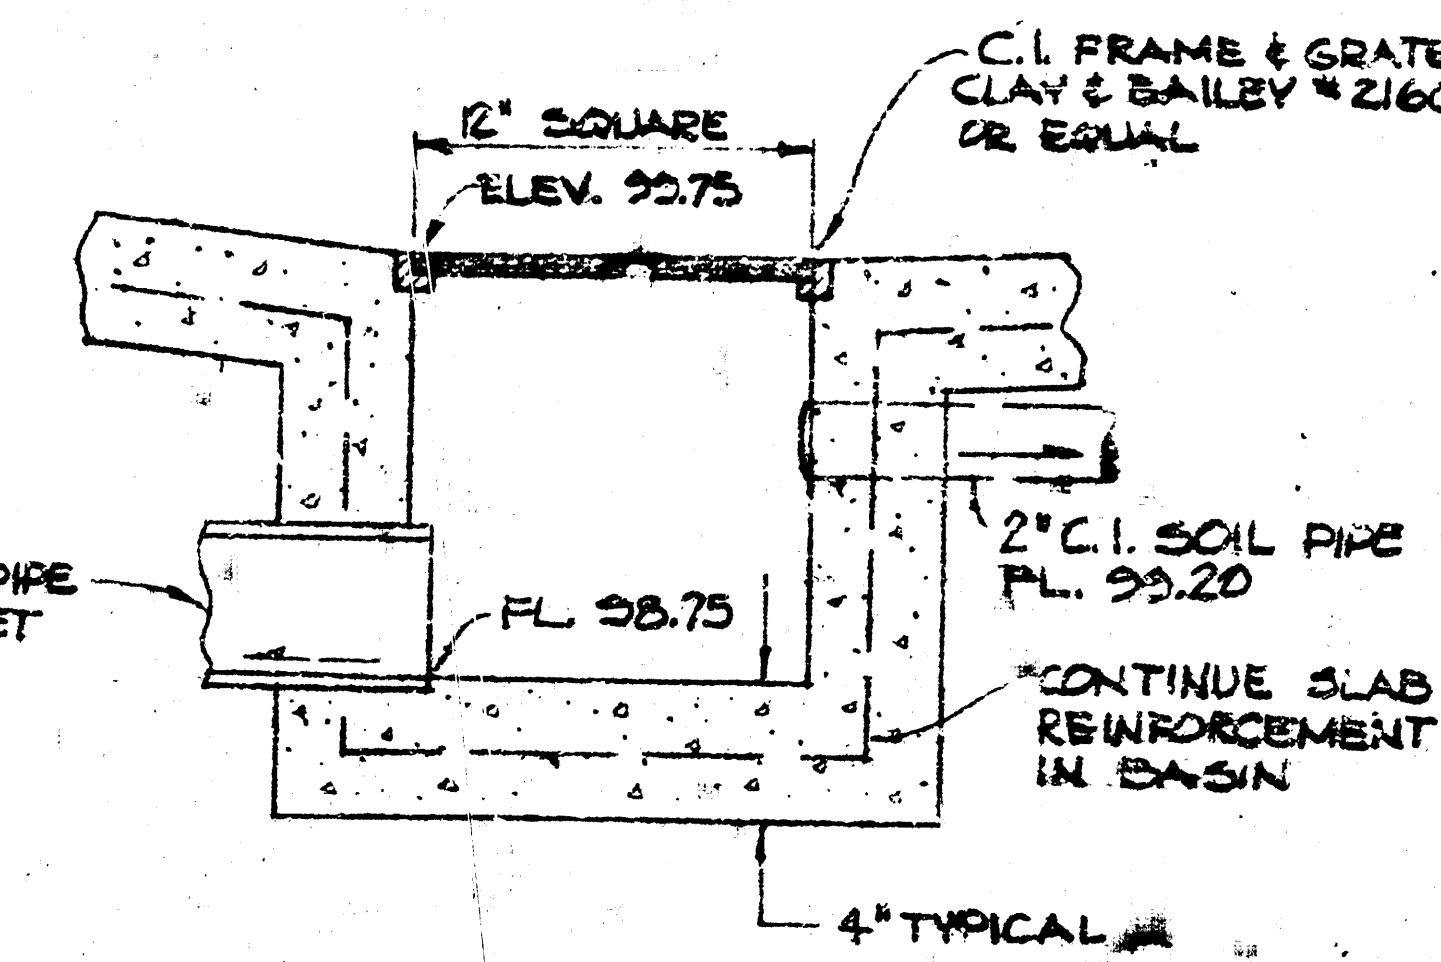
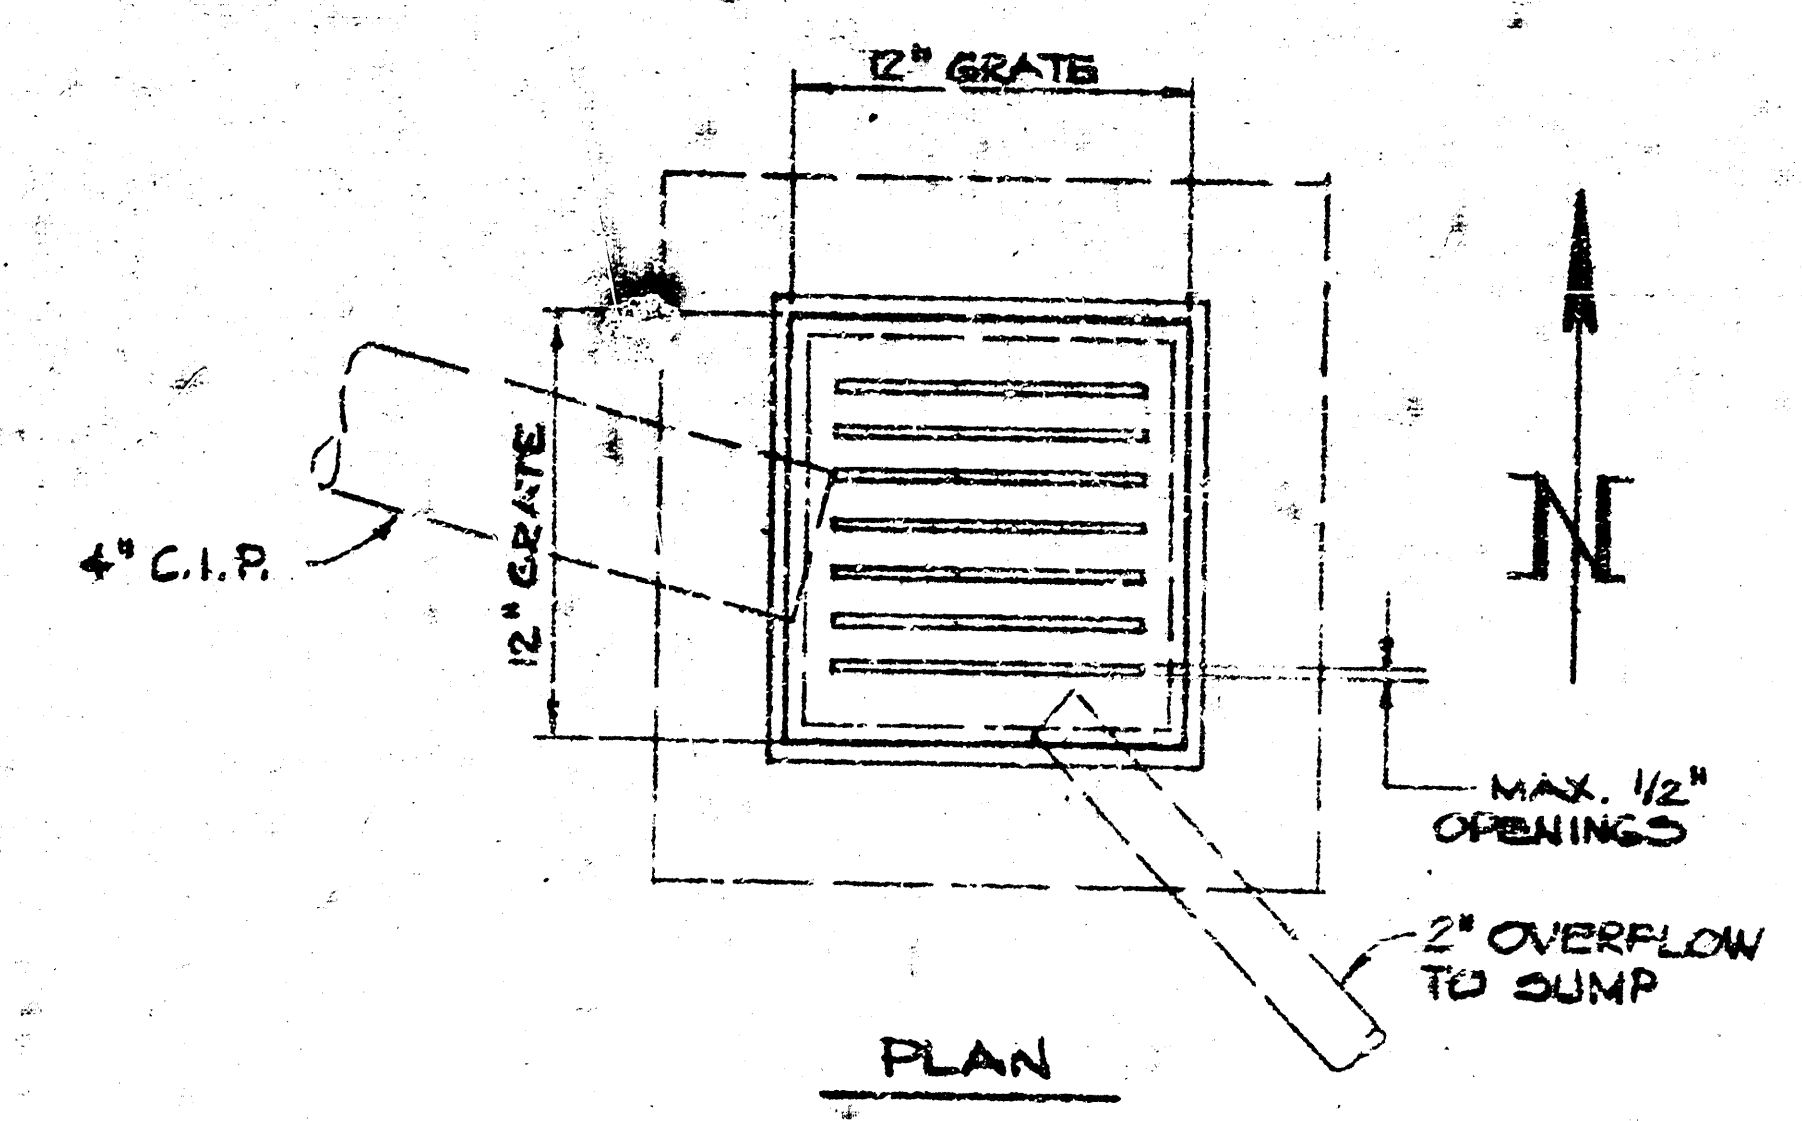


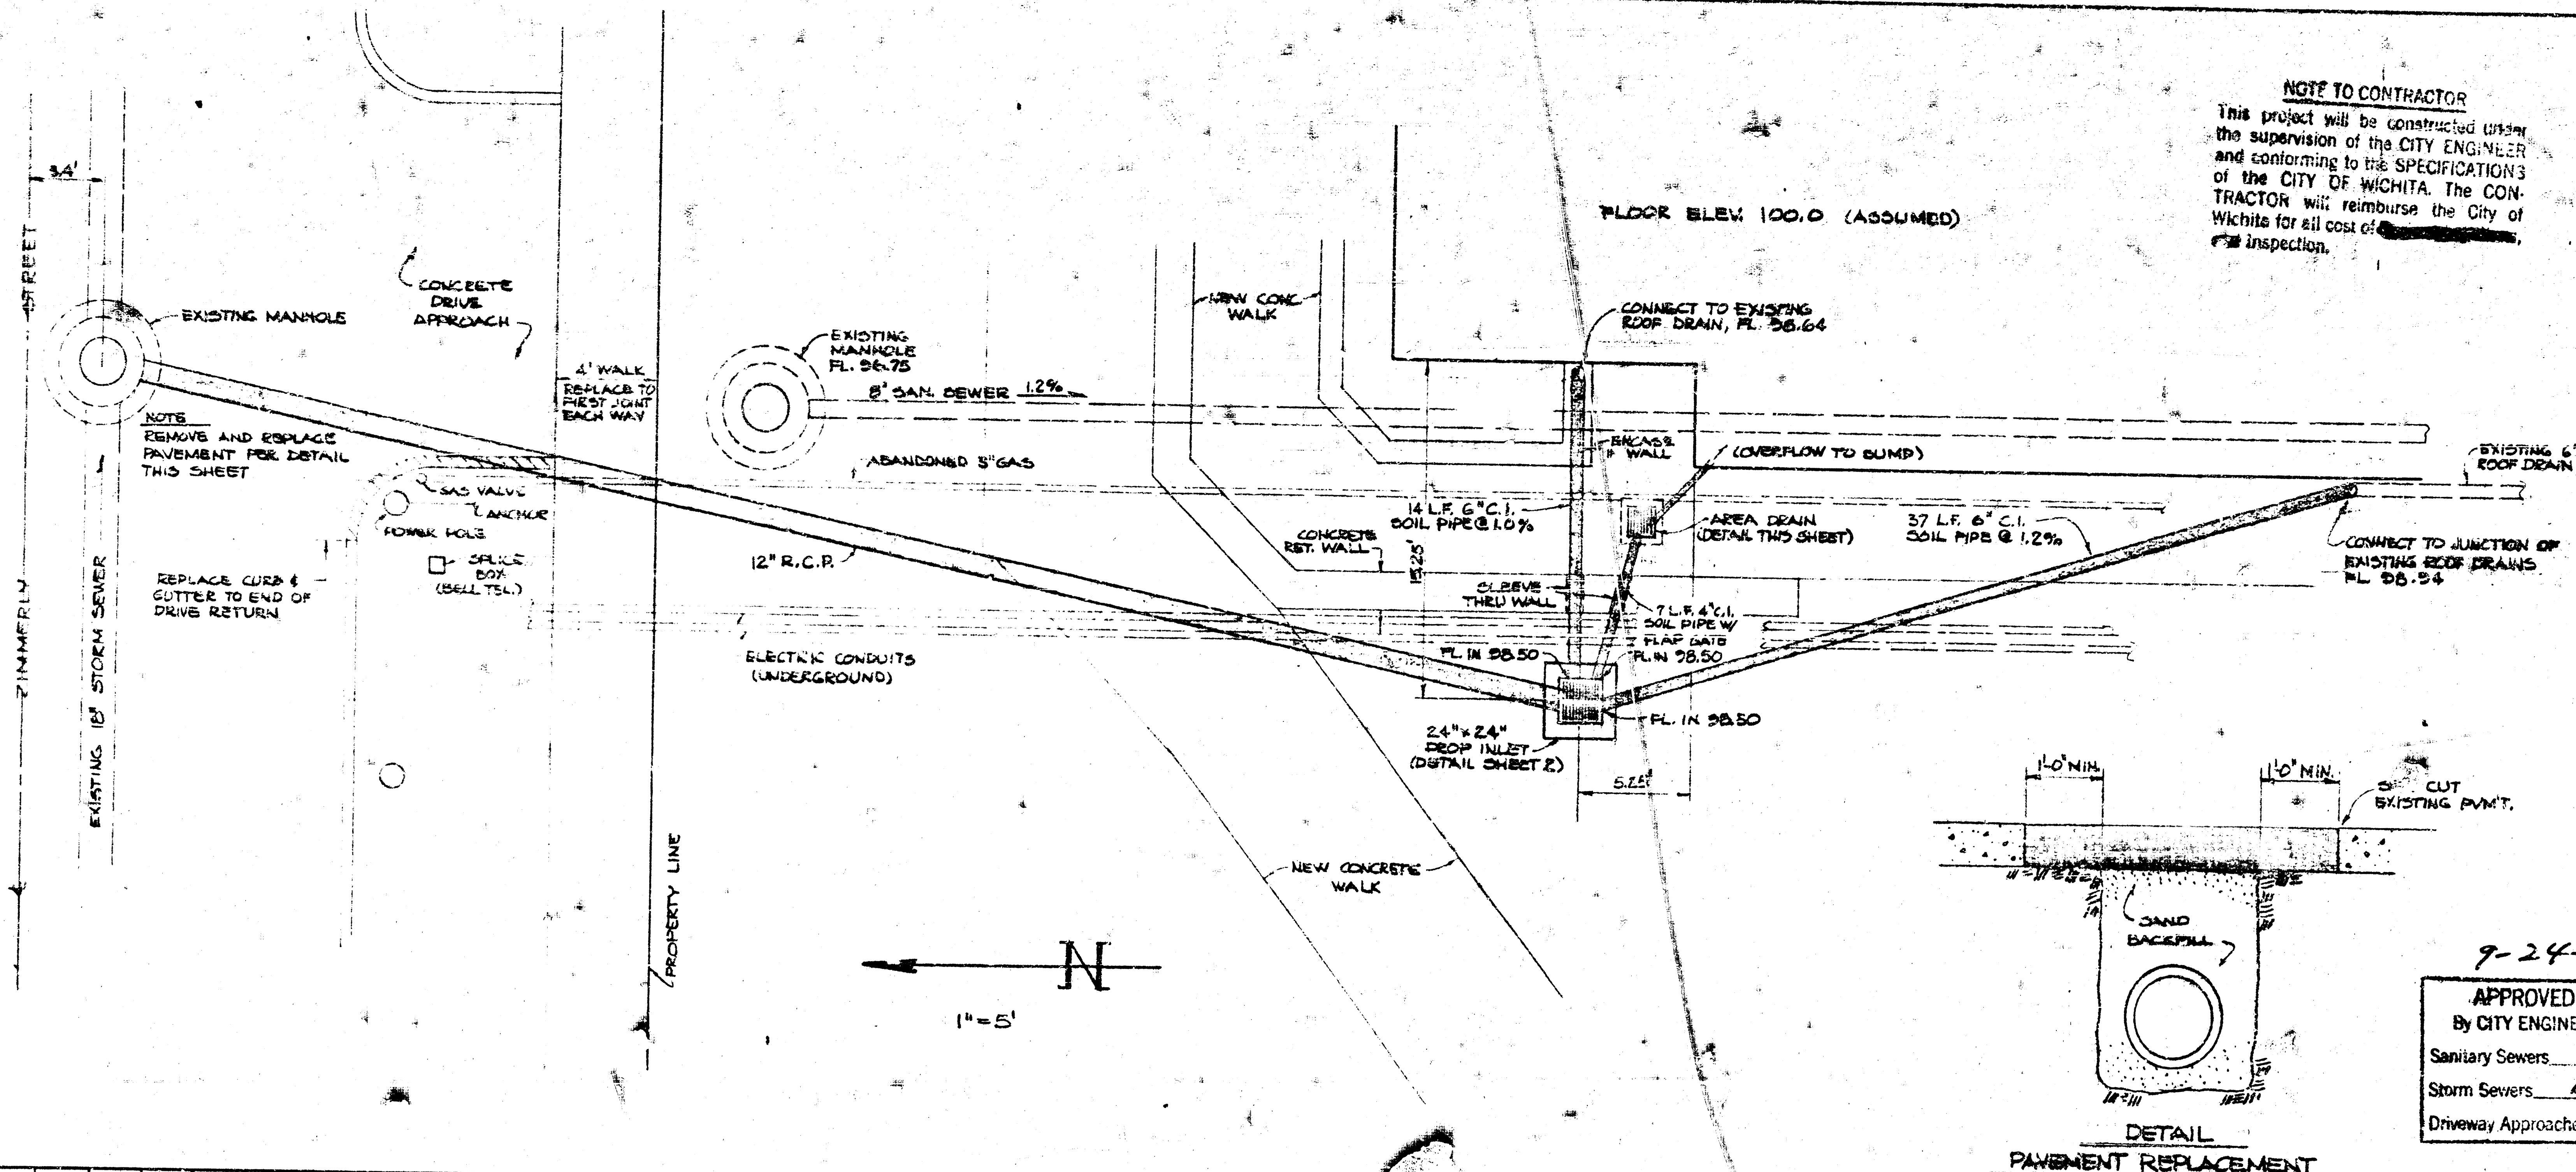

9-24-75


APPROVED AS NOTED
By CITY ENGINEER OF WICHITA:



Sanitary Sewers _____

Storm Sewers D.E.S.


Driveway Approaches _____

DETAIL AREA DRAIN
1/8" = 1"



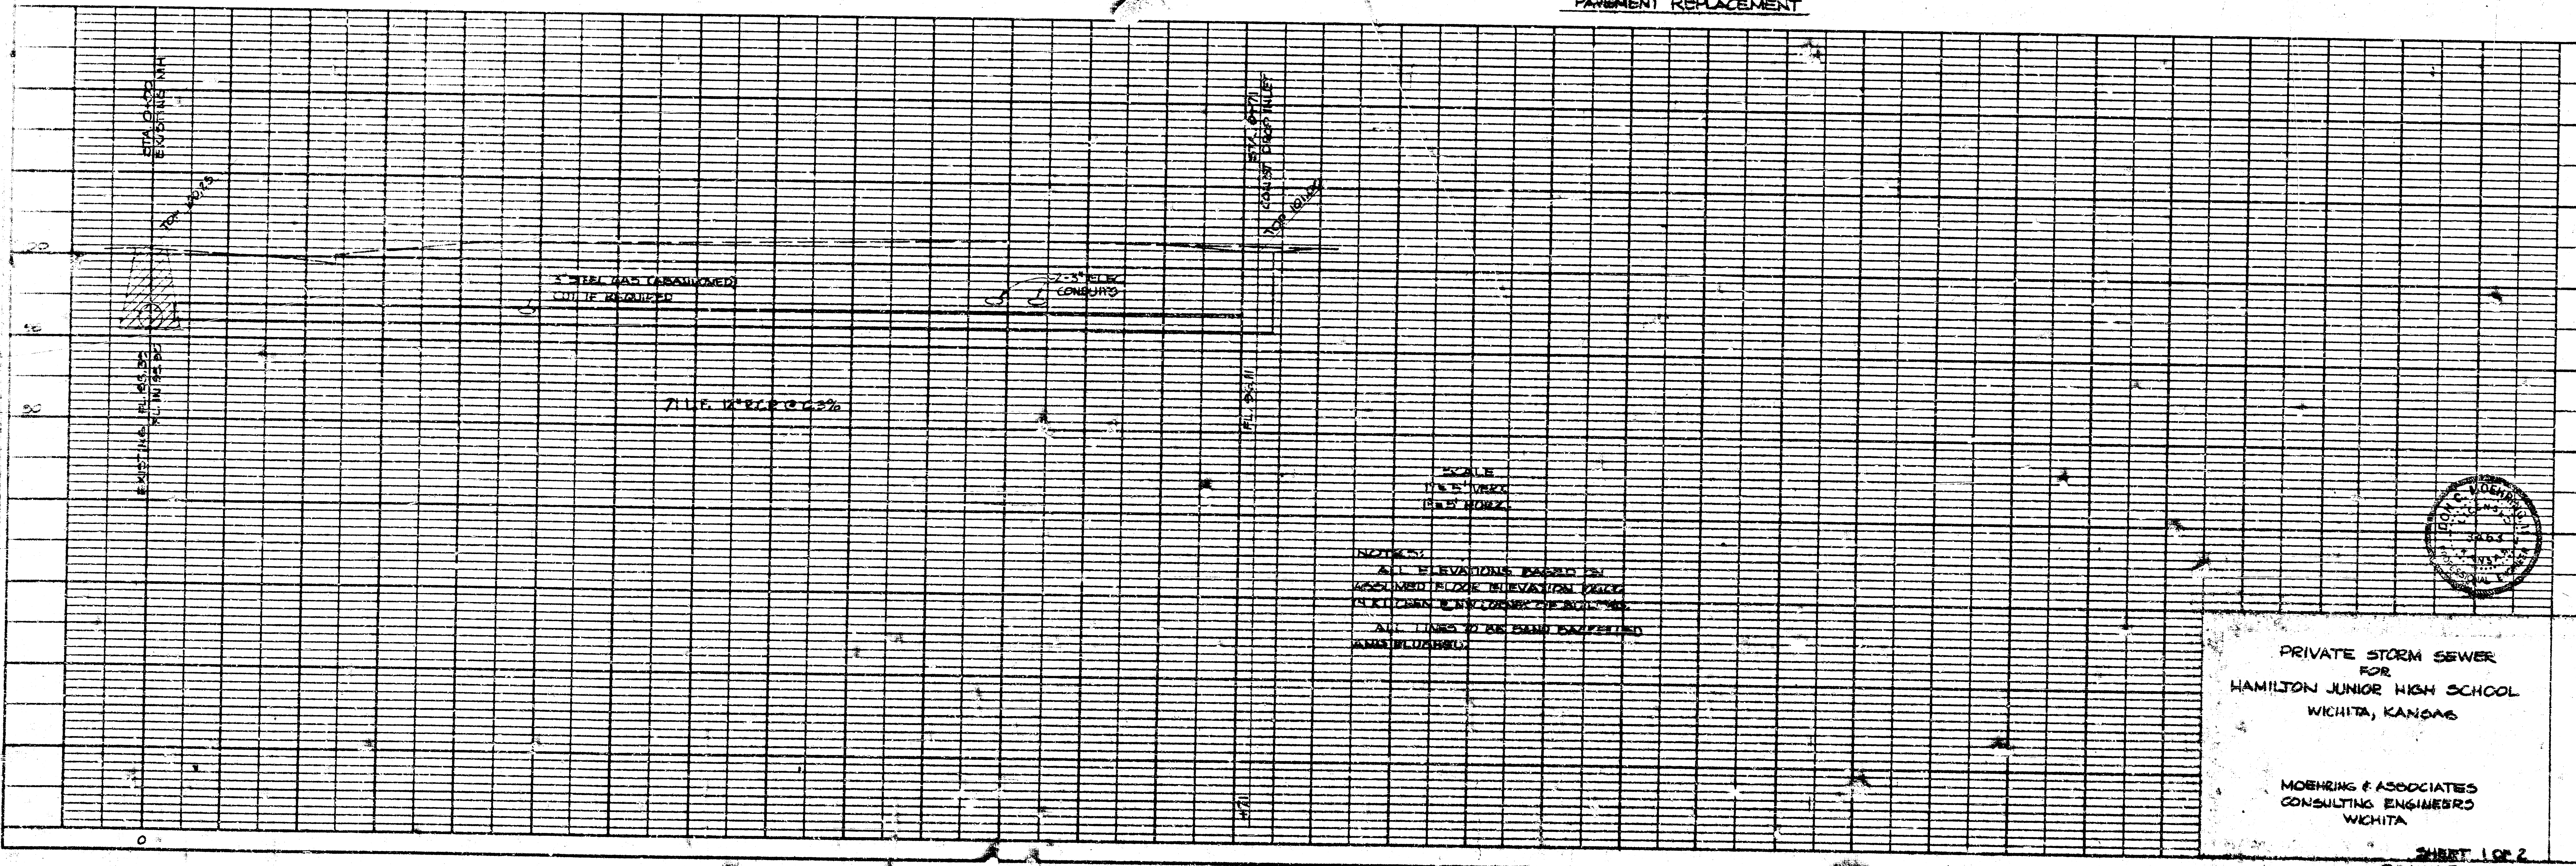


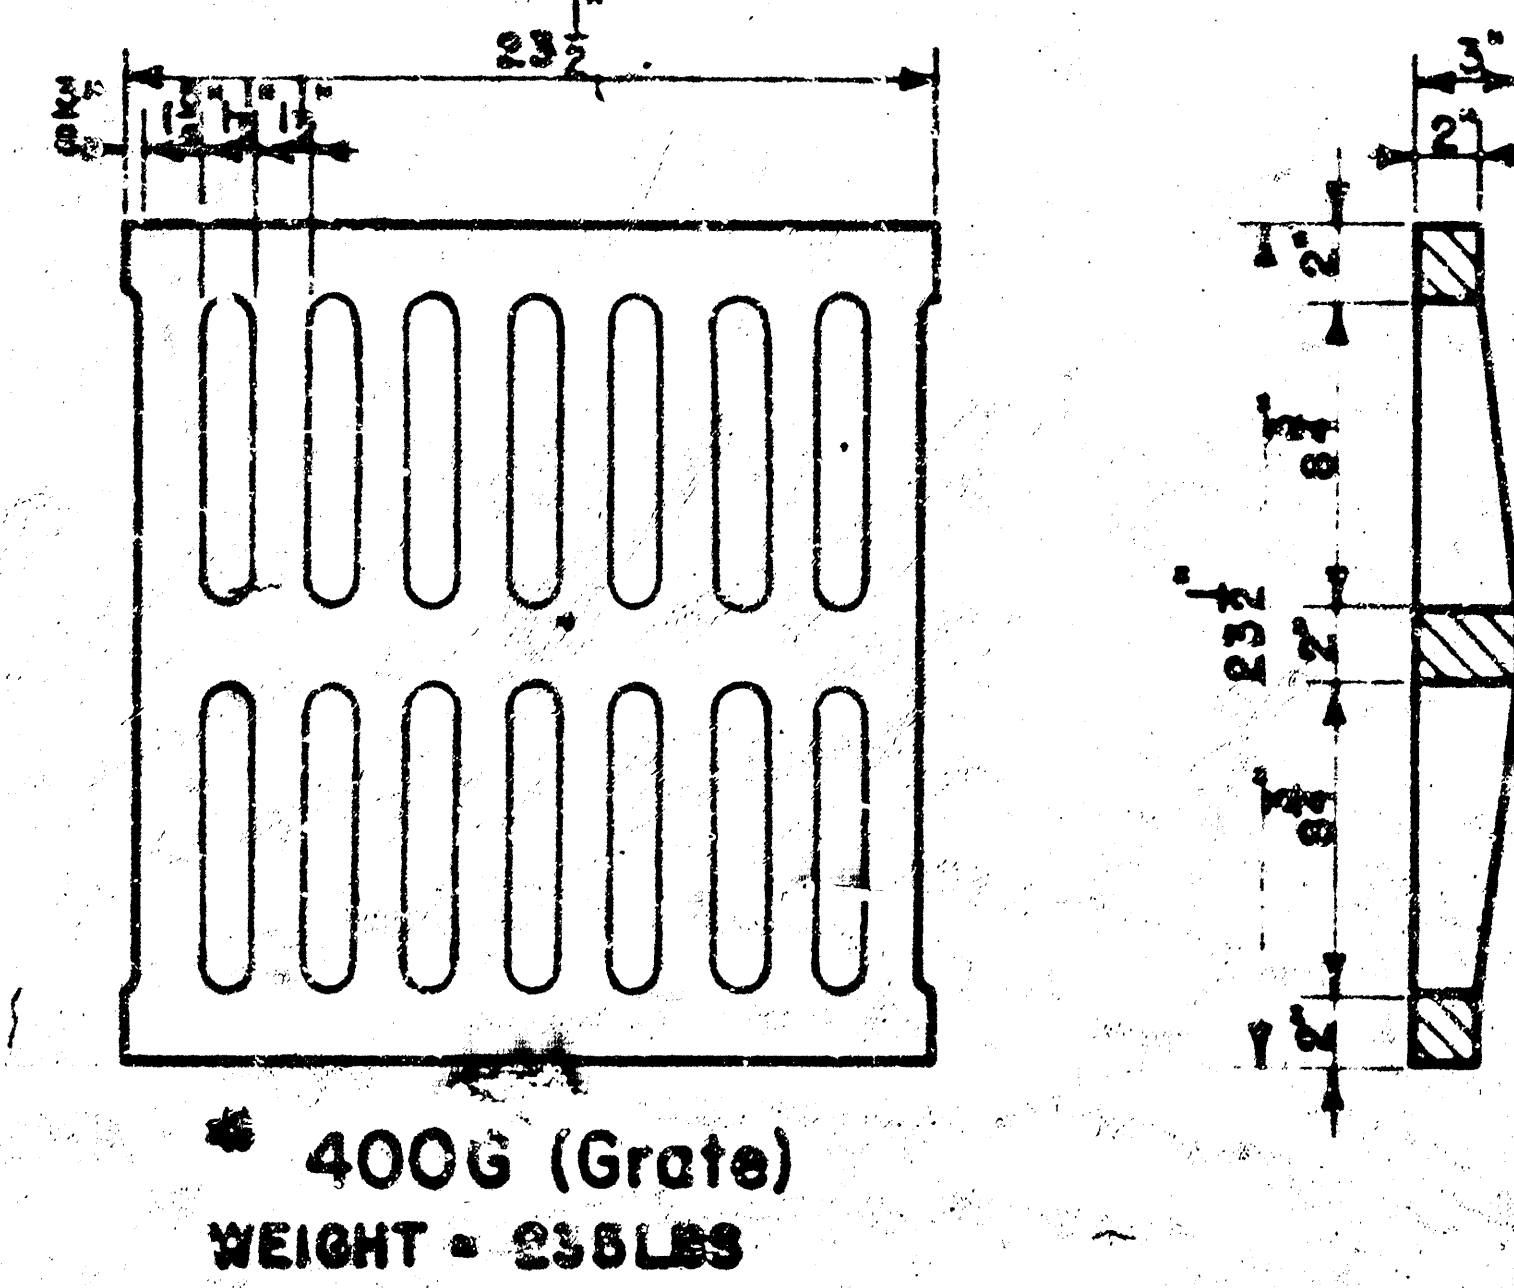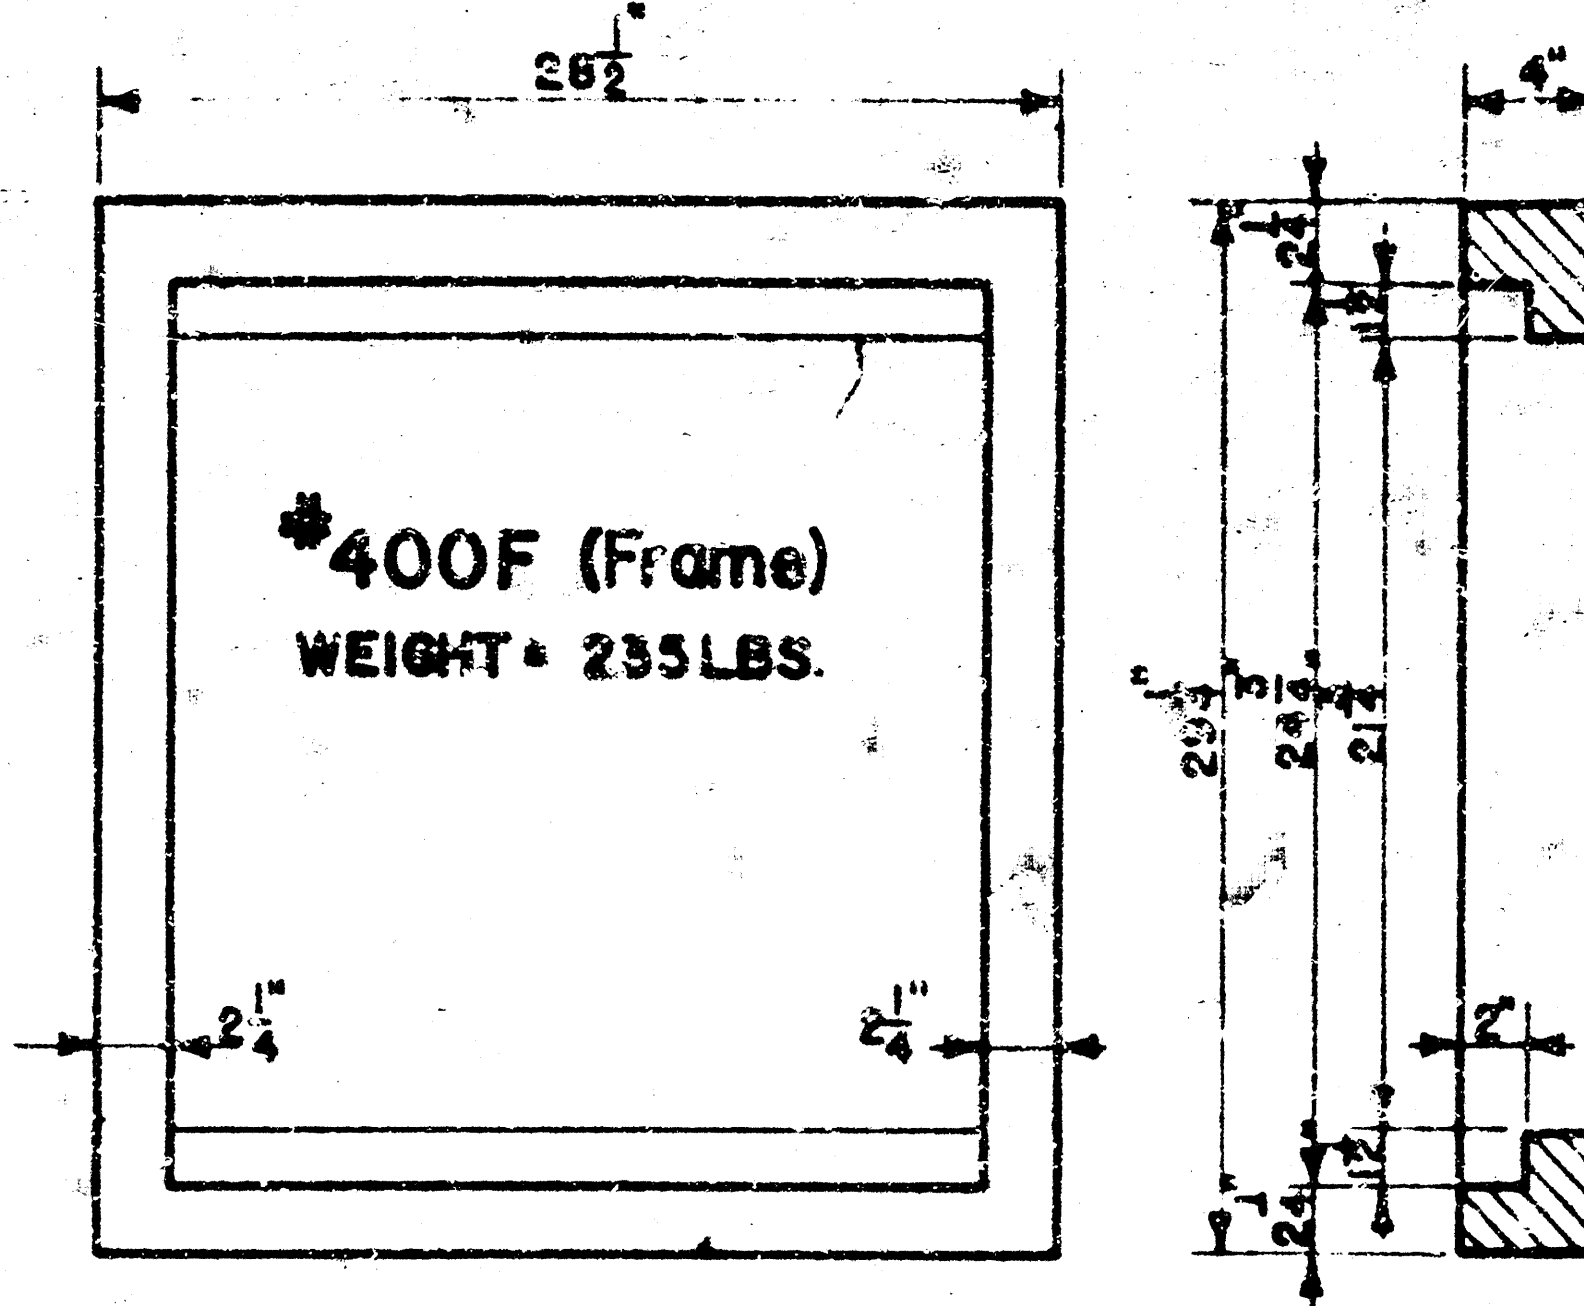

24"x24" Frame & Grate Detail

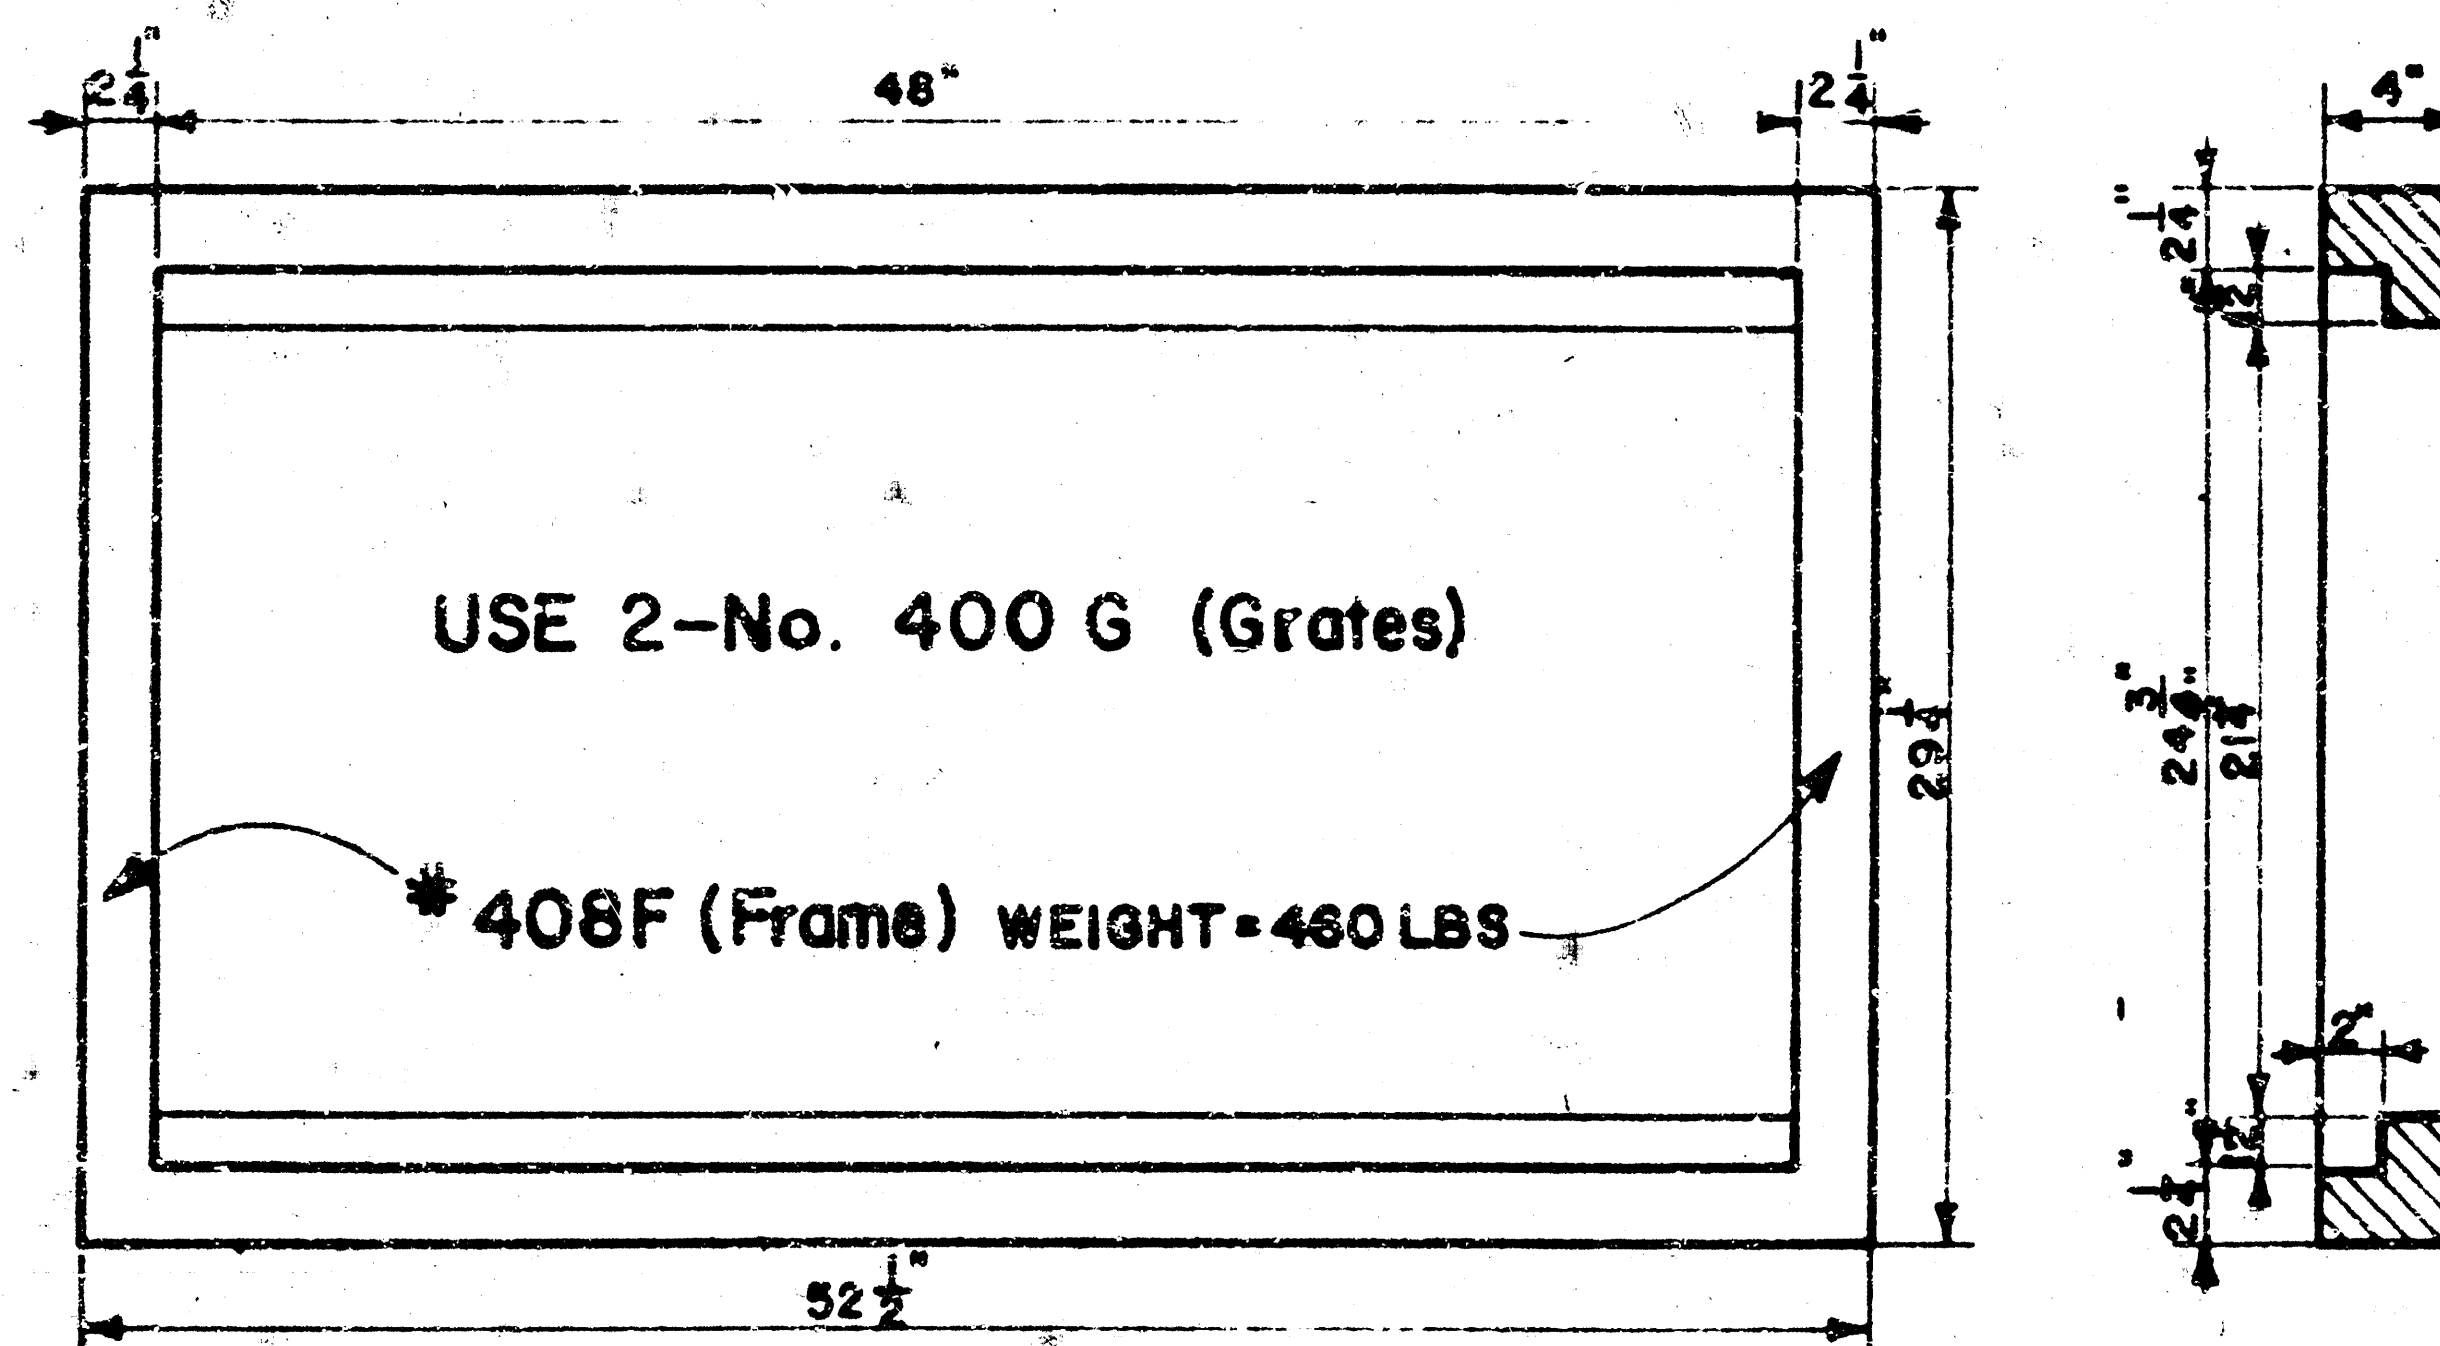

Double 24"x24" Frame Detail

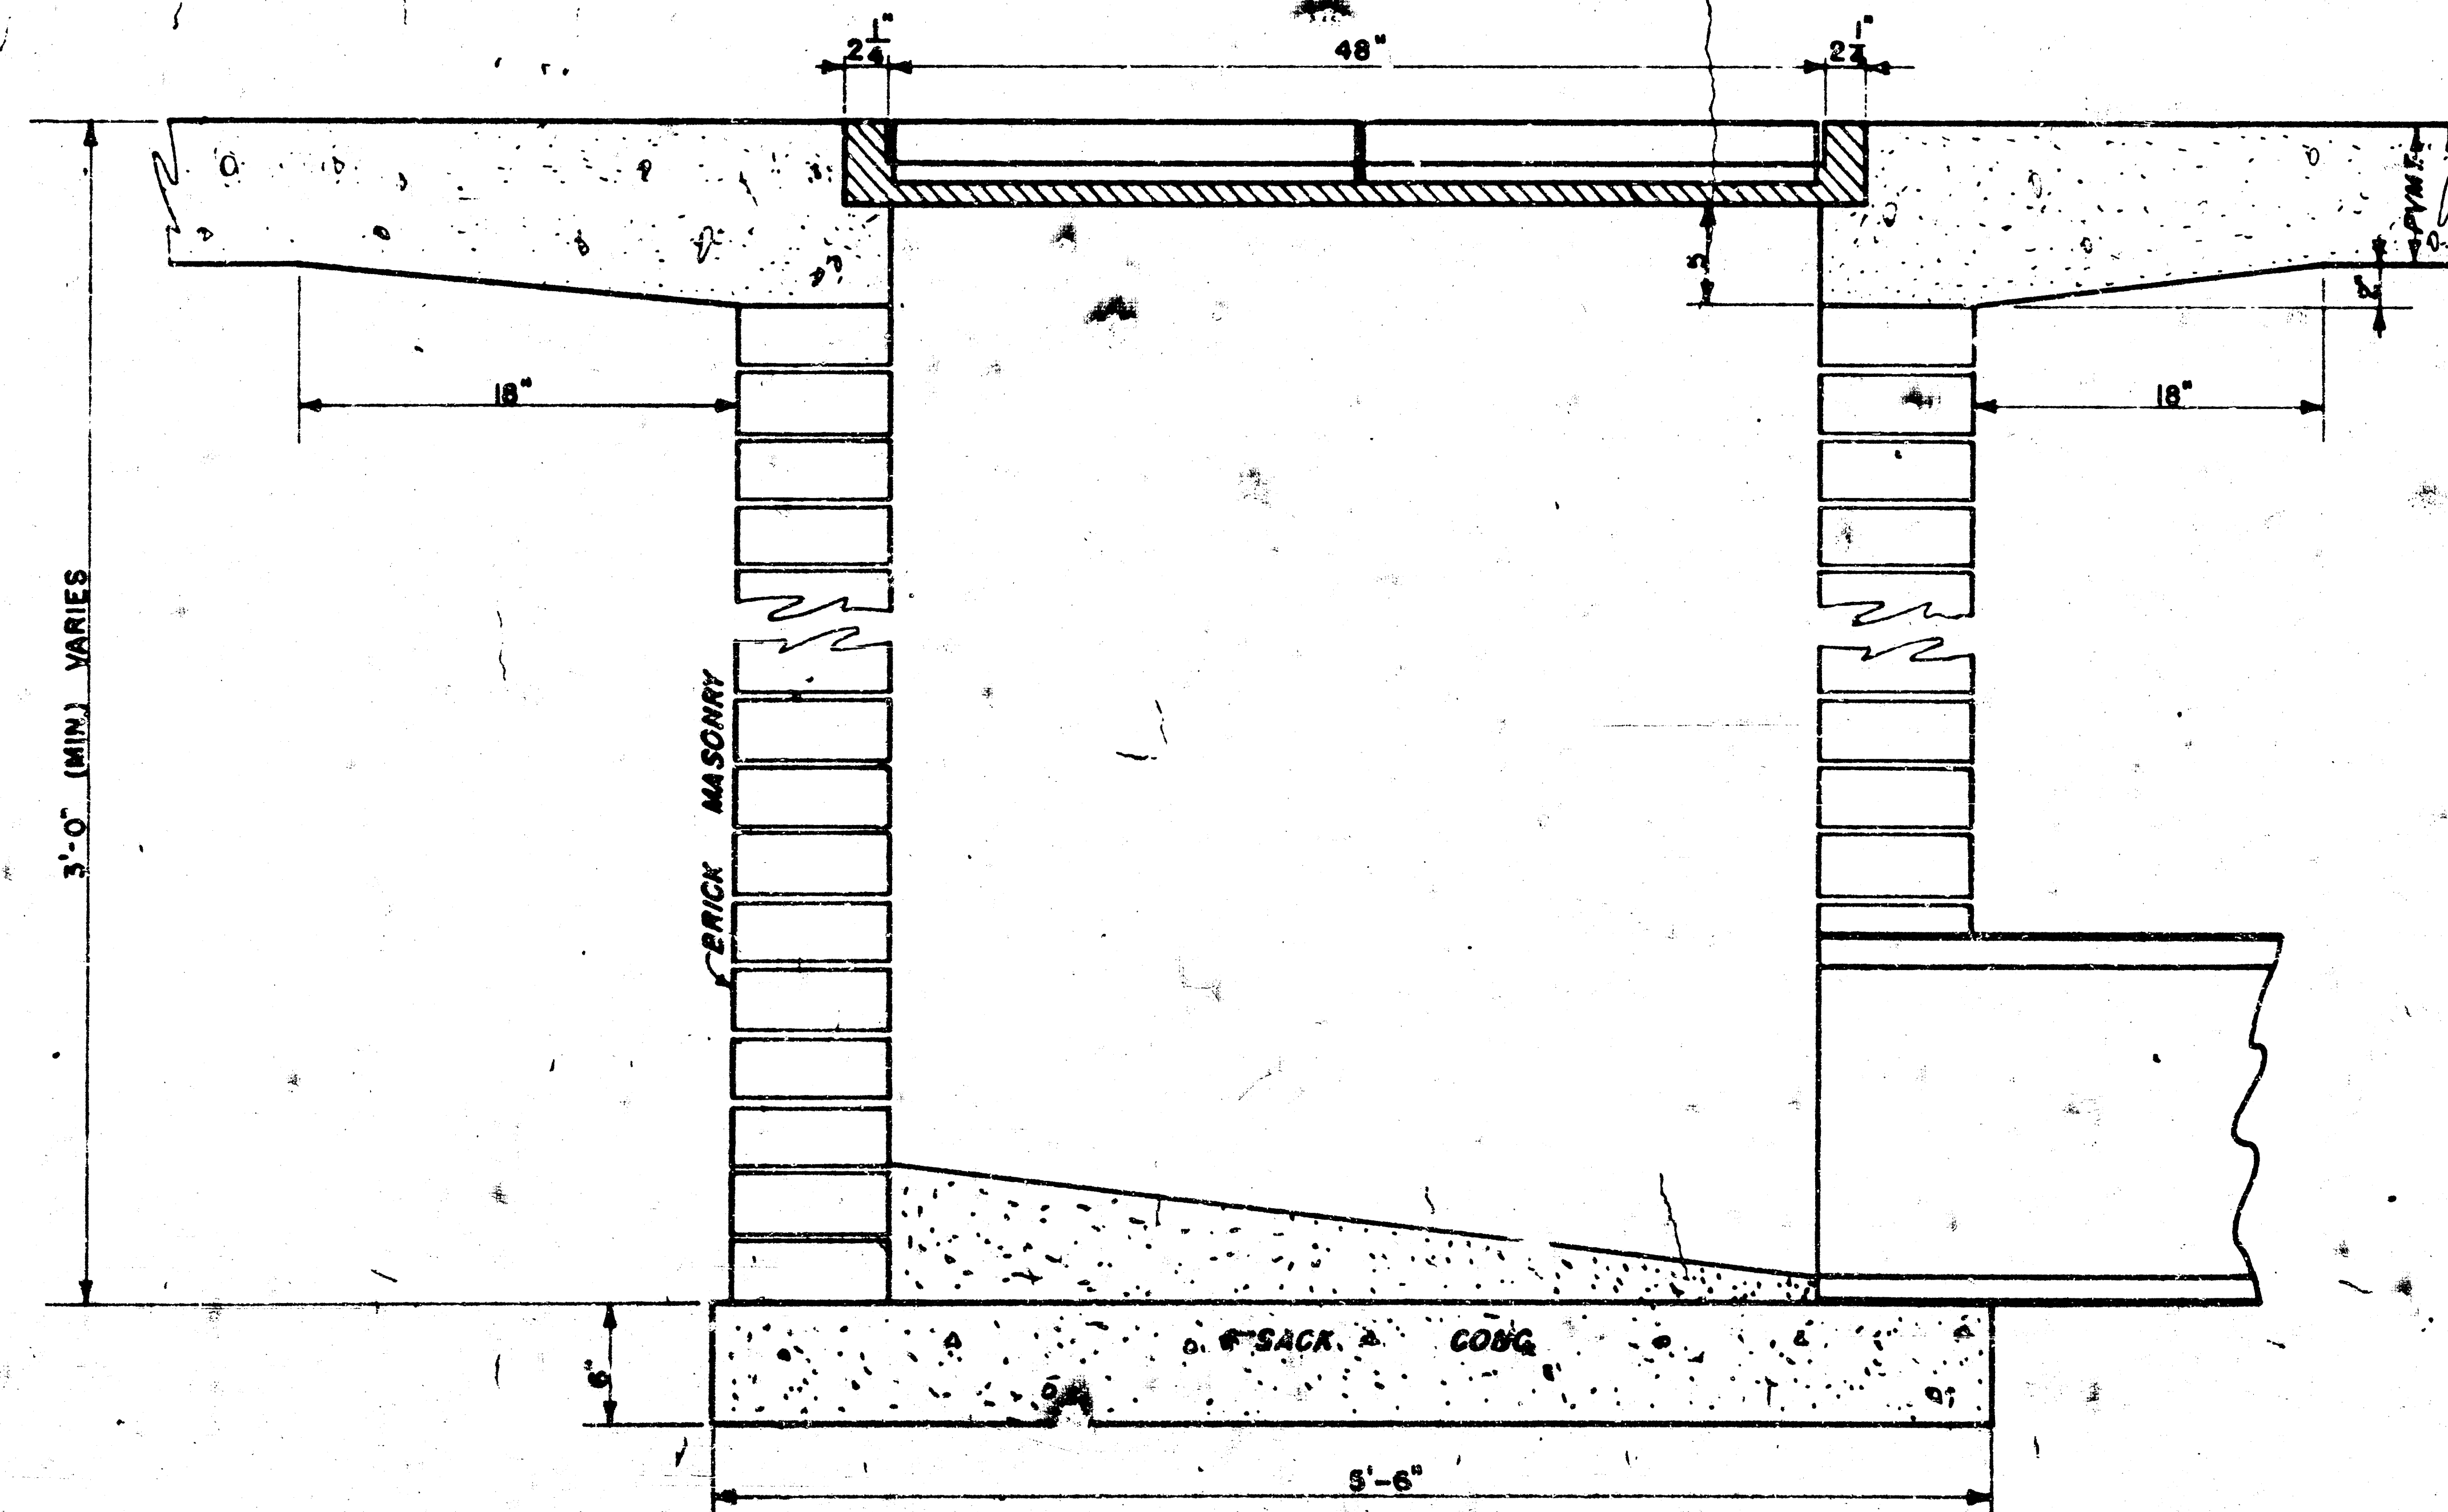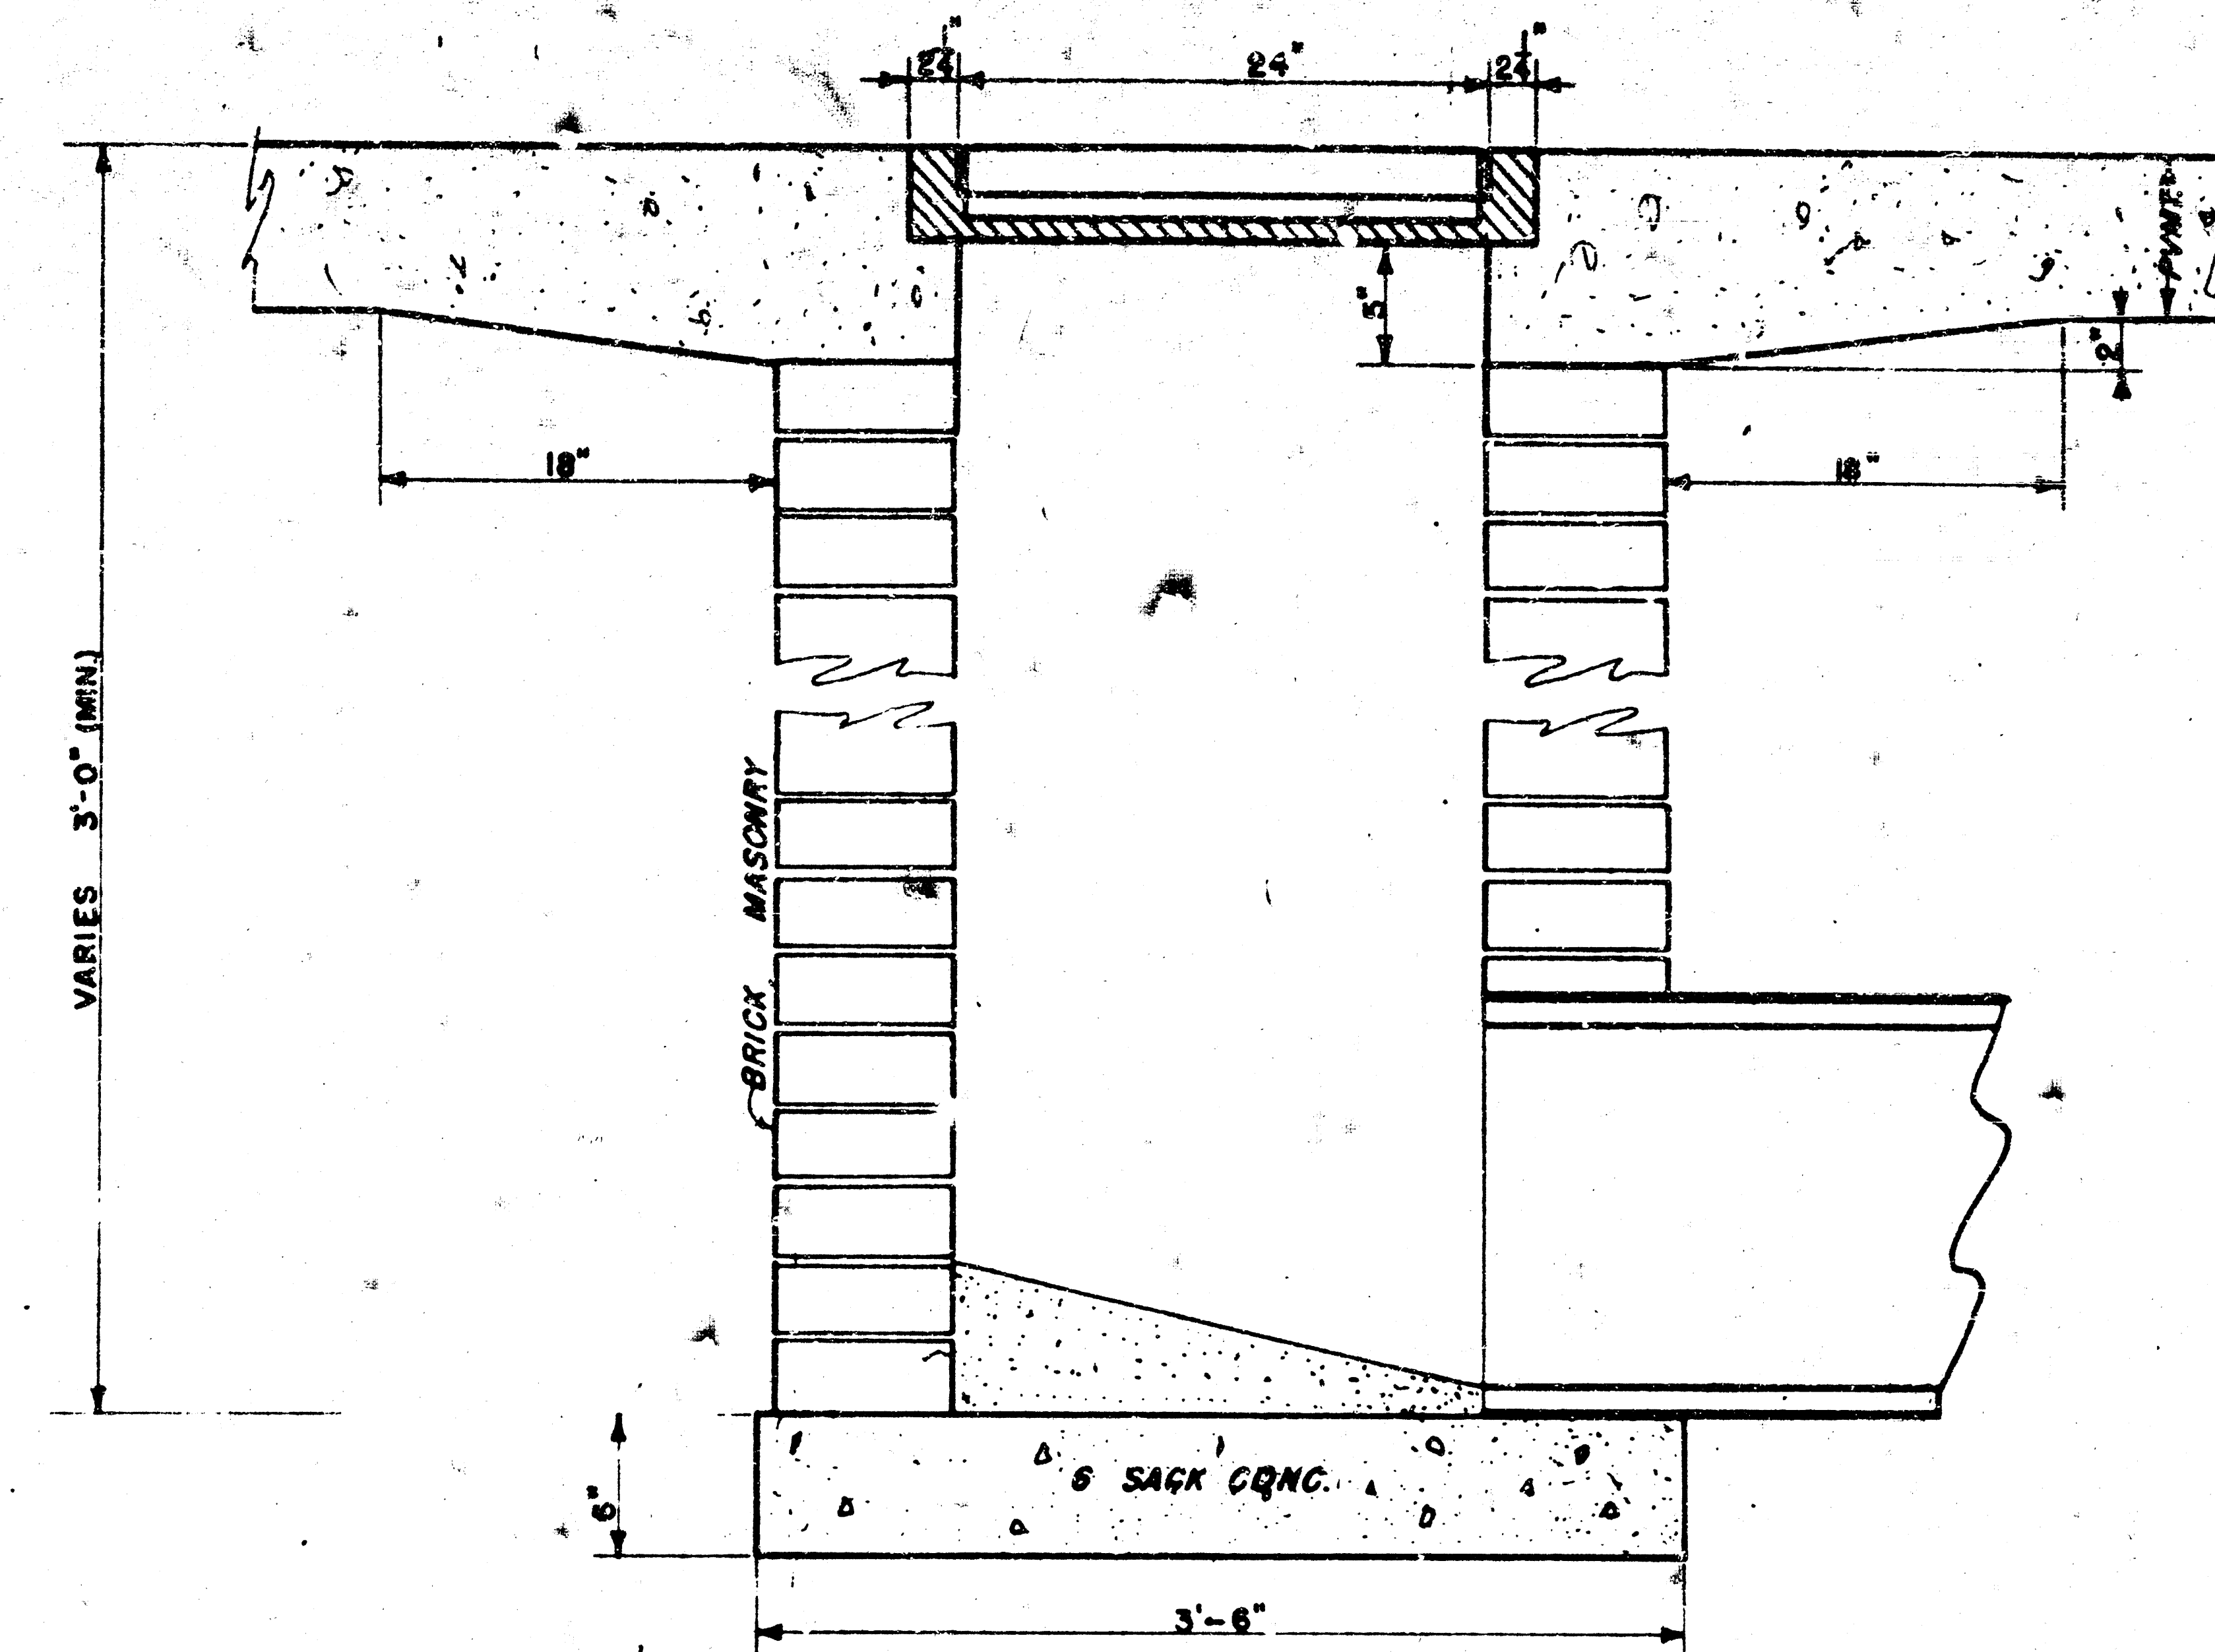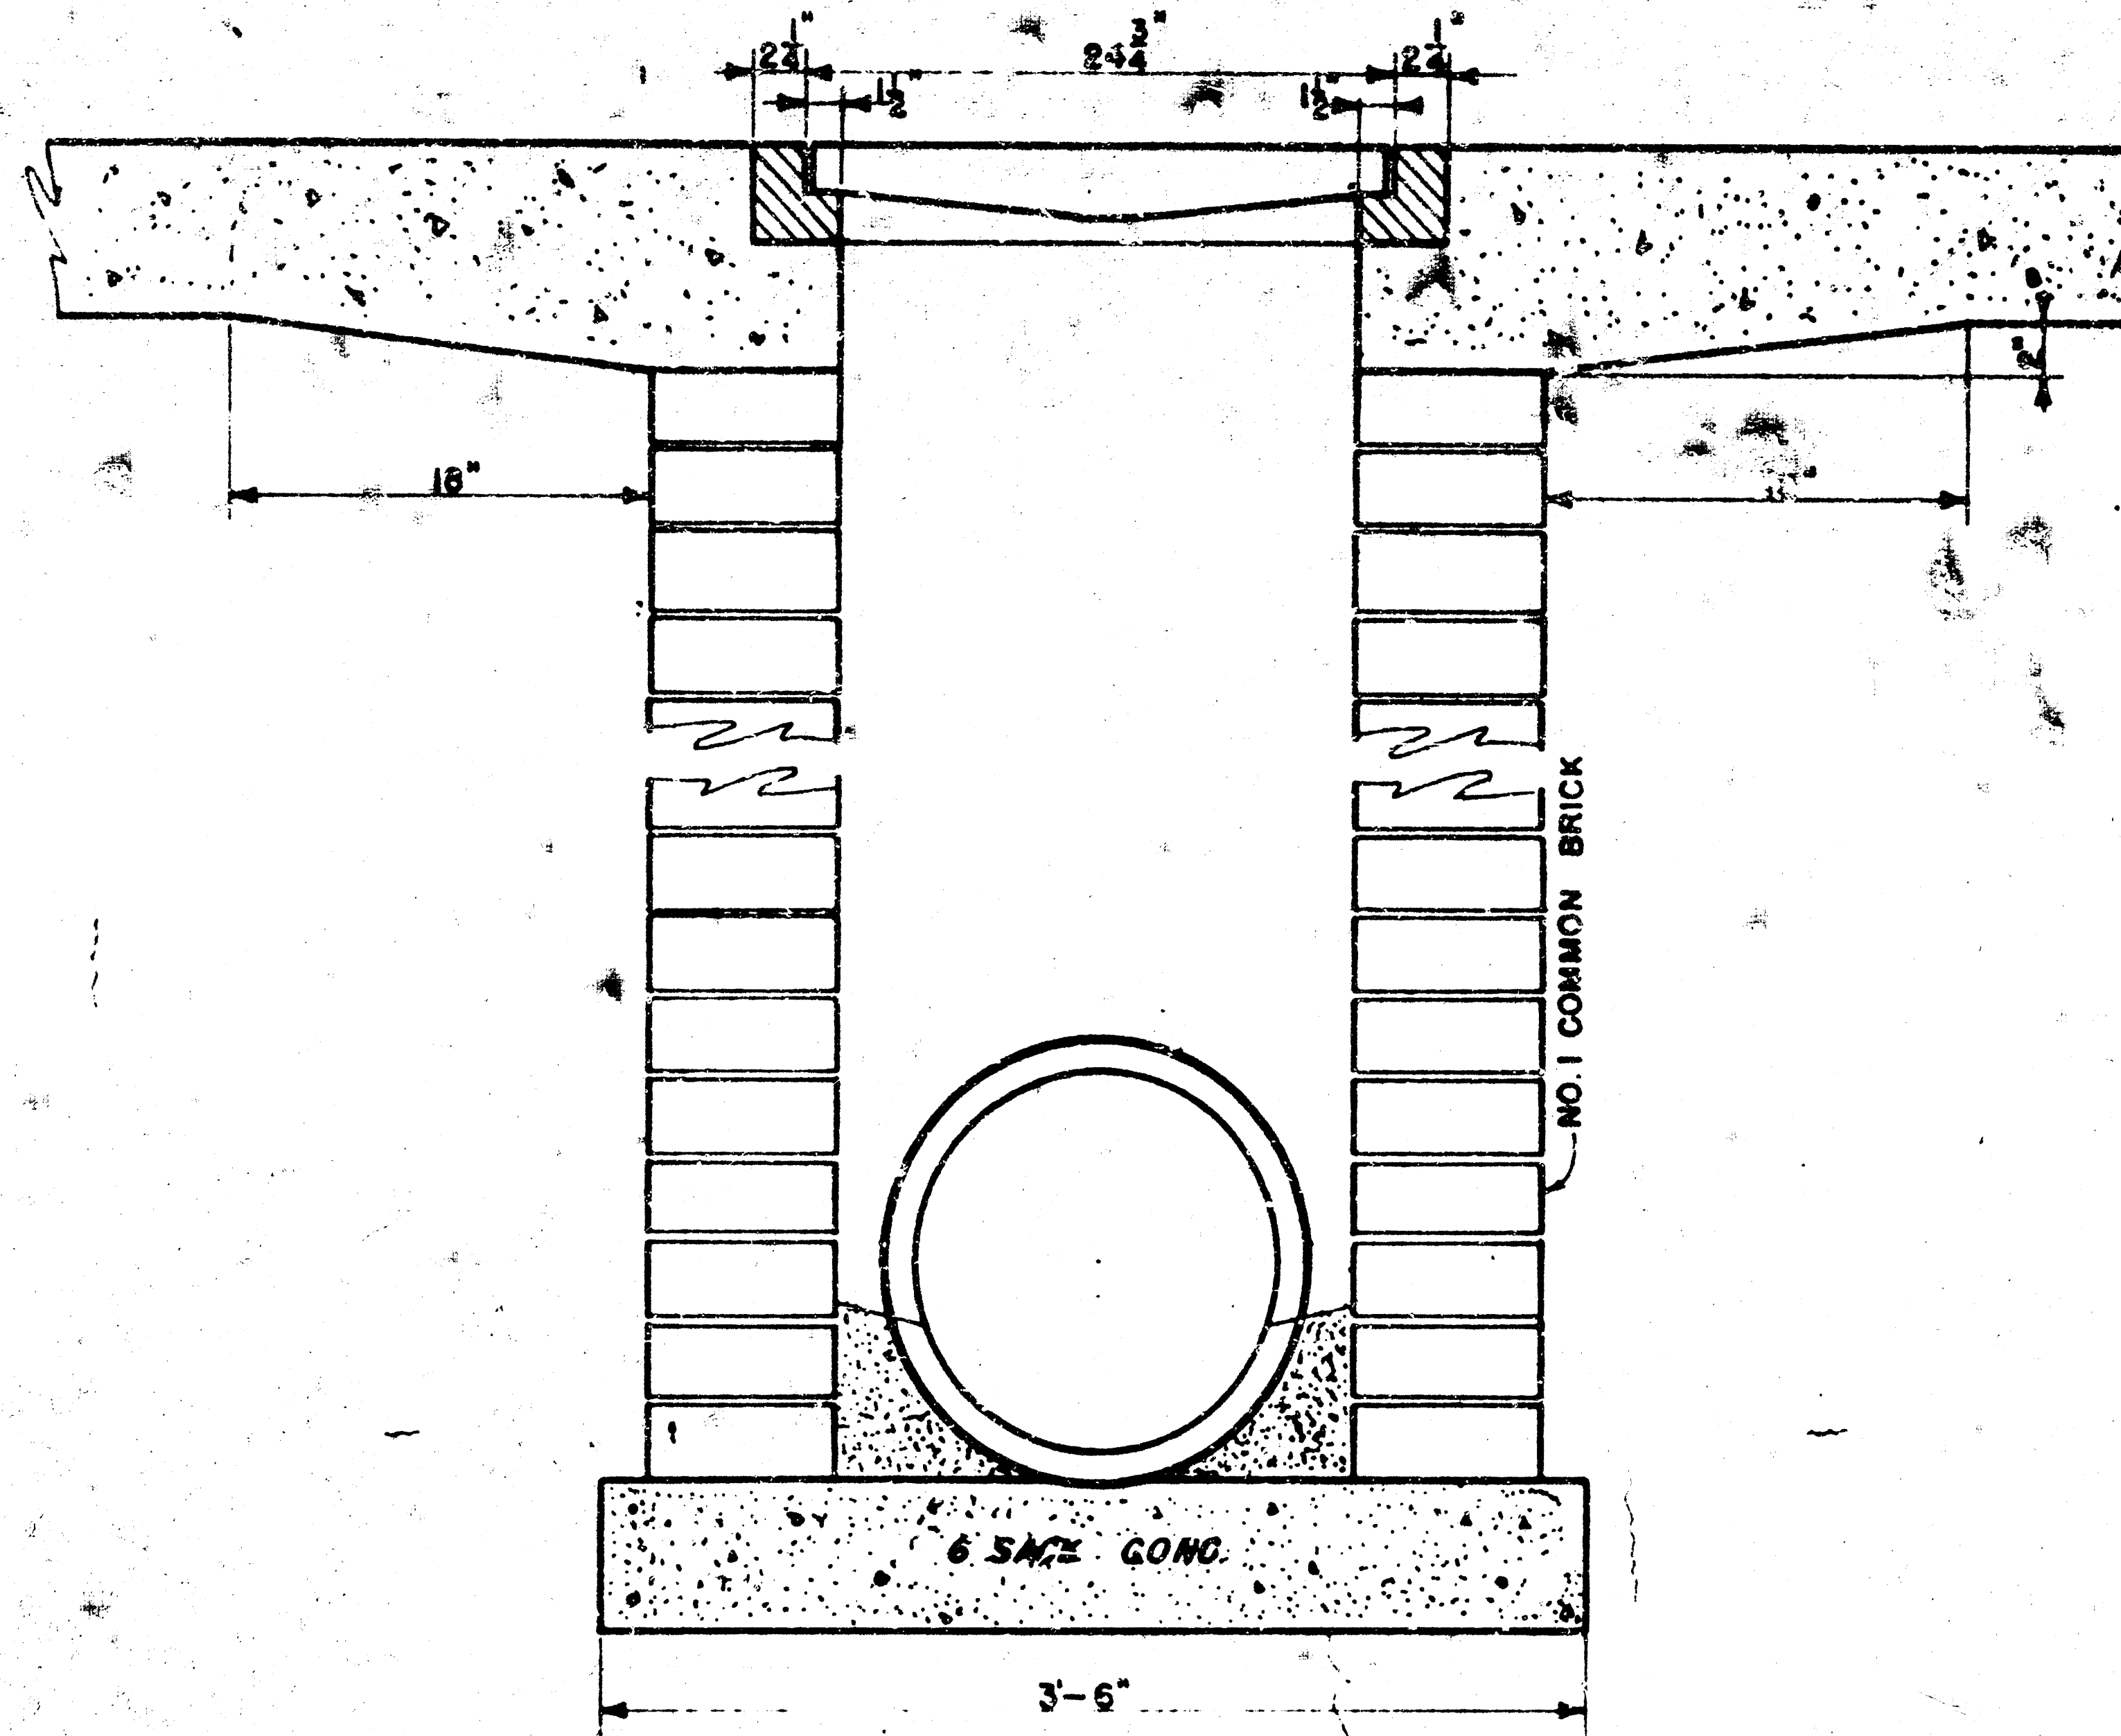

DROP INLET

R.W. Linn City E

City of Wichita,

Project

Project No.

Date:

Scale: 1-1/2" = 1'-0"