

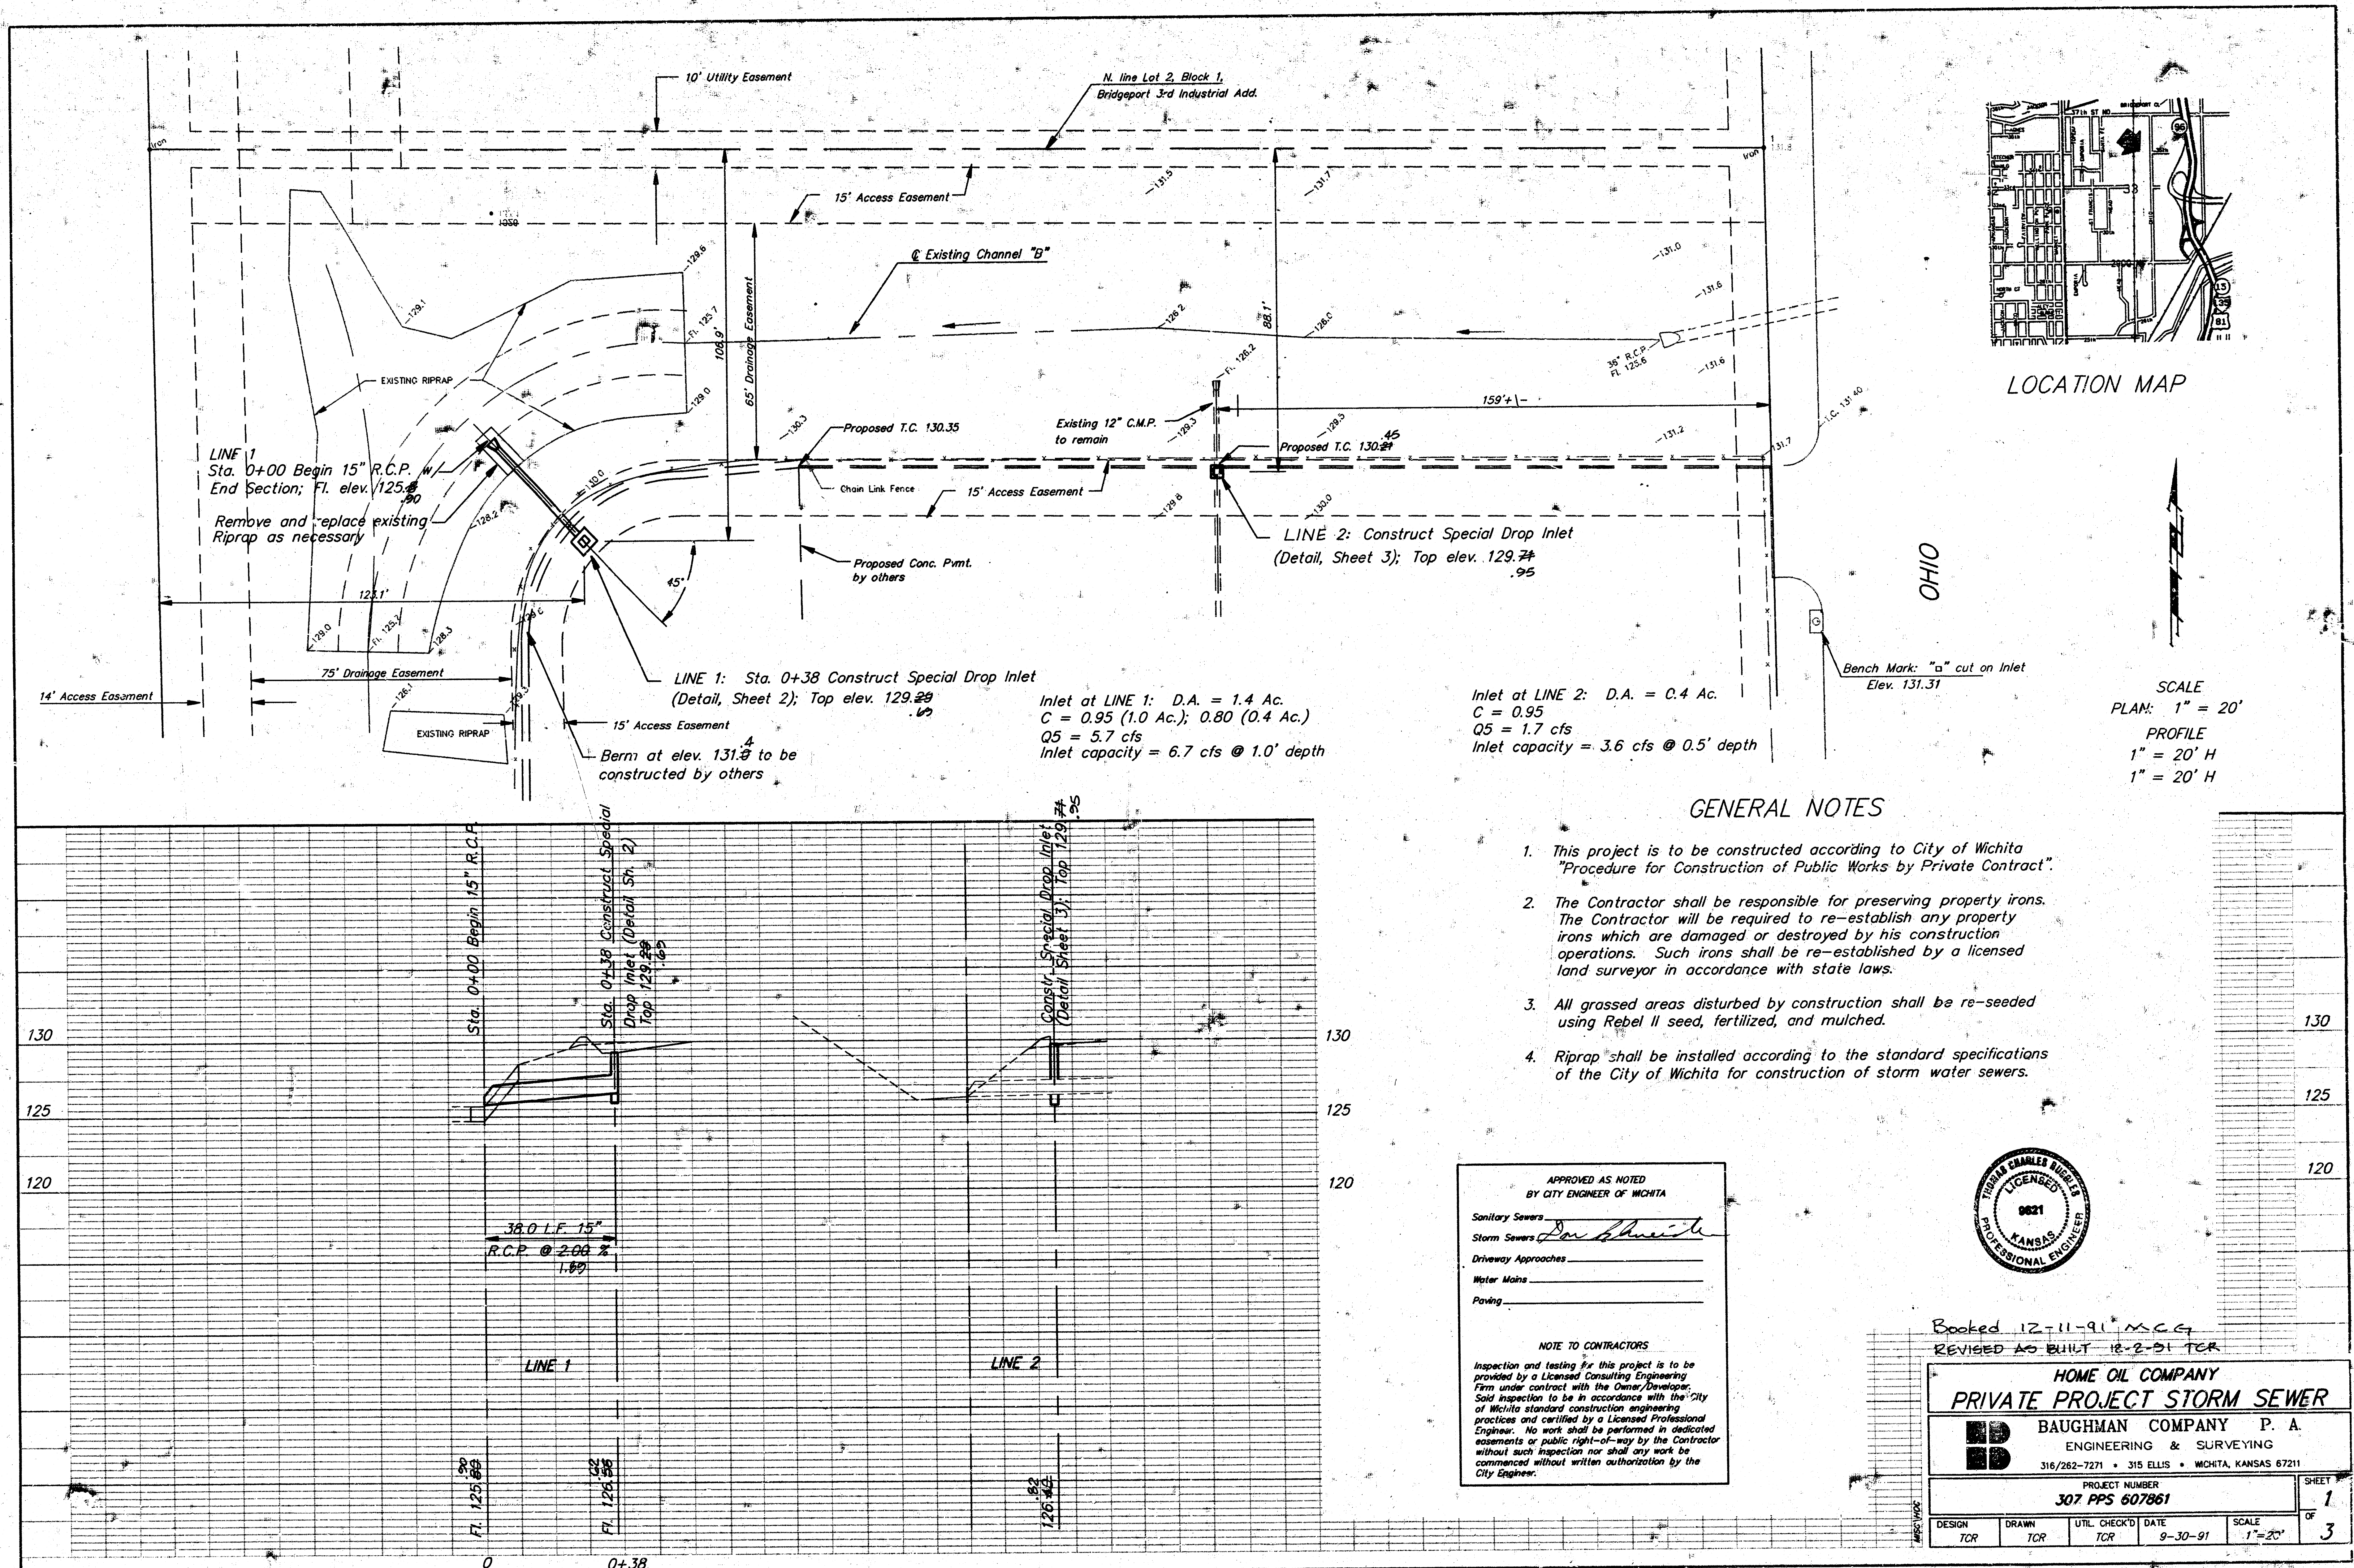
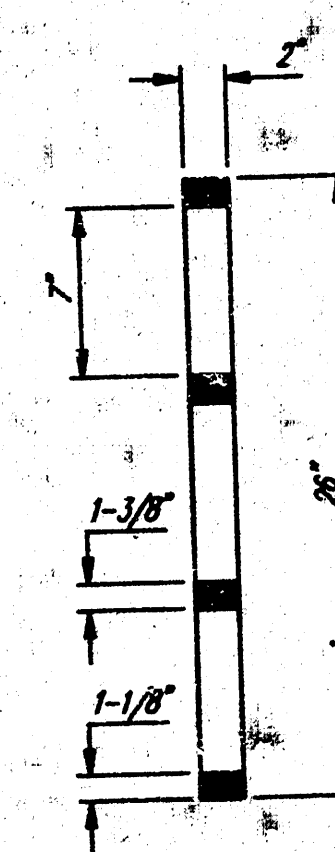
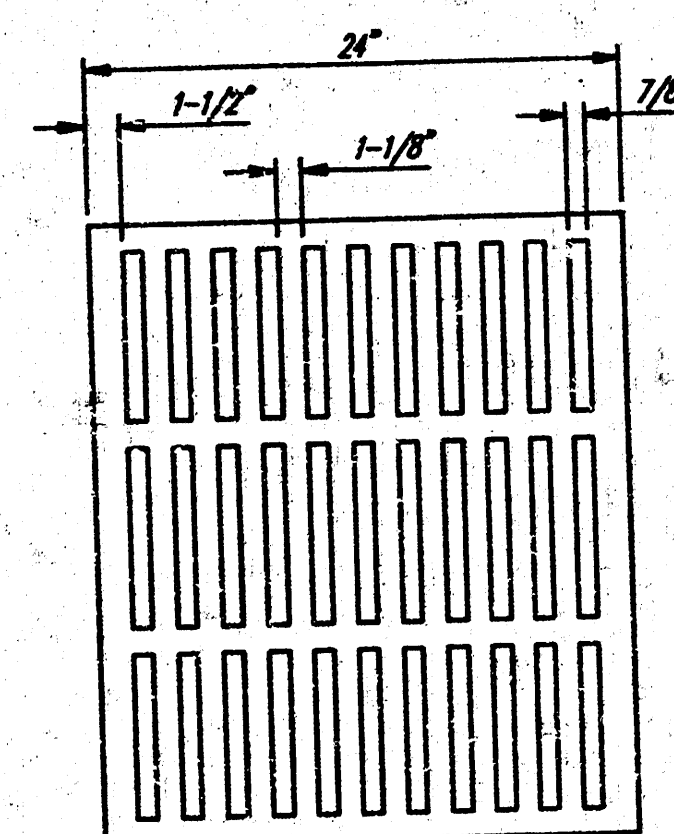
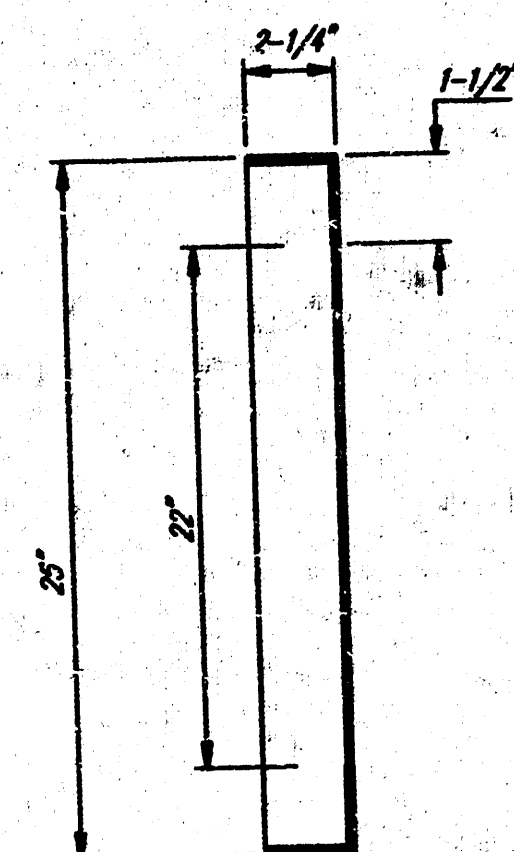
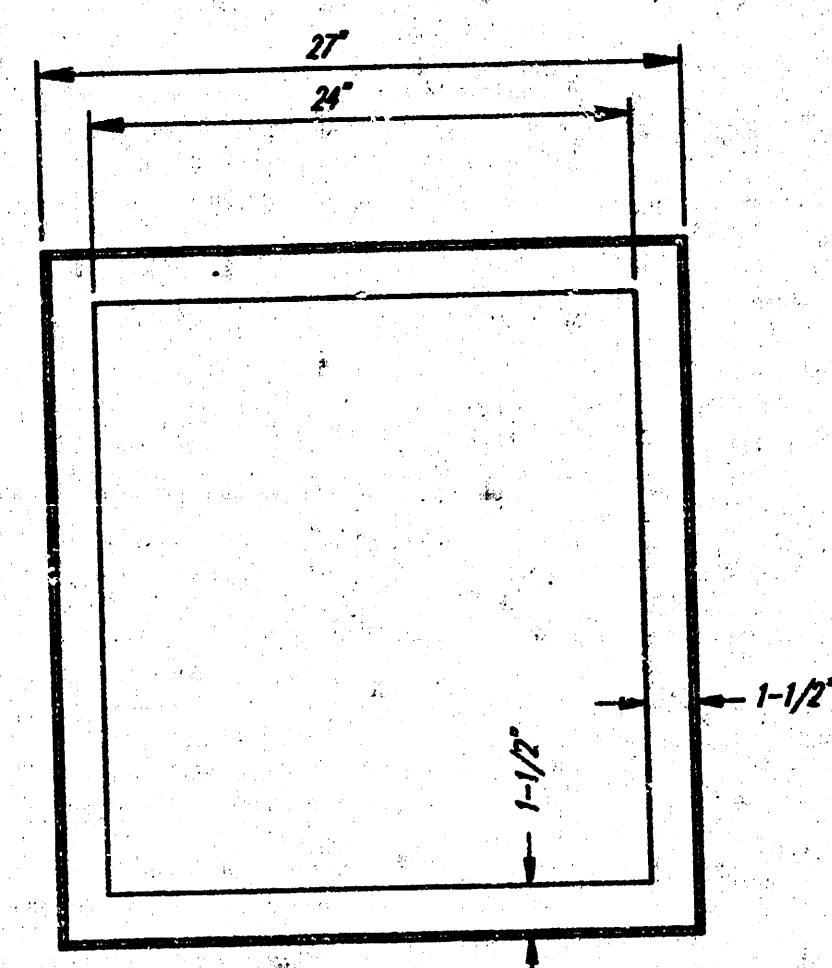


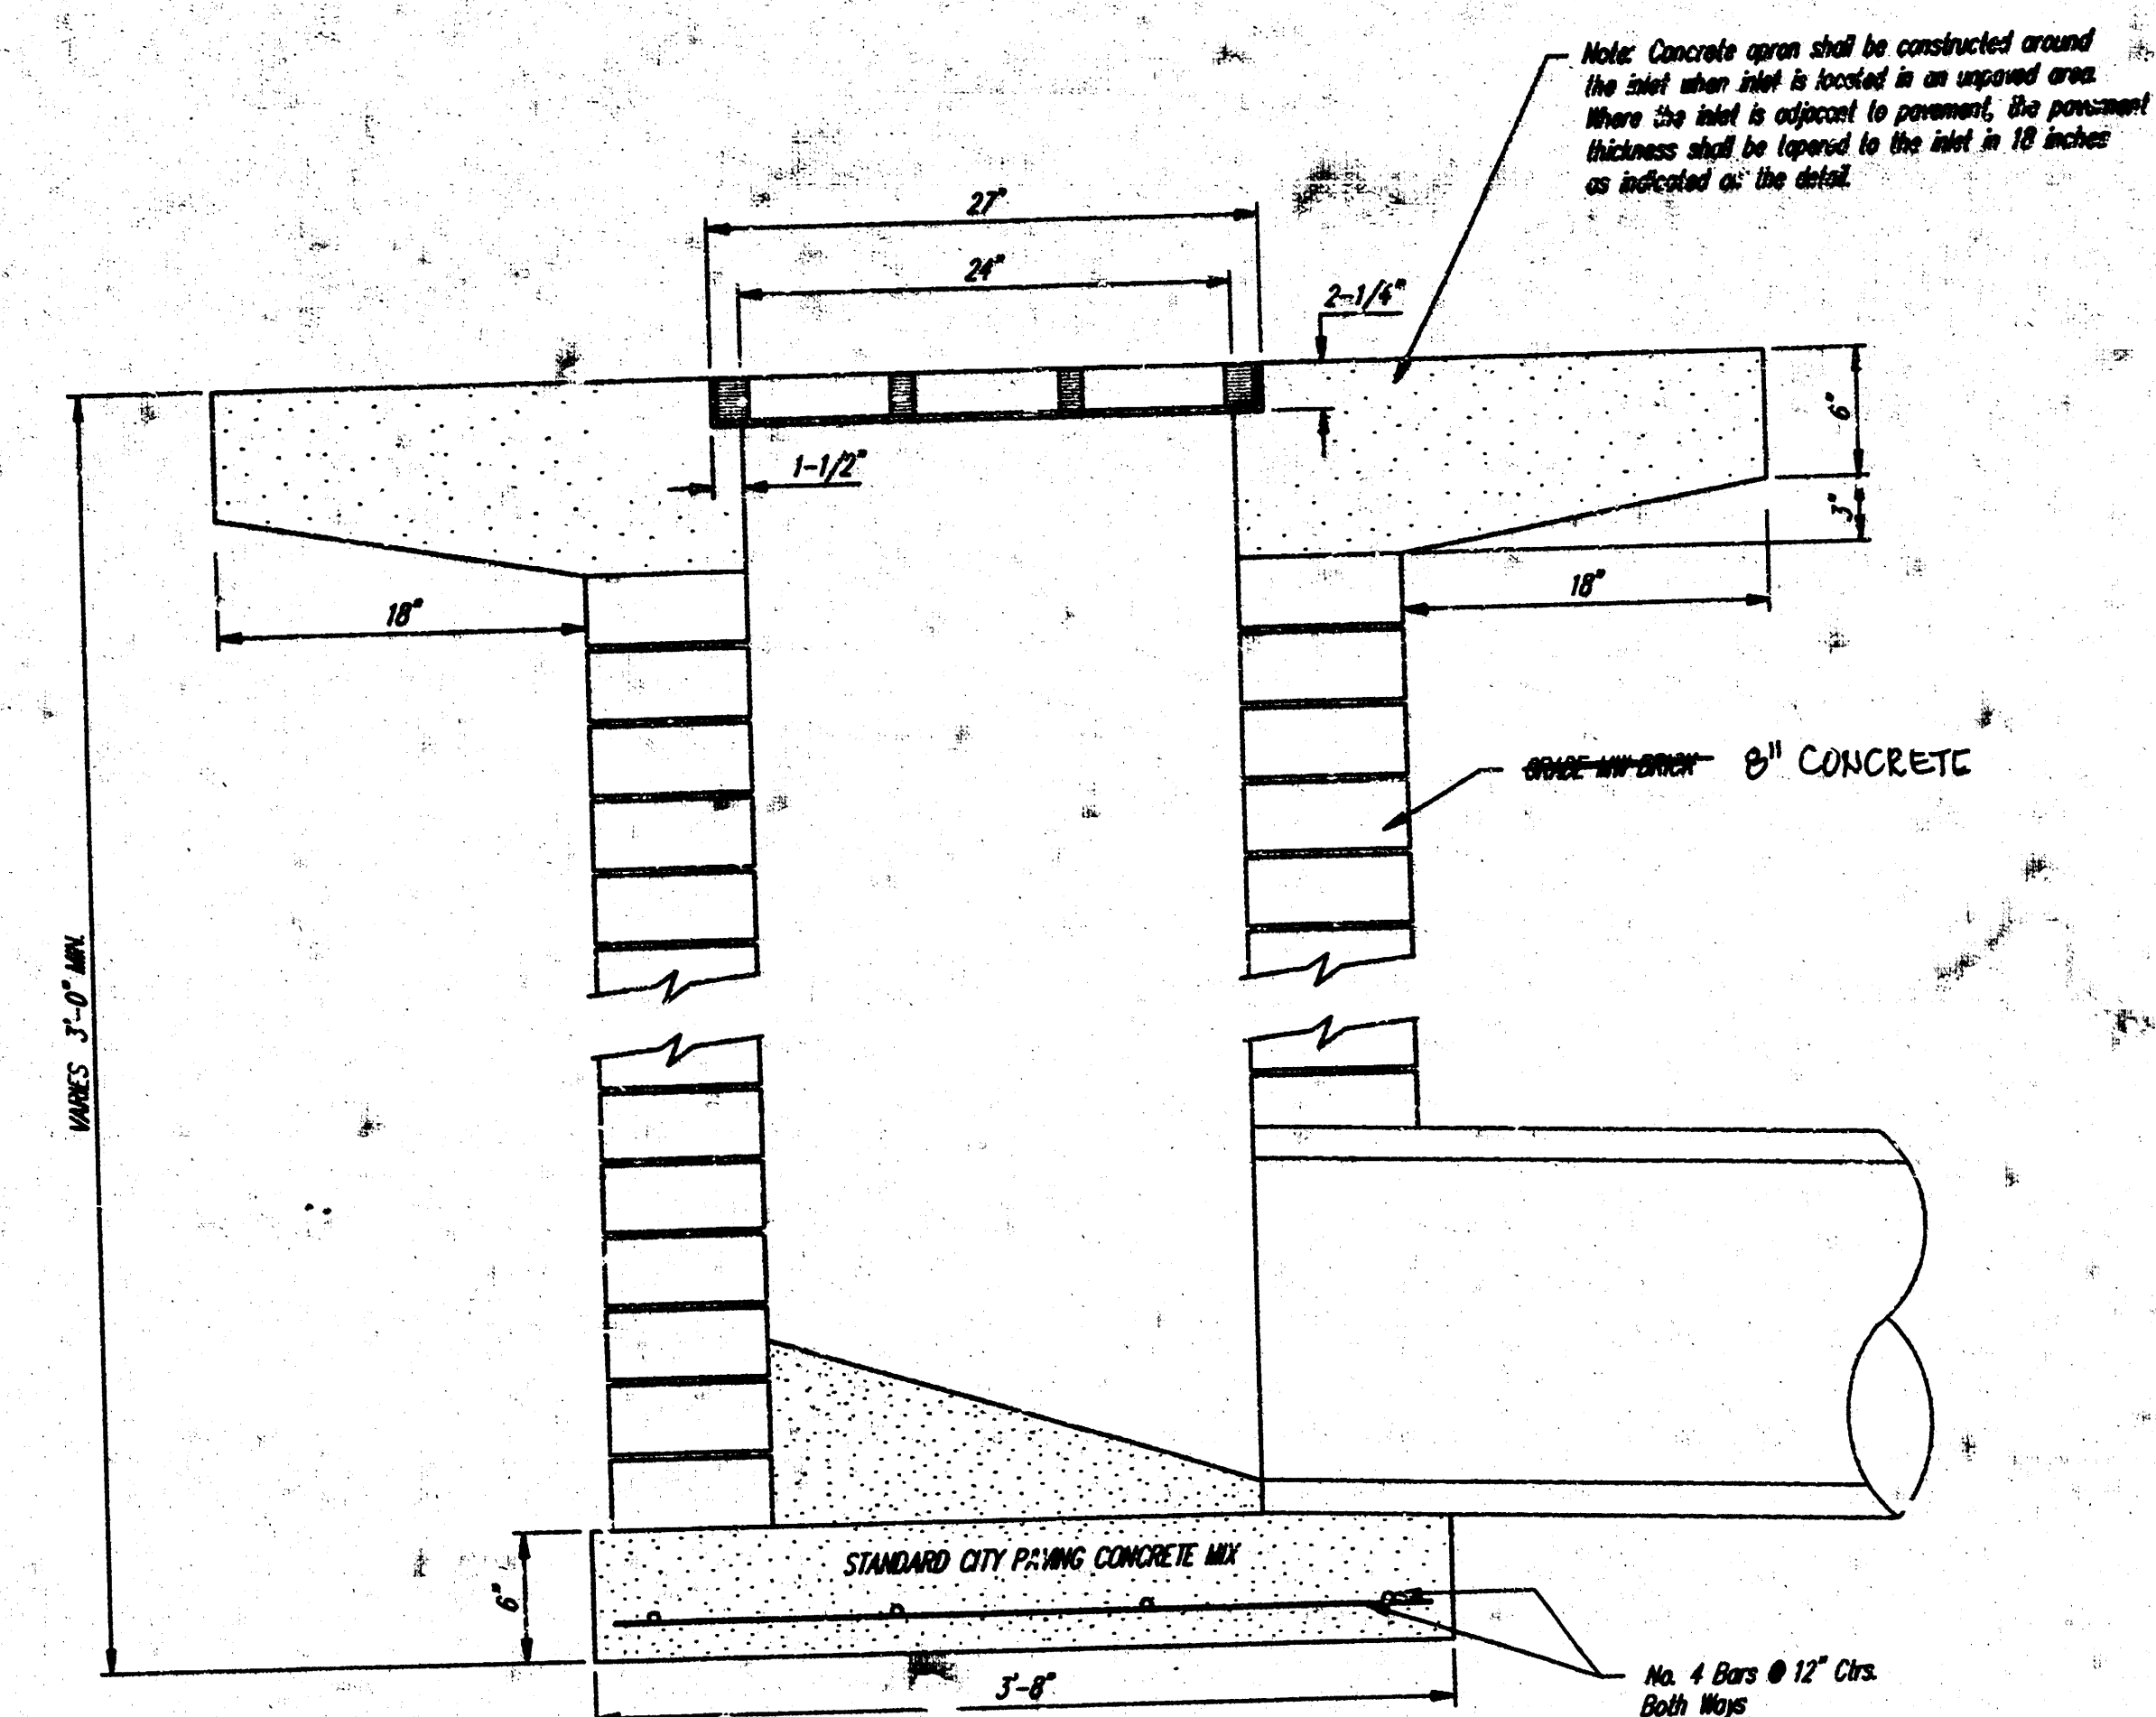






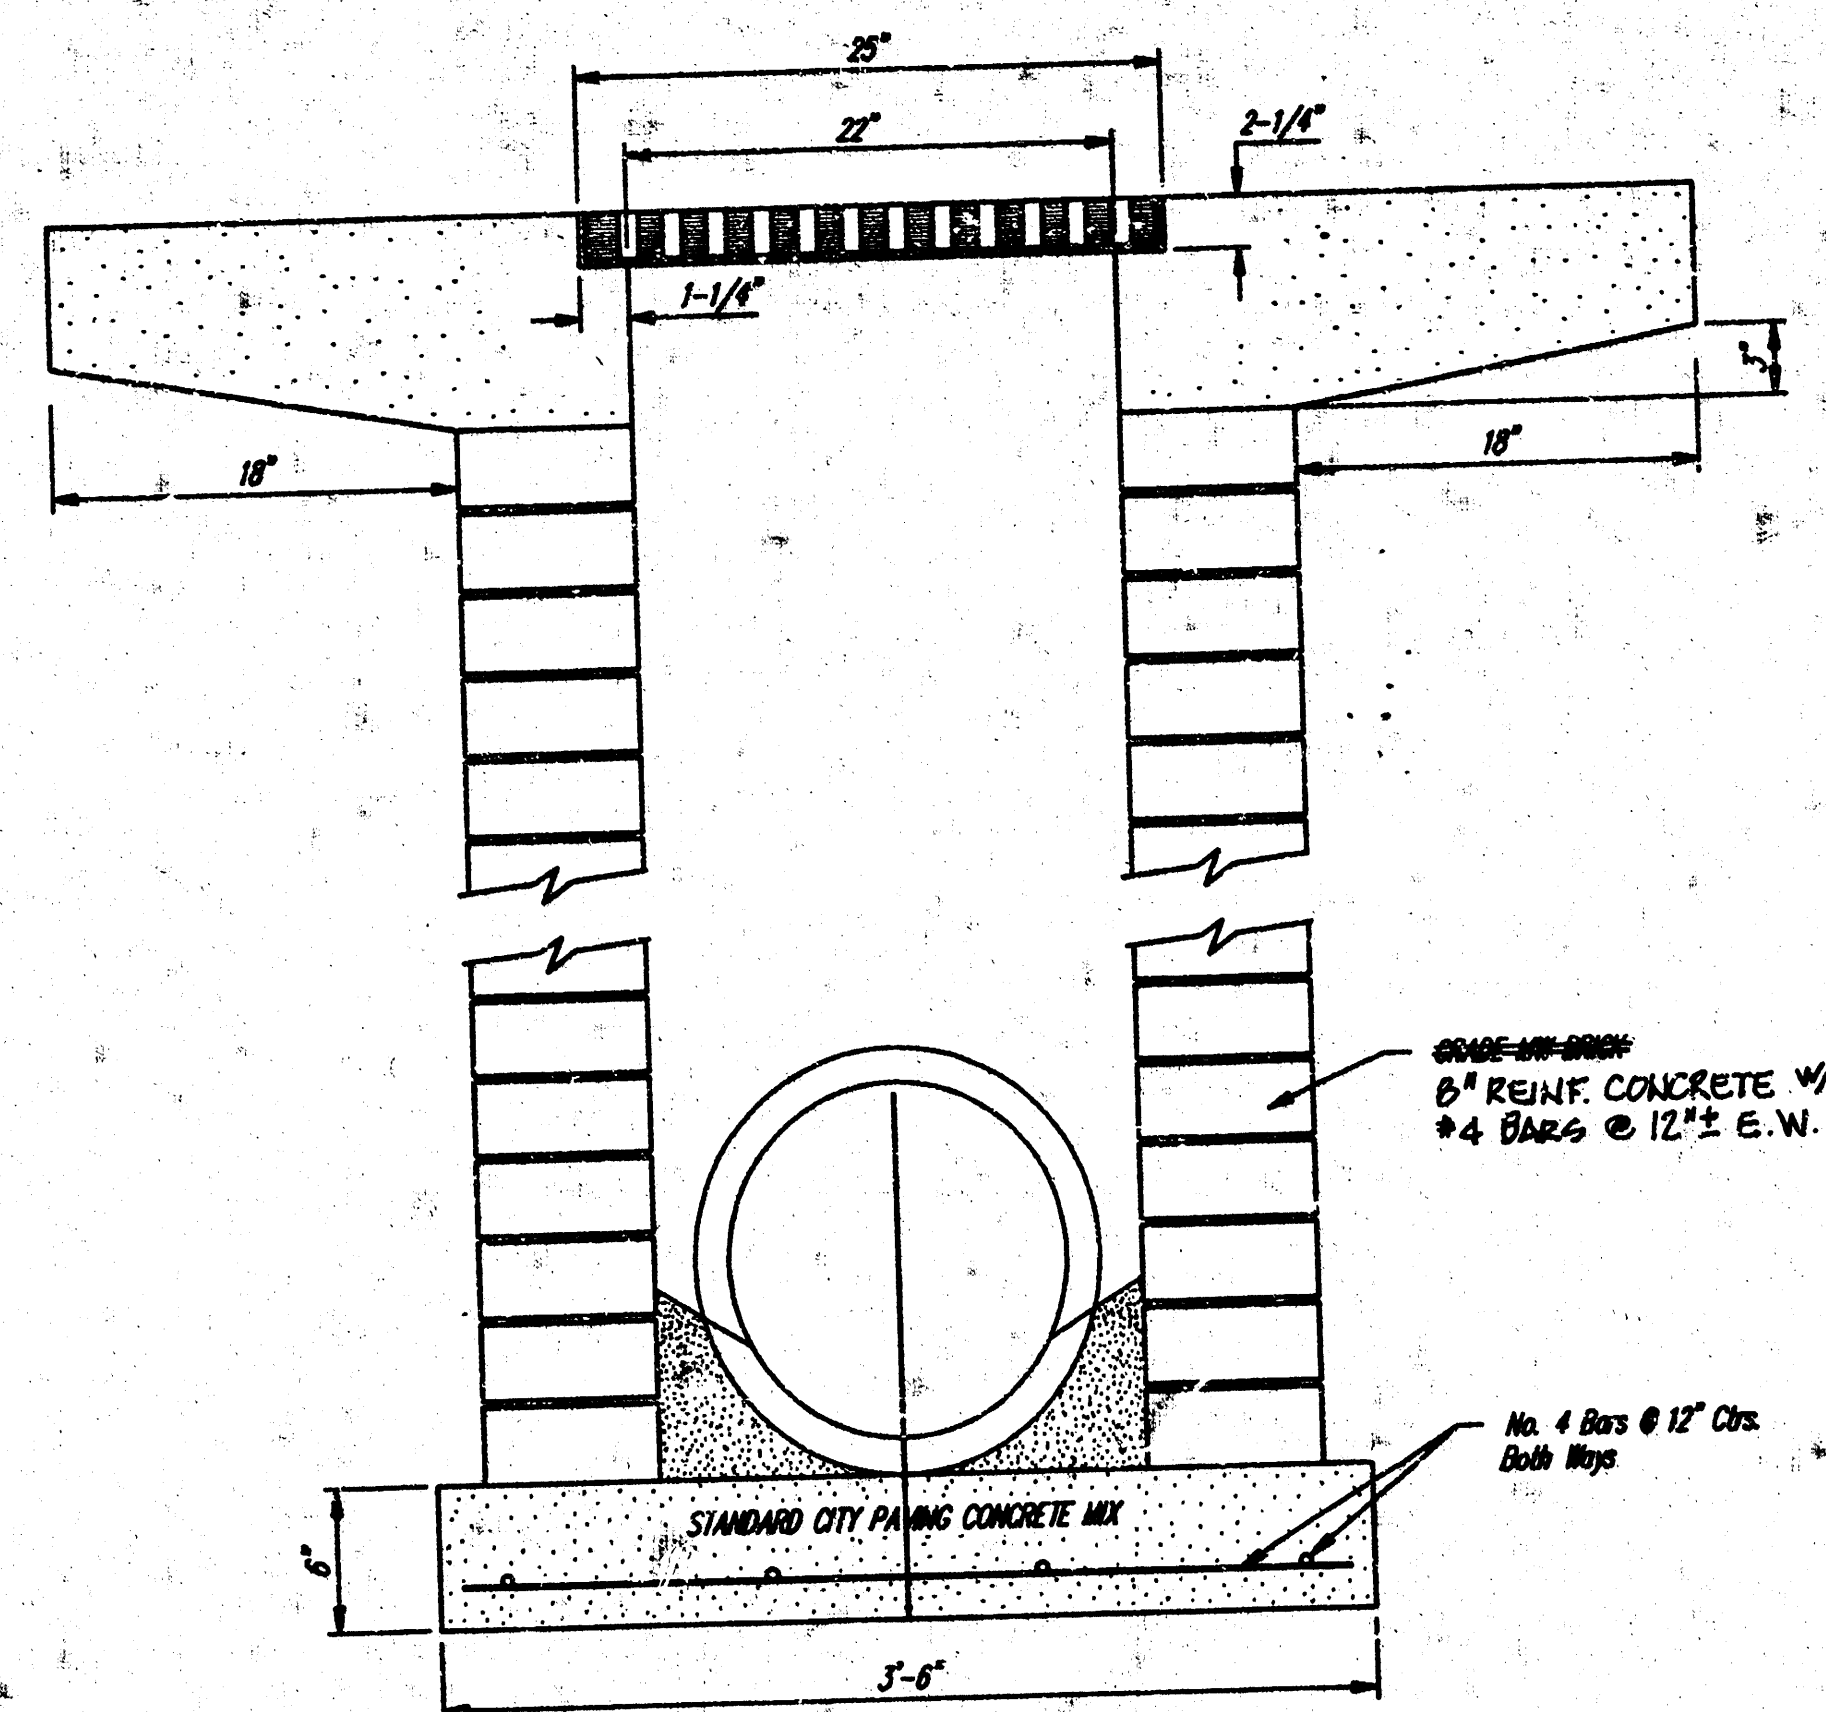


NOTE: Grate shall be Clay & Bailey #2143-H Heavy Duty (Weight 2094) or approved equal. Frame to be full-welded 2-1/4" x 1-1/2" x 1/4" steel angle.

REVISED AS BUILT (REINF. CONC.) 12-2-91 TCR

SPECIAL DROP INLET DETAIL LINE 1

Project Number 2
307 PPS 607861 3

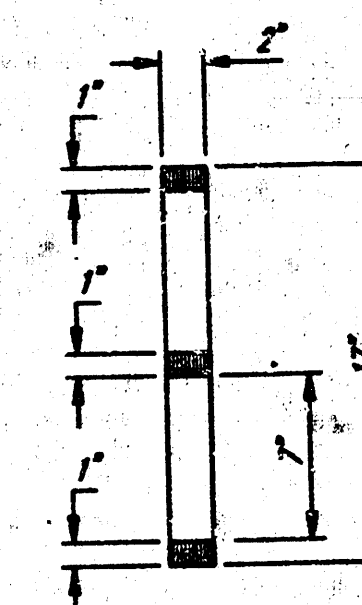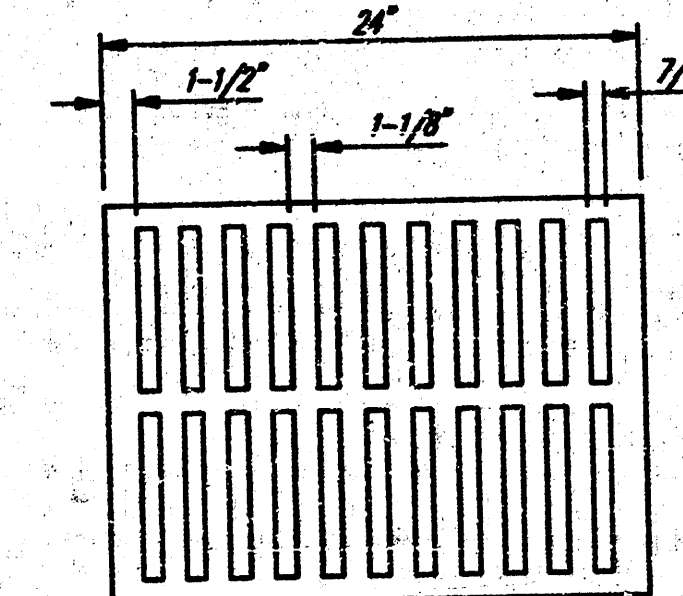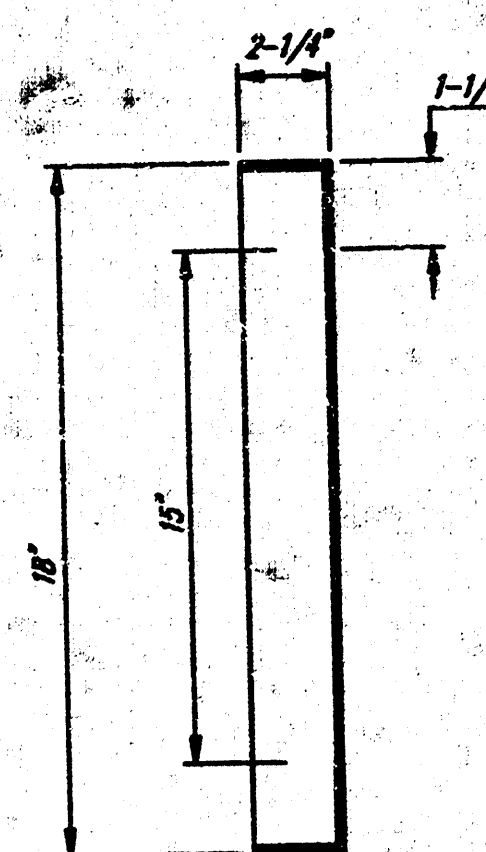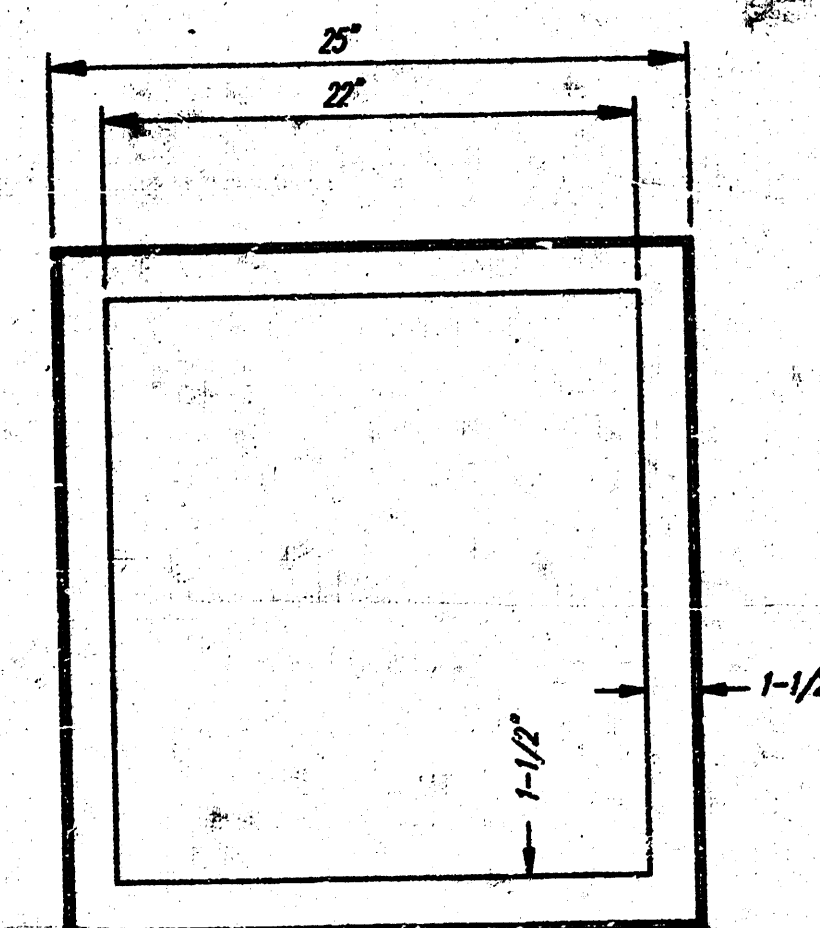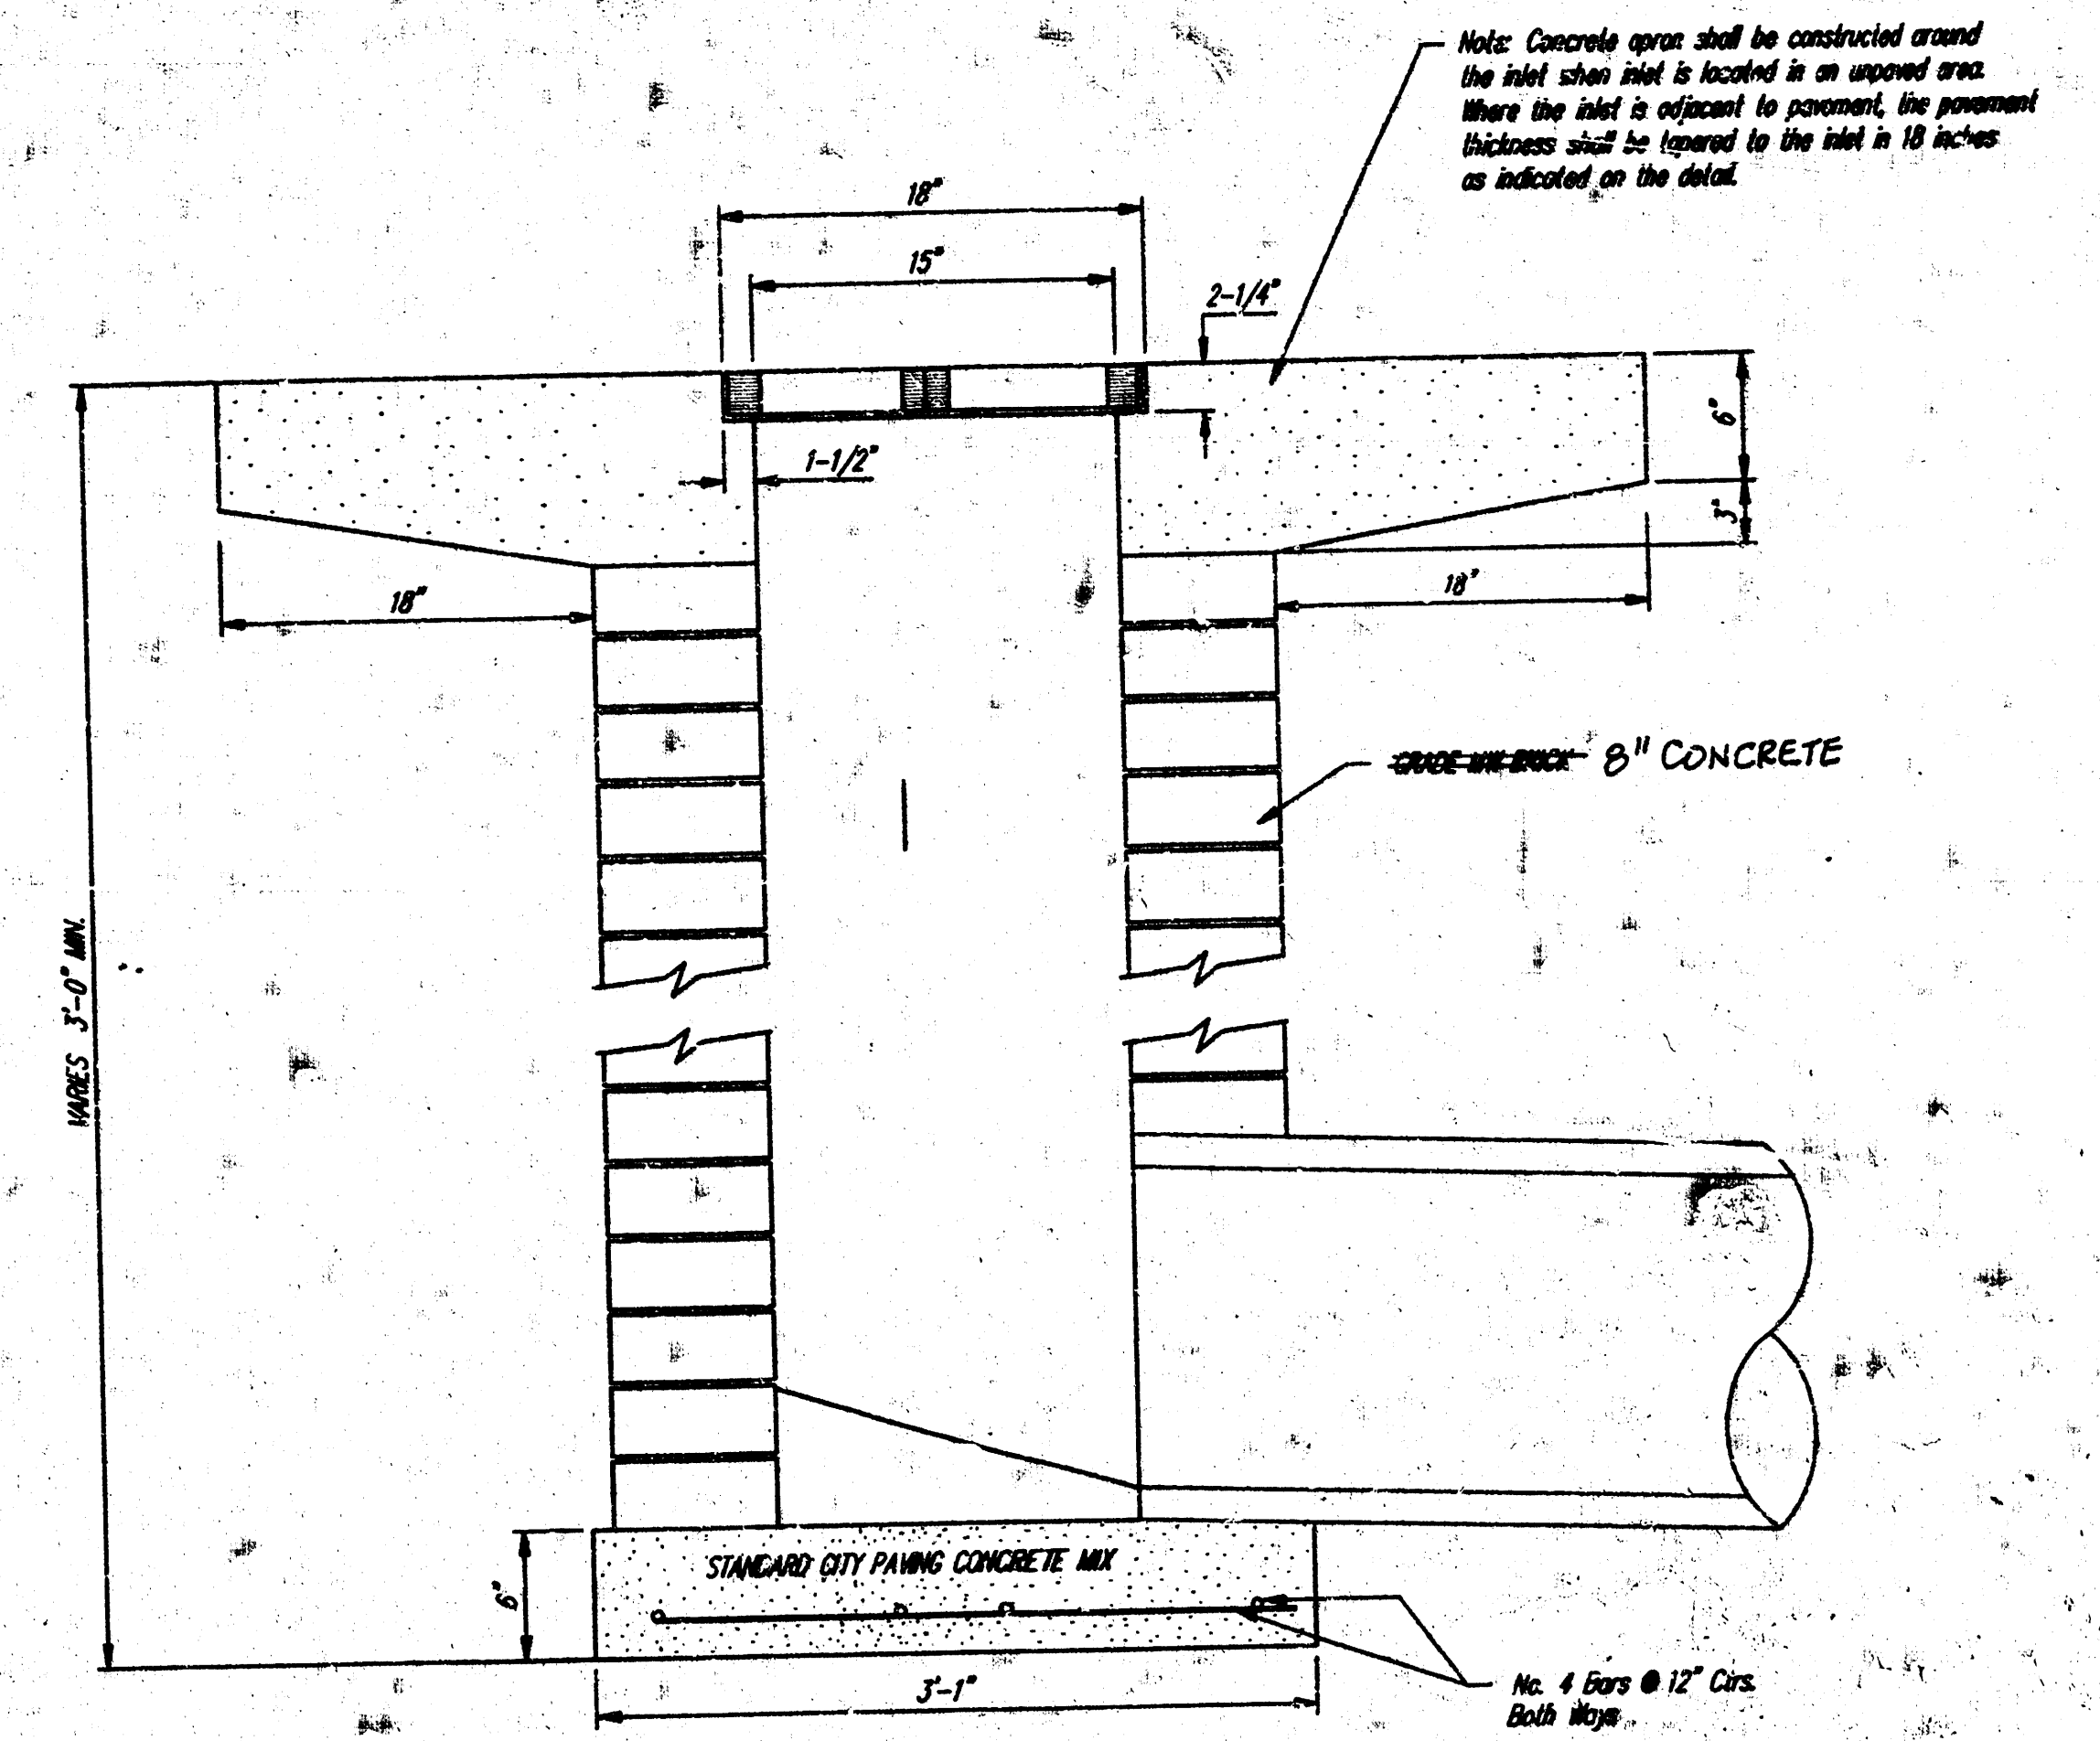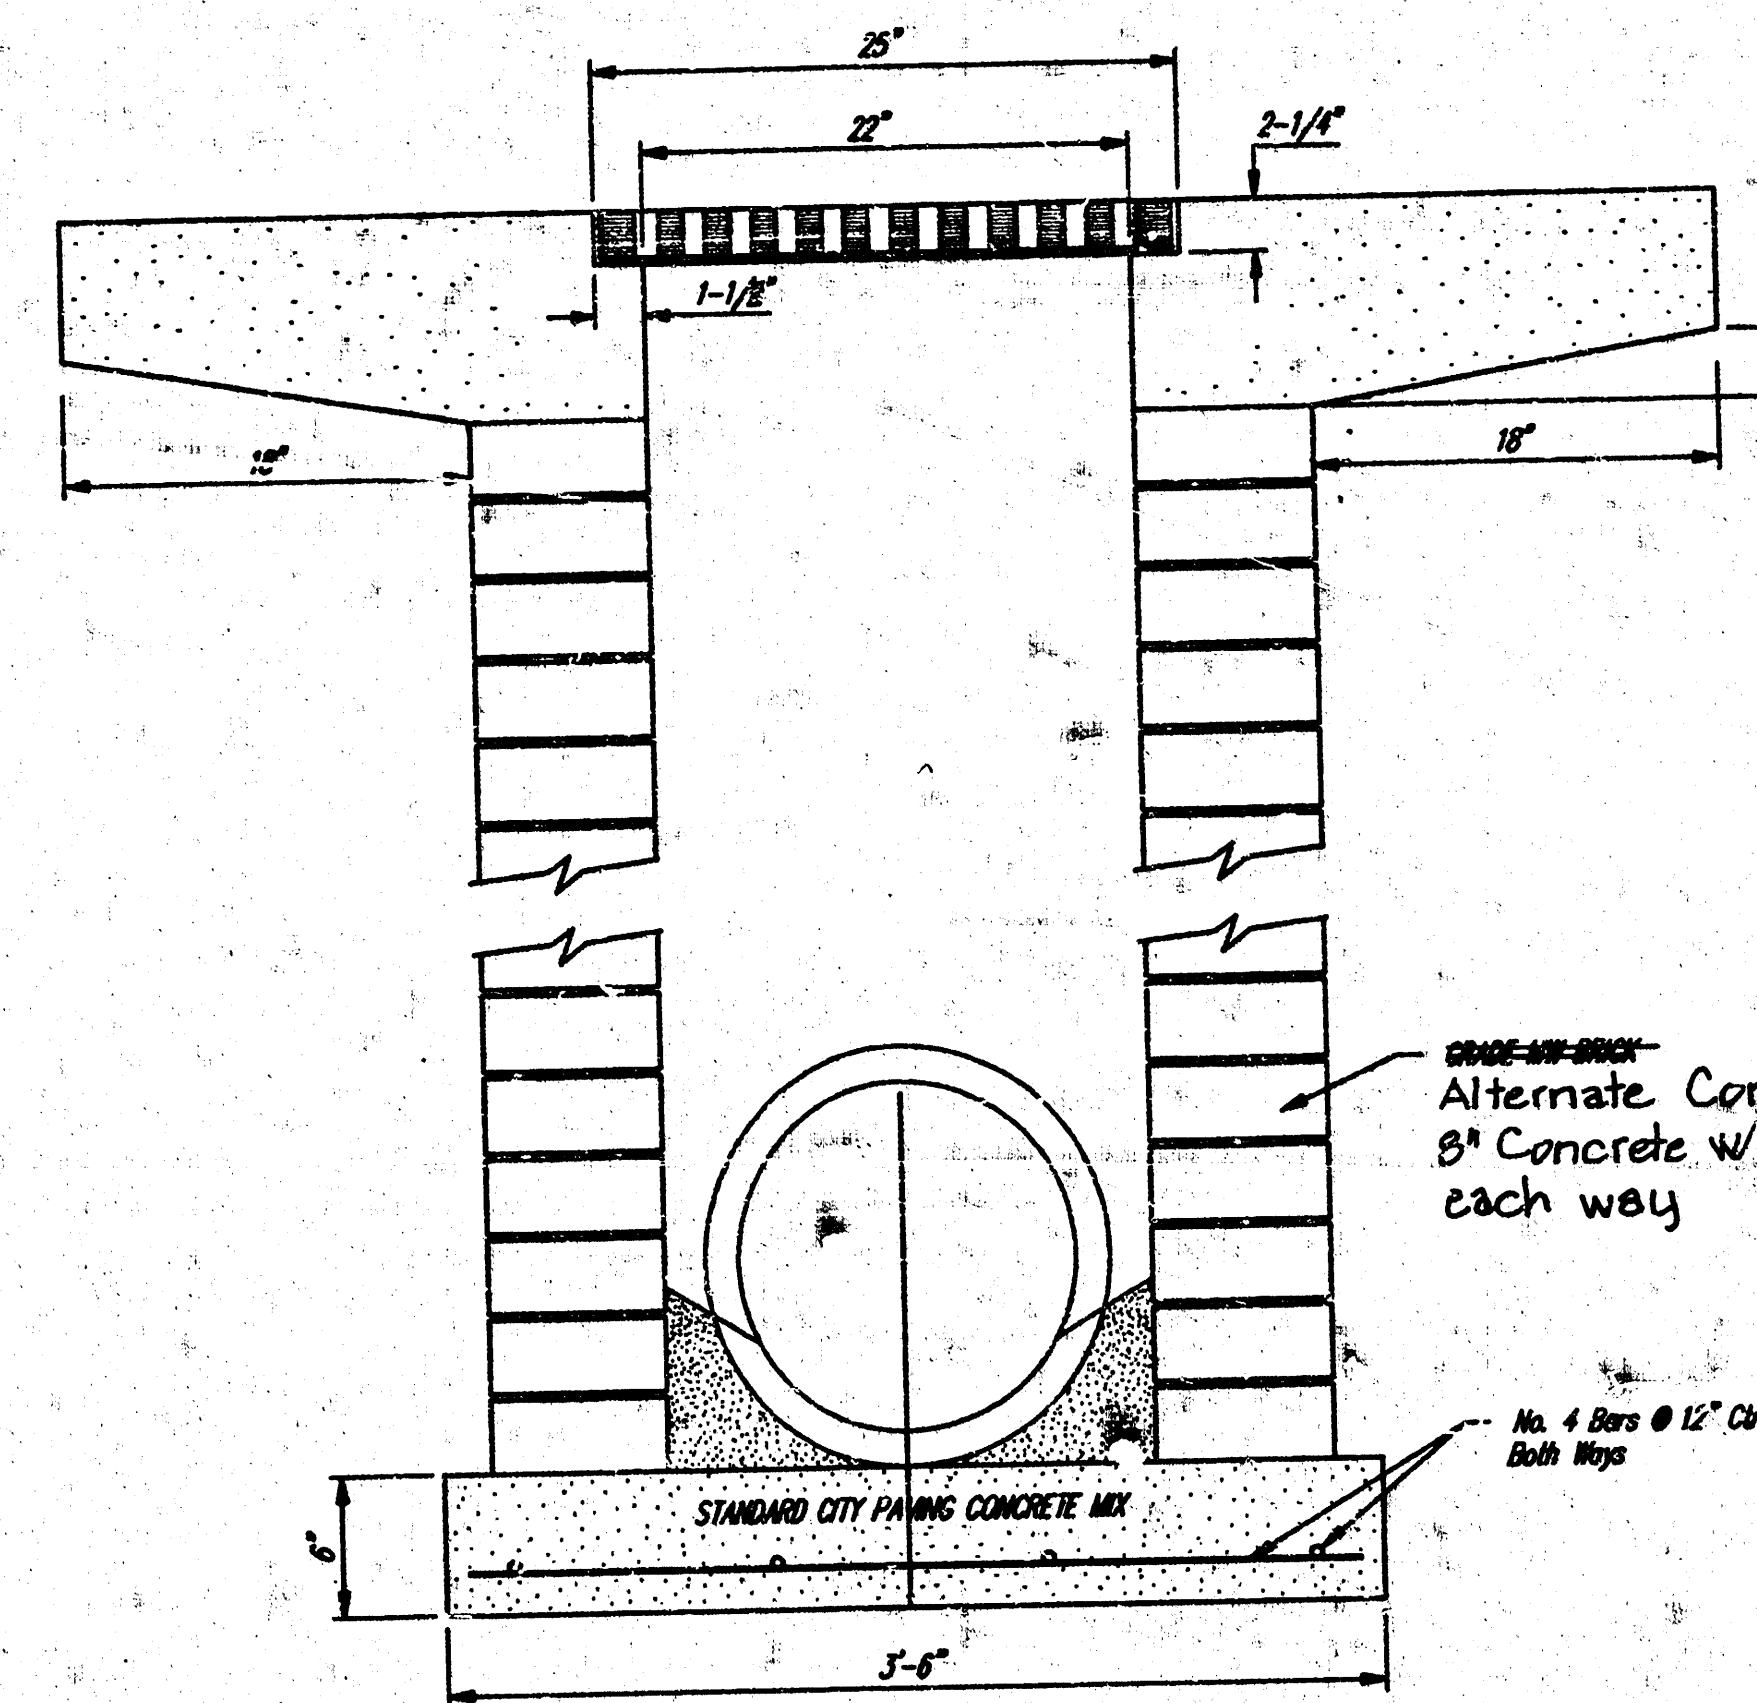

NOTE: Grate shall be Clay & Bailey #143-E Heavy Duty (Weight 2000) or approved equal. Frame to be full-welded 2-1/4" x 1-1/2" x 1/4" steel angle.

REVISED AS BUILT (REINF. CONCRETE) 12-2-91 TCR

SPECIAL DROP INLET DETAIL

LINE 2

Project Number

307 PPS 607861

3

3