

1. Contractor will be required to provide notice to utility companies a minimum of twenty-four (24) hours prior to any excavation, as follows:

687-2470

Kansas One-Call

The Contractor must notify the following in case of an emergency:

262-4270

Cablevision

263-2061

or

263-7511

K.P.L. Gas Service Company

264-1141





Kansas Gas & Electric Company


942-8350

Arkla Gas Company

1-571-2611


Southwestern Bell Telephone Company
2. Contractor shall not start work on the project until the project inspector is assigned to the project and is present on the site. Any work done without inspection will be required to be uncovered for inspection.
3. Exist, utilities and their locations, as shown on the plans, represent the best information obtainable for design. Location information has been obtained from the various utility companies and is either from company record drawings or company-provided field locations. The Contractor will be required to work around existing utilities which do not conflict with proposed construction.
4. Traffic affected by the construction on this project shall be handled in accordance with the latest edition of the Manual on Uniform Traffic Control Devices.
5. The Contractor to verify utility locations prior to construction of this project.
6. All disturbed areas shall be seeded with Rebel II fescue at the rate of 340 lbs. per acre. Fertilizer (13-13-13) shall be applied at the rate of 100 lbs. per acre.
7. Storm sewer shown herein is to be privately maintained. The contractor shall obtain approval for Line 2 and Line 1 Sta. 0+43.8 to 2+35.2 from the Office of Central Inspection.
8. Storm sewer may be constructed with either RCP, CMP, or PVC pipe at the election of the Contractor.

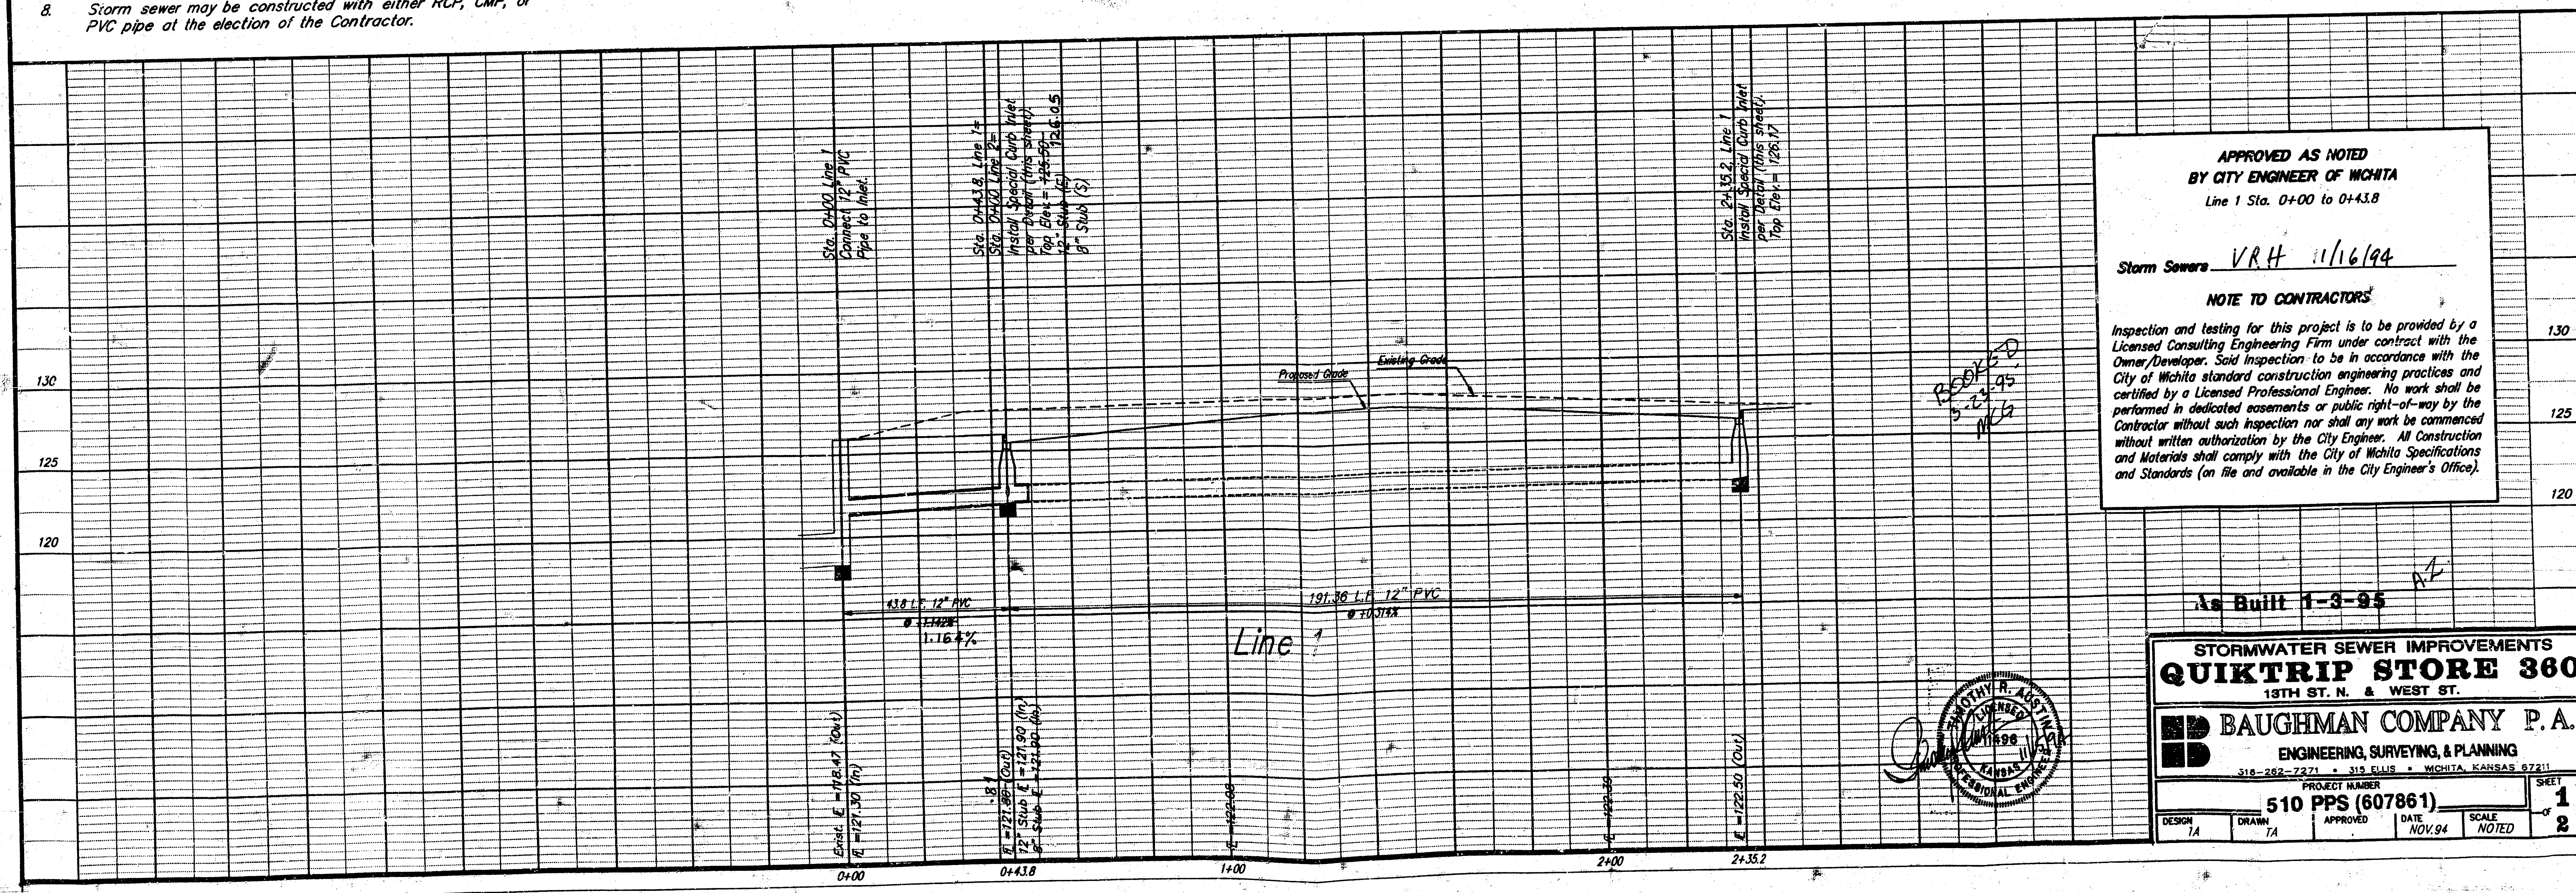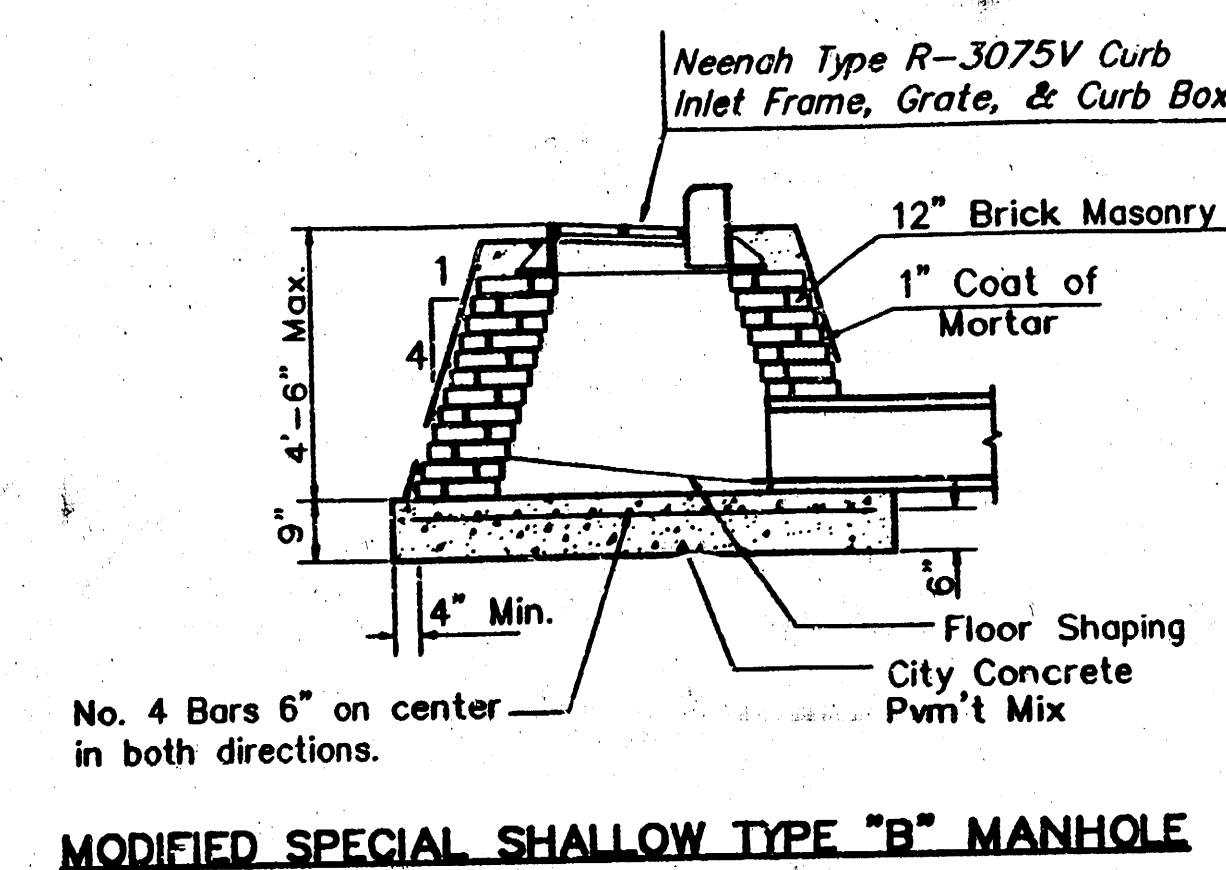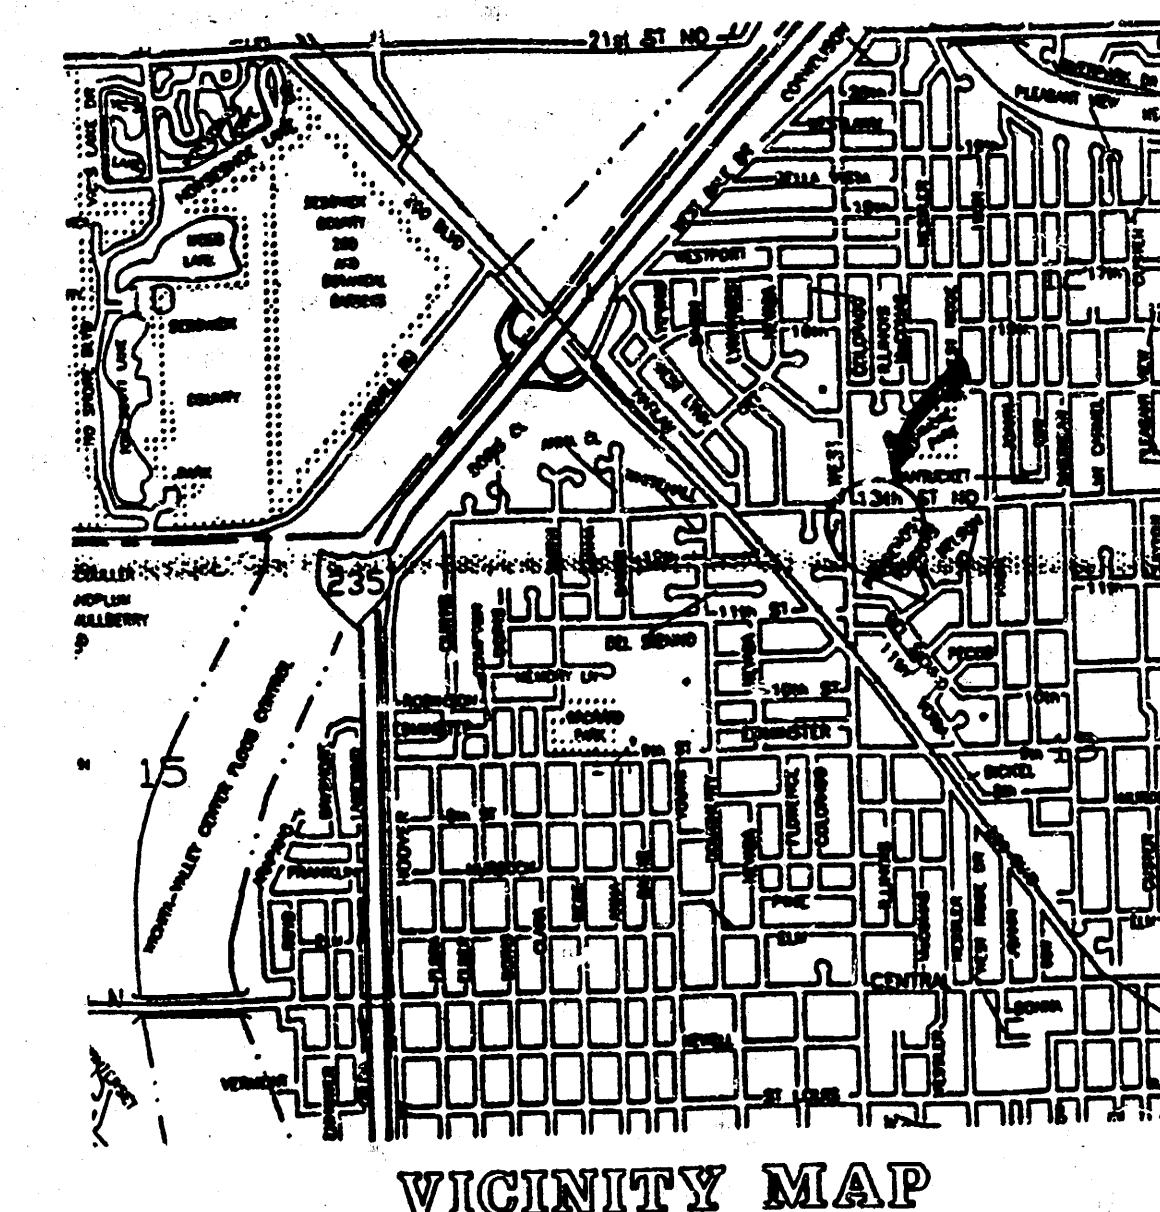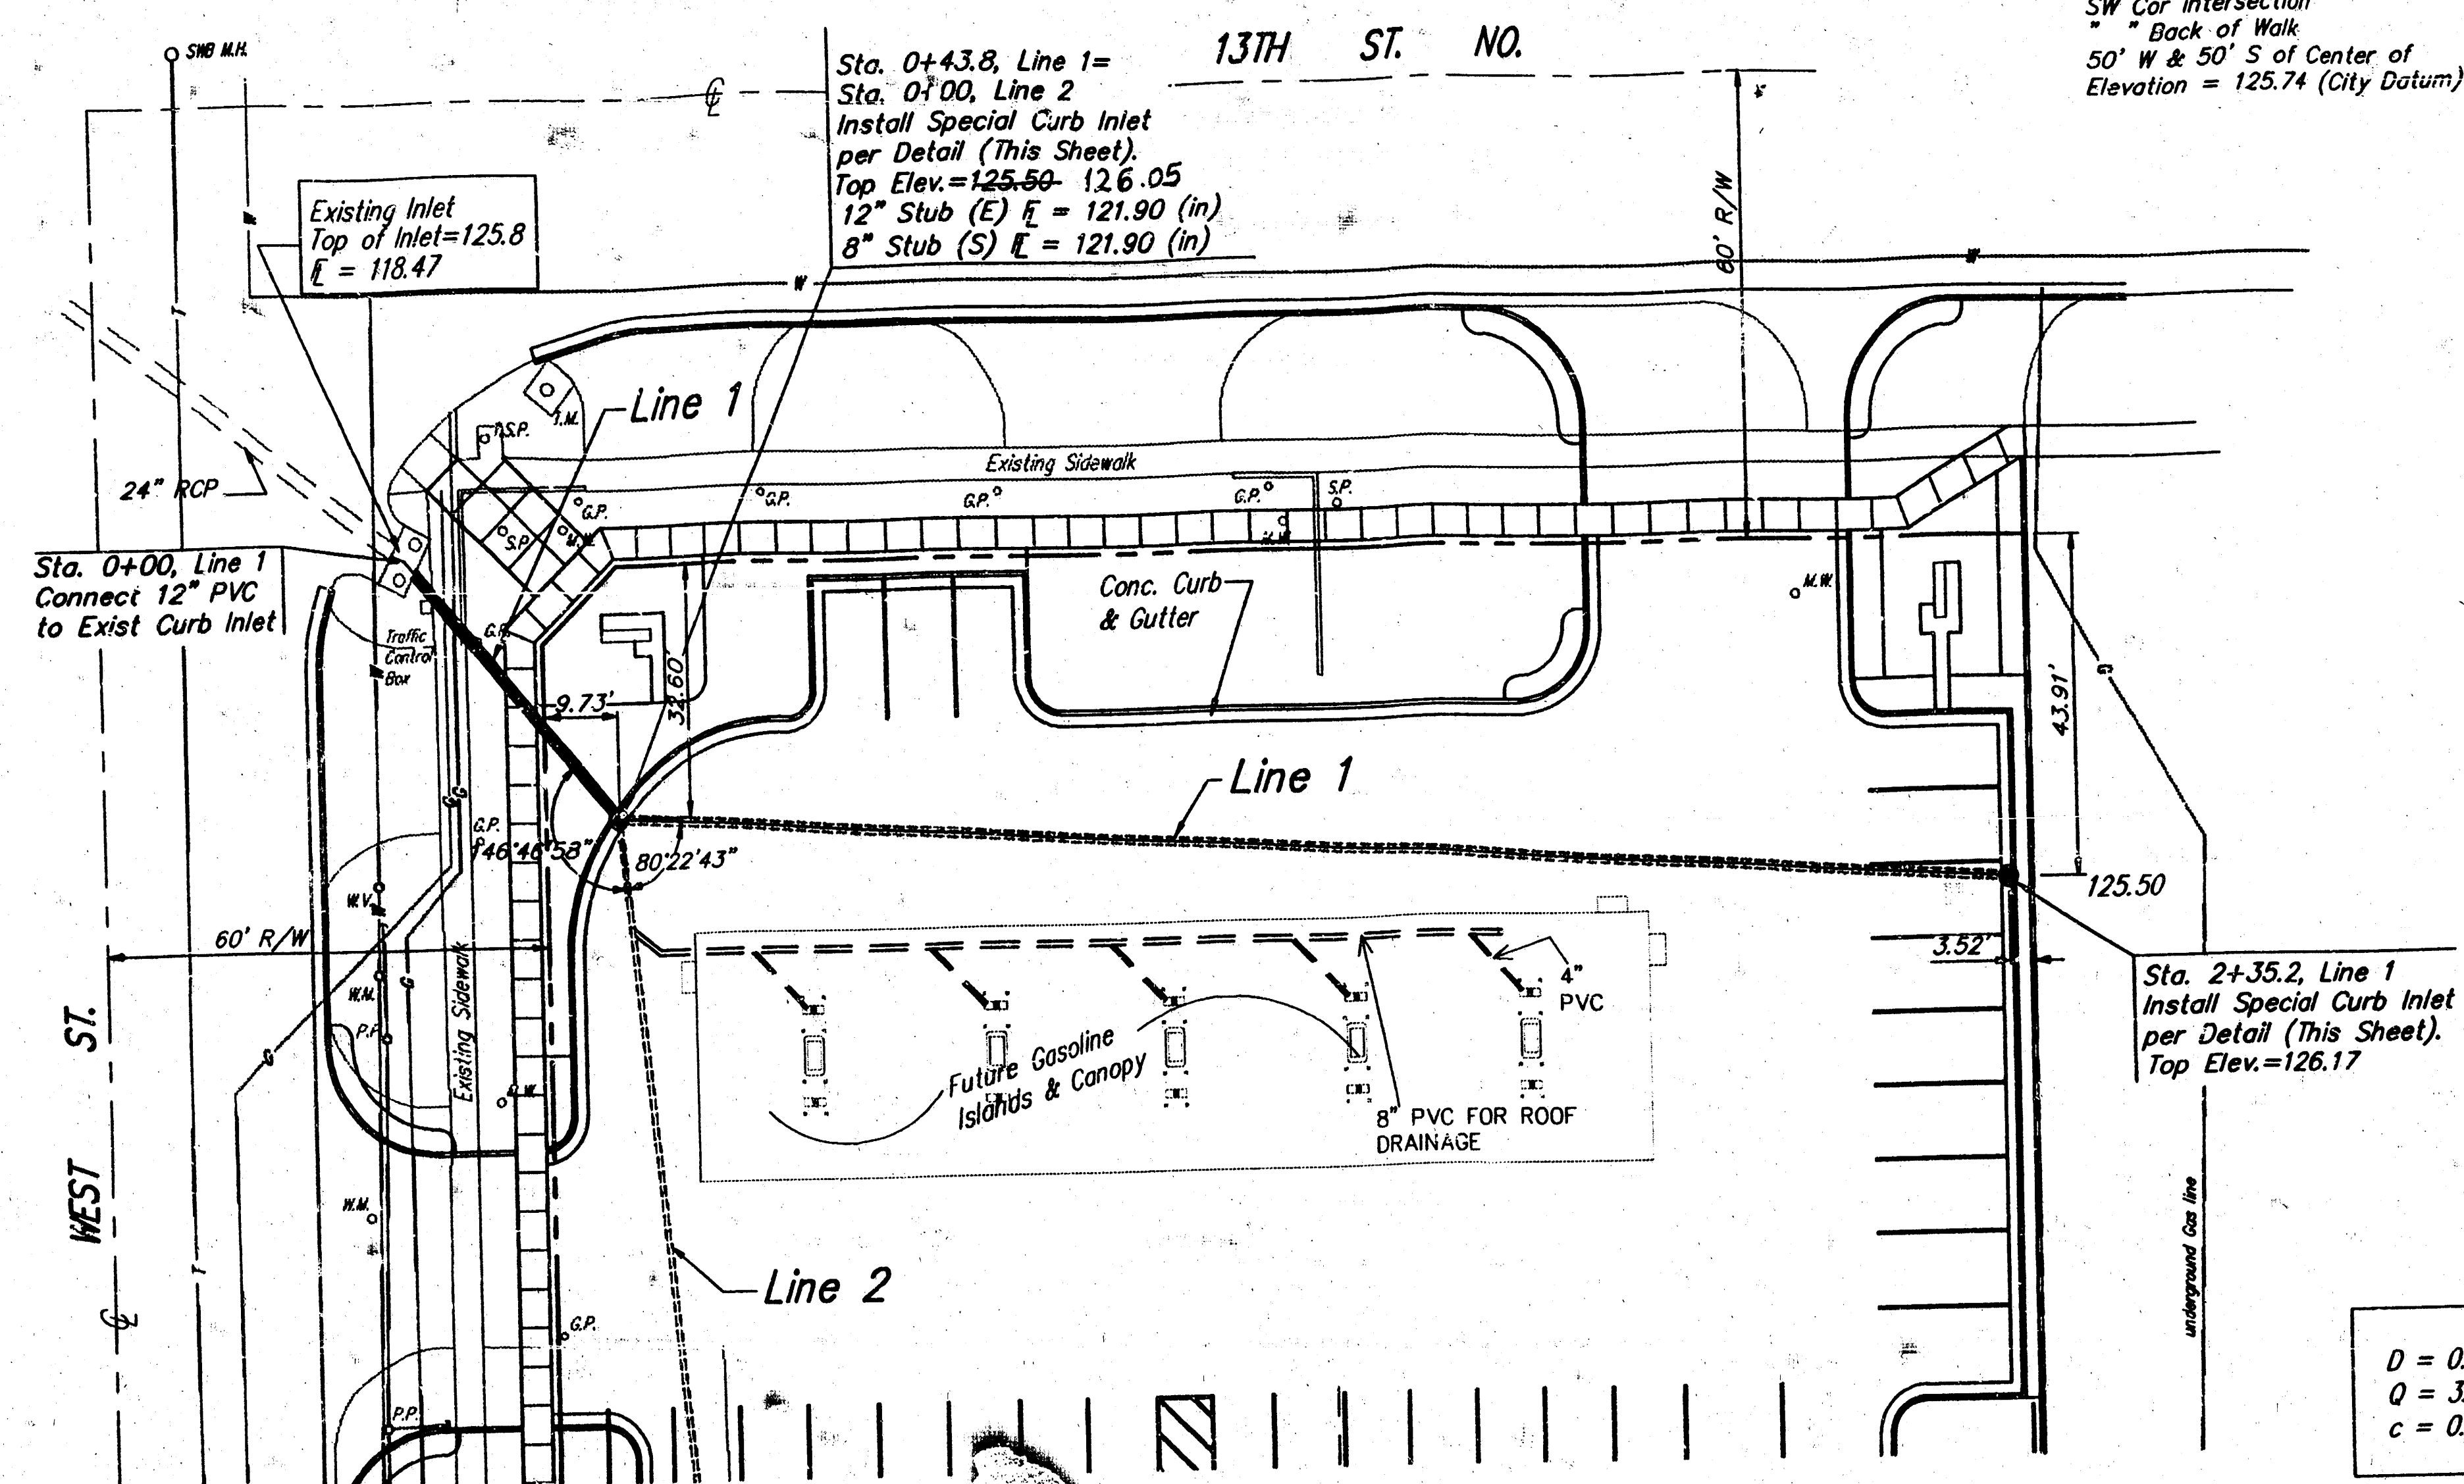

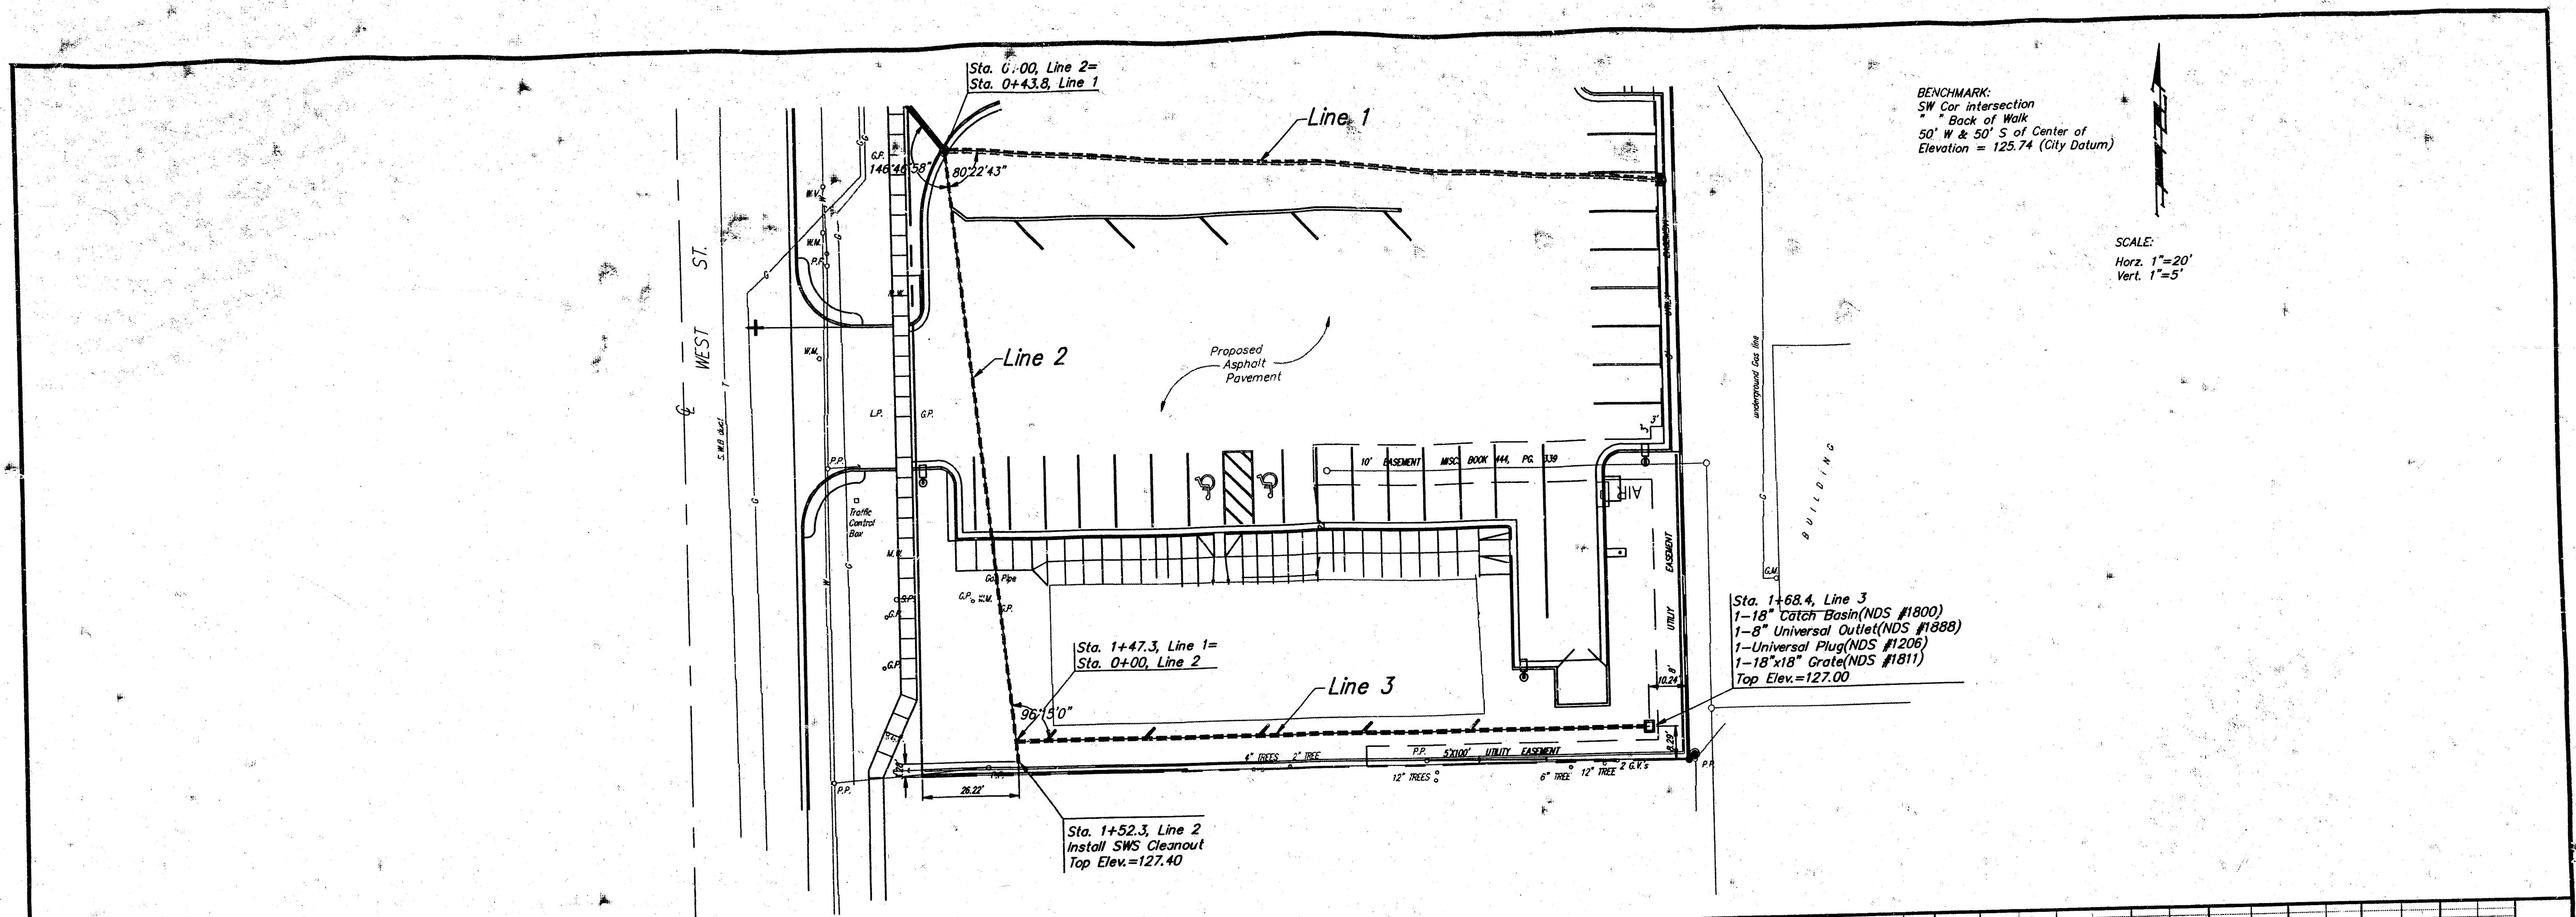

BENCHMARK:
SW Cor Intersection
Back of Walk
50' W & 50' S of Center of
Elevation = 125.74 (City Datum)

SCALE:
Horz. 1"=20'
Vert. 1"=5'

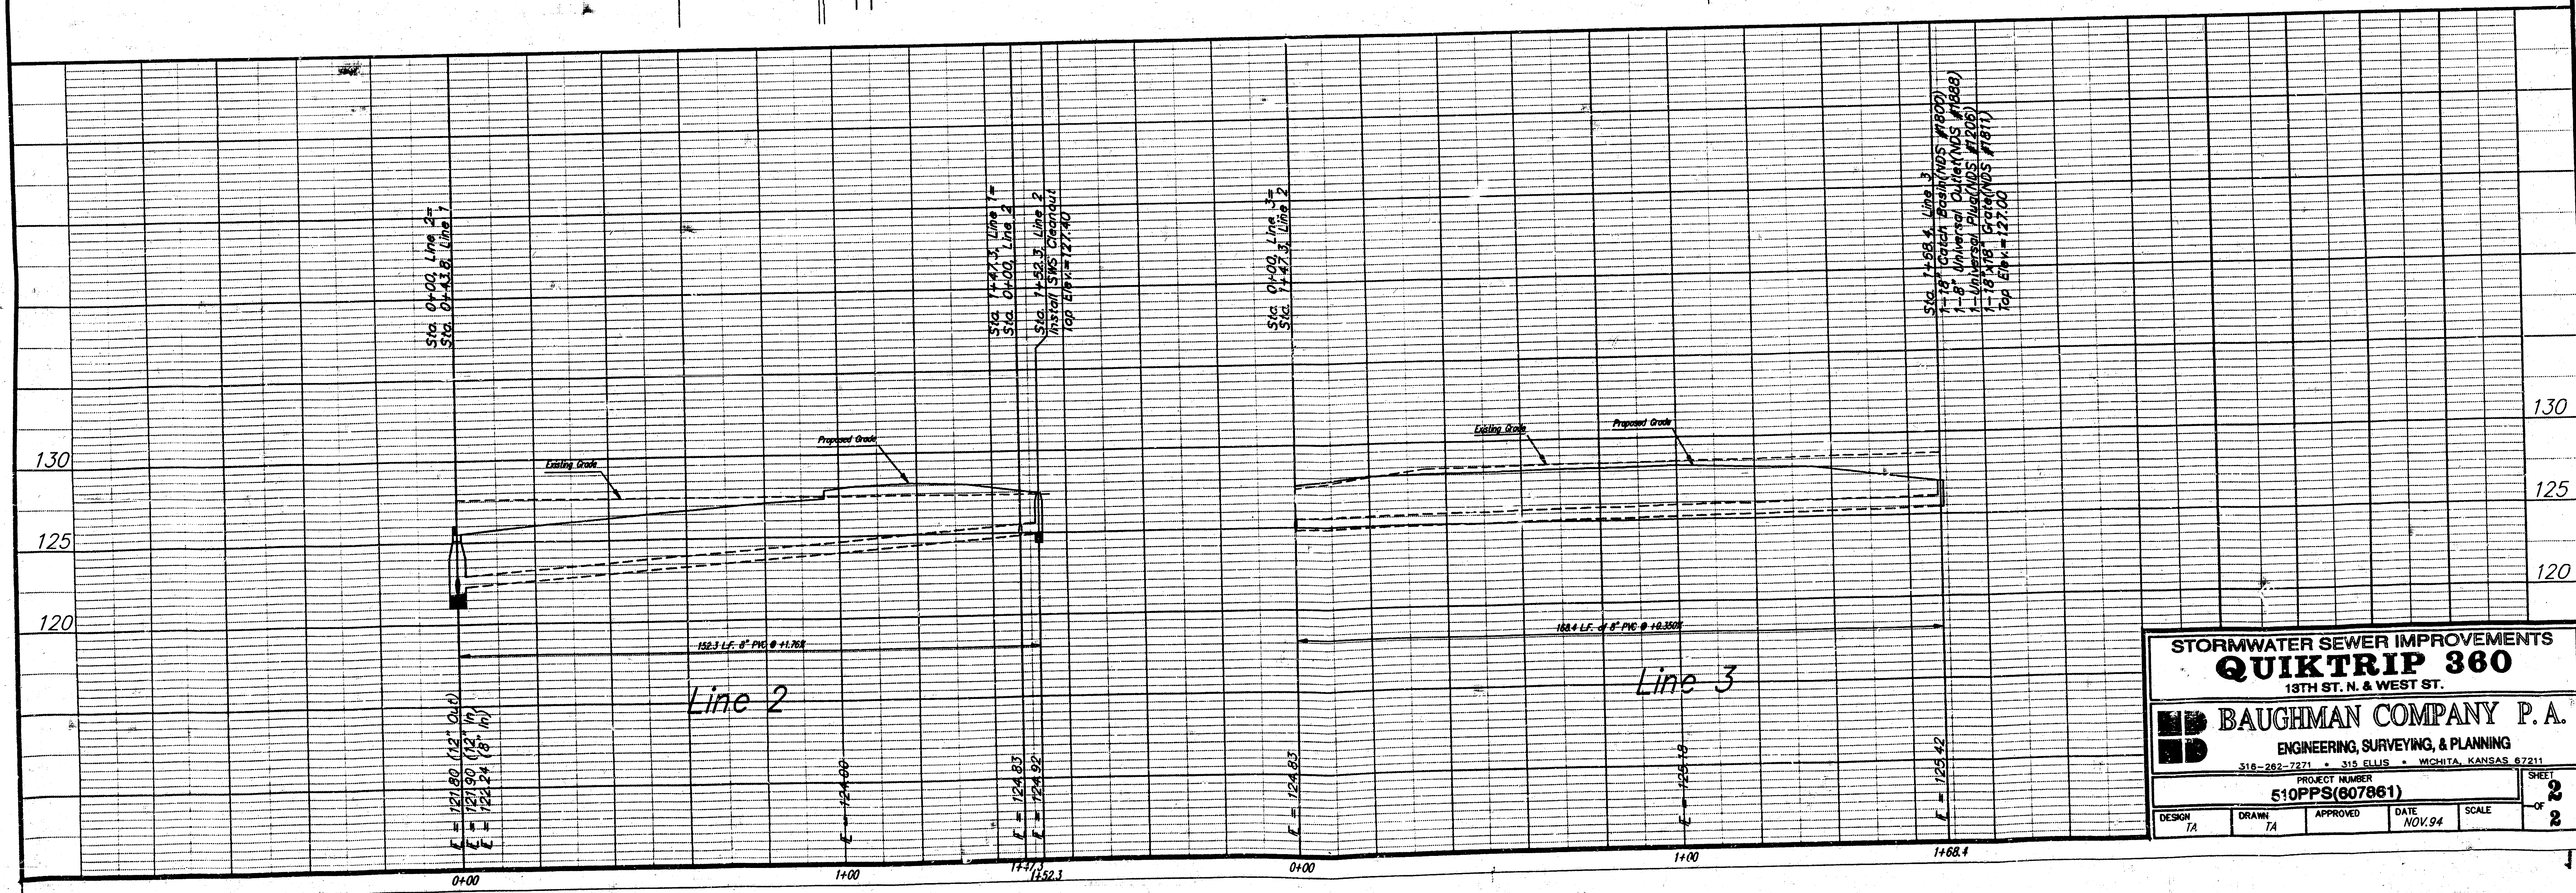

STORMWATER SEWER IMPROVEMENTS					
QUIKTRIP 360					
13TH ST. N. & WEST ST.					
BAUGHMAN COMPANY P. A.					
ENGINEERING, SURVEYING, & PLANNING					
318-281-7271 • 315 ELLIS • WICHITA, KANSAS 67211					
PROJECT NUMBER					
510PPS(607861)					
DESIGN	TA	DRAWN	TA	APPROVED	DATE
					NOV. 94
SCALE					SHEET
					2
					OF
					2