

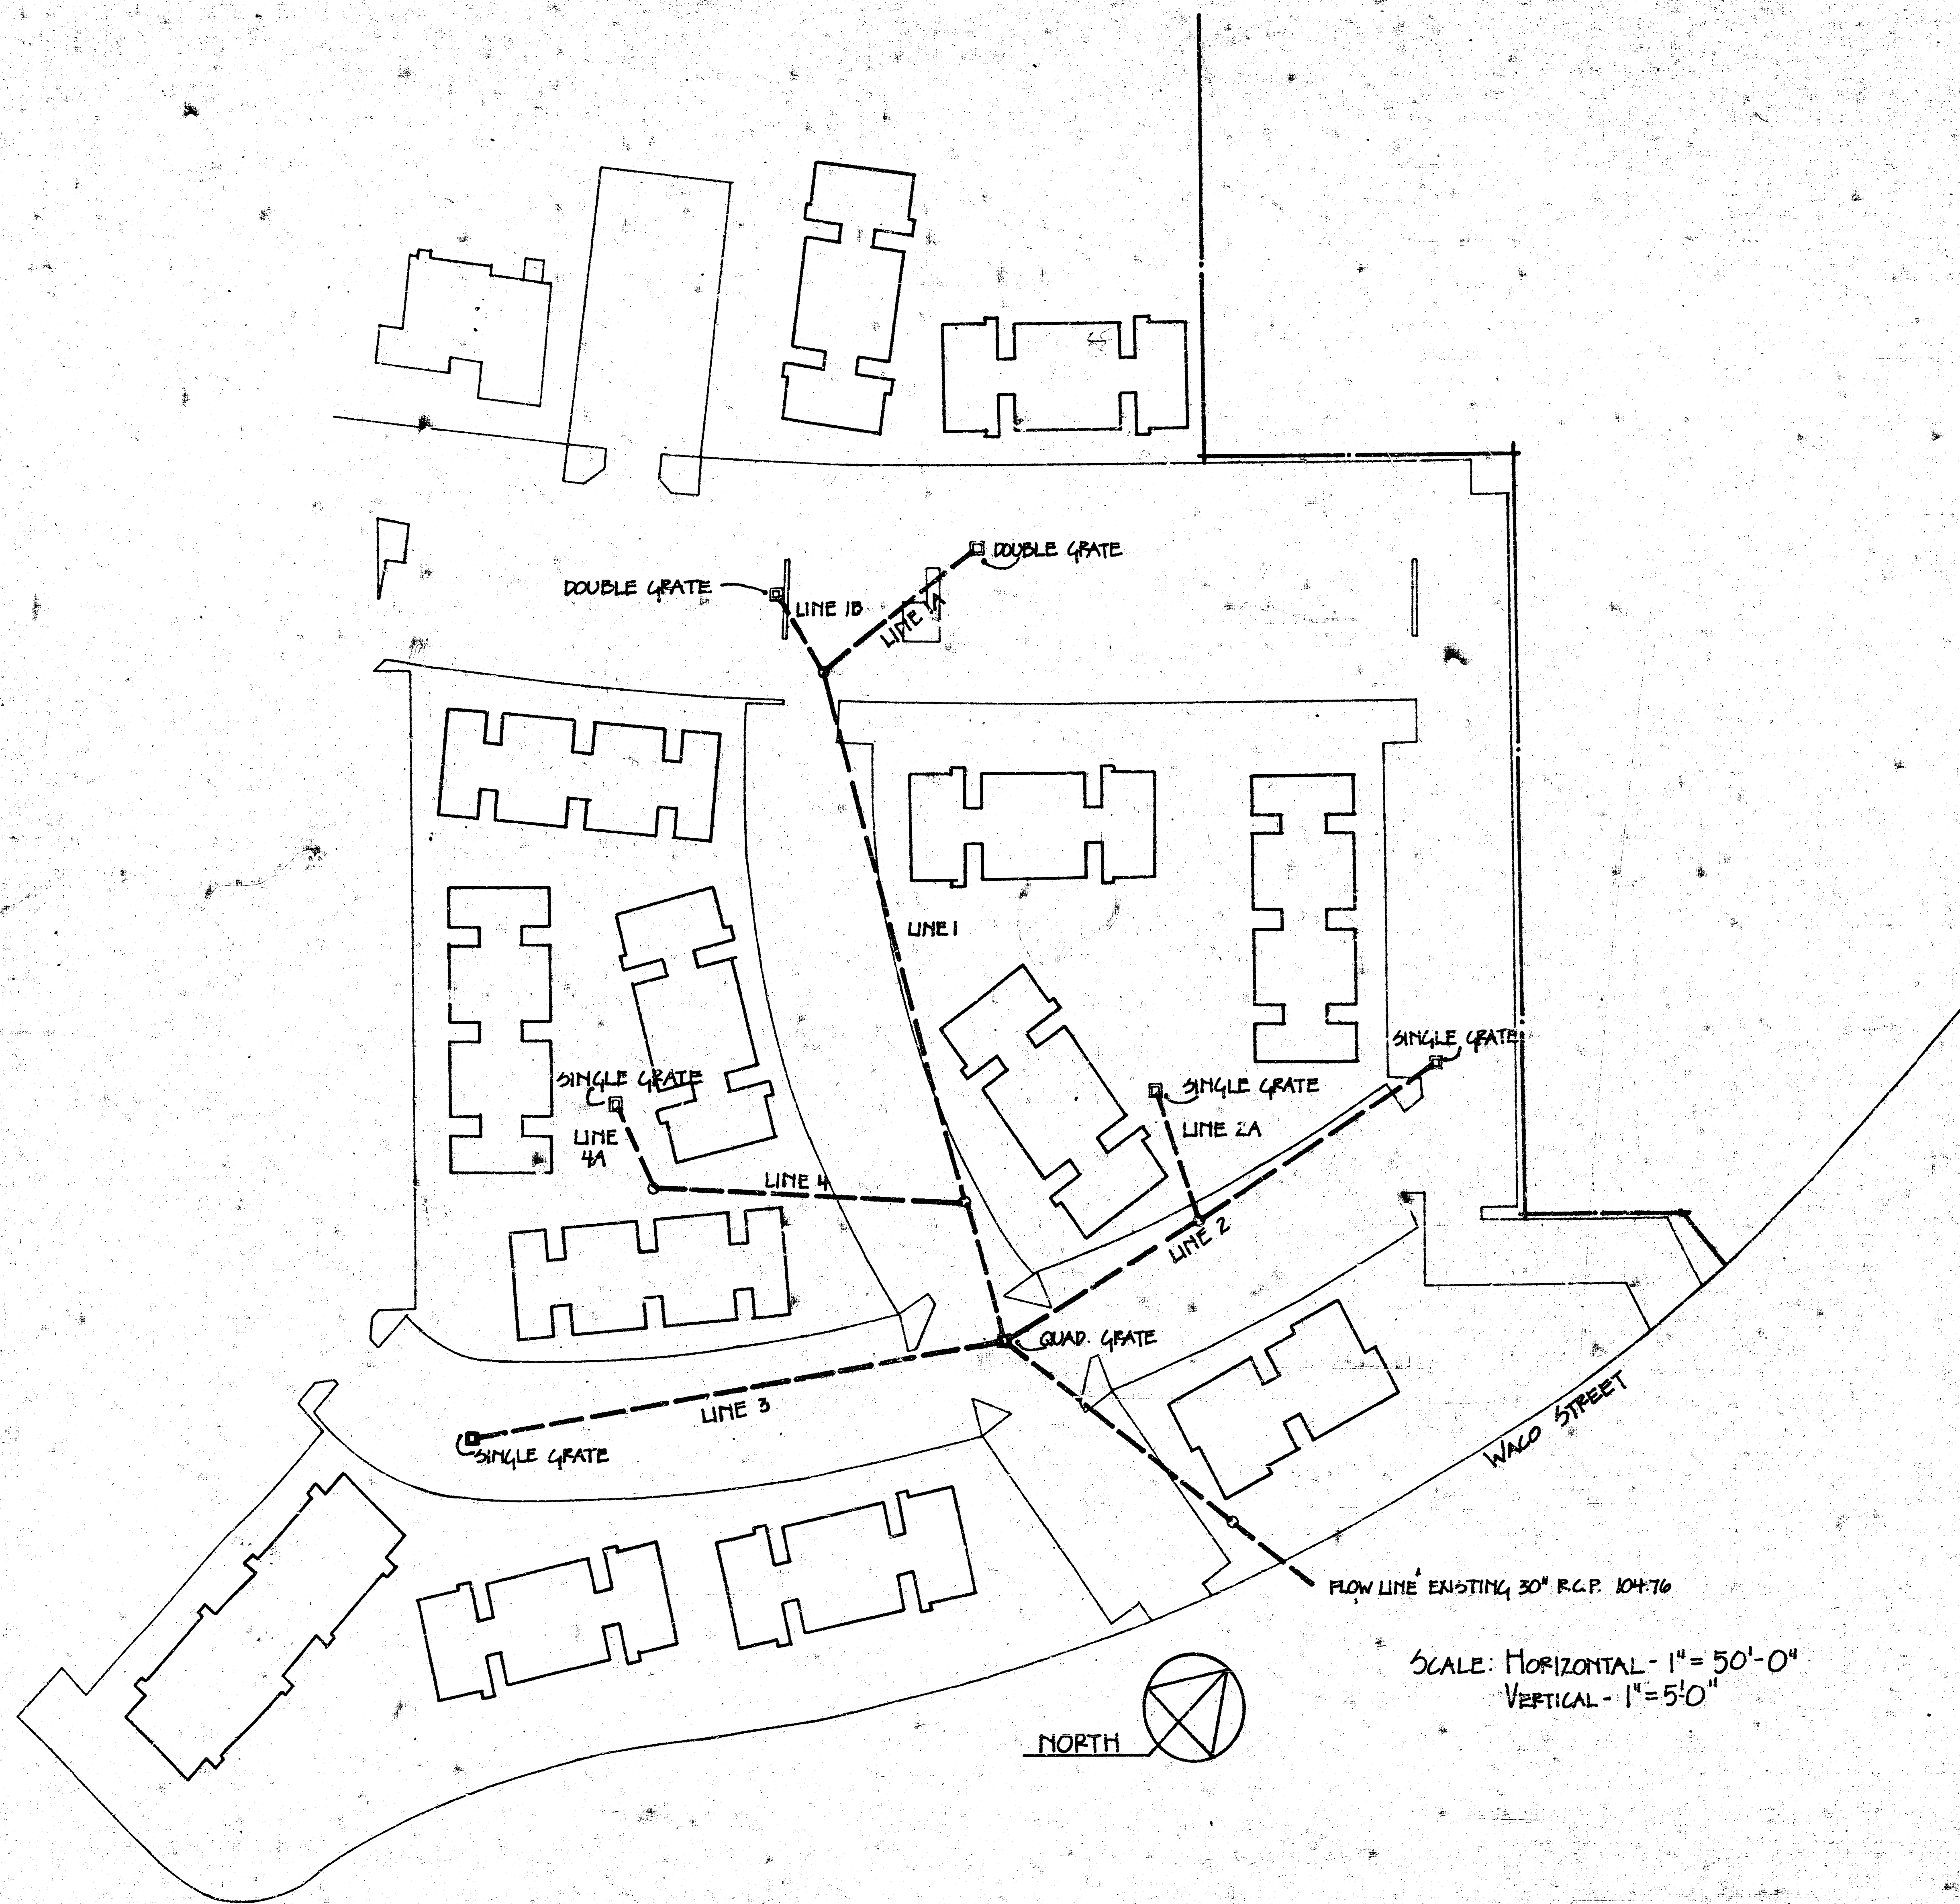
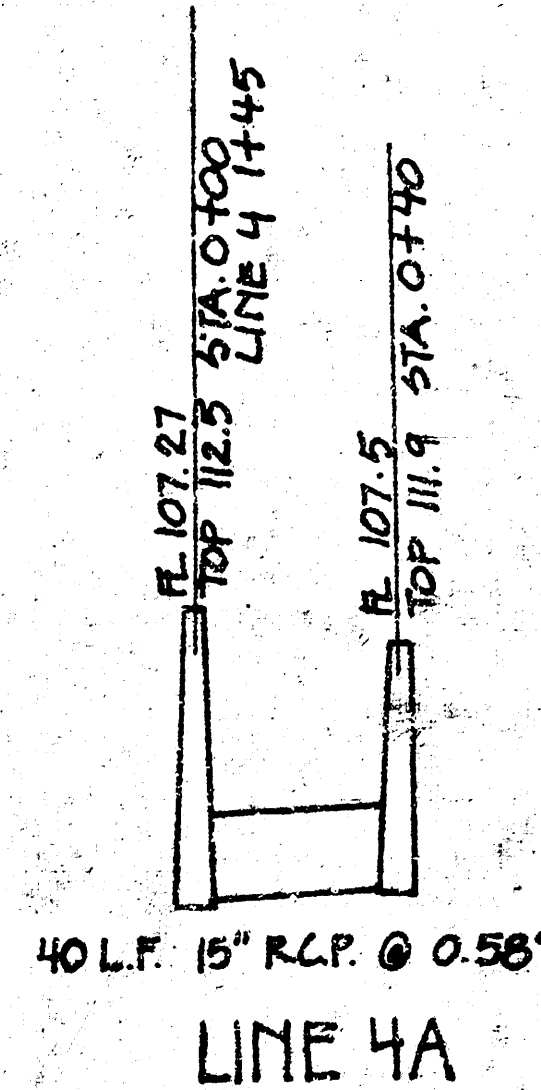
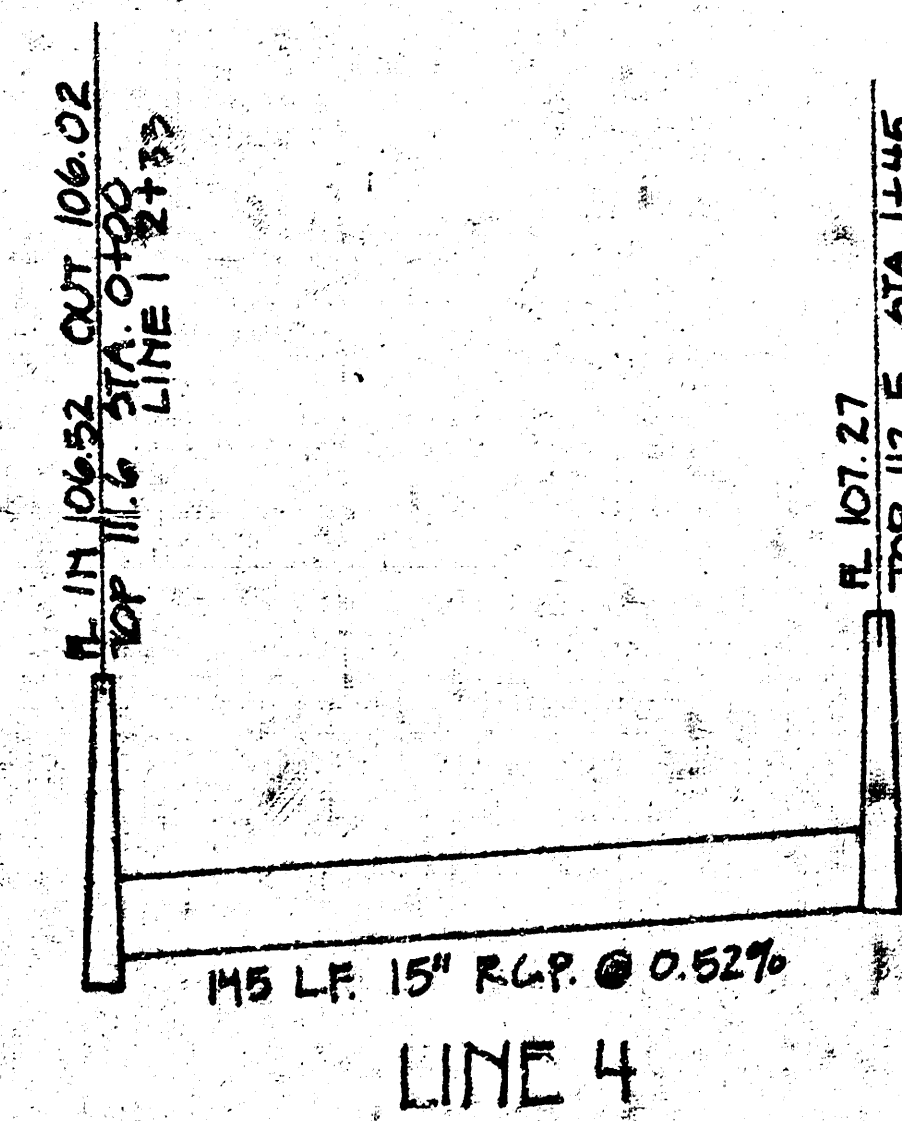
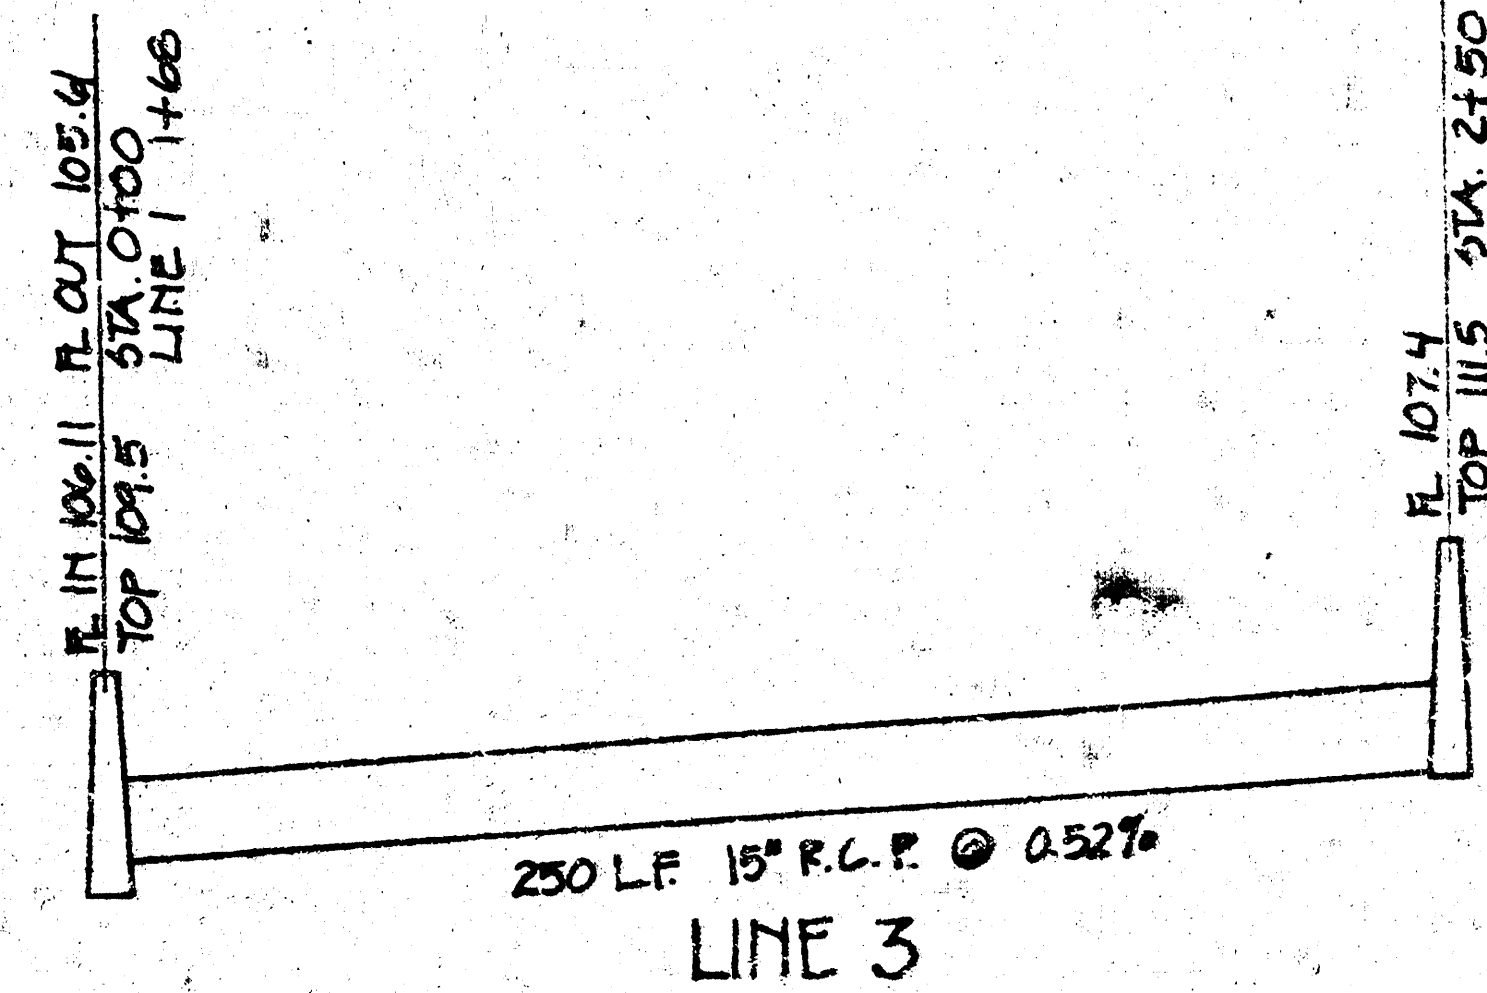
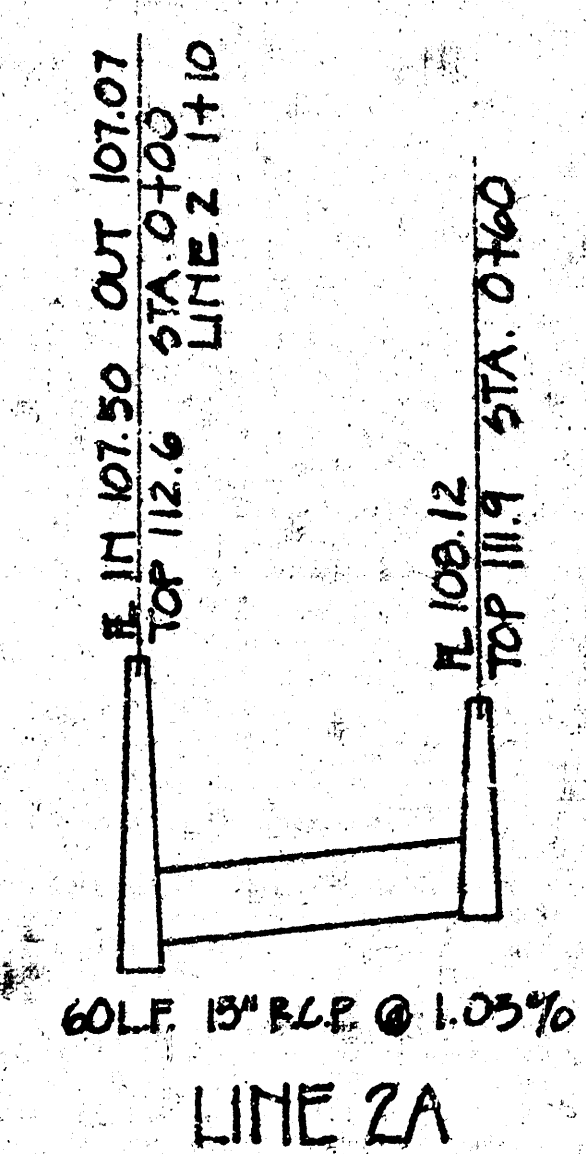
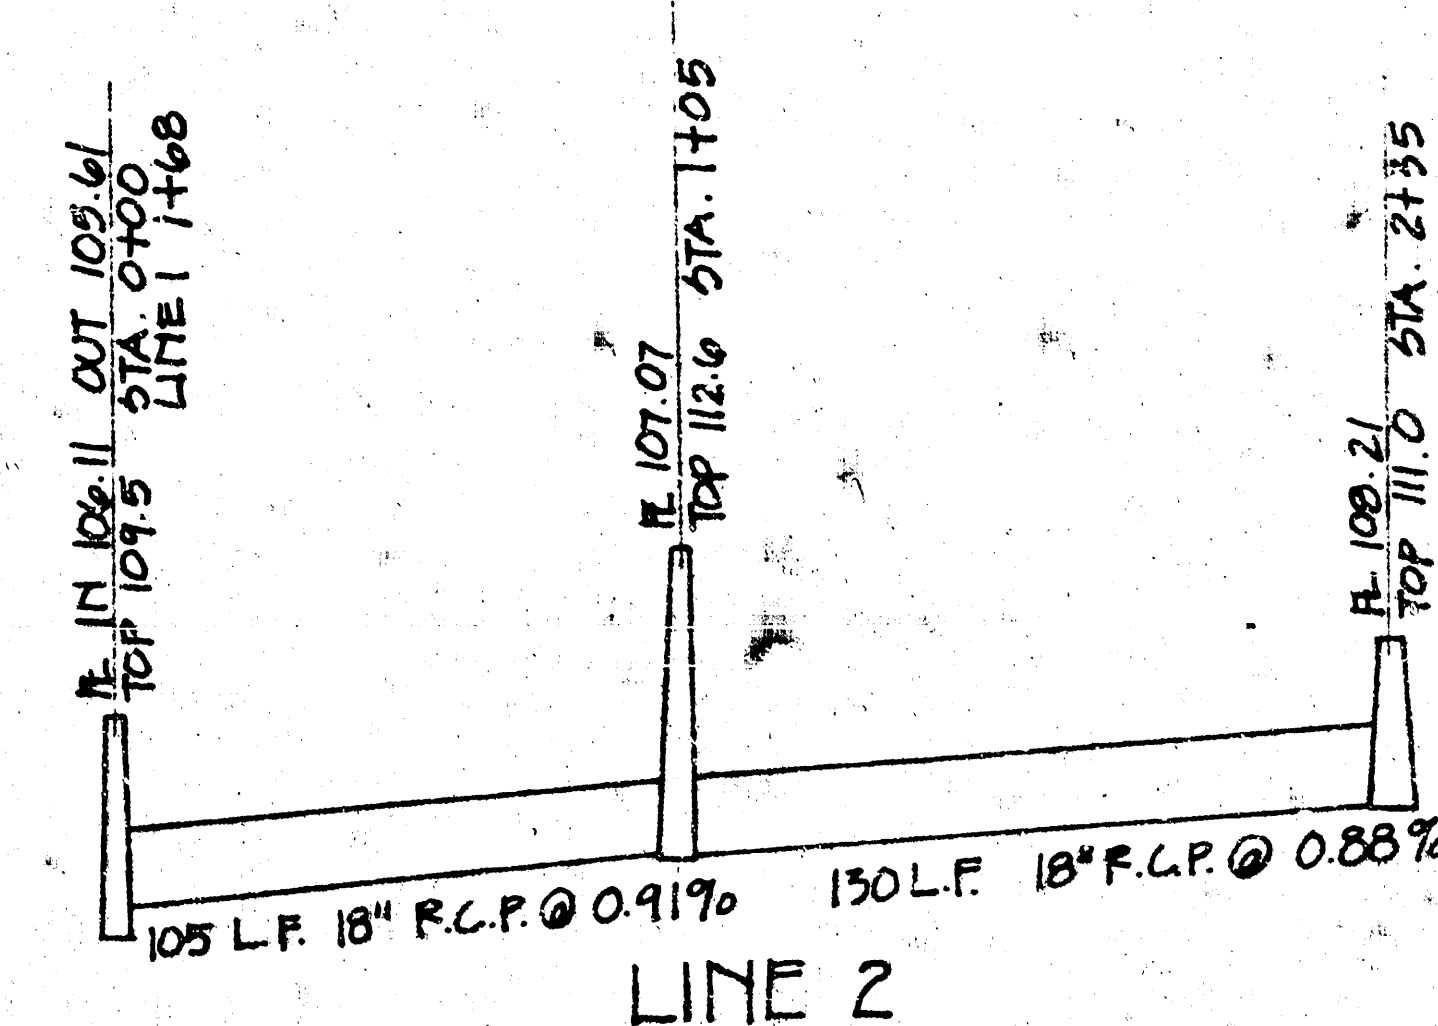
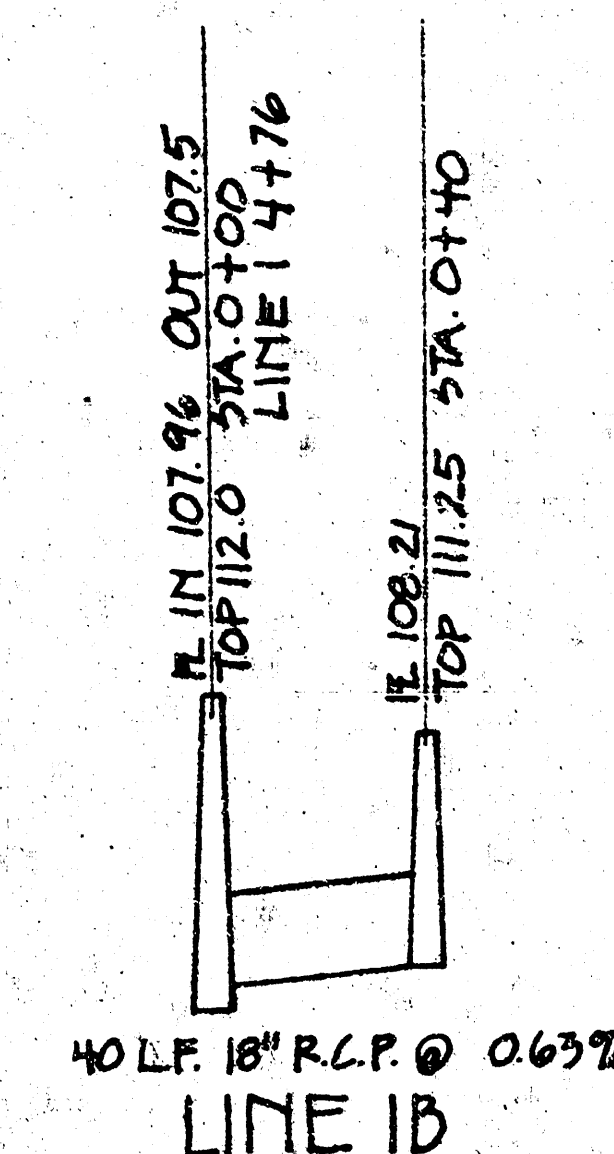


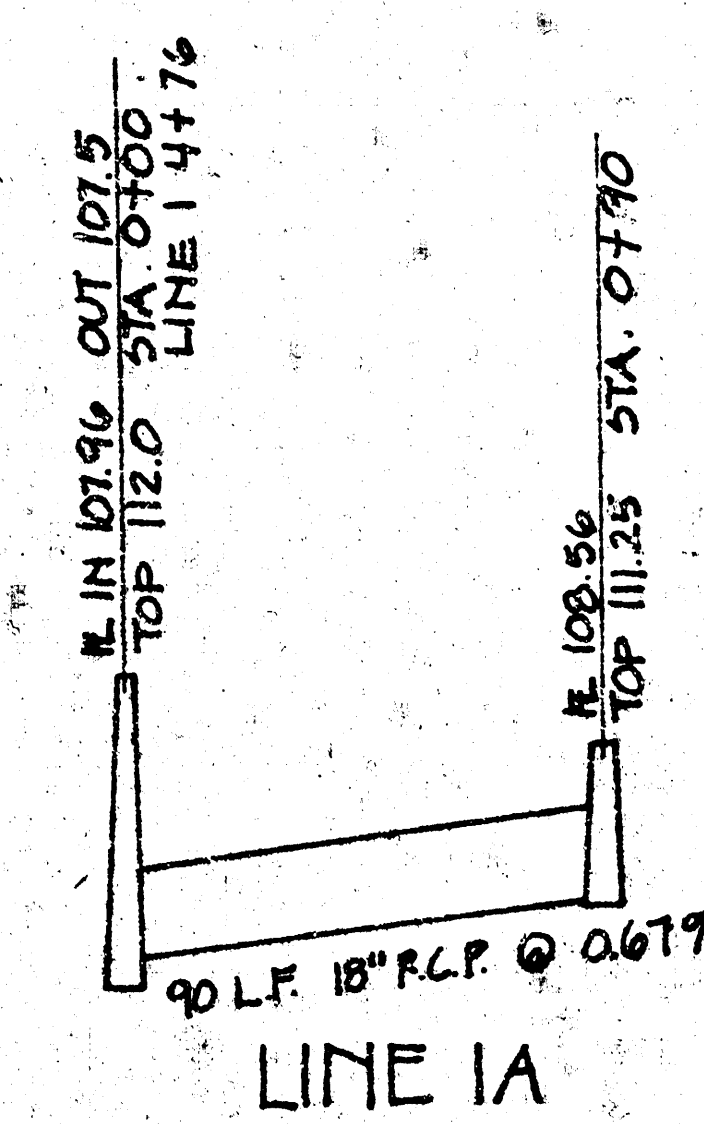

RIVERPARK II


STORM SEWER PLAN & PROFILES
 GENERAL CONTRACTOR - UTILITY CONTRACTORS INC.
 1977 U-1065

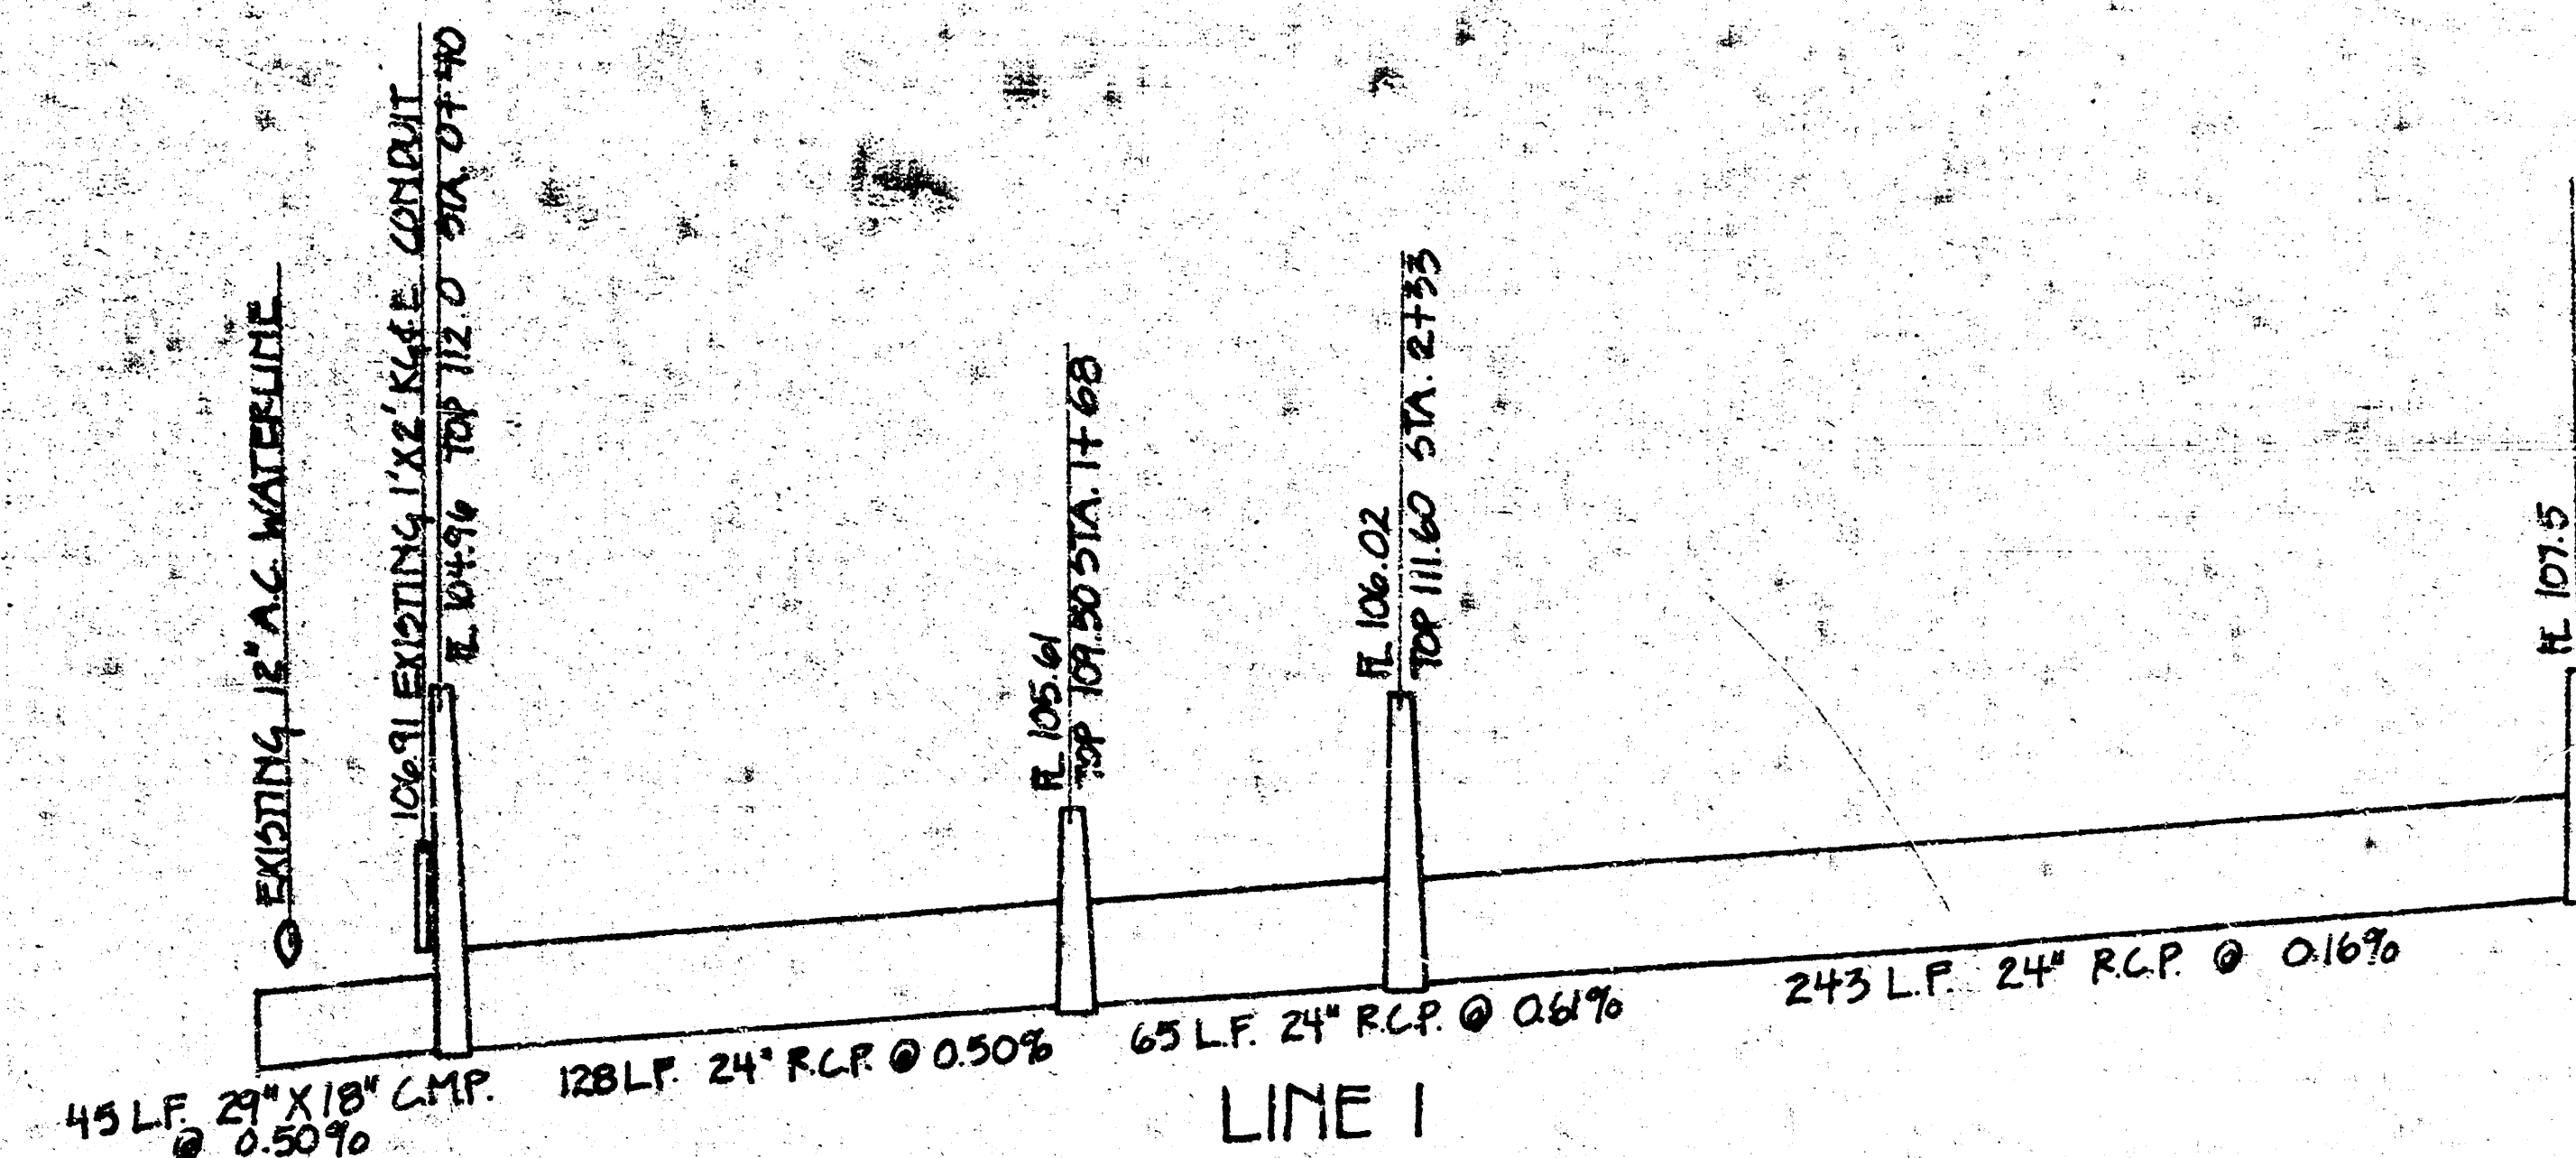


2' or 3" thick minimum
Gone. Cradle around water pipe
required. *Yes*

APPROVED AS NOTED
BY CITY ENGINEER OF WICHITA
Sanitary Sewers
Storm Sewers *Yes* 8/15/77
Driveway Approaches


City of Wichita Private Storm Sewer NO. DBKW 707043

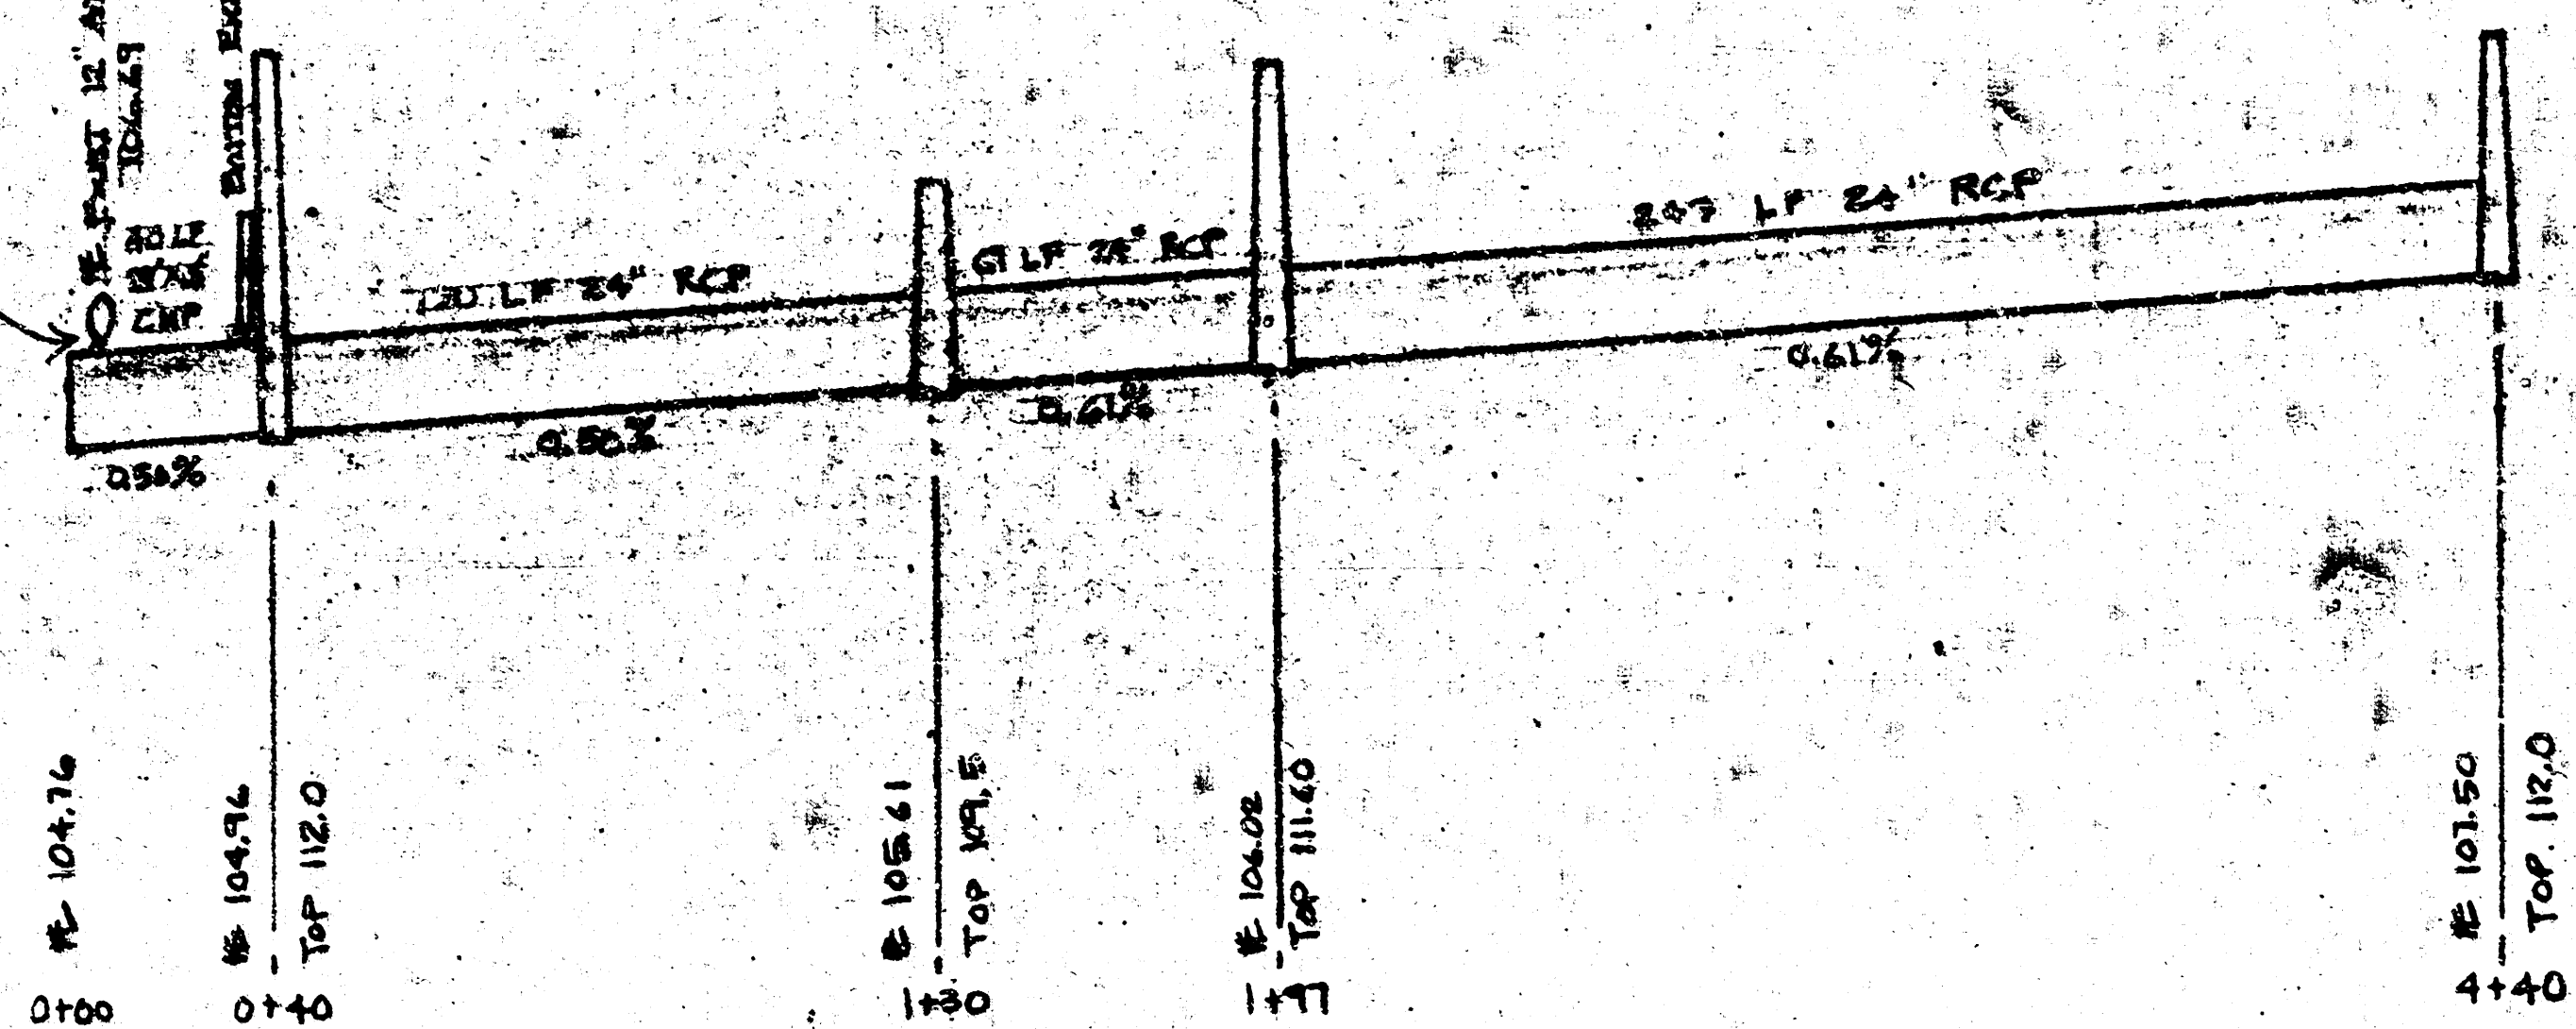


LINE 1

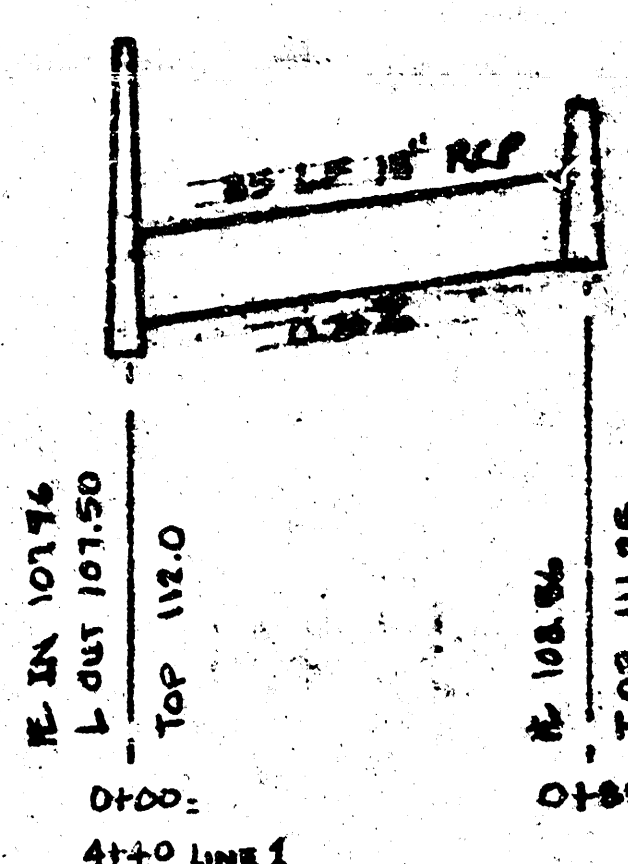


LINE 1A

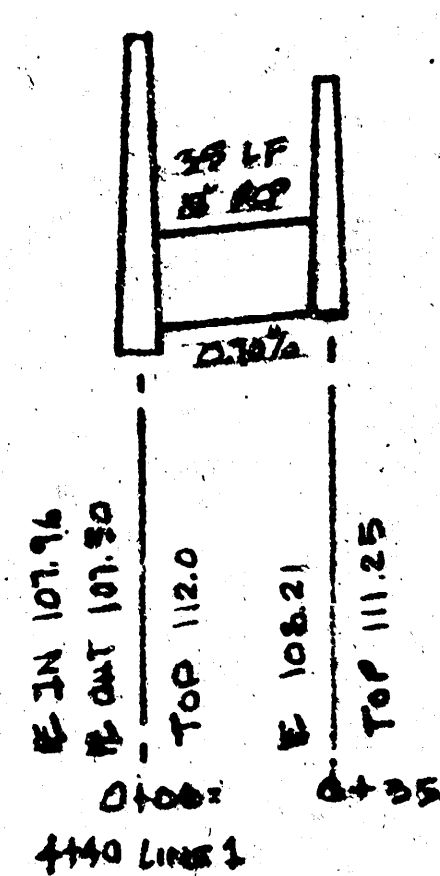


LINE 1B

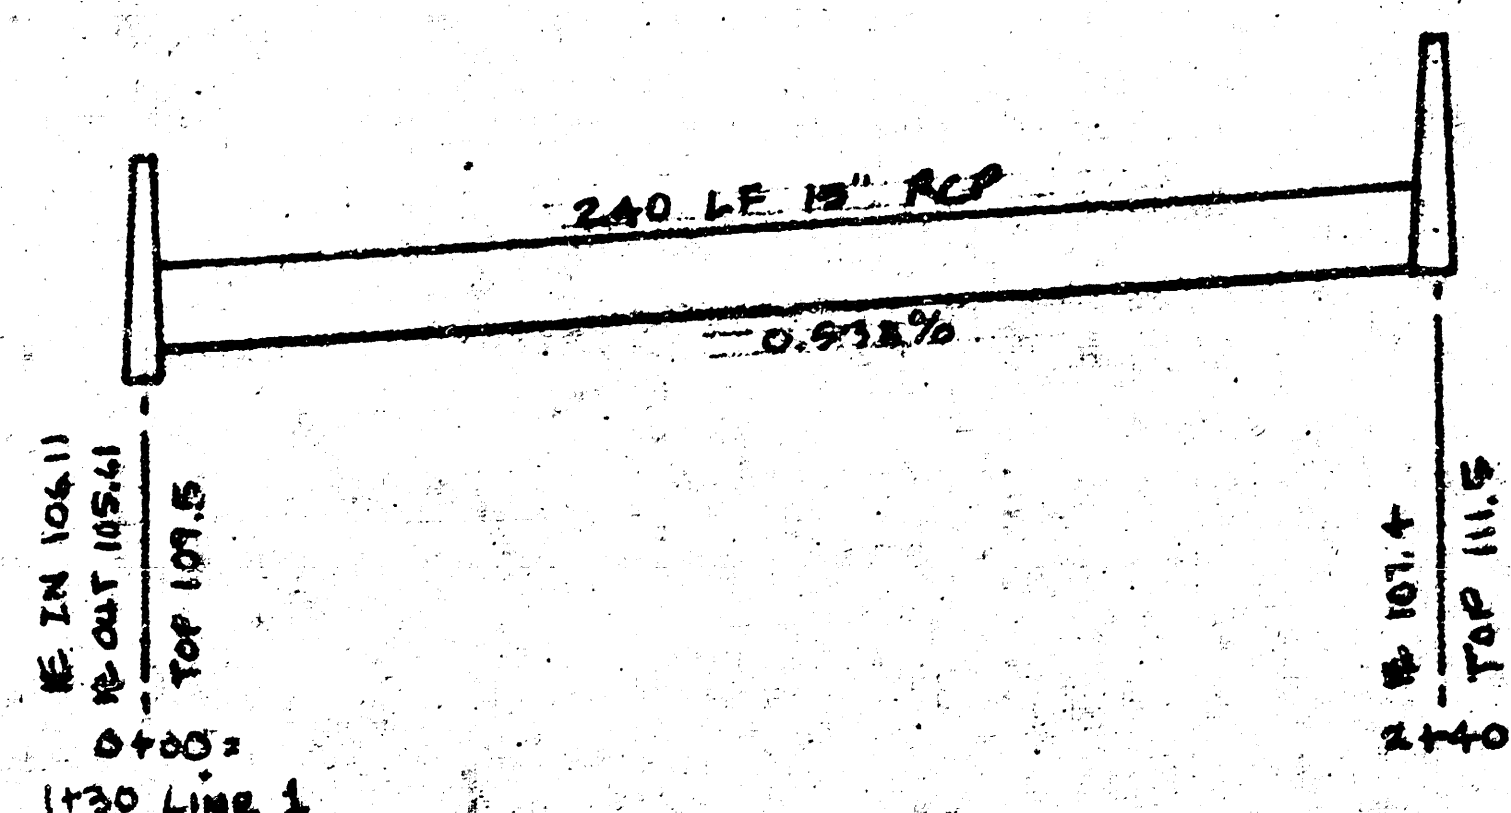


LINE 3

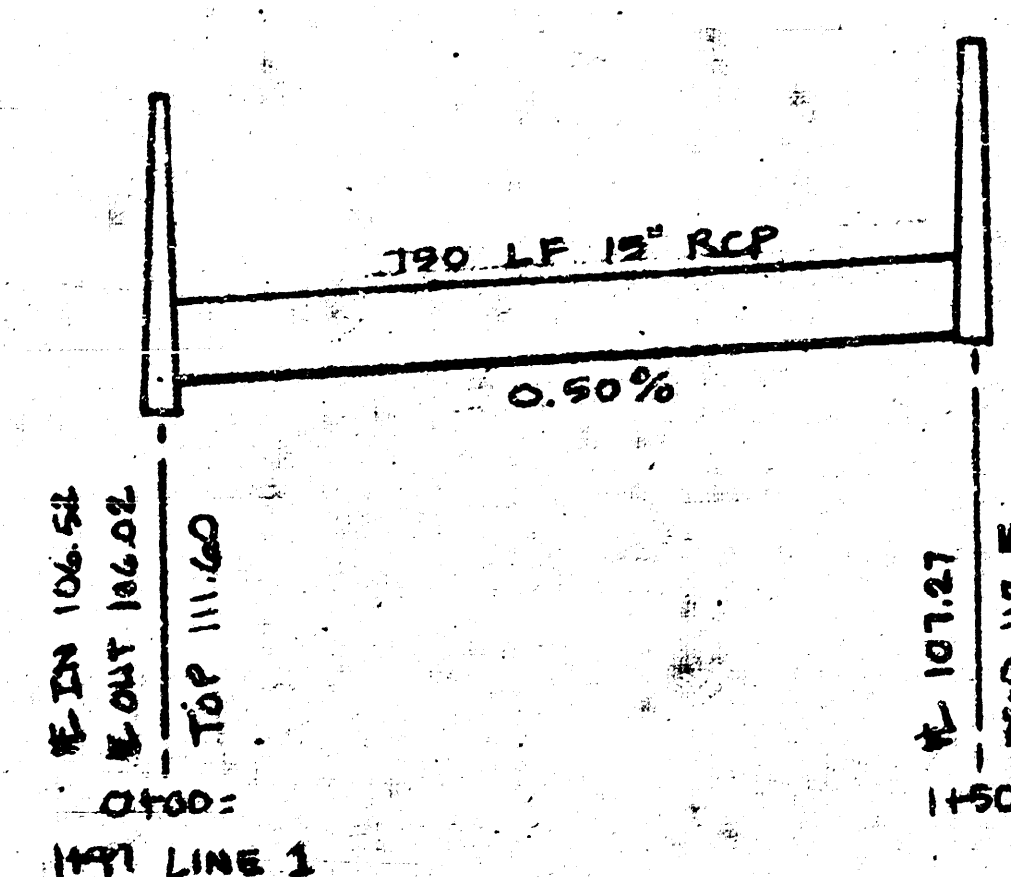


LINE 4

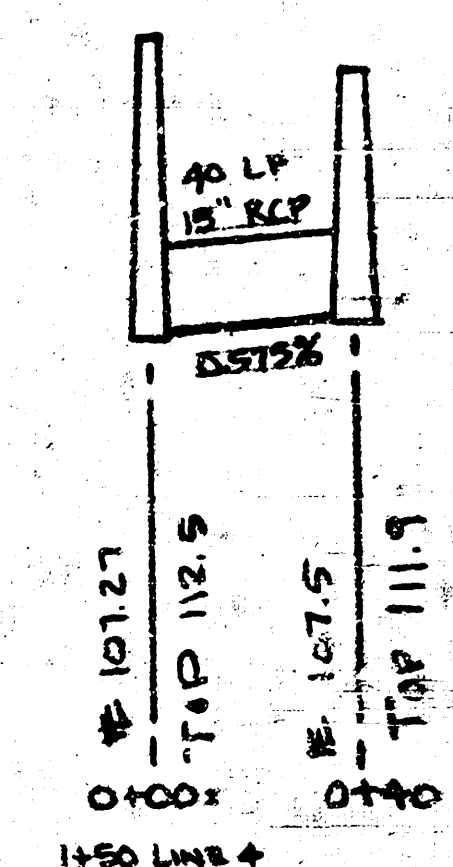

LINE 4A

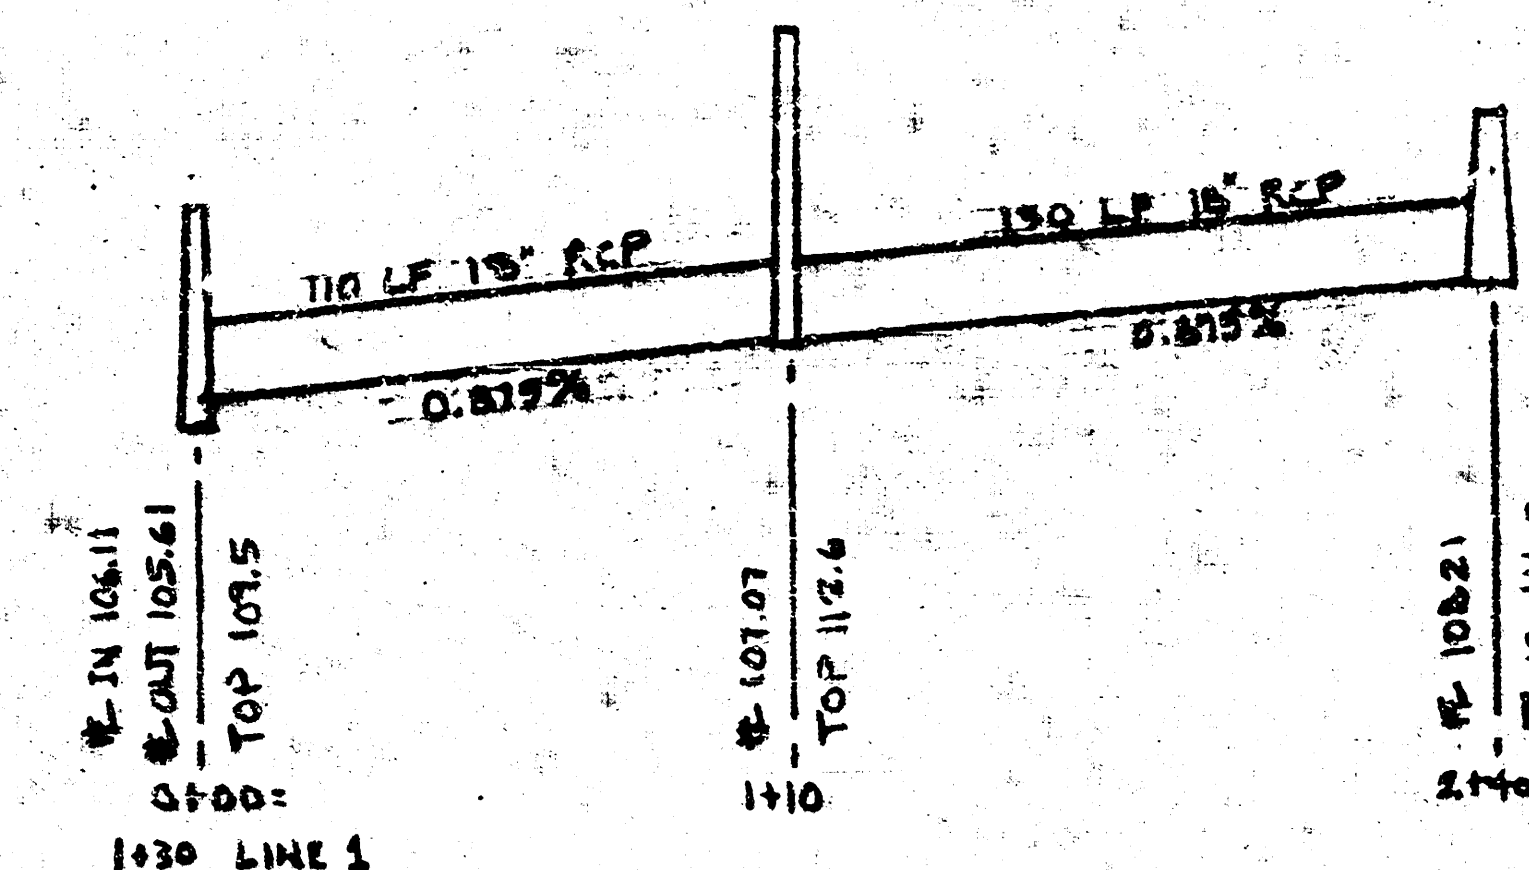

LINE 2

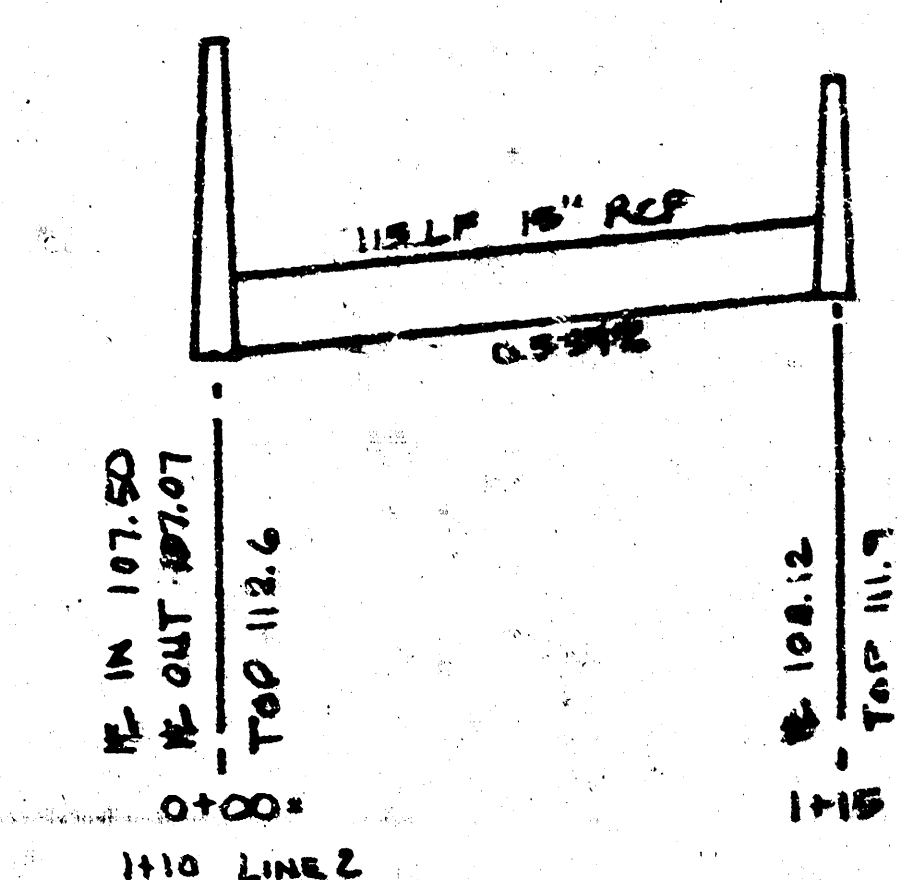

LINE 2

Scales Horiz. 1" = 50'
Vert. 1" = 5'