

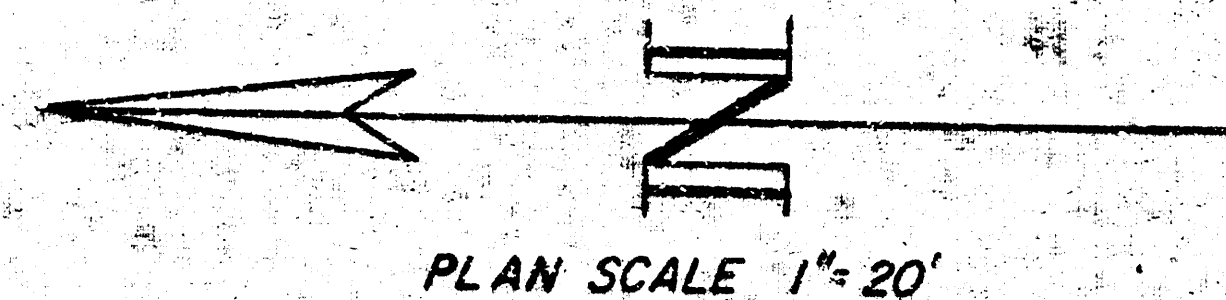


PROFESSIONAL OFFICE
BUILDING

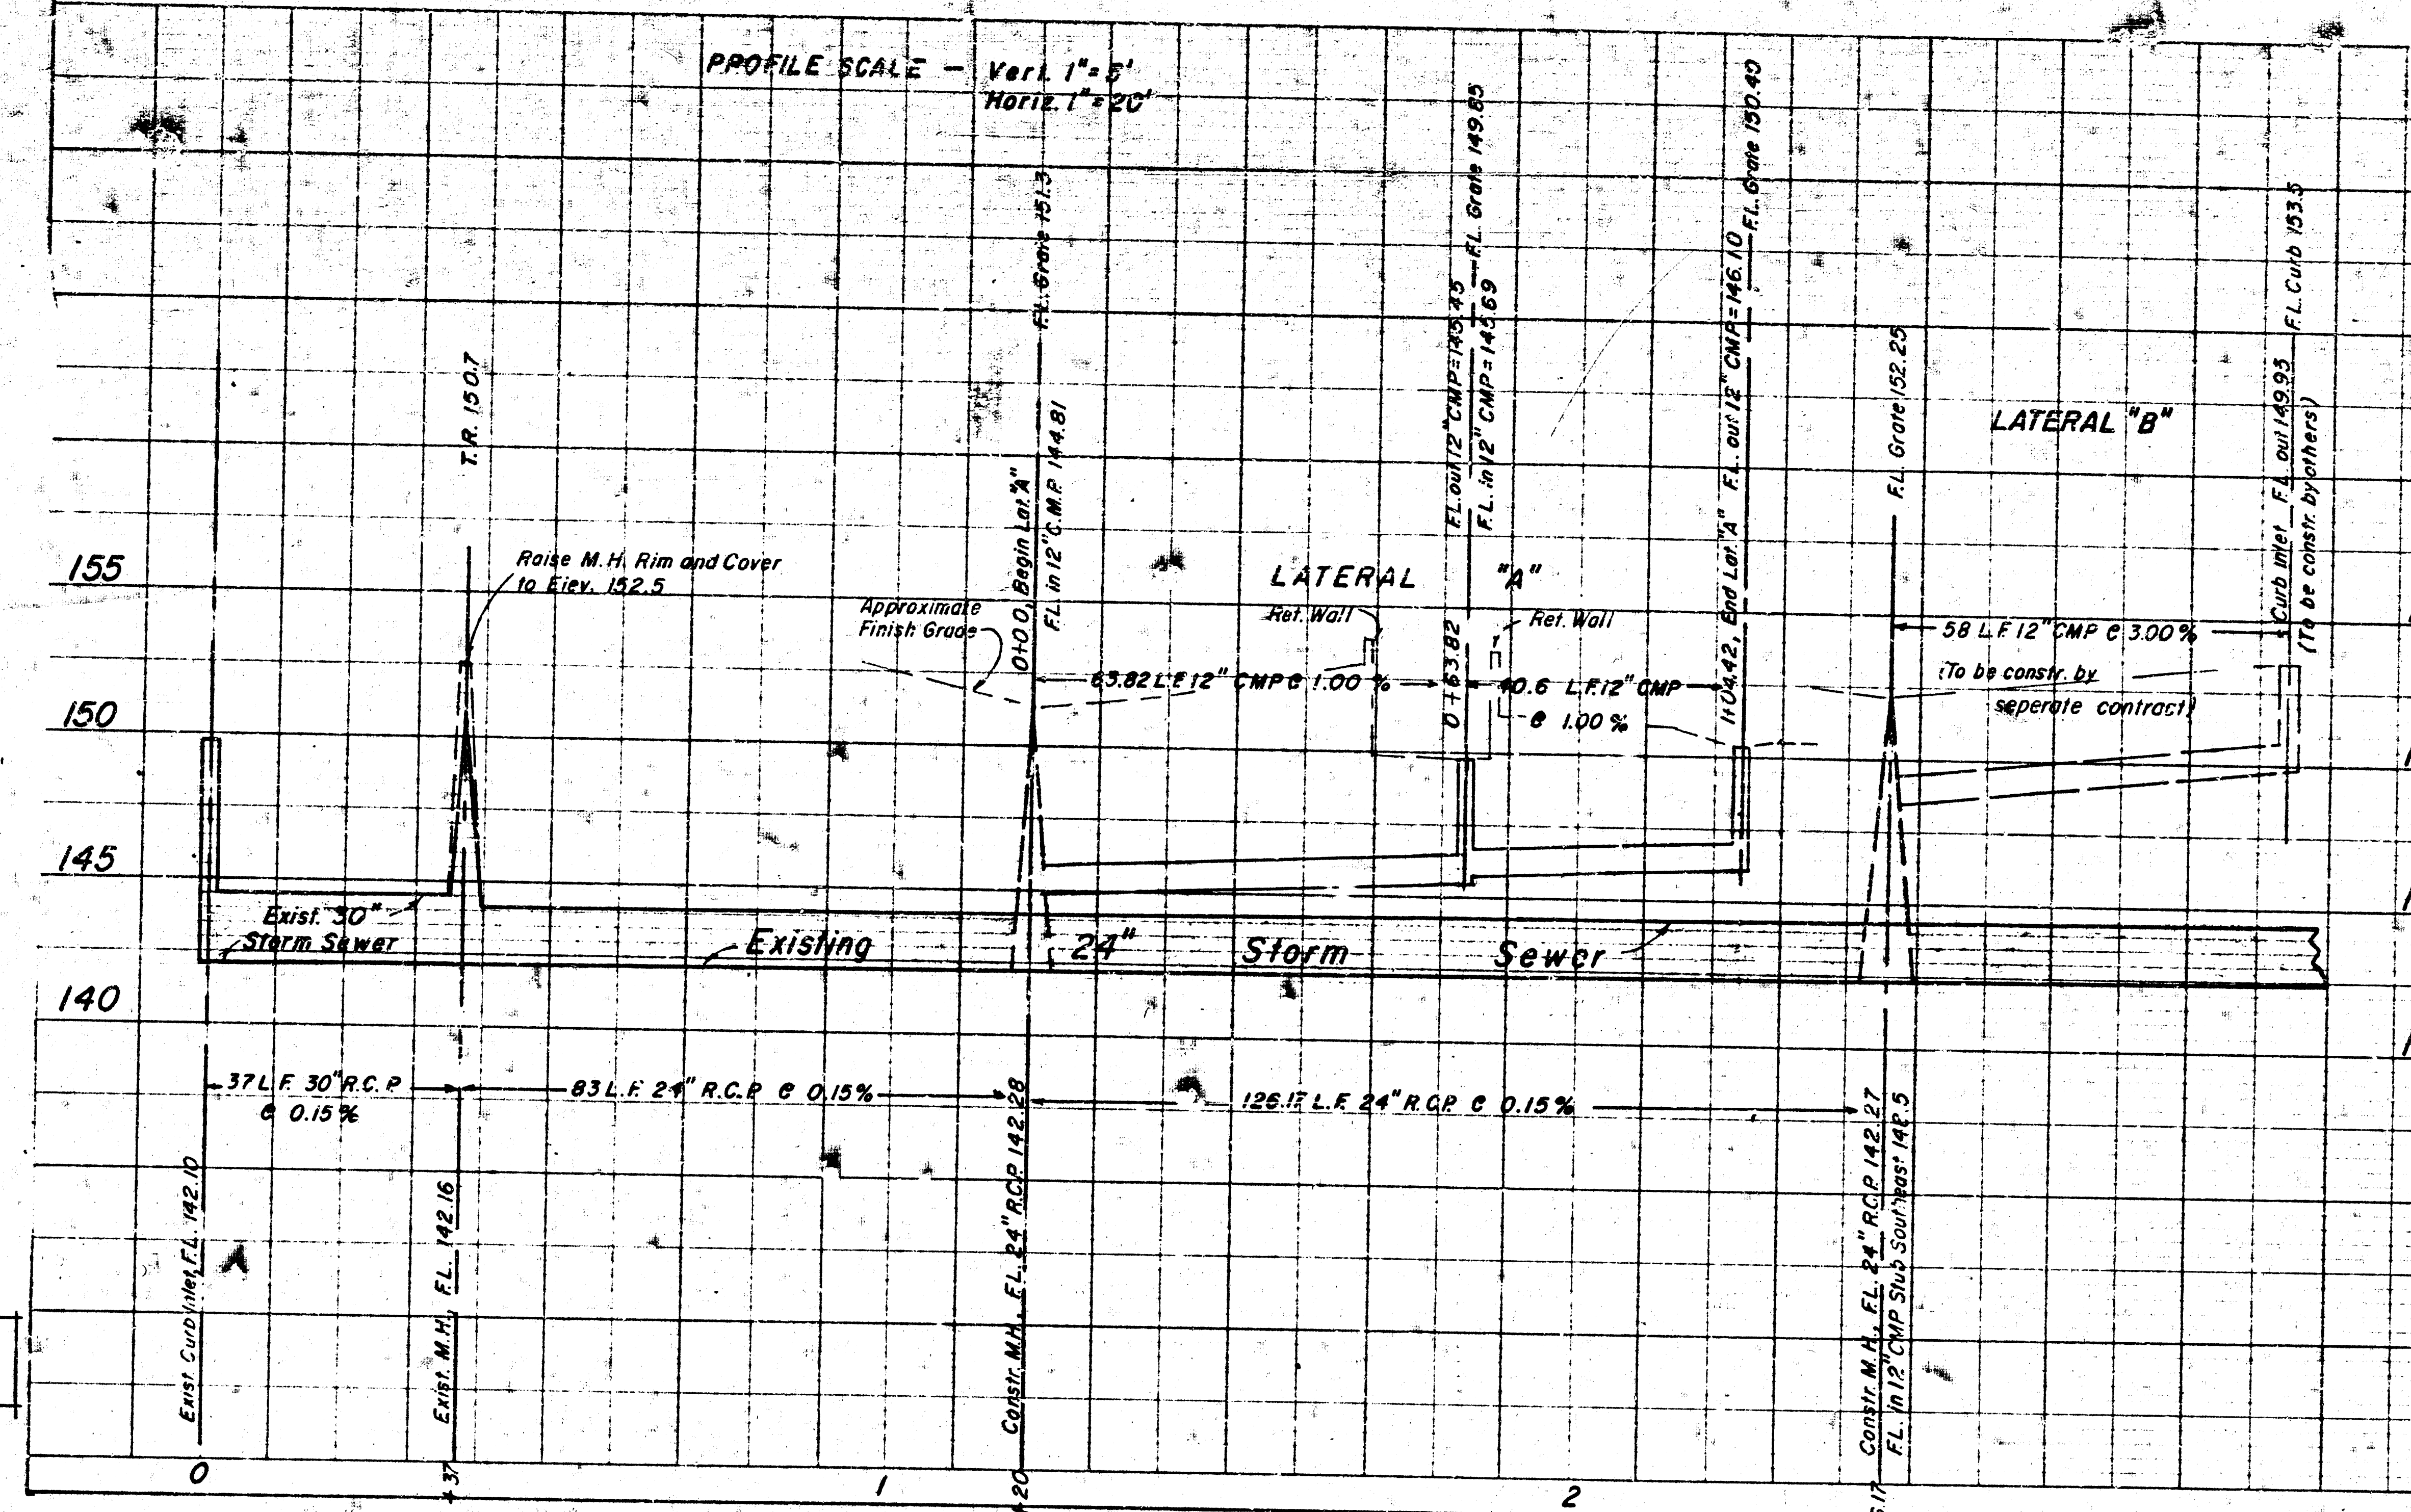

Bench Mark: Top of slab at base of S.E. corner of W. brick
wall of parking garage elevator entrance, Elev. 151.9, City Datum.

ENERGY CENTER

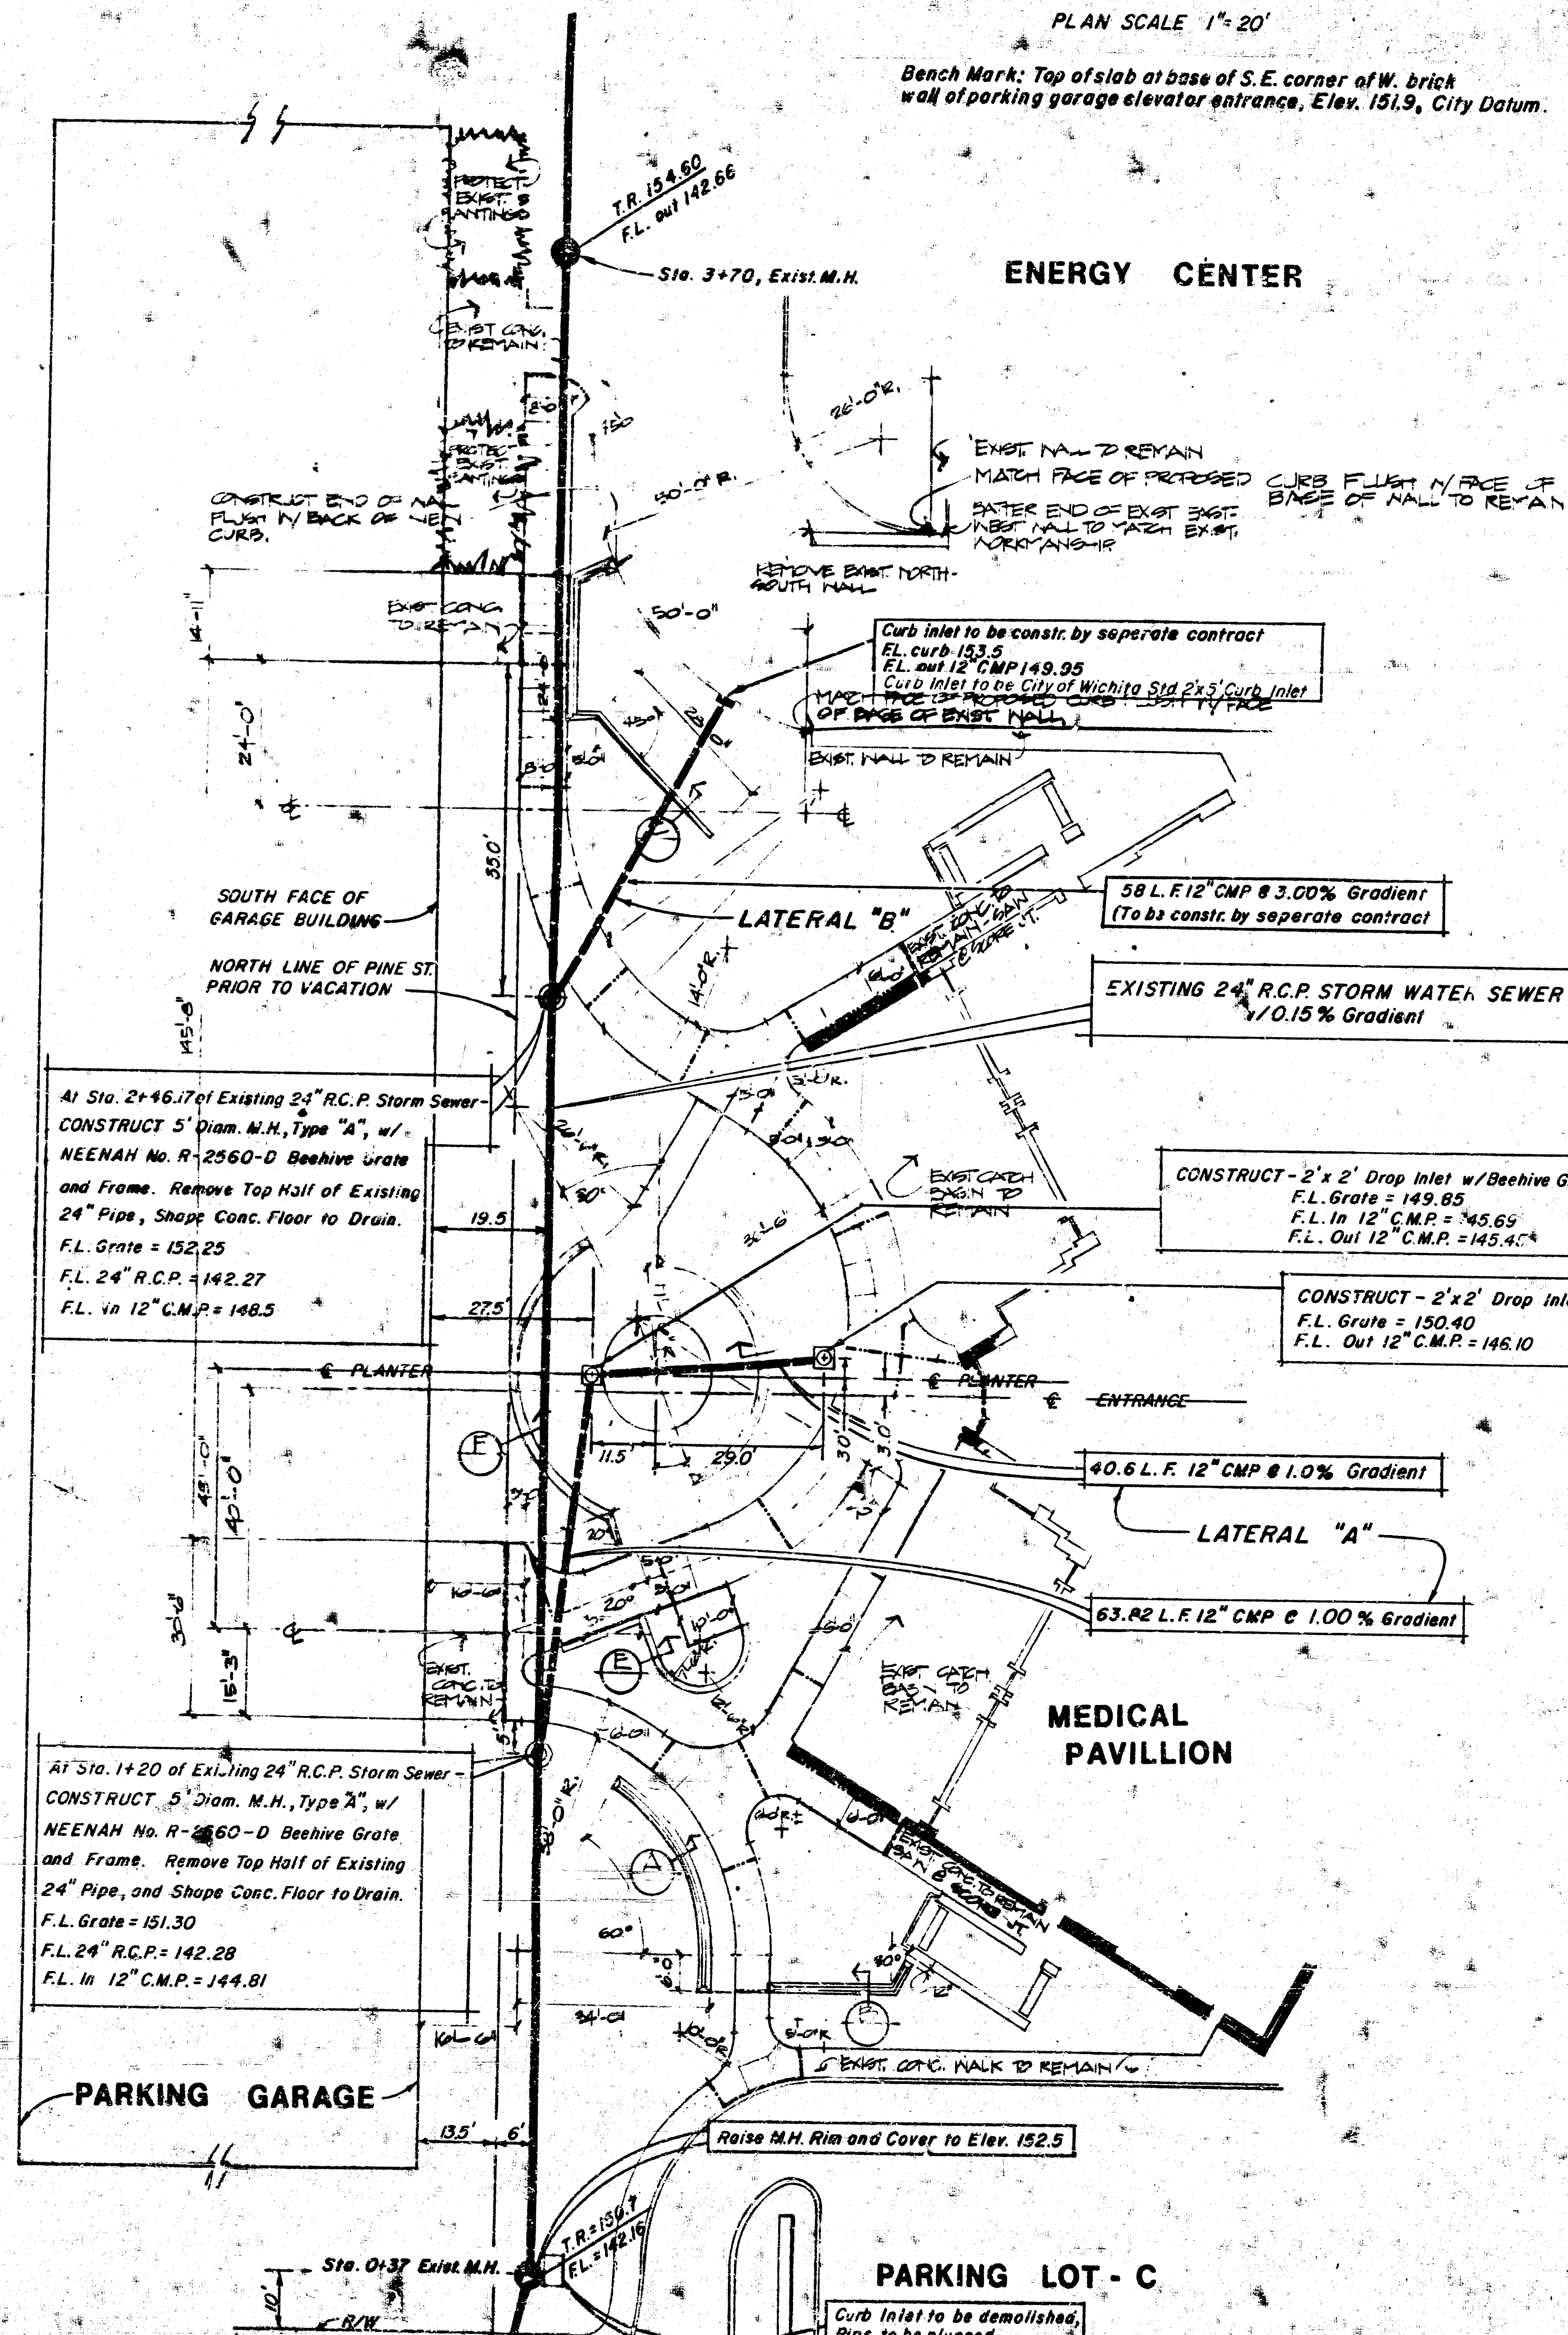

CITY OF WICHITA
ENGINEERING DEPARTMENT

Approved By *Em Schneider*
Date 8-3-76

8-3-76

APPROVED AS NOTED
By CITY ENGINEER OF WICHITA

Sanitary Sewers _____
Storm Sewers I.E.S.
Driveway Approaches _____

WV 8-6-76

NOTE TO CONTRACTOR

This project will be constructed under
the supervision of the CITY ENGINEER
and conforming to the SPECIFICATIONS
of the CITY OF WICHITA. The CON-
TRACTOR will reimburse the City of
Wichita for all cost of ~~inspection~~
Inspection.

WESLEY MEDICAL CENTER


Pedestrian Mall

SURFACE WATER DRAINAGE


Project No. DBKW 706048

MOENRING & ASSOCIATES
CONSULTING ENGINEERS
WICHITA



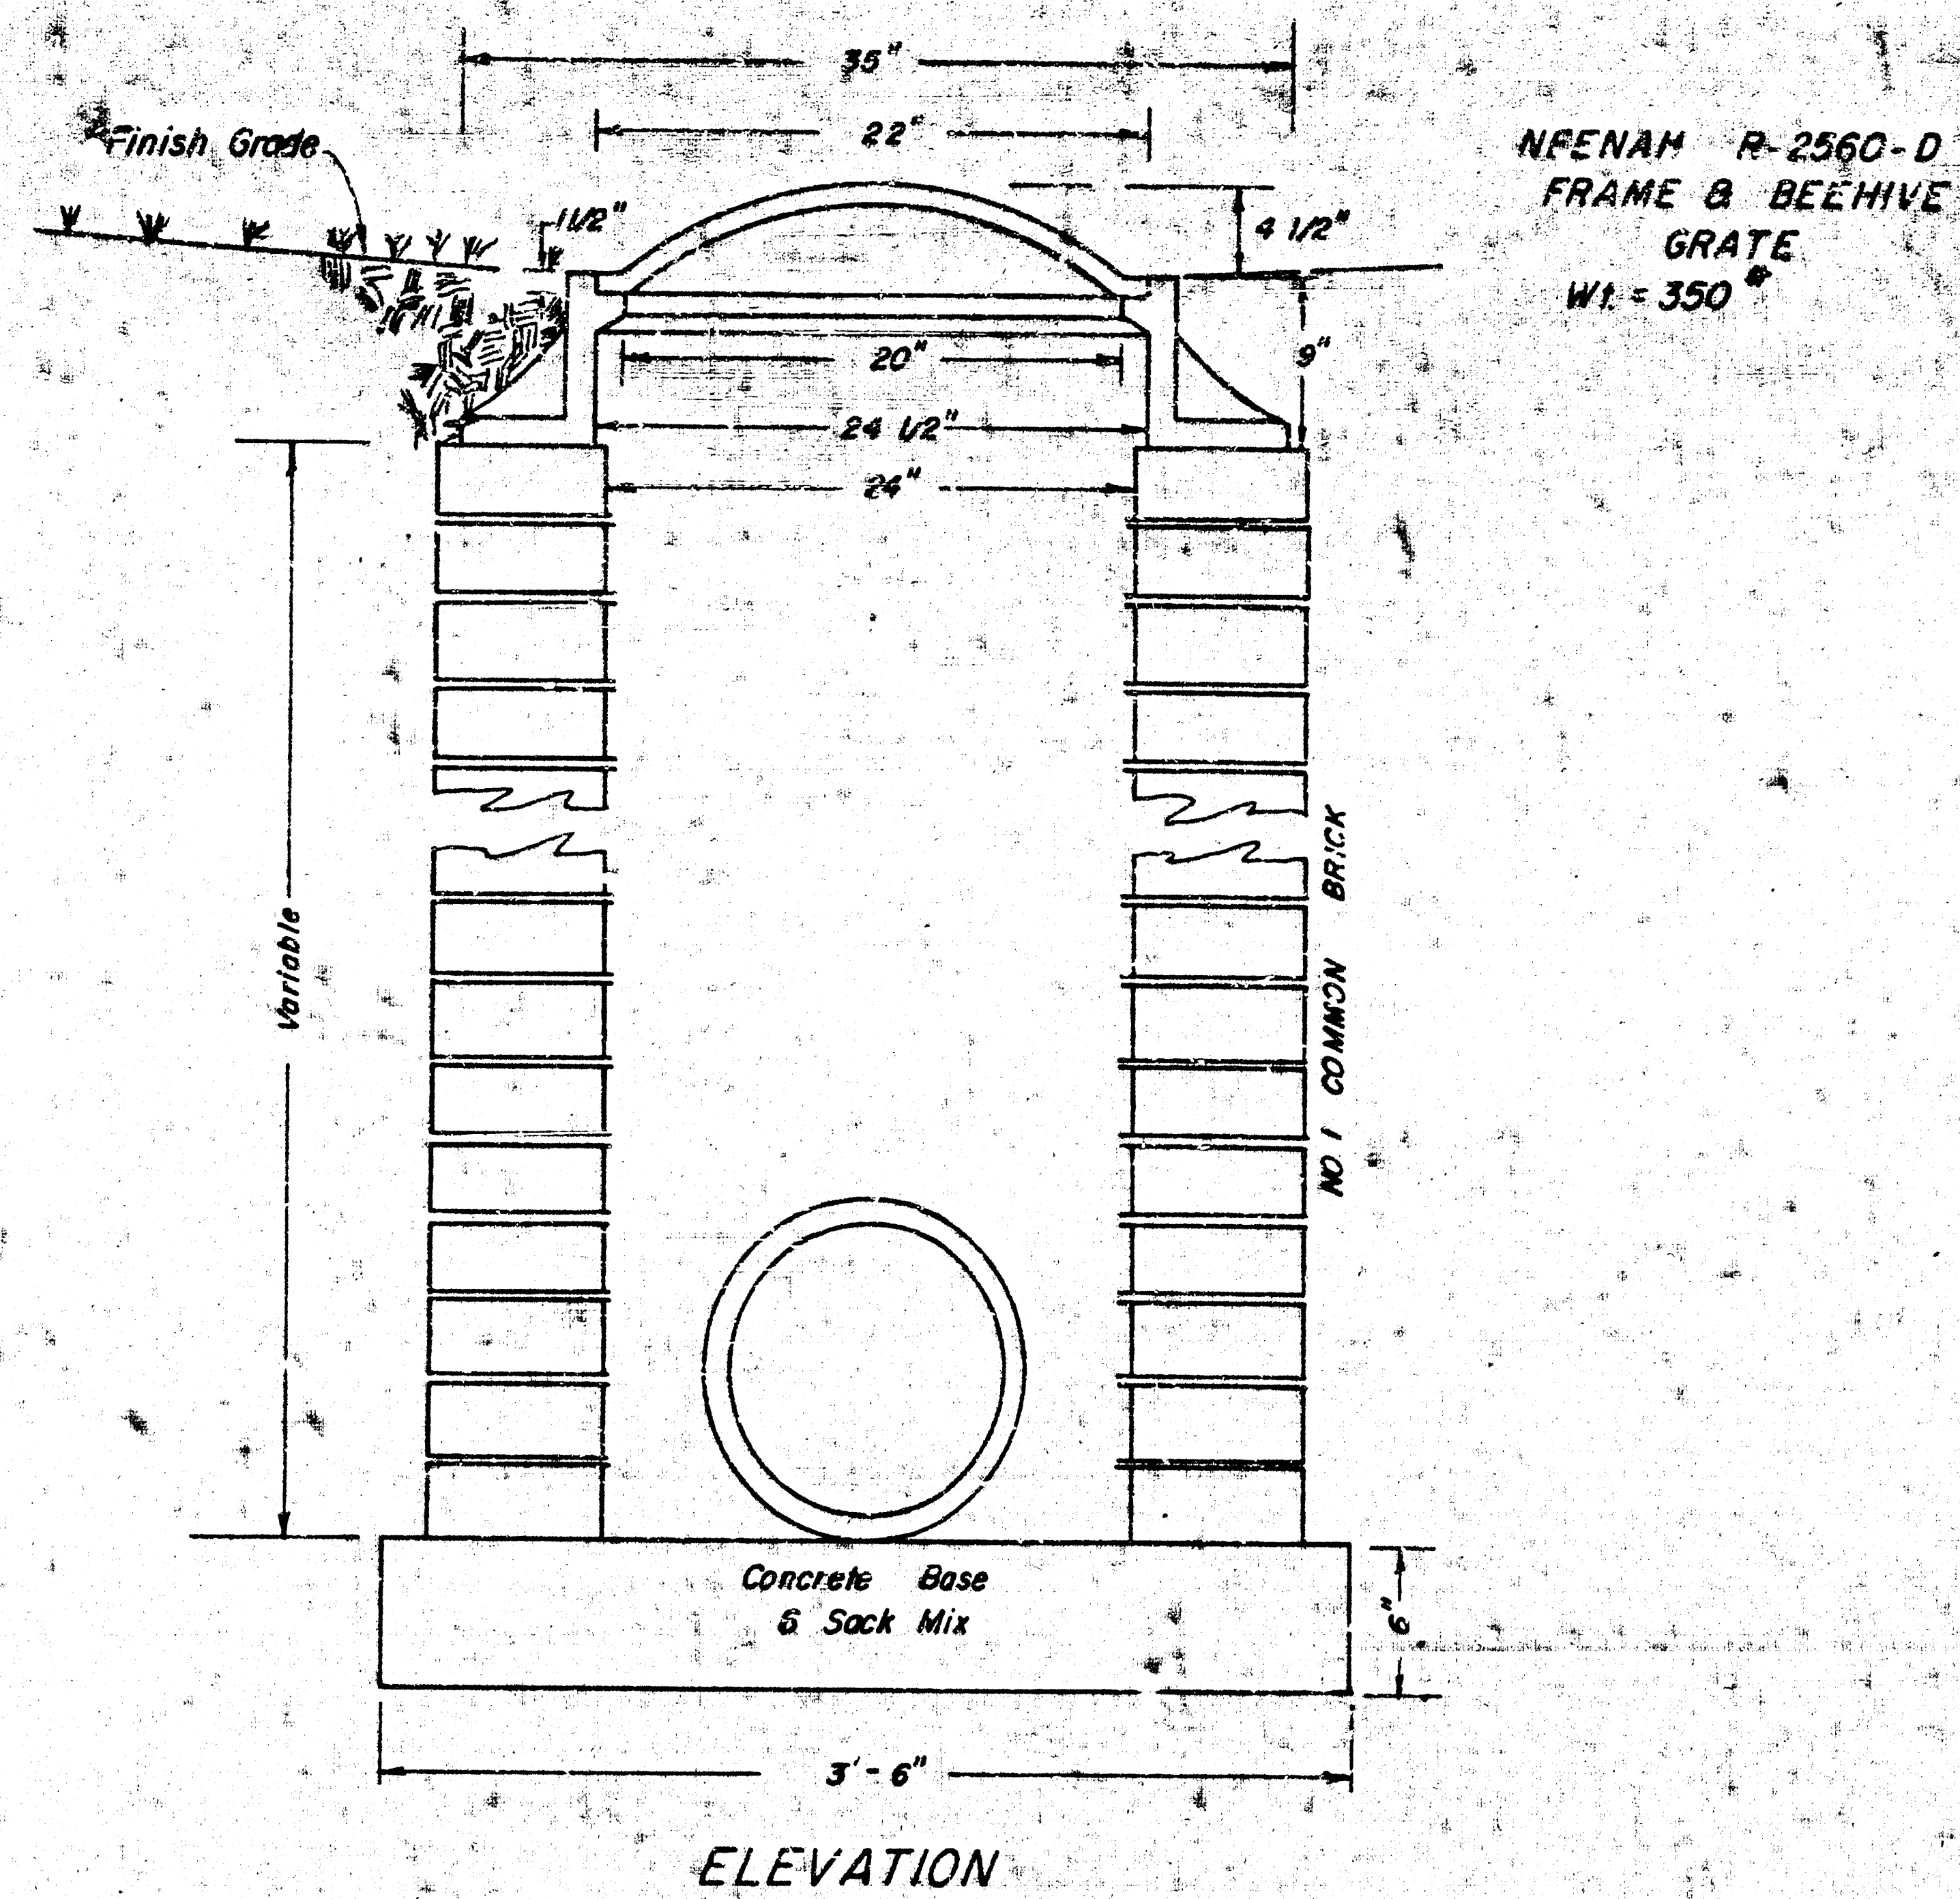

2' x 2' BRICK DROP INLET
WITH BEEHIVE GRATE

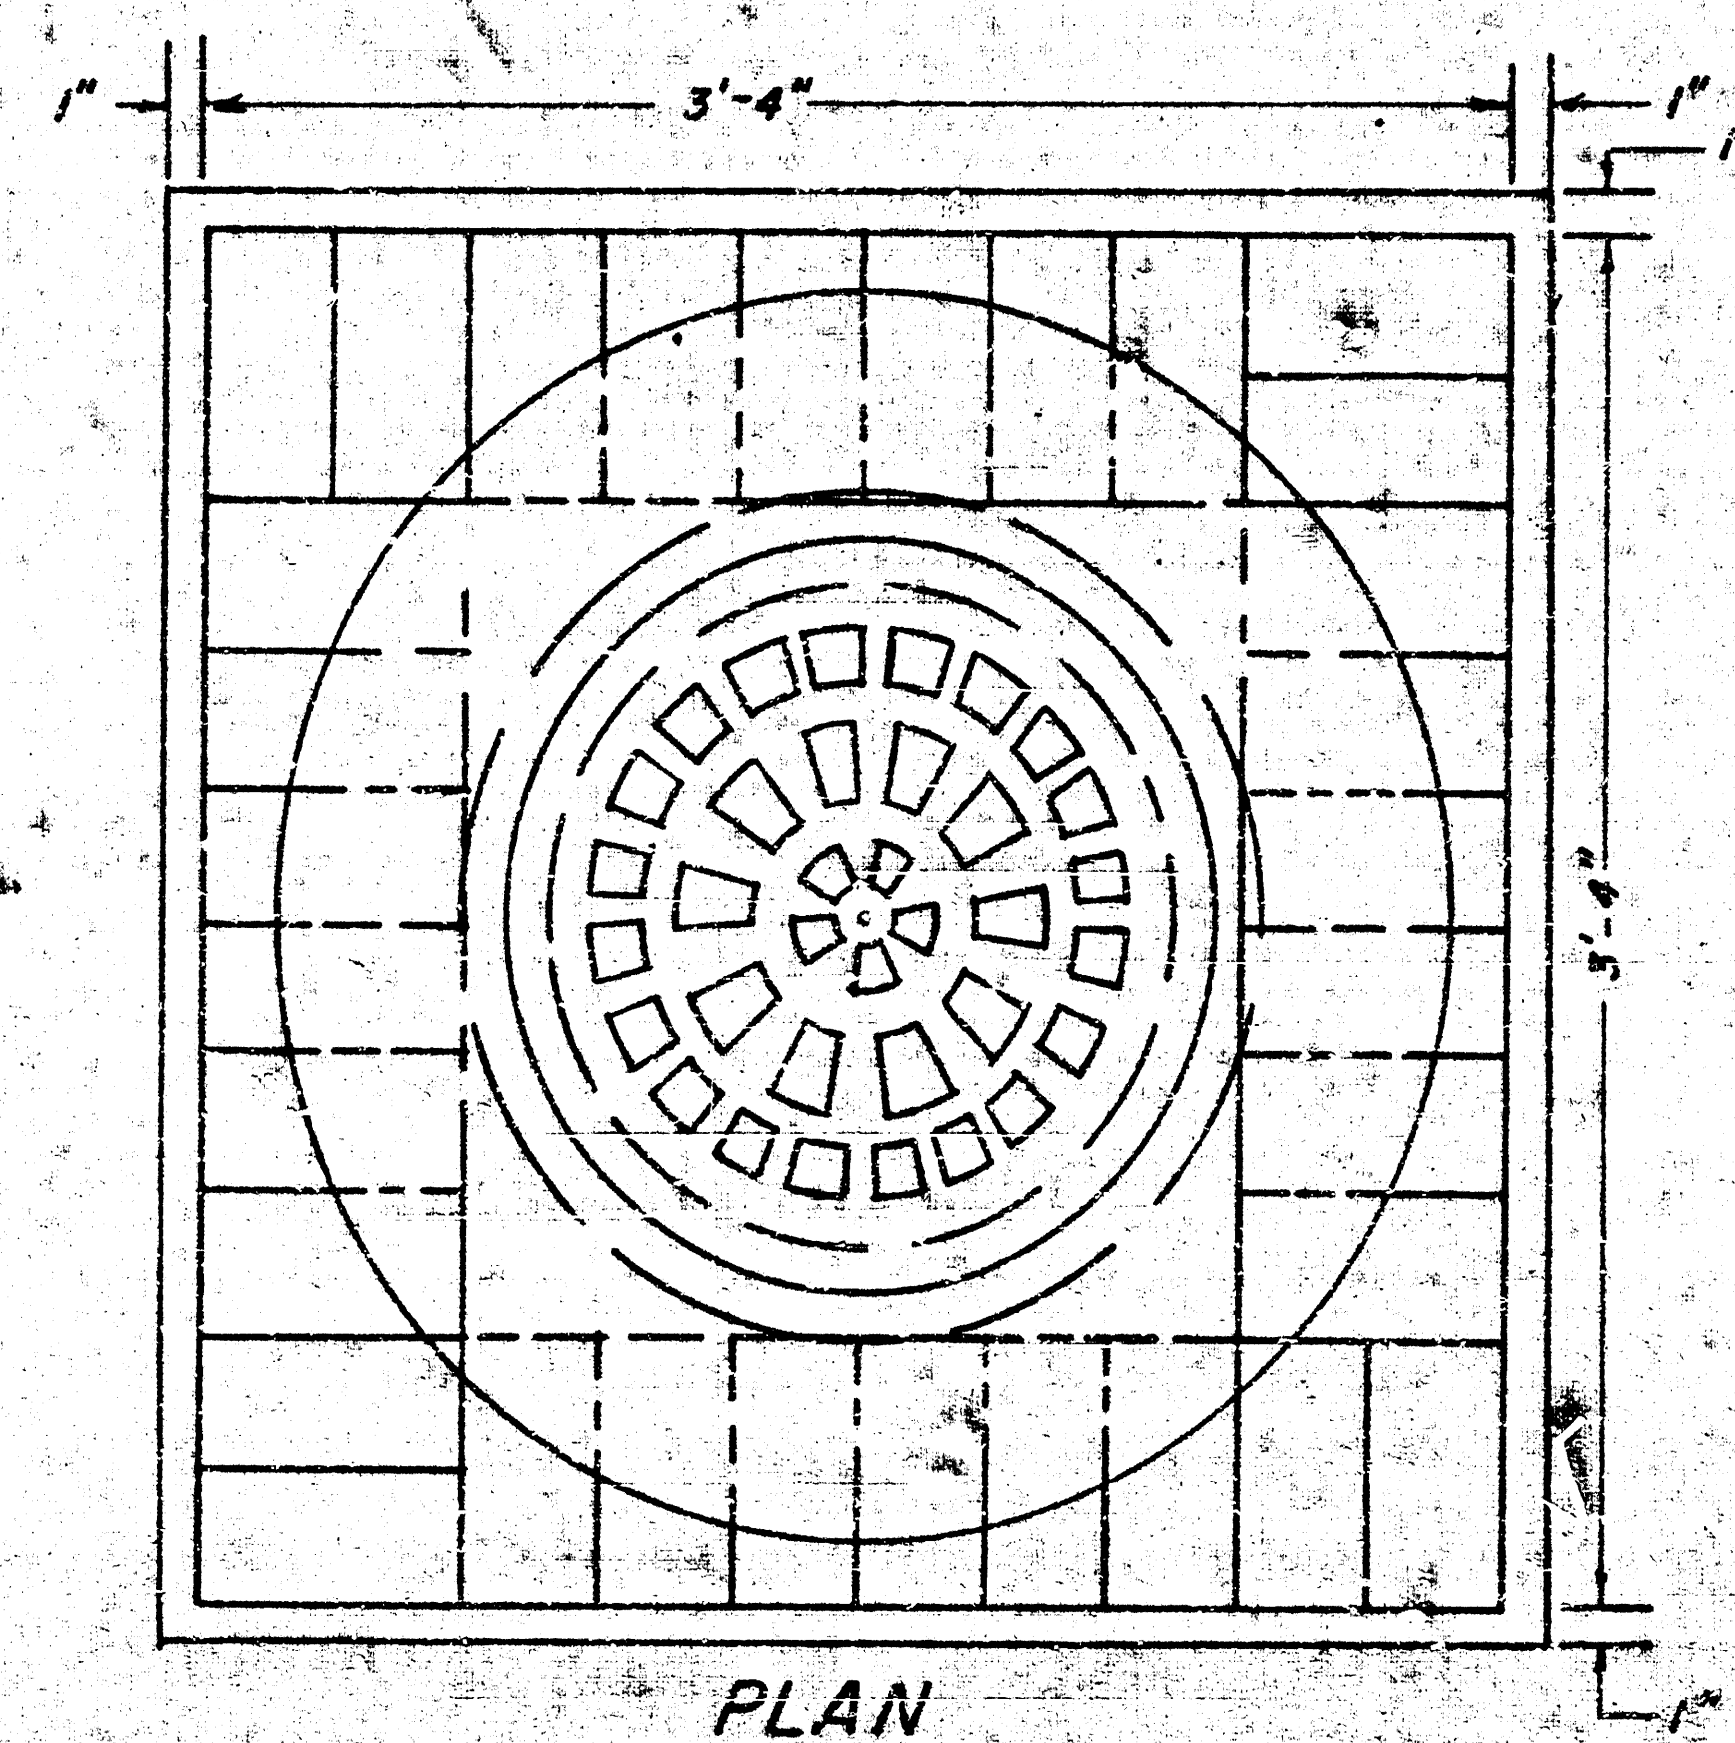

MOEHRING & ASSOCIATES
314 Brown Bldg.

CONSULTING ENGINEERS
Wichita, Kansas