


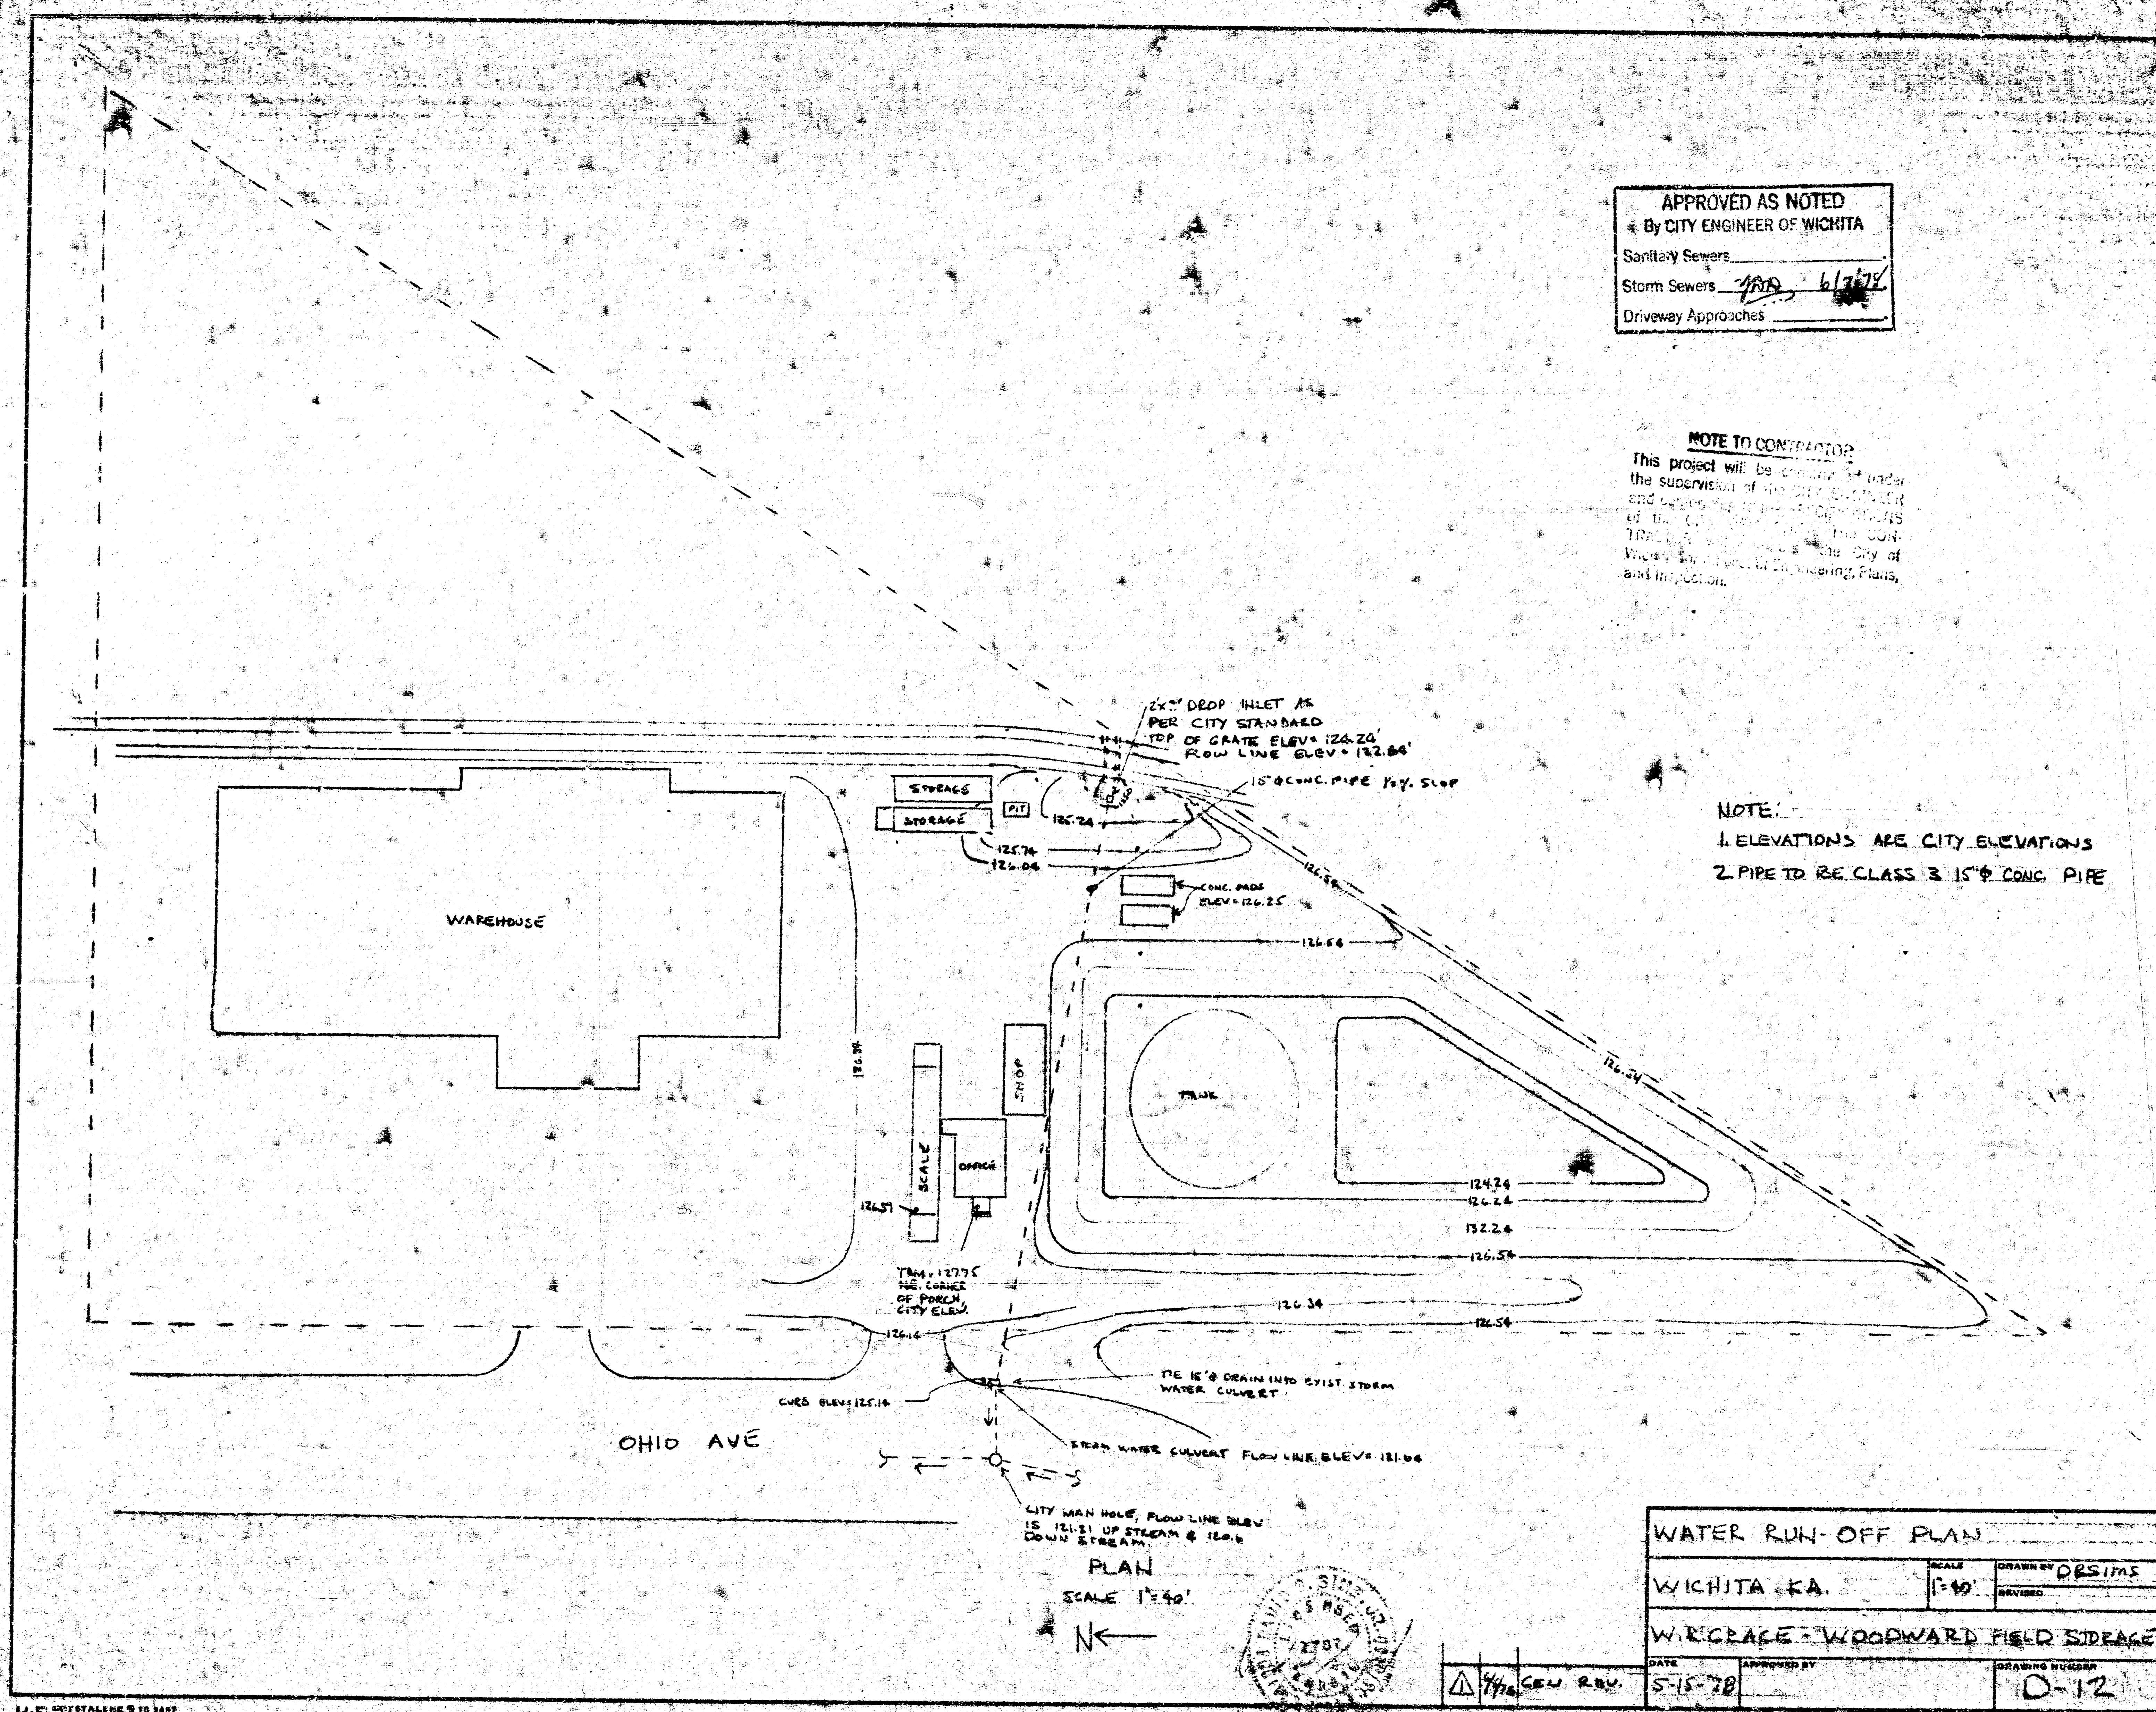

APPROVED AS NOTED
By CITY ENGINEER OF WICHITA
Sanitary Sewers
Storm Sewers 7/10/78 6/7/78
Driveway Approaches

NOTE TO CONTRACTOR
This project will be done under the supervision of the City Engineer and the City Engineer's Office. The City Engineer's Office will be responsible for the design, construction, and inspection of the project.


NOTE:
1. ELEVATIONS ARE CITY ELEVATIONS
2. PIPE TO BE CLASS 3 15\"/>

WATER RUN-OFF PLAN	
WICHITA, KA.	SCALE 1\"/>
W. CRANE - WOODWARD FIELD SIDEAGE	
DATE 5-15-78	DRAWING NUMBER D-12

PROJECT NUMBER 468-78-245-80562-000-000-008

PLAN
 1" = 40' HORIZ.
 1" = 4' VERT.

PROFILE
 1" = 4' HORIZ.
 1" = 4' VERT.

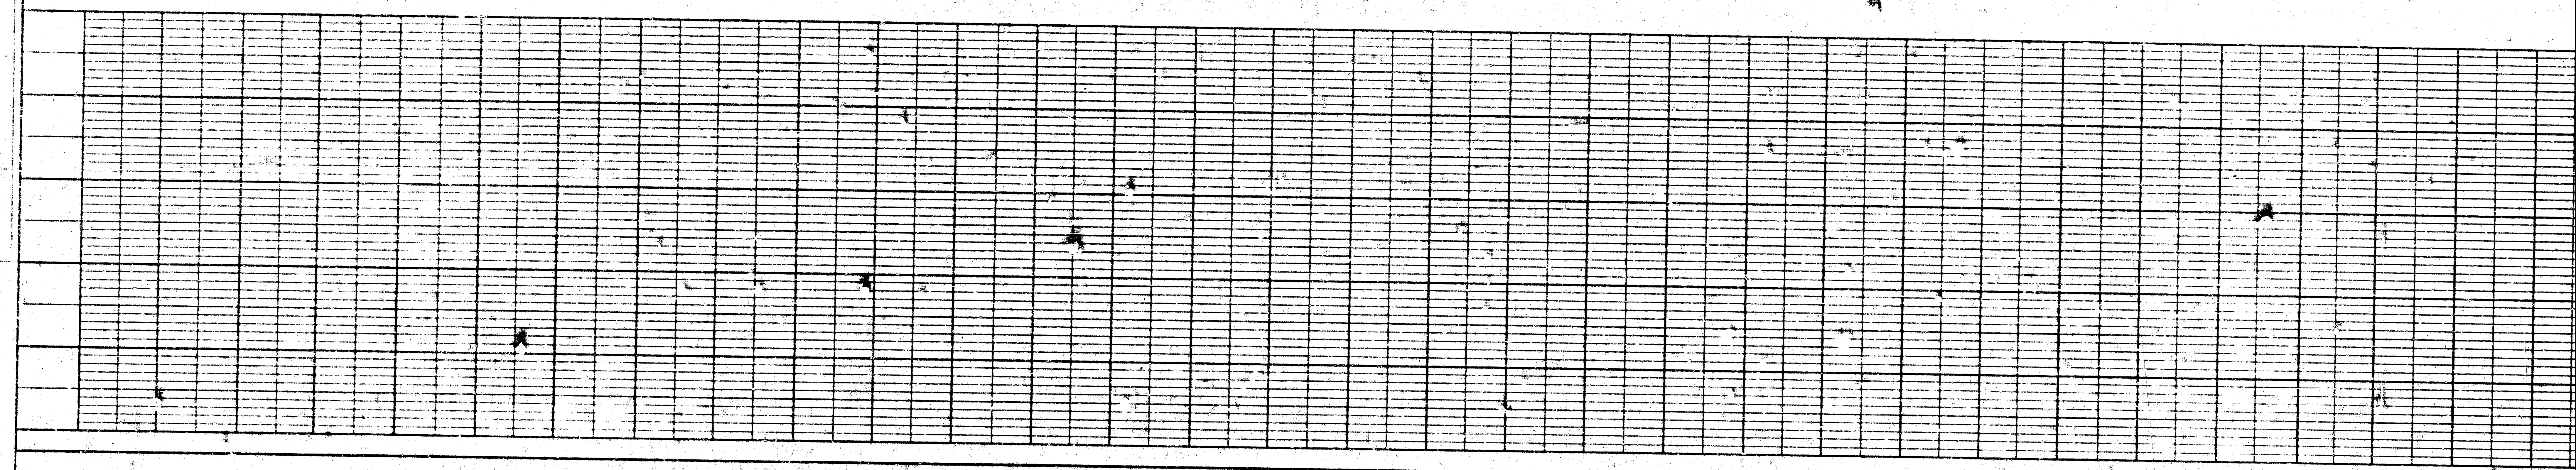

APPROVED AS NOTED
 BY CITY ENGINEER WICHITA
 DATE 6/7/78
 ENGINEER

NOTE TO CONTRACTOR
 This project will be under the supervision of the City Engineer and the contractor shall be responsible for the construction of the project in accordance with the City of Wichita Engineering Plans and Specifications.

