


HOOPER ROAD

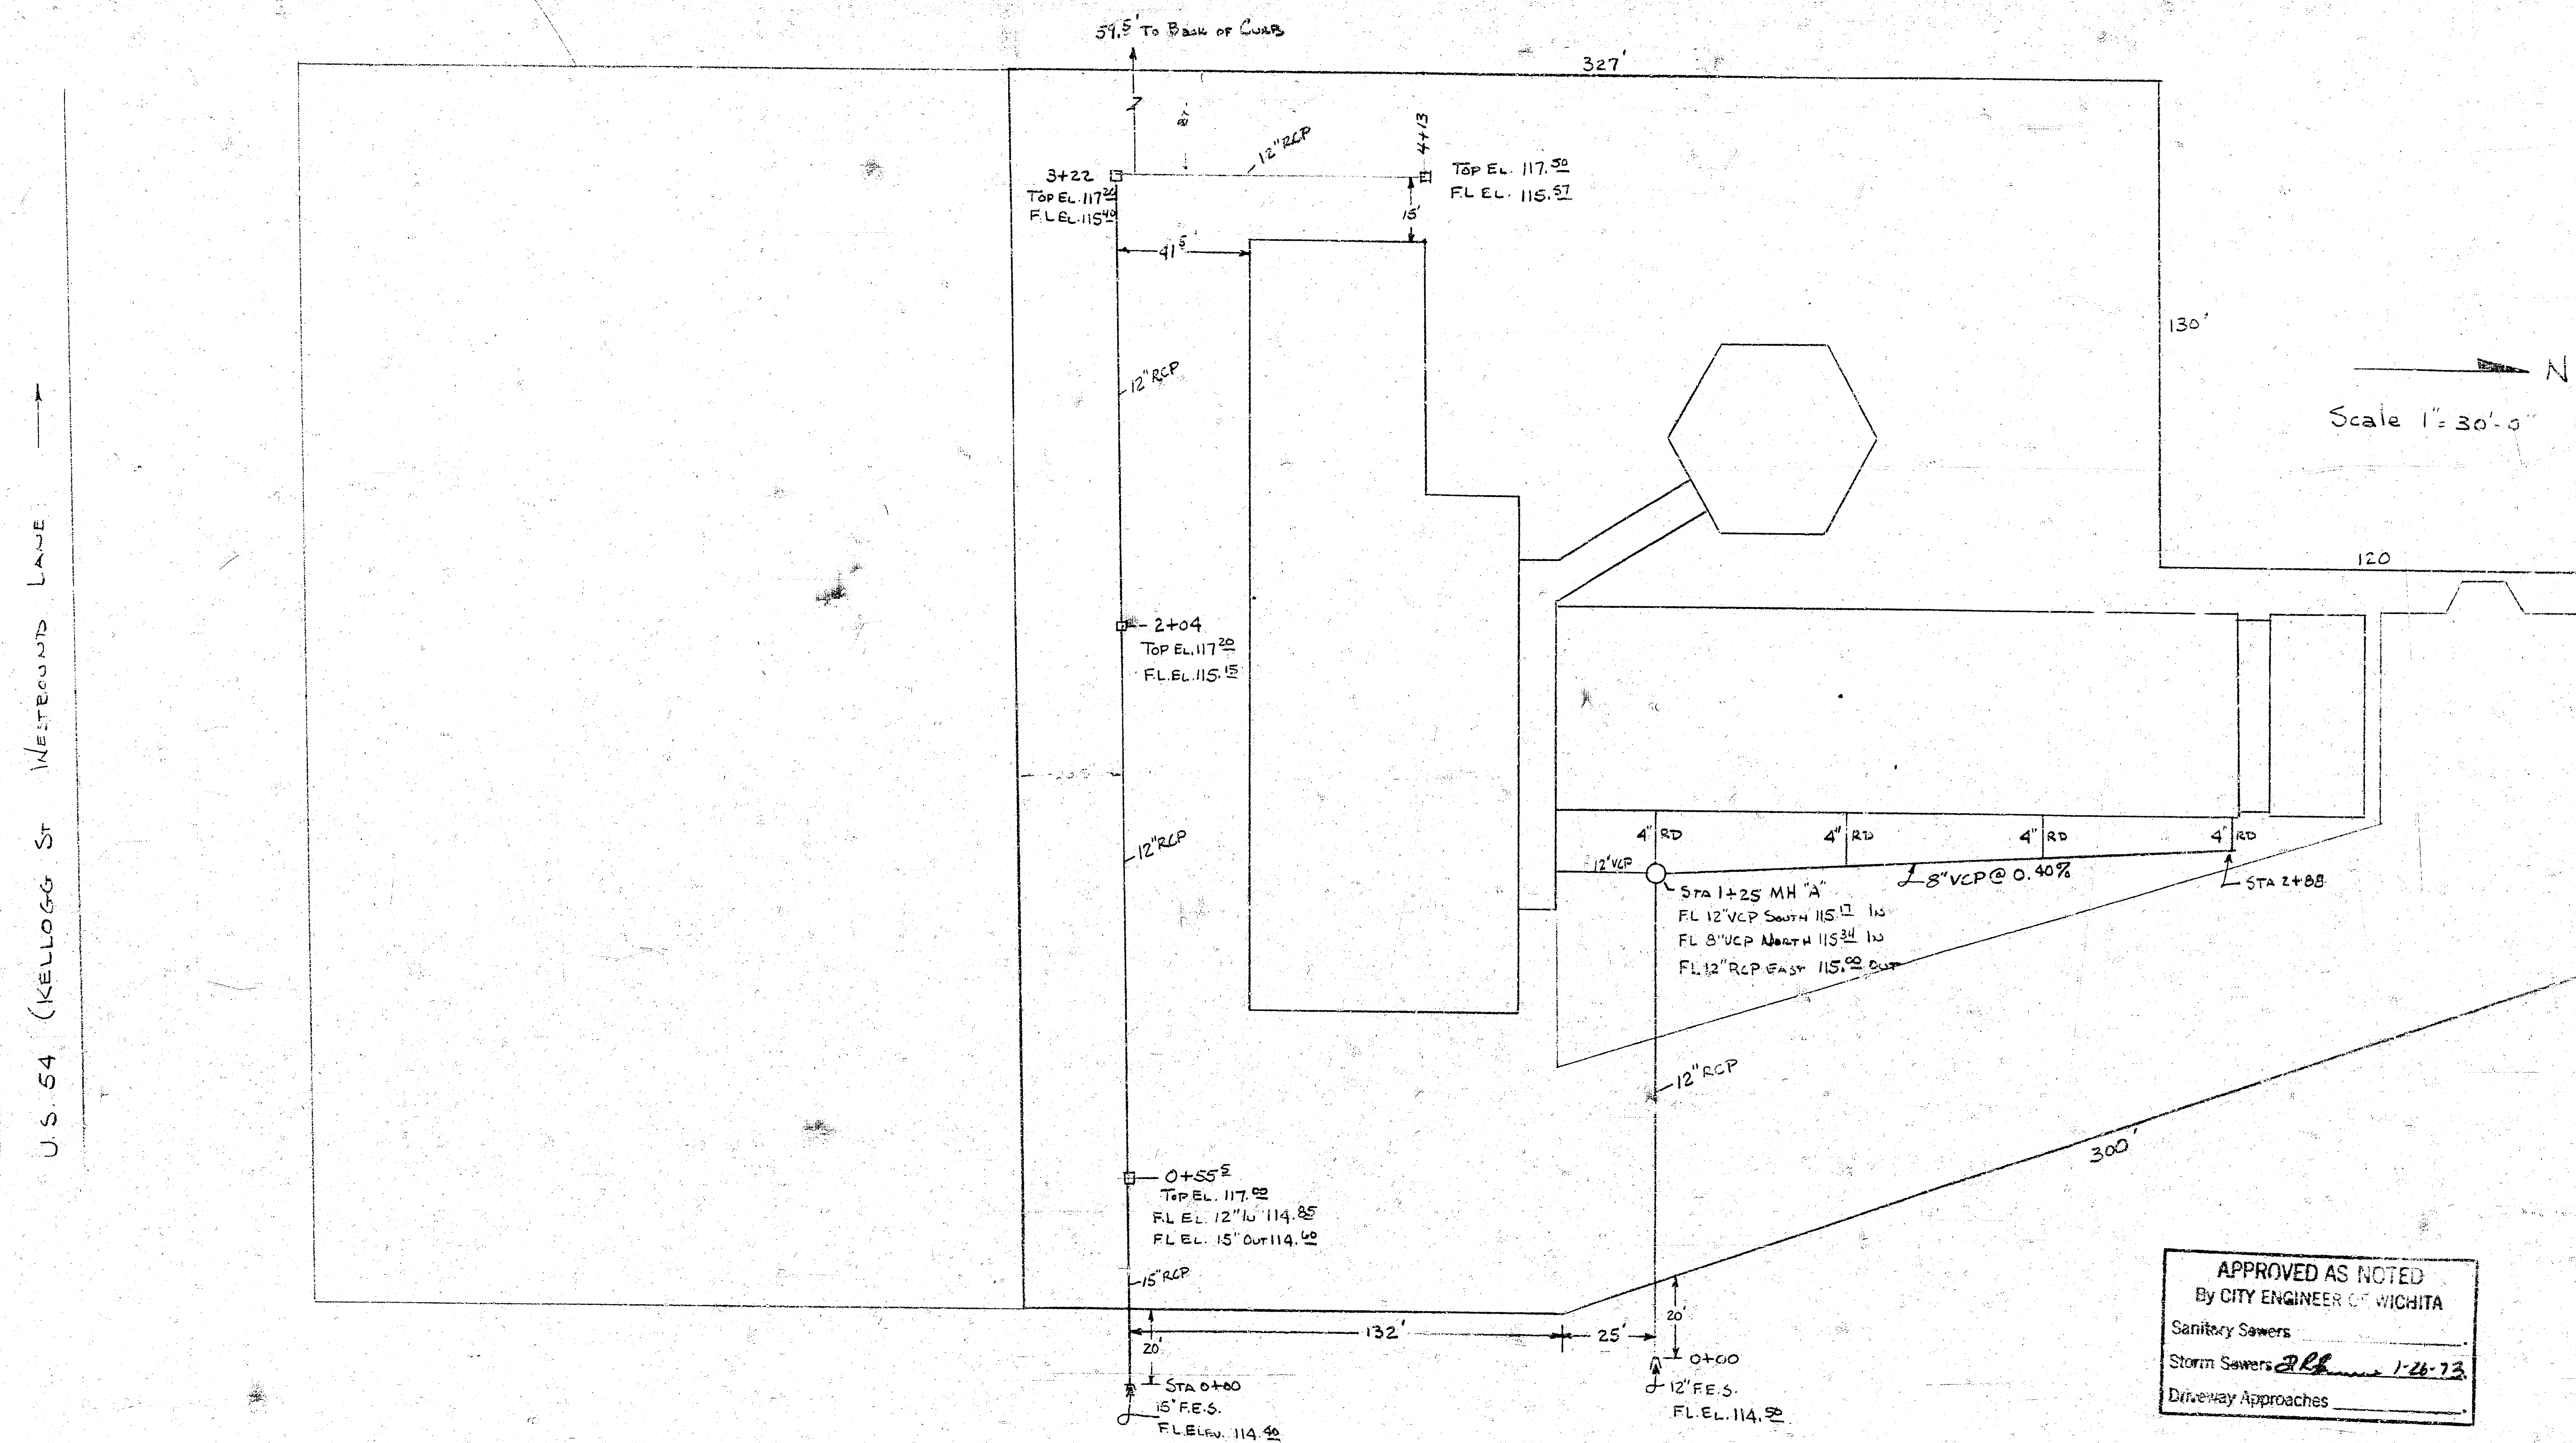

STORM SEWER QUANTITIES

15' ROP 56 L.F.

12'ACP 482 L.F.

12 VCP 25 LF

3 VCP 165 LF

MANHOLE A 1 EA

2X2 INCHES 4 EA

APPROVED AS NOTED
By CITY ENGINEER OF WICHITA

Sanitary Sewers _____
Storm Sewers RLR 1-26-73
Driveway Approaches _____

NOTE TO CONTRACTOR

This project will be constructed under the supervision of the CITY ENGINEER and conforming to the SPECIFICATIONS of the CITY OF WICHITA. The CONTRACTOR will reimburse the City of Wichita for all cost of Engineering, Plans, and Inspection.

WICHITA SHERATON INN - KANSAS

PLOT PLAN
STORM DRAINAGE
MID STATES CONST. CO., INC
NOVEMBER - 1972 AS BUILT DRAWING