




PLAN	NOTES	DATE
1	1	
2	2	
3	3	
4	4	
5	5	
6	6	
7	7	
8	8	
9	9	
10	10	

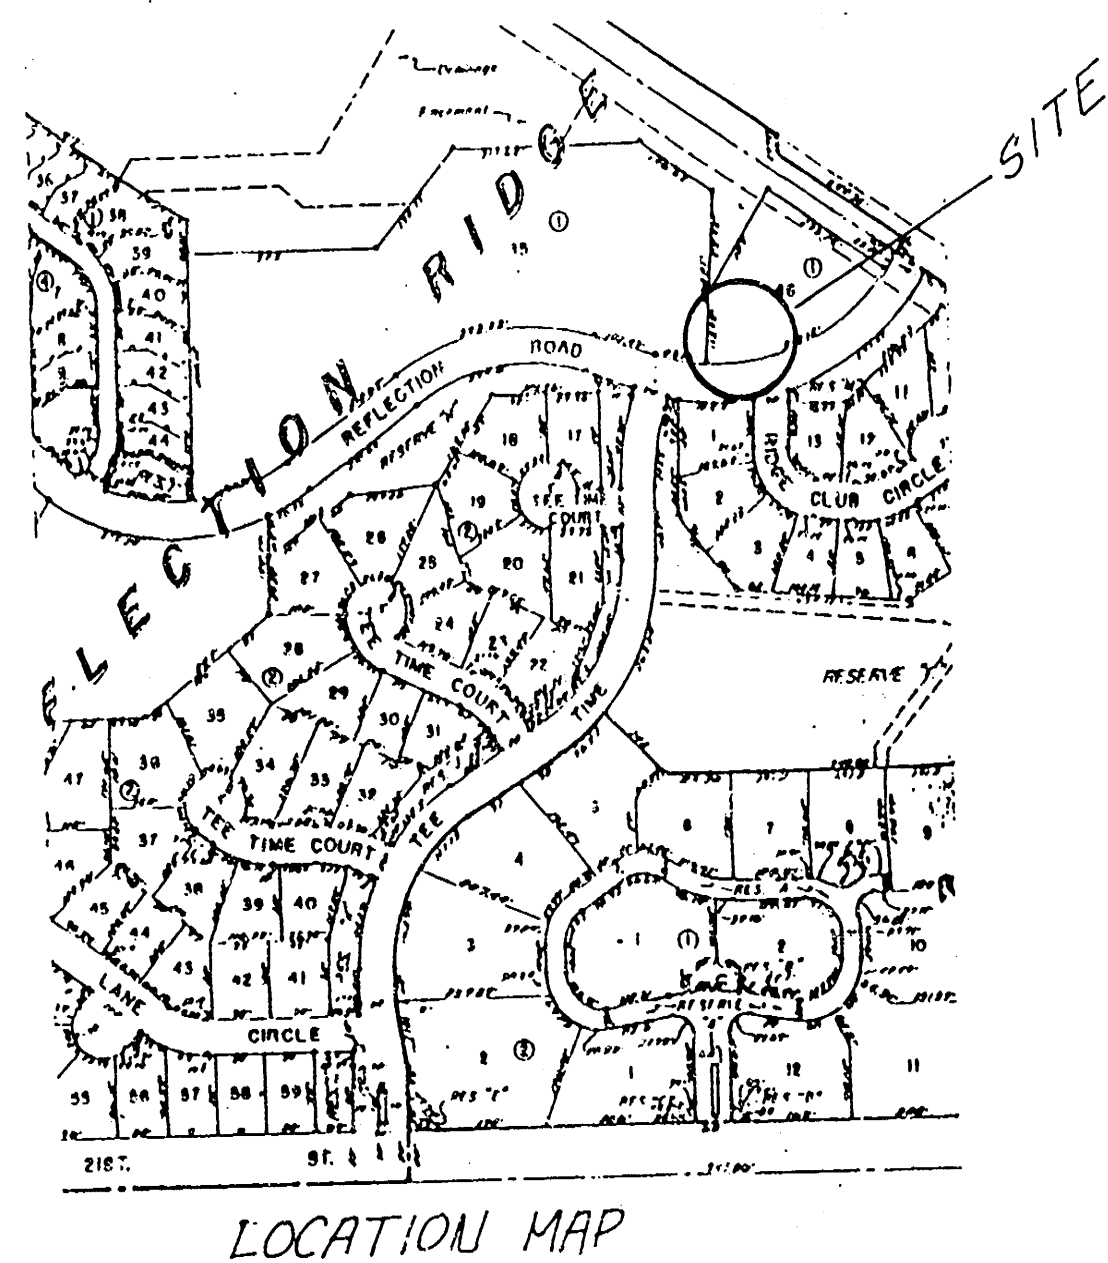

Bench Mark:
Chiseled "H" Cut Top of Curb
West of inlet
Elev. = 143.15

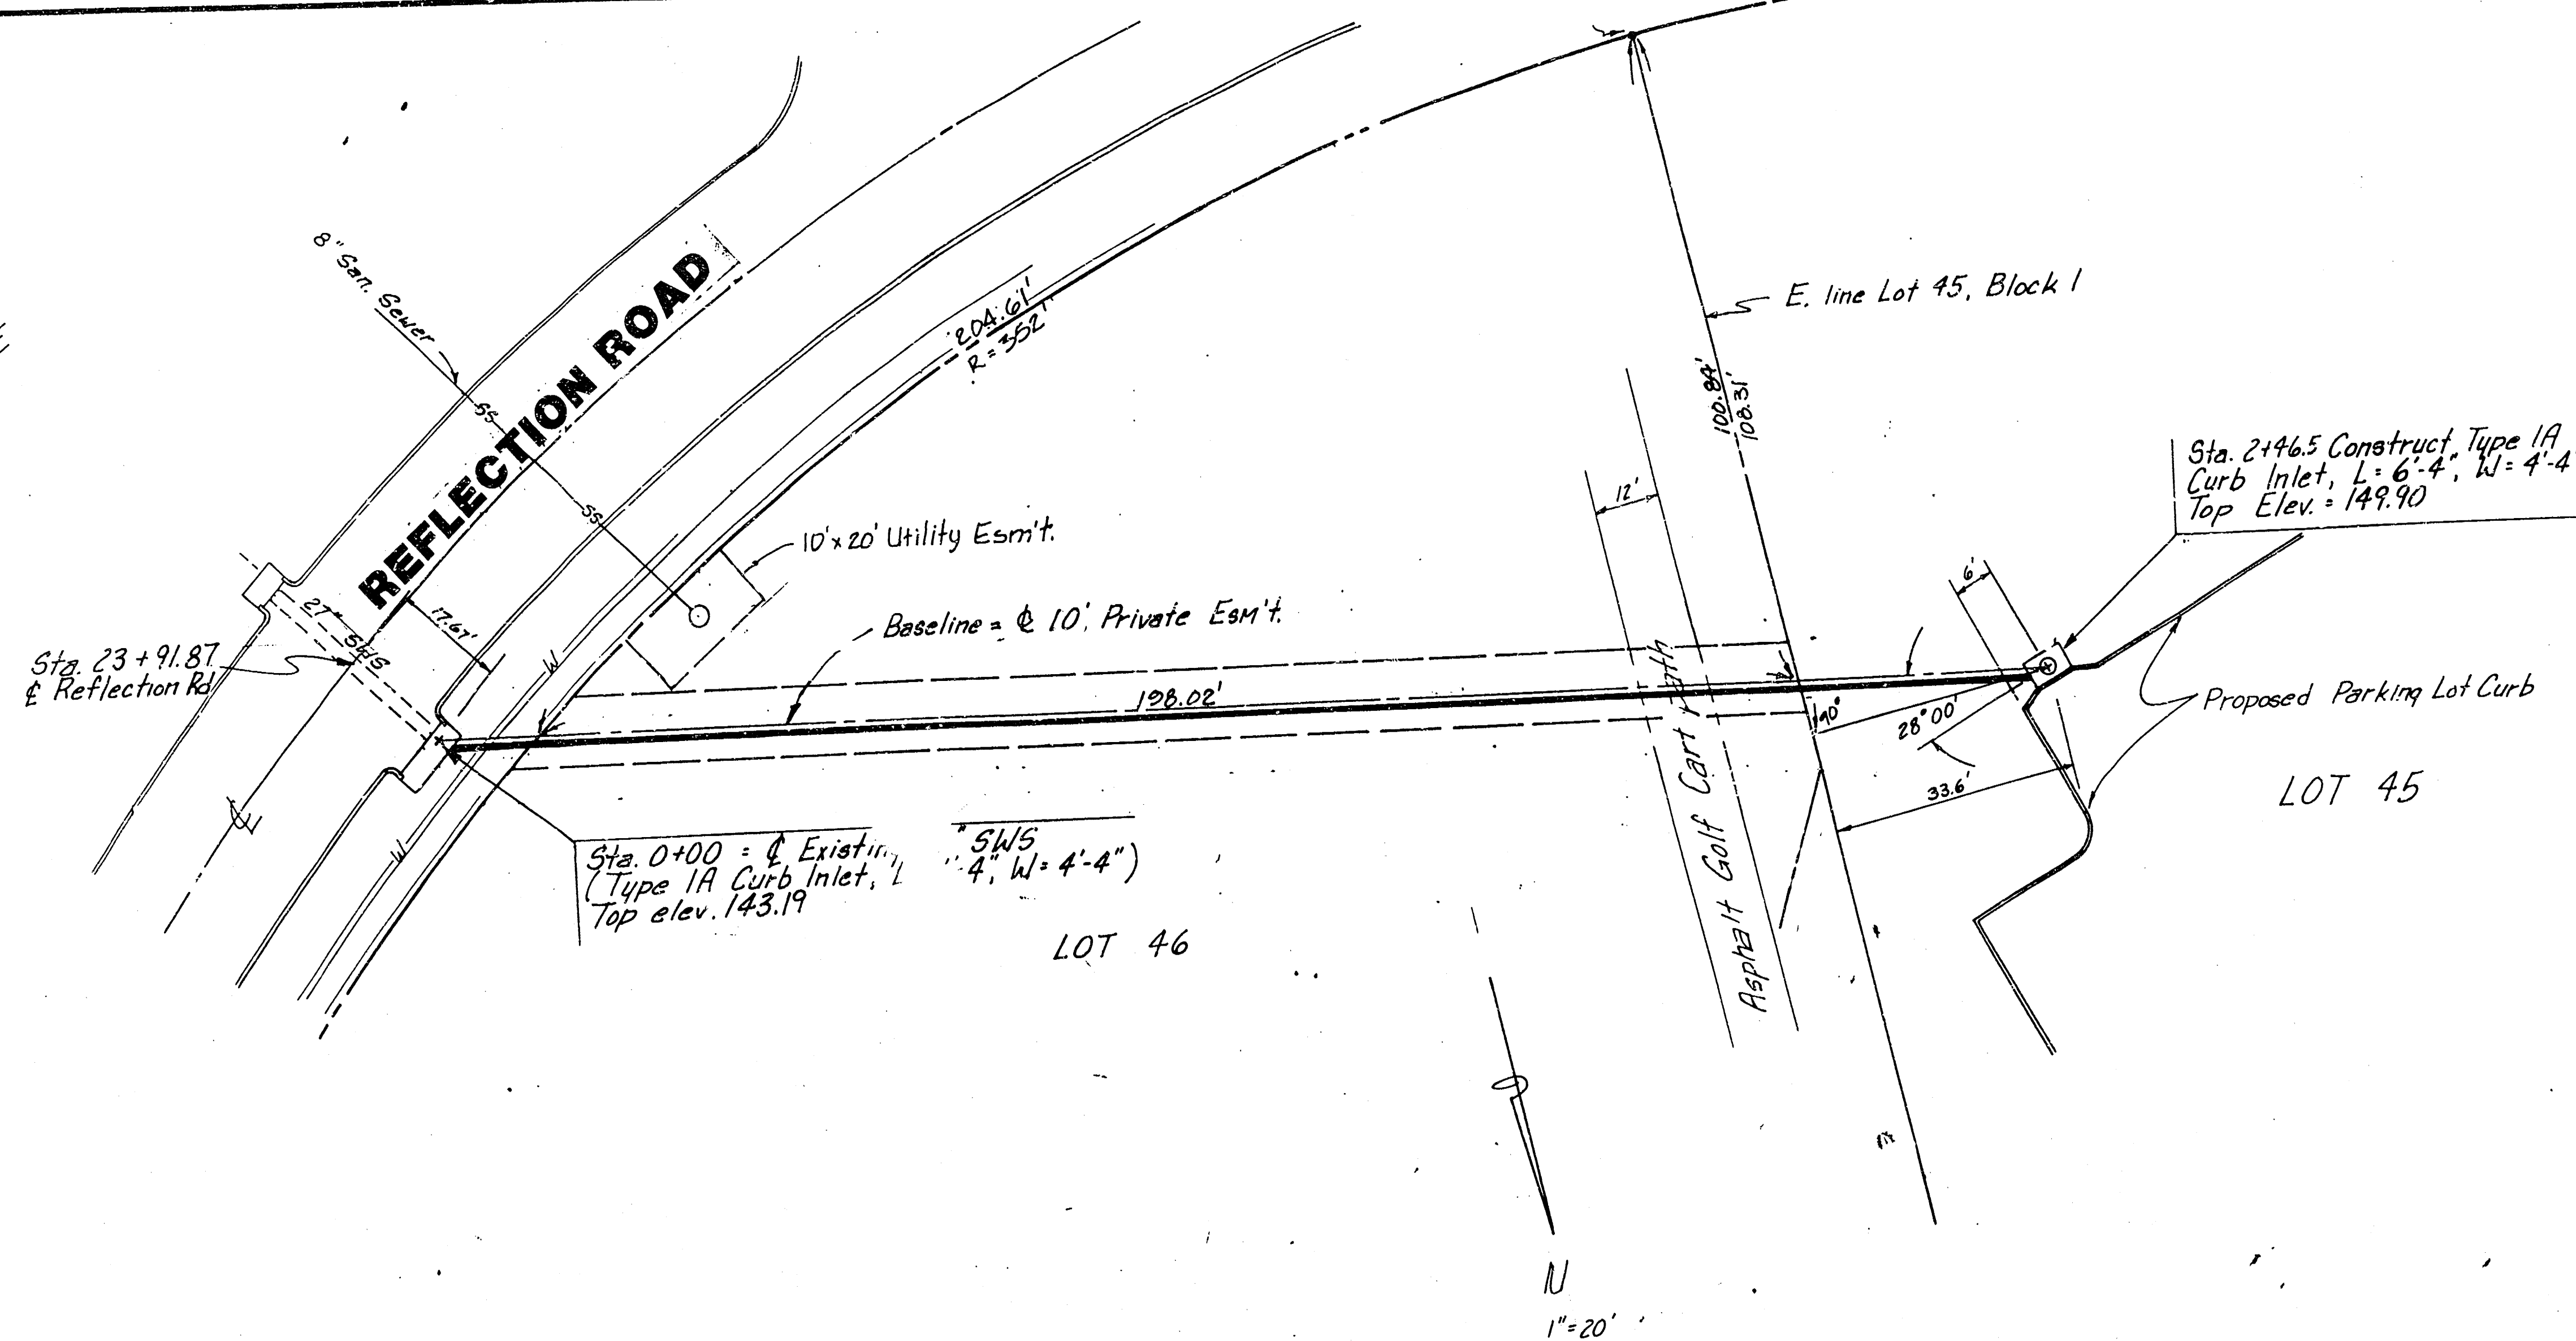

PROFILE	NOTES	DATE
1	1	
2	2	
3	3	
4	4	
5	5	
6	6	
7	7	
8	8	
9	9	
10	10	

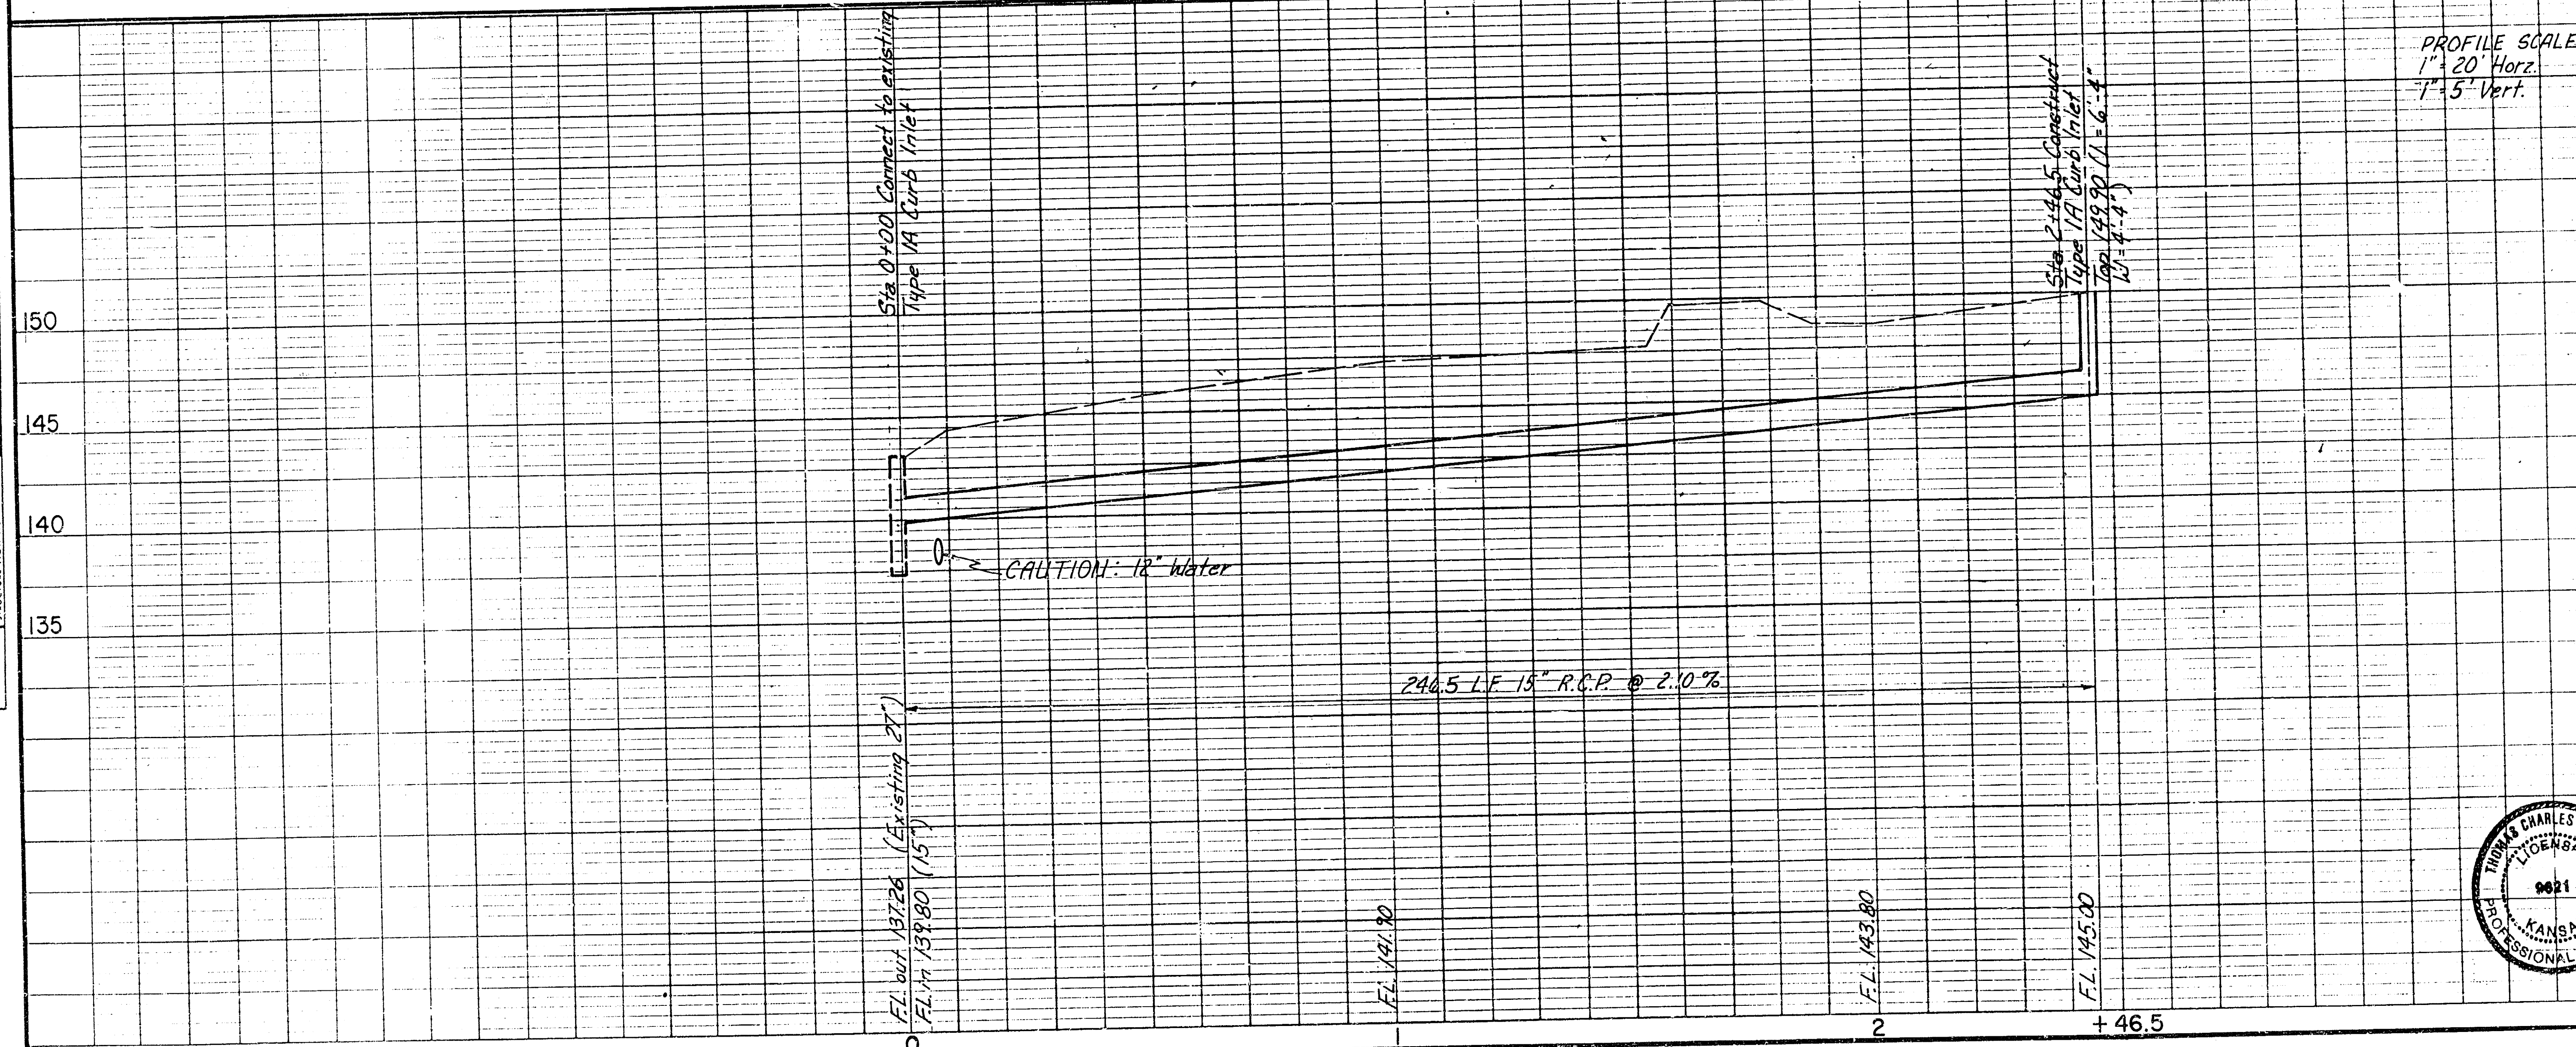


PROFILE SCALE
1" = 20' Horiz.
1" = 5' Vert.

APPROVED AS NOTED
By CITY ENGINEER OF WICHITA

Sanitary Sewers _____
Storm Sewers 2/1/89
Driveway Approaches _____
Water Mains _____
Paving _____

NOTE TO CONTRACTOR

INSPECTION AND TESTING FOR THIS PROJECT IS TO BE PROVIDED BY A LICENSED CONSULTING ENGINEERING FIRM UNDER CONTRACT WITH THE OWNER/DEVELOPER. SAID INSPECTION TO BE IN ACCORDANCE WITH THE CITY OF WICHITA STANDARD CONSTRUCTION ENGINEERING PRACTICES AND CERTIFIED BY A LICENSED PROFESSIONAL ENGINEER. NO WORK SHALL BE PERFORMED IN DEDICATED EASEMENTS OR PUBLIC RIGHT-OF-WAY BY THE CONTRACTOR WITHOUT SUCH INSPECTION NOR SHALL ANY WORK BE COMMENCED WITHOUT WRITTEN AUTHORIZATION BY THE CITY ENGINEER.

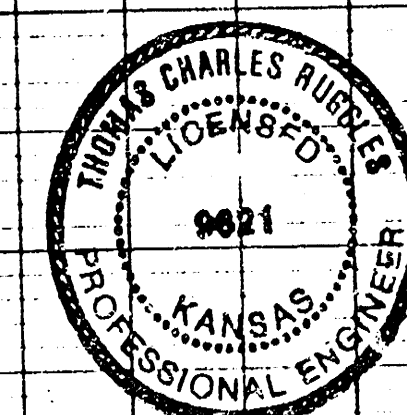



Revised easement 7-28-89

PRIVATE STORM WATER SEWER
REFLECTION RIDGE CLUBHOUSE
WICHITA, KANSAS
INDEX CODE: 220PFS 607853

BAUGHMAN COMPANY, P.A.
SURVEYING & ENGINEERING
3102022-7271 • 315 ELLIS • WICHITA, KANSAS 67211


Design: TCR Drawn: DSN Approved: Date: 7-6-89 Scale: 1" = 20'

PLAN	NOTES	DATE
NO. 1	DATE	
NO. 2	DATE	
NO. 3	DATE	
NO. 4	DATE	
NO. 5	DATE	
NO. 6	DATE	
NO. 7	DATE	
NO. 8	DATE	
NO. 9	DATE	
NO. 10	DATE	

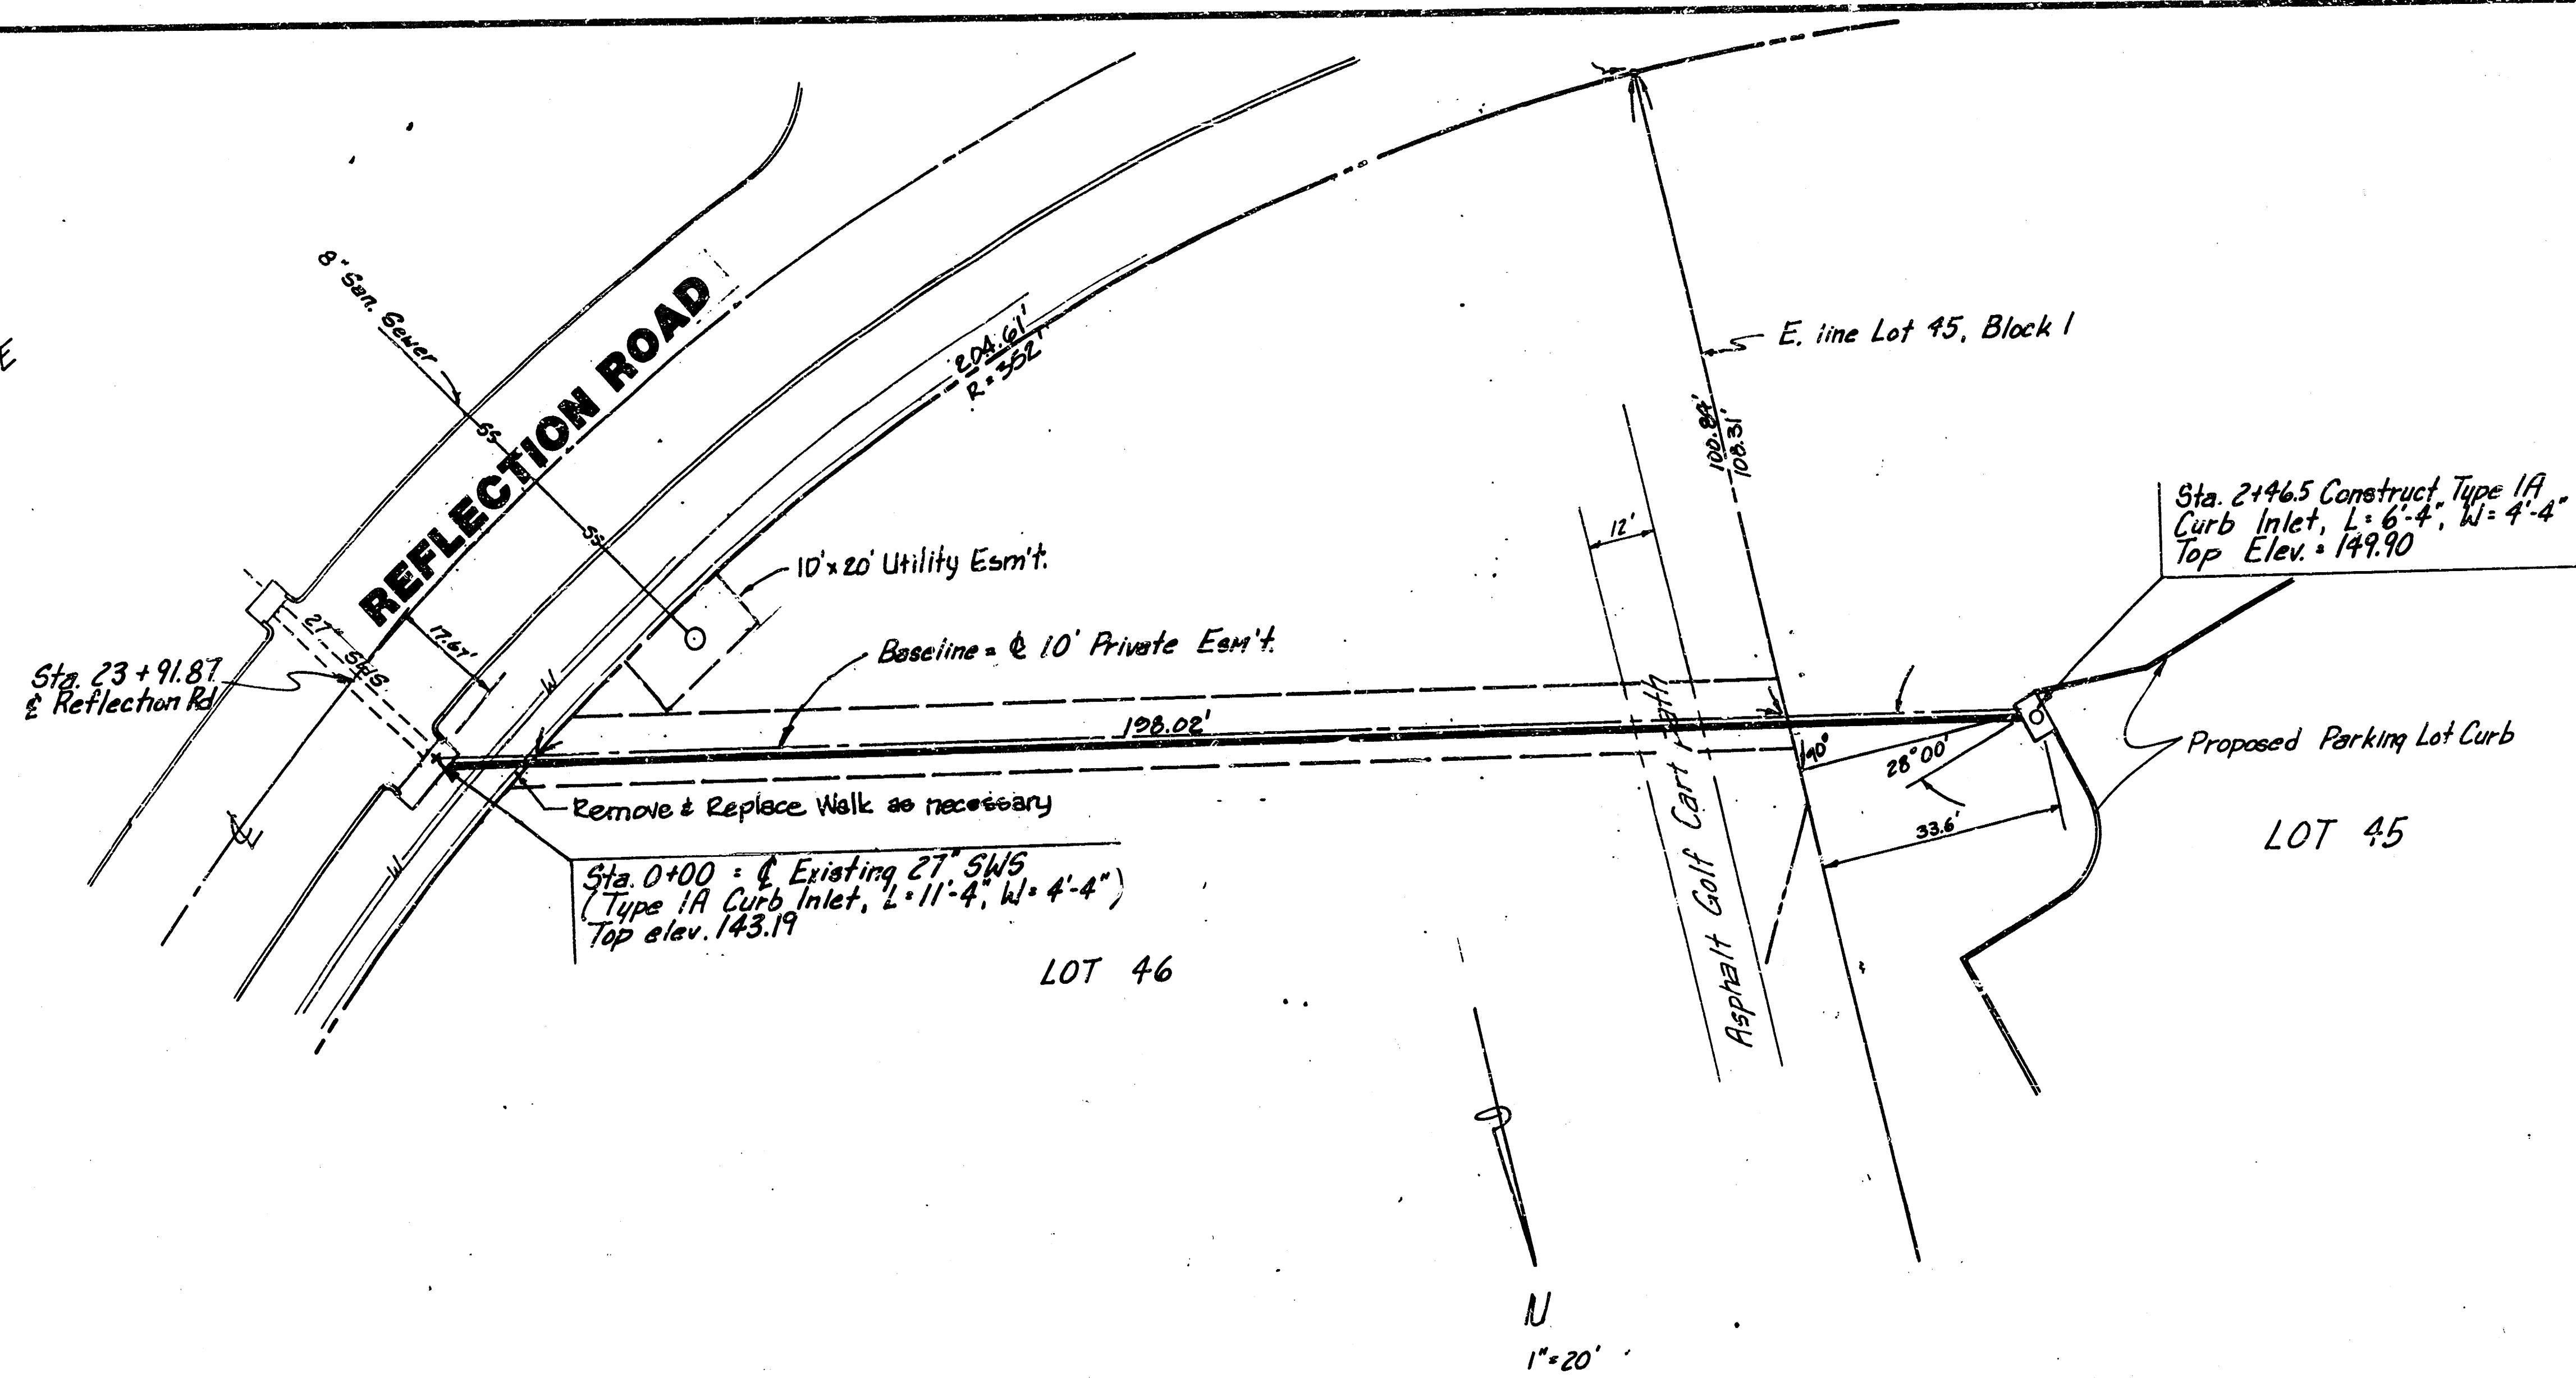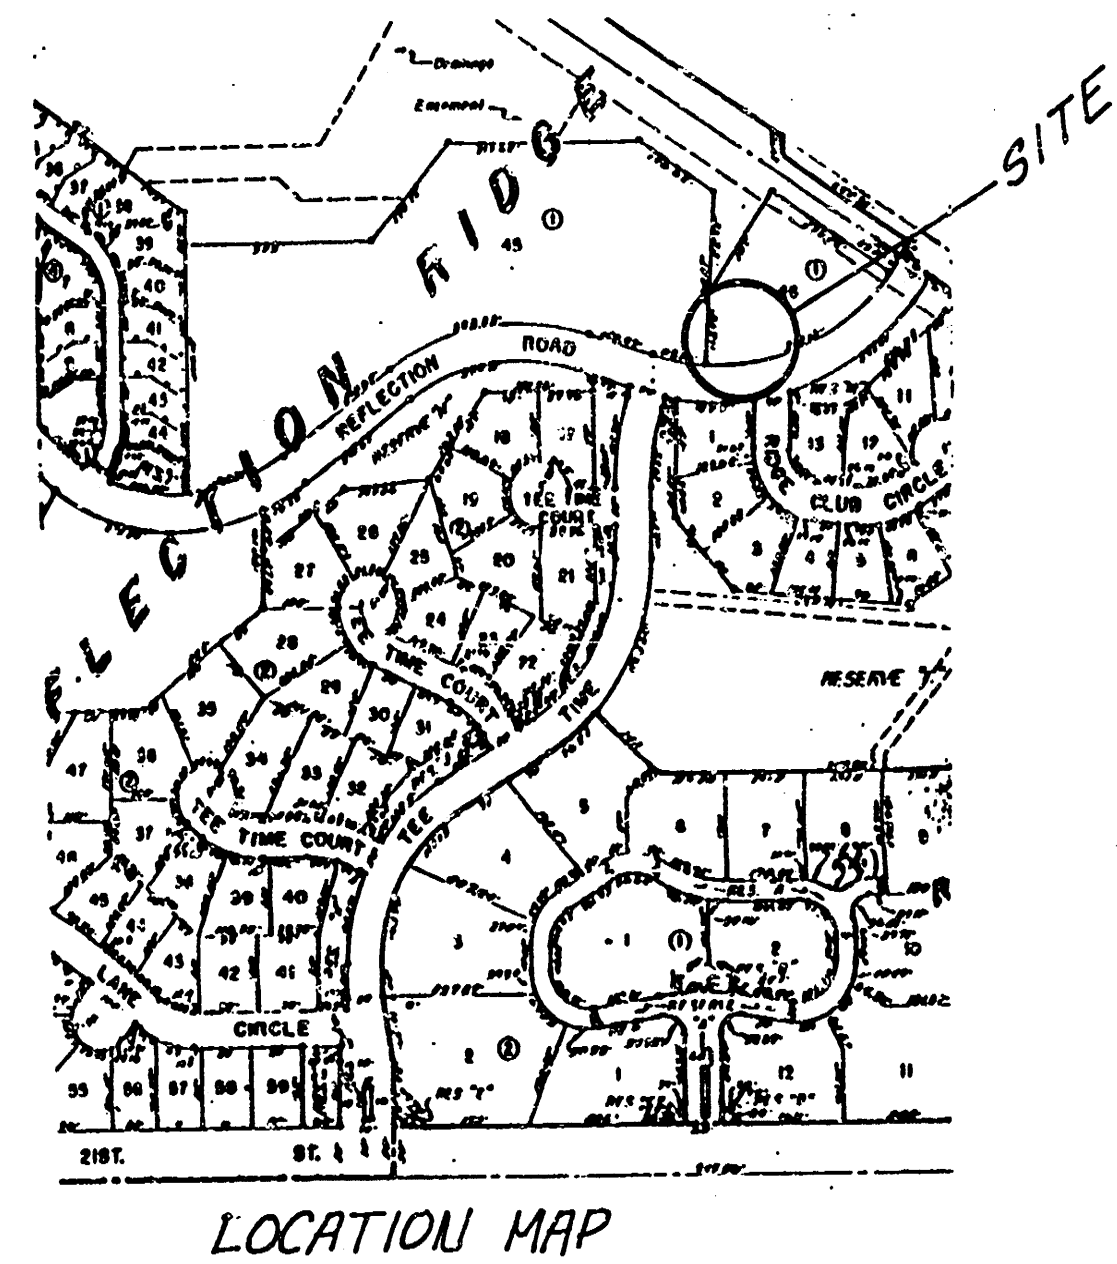

Bench Mark:
Chisled "H" Cut Top of Curb
West of inlet
Elev. = 143.15

PROFILE	NOTES	DATE
NO. 1	DATE	
NO. 2	DATE	
NO. 3	DATE	
NO. 4	DATE	
NO. 5	DATE	
NO. 6	DATE	
NO. 7	DATE	
NO. 8	DATE	
NO. 9	DATE	
NO. 10	DATE	

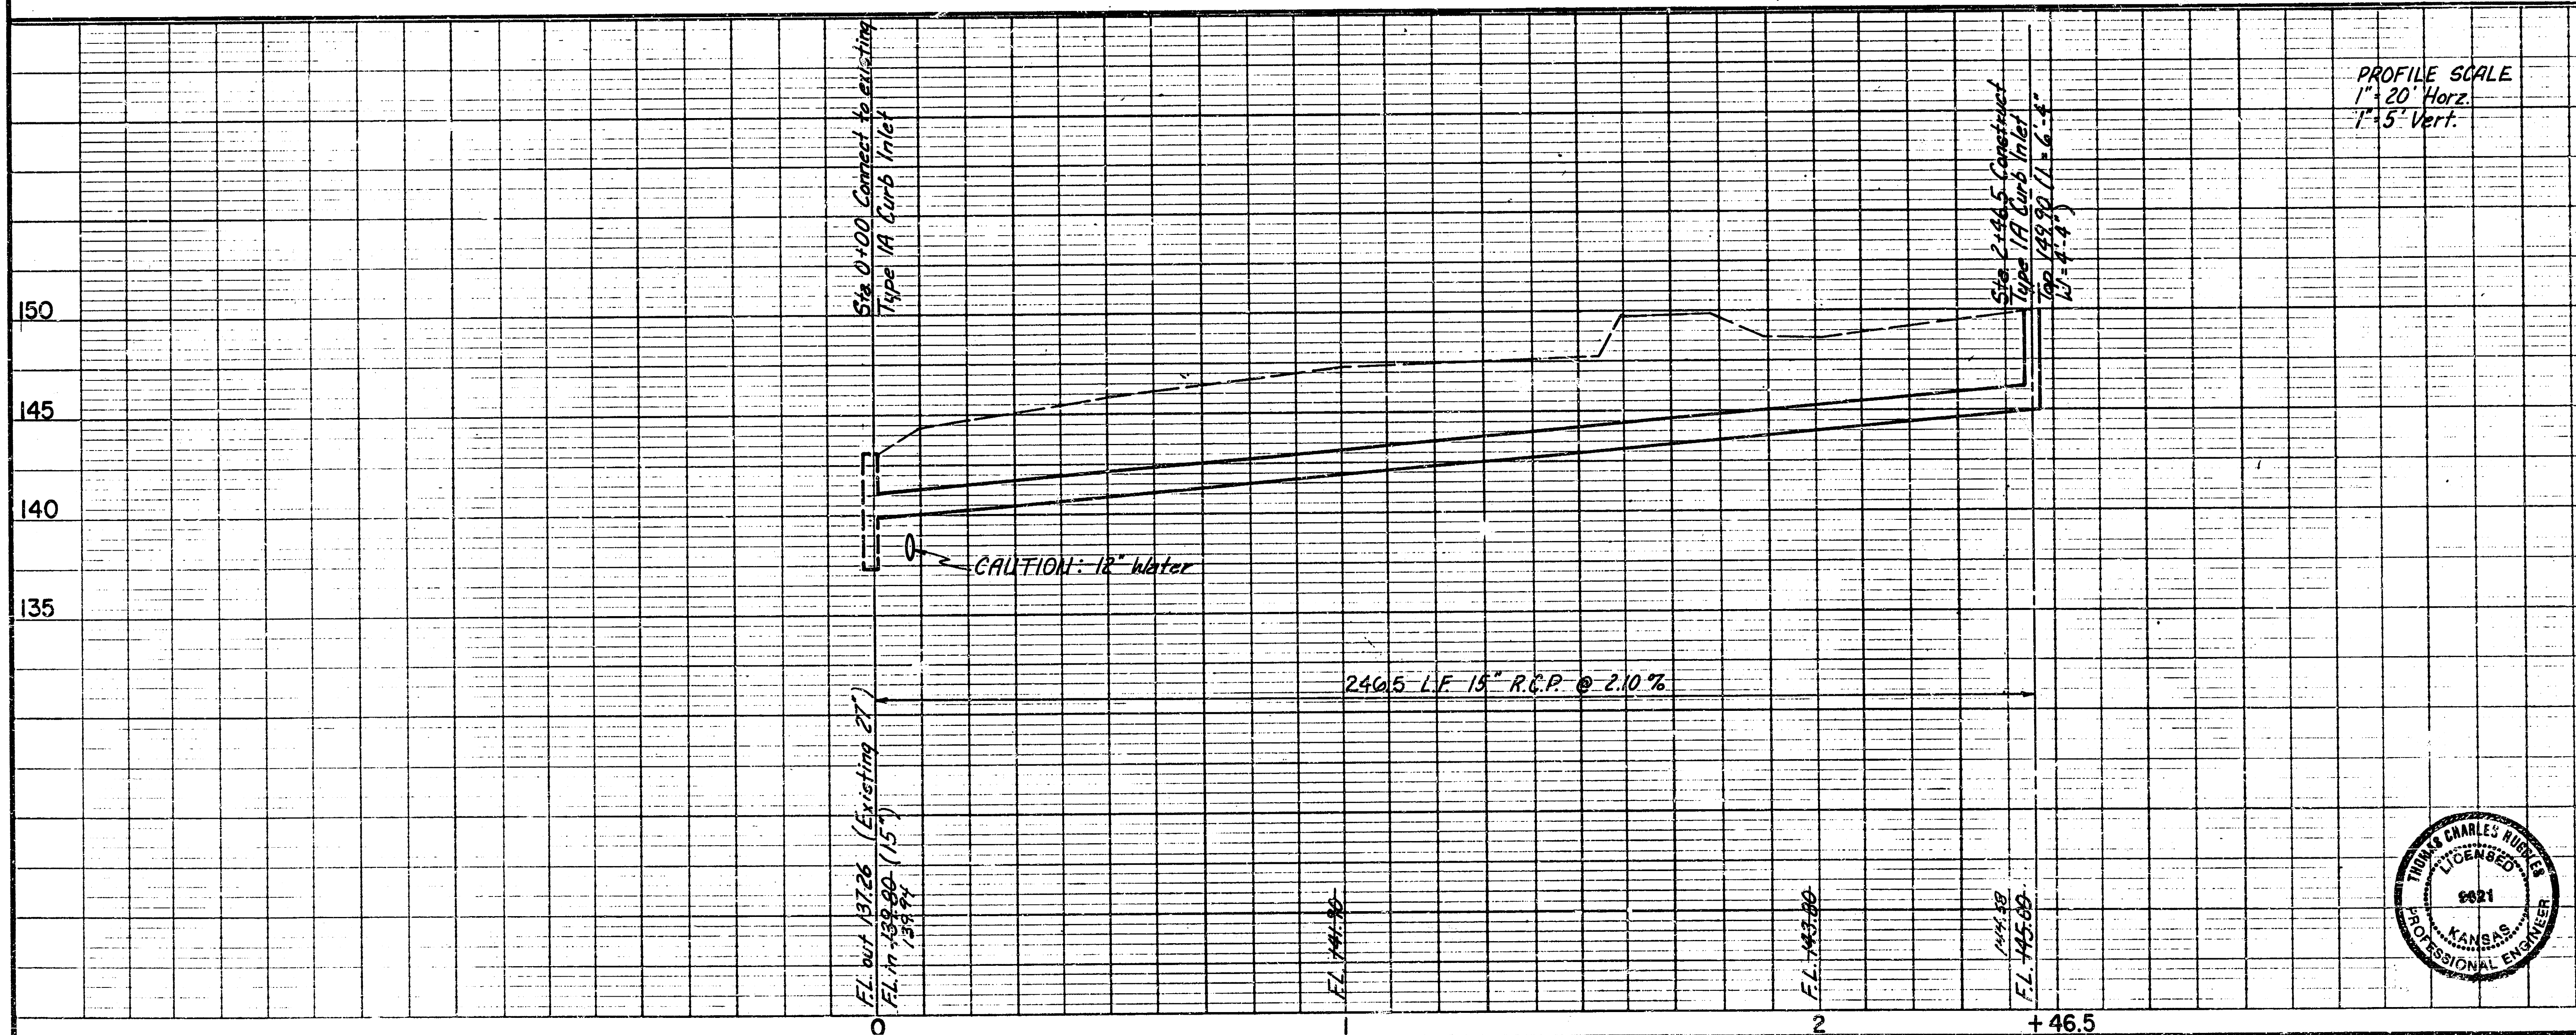

APPROVED AS NOTED
By CITY ENGINEER OF WICHITA

Sanitary Sewers _____
Storm Sewers 2" x 1/2"
Driveway Approaches _____
Water Mains _____
Paving _____

NOTE TO CONTRACTOR

INSPECTION AND TESTING FOR THIS PROJECT IS TO BE PROVIDED BY A LICENSED CONSULTING ENGINEERING FIRM UNDER CONTRACT WITH THE OWNER/DEVELOPER. SAID INSPECTION TO BE IN ACCORDANCE WITH THE CITY OF WICHITA STANDARD CONSTRUCTION ENGINEERING PRACTICES AND CERTIFIED BY A LICENSED PROFESSIONAL ENGINEER. NO WORK SHALL BE PERFORMED IN DEDICATED EASEMENTS OR PUBLIC RIGHT-OF-WAY BY THE CONTRACTOR WITHOUT SUCH INSPECTION NOR SHALL ANY WORK BE COMMENCED WITHOUT WRITTEN AUTHORIZATION BY THE CITY ENGINEER.

Revised as built 7-25-89
Revised easement 7-28-89

PRIVATE STORM WATER SEWER
REFLECTION RIDGE CLUBHOUSE
WICHITA, KANSAS
INDEX CODE: 220PPS 607853

BAUGHMAN COMPANY, P.A.
SURVEYING & ENGINEERING
310262-7271 • 315 ELLIS • WICHITA, KANSAS 67211

Design: TCR Draw: DSN Approved: Date: 7-6-89 Scale: 1"=20'