

TRENCH DRAIN SECTION  
SCALE: 3/4" = 1'-0"

BENCH MARK:



City Standard Disc, located 50.7 feet north and 39.0 feet east of the center lines of Tyler Road and Maple Street, on concrete island at northeast corner of intersection; Elev. 144.12, City Datum

NOTE TO CONTRACTOR:

INSPECTION AND TEST FOR THIS PROJECT, FROM STATION 0+00 TO STATION 0+24.5, IS TO BE PROVIDED BY A LICENSED CONSULTING ENGINEERING FIRM UNDER CONTRACT WITH THE OWNER/DEVELOPER. SAID INSPECTION TO BE IN ACCORDANCE WITH THE CITY OF WICHITA STANDARD CONSTRUCTION ENGINEERING PRACTICES AND CERTIFIED BY A LICENSED PROFESSIONAL ENGINEER. NO WORK SHALL BE PERFORMED IN DEDICATED EASEMENTS OR PUBLIC RIGHT-OF-WAY BY THE CONTRACTOR WITHOUT SUCH INSPECTION. NOR SHALL ANY WORK BE COMMENCED WITHOUT WRITTEN AUTHORIZATION BY THE CITY ENGINEER.

APPROVED AS NOTED  
By CITY ENGINEER OF WICHITA

Sanitary Sewers \_\_\_\_\_  
Storm Sewers VRH 9/13/90  
Driveway Approaches \_\_\_\_\_  
Water Mains \_\_\_\_\_  
Paving \_\_\_\_\_

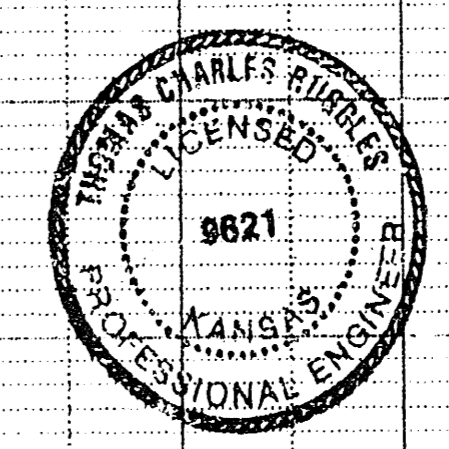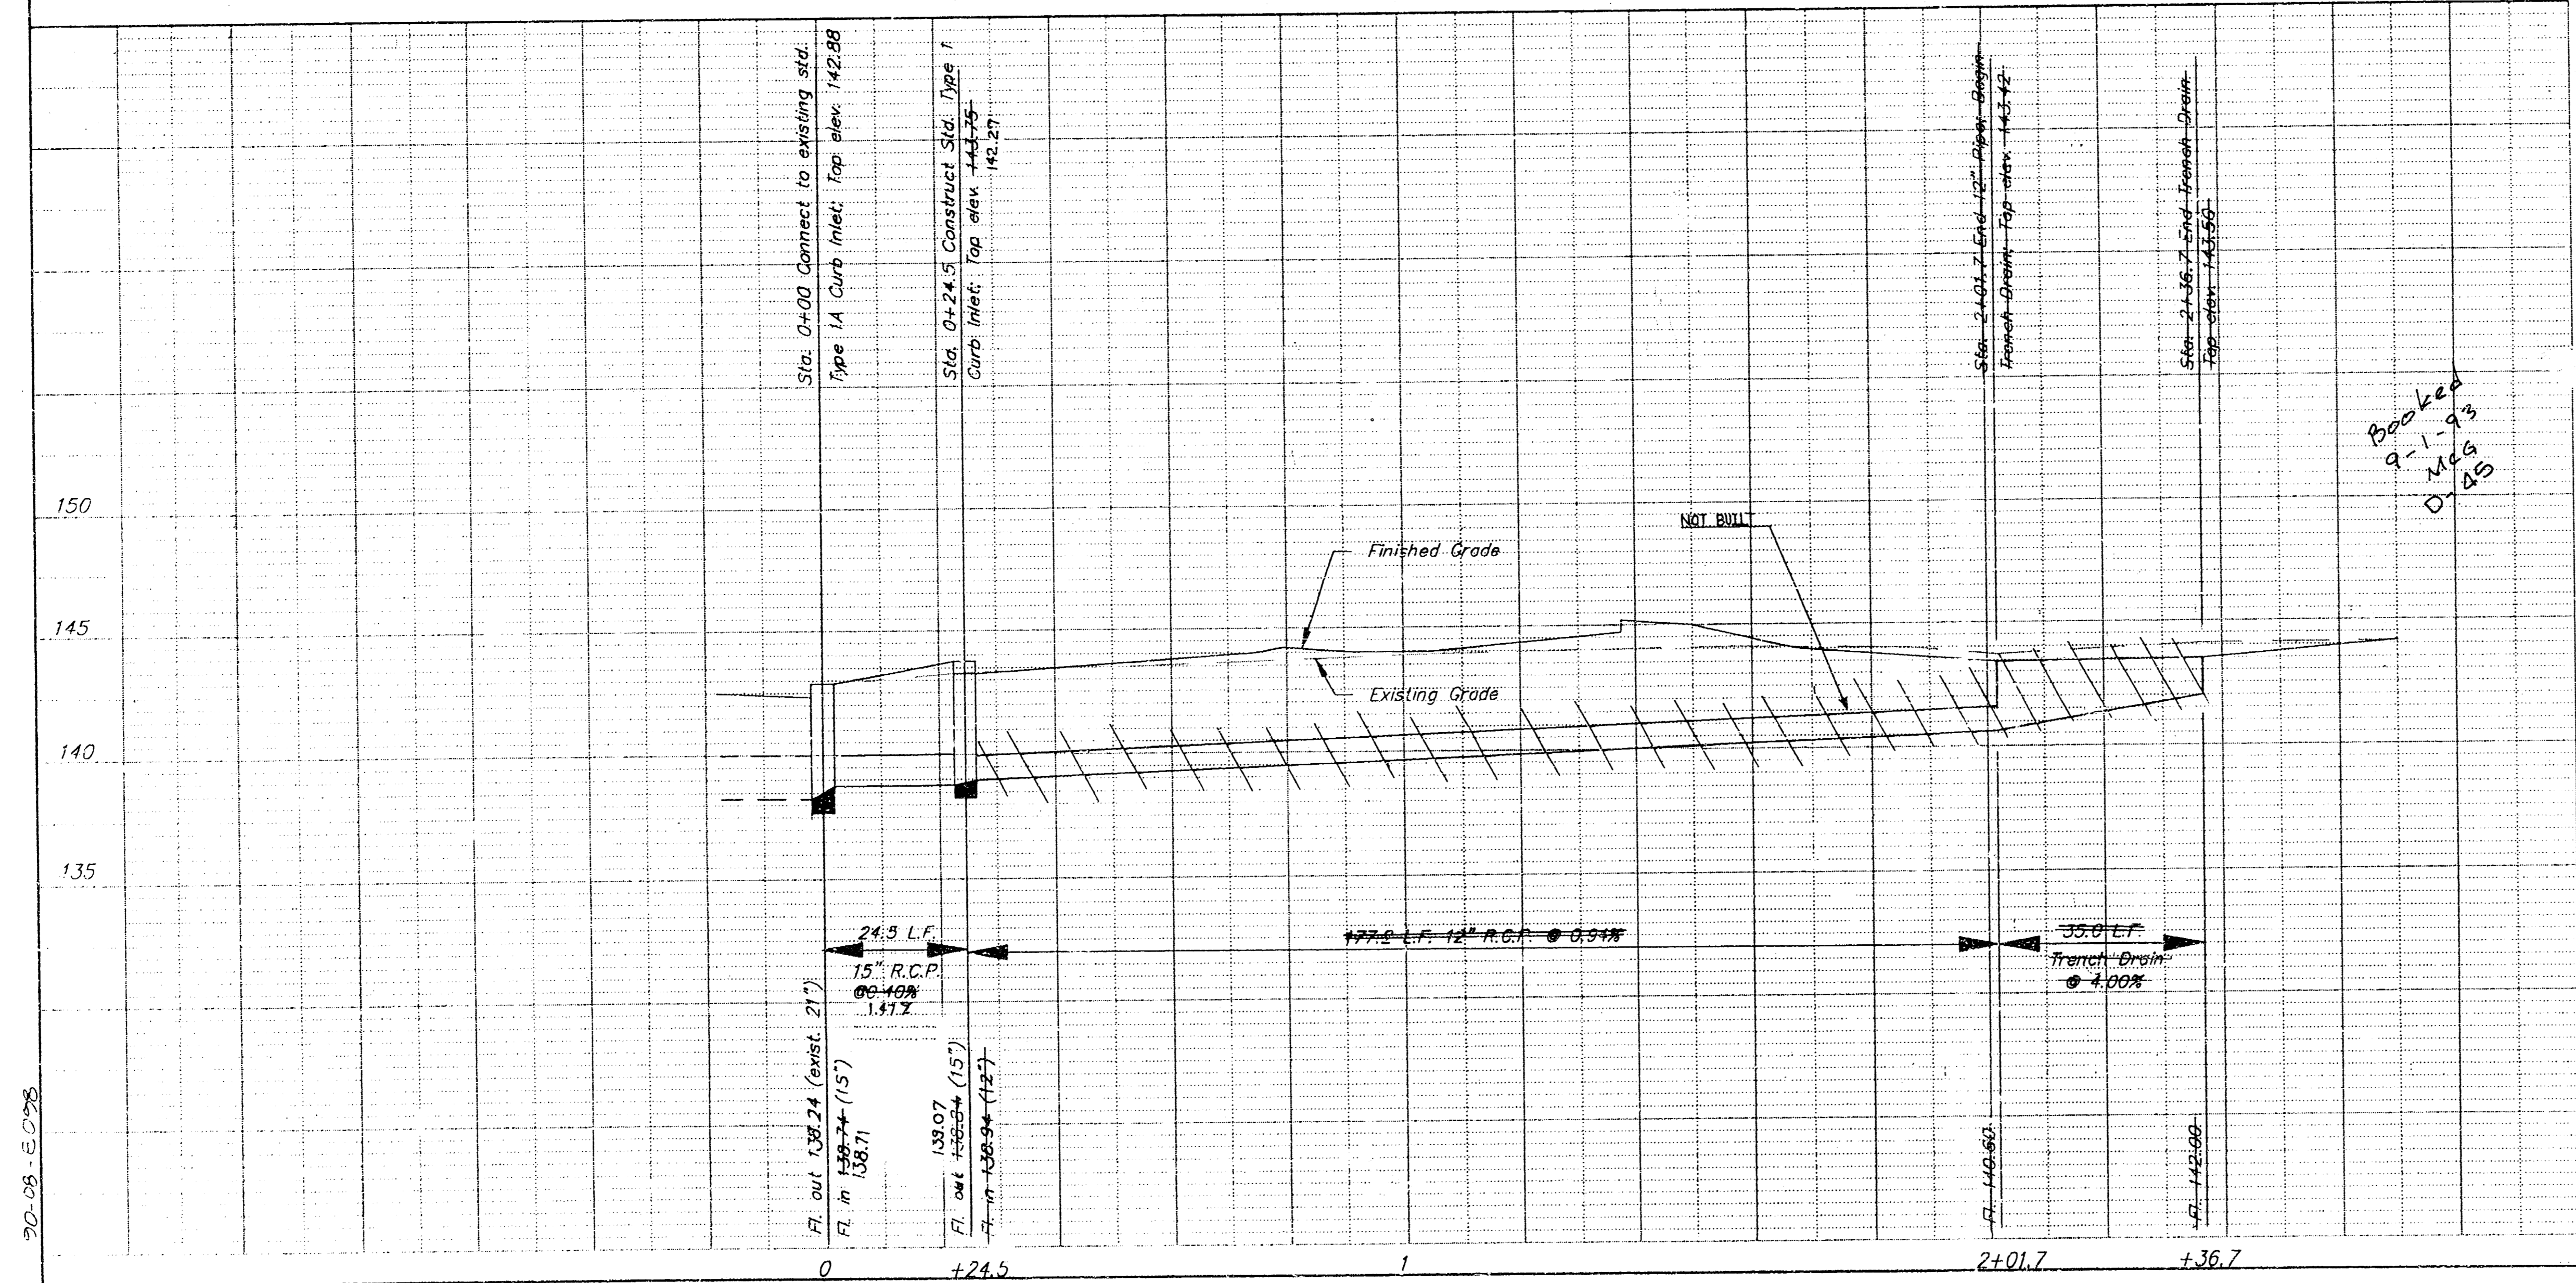

As Built 6-8-93 A.Z.

QUIK TRIP 2ND ADDITION  
PRIVATE STORM SEWER  
QUIK TRIP 343R

BAUGHMAN COMPANY P. A.  
SURVEYING & ENGINEERING  
316/262-7271 • 315 ELLIS • WICHITA, KANSAS 67211

PROJECT NUMBER  
266 PPS 607861

DESIGN	DRAWN	APPROVED	DATE	SCALE
TCR	TCR		9-11-90	1" = 20'

SHEET 1 OF 2