


Construction Notes


1. MORTAR USED IN MASONRY CONSTRUCTION SHALL CONTAIN 8 SACKS OF CEMENT PER CUBIC YARD. CONCRETE USED IN MANHOLE BASES SHALL CONFORM TO THE REQUIREMENTS OF CONCRETE FOR CONCRETE PAVEMENT CONSTRUCTION AS SPECIFIED IN THE CITY STANDARD PAVEMENT SPECIFICATIONS USING CITY CONCRETE CEMENT MIX WITHOUT AIR ENTRAINING ADMIXTURE. COMPLETED MANHOLE SHALL BE WITHOUT LEADS AND WATER TIGHT.

2. REINFORCING STEEL SHALL BE INSTALLED IN THE MANHOLE BASES AND SHALL CONSIST OF NO. 4 BARS PLACED ON 6" CENTERS IN BOTH DIRECTIONS. THE MANHOLE BASE REINFORCEMENT SHALL BE PLACED 6 INCHES ABOVE THE BOTTOM OF THE MANHOLE BASE. ALL COST FOR FURNISHING AND INSTALLING REINFORCING STEEL SHALL BE INCLUDED IN THE UNIT PRICE BID FOR THE MANHOLE.

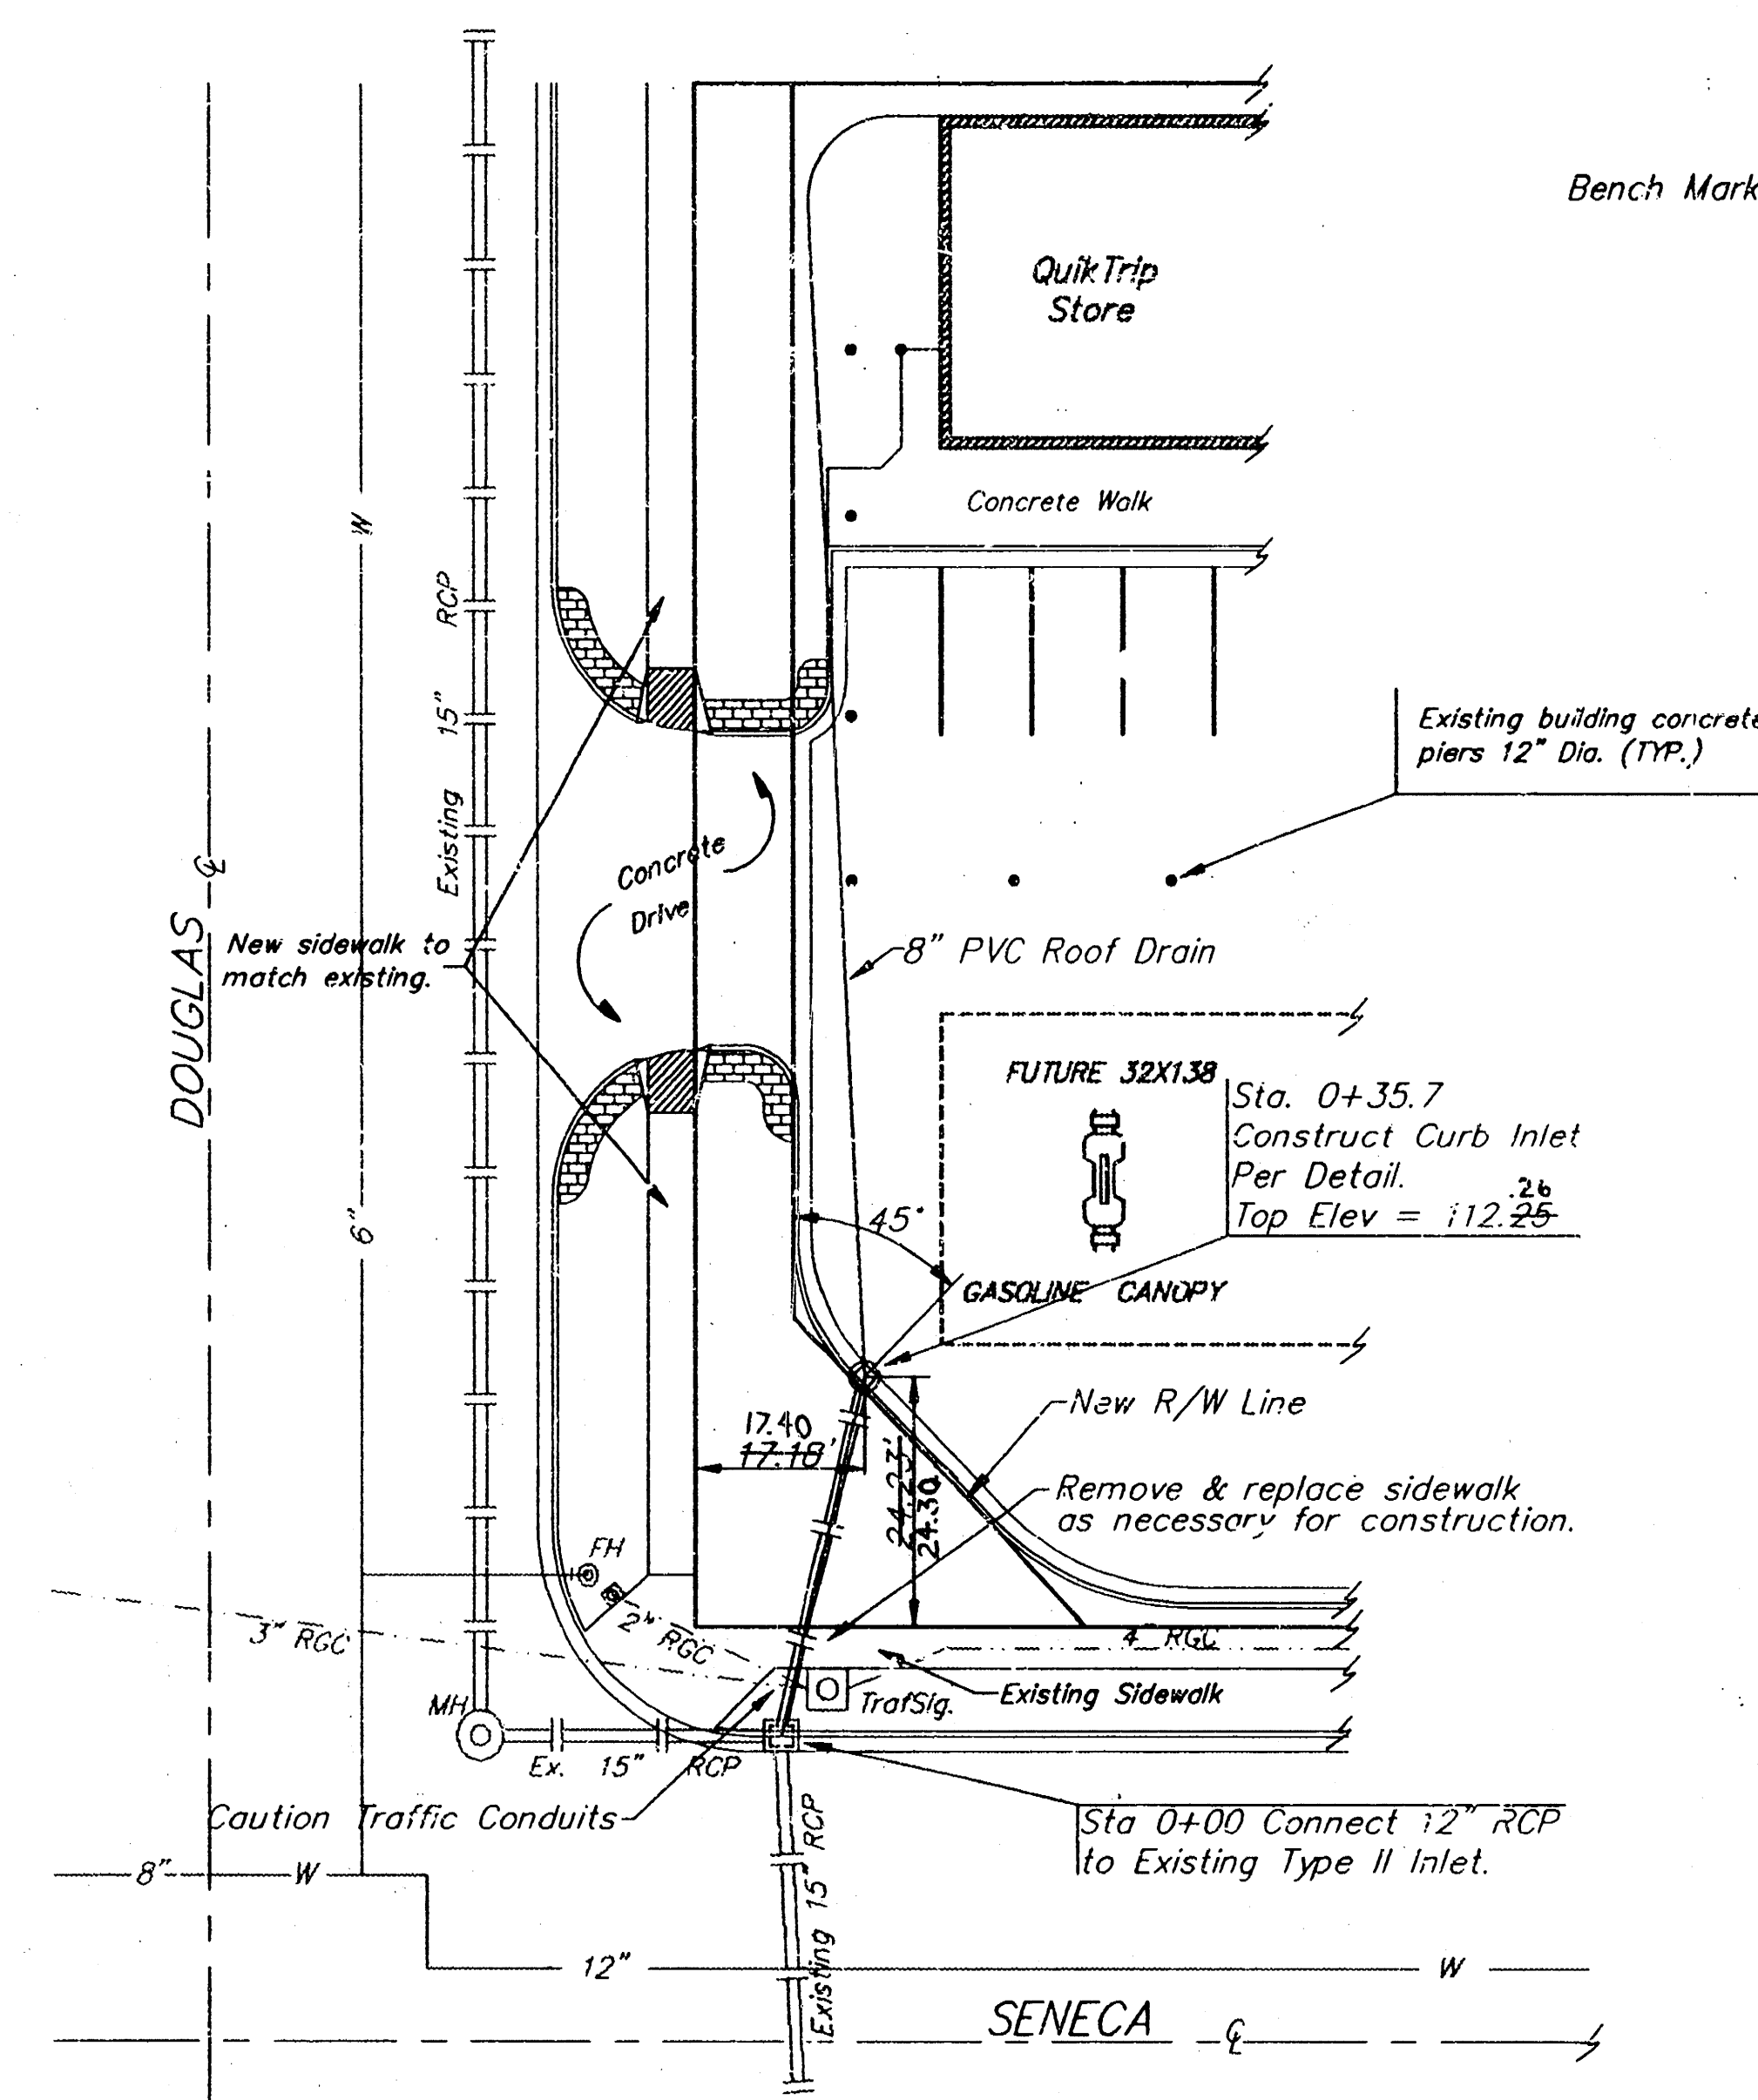

Bench Mark: "X" cut in the top of SW bolt of R.R. signal light, 380' N. and 24.5' W. of $\odot$ Seneca and Douglas. Elev.=115.36 City Datum

SCALE:
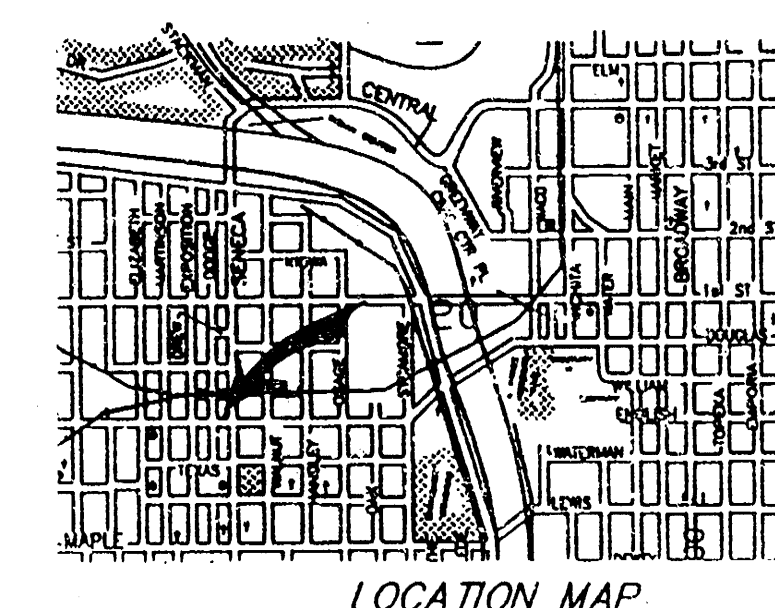
$$\begin{aligned} 1'' &= 20' \text{ Horiz.} \\ 1'' &= 5' \text{ Vert.} \end{aligned}$$


APPROVED AS NOTED
BY CITY ENGINEER OF WICHITA

Sanitary Sewers

Storm Sewers VRH 11/16/92

Driveway Approaches

Water Mains

Paying

NOTE TO CONTRACTORS


Inspection and testing for this project is to be provided by a Licensed Consulting Engineering Firm under contract with the Owner/Developer. Said inspection to be in accordance with the City of Wichita standard construction engineering practices and certified by a Licensed Professional Engineer. No work shall be performed in dedicated easements or public right-of-way by the Contractor without such inspection nor shall any work be commenced without written authorization by the City Engineer.

GENERAL NOTES

1. *Underground utility service lines and overhead utility pole lines are to be adjusted as necessary by others prior to construction to avoid the plans, specifically for their adjustment, by the Contractor. Existing utilities and their locations, as shown on the plans, represent the best information obtainable for design. Location information has been obtained from the various utility companies and is either from company record drawings or company-provided field locations. The Contractor will be required to work around existing utilities within the right-of-way which do not conflict with proposed construction.*
2. *Rubble from the removal of miscellaneous structures and excess excavation which is to be wasted shall be disposed of on site to be provided by the Contractor. These sites shall be approved by the Engineer as to suitability, appearance and site location. Locations that, in the opinion of the Engineer, will leave an unsightly appearance will not be approved. All disposal sites must be approved by the Kansas Department of Health and Environment. Material either stockpiled or disposed of in a flood plain would require a Kansas State Board of Agriculture permit. Any material dumped in waters of the United States or wetlands is subject to U.S. Corps. of Engineers permitting regulations. Any material buried or stockpiled beyond approved construction limits would require additional archeological investigations unless buried in a previously approved borrow location.*
3. *The Contractor shall notify pipeline companies at least 24 hours in advance of work being performed across and/or adjacent to pipelines.*

As Built 6-4-93

PRIVATE STORM WATER SEWER TO SERVE
QUICK TRIP #349R

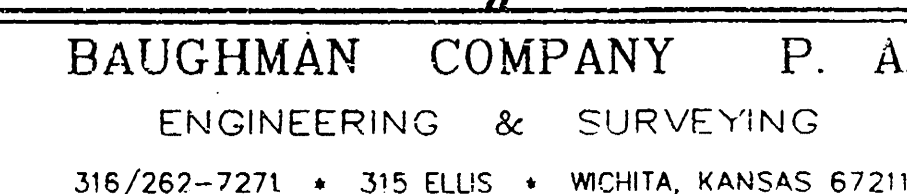

PROJECT NUMBER

PROJECT NUMBER
370PPS (607861)

DESIGN B.P.	DRAWN B.P./G.L.D.	UTIL. CHECK'D	DATE 11-16-92	SCALE NOTED
----------------	----------------------	---------------	------------------	----------------

DATE:	D.O.B./O.L.D.	11-10-52	NOTED
-------	---------------	----------	-------
