



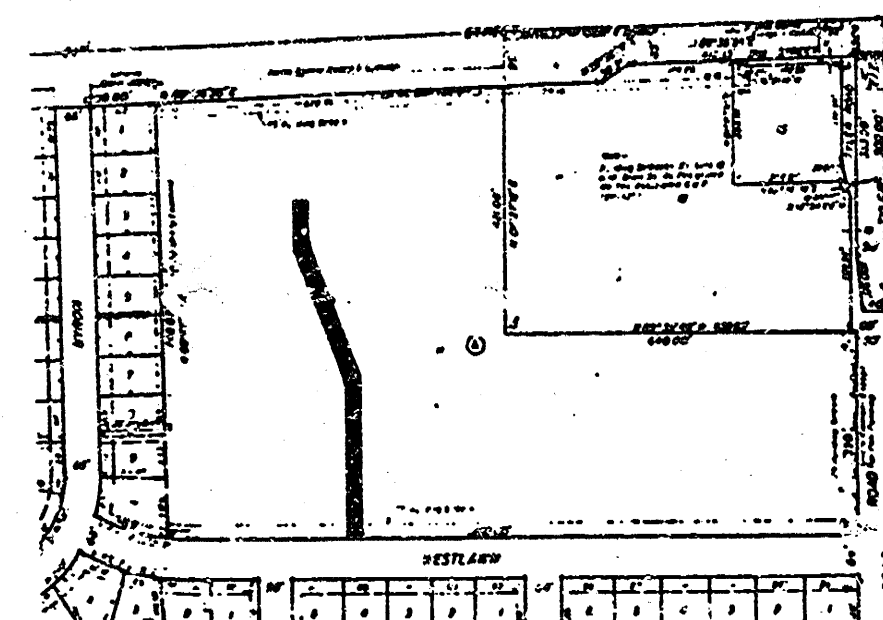


Scale: 1" = 20'

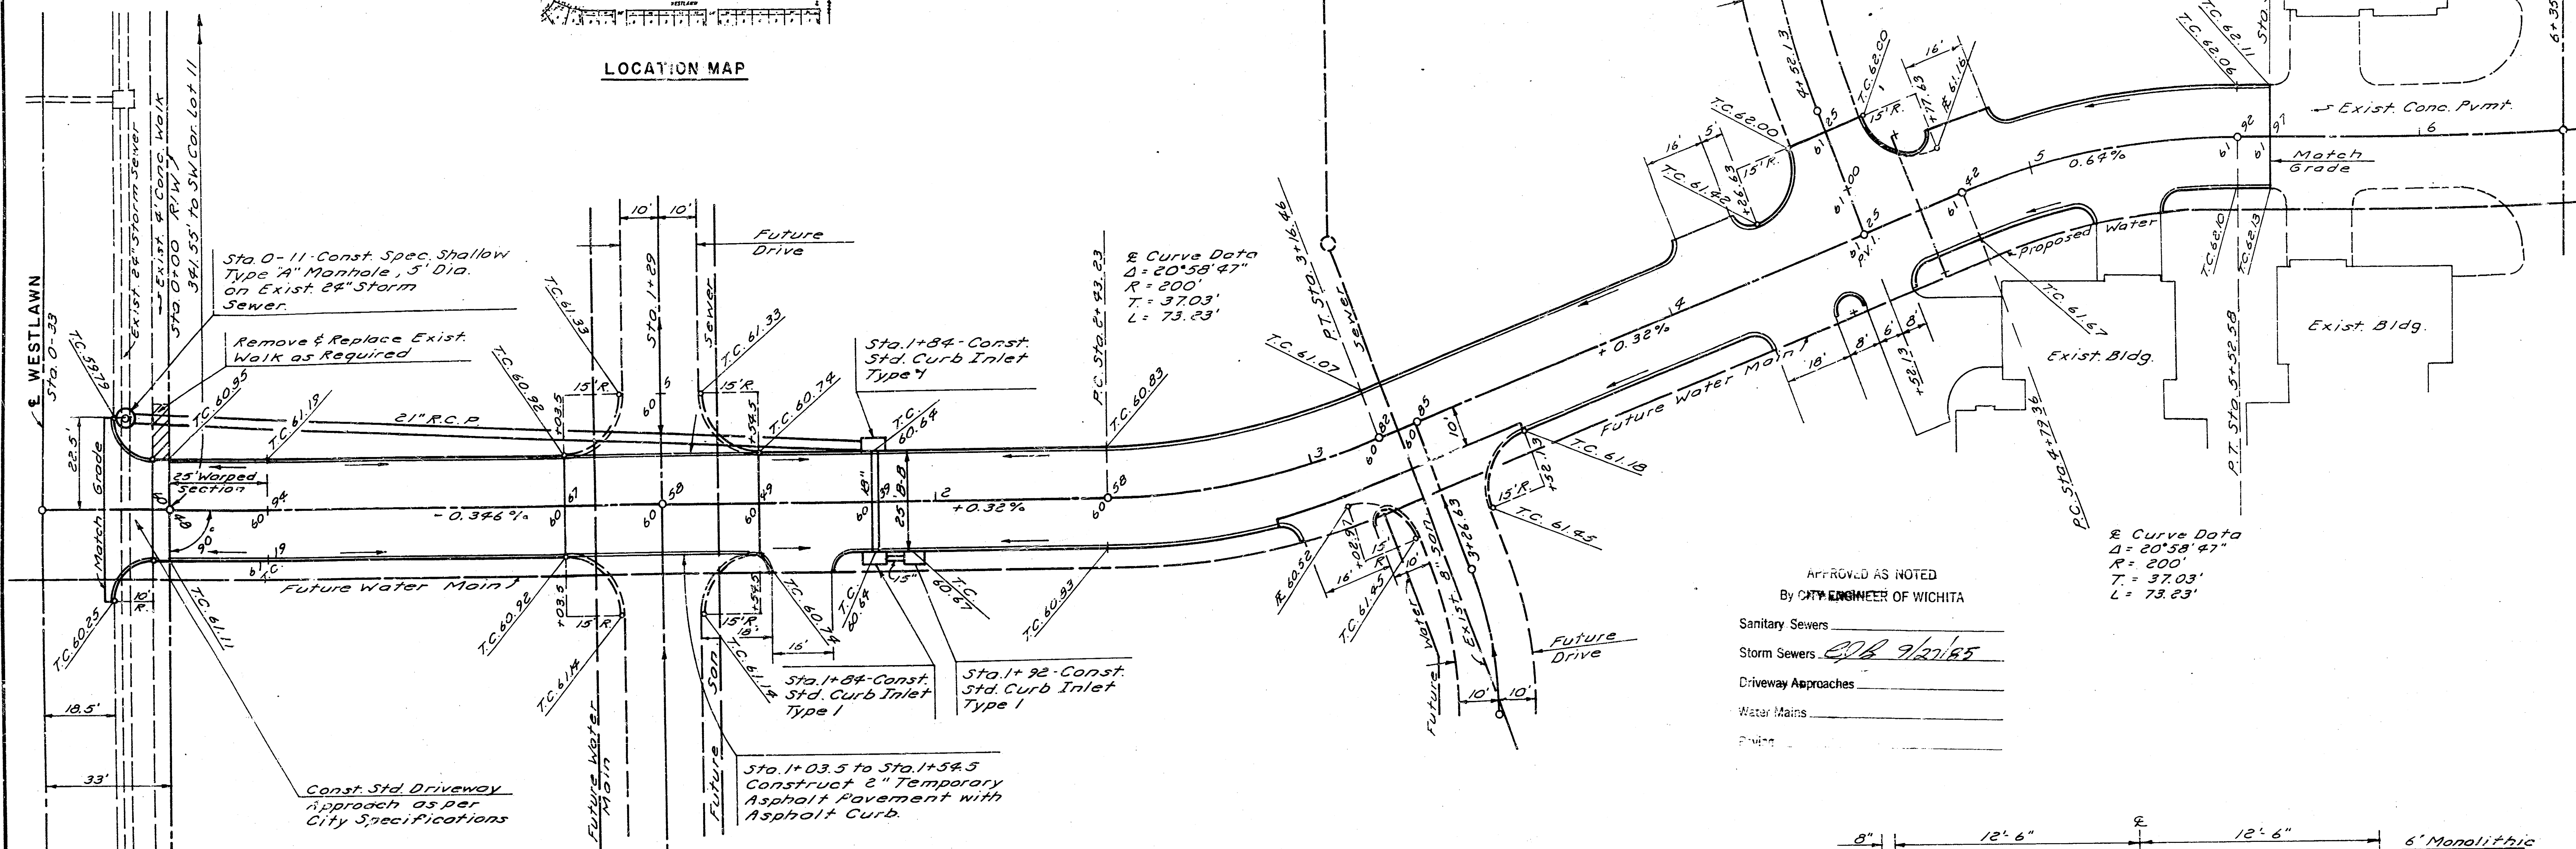


APPROVED AS NOTED
By CITY ENGINEER OF WICHITA


Sanitary Sewers _____
Storm Sewers 9/27/85
Driveway Approaches _____
Water Mains _____
Paving _____

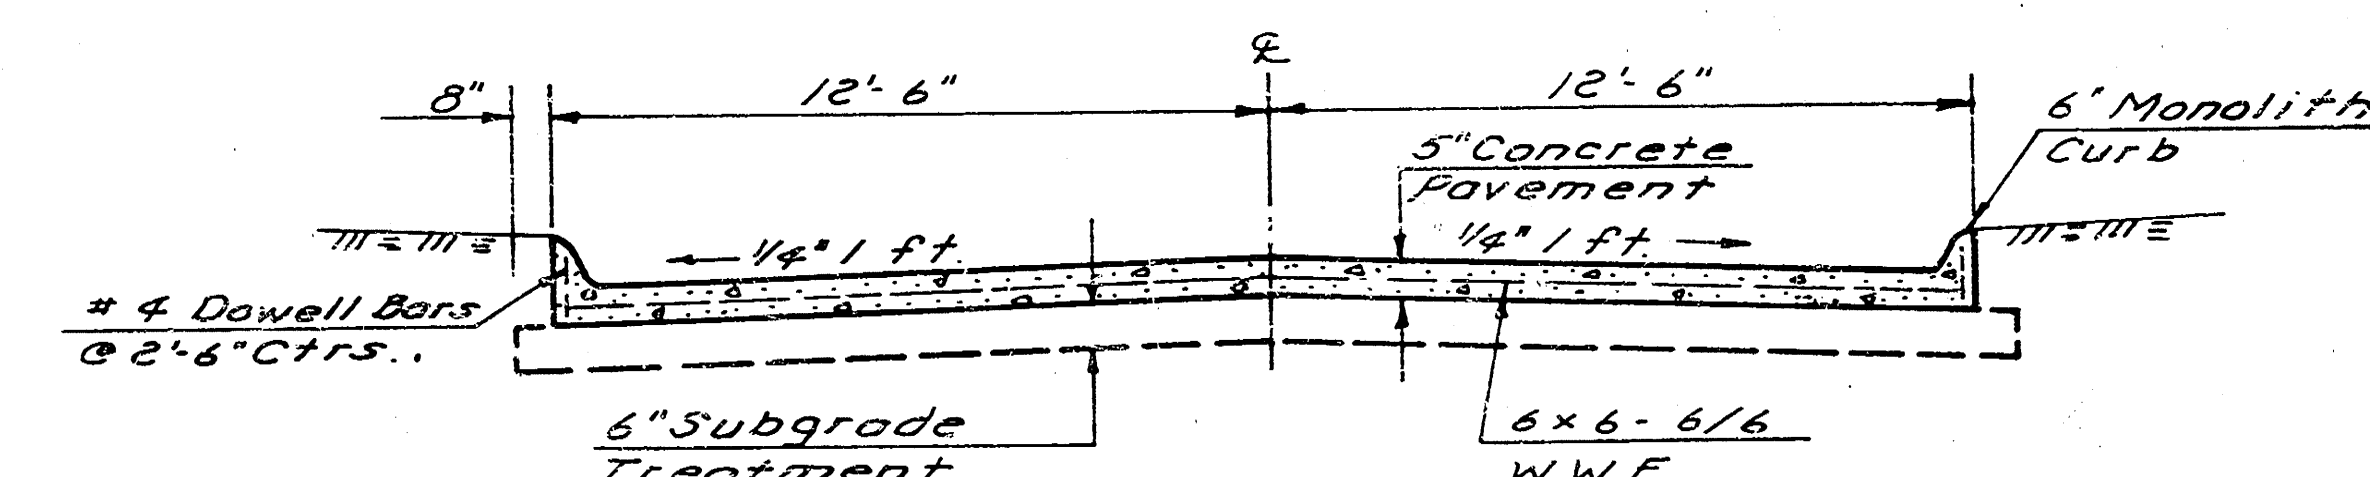

TYPICAL SECTION - 25'-B-B PAVEMENT

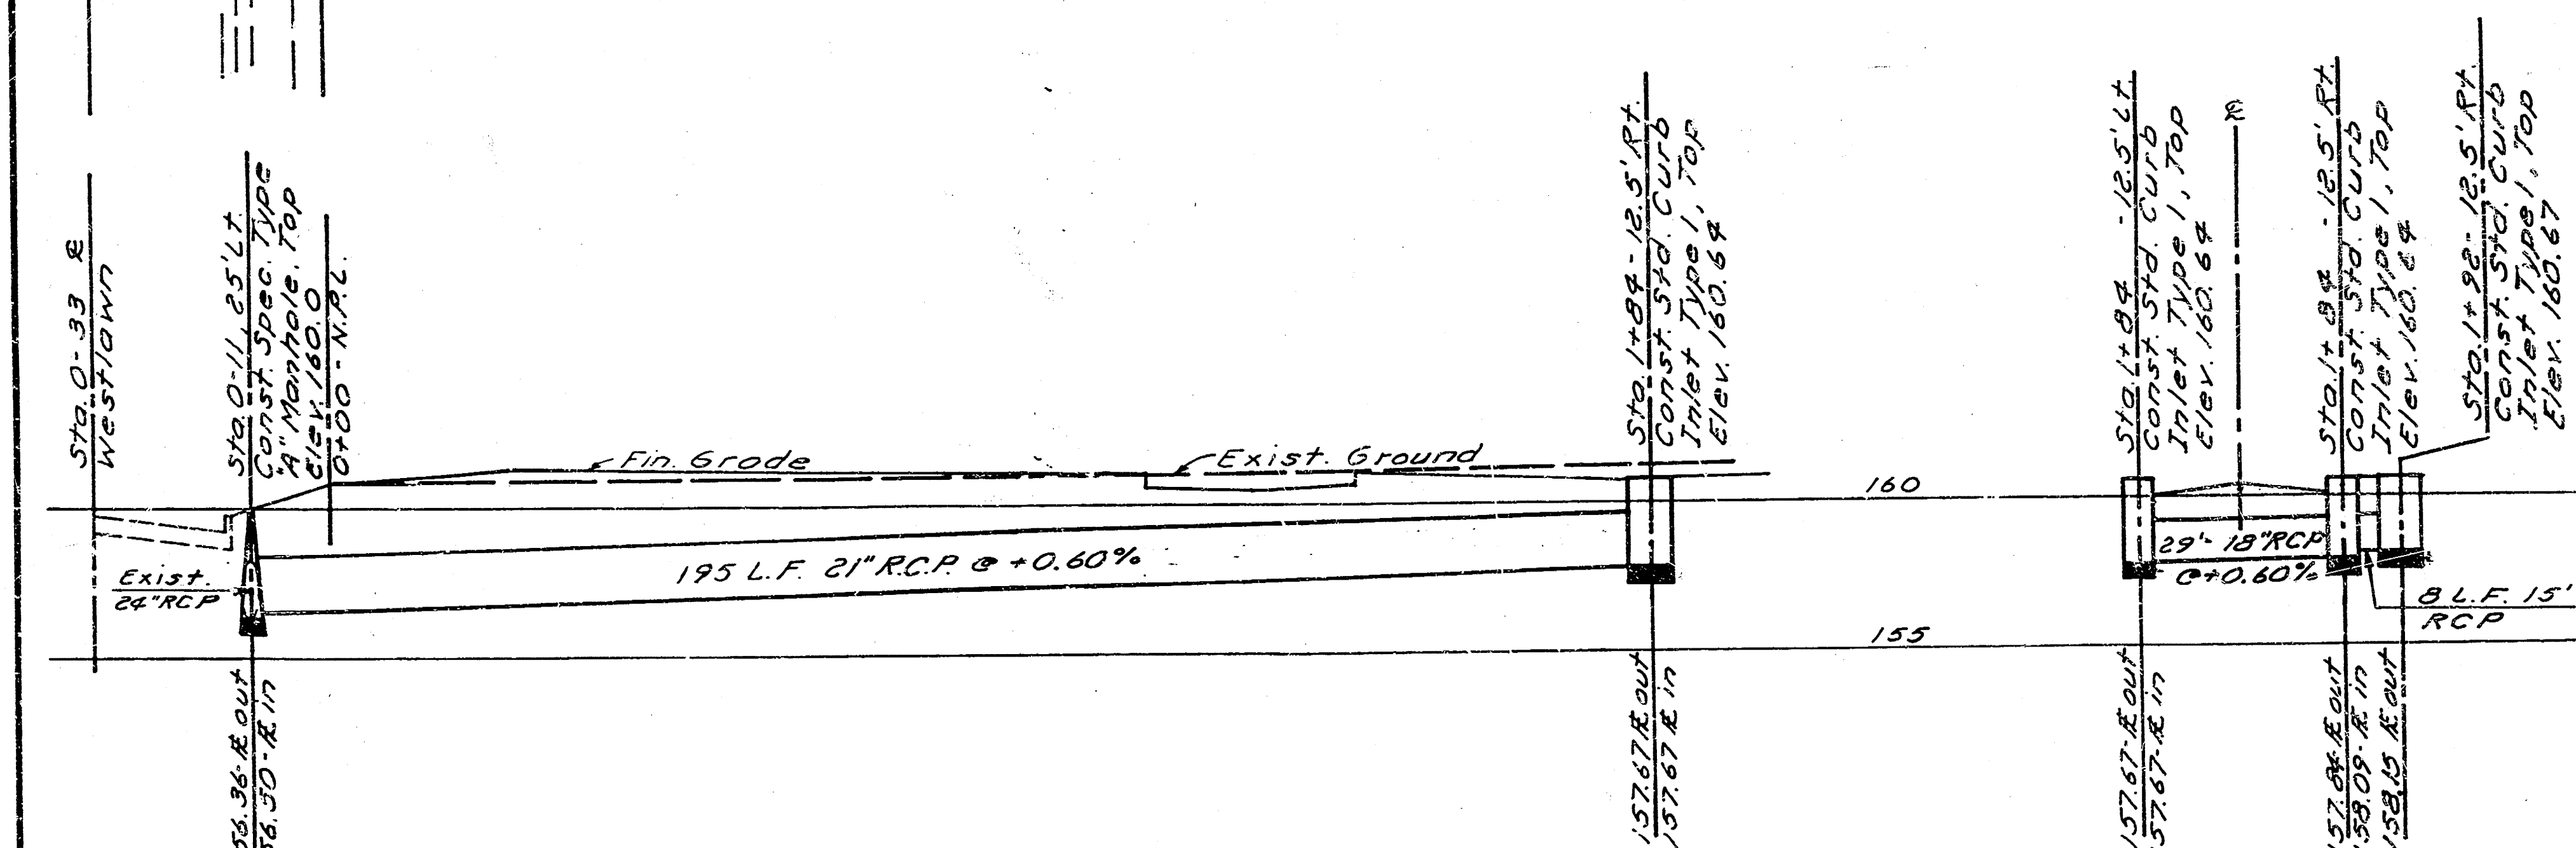

STORM SEWER PROFILES

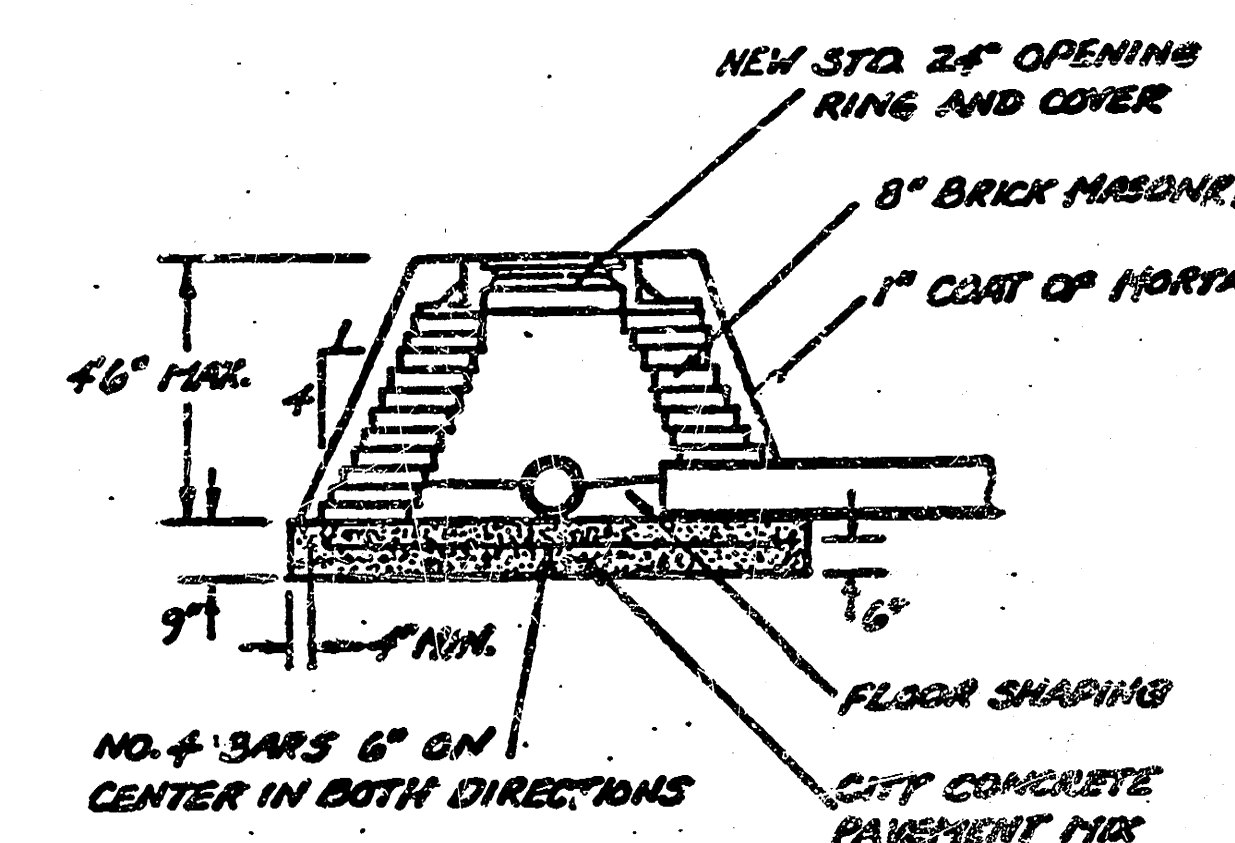

SHALLOW SPECIAL MANHOLE "TYPE A"

NOTE TO CONTRACTOR

This project will be constructed under the supervision of the CITY ENGINEER and conforming to the SPECIFICATIONS of the CITY OF WICHITA. The CONTRACTOR will pay the City of Wichita for all costs of plan review, inspection and testing per contract.

Aug. 12, 1985

PROPOSED PRIVATE DRIVE & STORM SEWER
THE PINES LOCATED IN PART OF LOT 11,
BLK. A, JAMESBURG PARK ADD.

PRIVATE PROJ. 468-76-245-80001-000-000-036

BAUGHMAN COMPANY, P.A.
SURVEYING & ENGINEERING
316/262-7271 • 330 LAURA • WICHITA, KANSAS 67211

FILMED FROM THE BEST
AVAILABLE COPY