

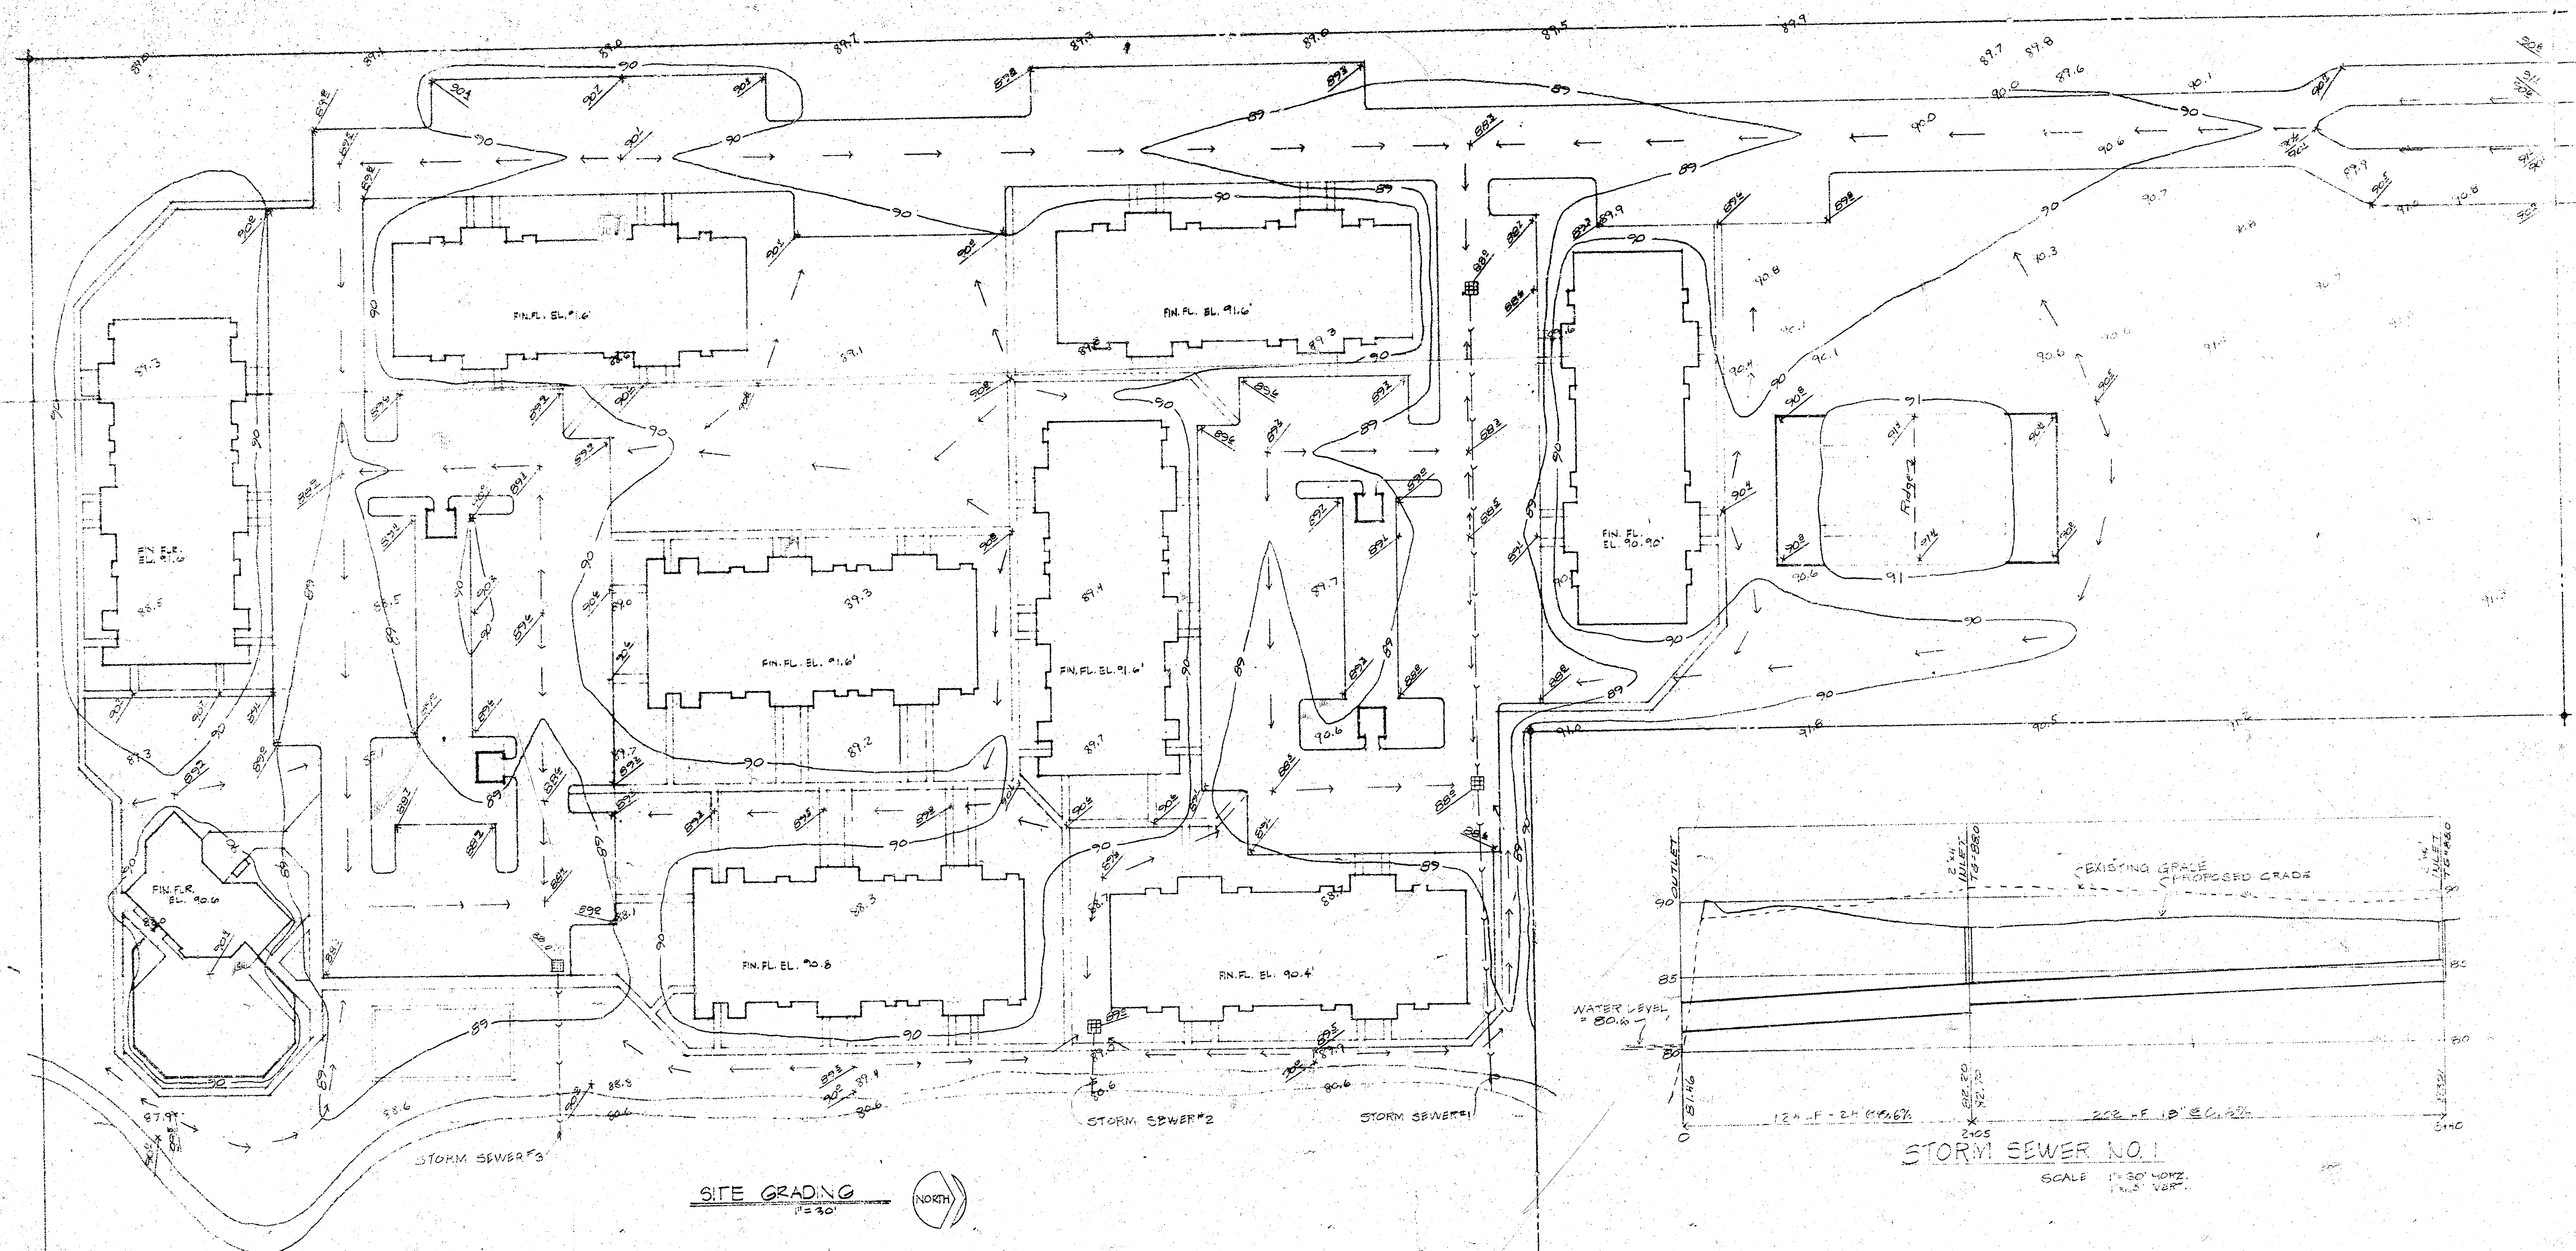


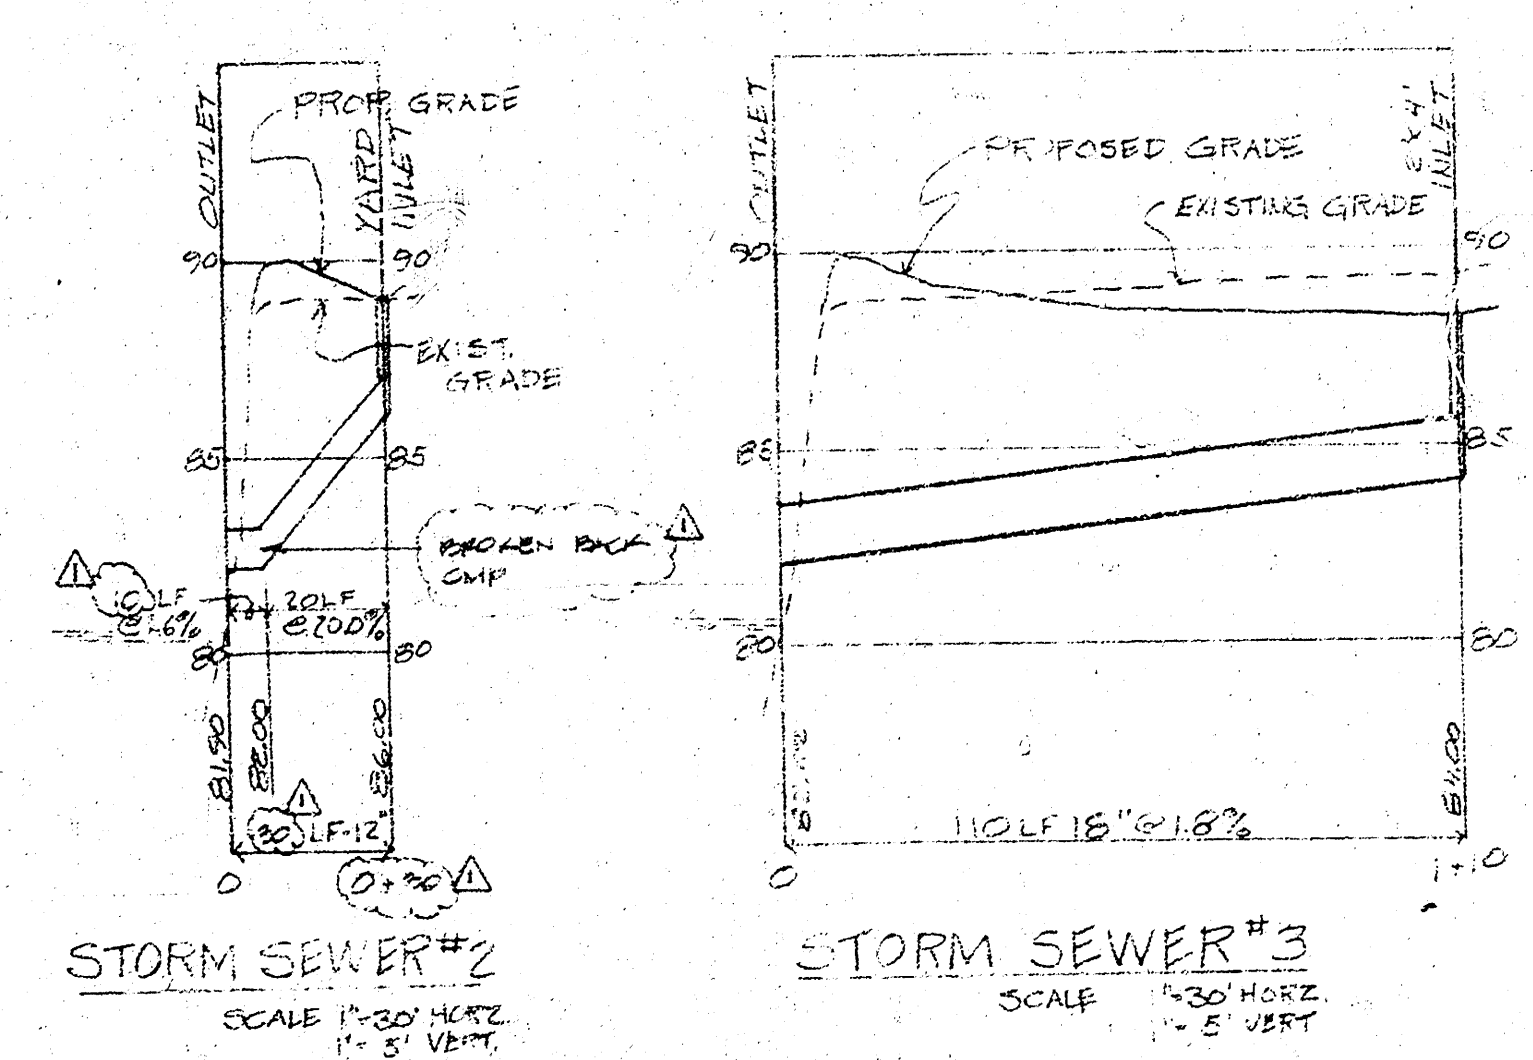

NOTES:
 1. ALL STORM SEWERS TO BE 18" DIA. CORRUGATED METAL PIPE.
 2. CULVERT PIPE TO BE EITHER CLASS II REIN. CONCRETE PIPE OR 18" DIA. CORRUGATED METAL PIPE.
 3. 18" INLETS TO BE CONSTRUCTED AS CITY OF WICHITA STANDARD INLETS. TOP OF BRATE 10.0 ELEV. DRAIN SHALL GOVERN INLET ELEV.
 4. DRAINAGE ACROSS TOP OF LAKE BANK IS NOT PERMITTED. SEE TYPICAL SECTION AT BANK.

LEGEND
 1. EXISTING SPOT EL.
 2. NEW SPOT EL.
 3. NEW CONTOUR
 4. DRAINAGE
 5. STORM SEWER
 6. CULVERT IN END SECTIONS
 7. YARD INLET

BENCH MARK
 R. 51.05 S. SIDE POWER POLE
 2 MACARTHUR & GOLD, NE CORNER




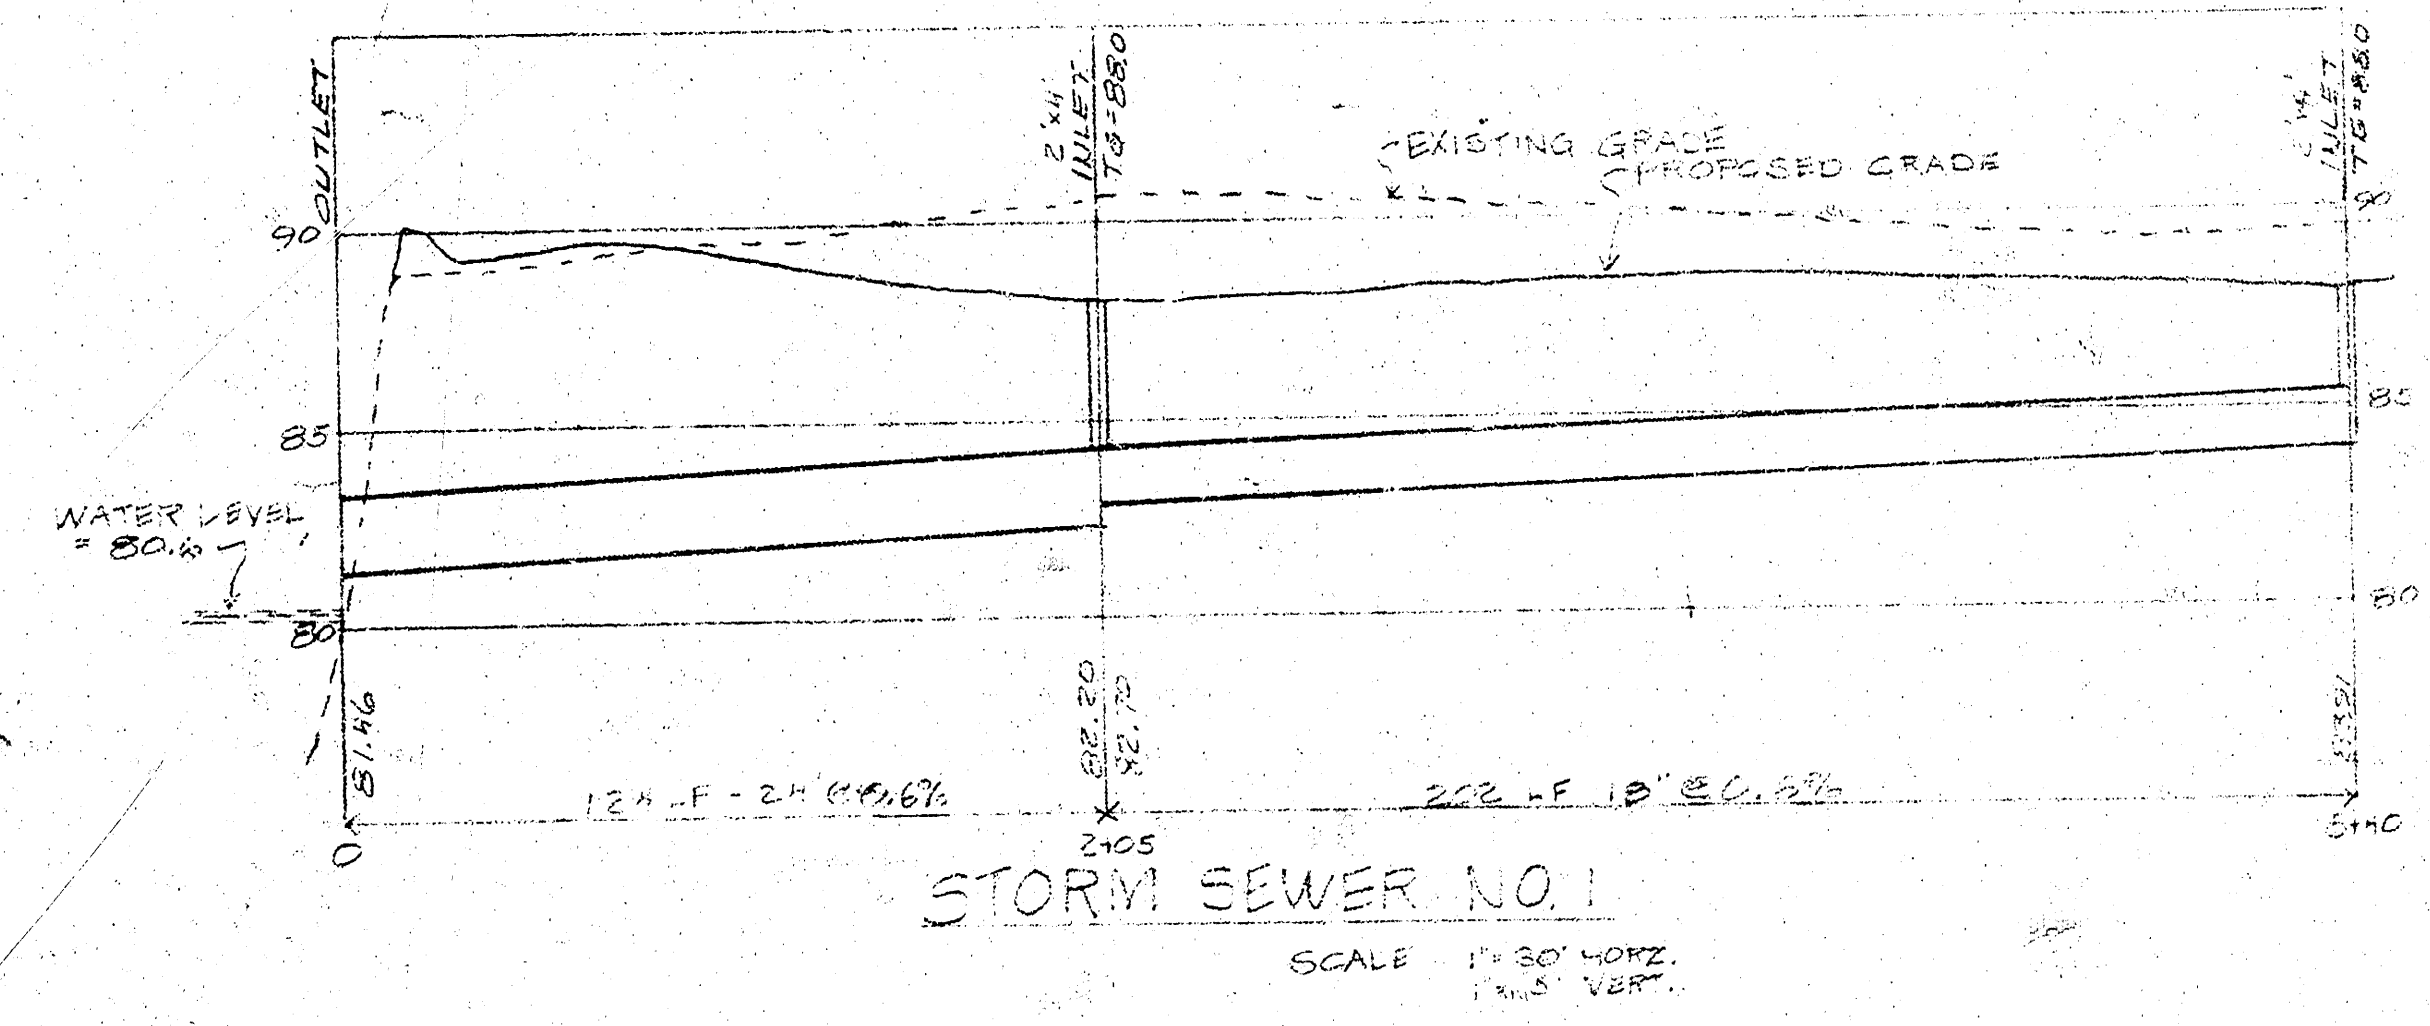


GENERAL NOTE:
 REFER TO STORM SEWER OUTLET
 DETAIL PER STORM SEWER #1, 2 & 3

APPROVED AS NOTED
 BY CITY ENGINEER OF WICHITA
 Sanitary Sewers
 Storm Sewers
 3/28/79
 Jeff Krehbiel Associates


CITY OF WICHITA
 This project will be constructed under the supervision of the CITY ENGINEER and compliance to the SPECIFICATIONS of the CITY OF WICHITA. The CONTRACTOR shall reimburse the City of Wichita for the engineering, printing, and reproduction costs.

NOTE TO CONTRACTOR
 This project will be constructed under the supervision of the CITY ENGINEER and compliance to the SPECIFICATIONS of the CITY OF WICHITA. The CONTRACTOR shall reimburse the City of Wichita for the engineering, printing, and reproduction costs.

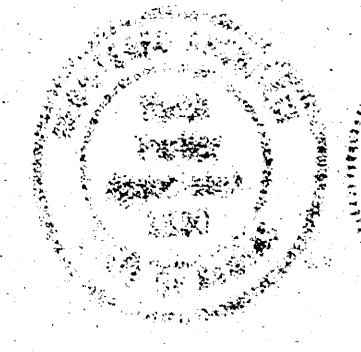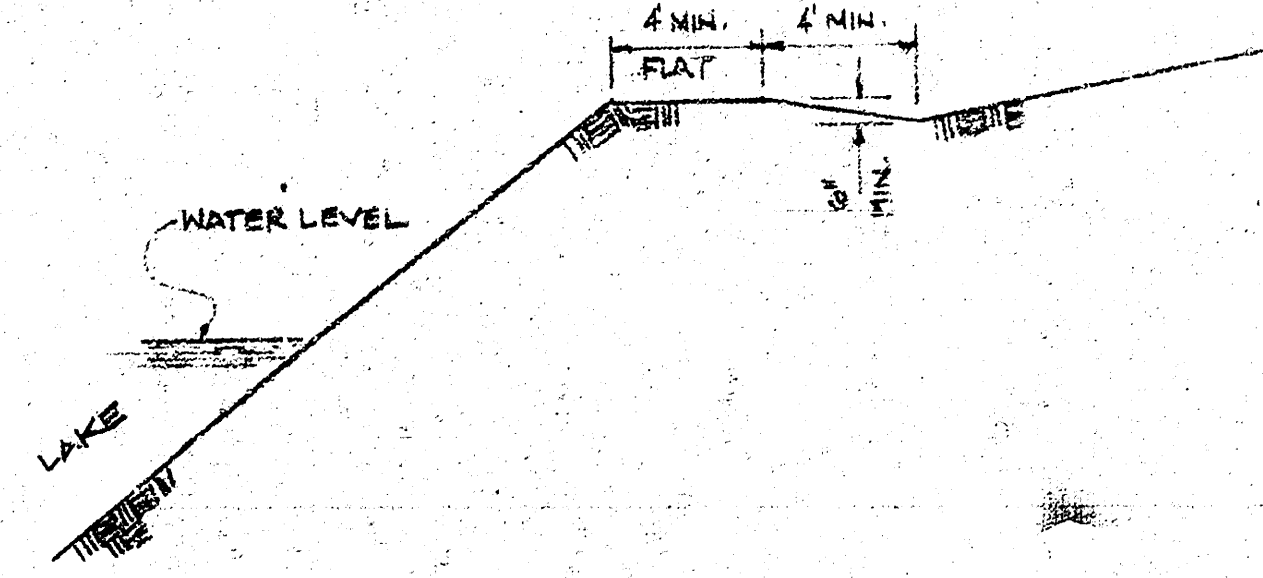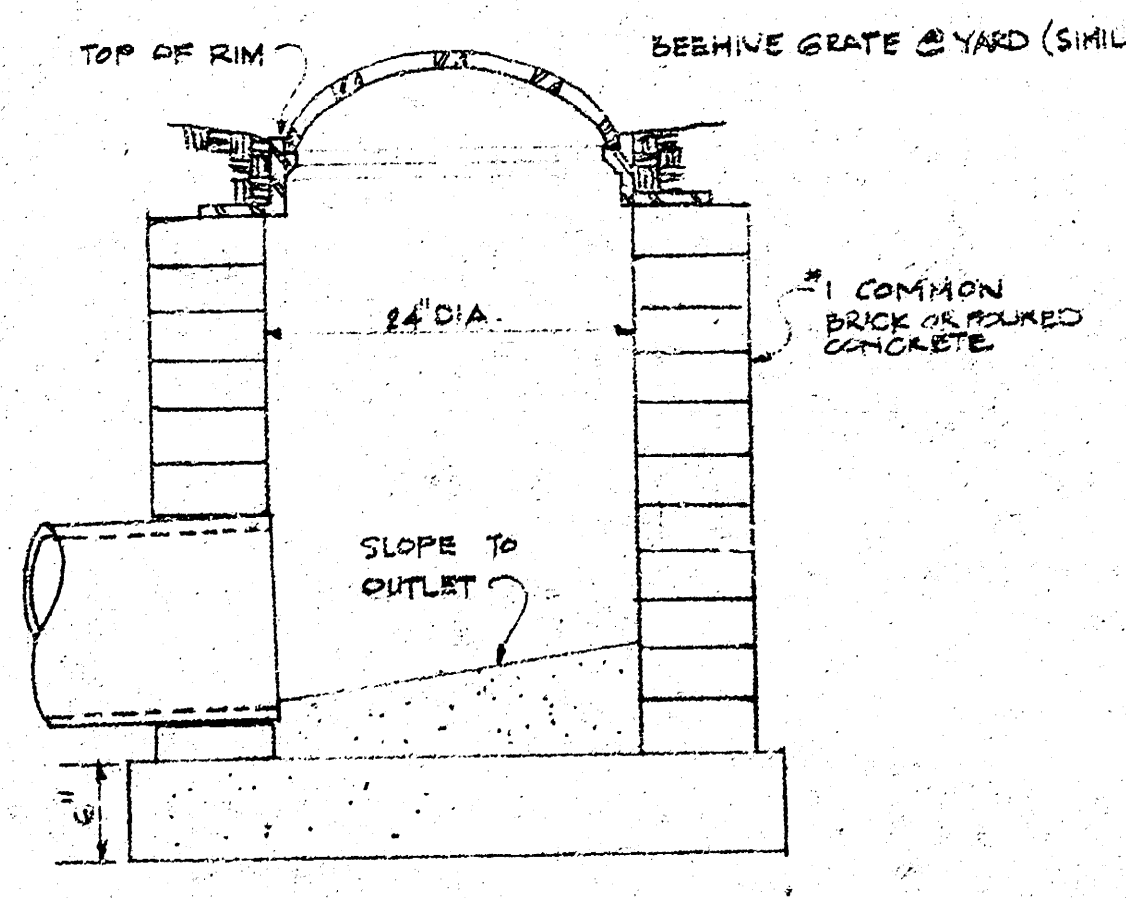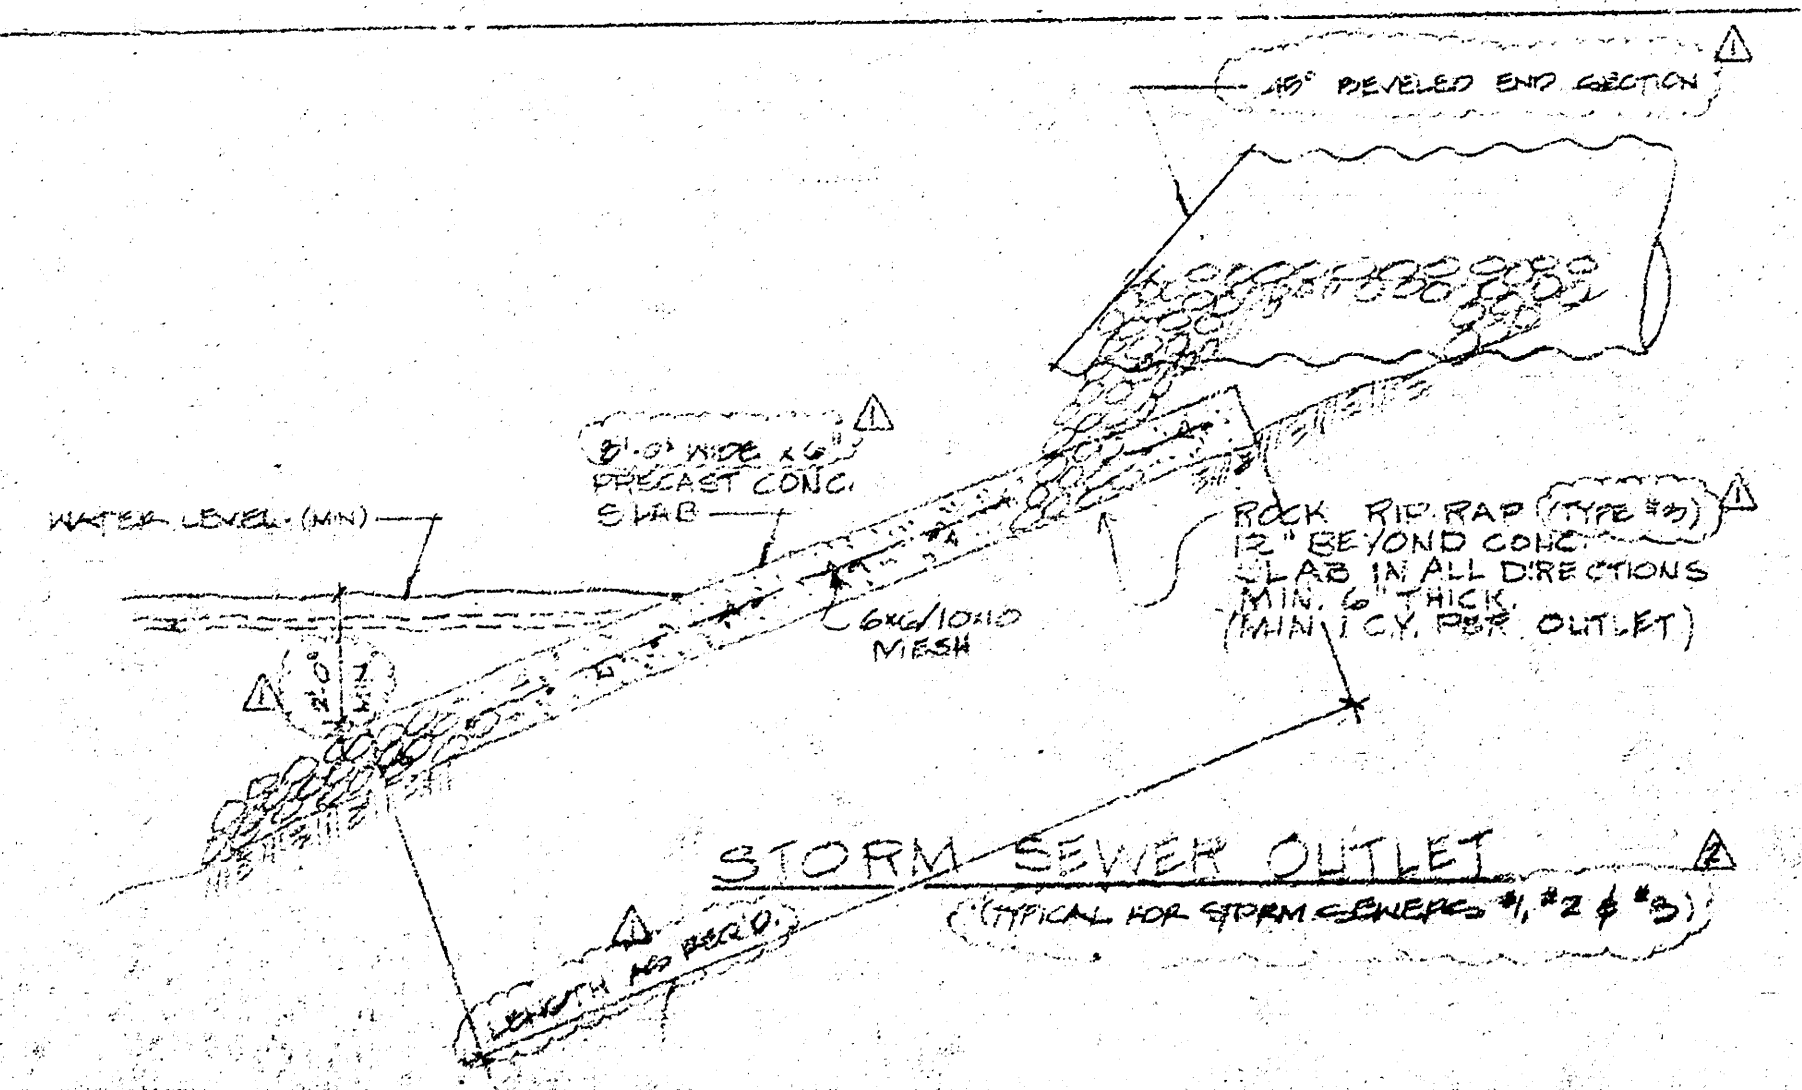

revision	date	description
1	3/28/79	FINAL

JK
 JEFF KREHBIEL
 ASSOCIATES, P.C.
 architecture • planning

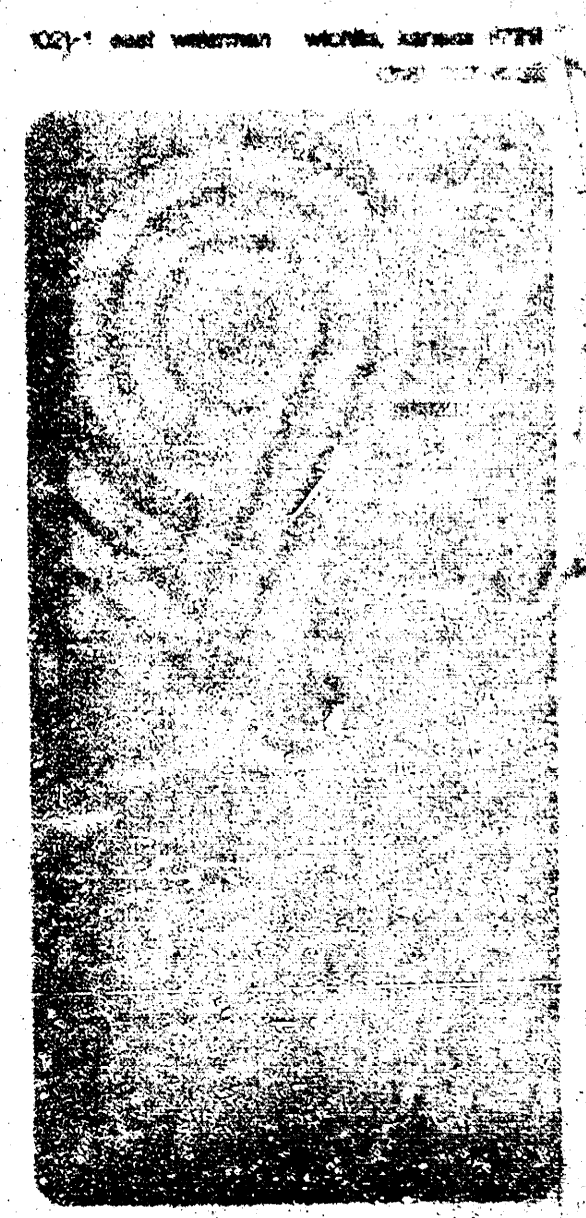

MACARTHUR BEACH APTS.
 727 WEST MACARTHUR ROAD
 WICHITA, KANSAS
 FOR:
 RITCHEE ENTERPRISES

sheet title
 SITE GRADING

sheet
 SG-1
 of 1 sheets