


12/11/75
JAH

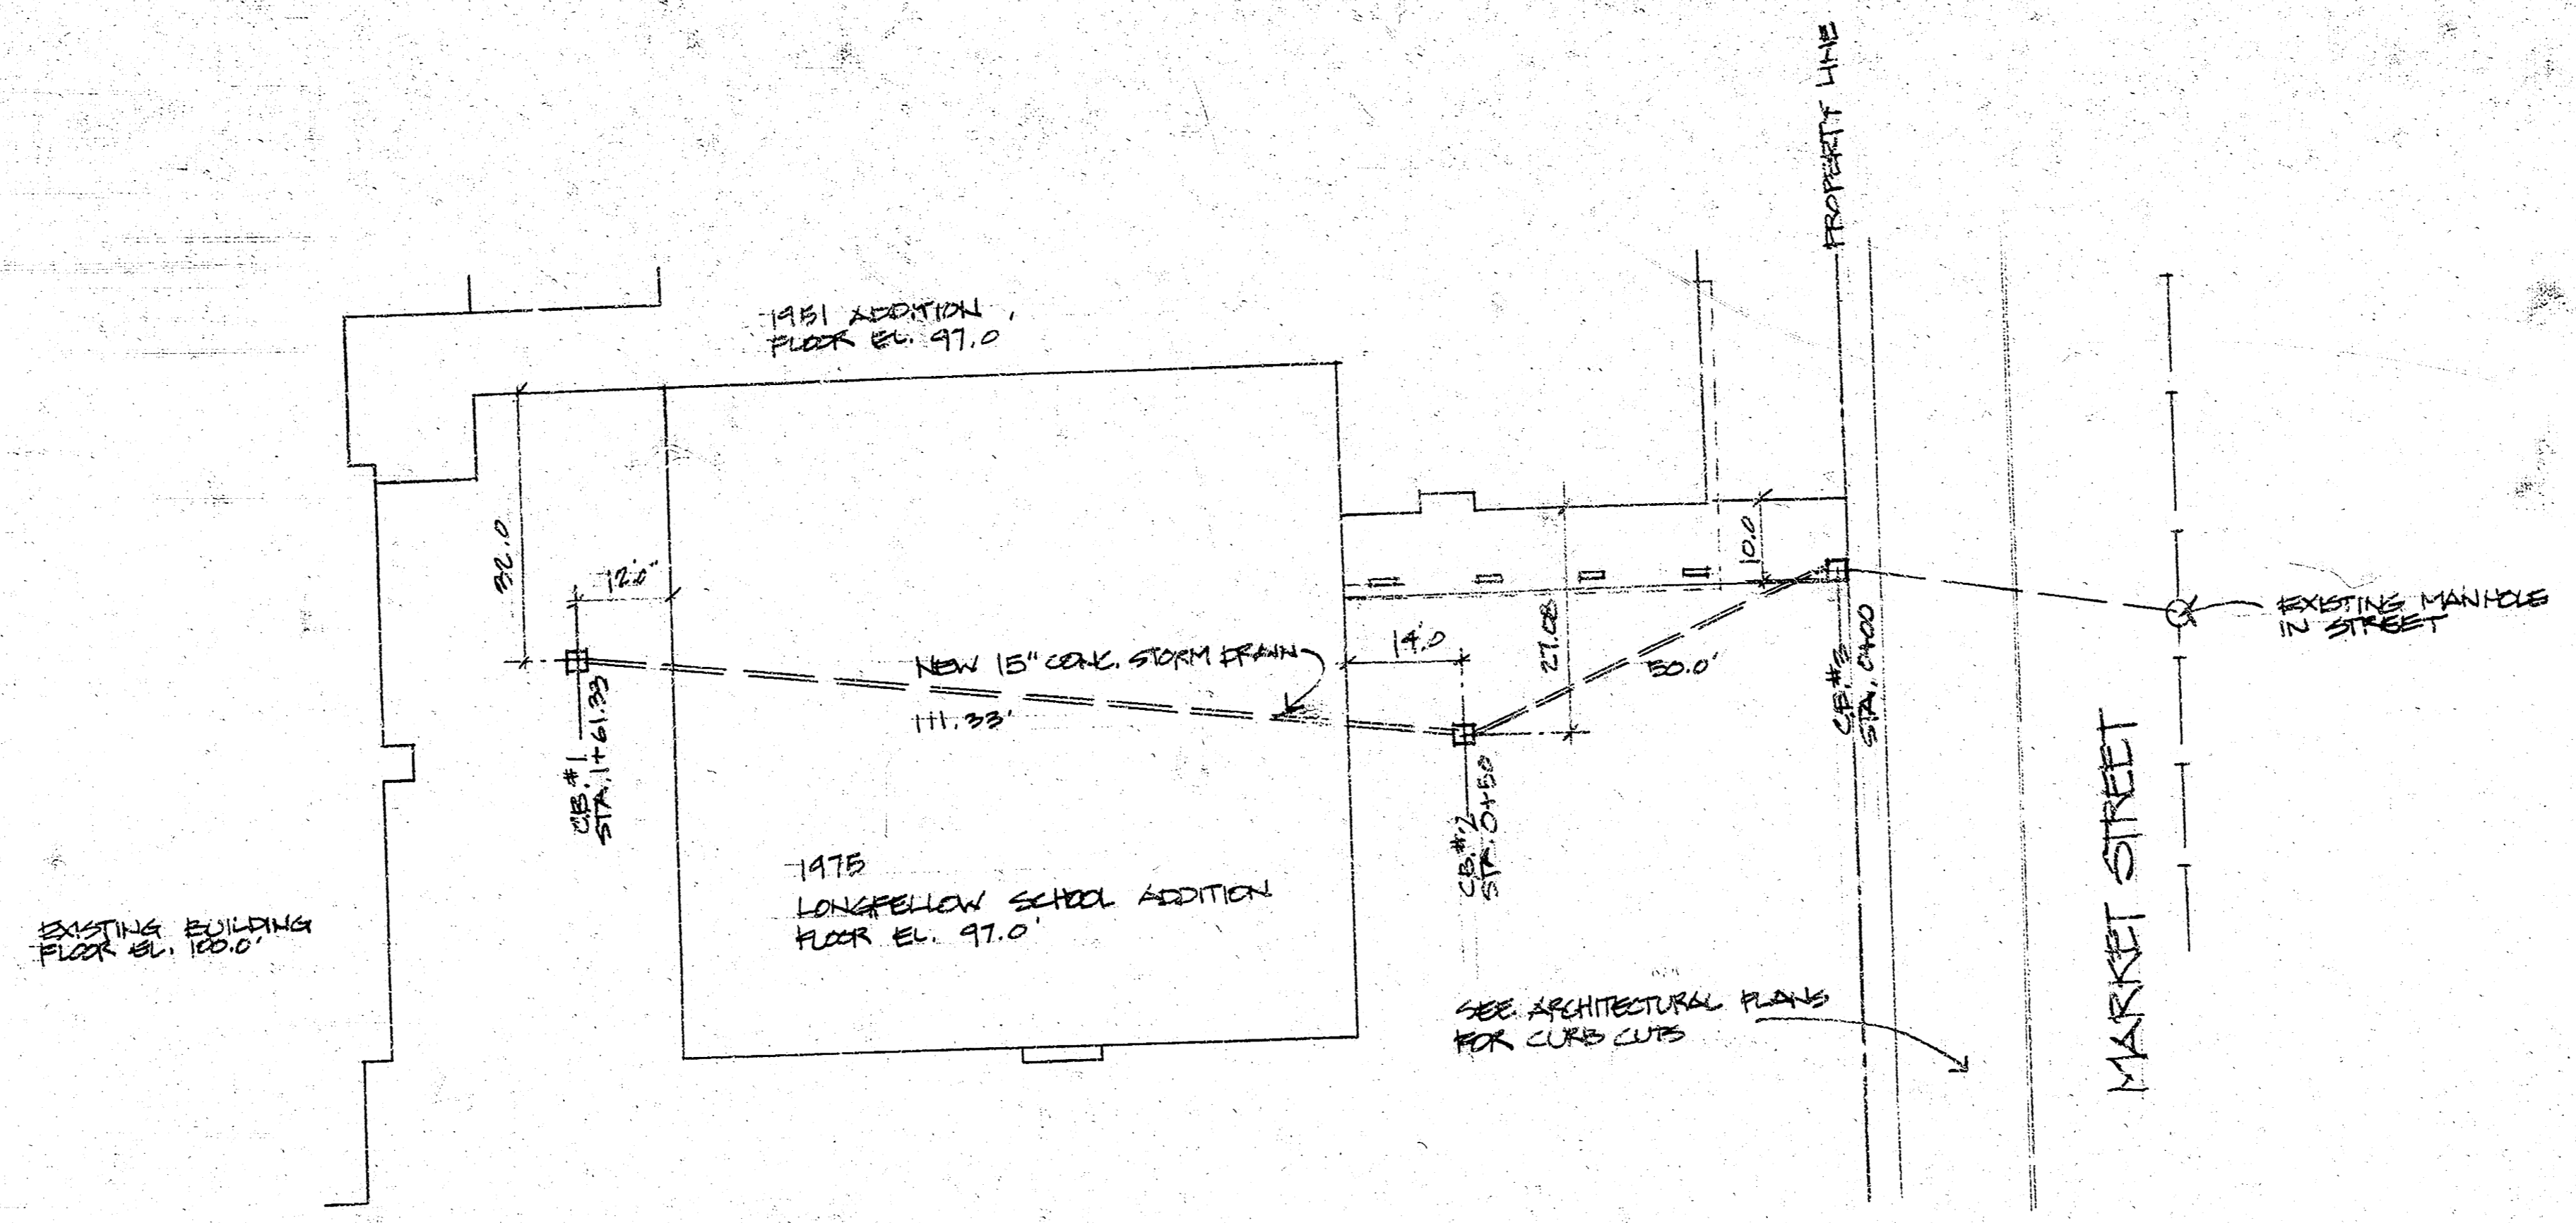

SITE PLAN / STORM DRAIN LAYOUT
SCALE 1" = 20'-0"

NOTE TO CONTRACTOR
This project will be constructed under the supervision of the CITY ENGINEER and conforming to the SPECIFICATIONS of the CITY OF WICHITA. The CONTRACTOR will reimburse the City of Wichita for all cost of Engineering Plans and Inspections.

12-11-75
APPROVED AS NOTED
By CITY ENGINEER OF WICHITA


Sanitary Sewers	
Storm Sewers	D.E.S.
Driveway Approaches	

**1975 ADDITION to
LONGFELLOW
ELEMENTARY SCHOOL**
2116 S. MAIN, WICHITA, KANSAS
U. S. D. #259 WICHITA, KANSAS



WILBUR F. KRUSE, ARCHITECT
1401 PERRY 265-6934
WICHITA, KANS. 67203

12/11/75
JAH

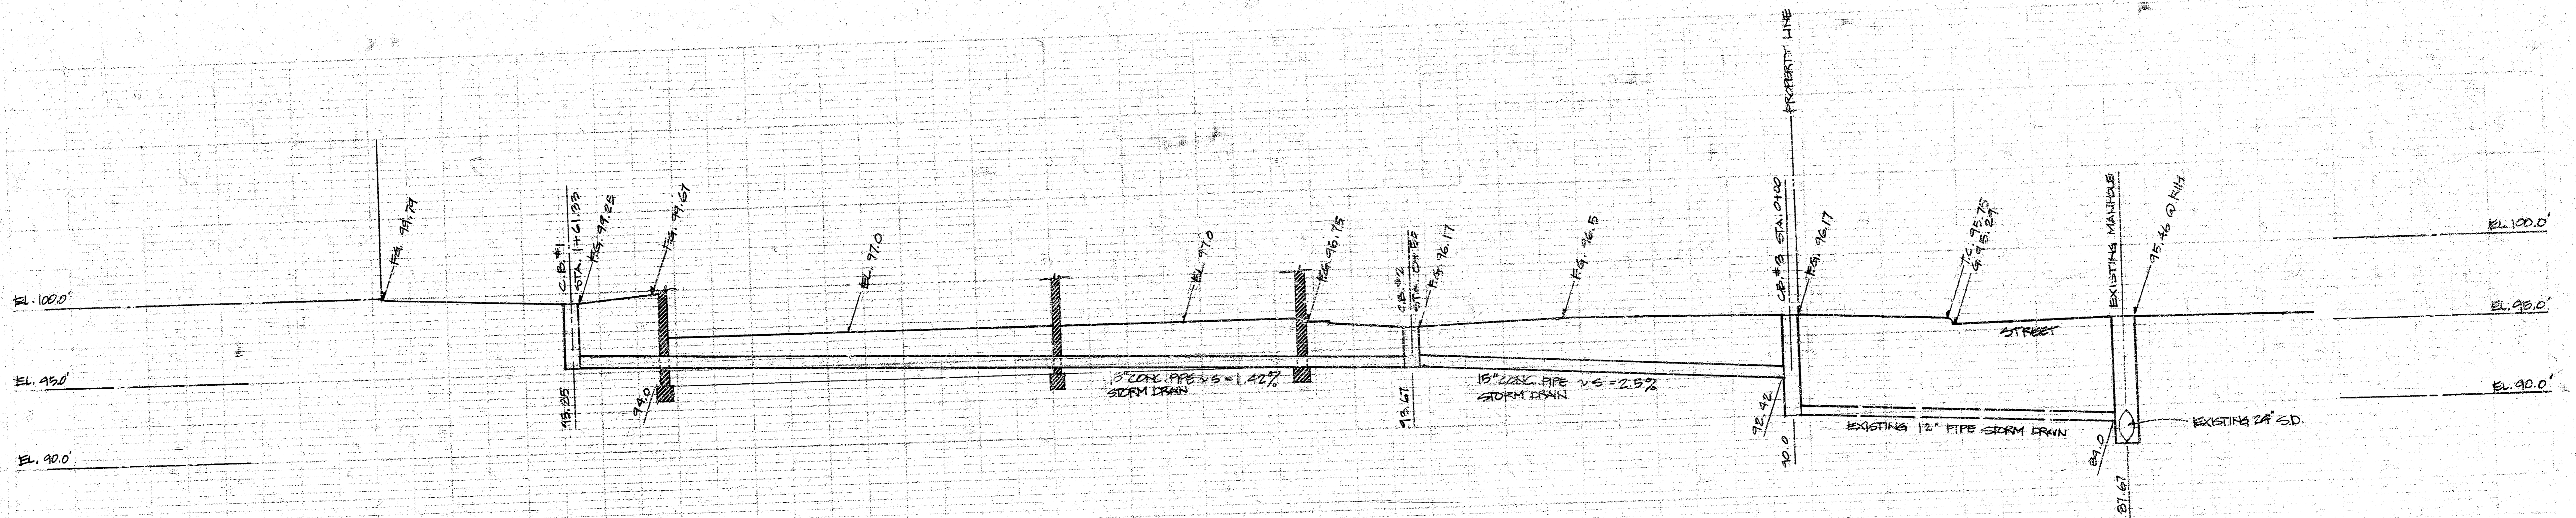

STORM DRAIN PROFILE
HORIZONTAL 1" = 10'-0"
VERTICAL 1" = 5'-0"

CB = CATCH BASIN
F.A. = FINISH GRADE
EL. = ELEVATION, M.K.

PROJECT NO. 105054