

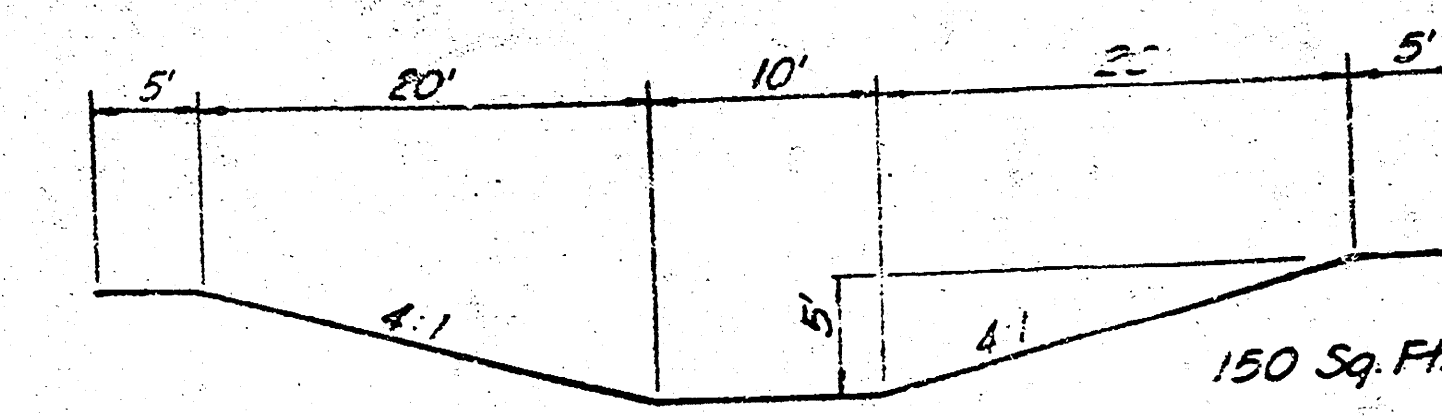


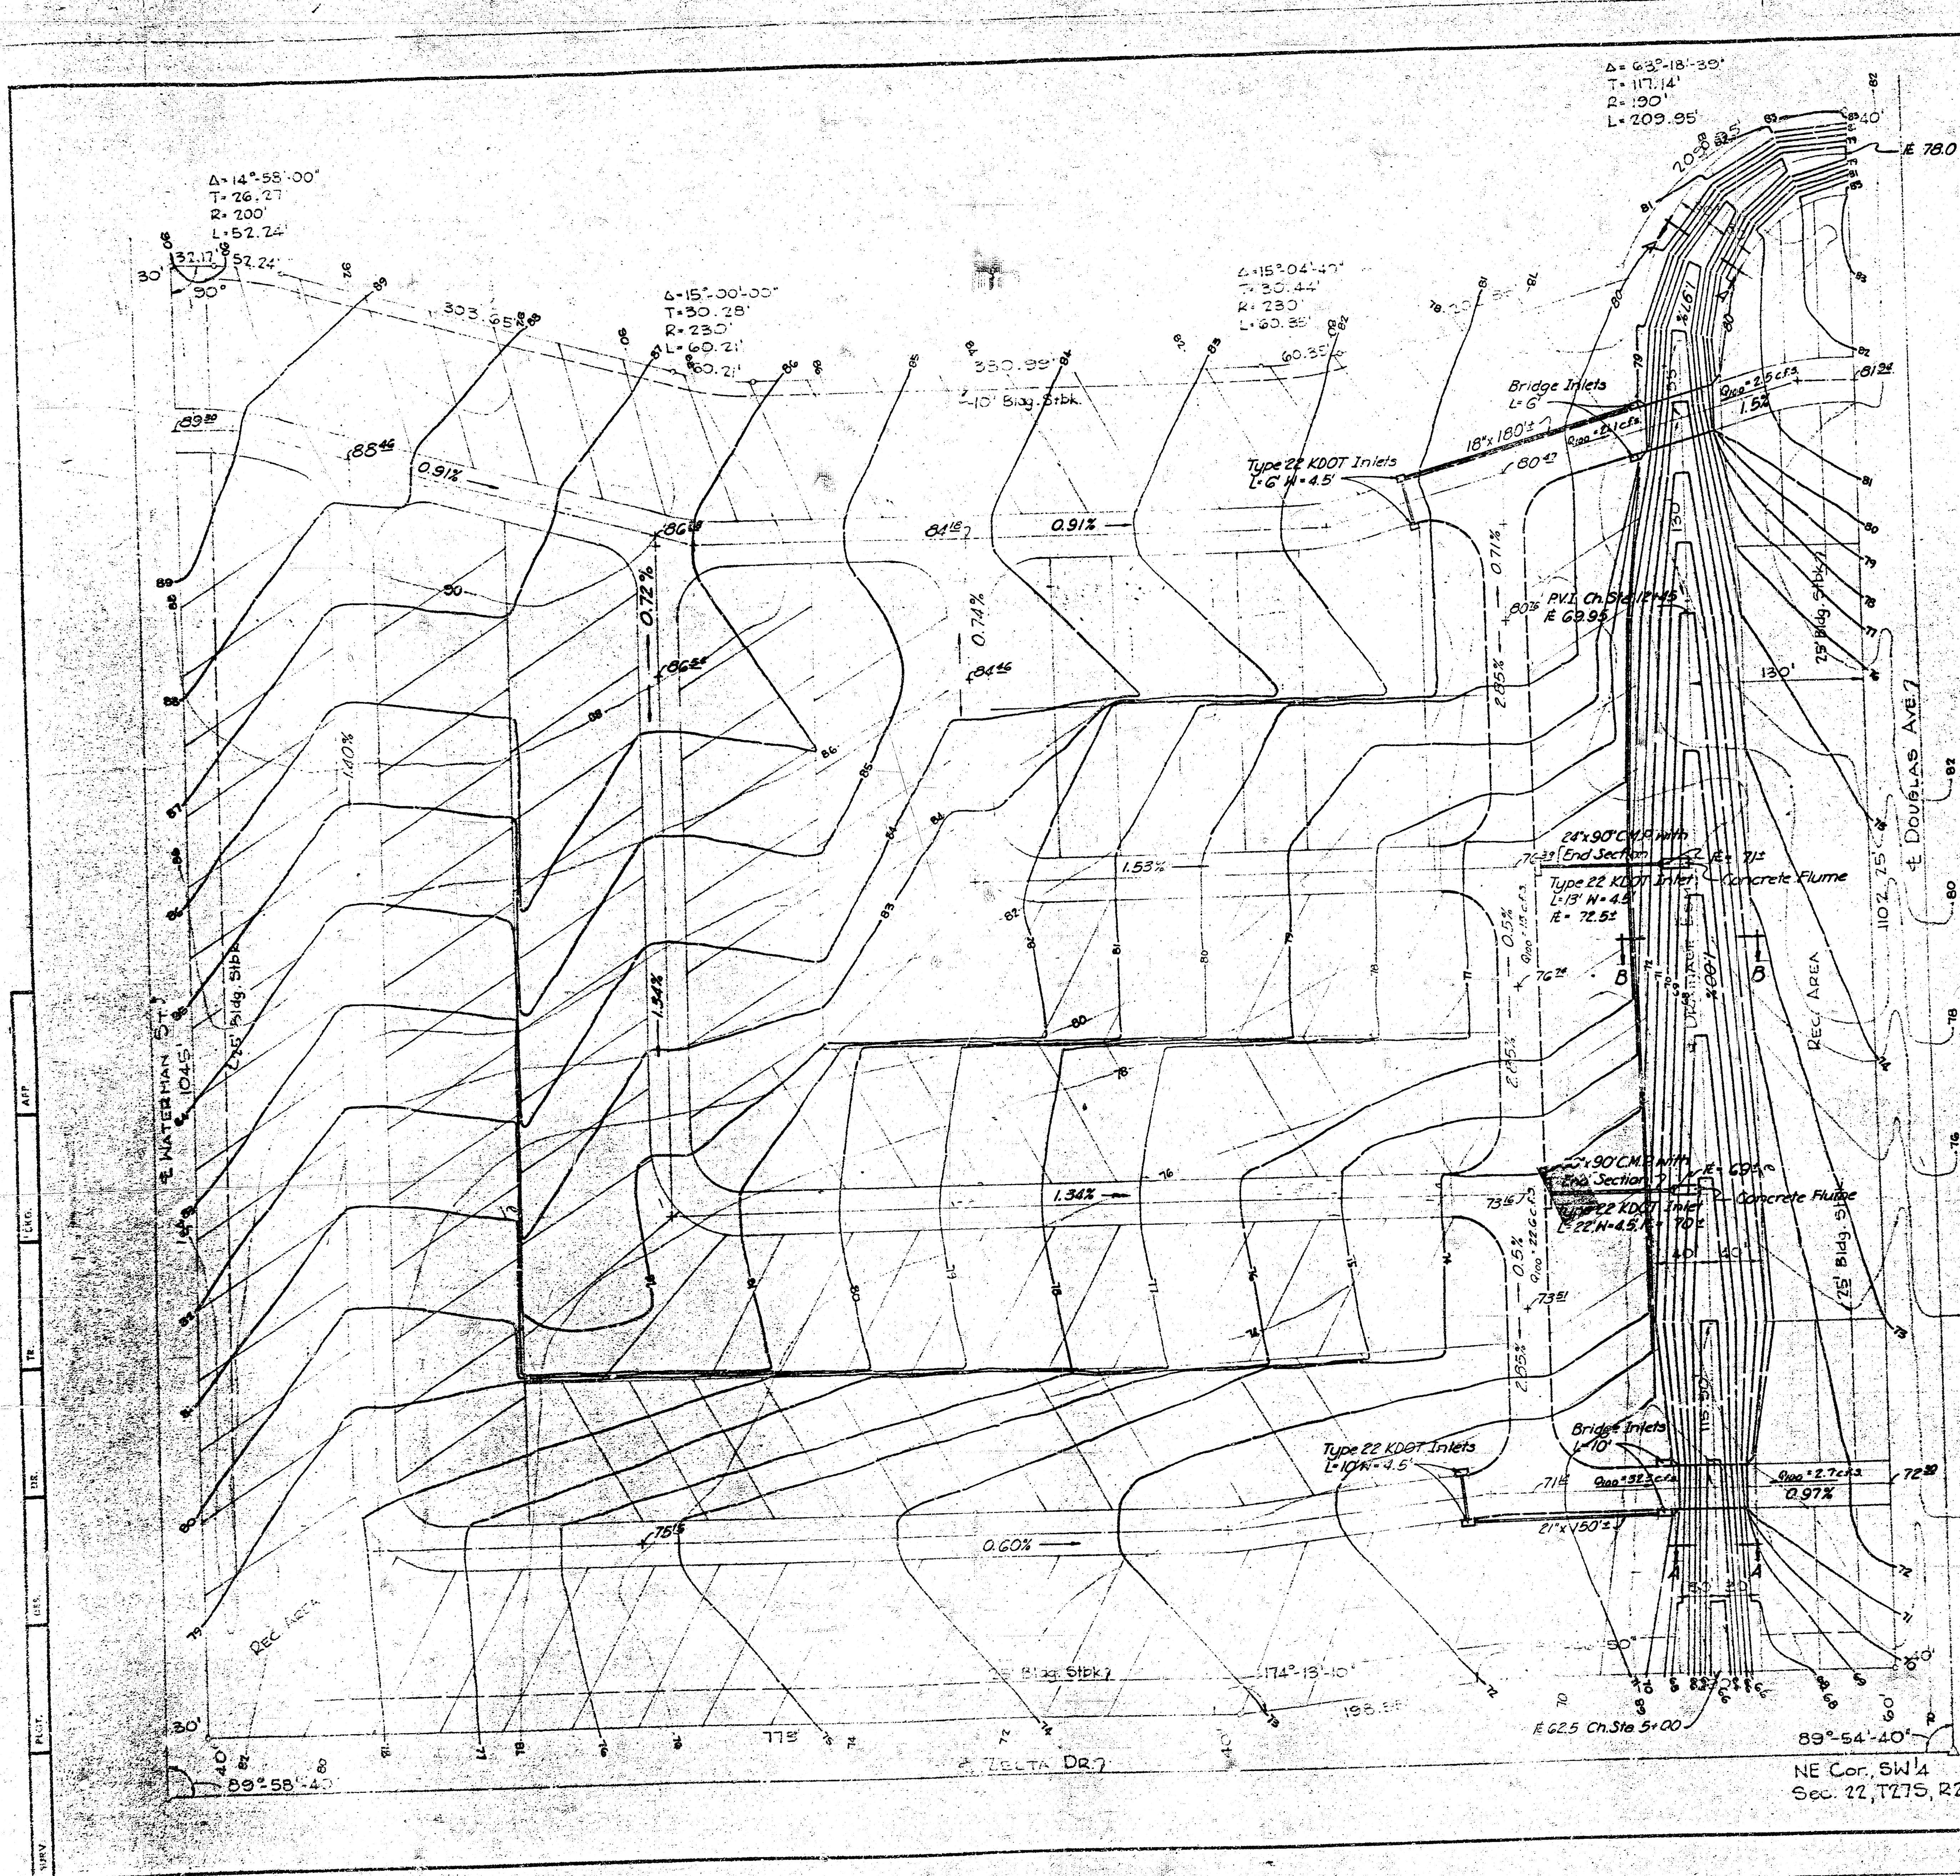

SECTION A-A

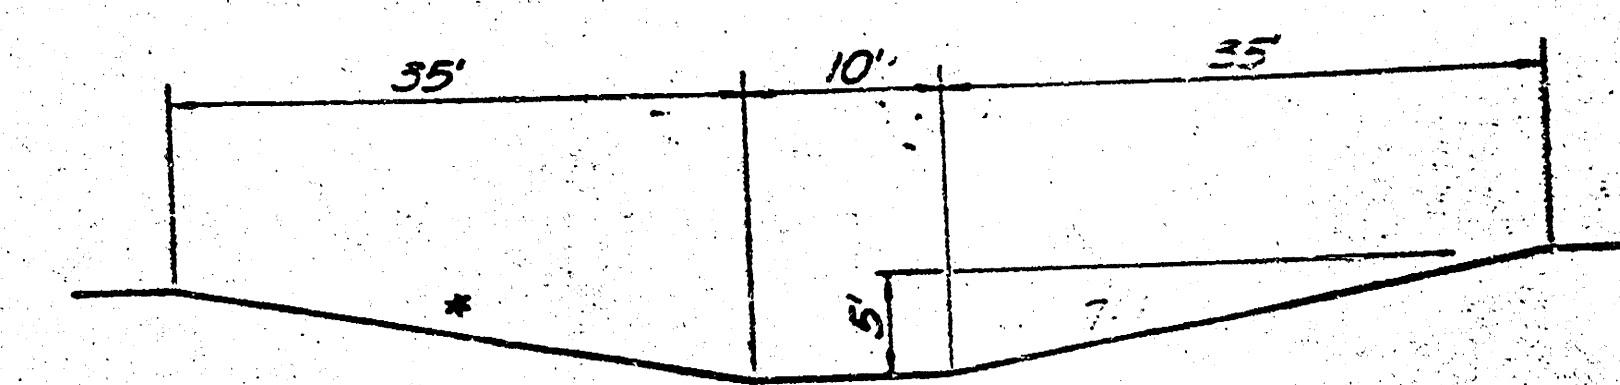

SECTION B-B

NOTE: Waterway opening provided at bridge crossings over drainage easement will equal or exceed 150 sq. ft.
 Outfall opening size at bridge inlets will equal or exceed inlet opening size.
 Unless otherwise designated all Cuts = Gutter is 4" Alternate Roll Type.


APPROVED AS NOTED
 By CITY ENGINEER OF WICHITA
 Sanitary Sewers
 Storm Sewers
 Driveway Approaches

Maintenance Inspection Required
 Contact George Minton at 268-4599

LEGEND:
 STANDARD 6" CURB
 & GUTTER

NOTE TO CONTRACTOR
 This project will be constructed under the supervision of the City Engineer and conforming to the Specifications of the CITY OF WICHITA. The CONTRACTOR will reimburse the City of Wichita for all cost of Engineering and Inspection.

Excavation - 43,630 cu. yd.
 Embankment - 43,630 cu. yd.
 **Includes 19.5% for compaction

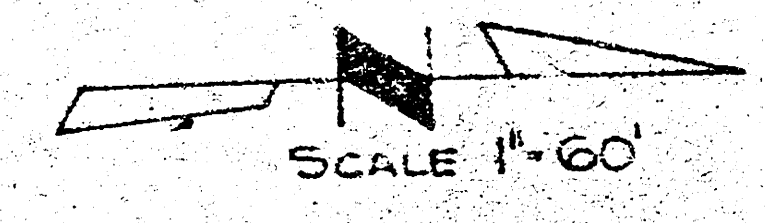

ENVIRONMENTAL ENTERPRISES INC.
 CECIL MASTERS, PRES PAUL TREADWELL, SEC.-TREAS.
 LIFESTYLE MOBILE HOME PARK
DRAINAGE & SITE GRADING PLAN
 DELAMATER, FREUND & ASSOCIATES, P.A.
 ENGINEERS & ARCHITECTS
 WICHITA, KANSAS
 SCALE 1"=60'
 DWG. 249-D-202