


B.M. 114.23' Broadway & 9th, Brass Rod In Concrete Post 20' West,
And 22' South Of Centerline Of Both.

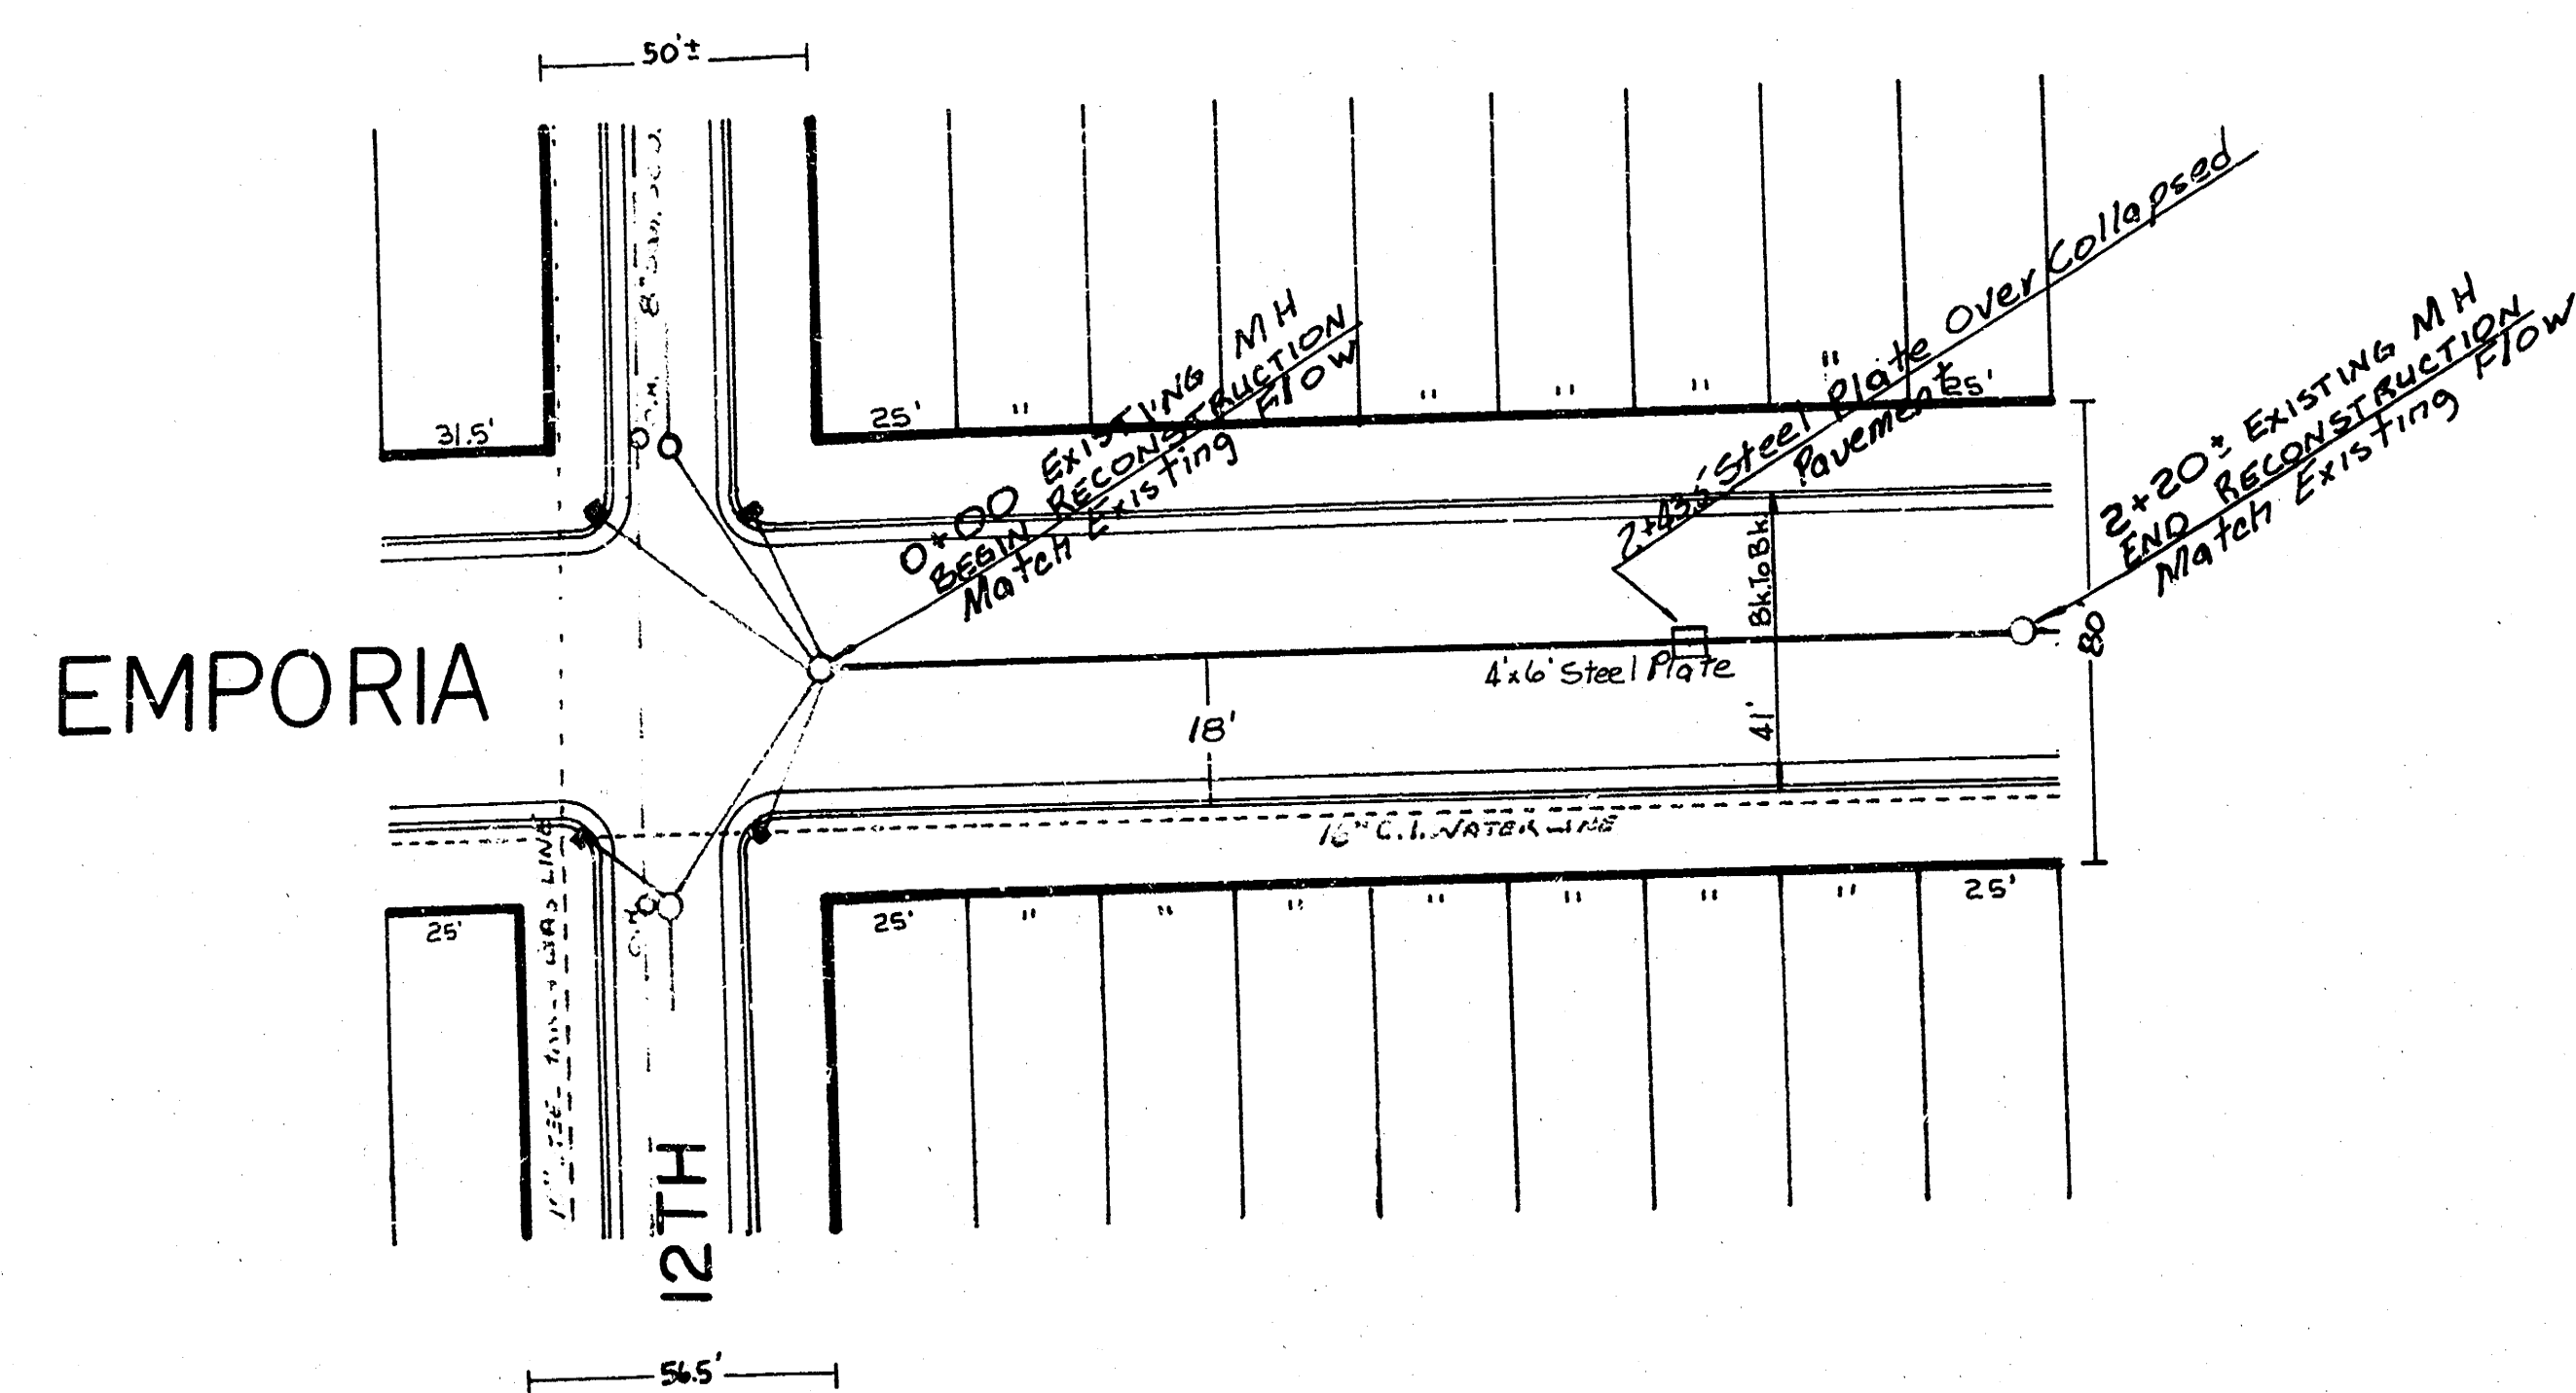


Scale: Plan 1" = 40'
Profile 1" = 40' Horiz.
1" = 5' Vert.

115

110

105

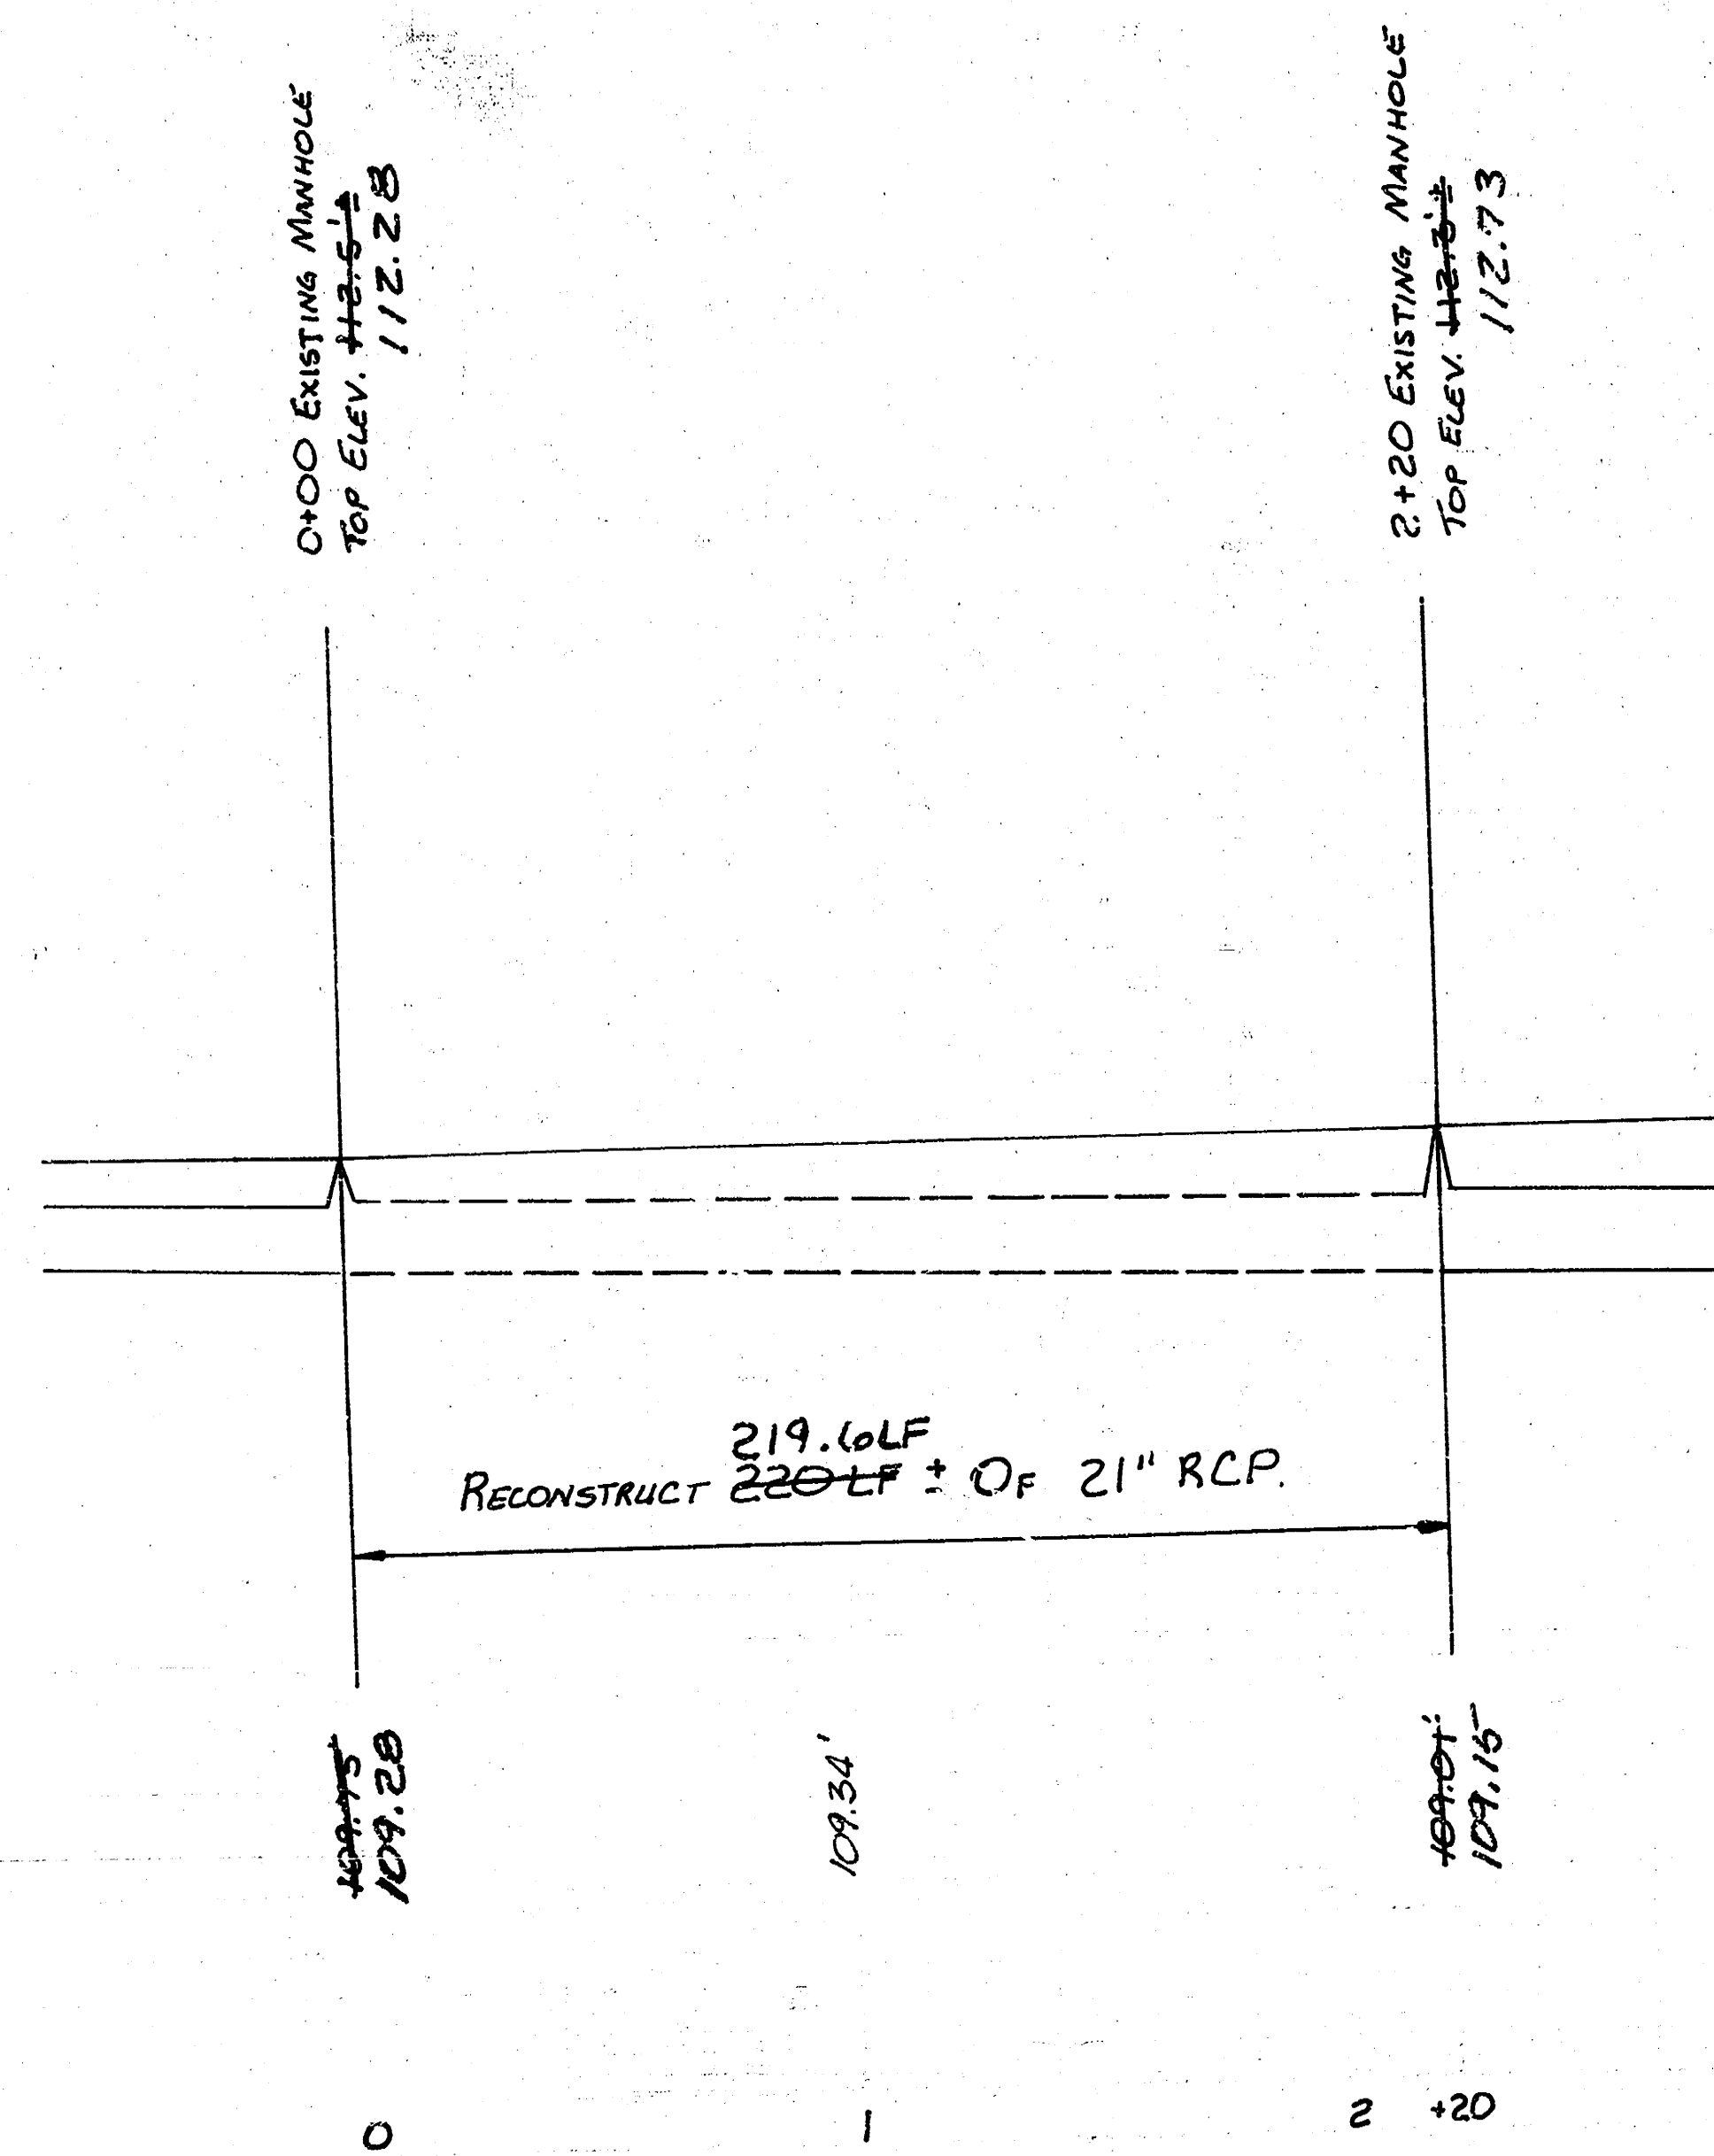


115


110



Scale: Plan 1" = 40'
Profile 1" = 40' Horiz.
1" = 5' Vert.

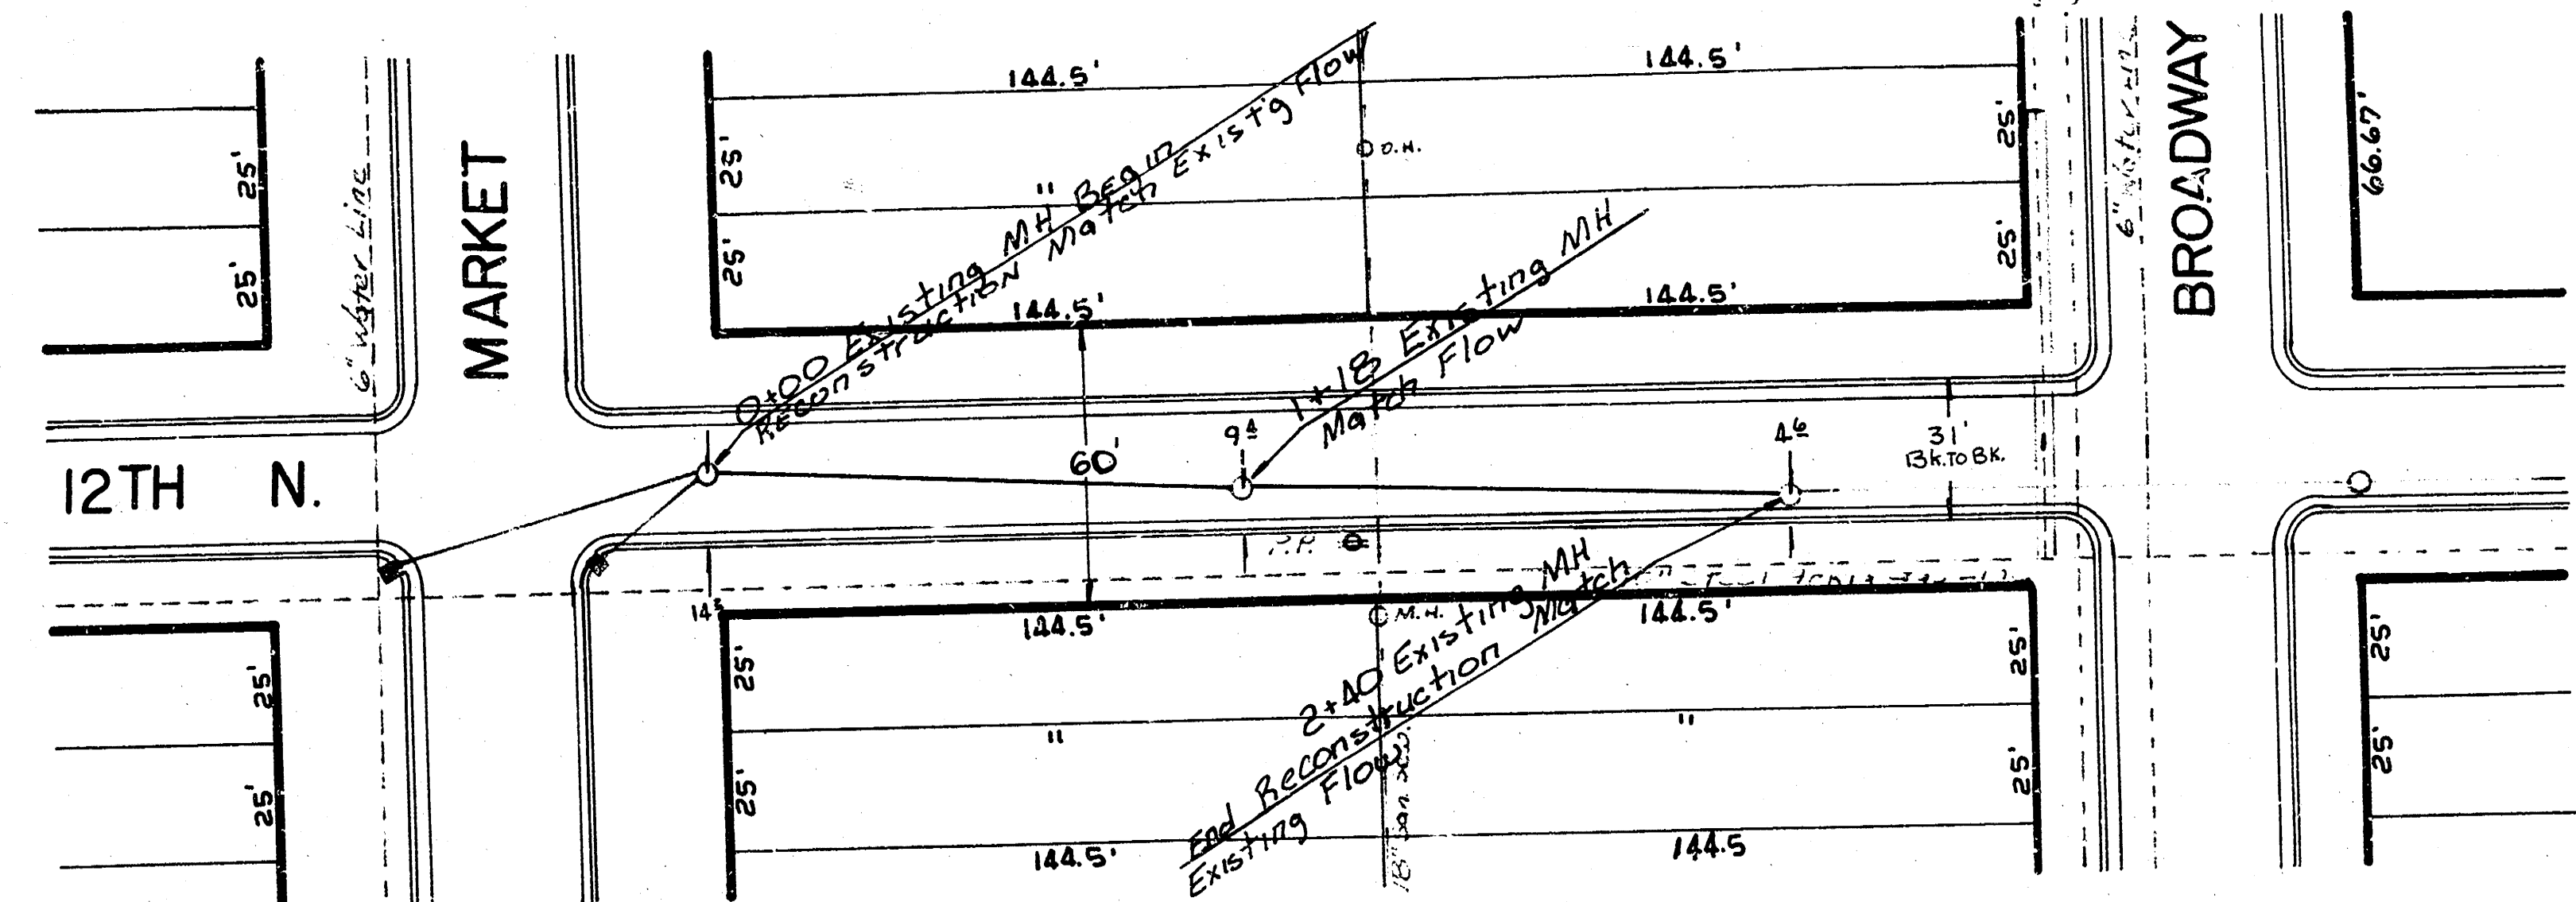

B.M. 114.23' Broadway & 9th, Brass Rod In Concrete
Post 20' West, And 22' South Of Centerline Of Both.

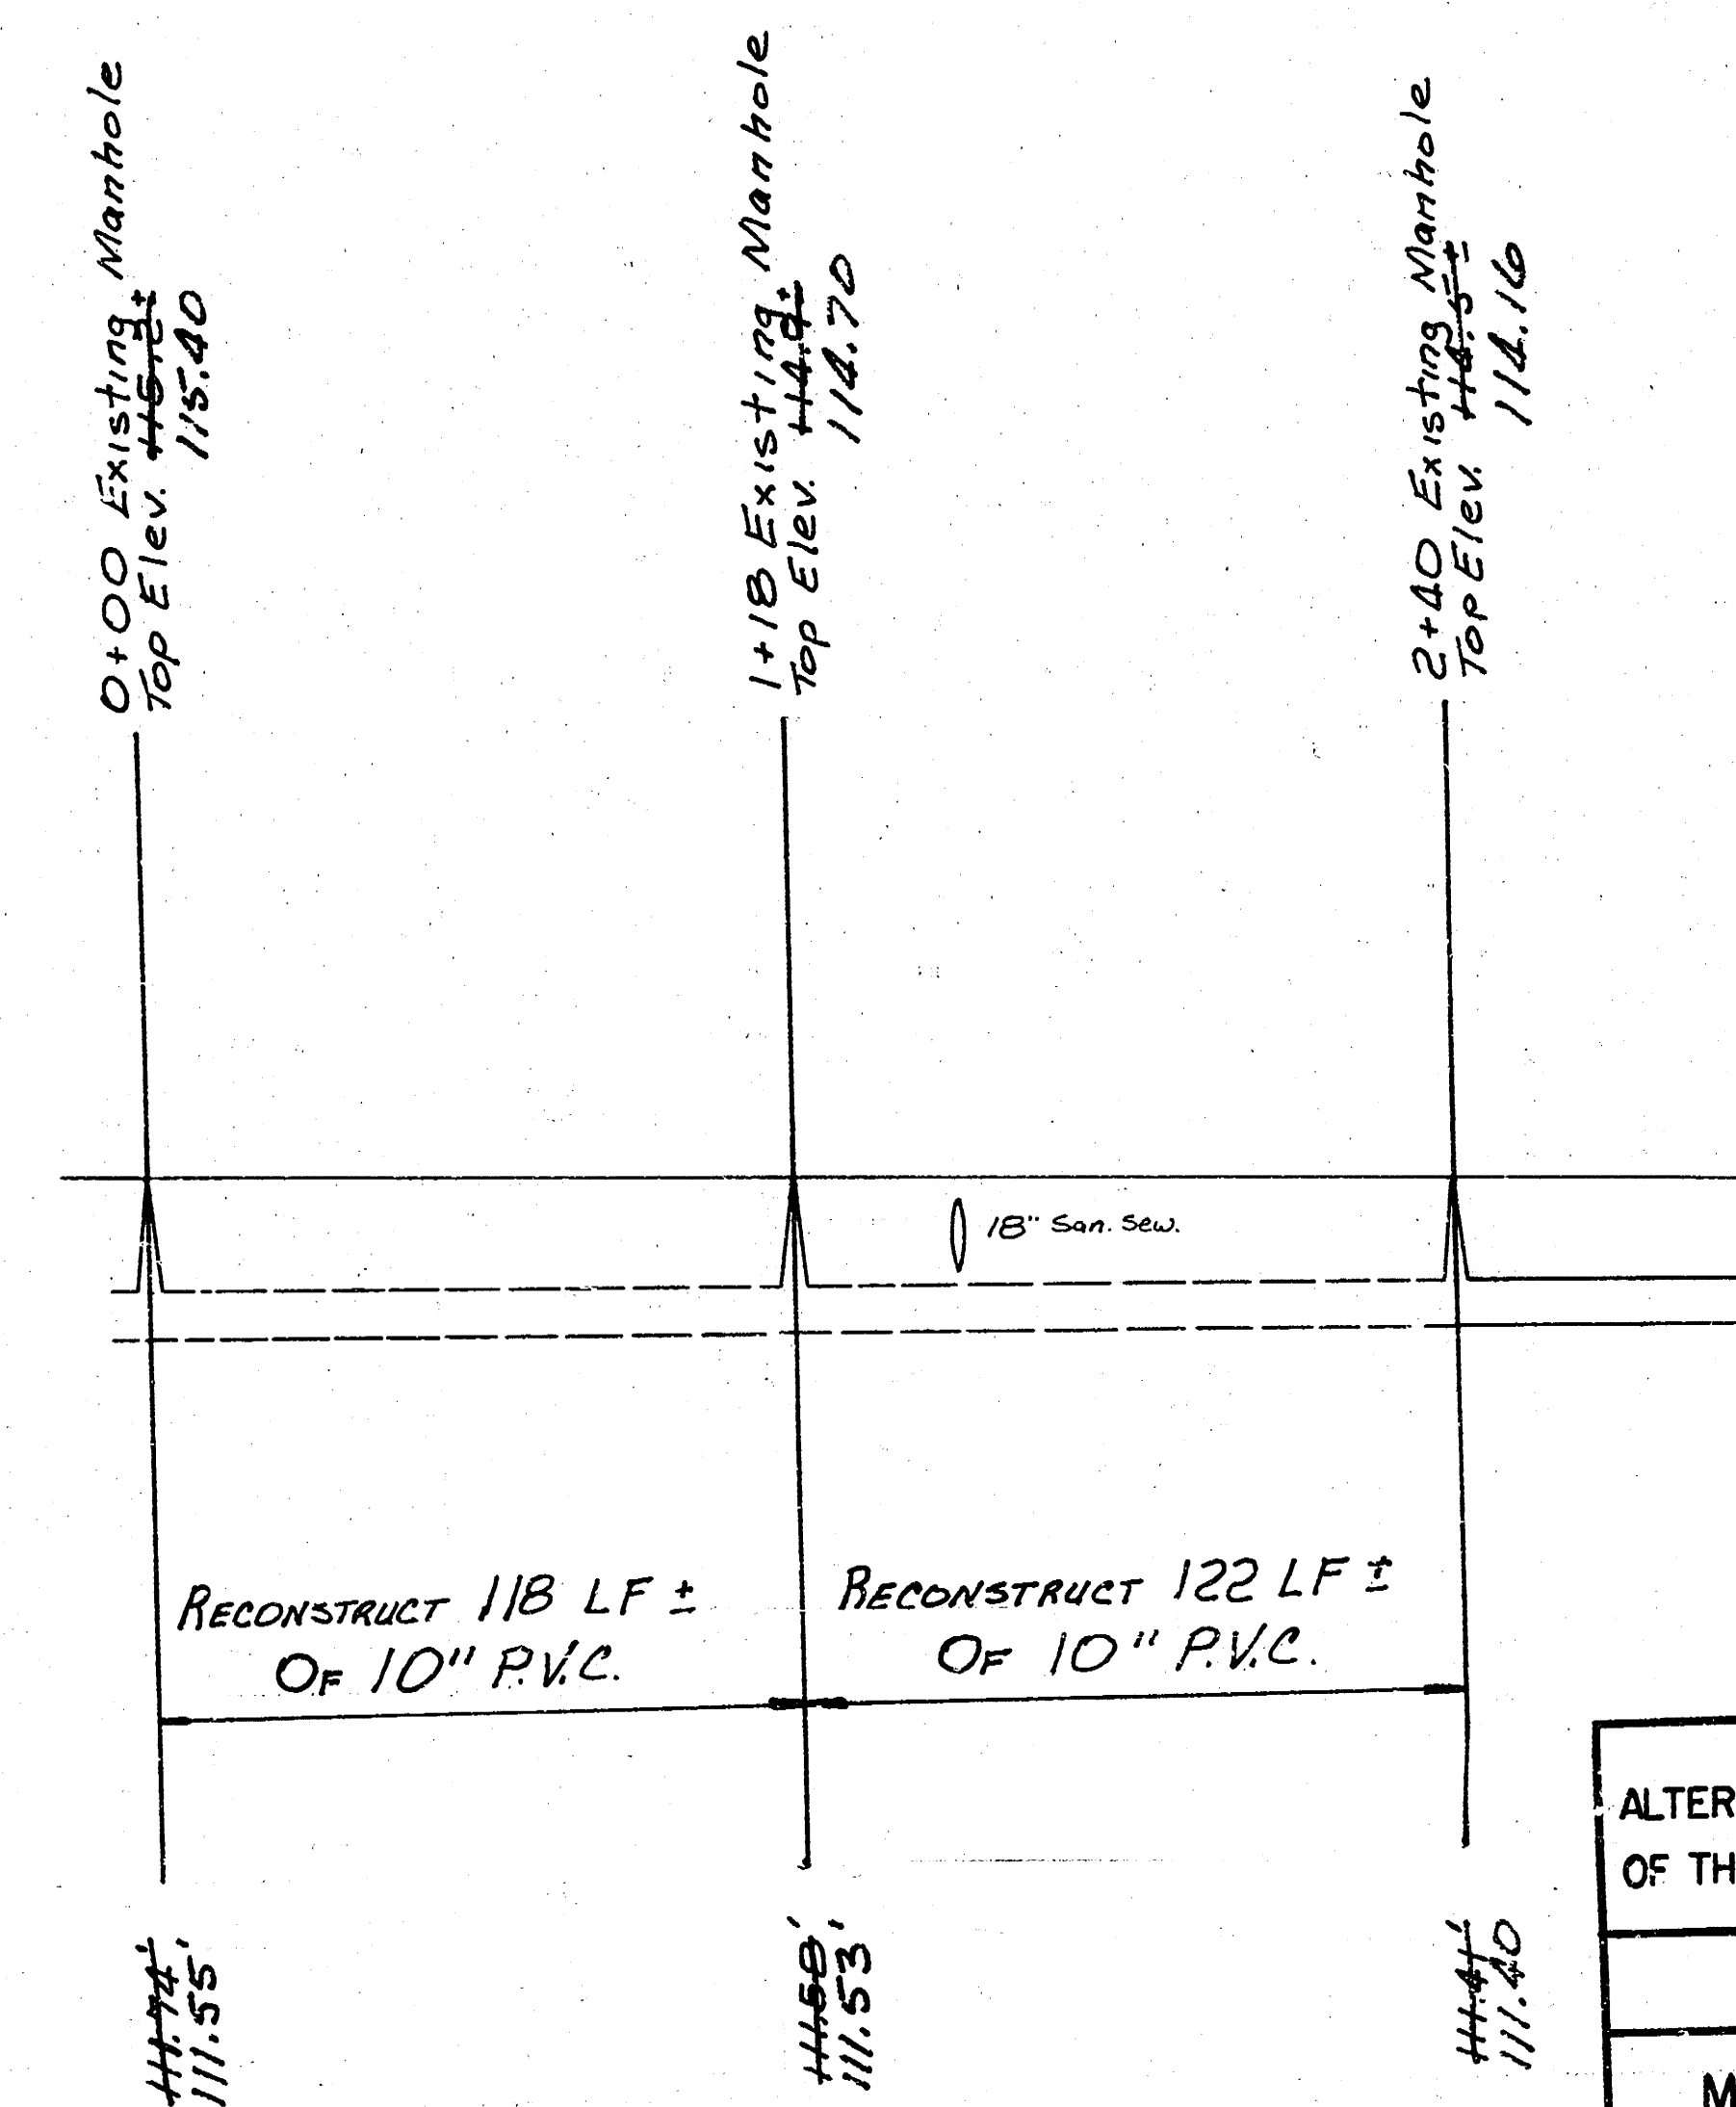

As Built
11-2-86
GREENE

PROJECT DESCRIPTION	
ALTER, REPAIR, RECONSTRUCT, OR CONSTRUCT A PORTION OF THE 12TH STREET LATERAL STORM SEWER	
468-76-245-81601-000-000-001	
MICHAEL E. LINDEBAK - CITY ENGINEER	
WICHITA, KANSAS	
1986	

SIC 587

10 8 1 3