

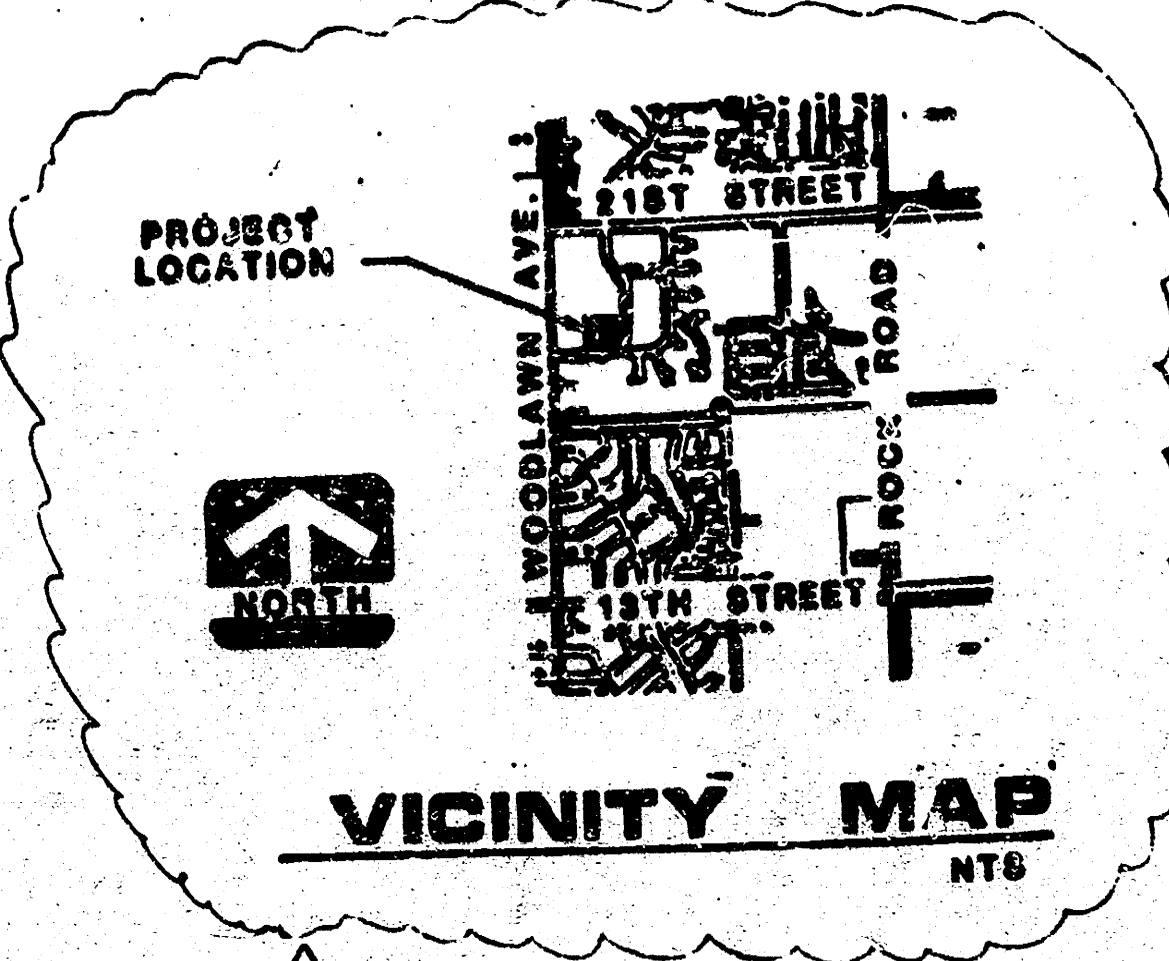
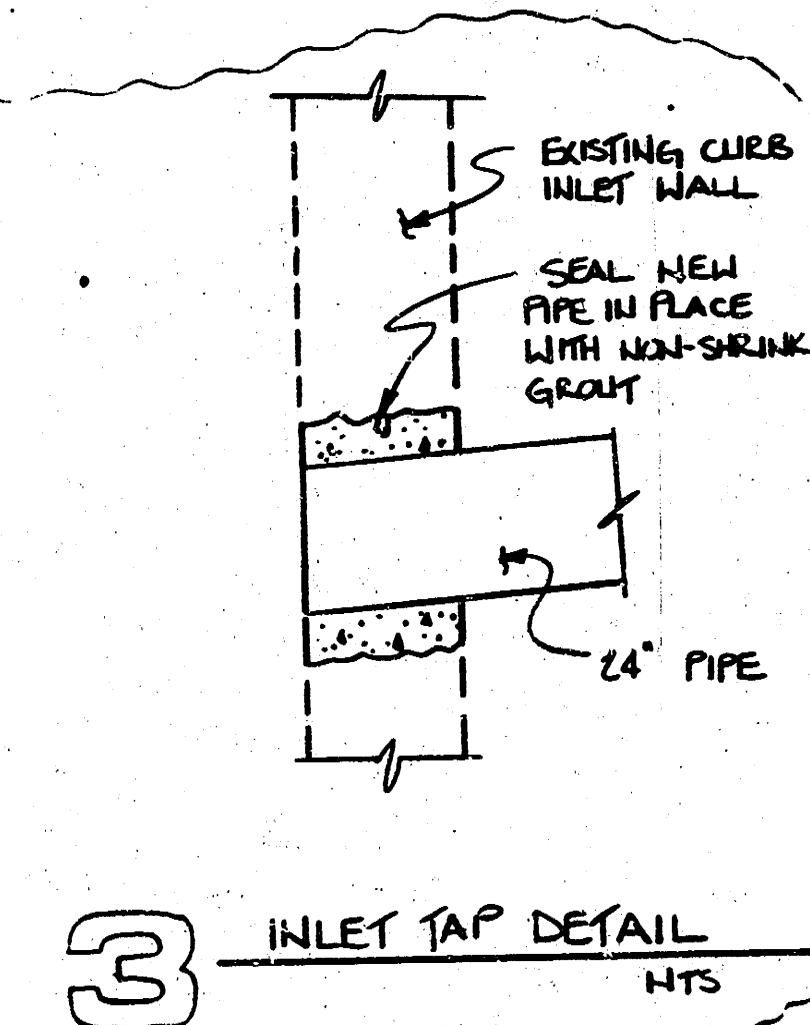
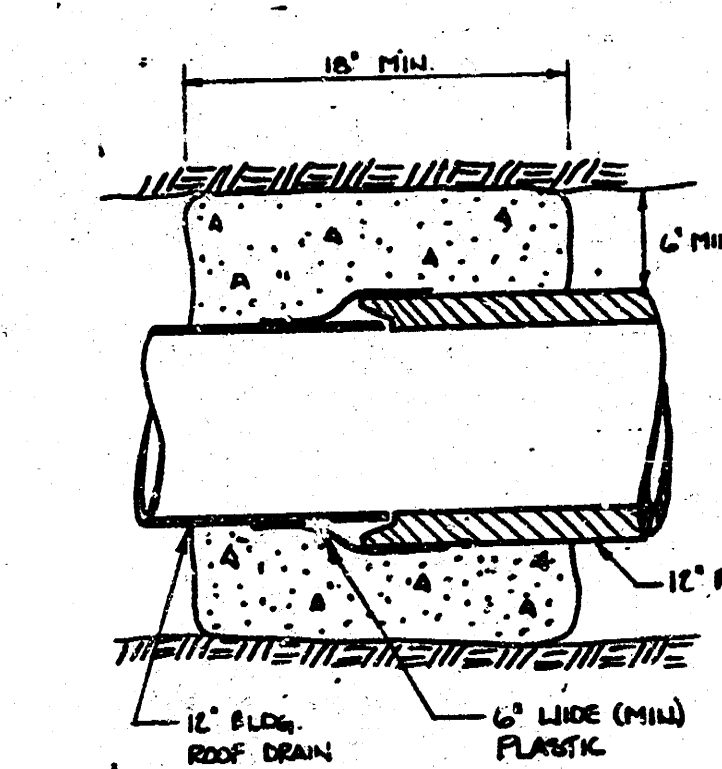
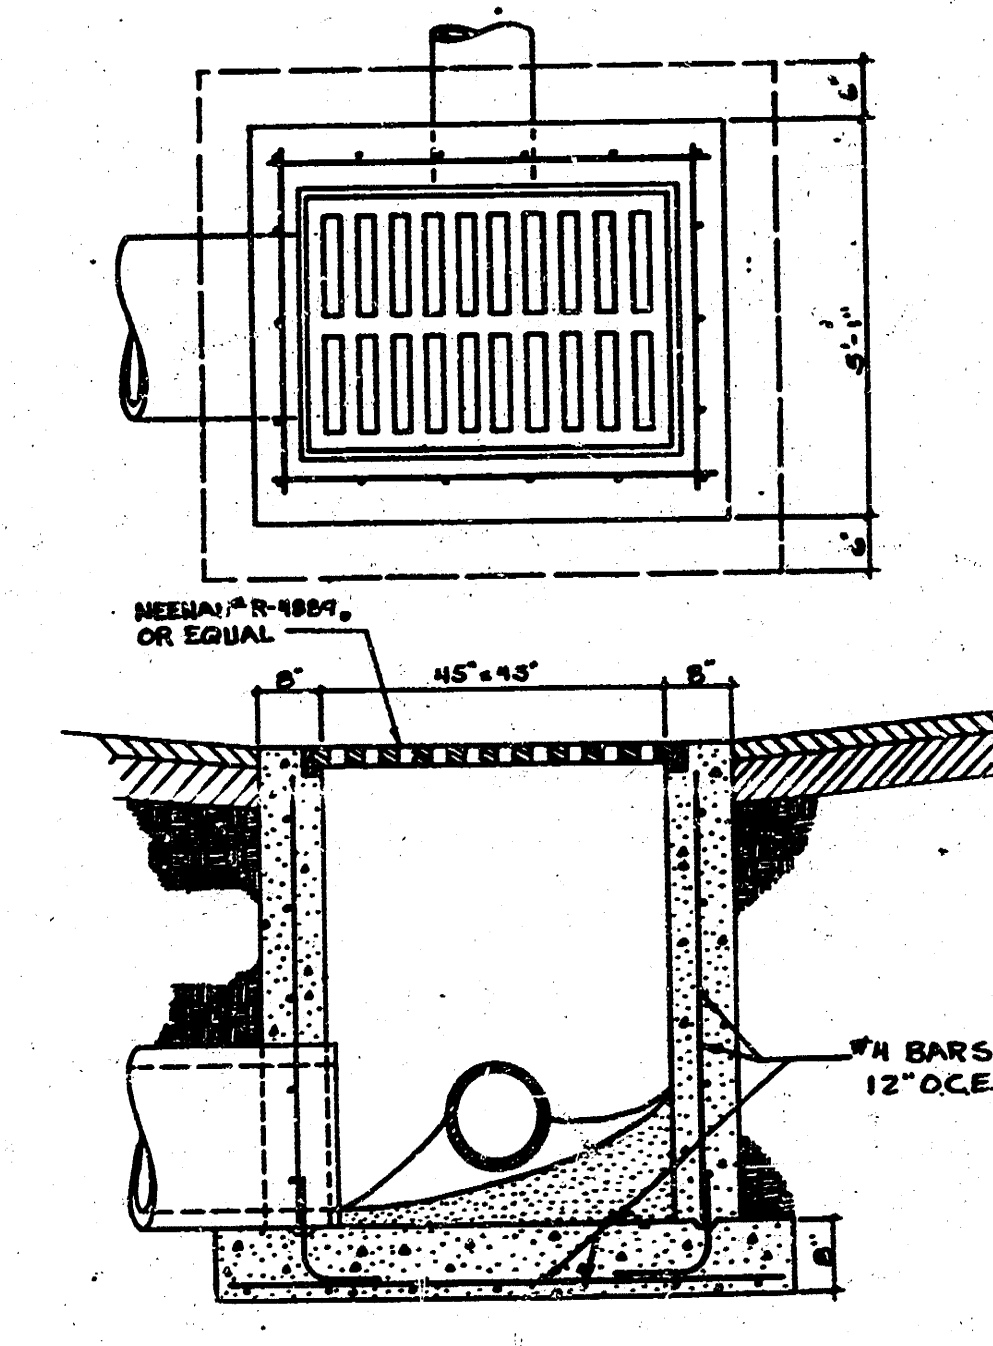
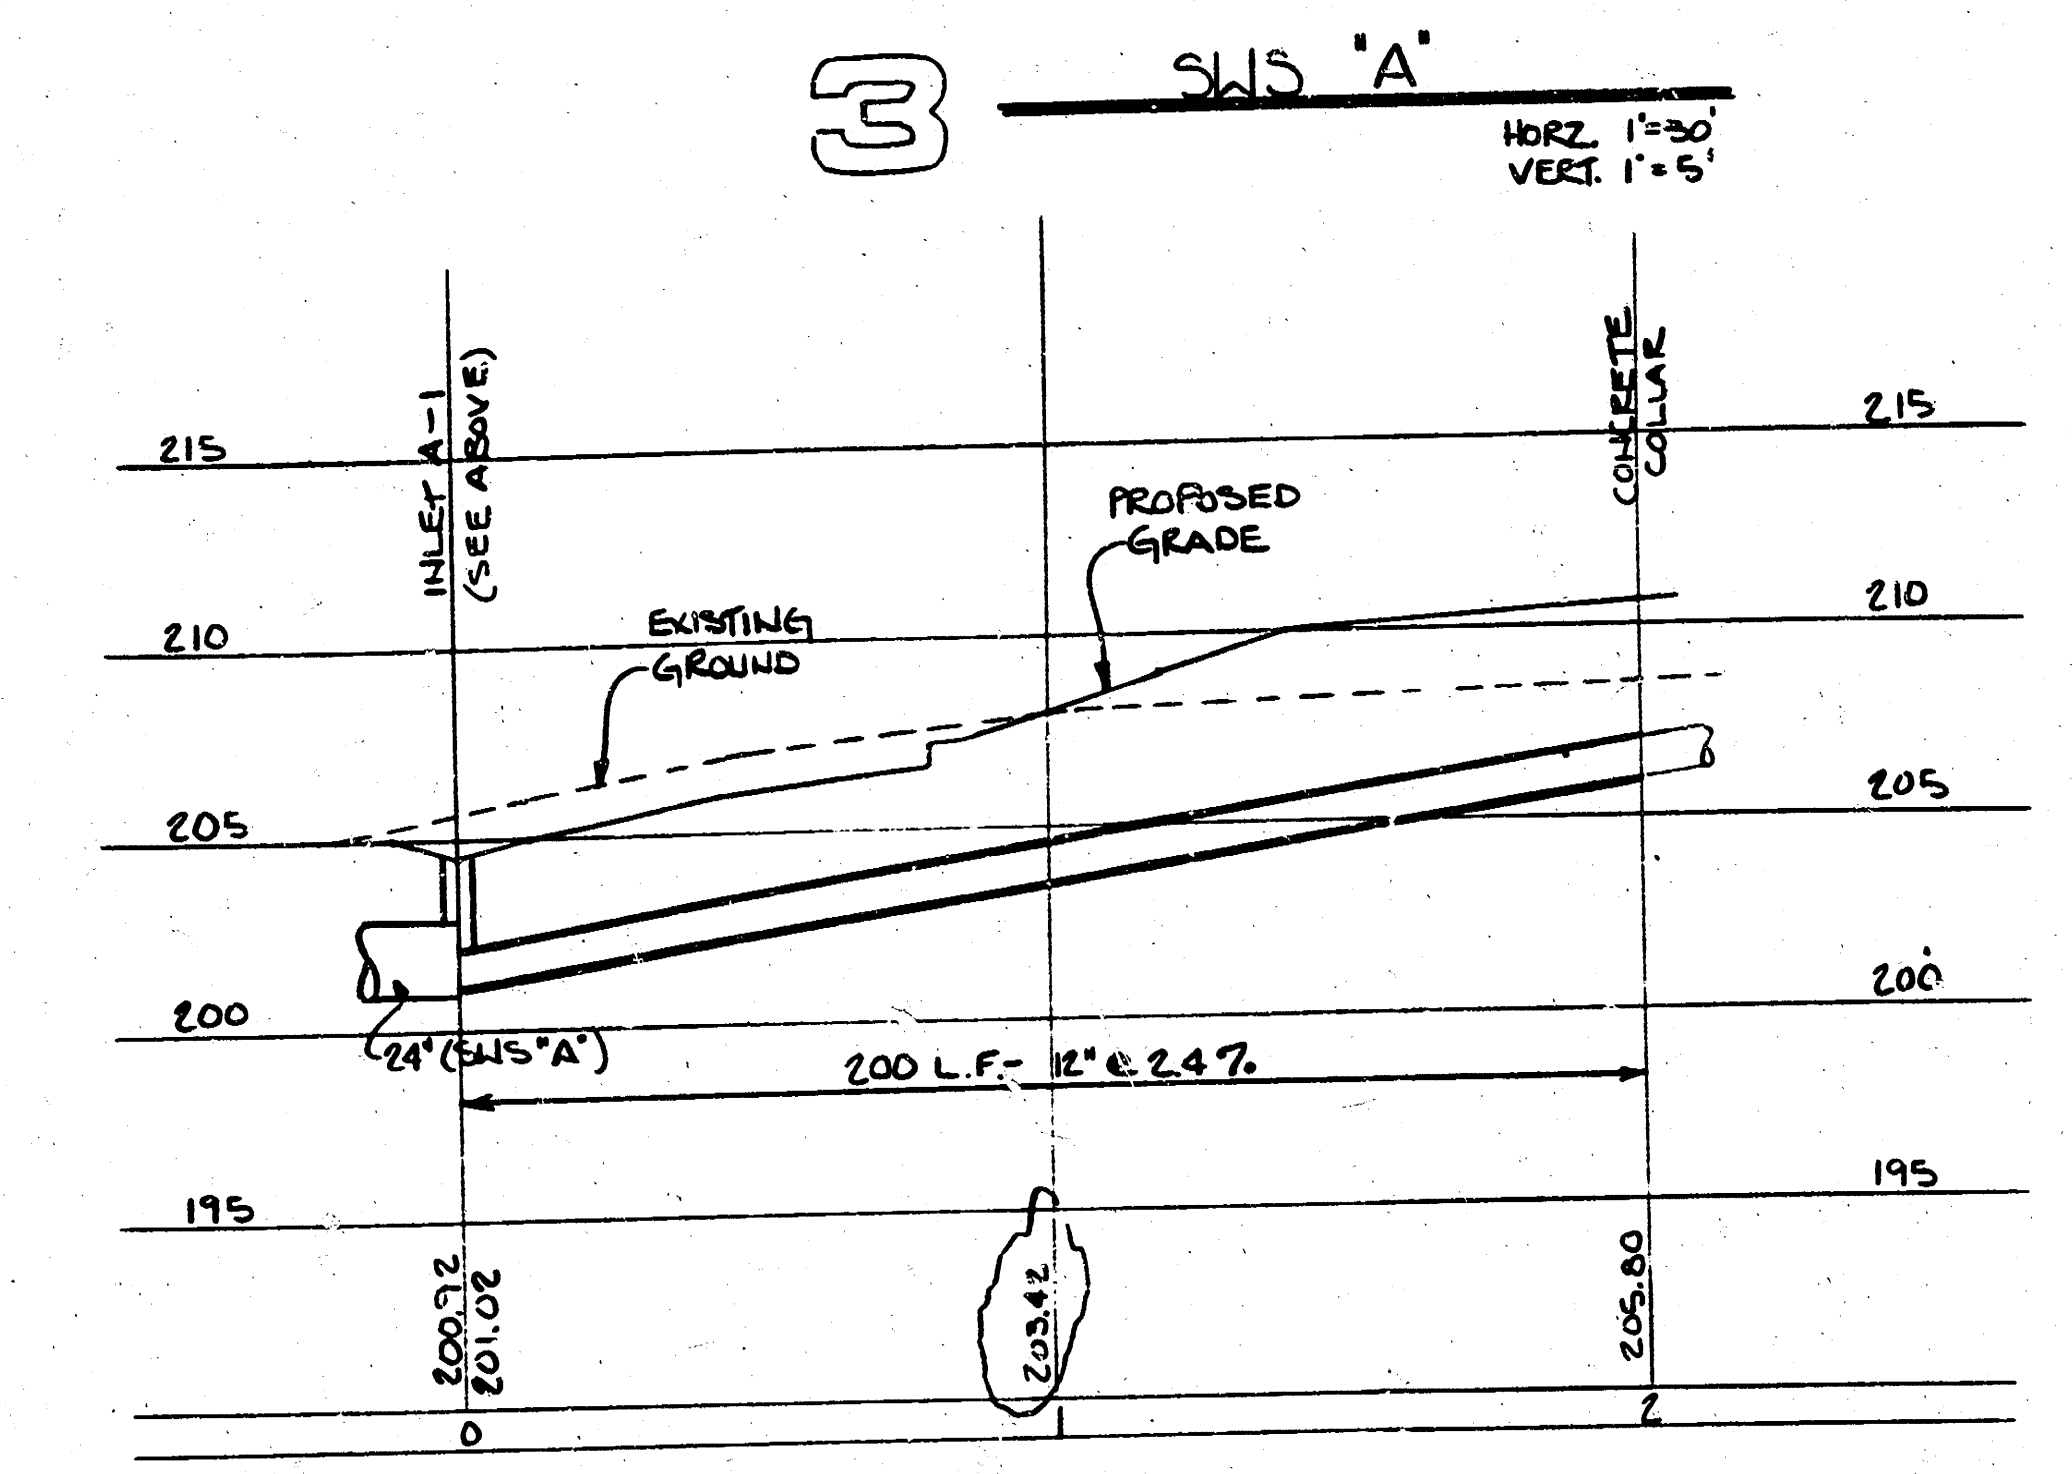


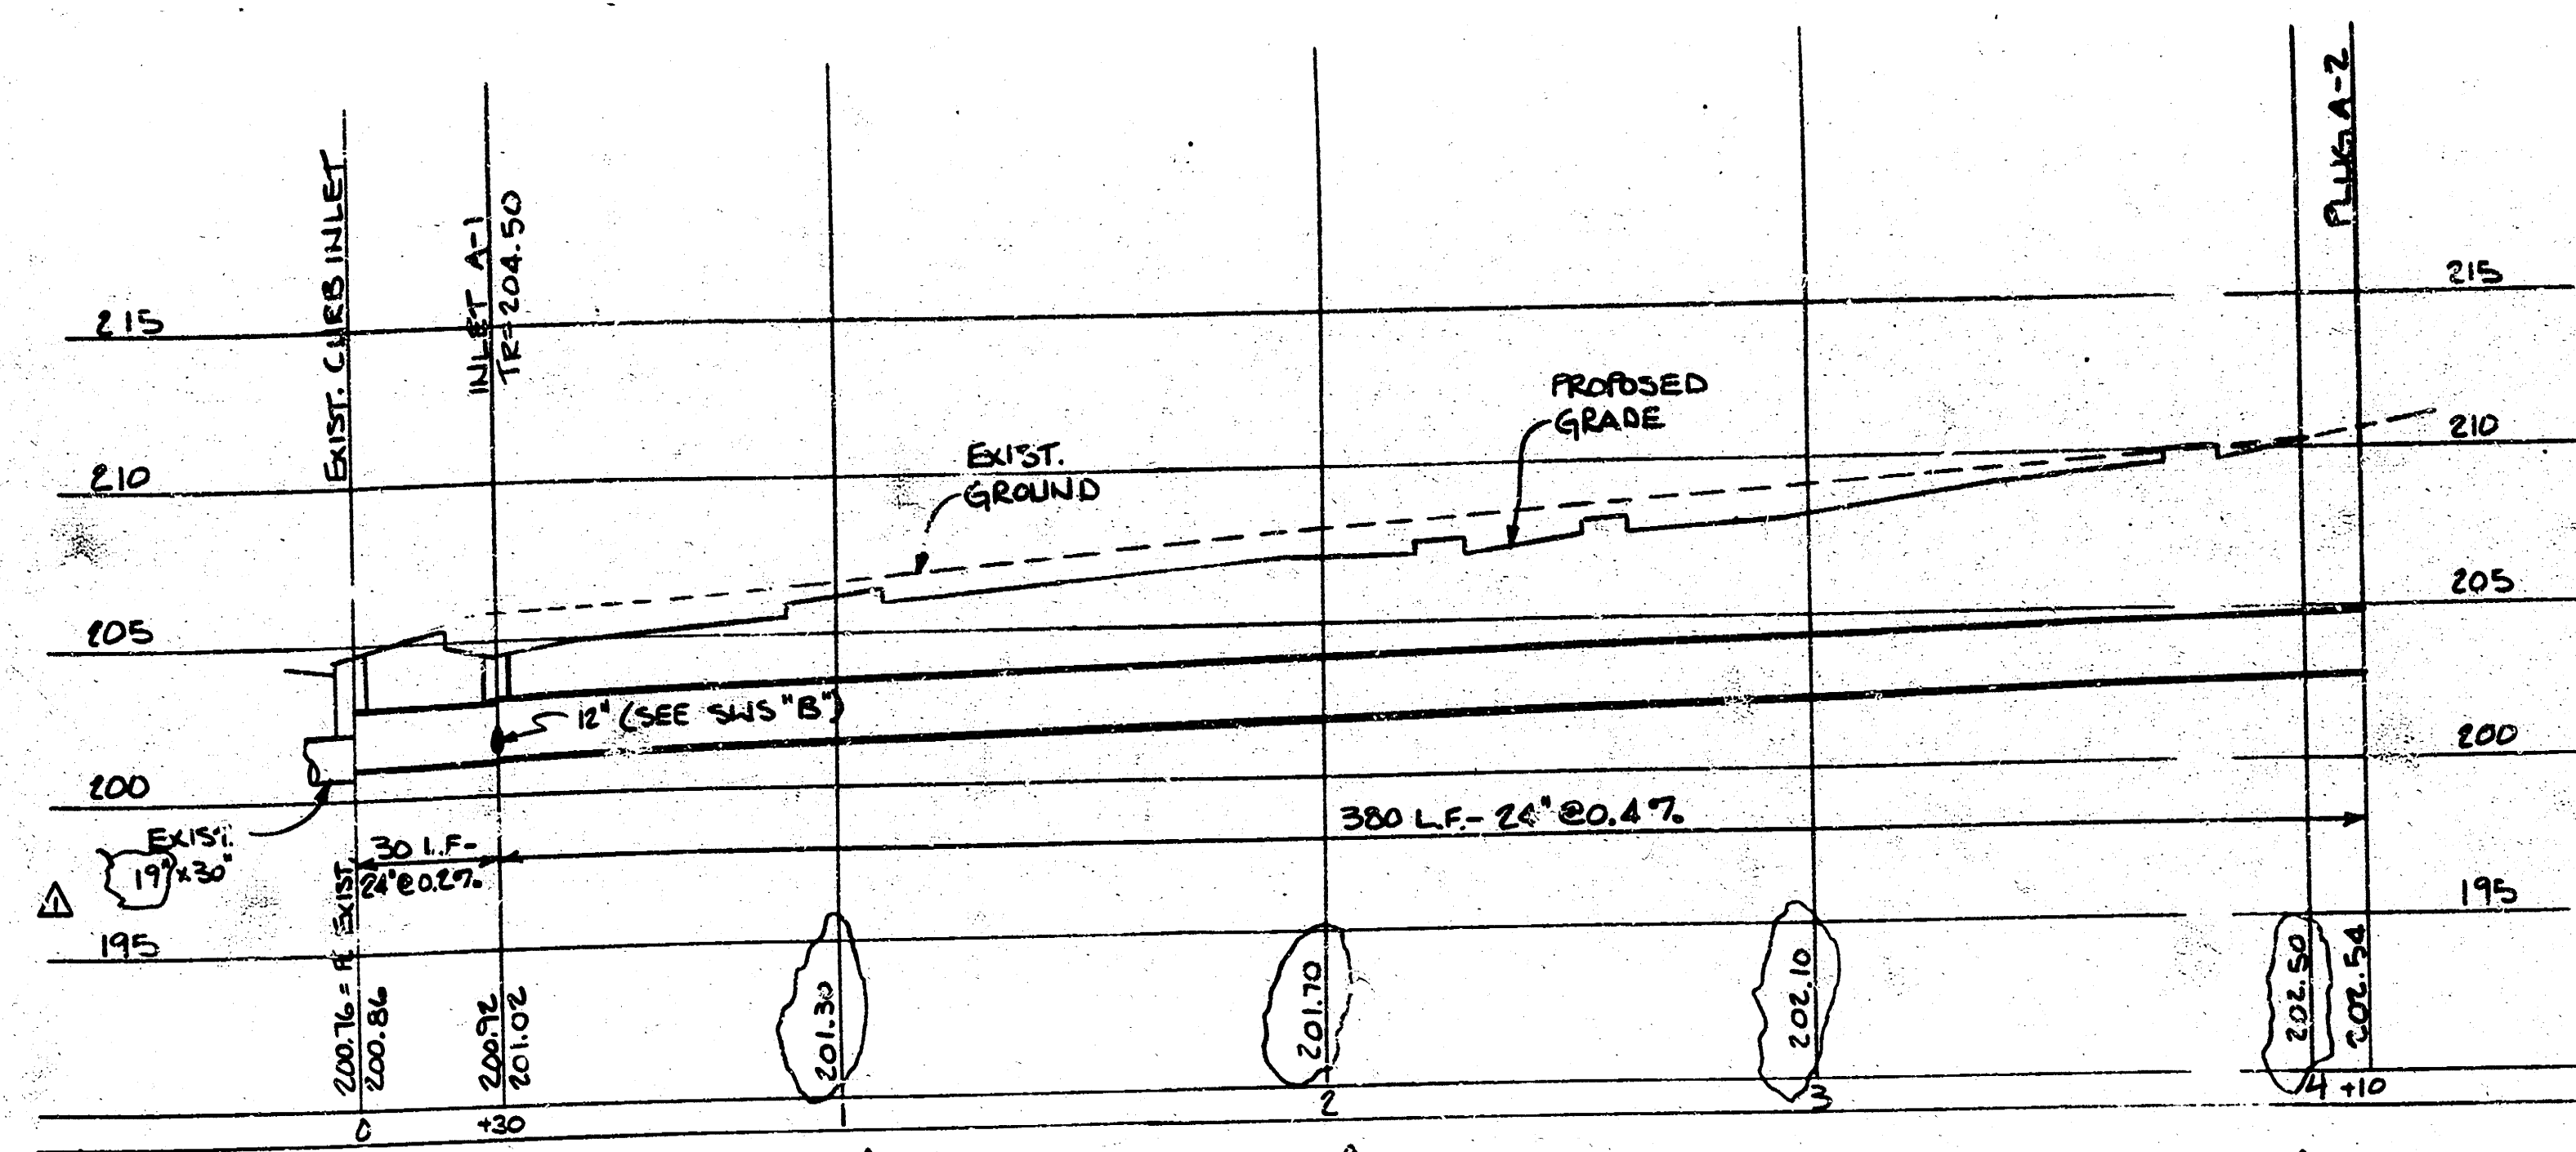

- GENERAL NOTES**
1. Refer to plumbing drawings for exact location and elevation of roof drains. Site Storm Water Saver to connect to roof drain system or provide temporary plug.
 2. Refer to Sheet SA-1 for coordinate baseline information.
 3. Refer to Site Survey for Bench Mark and complete existing topographic information.
 4. All Storm Saver shown on this sheet to be Reinforced Concrete Pipe.
 5. Contractor to contact Continental Pipeline Company prior to any grading work within pipeline easement.

APPROVED AS NOTED
By CITY ENGINEER OF WICHITA
Sanitary Sewers
Storm Saver
Driveway Approaches

NOTE TO CONTRACTOR
This project will be constructed under the supervision of the CITY ENGINEER and conforming to the SPECIFICATIONS of the CITY OF WICHITA. The CONTRACTOR will pay the City of Wichita for all costs of plan review, inspection and testing per contract.

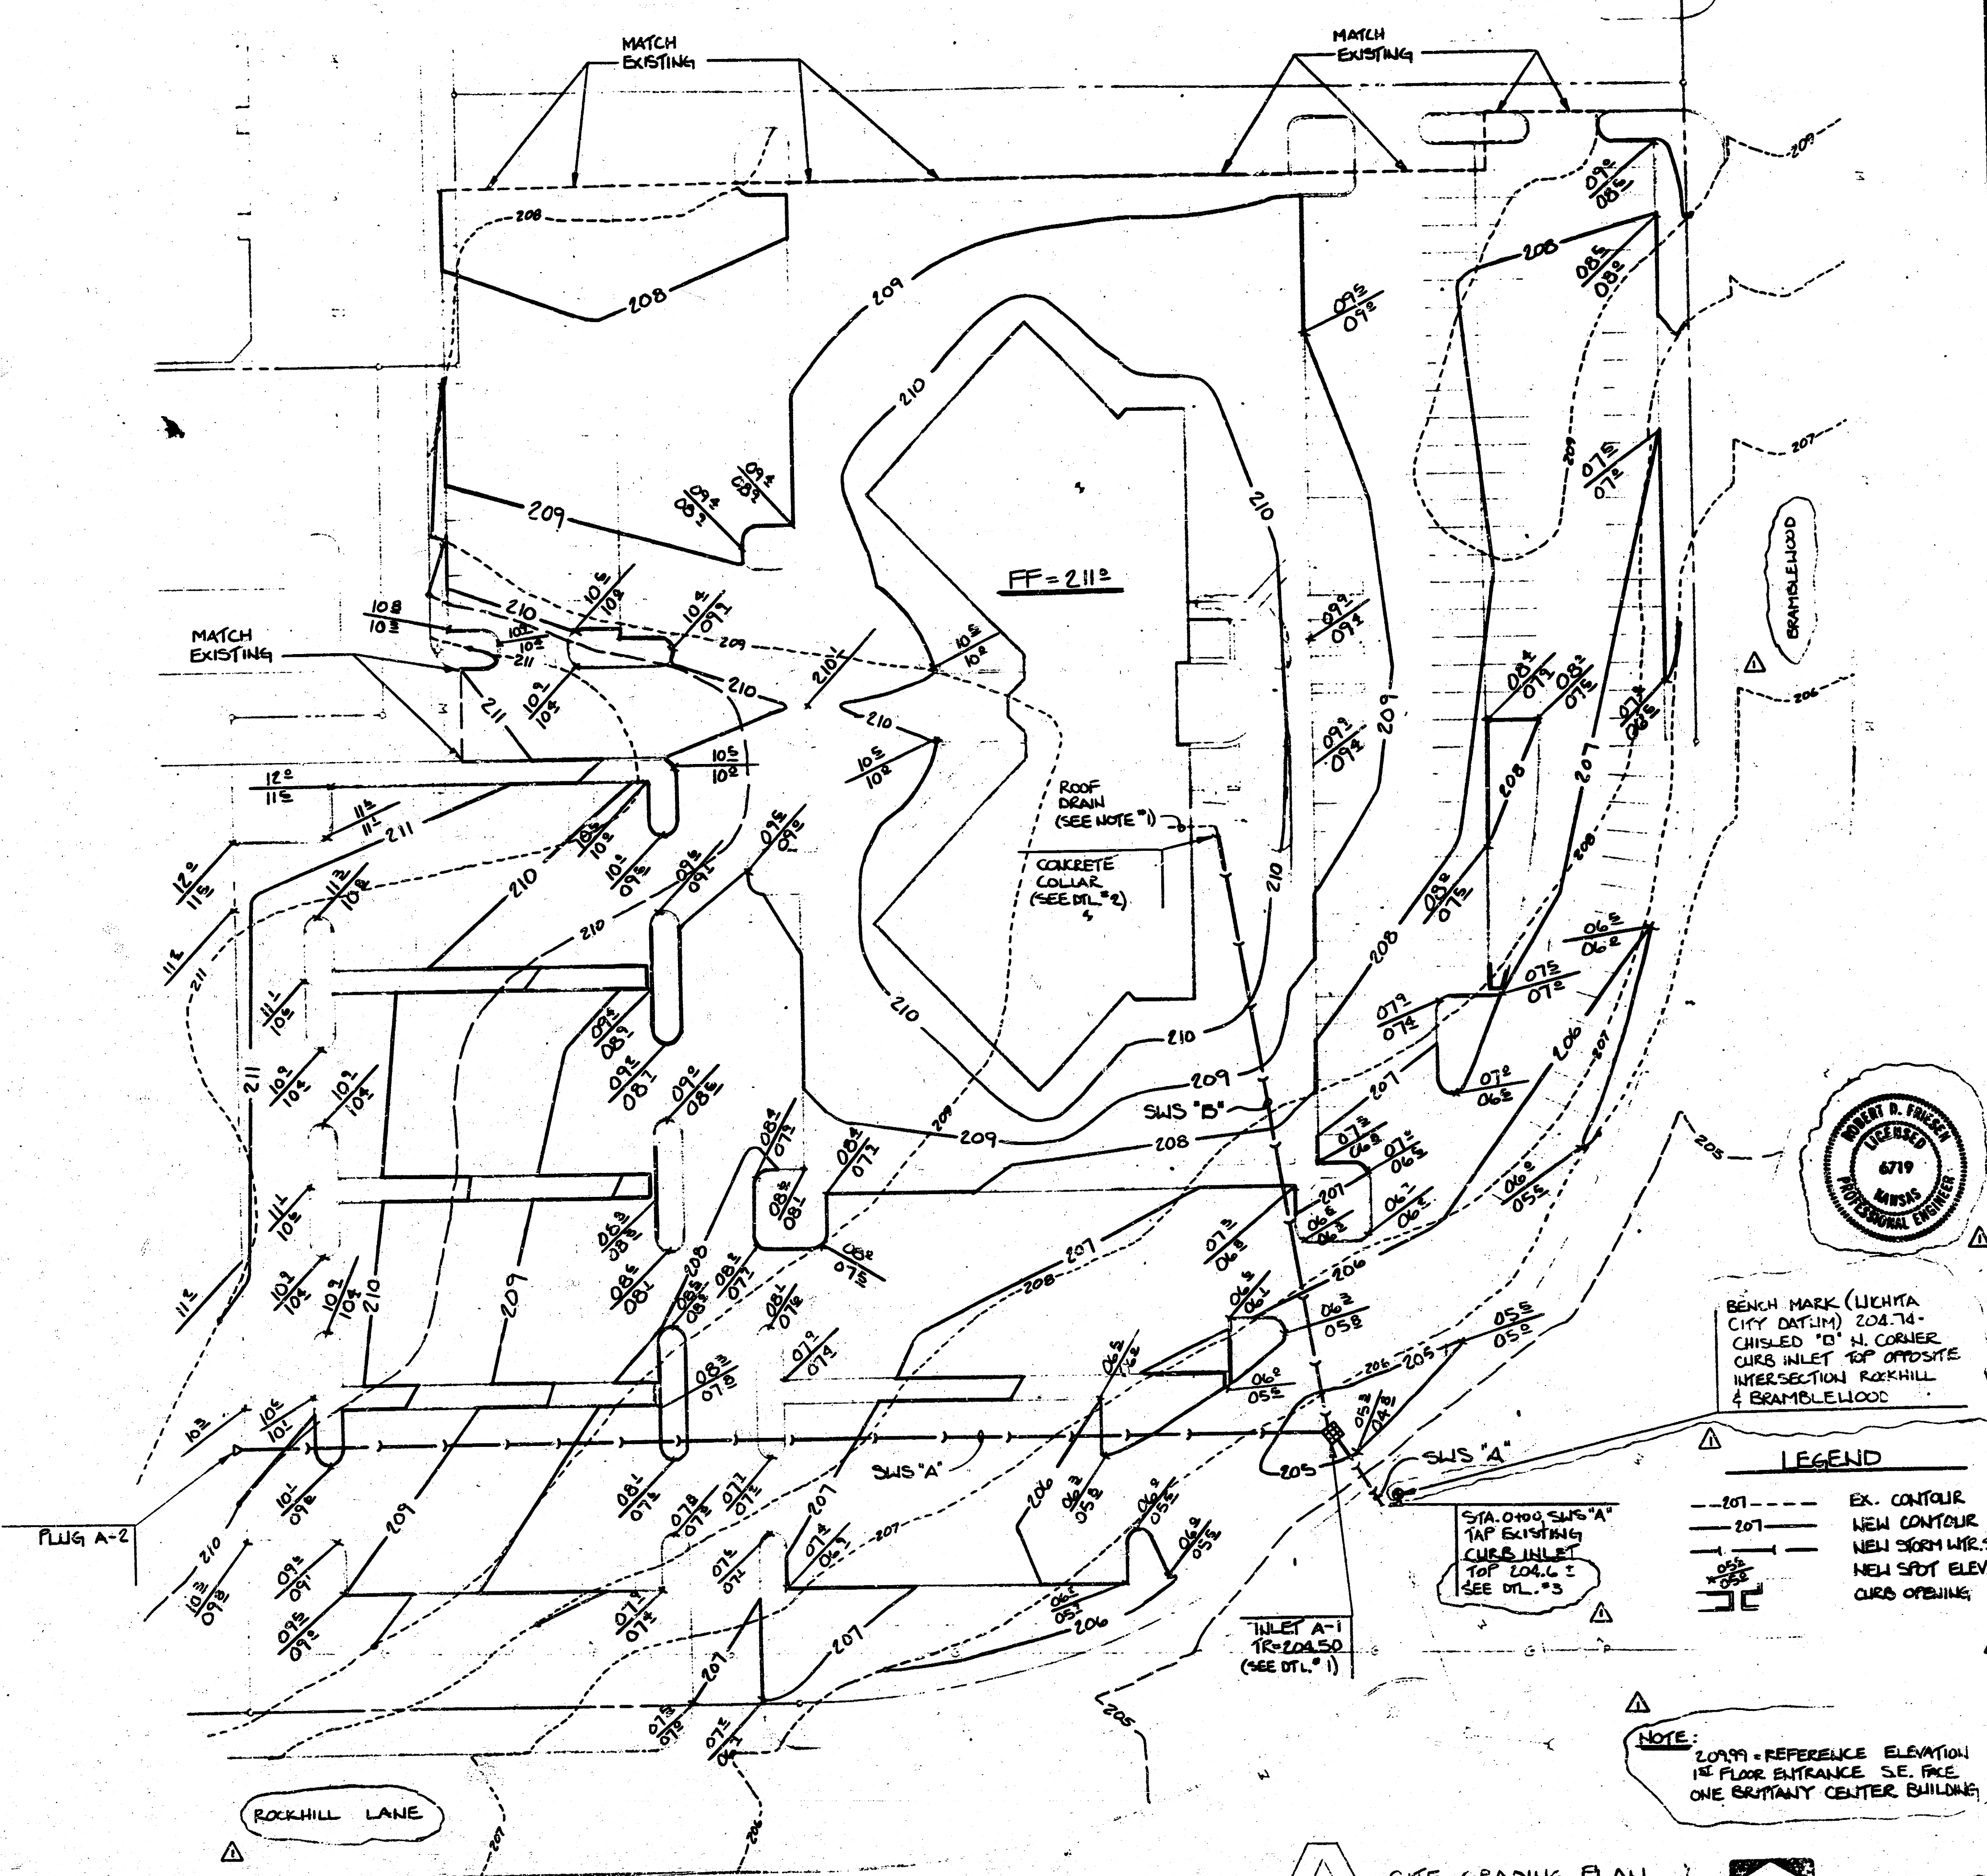

BENCH MARK (WICHITA CITY DATUM) 204.74 - CHISELED "D" IN CORNER CURB INLET TOP OPPOSITE INTERSECTION ROCKHILL & BRAMBLEWOOD



LEGEND
--- 201 --- EX. CONTOUR
--- 207 --- NEW CONTOUR
--- 207 --- NEW STORM WATER Saver
--- 207 --- NEW SPOT ELEV. CURB OPENING

NOTE:
2009 - REFERENCE ELEVATION 12" FLOOR ENTRANCE S.E. FACE ONE BRITANNY CENTER BUILDING

A SITE GRADING PLAN
10 20 NORTH 10

DATE	ISSUED	NO.
11-15-05	FOR BUILDING PERMIT	10

DATE	REVISION	NO.
11-15-05	FOR STORM Saver	10

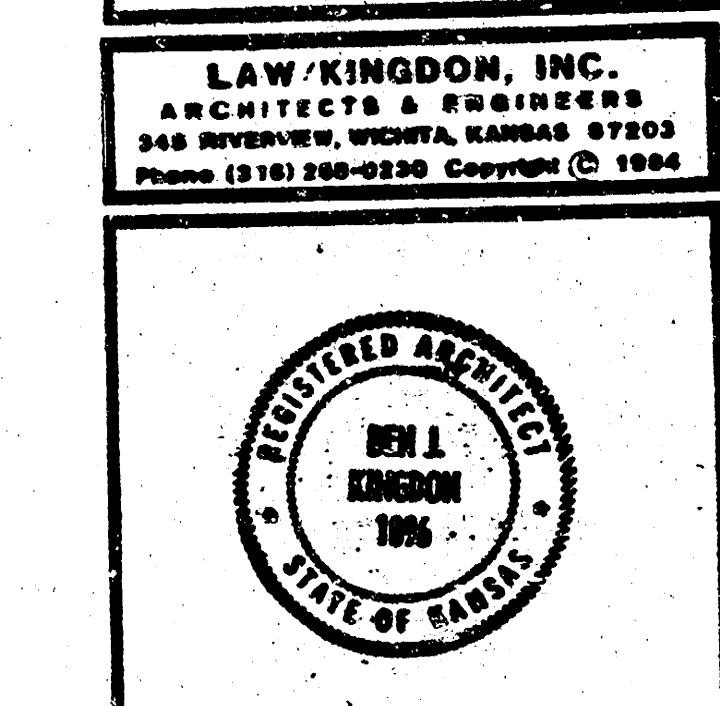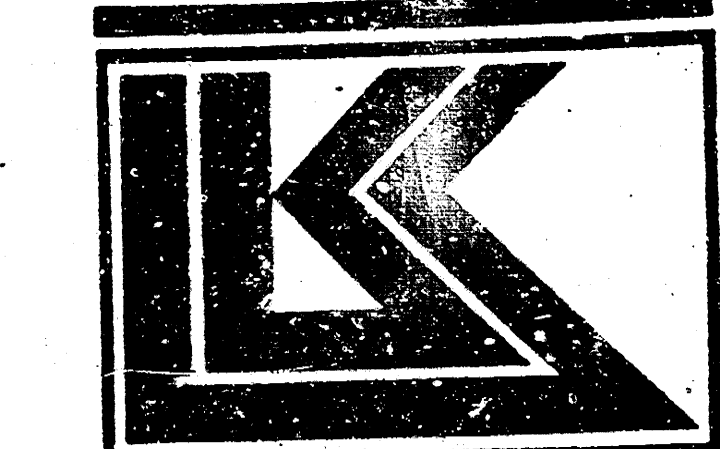

DRAWN	CHECKED
SKV	

RELATED DRAWINGS
SHELL
DETAILS
STRUCTURE
MECHANICAL
ELECTRICAL
OTHER

SEQUENCE NUMBER
OF SHEETS

PROJECT NUMBER
7515

FILMED FROM THE BEST AVAILABLE COPY