



PLAN
 1"=10'
 NORTH ARROW
 1"=10'

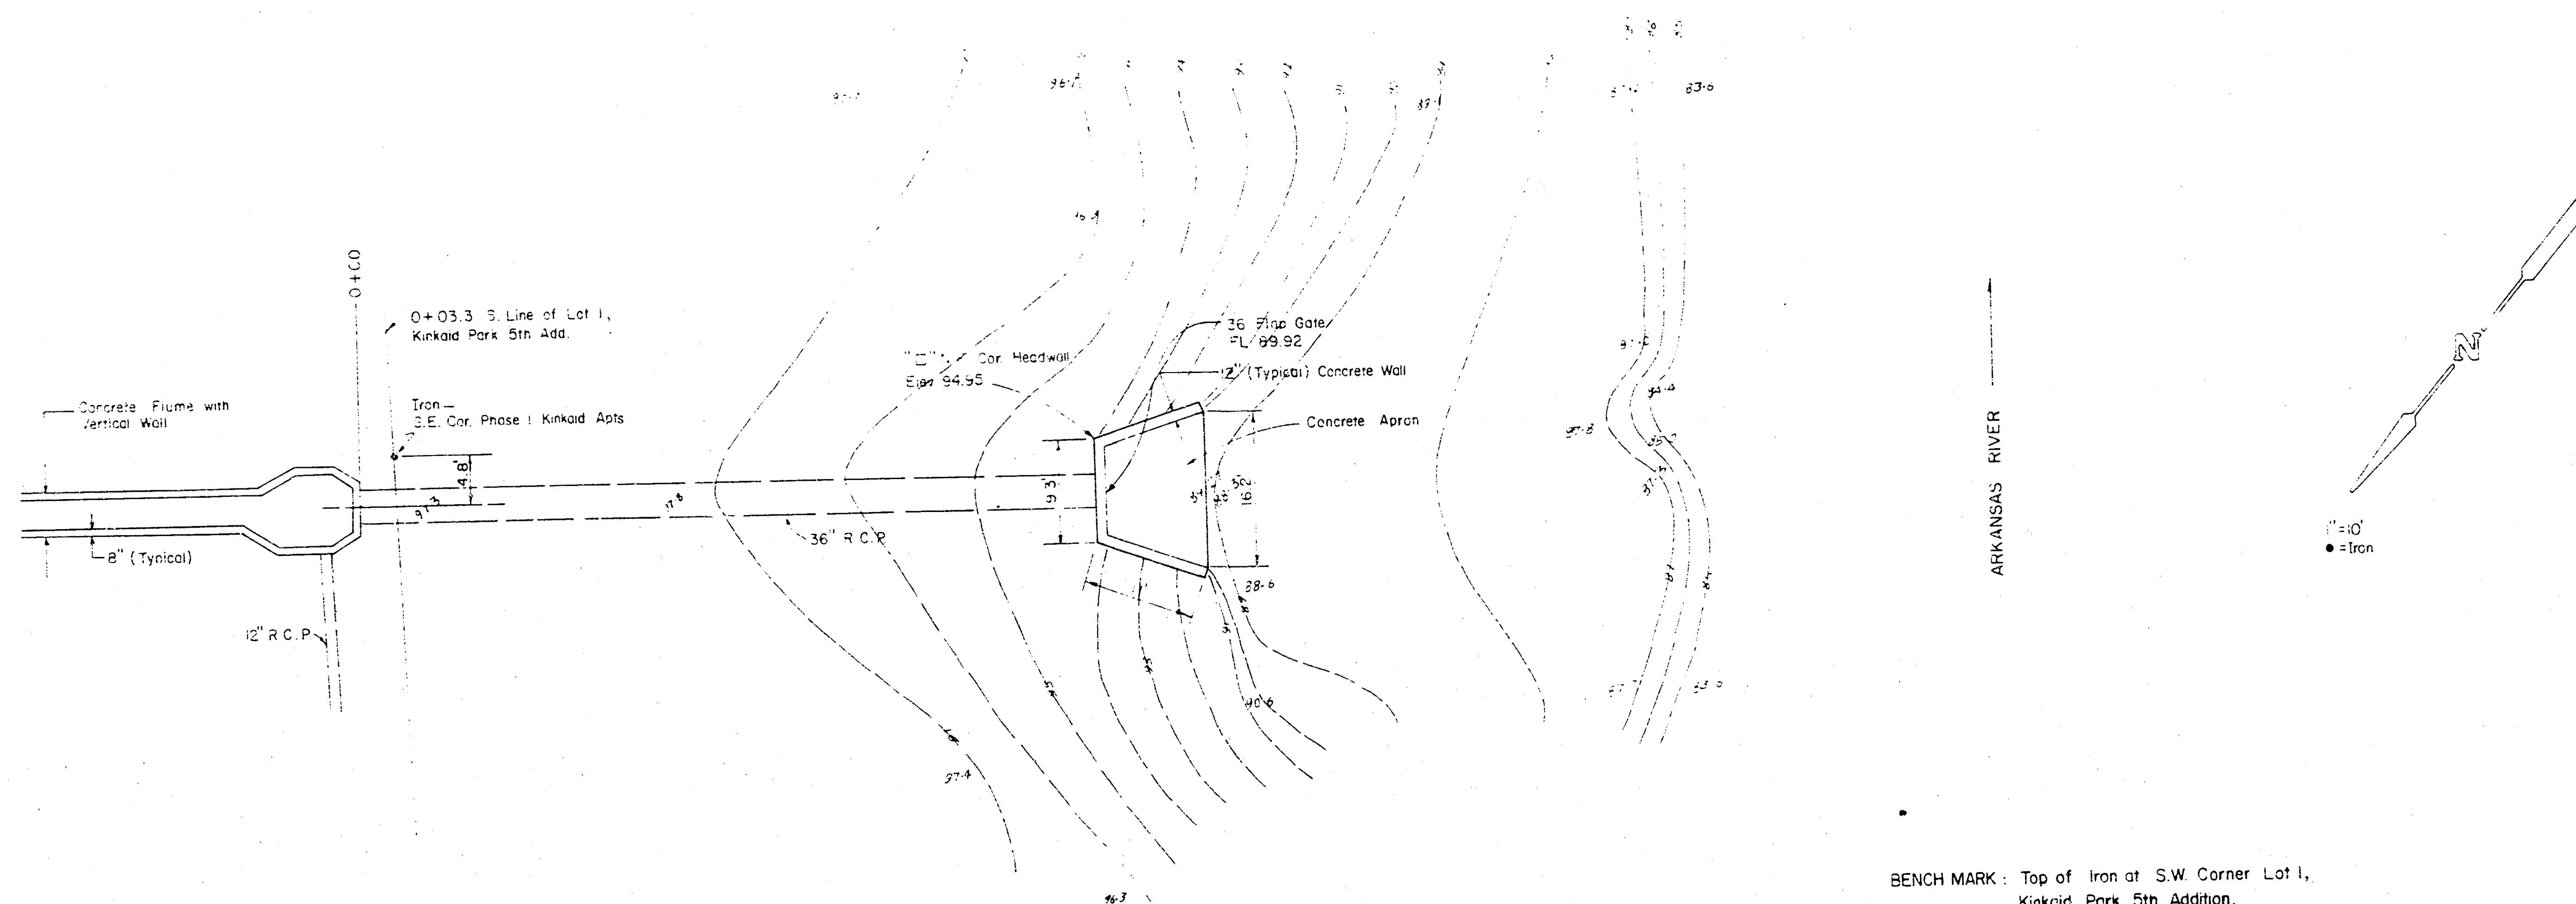

BENCH MARK: Top of Iron at S.W. Corner Lot 1,
 Kinkaid Park 5th Addition.
 Elev. 98.20 City Datum

PROFILE
 1"=5' VERT.
 1"=10' HORIZ.

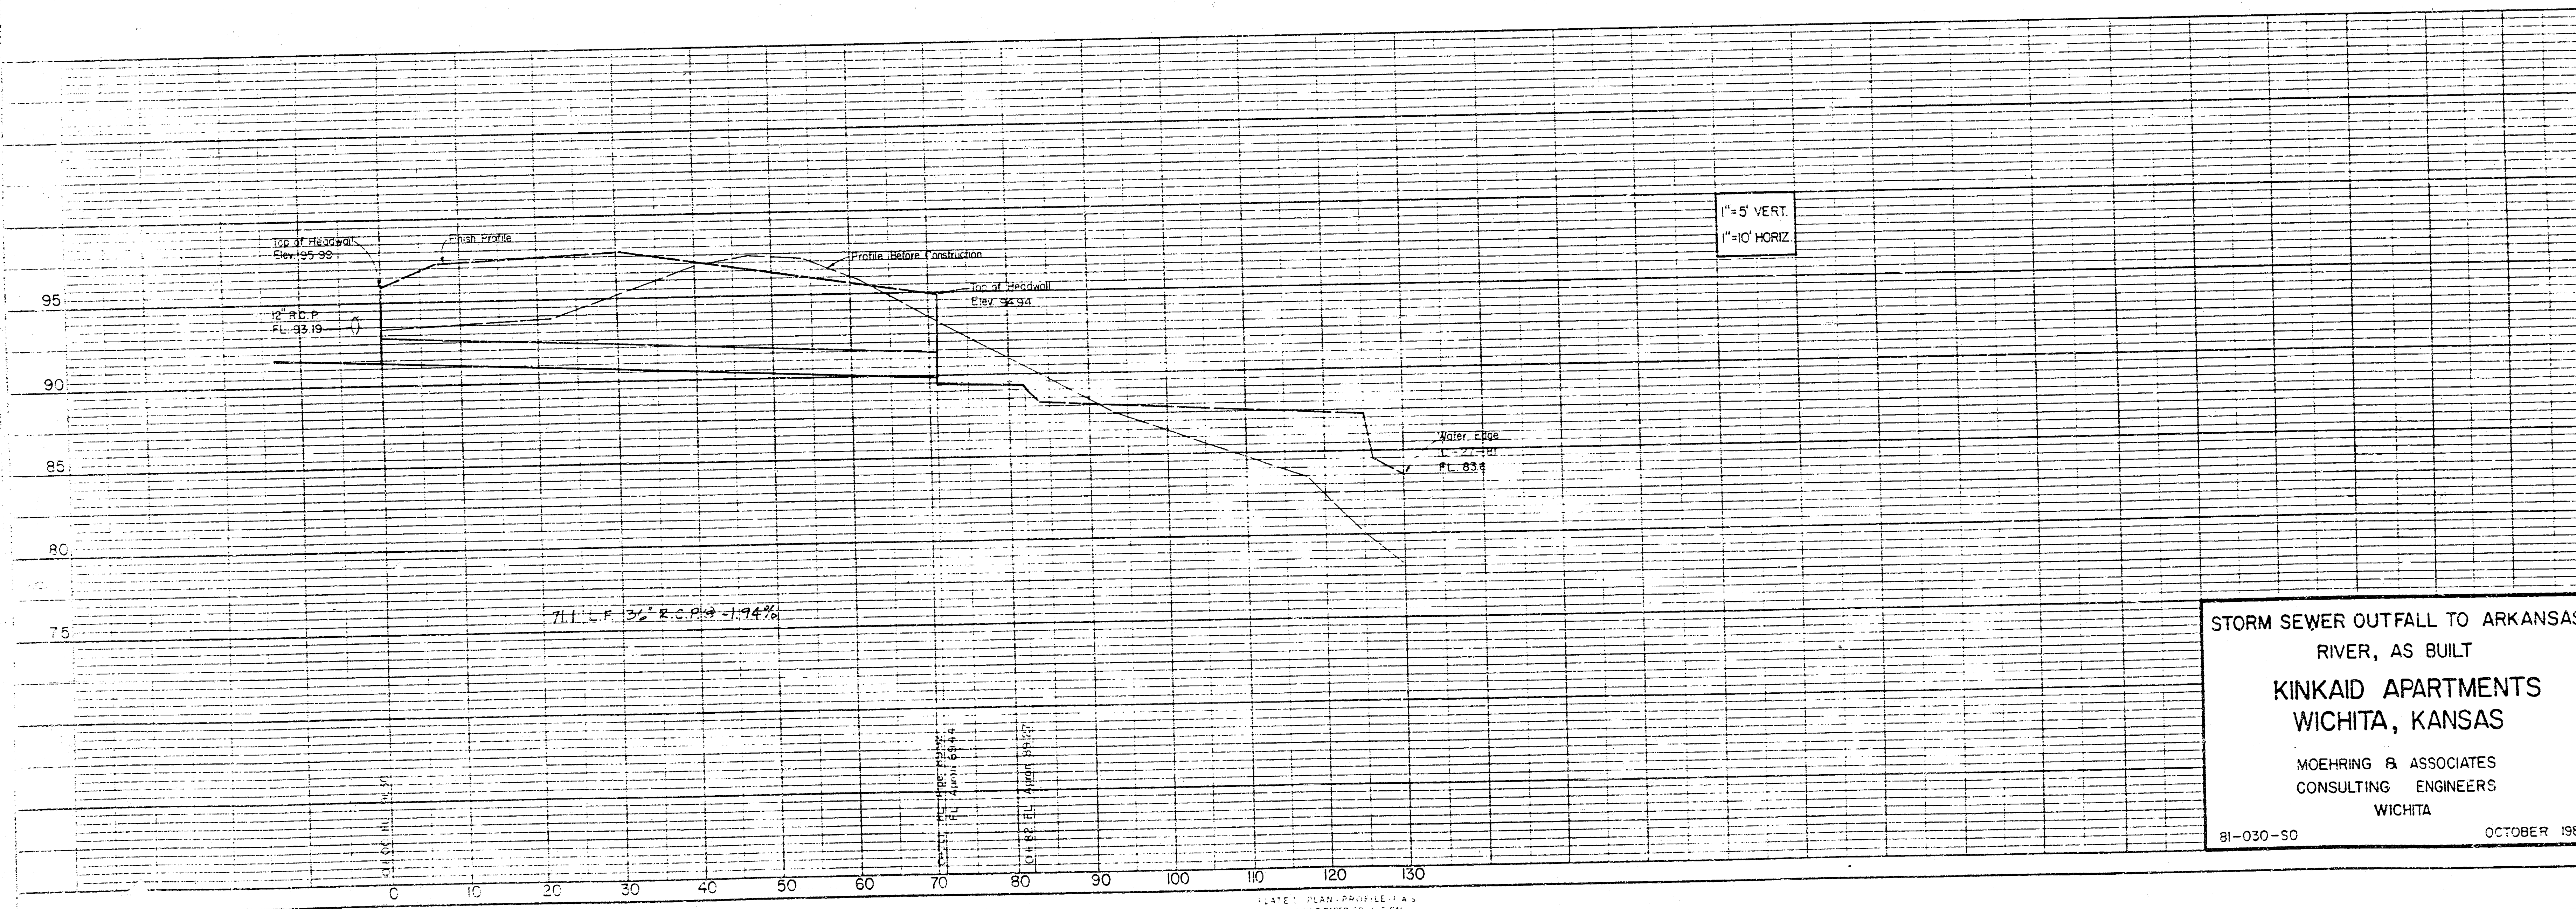

STORM SEWER OUTFALL TO ARKANSAS
 RIVER, AS BUILT
KINKAID APARTMENTS
 WICHITA, KANSAS
 MOEHRING & ASSOCIATES
 CONSULTING ENGINEERS
 WICHITA
 81-030-SO OCTOBER 1981