


2717

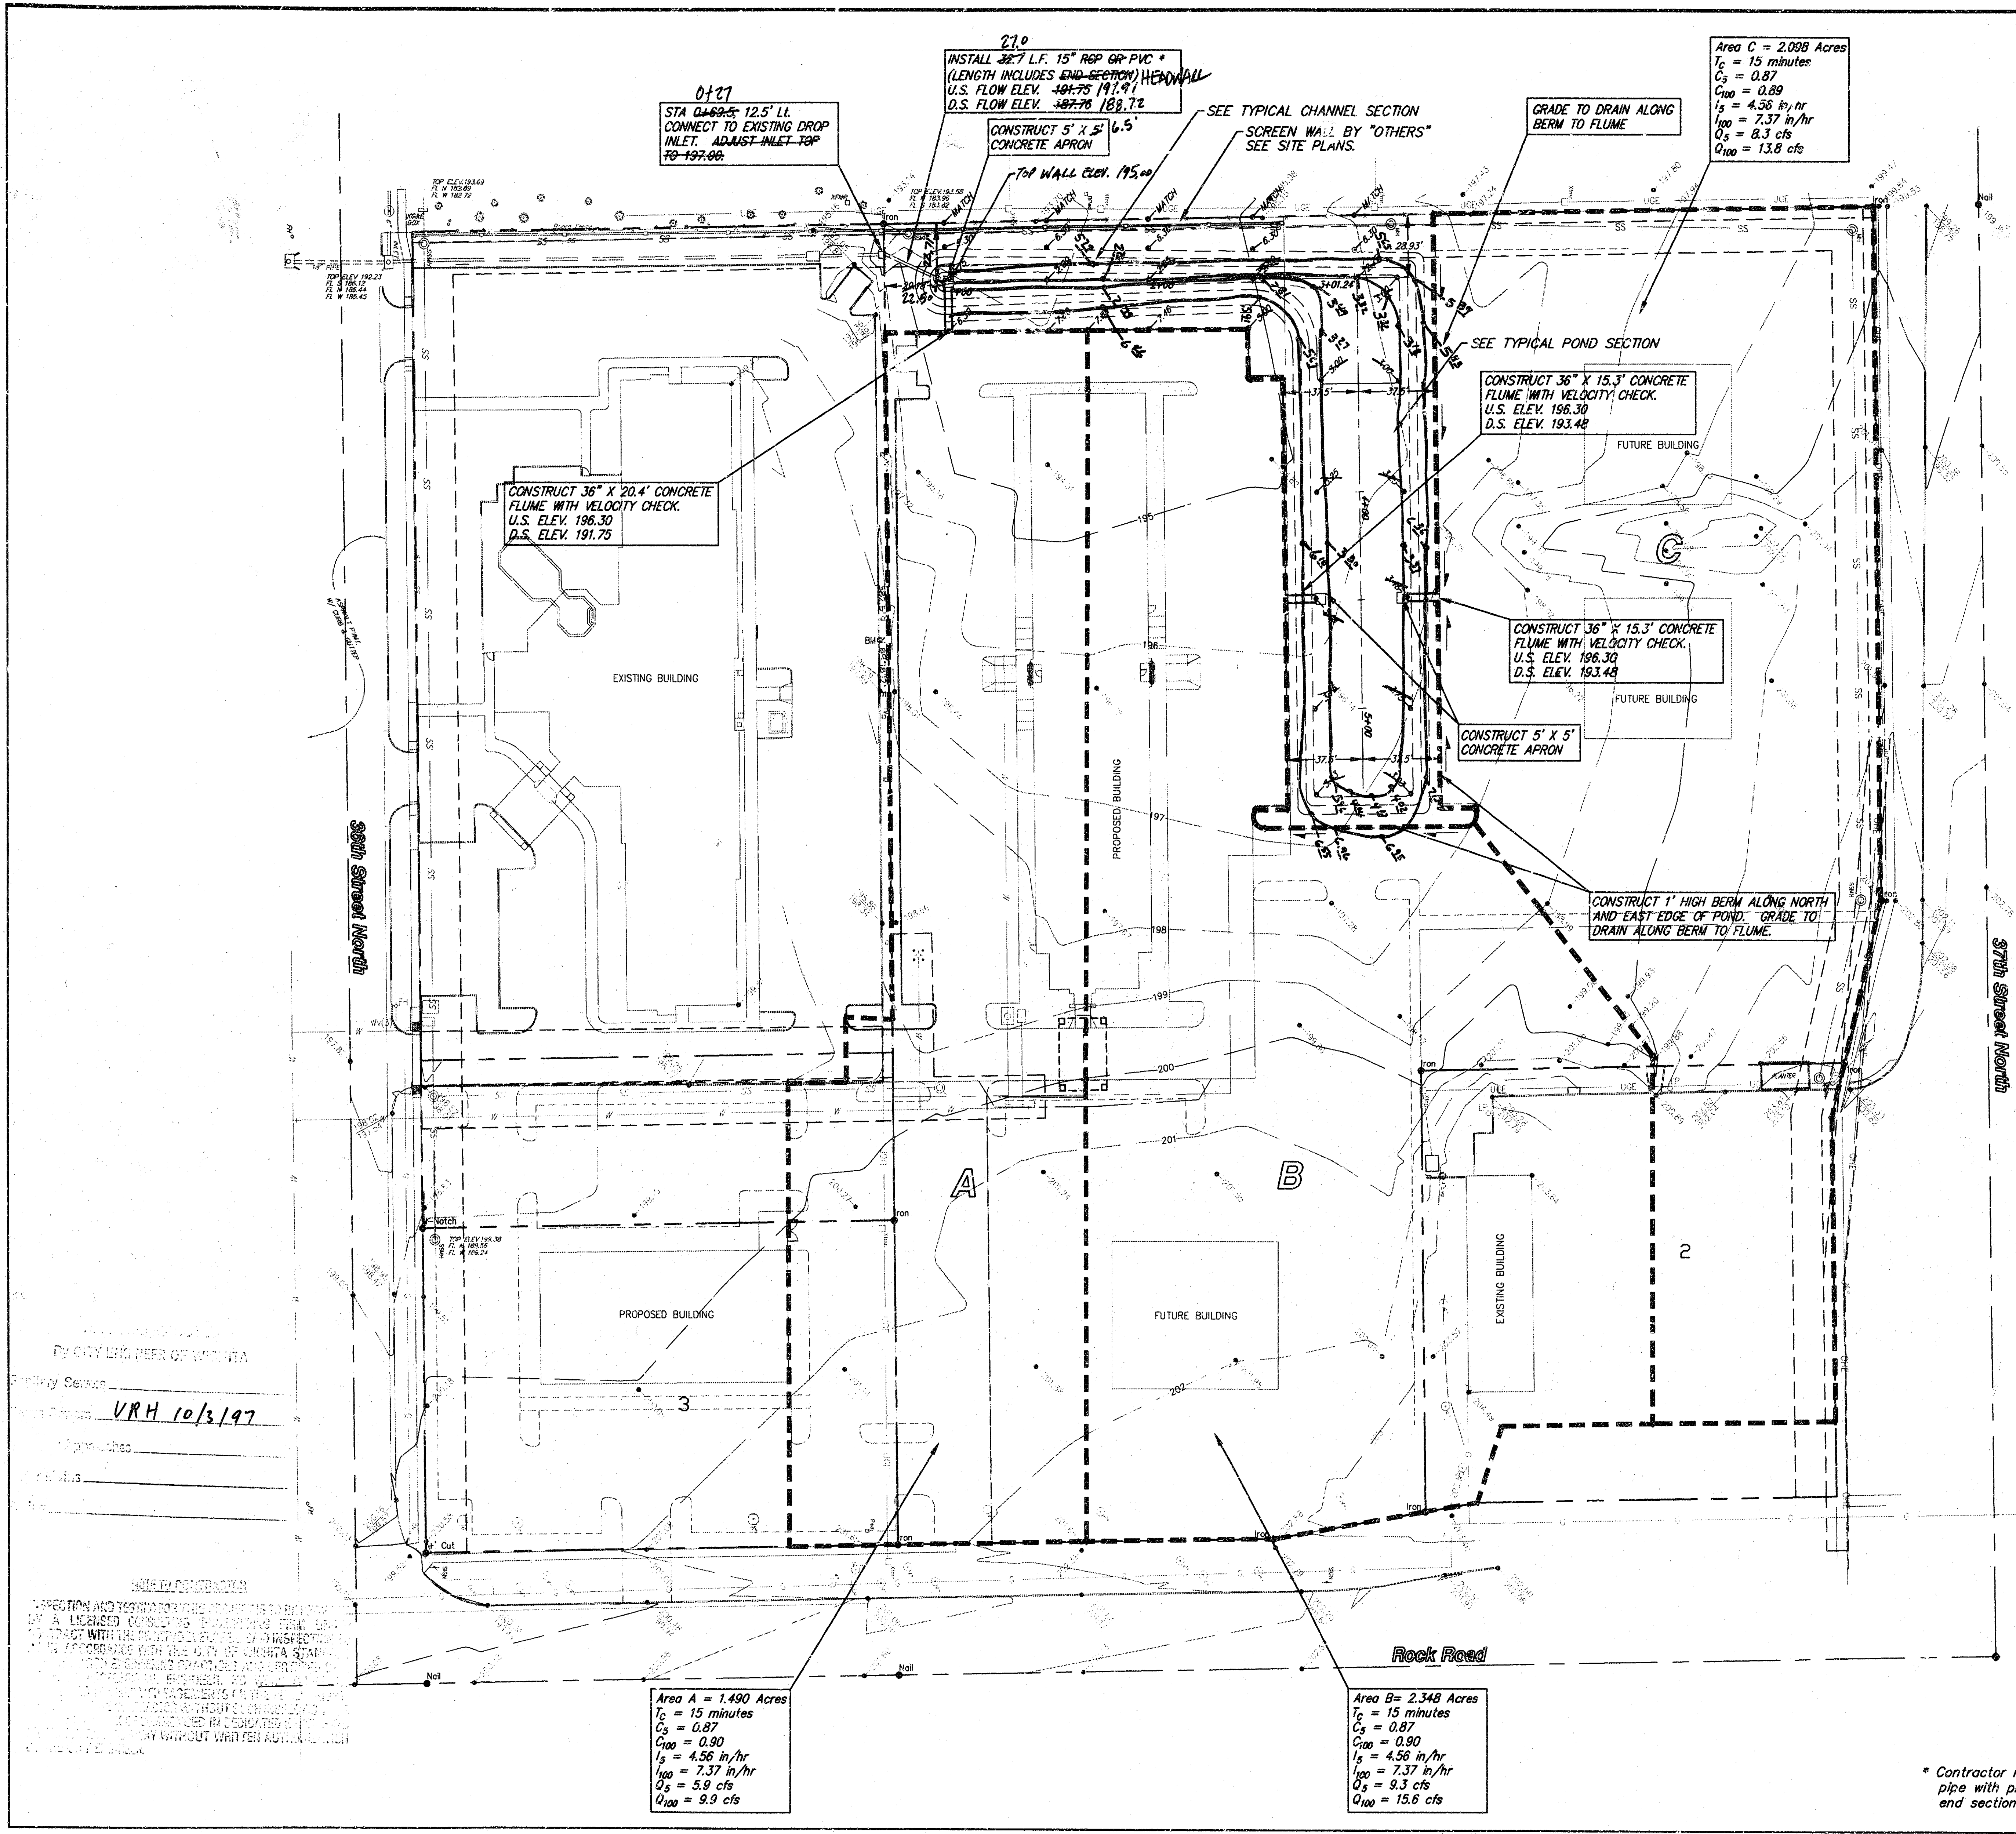

SRB




SCALE:
1" = 40'

BM Notes:

- BM #1: City of Wichita Std. Disk at NW Corner Concrete Field Drain. 150'± E. of the E.L. of Rock Road and 6" S. of S.L. 37th Street North. Elev. 203.87
- BM #2: '4' Cut in T.C. 10' E. of 2nd Light Pole E. of W.L. Tract 2, N. of Northrock Suites Hotel. Elev. 198.24
- BM #3: '4' Cut at S.E. Corner of Lot 3, Block 1, Killarney Plaza First Addition. Elev. 200.24


Legal Description:

BLOCK 1, KILLARNEY PLAZA FIRST ADDITION, EXCEPT THE SOUTH 230 FEET THEREOF.

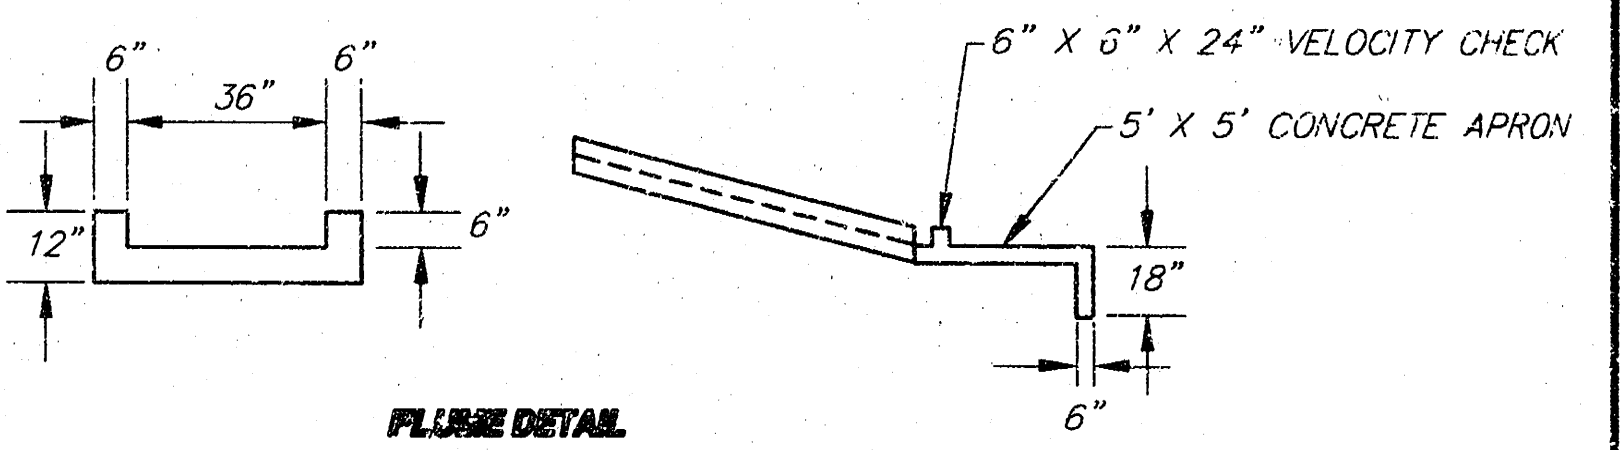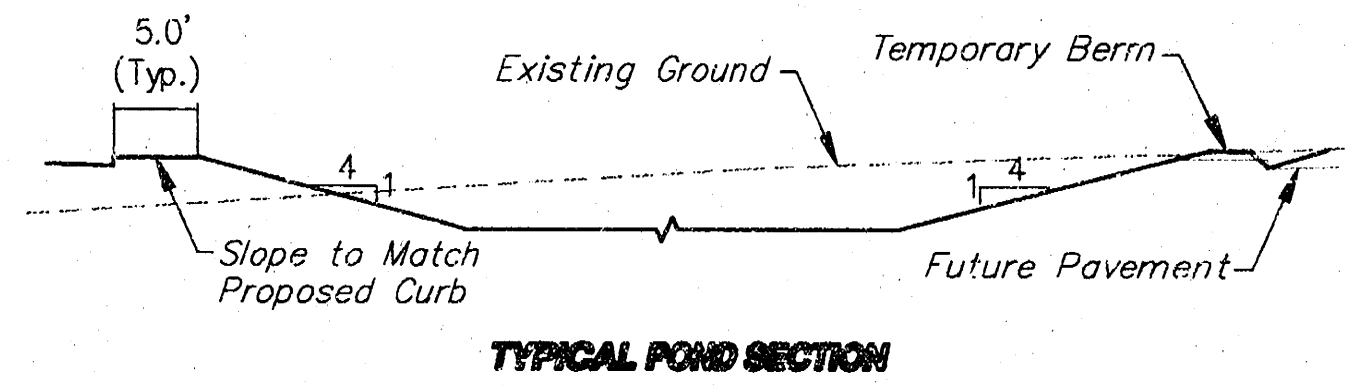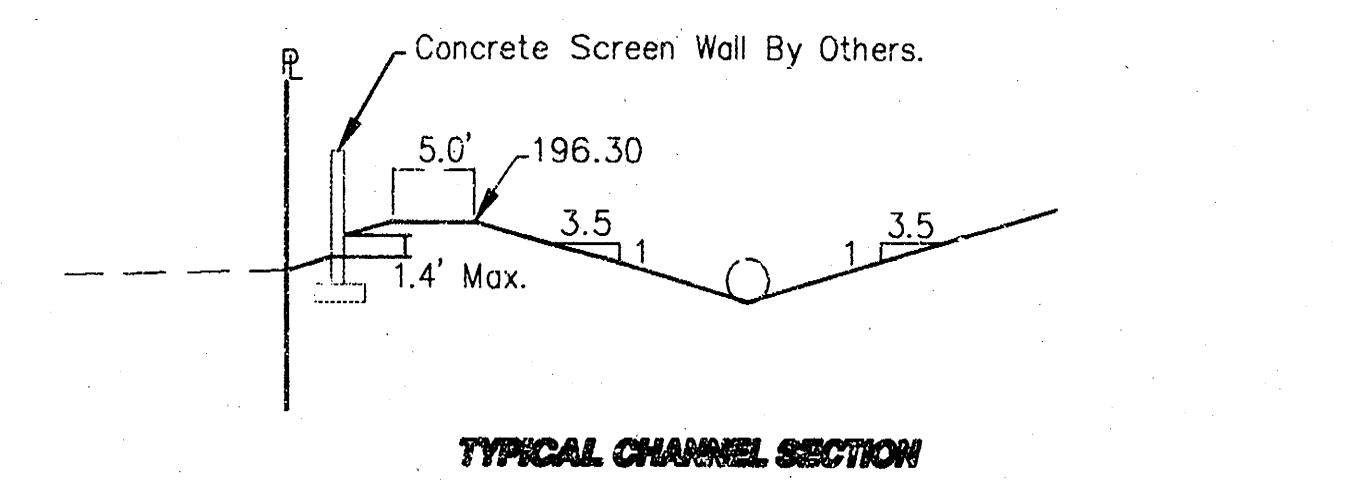

HEC-1 OUTPUT:

Basin Area = 0.010 sq. miles
Curve Number = 90
100 year Pond Surface = 195.30
Peak Inflow = 35 cfs
Peak Outflow = 11 cfs

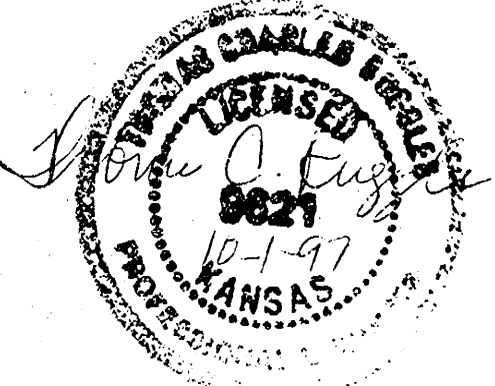

REVISED "AS BUILT" 12-4-97 TEB

BLOCK 1, KILLARNEY PLAZA FIRST ADDITION PRIVATE STORM DRAIN PLAN WICHITA, KANSAS			
SRB 924 NORTH MAIN 316-264-8008 WICHITA, KANSAS 67203 FAX 264-4621 http://www.fest.com/~srb E-mail: srb@fest.com			
SAVOY, RUGGLES & BOHM, P.A. ENGINEERING & SURVEYING			
PROJECT NUMBER 744 PPS (607861)			
DESIGN TCR/KWL	DRAWN KWL	UTILITY JCR	REVIEW JCR
DATE Sept. 24, 1997		REVISED 12-1-97	
SHEET 1		OF 1	

* Contractor may use optional PVC pipe with prior approval of pipe and end section by the Engineer.

AT 50 40 31