




BENCHMARKS:

City Disc Located in Island at
Northeast Corner of Maize Road
and Central.

Elevation = 146.00 (City Datum)

□ Cut in Top of Curb on West
Side of Maize Road Between Lots
2 & 3, Block 1, 1st-N-Hah
Village.

Elevation = 151.29 (City Datum)

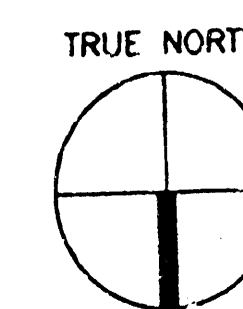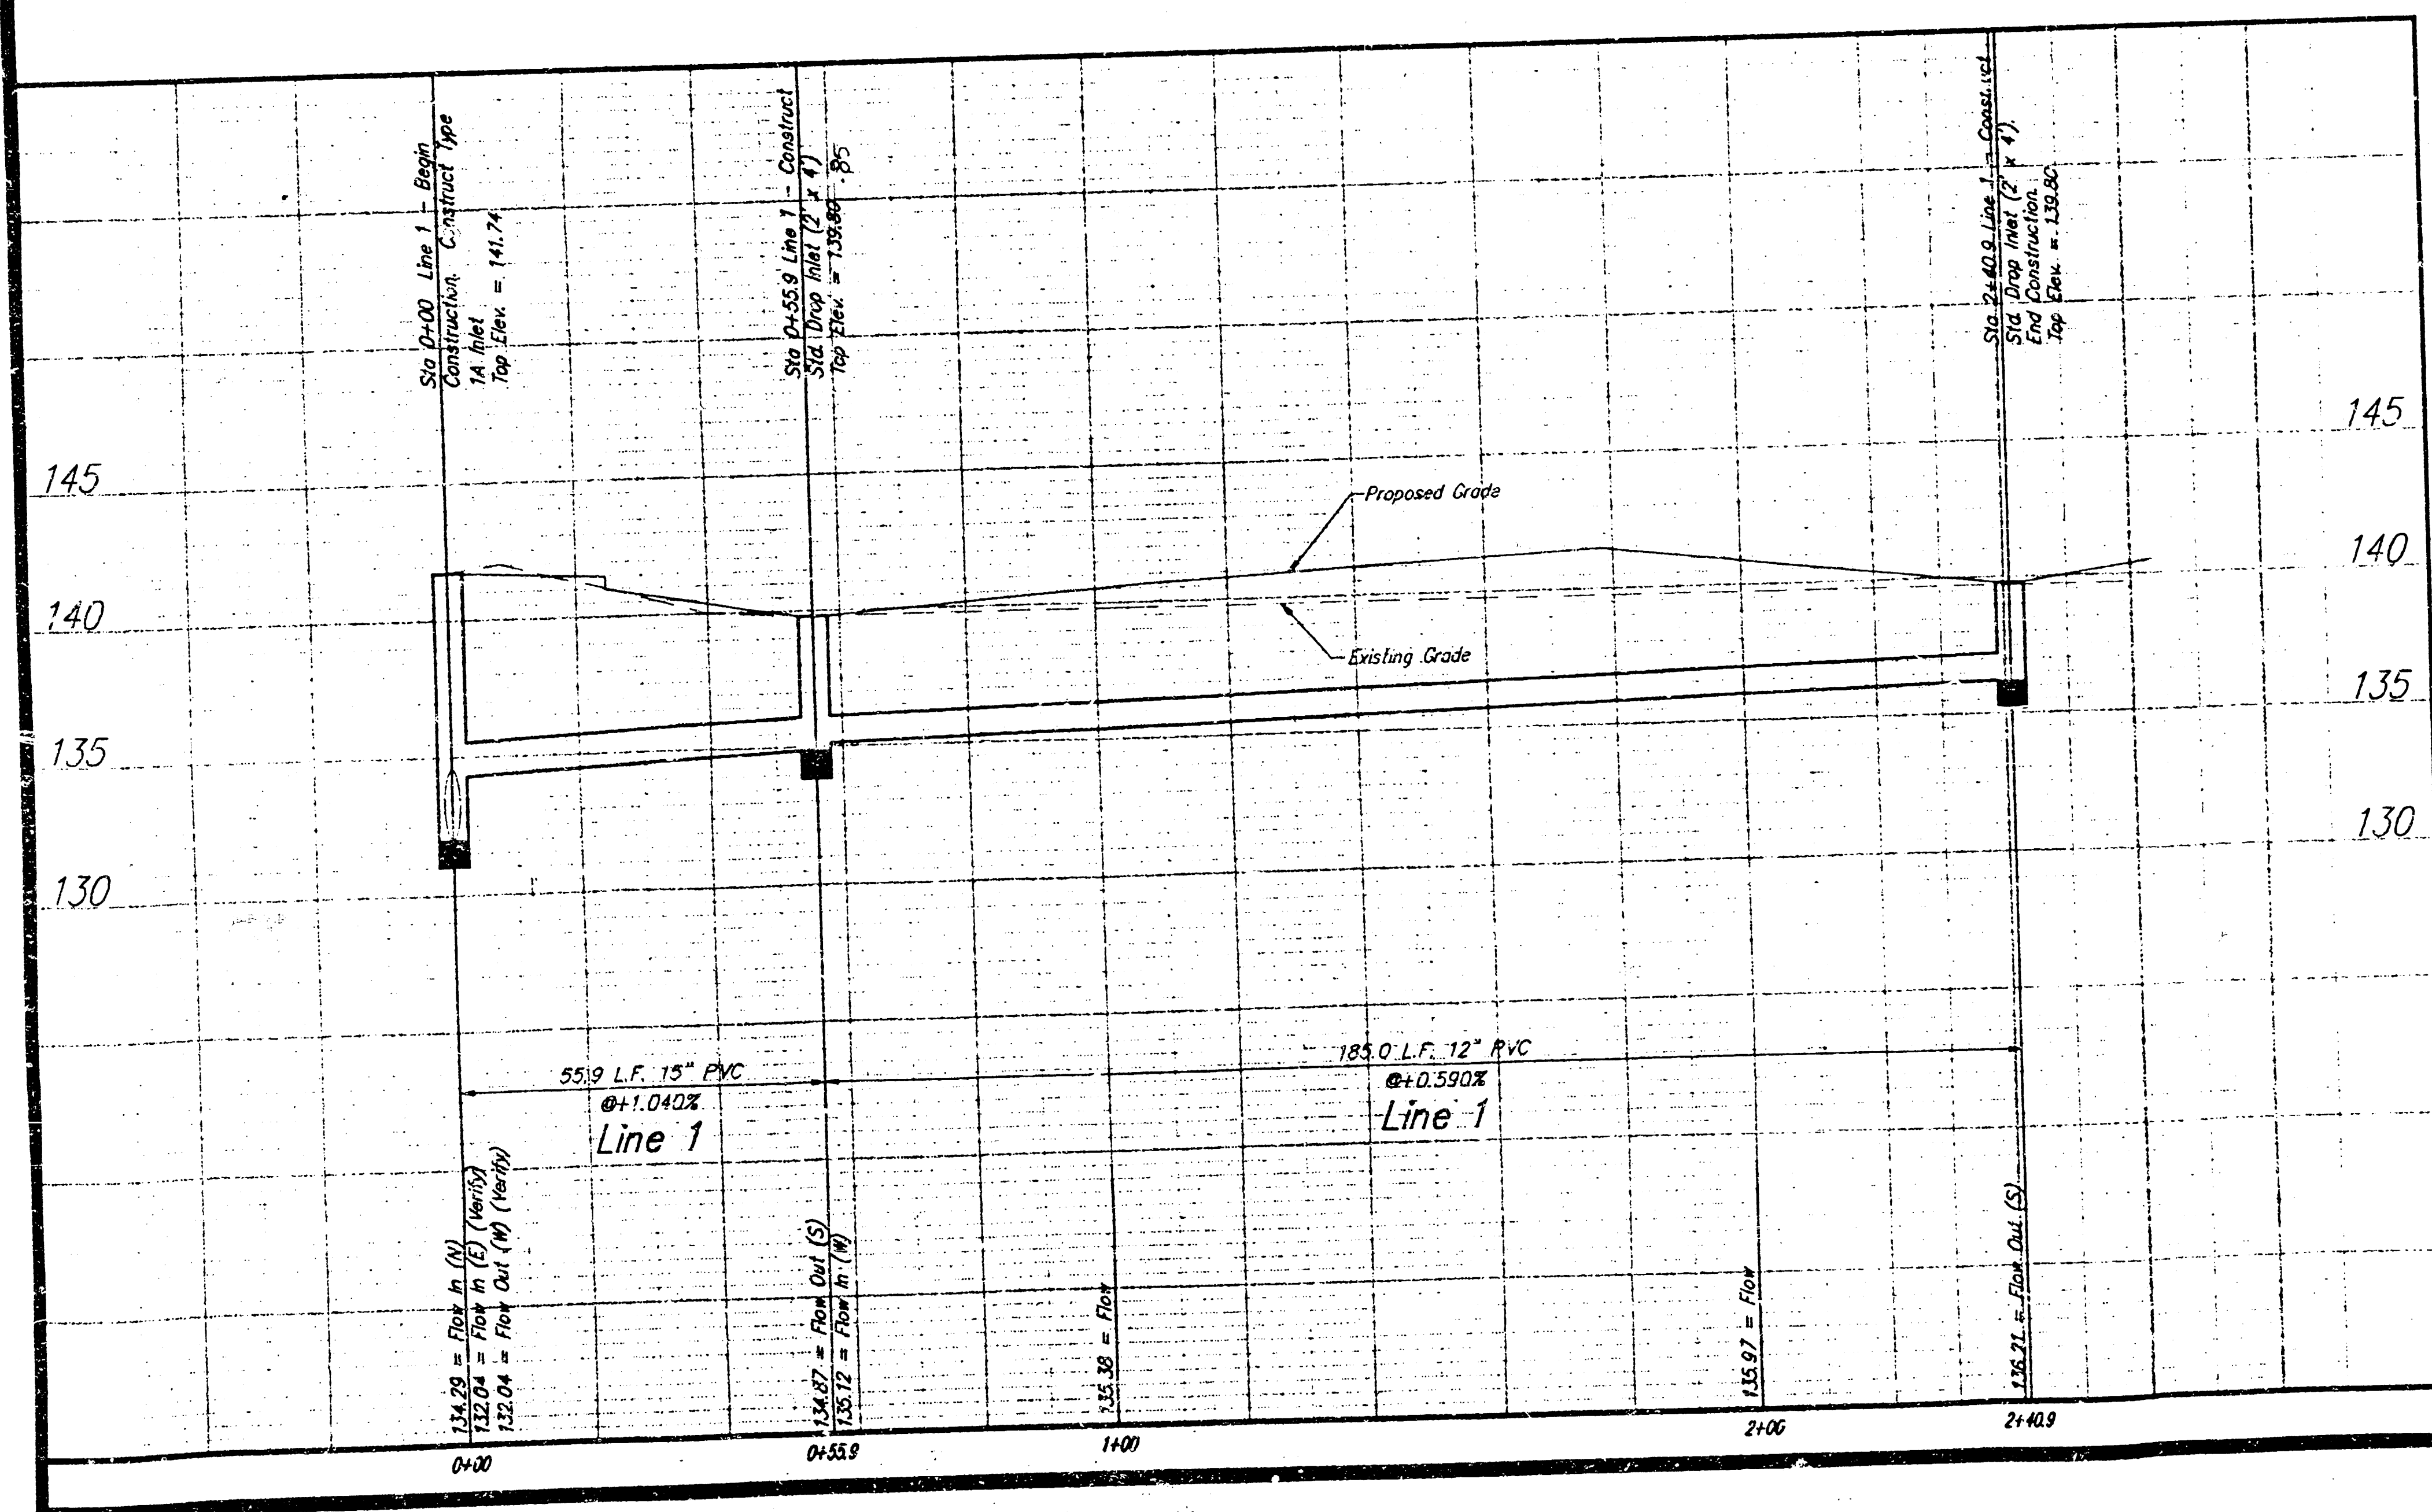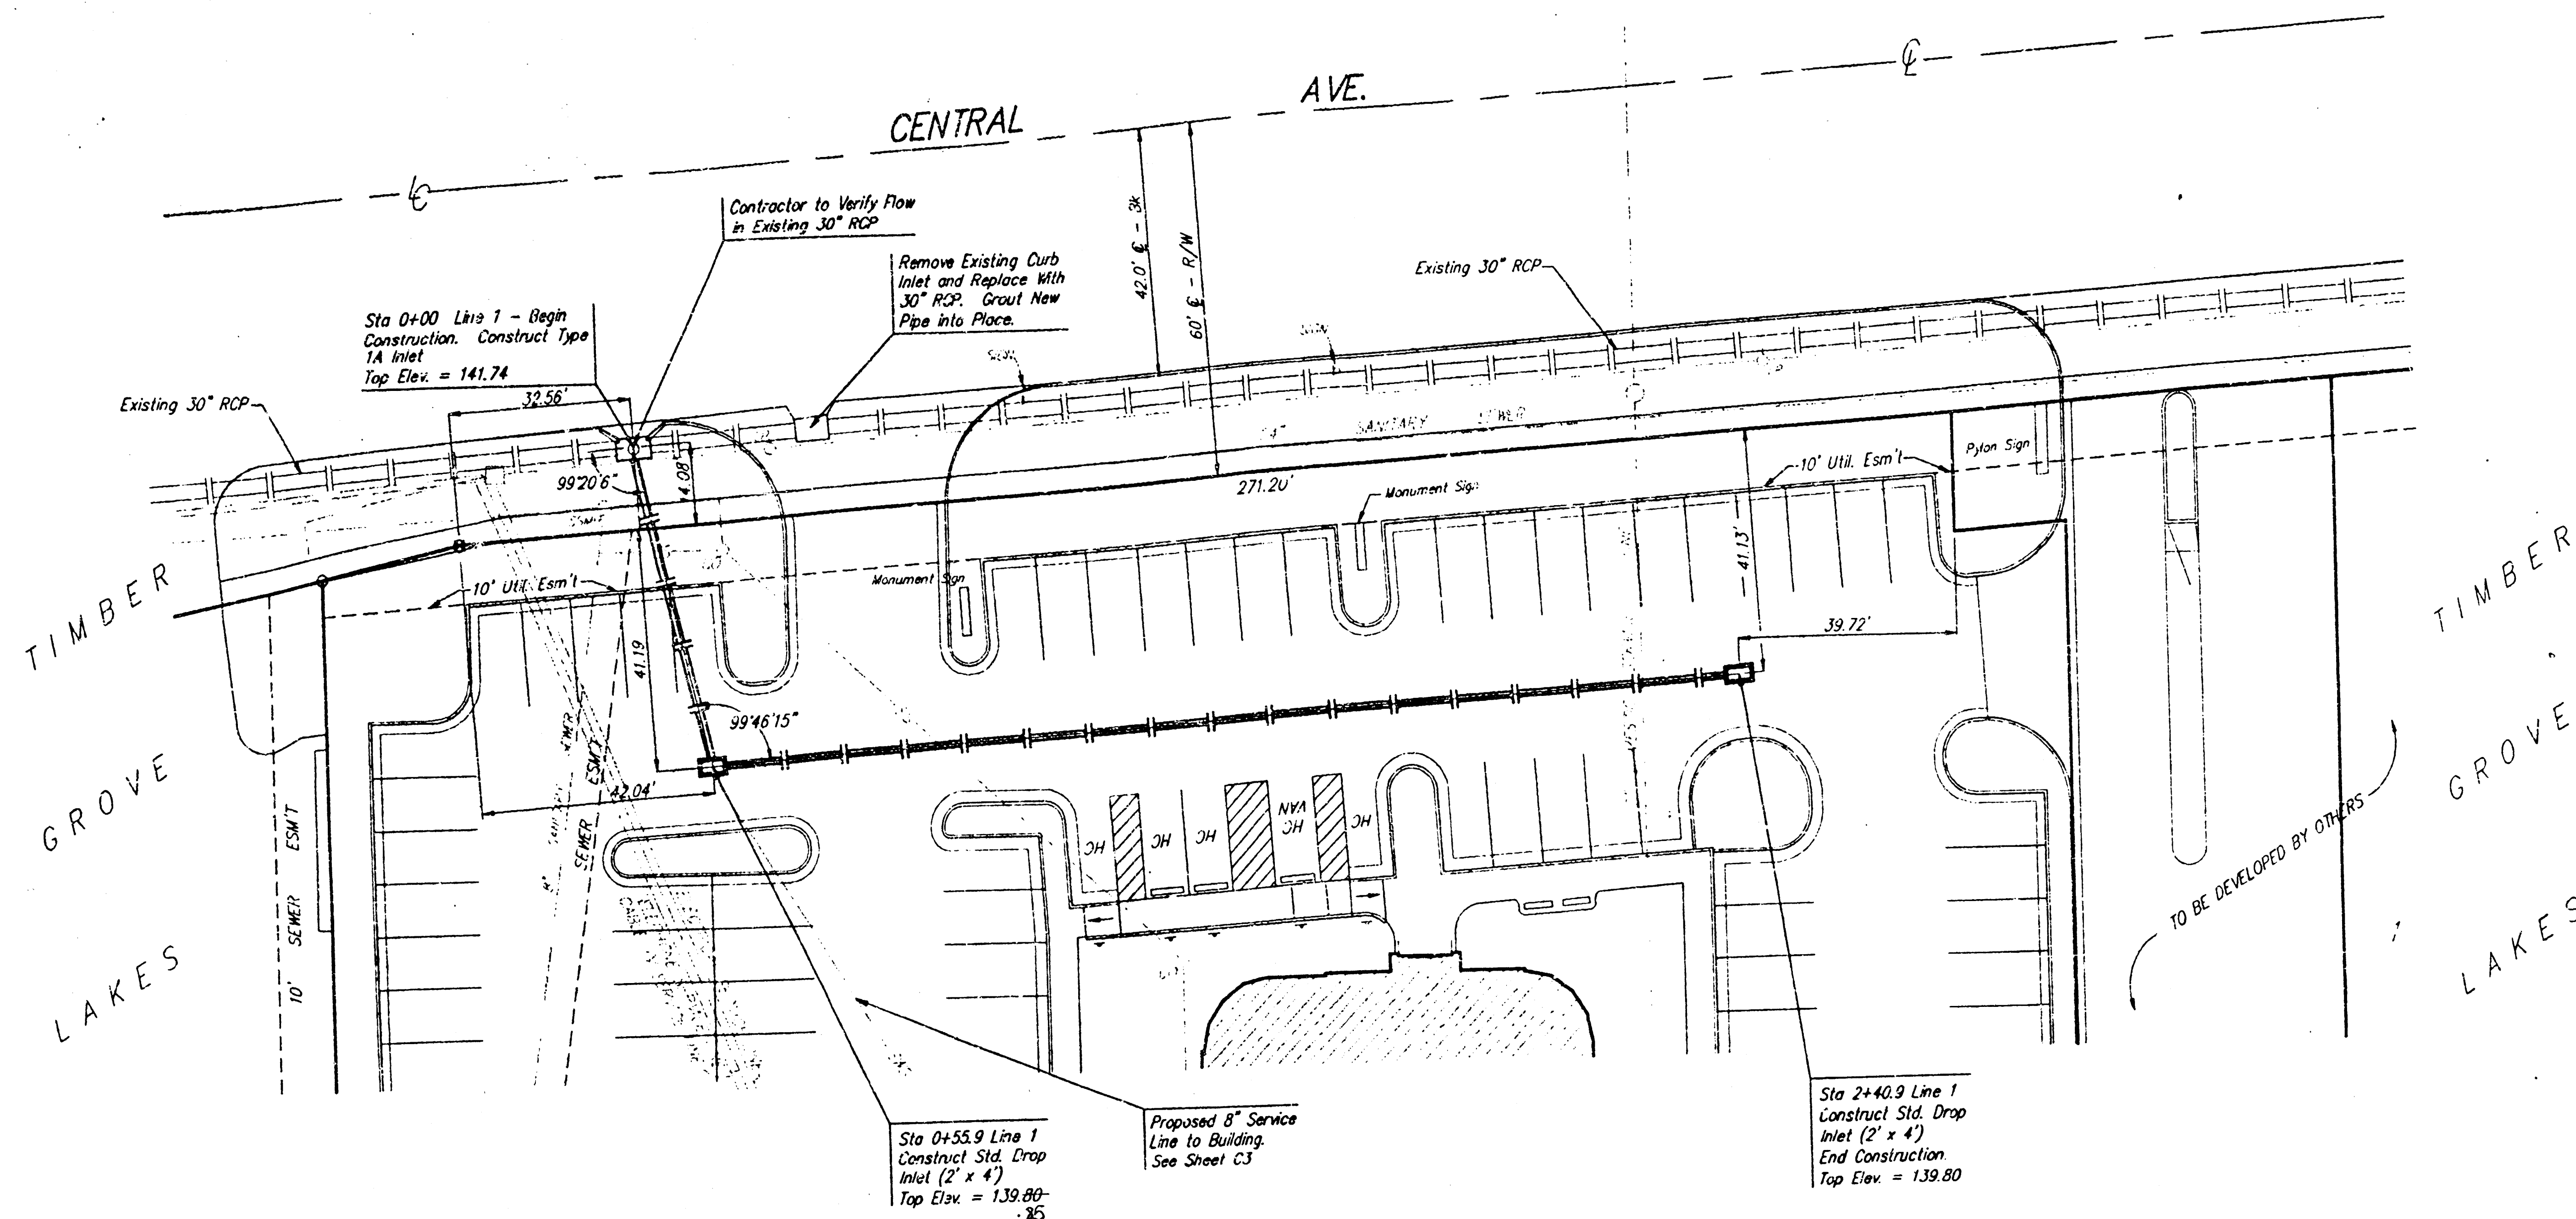



C4

STORM SEWER IMPROVEMENTS

HORIZONTAL: 1" = 20'-0"
VERTICAL: 1" = 5'-0"

CITY OF WICHITA, KANSAS
PRIVATE PROJECT NO. - 471 PPS (607861)
CITY ENGINEER - MICHAEL LINDEBAK

As Built 10-28-94

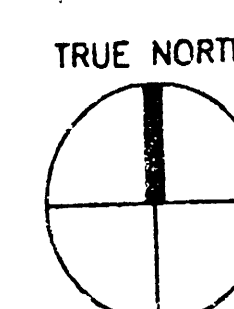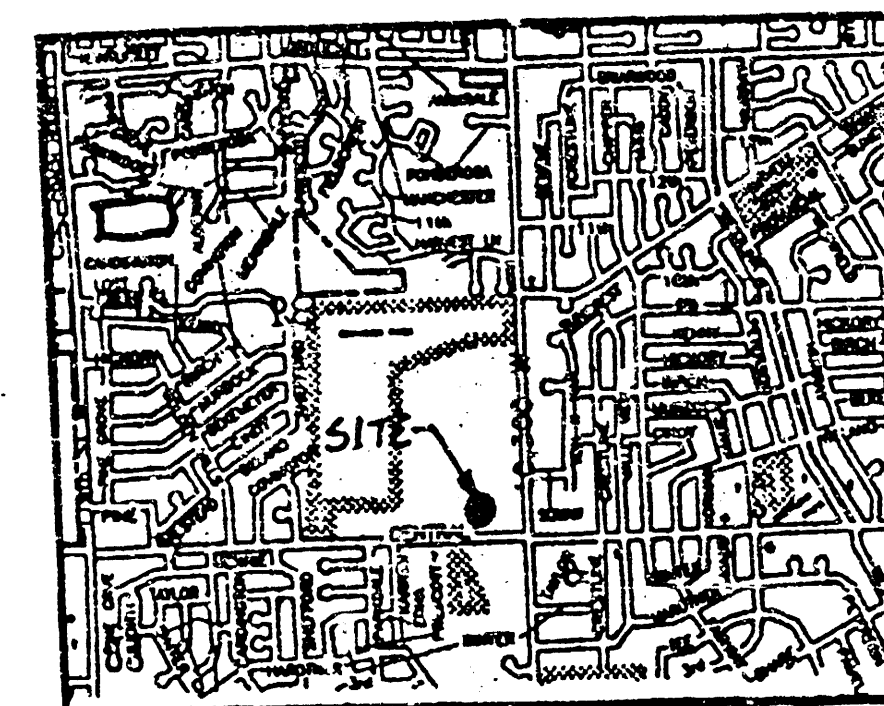

LOCATION MAP

APPROVED AS NOTED
BY CITY ENGINEER OF WICHITA

Sanitary Sewers _____
Storm Sewers VRH 6/22/94
Driveway Approaches _____
Water Mains _____
Paving _____

NOTE TO CONTRACTORS
Inspection and testing for this project is to be provided by a
Licensed Consulting Engineering Firm under contract with the
Owner/Developer. Said inspection to be in accordance with the
City of Wichita standard construction engineering practices and
certified by a Licensed Professional Engineer. No work shall be
performed in dedicated easements or public right-of-way by the
Contractor without such inspection nor shall any work be commenced
without written authorization by the City Engineer. All Construction
and Materials shall comply with the City of Wichita Specifications
and Standards (on file and available in the City Engineer's Office).

NO. DATE REVISIONS BY
DATE OF THIS PRINTING

WEST WICHITA, KS
(CHANGELIST #3 INCLUDED)

chili's
GRILL & BAR

JOB NUMBER
94034.00

SHEET NUMBER

C4

OF SHEETS

DATE OF ORIGINAL ISSUE
22 JUNE 1994

DAVID SCOTT
WINDLE, AIA

10015 Technology Blvd West
Suite 201
Bellevue, WA 98004-4039
Tel: 206/341-1965

Architecture
Interiors
Food Service Design

BAUGHMAN COMPANY P.A.
ENGINEERING & SURVEYING
316-202-1271 • 316 ELLS • WICHITA, KANSAS 67201

CONTRACTOR SHALL VERIFY ALL
CONDITIONS AND DIMENSIONS
AT THE JOB SITE AND NOTIFY
THE ARCHITECTS OF ANY DIMEN-
SIONAL ERRORS, OMISSIONS OR
DISCREPANCIES BEFORE BEGIN-
NING OR FABRICATING ANY WORK
DO NOT SCALE DRAWINGS

