


B.M. 11953 - RR SPIKE - West Face of RR 65' East of Broadway & South Side of 14<sup>TH</sup> Street  
 B.M. 11952 - Top of Iron in Tumble, S.W. Broadway & 14<sup>TH</sup> St. east  
 Base Line - Center Line of Existing Storm Water Sewer


Scale: Horiz.: 1" = 20'  
 Profile: Vert.: 1" = 5'  
 Horiz.: 1" = 20'

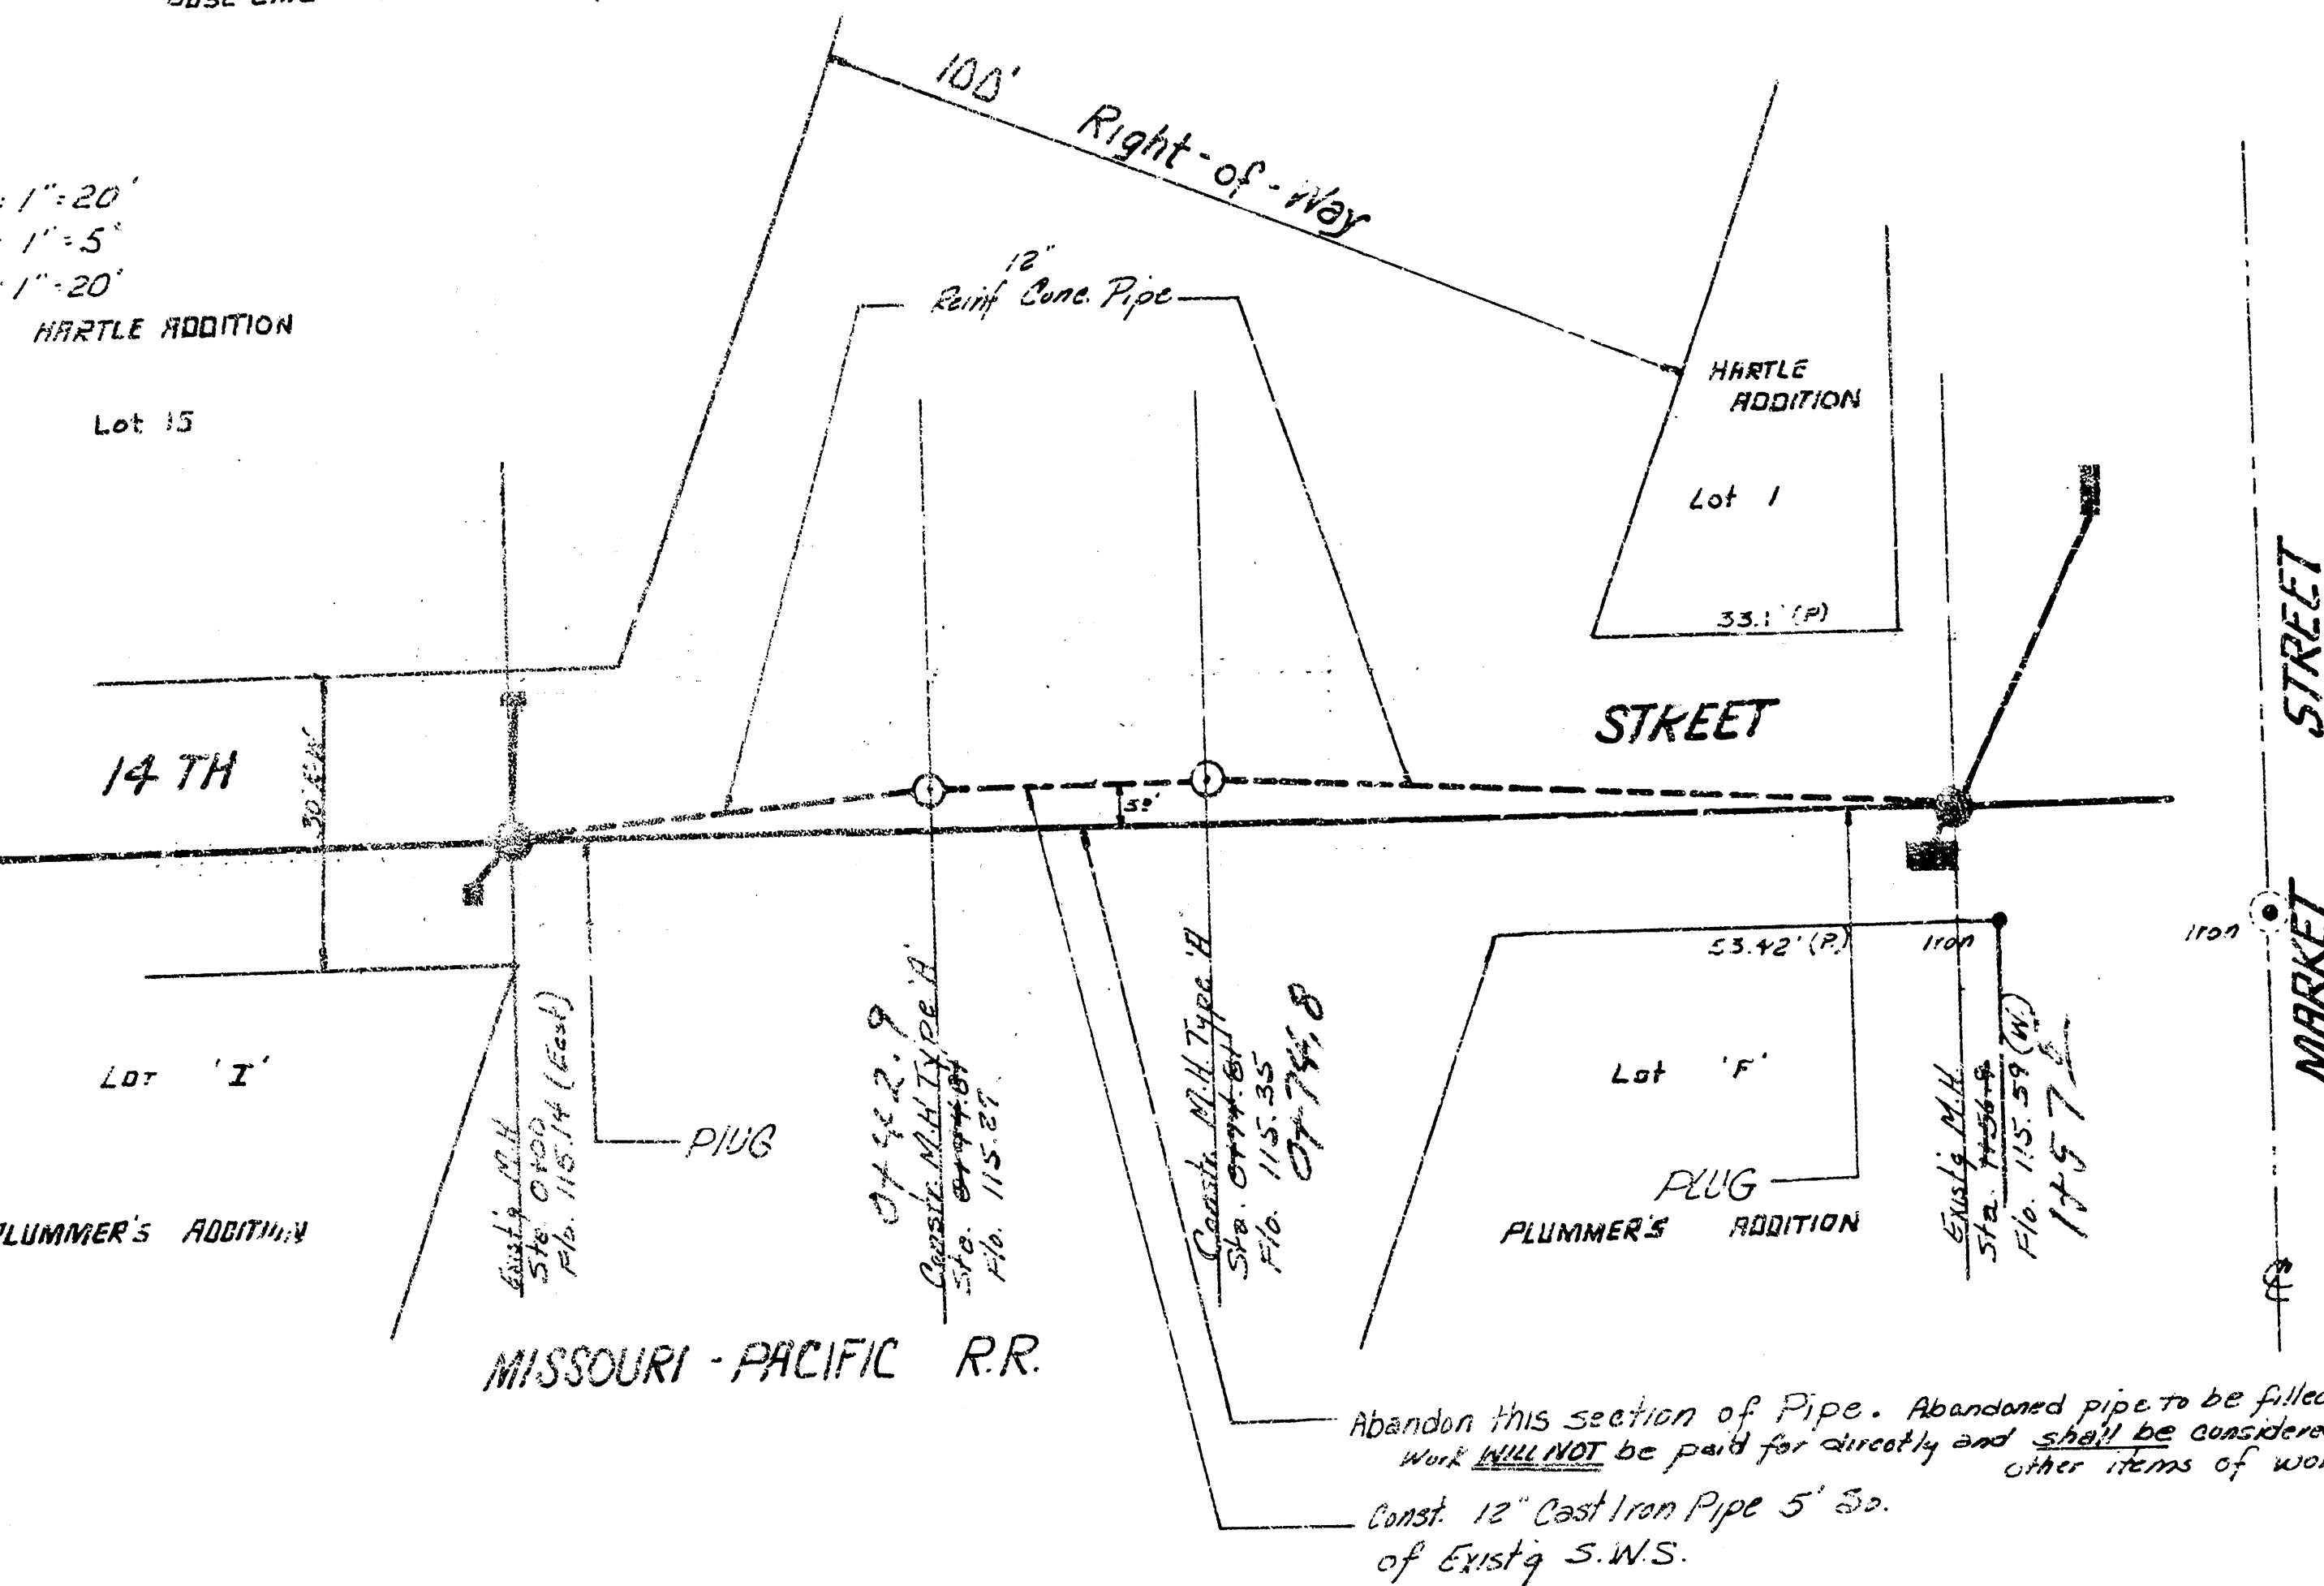

Note to Field Engineer: Field Engineer to determine type of Pipe to be replaced

Type Cast Iron Pipe to be: U.S. TYTON JOINT PIPE  
 or Approved Equal.  
 Manholes to be 4' Dia. Type 'A'

NOTE: 12" Cast Iron Pipe to be  
 Flanged & Jacked for Grade  
 and Alignment.

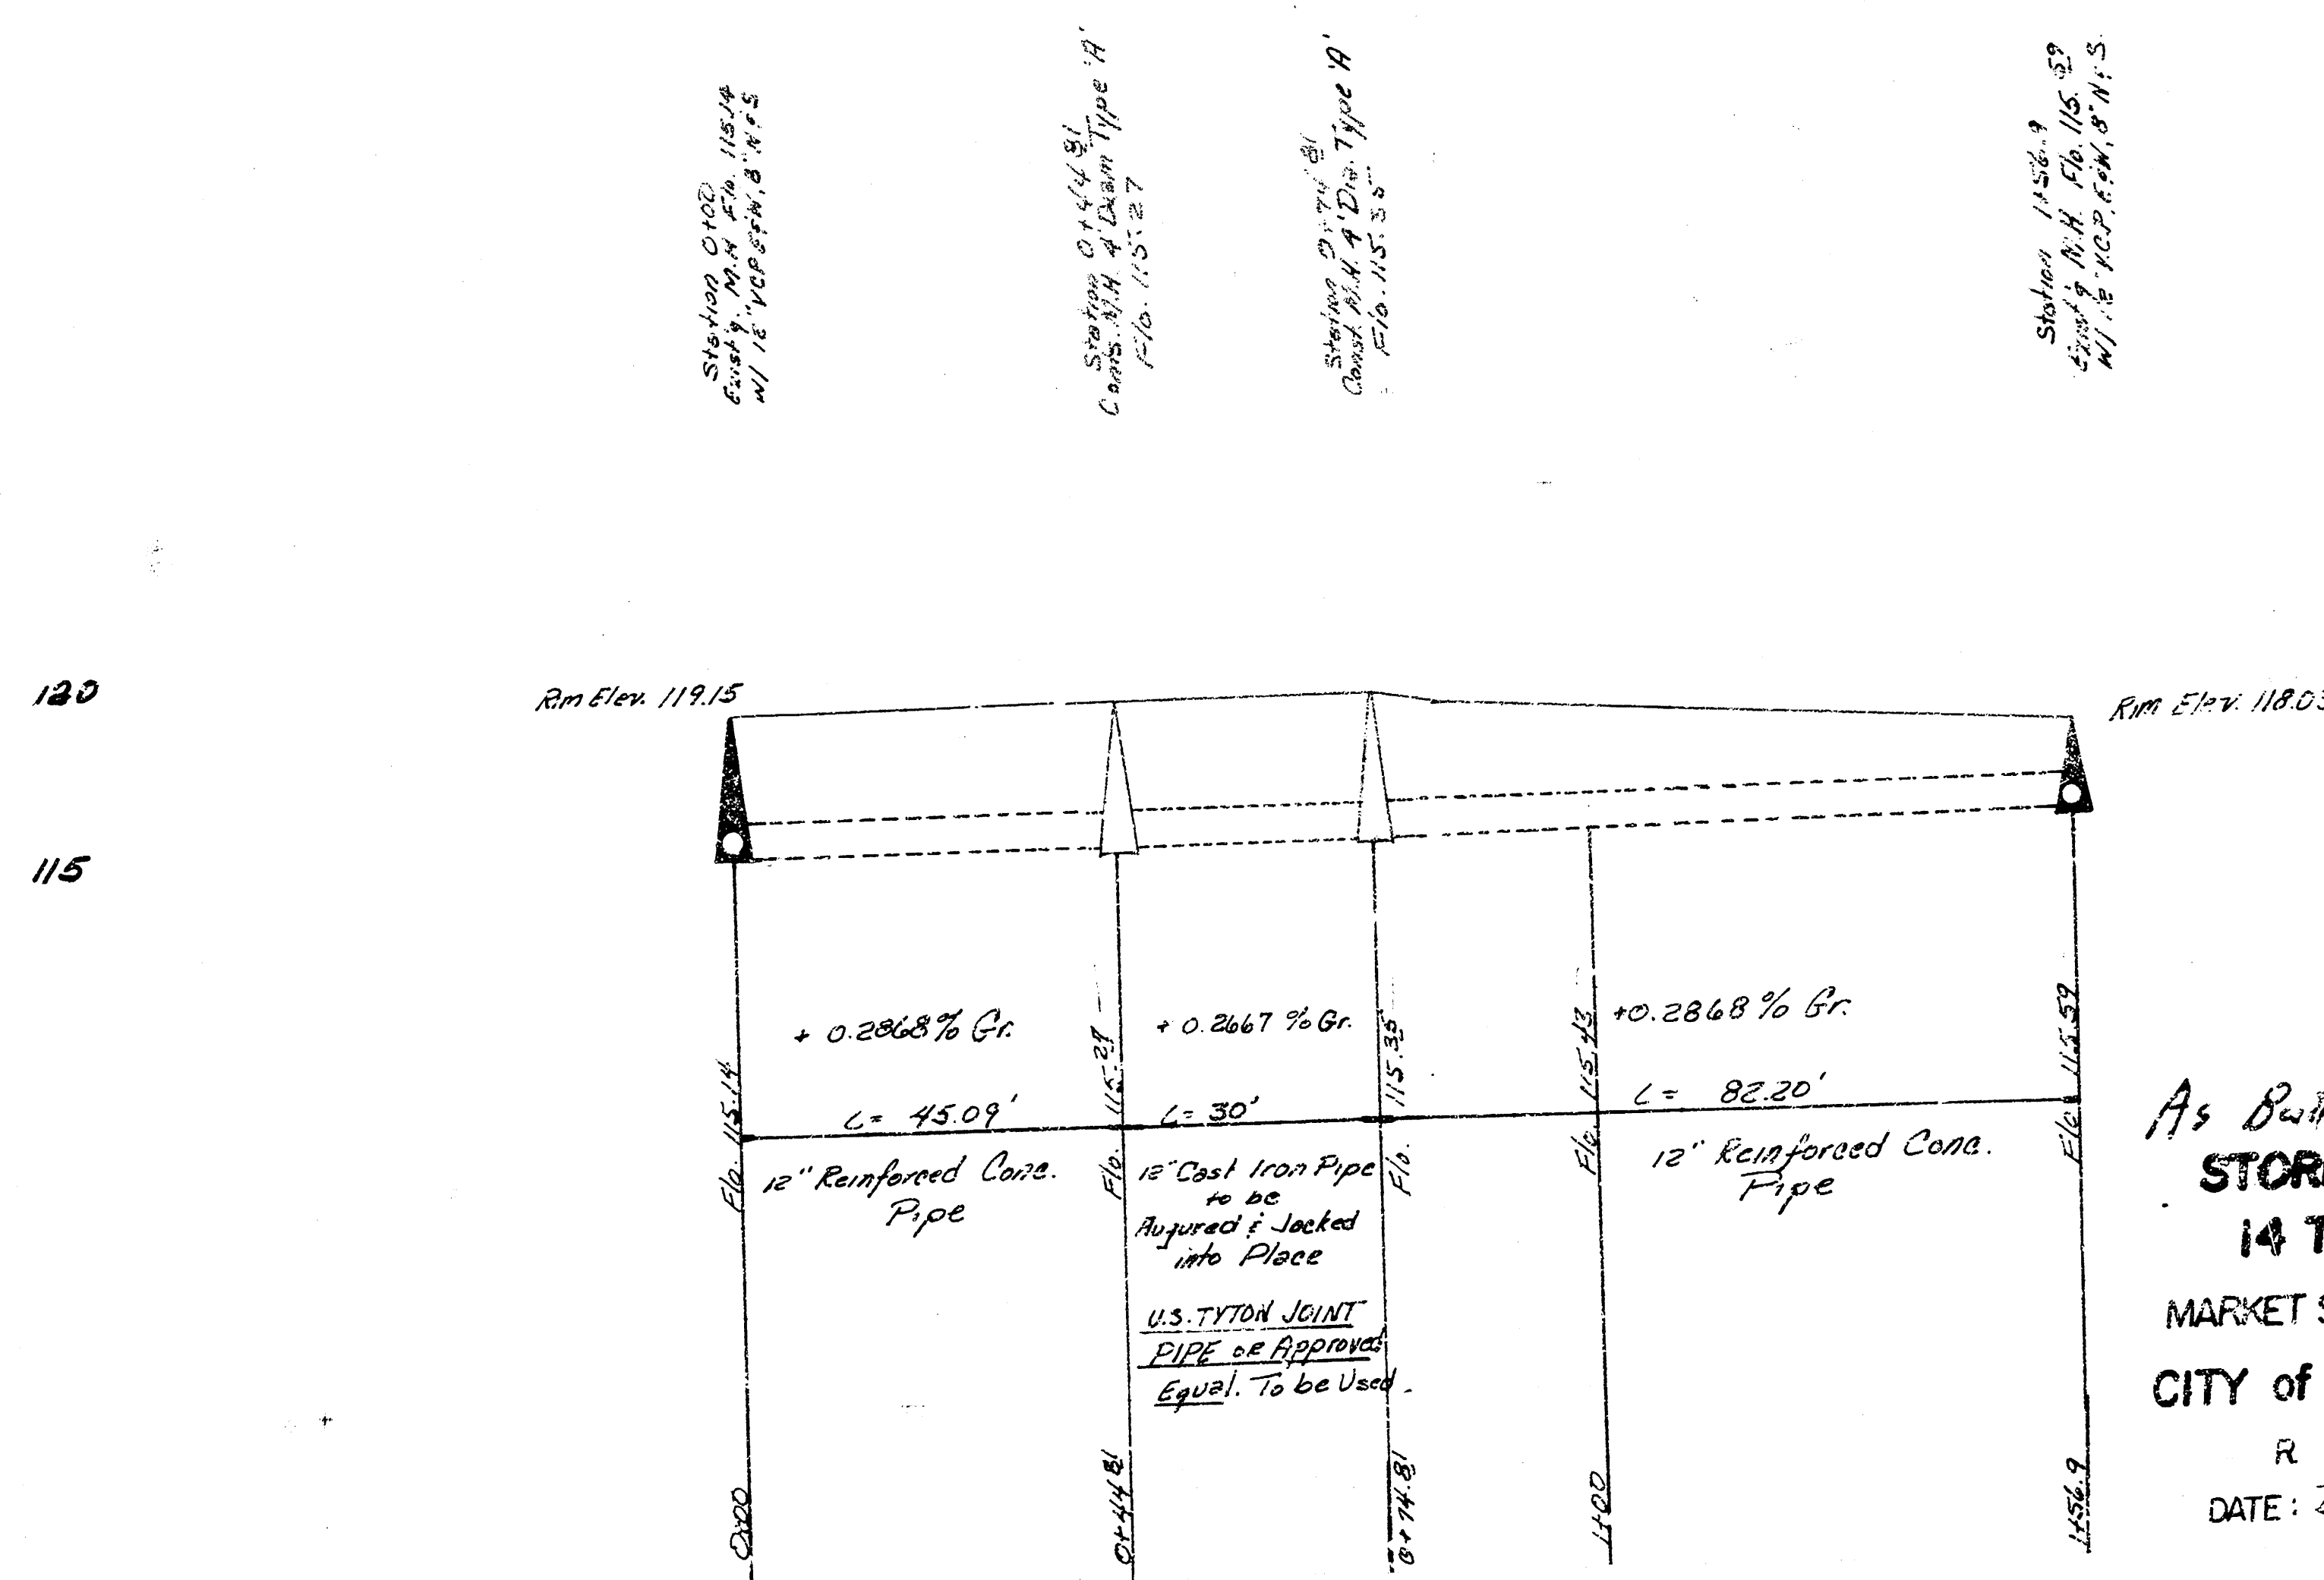

As Built 4-14-76  
**STORM WATER SEWER in**  
**14 TH STREET** from  
 MARKET ST. to 150' E. of MARKET ST.  
 CITY of WICHITA, KANSAS  
 R. W. LINN - CITY ENGINEER  
 DATE: Dec 1975 PROJ. NO. DBKA575082