

STORM WATER SEWER NO. 279



PROJECT NO. 468-76-245-81429-000-000-001

INDEX	
TITLE SHEET	1
STORM SEWER PLAN	2
INLET LOCATION DETAIL	3
MODIFIED TYPE I INLET DETAIL	4-5
DROP INLET DETAIL	6

SYMBOLS	
GAS LINE	— G —
WATER LINE	— W —
SANITARY SEWER	— S —
NEW JOINT	— X —
PAVEMENT REMOVAL	▨

BENCH MARK

Rim of Manhole located 5' left of Sta. 1+88 Line 2
Elevation = 188.45
"X" cut located at the back of the sidewalk approximately
55' west and 50' north of the CL of Central & Edgemoor
Elevation = 187.09

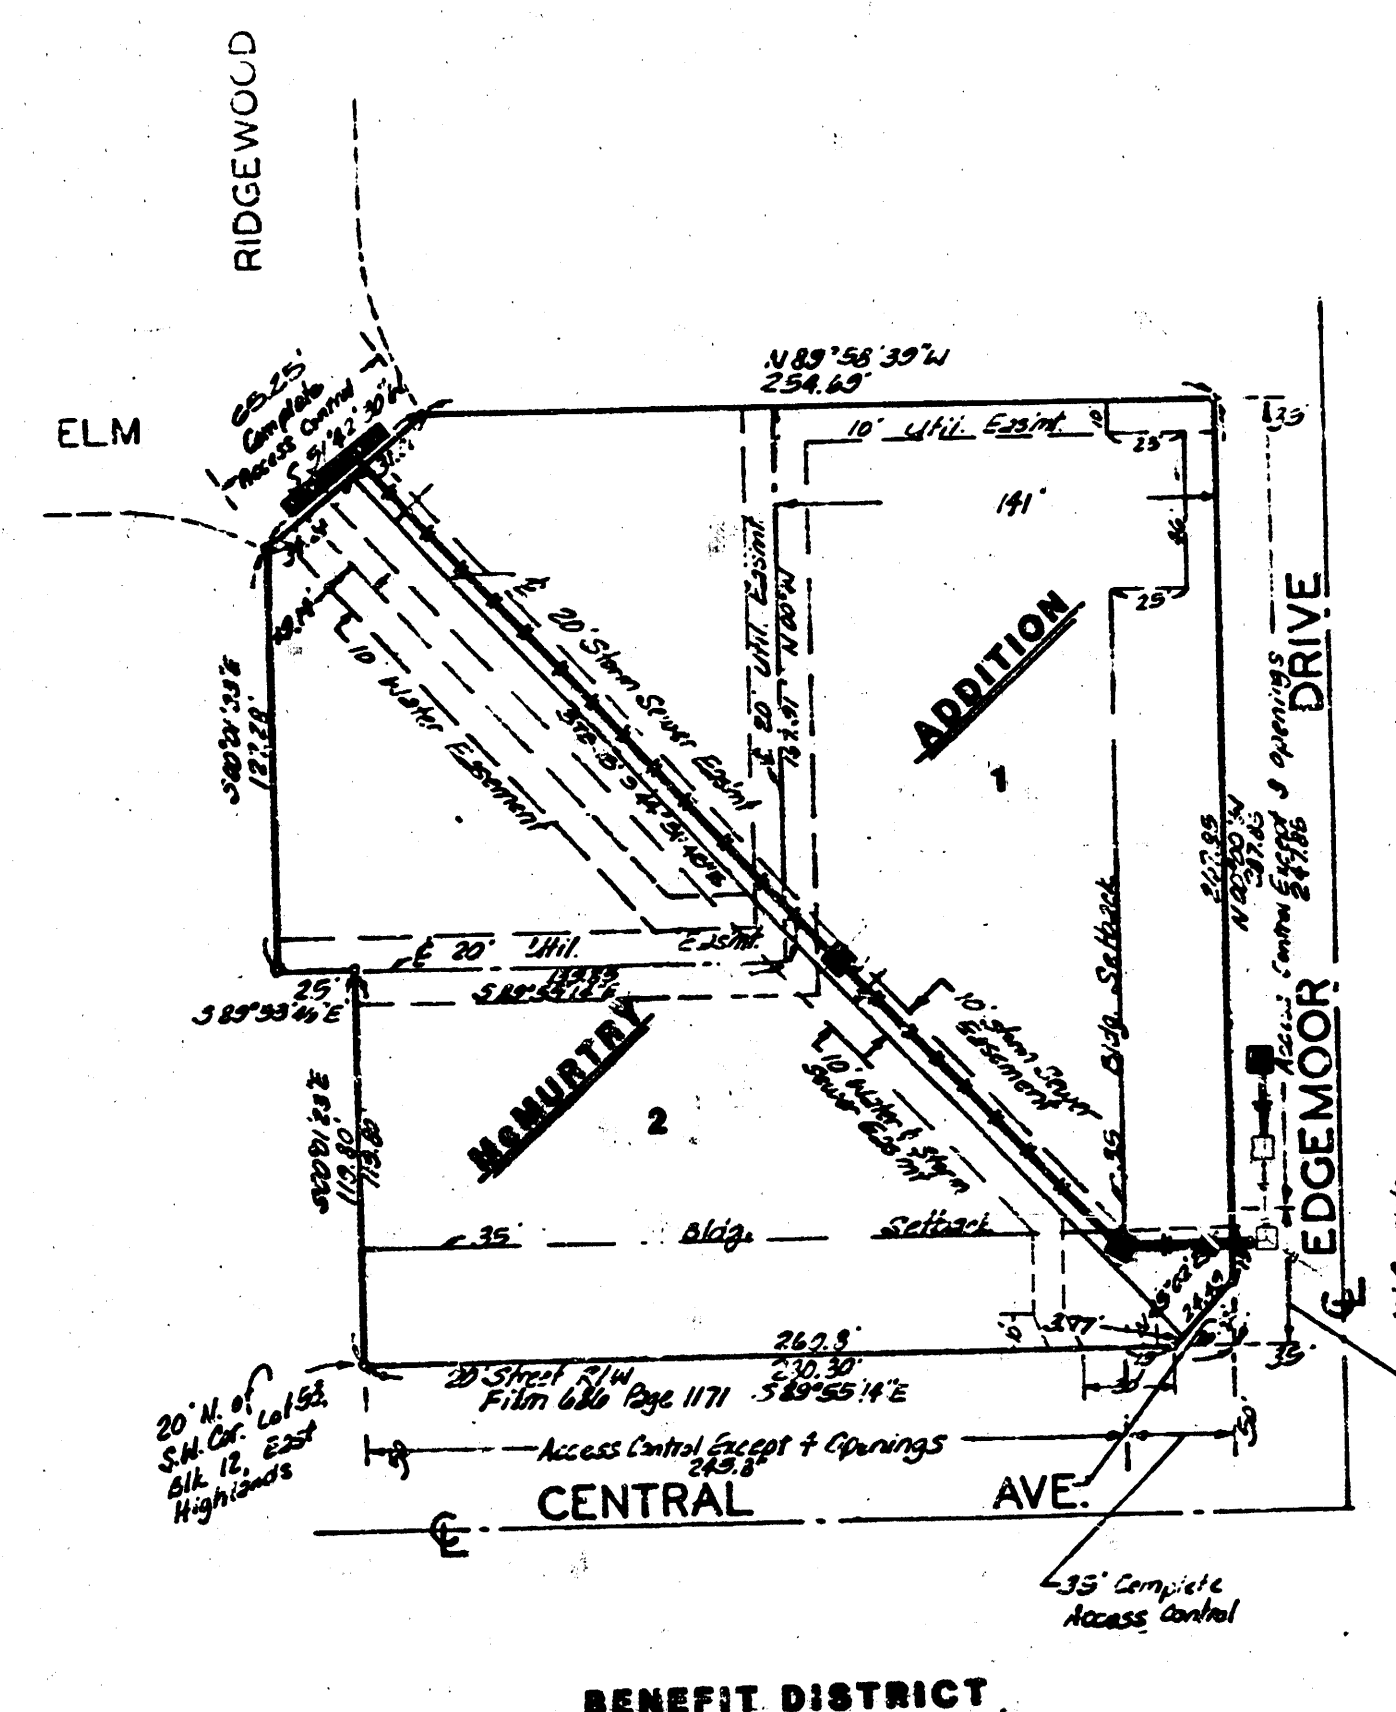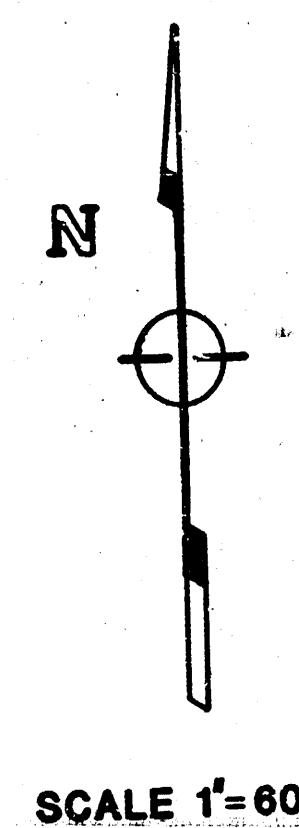


GENERAL NOTES

The contractor shall co-ordinate the storm sewer construction with the contractor of the 6" water main relocation.
The contractor shall notify all the necessary utility companies for verification of their underground lines in the field prior to construction.
The contractor shall also notify specifically The Gas Service Company in order to closely co-ordinate the relocation of their line at Elm and Ridgewood simultaneously with the storm sewer construction and street removal at that location.
The contractor shall use saw joint where necessary for pavement removal. The cost of any sawed joint shall be considered as incidental to the cost of pavement removal.
The contractor shall remove and reset the 30" RCP stub at Sta. 0+39.4 Line 1. The cost shall be considered as incidental to the cost of the 30" RCP.
The contractor shall regrade all disturbed areas within the street RW back in good finished condition. The trench areas and other areas of pavement removal shall be graded back to an even grade.
The intersection at Elm and Ridgewood shall be properly signed and barricaded to traffic during construction at this location.
The contractor shall remove one sign as indicated on the plans. The cost of the sign removal shall be considered as incidental to the project.

AS BUILTS
9/BS
GREENE

CITY OF WICHITA, KS
MICHAEL E. LINDEBAK CITY ENGINEER

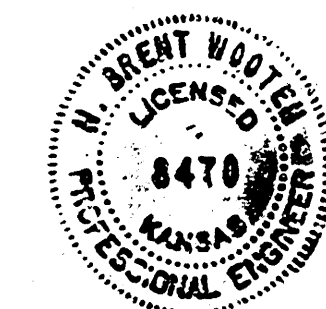



APRIL 1985


ED BAUGHMAN COMPANY, P.A.
SURVEYING & ENGINEERING
316/263-7271 • 320 LAURA • WICHITA, KANSAS 67211

BENCH MARKS
 Rim of Manhole located 9' left of Sta. 1+88 Line 2
 Elevation = 188.44 189.13
 "A" cut located at the back of the sidewalk approximately
 55' west and 50' north of the CL of Central & Edgemoor
 Elevation = 187.09

SCALE: 1"=20' PLAN
 1"=5' PROFILE


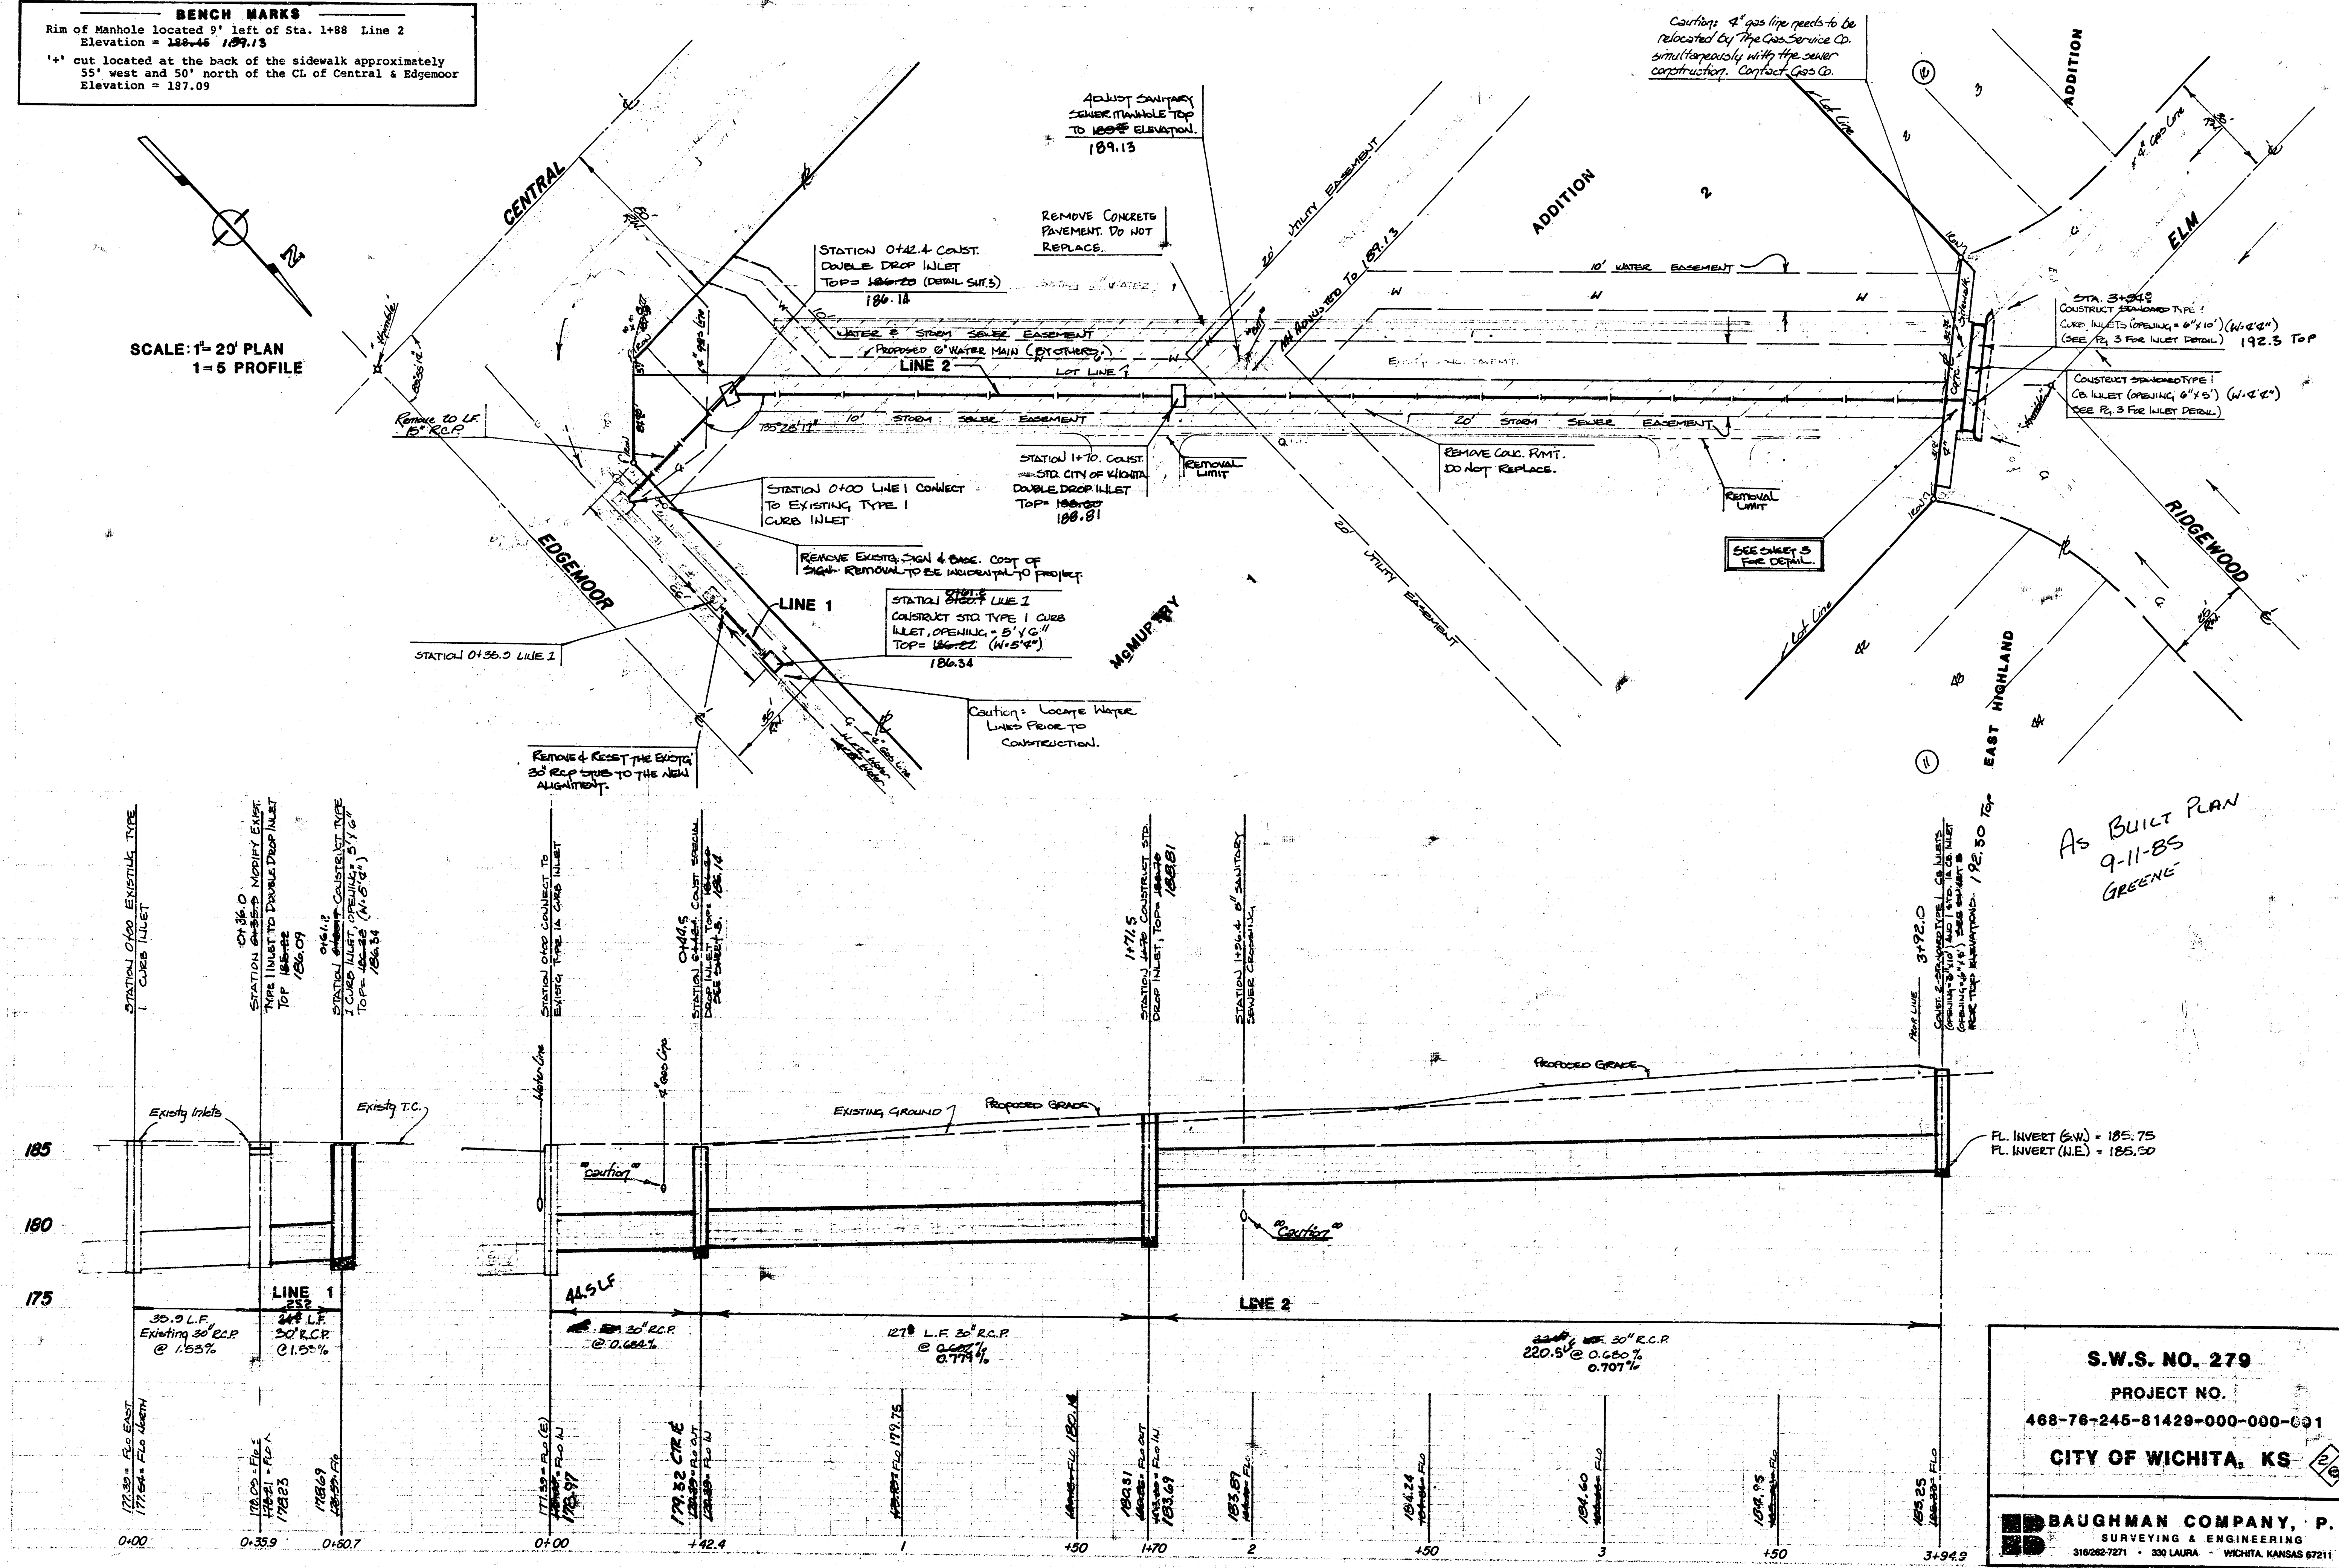


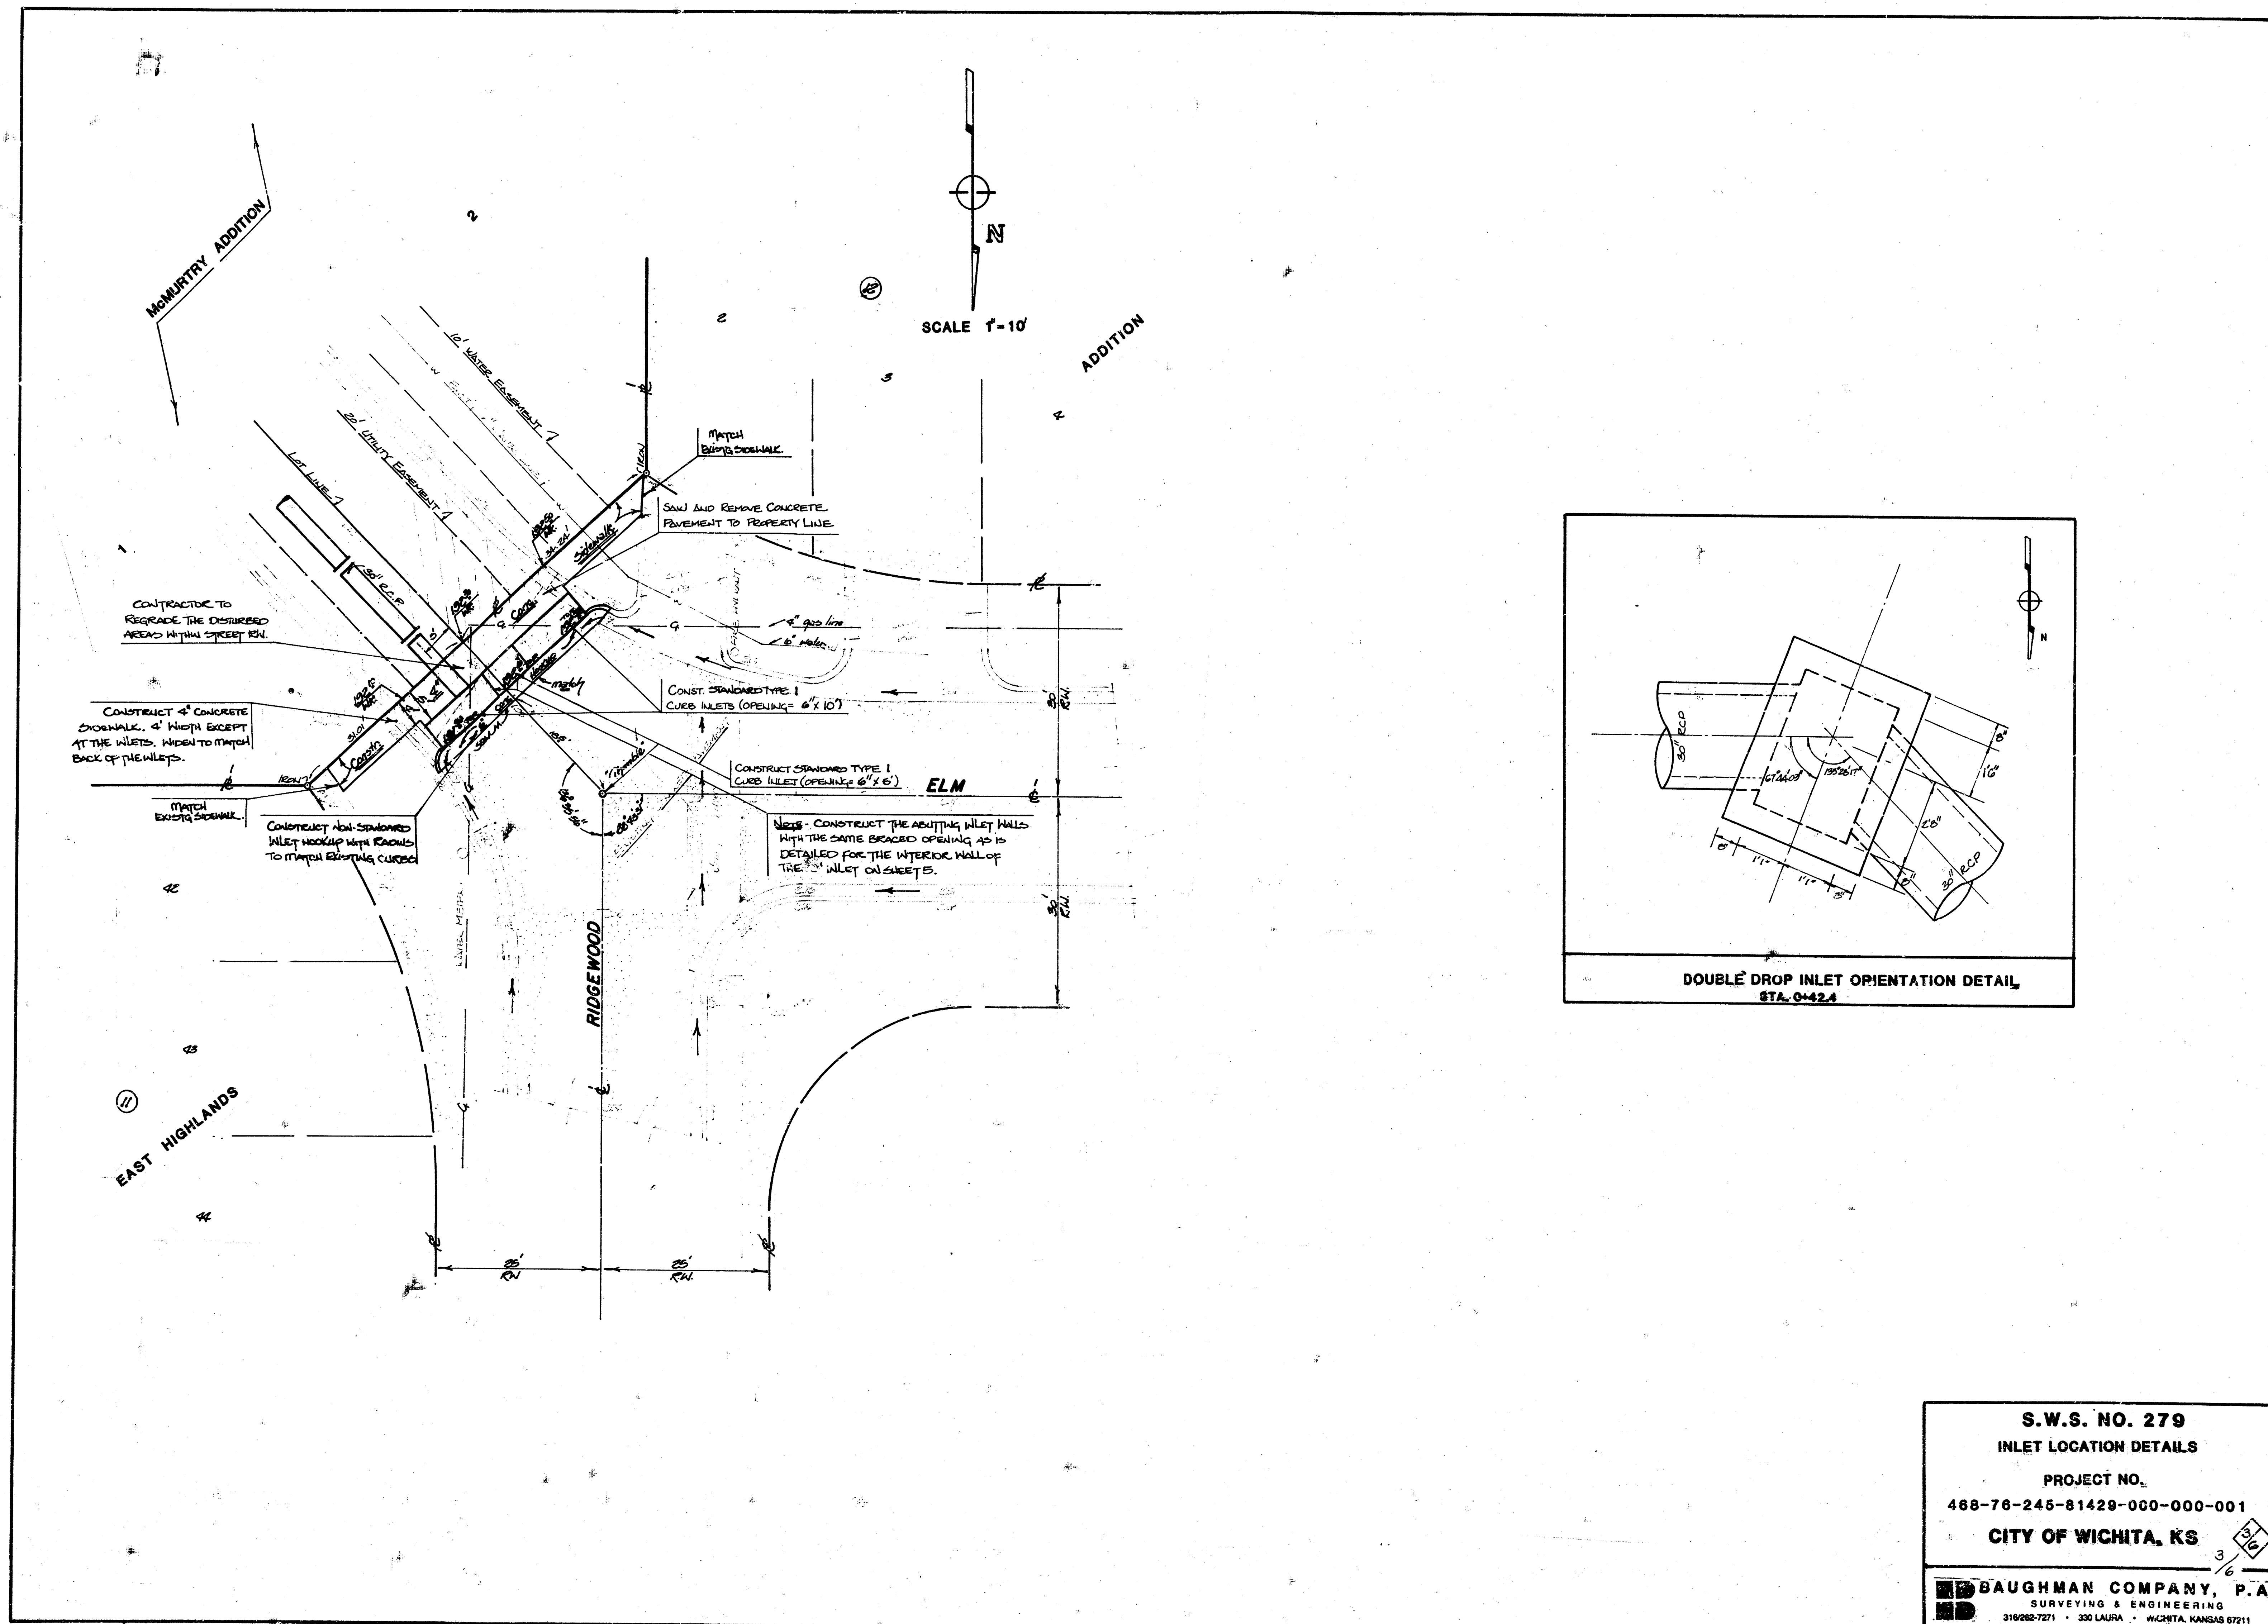

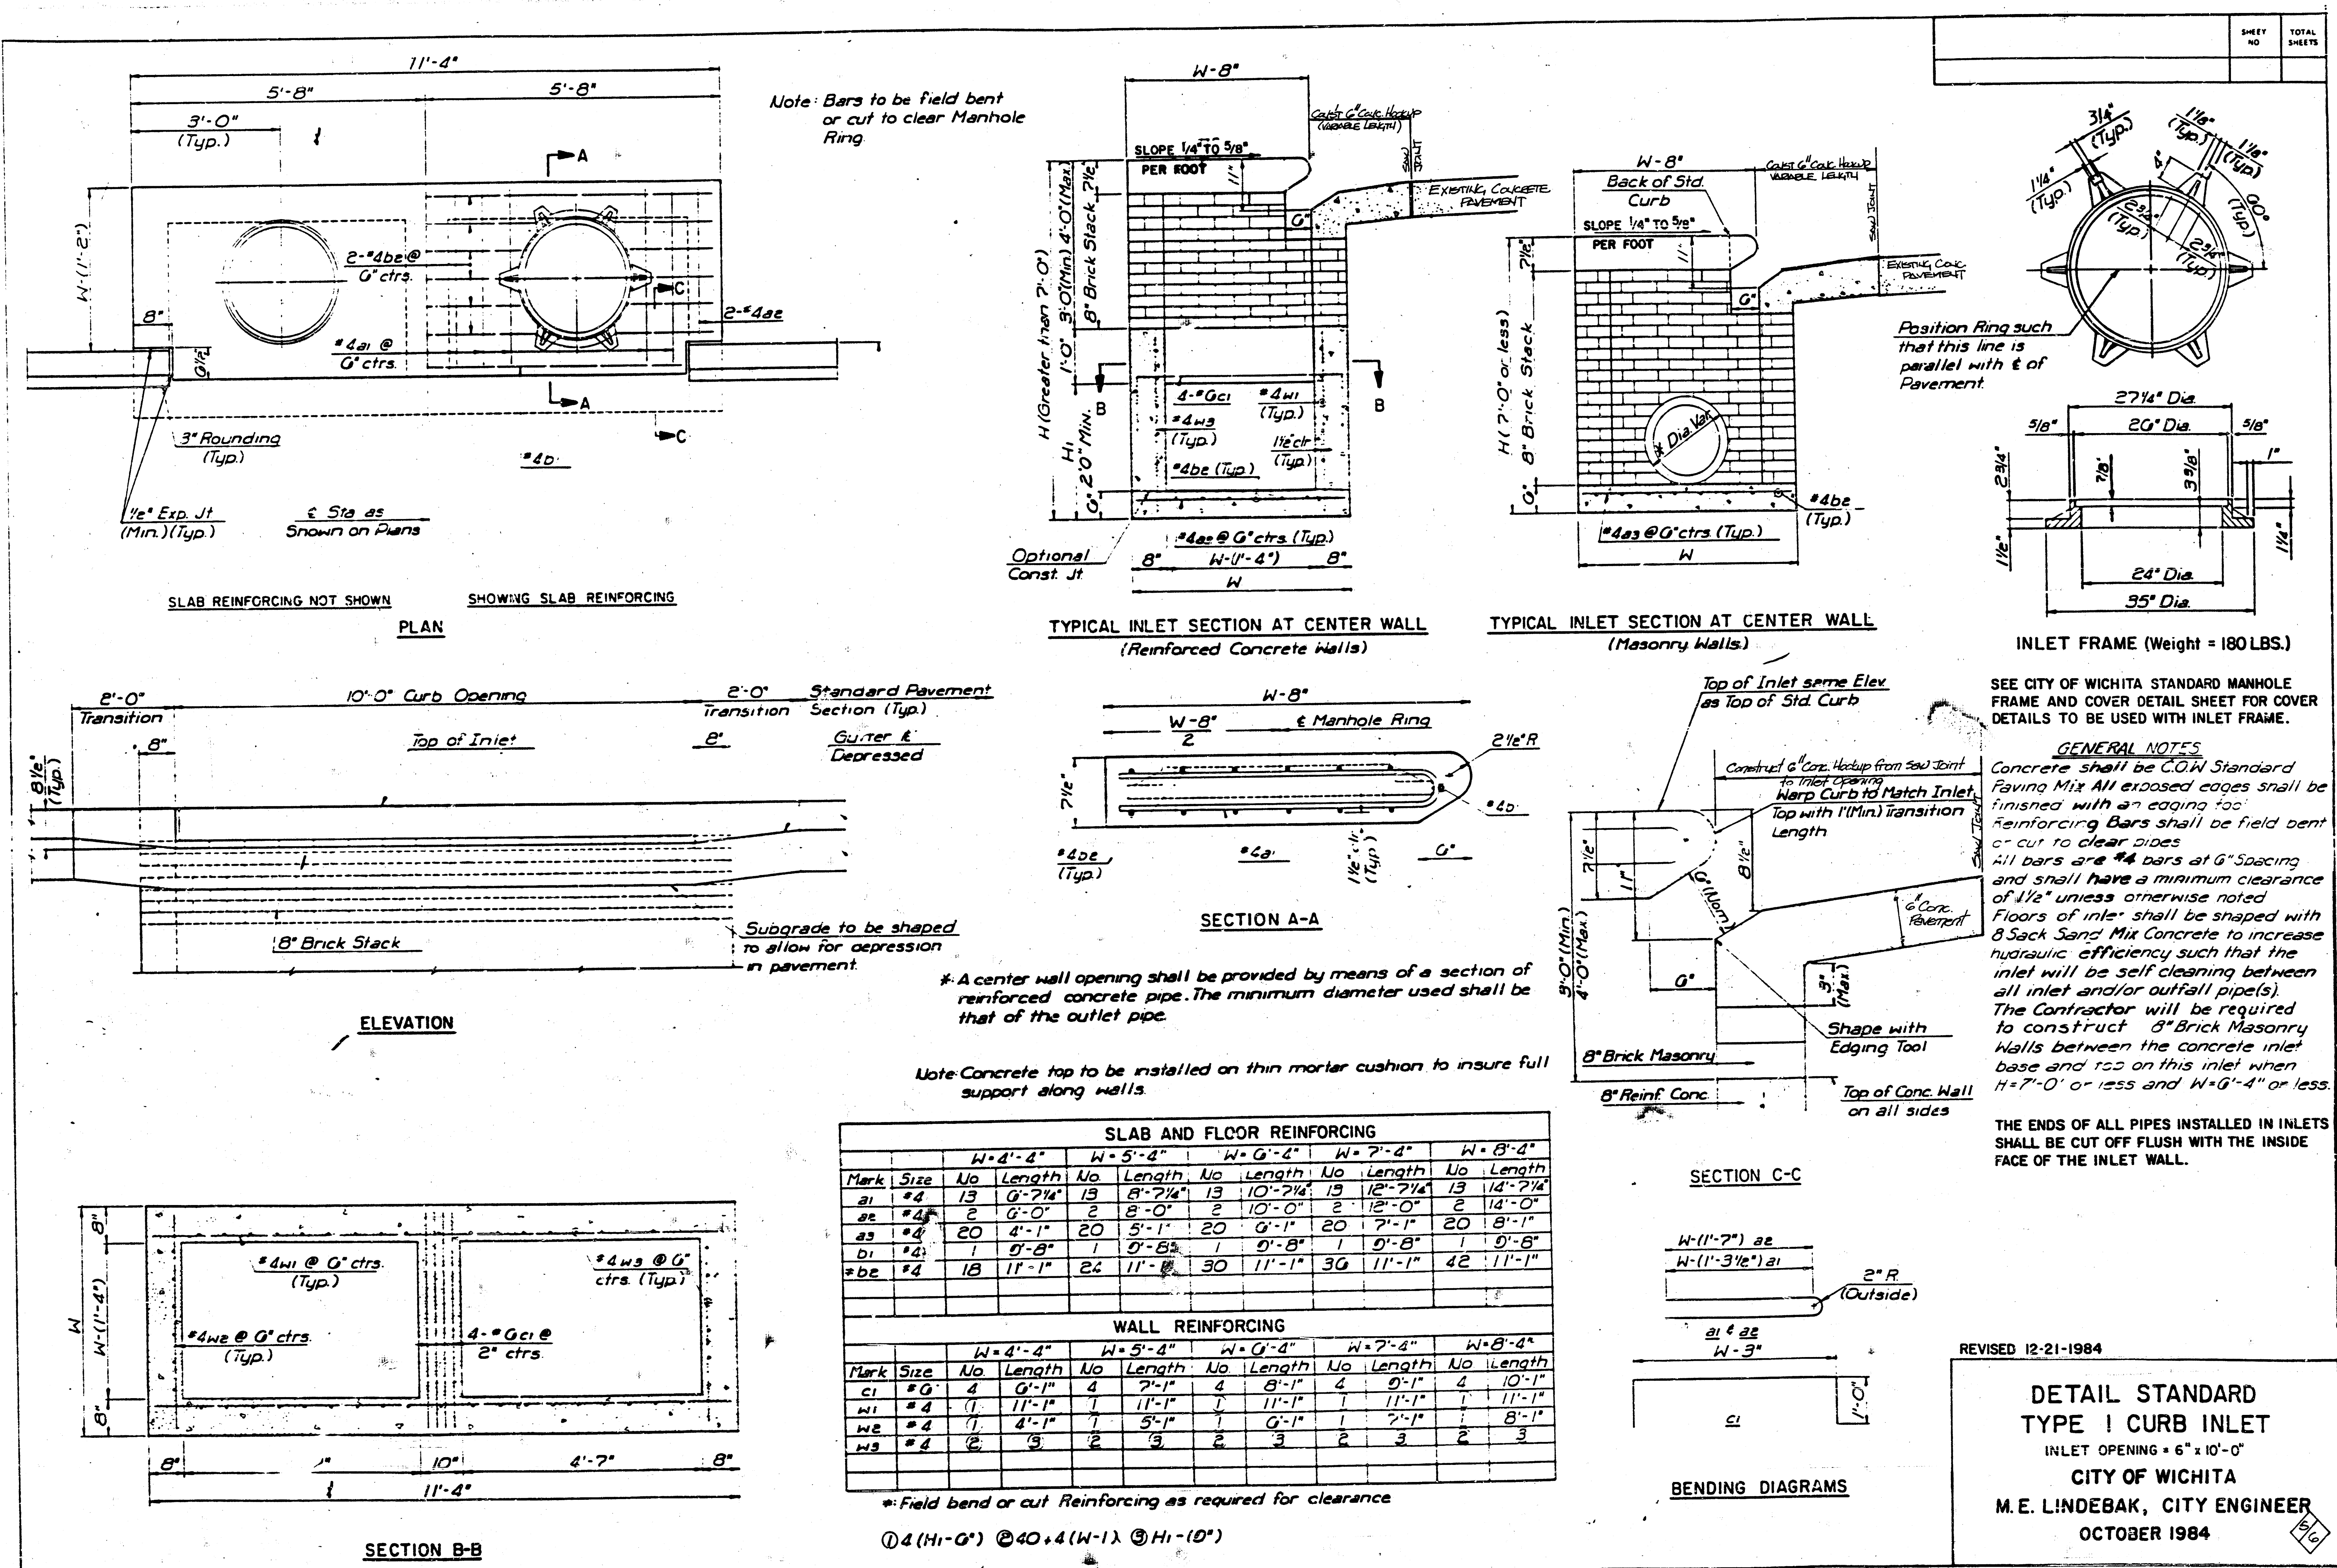


SHEET NO.	TOTAL SHEETS
1	1

NOTE: Grates shall be imprinted on the top surface with "CITY OF WICHITA" using letters at least 1" in height. Other marking methods may be used only if approved by the engineer.


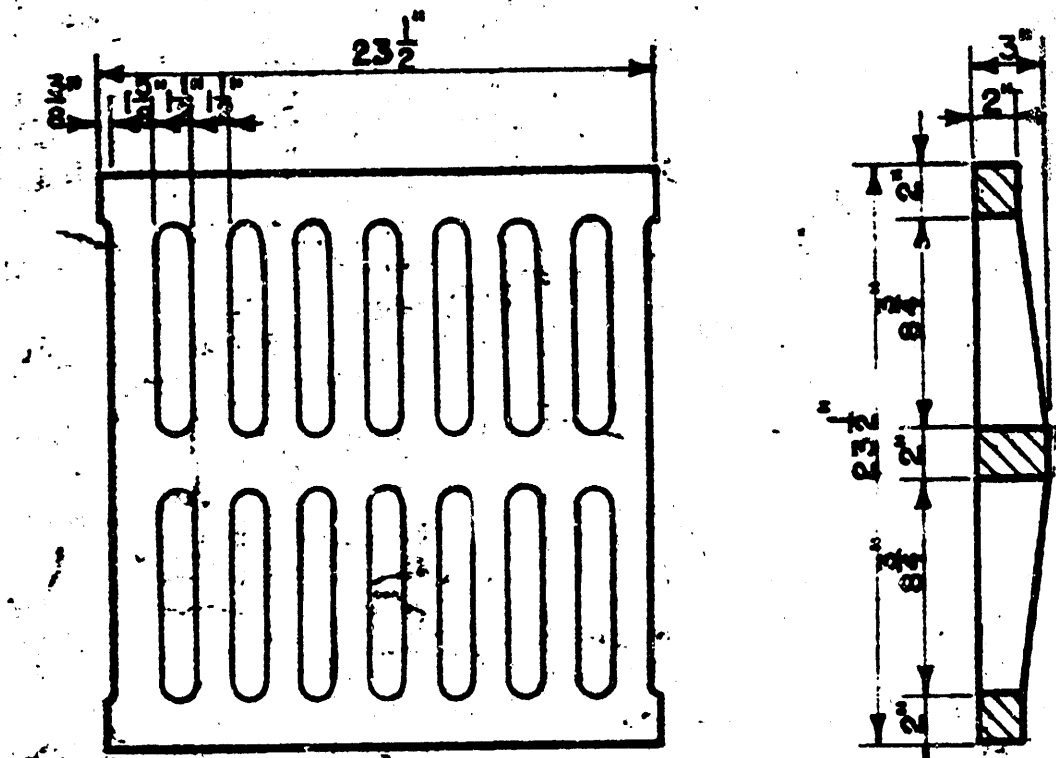
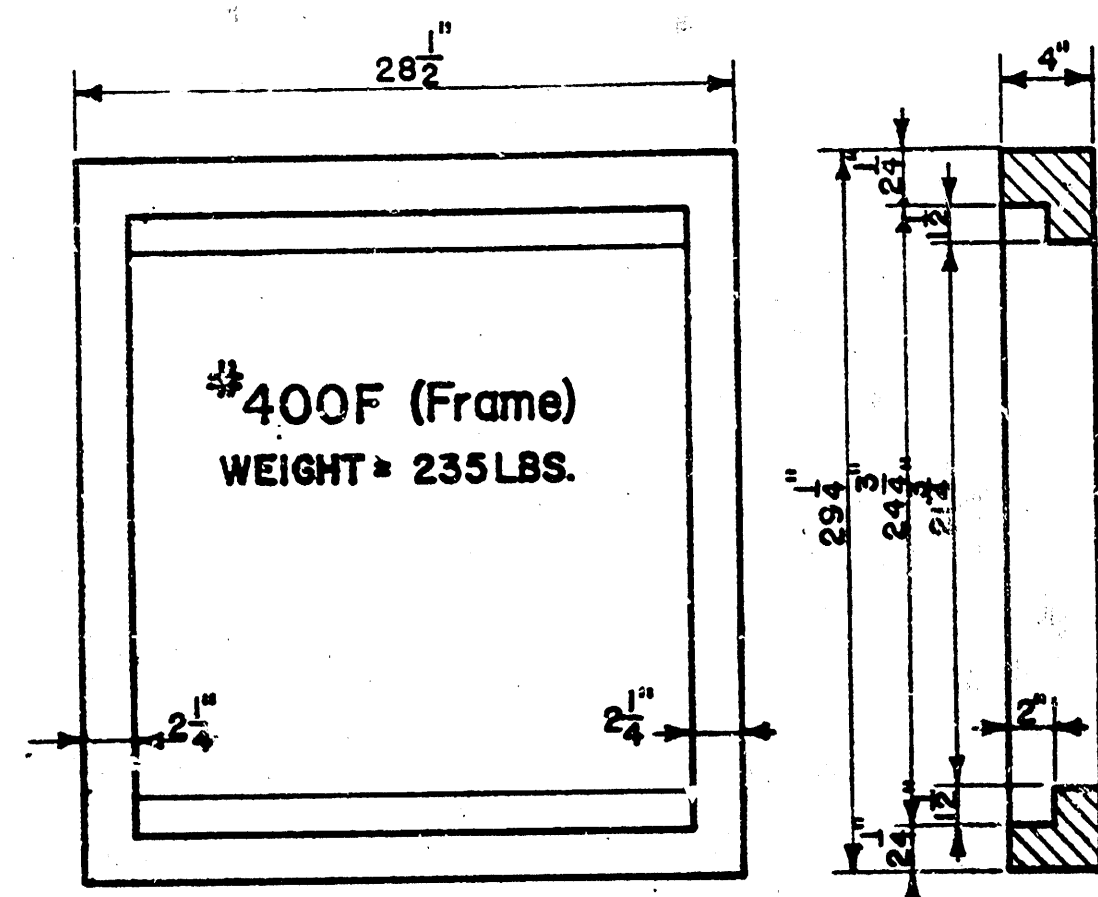


400G (Grate)
WEIGHT = 235 LBS

24"x24" Frame & Grate Detail

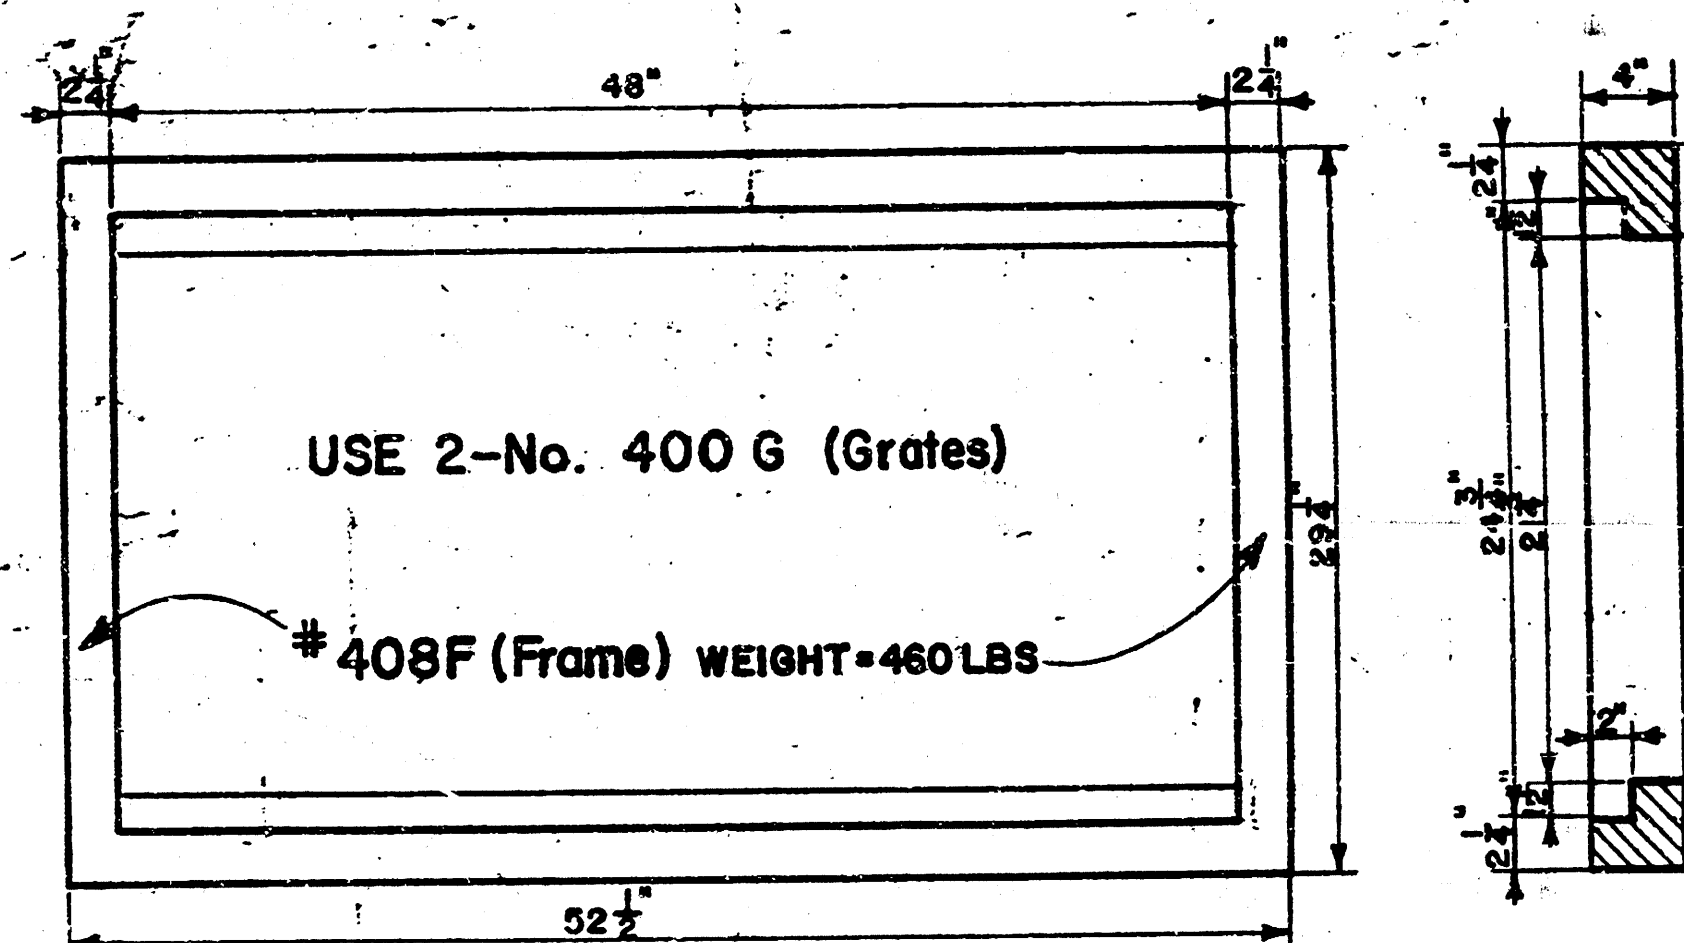

Double 24"x24" Frame Detail

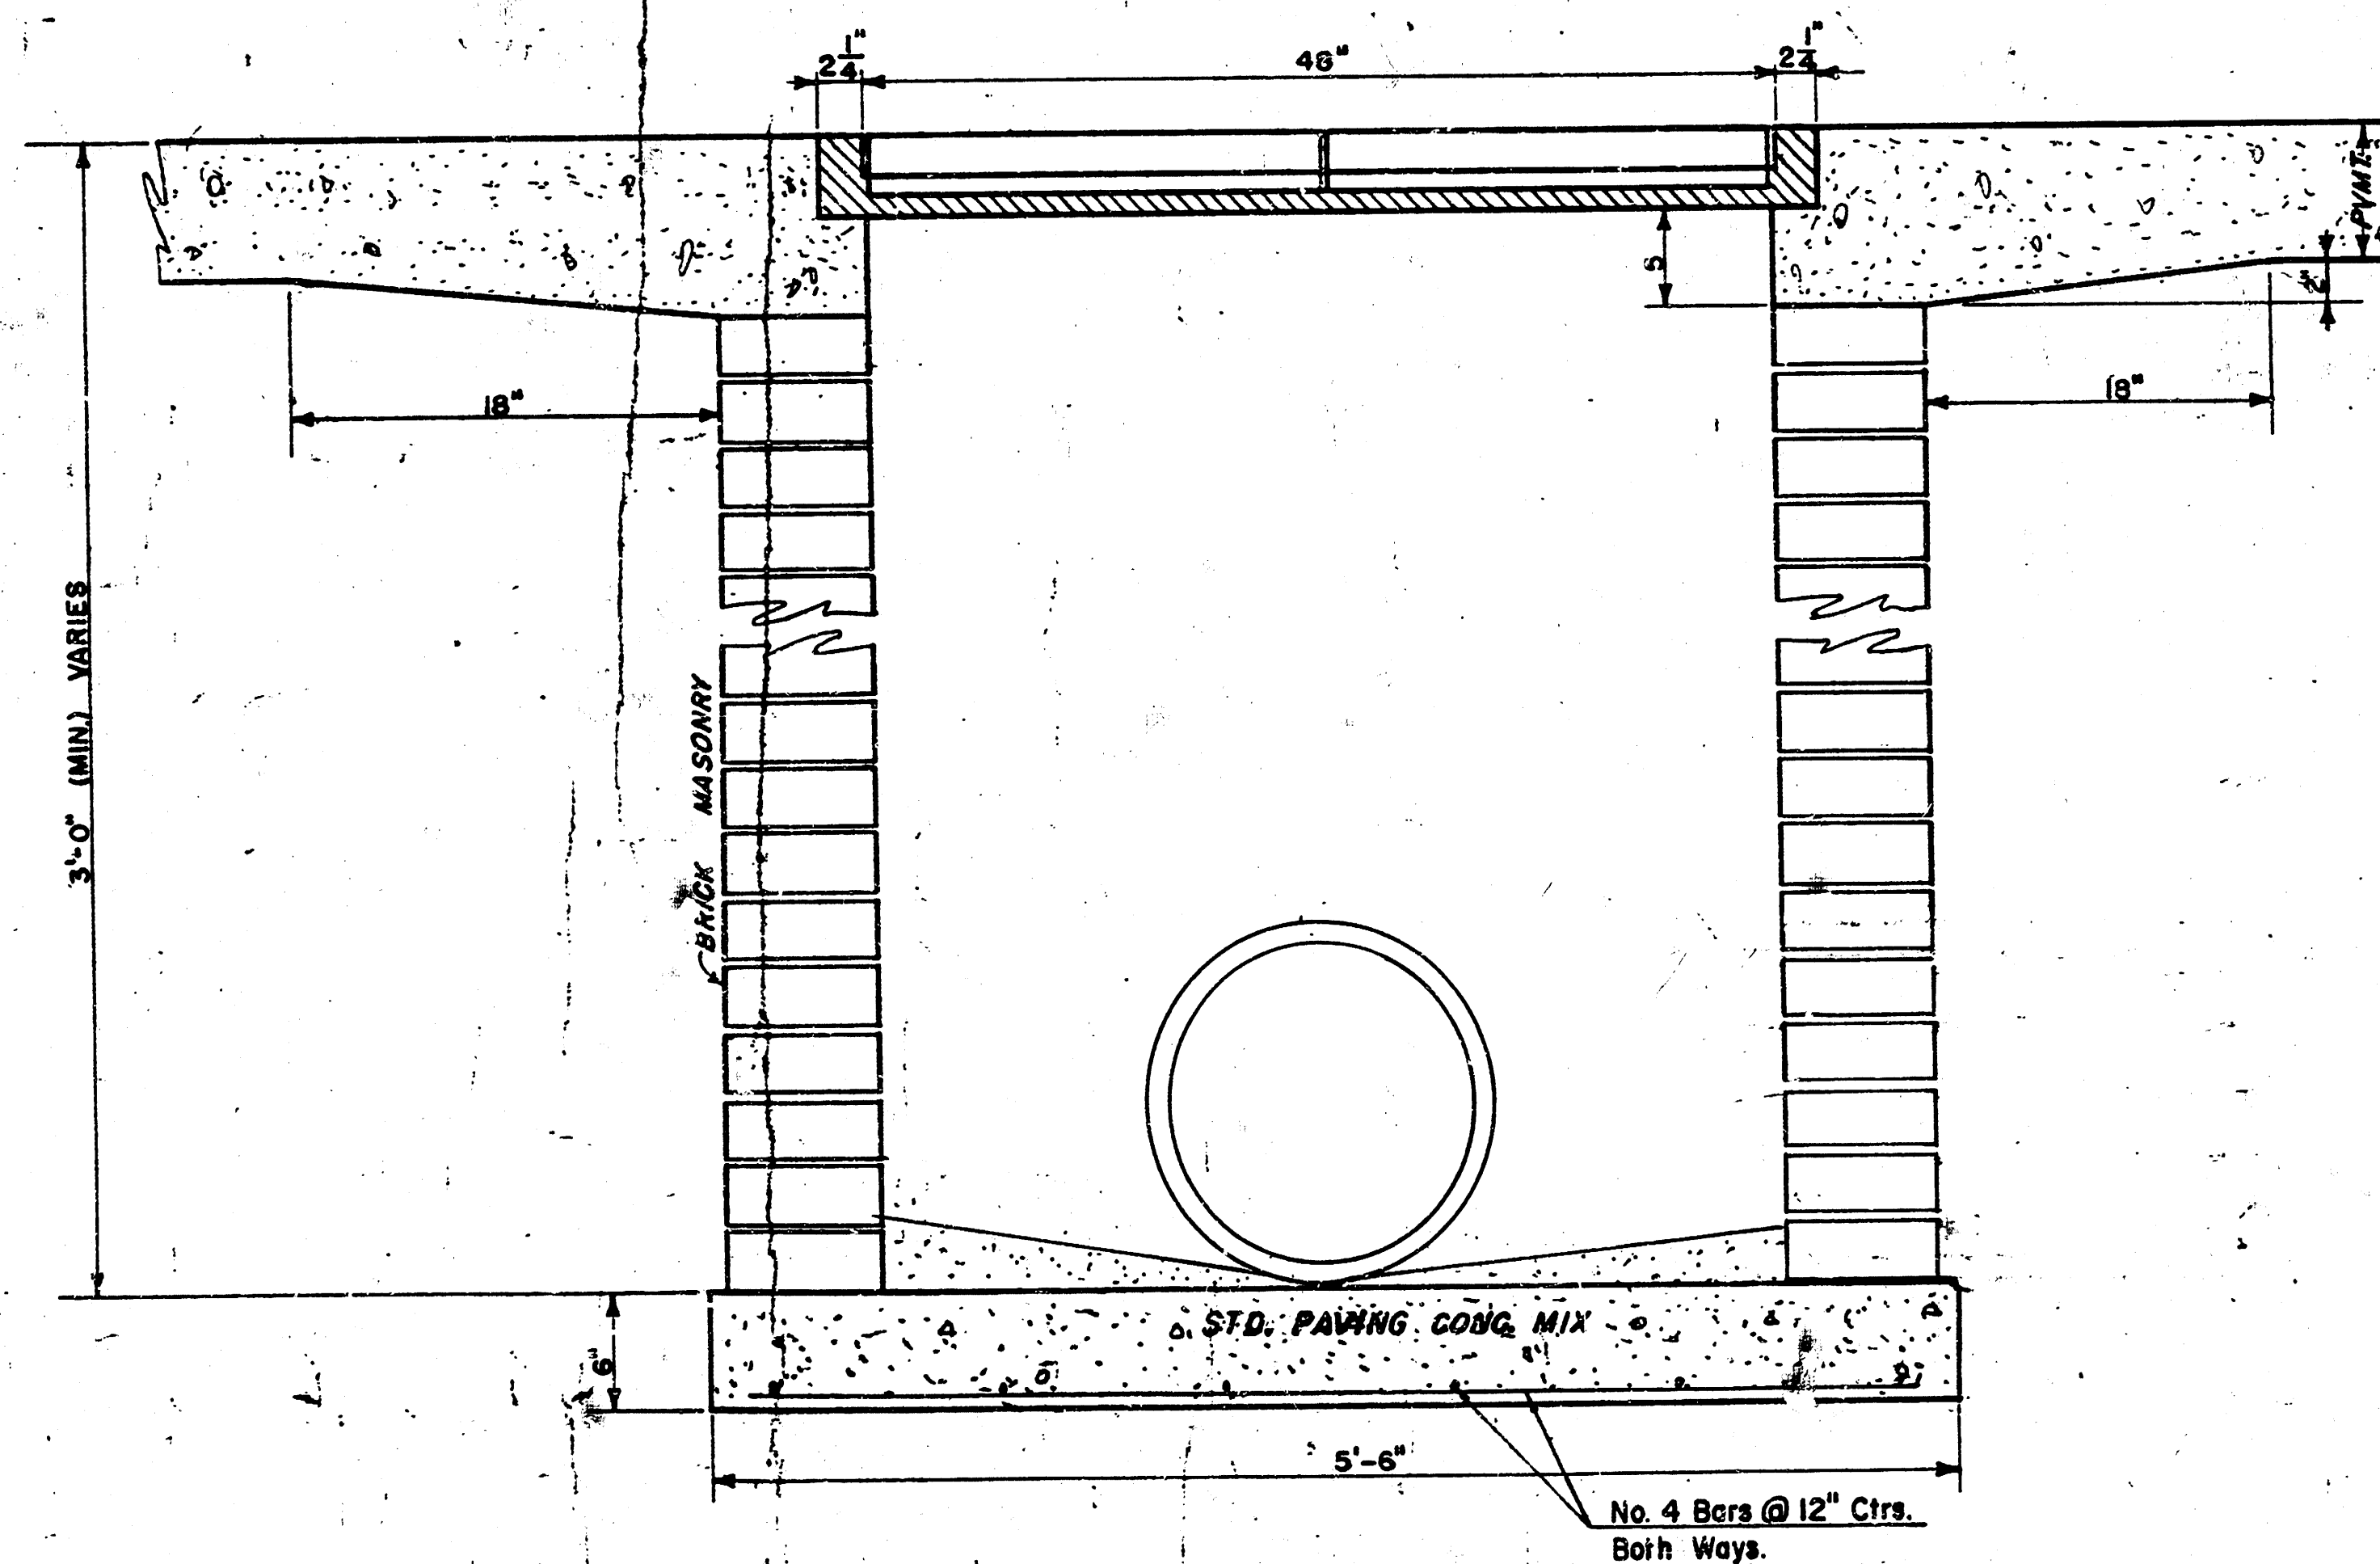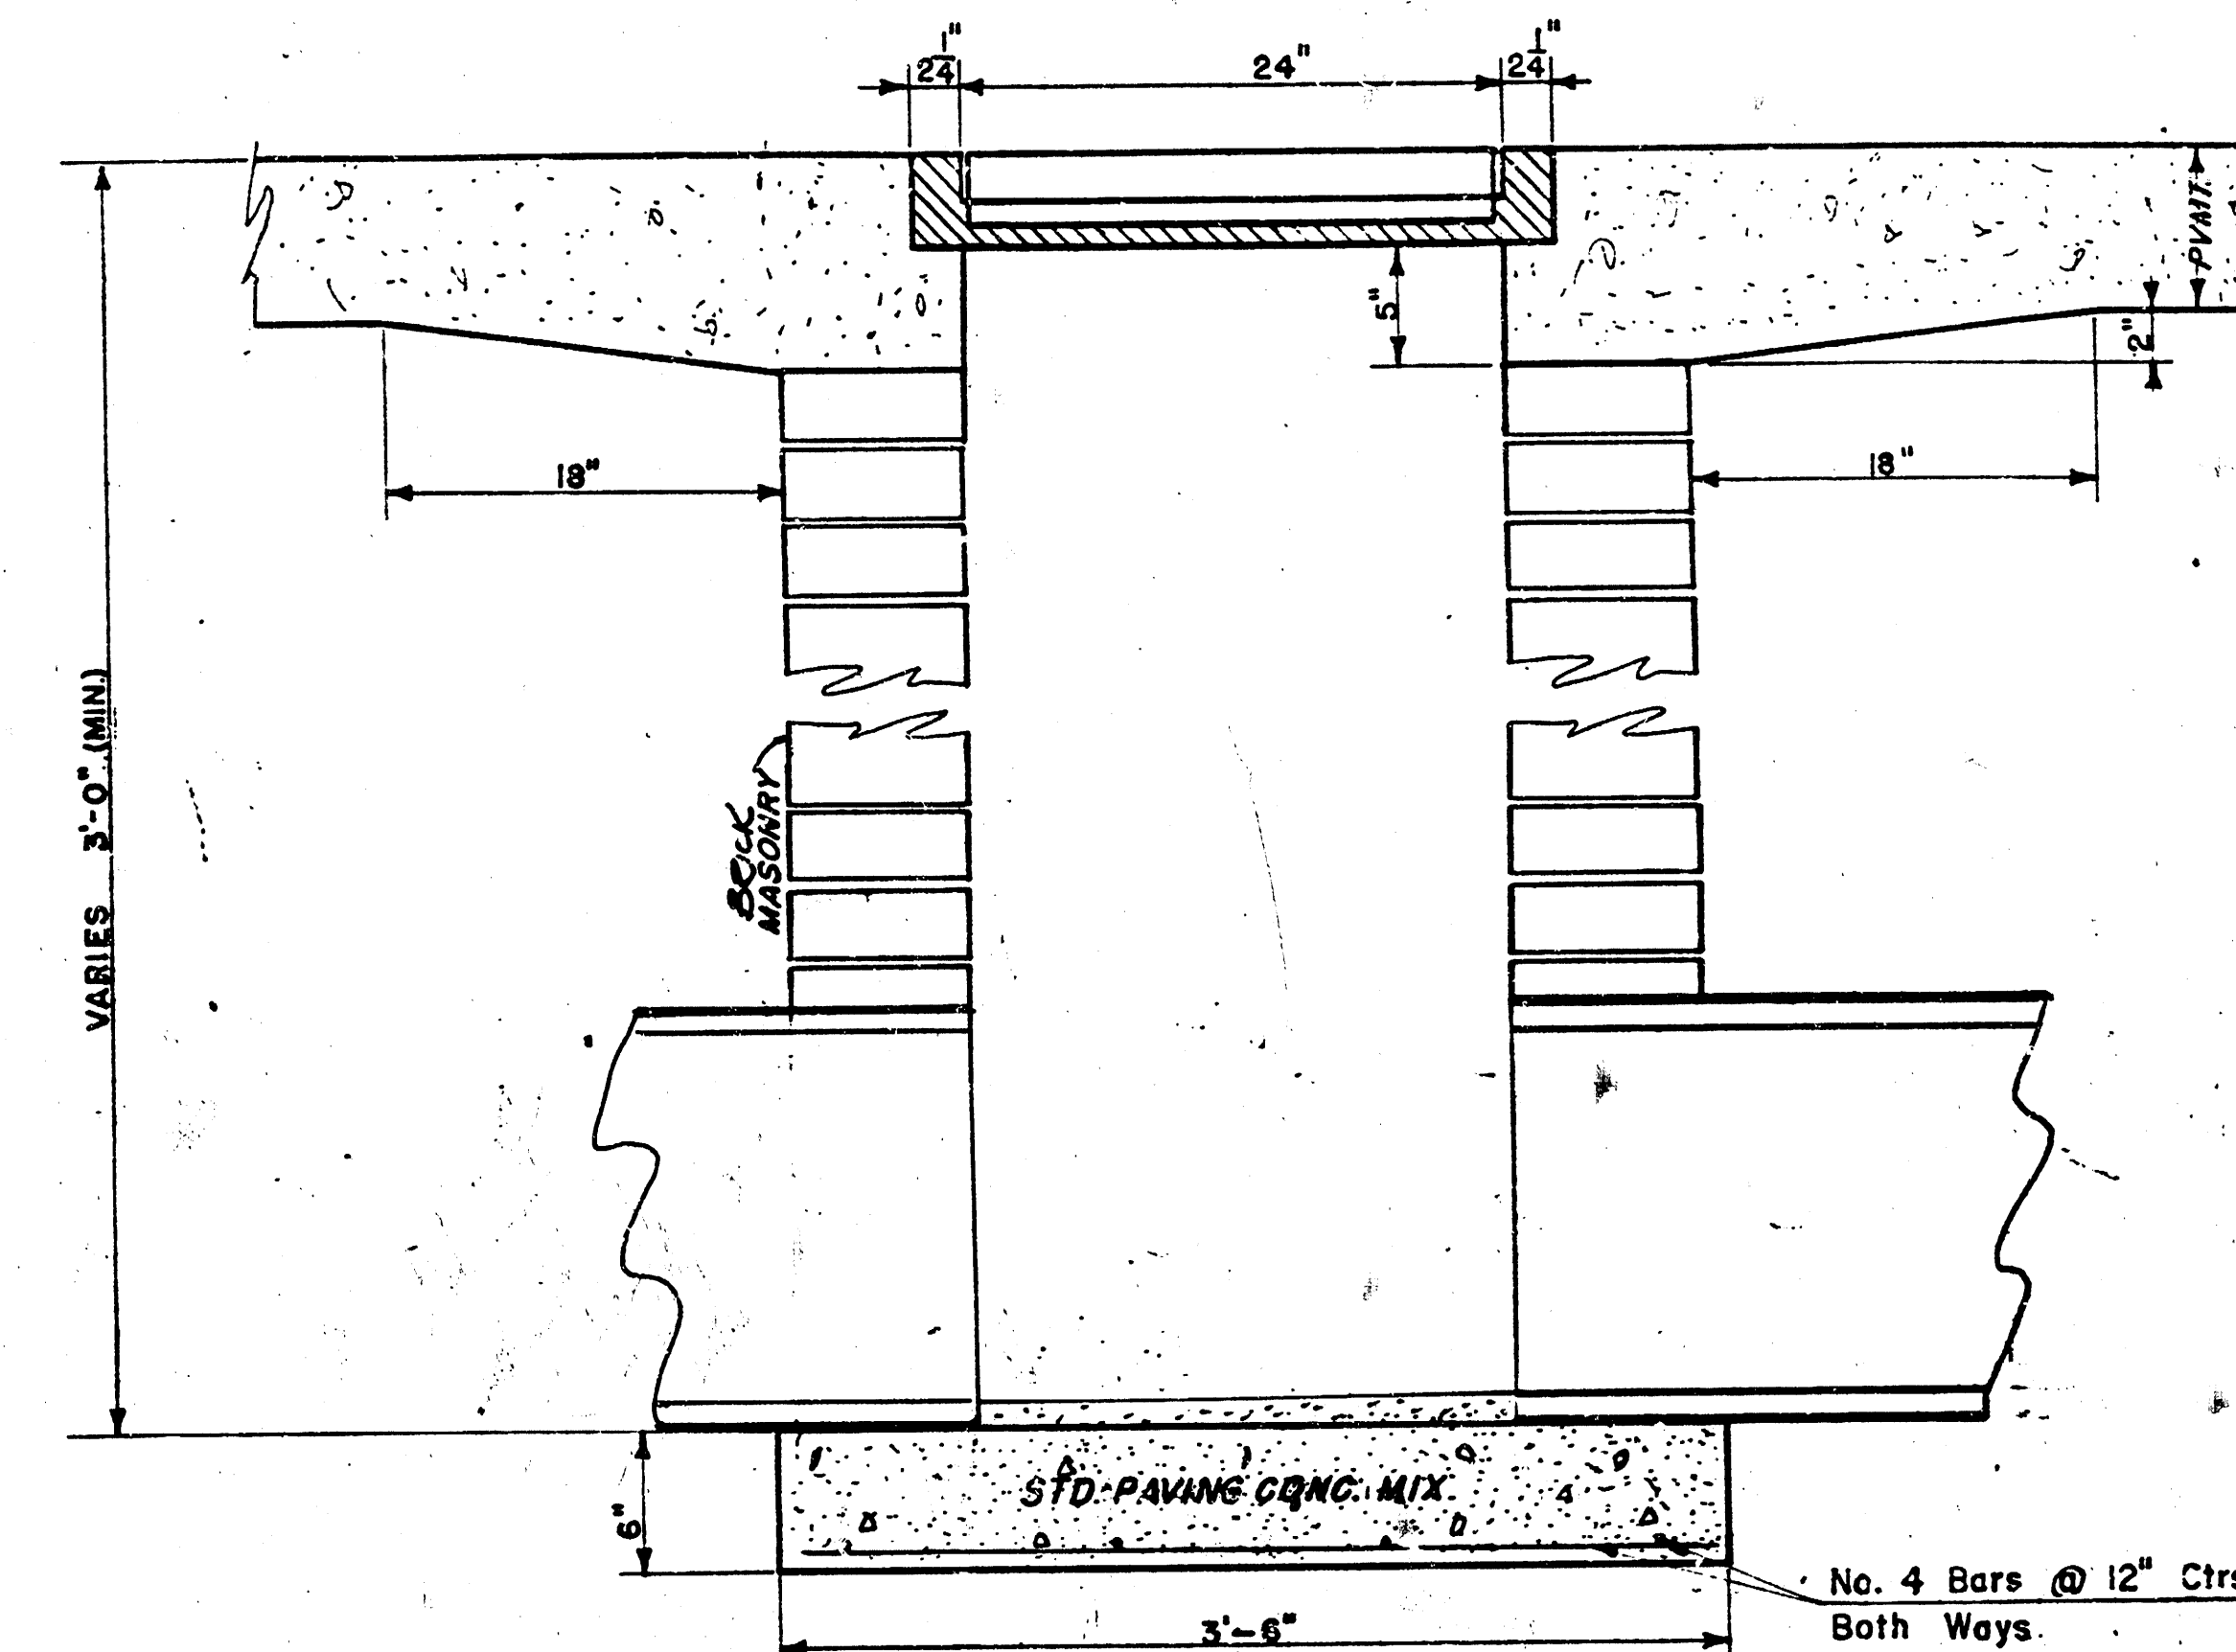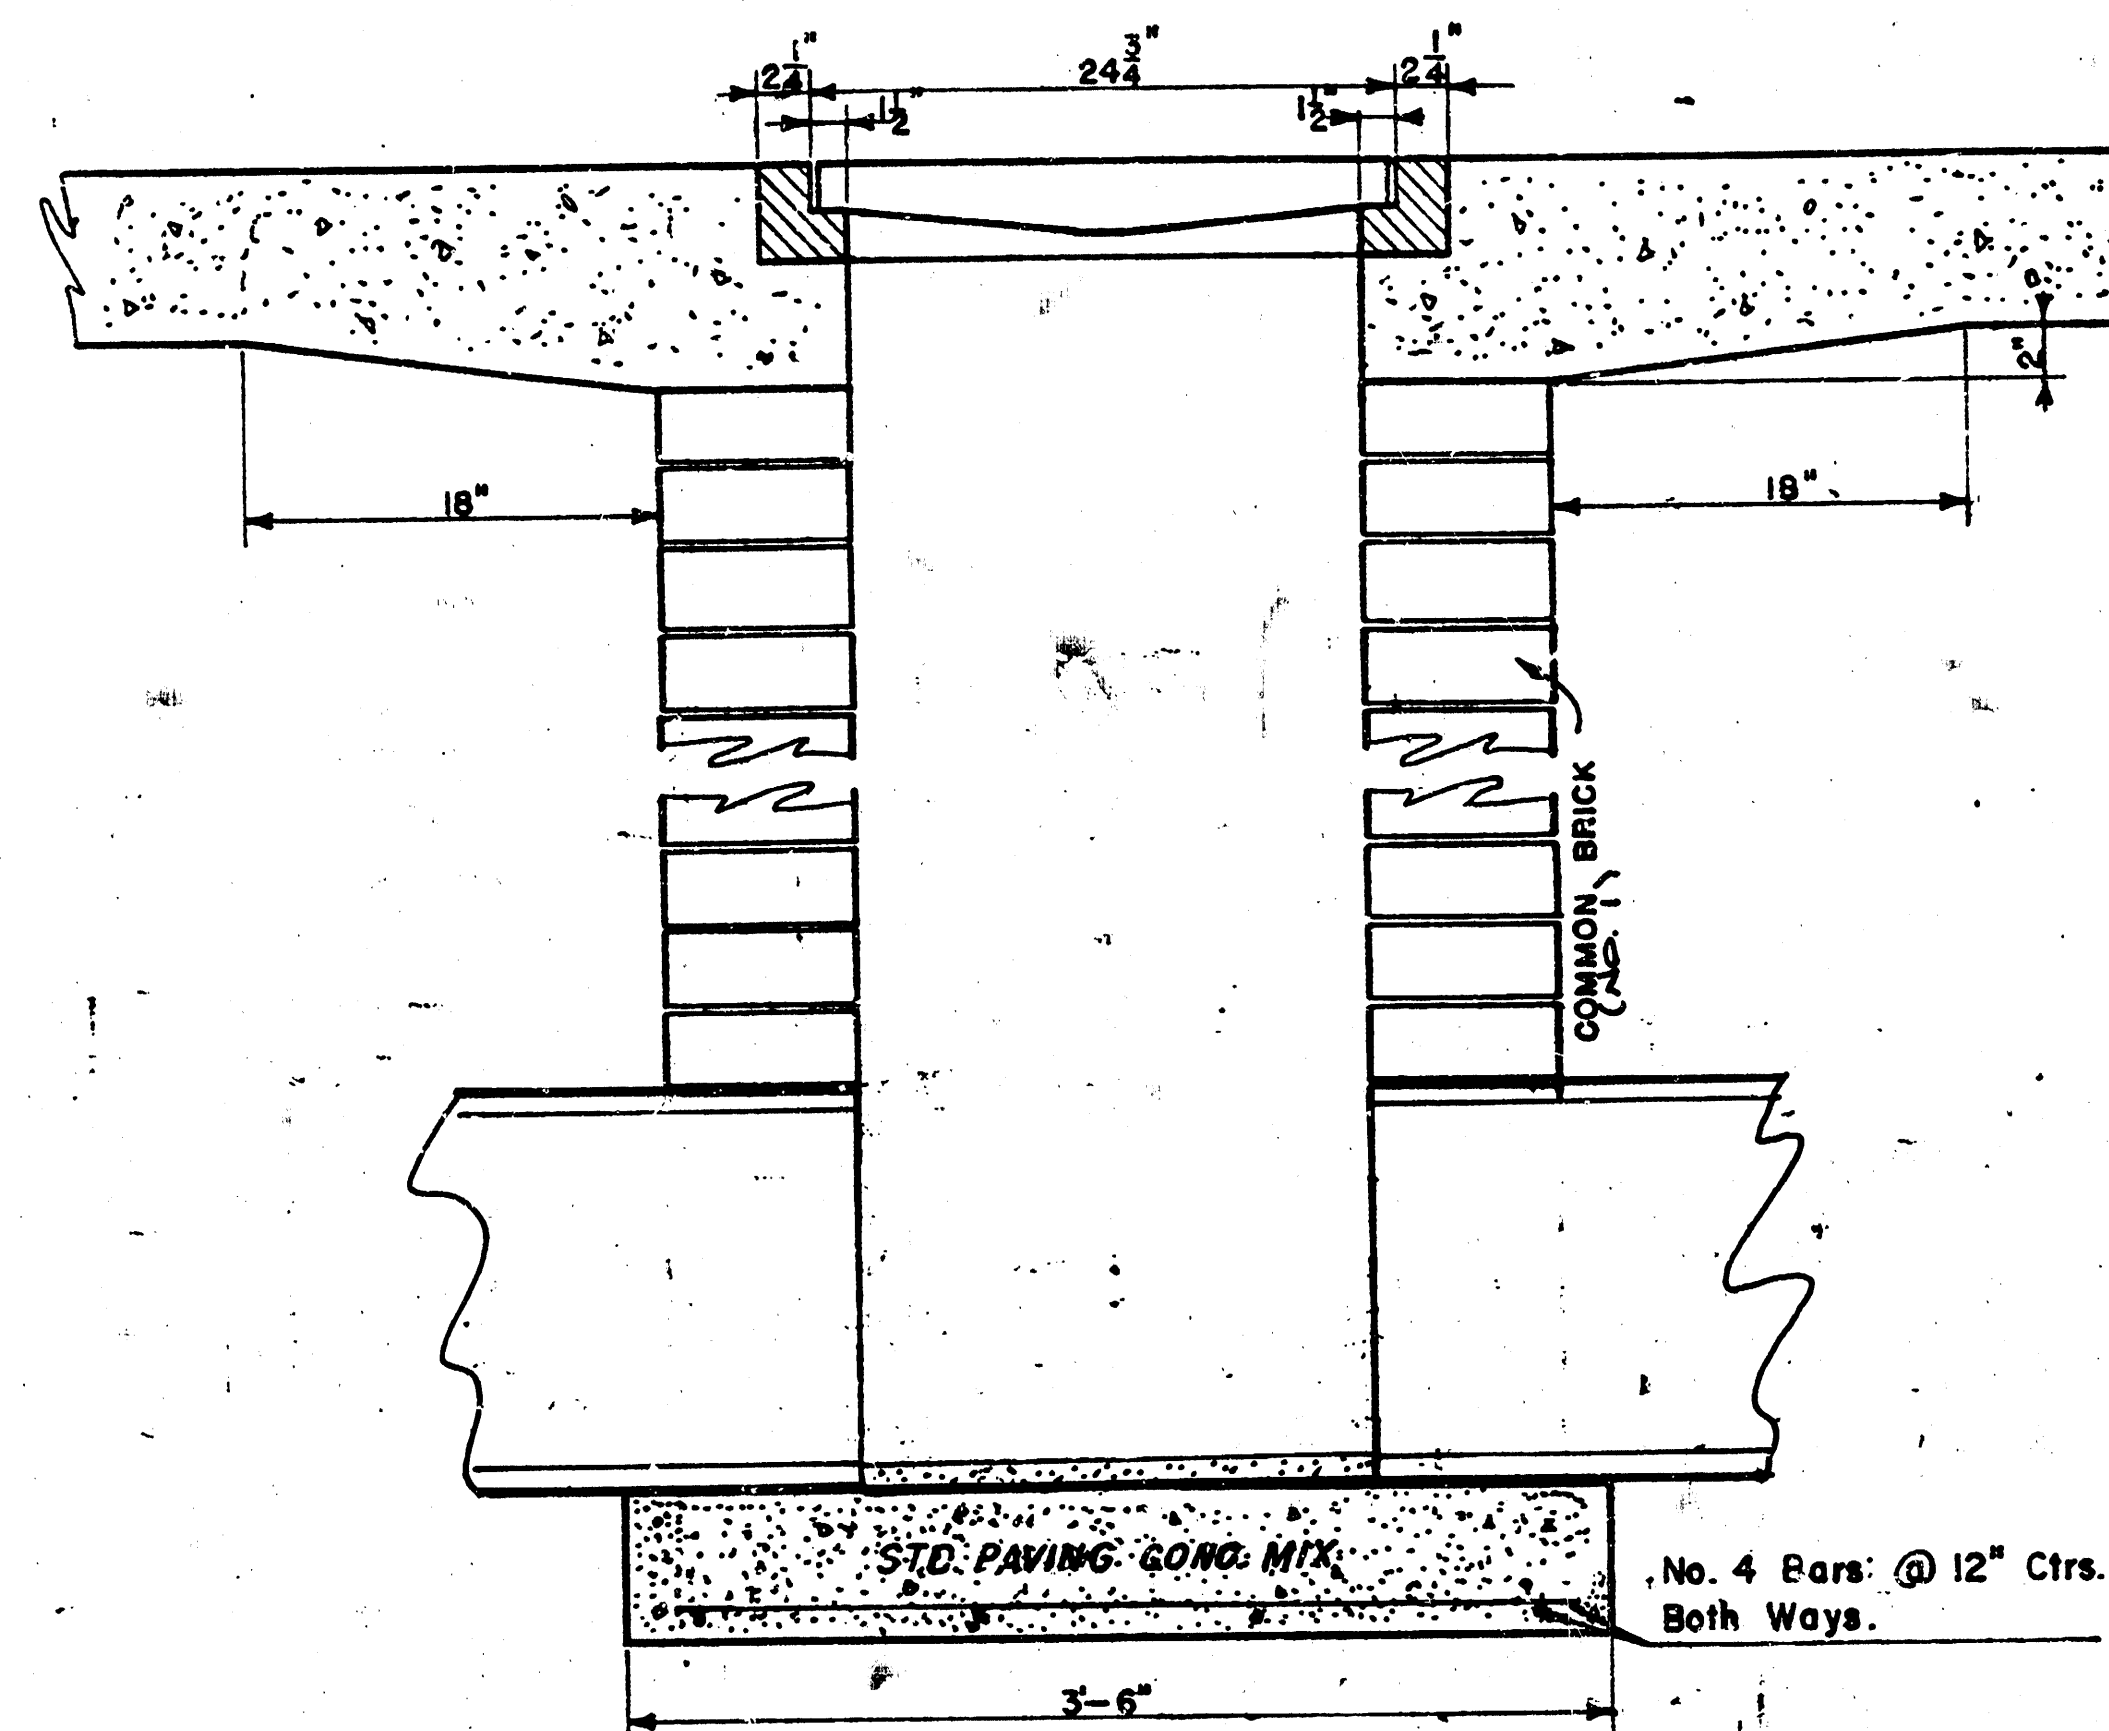

DROP INLET DETAILS

M.E. Lindebak, City Engineer
City of Wichita, Kansas
Project SWS #259
Project #468-76-245-61429-000-001
Date: APRIL 1985
Scale: 1-1/2" = 1'-0" 6/16