

CITY OF WICHITA, KANSAS
MICHAEL E. LINDEBAK, CITY ENGINEER

STORM WATER SEWER NO. 299 (GOLDEN HILLS ADDITION)

CITY OF WICHITA PROJECT NO. 468-76-245-81507-000-000-001


SURVEYED	DELMETER, FREUND & ASSOCIATES, P.A.
PLOTTED	PAUSEWANG-P.E.C.
INKED	CAD
DESIGNED	BERRY-P.E.C.

- INDEX OF SHEETS
1. TITLE SHEET
 2. LINE NO. 1-STA. 6+59 TO STA. 10+04.19
 3. LINE NO. 1-STA. 10+04.19 TO STA. 12+00
 4. LINE NO. 1-STA. 12+00 TO STA. 18+00
 5. LINE NO. 1-STA. 18+00 TO STA. 24+00
 6. LINE NO. 1-STA. 24+00 TO STA. 29+76.58
 7. AUXILIARY PROFILES
 8. STD. TYPE 1A CURB INLET (6" X 5'0" OPENING)
 9. STD. TYPE 1A CURB INLET (6" X 10'0" OPENING)
 10. STD. TYPE 1 CURB INLET (6" X 10'0" OPENING)
 11. MANHOLE FRAME & COVER
 12. CHANNEL & RIPRAP DETAILS
 13. PROJECT CONSTRUCTION SIGN
 - 14-15. CROSS-SECTIONS


PROJECT SURVEY CONTROL

VERTICAL DATUM: CITY OF WICHITA DATUM

DATUM BENCH MARK: CITY OF WICHITA STANDARD BENCH MARK DISC,
S.E. COR. CENTRAL & 11TH ST. WEST
ELEV. = 156.93

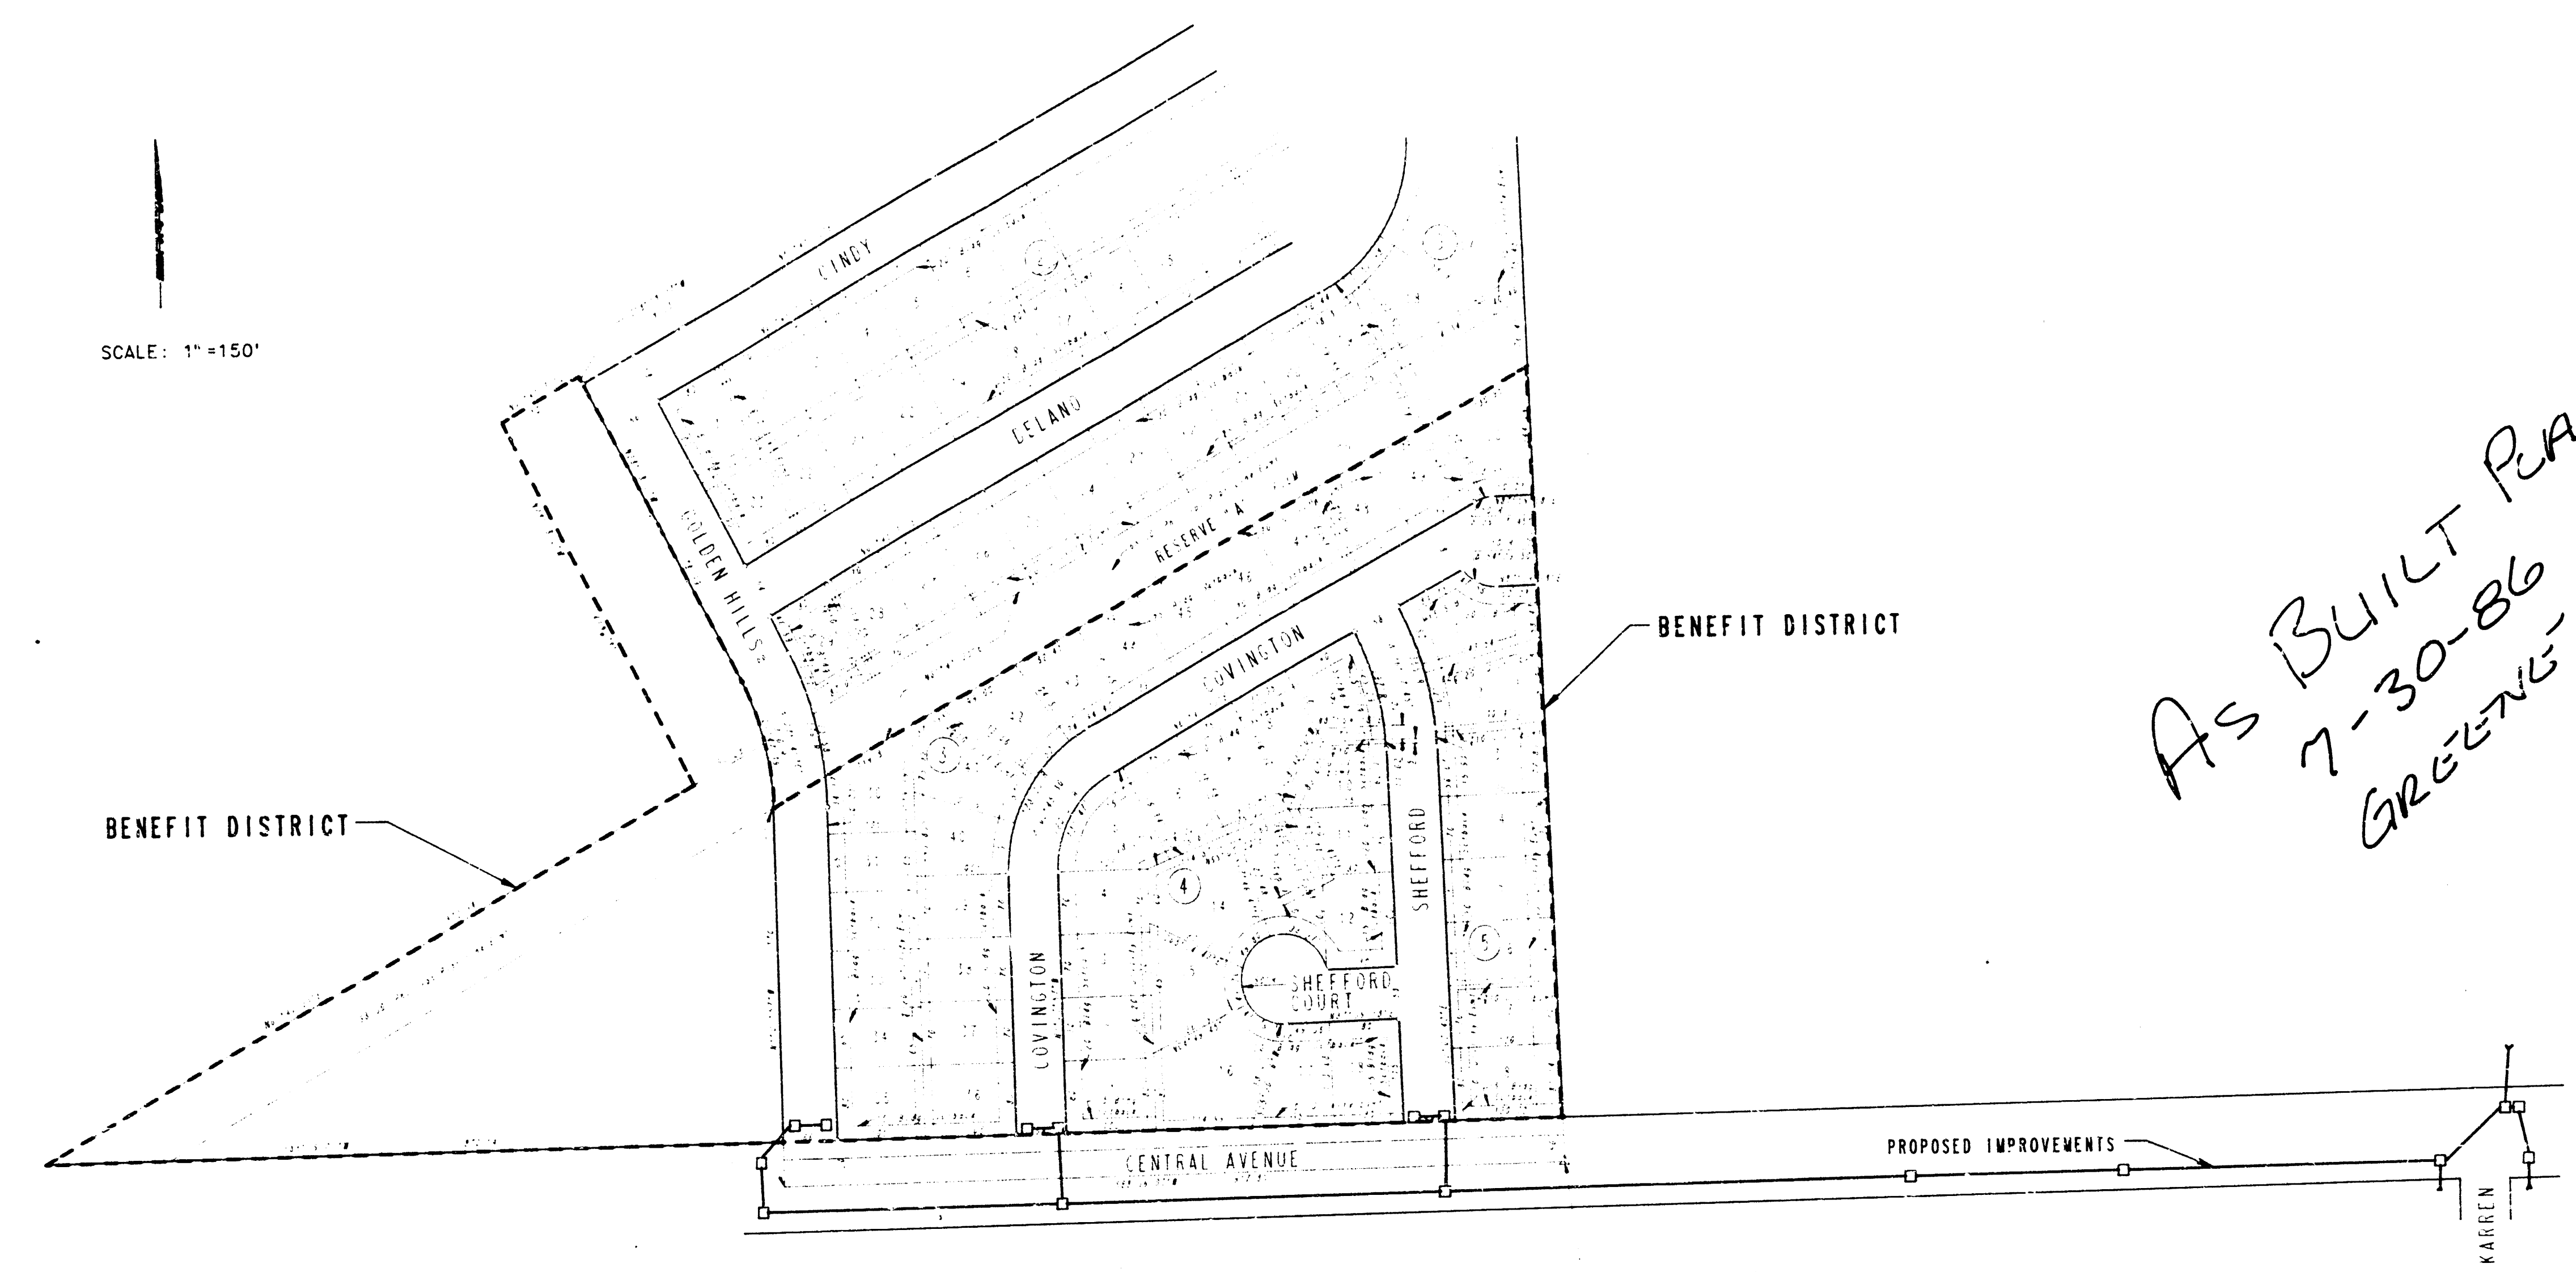

APRIL, 1986
PLANS PREPARED BY
PROFESSIONAL ENGINEERING CONSULTANTS, P.A.
ENGINEERS
WICHITA, KANSAS

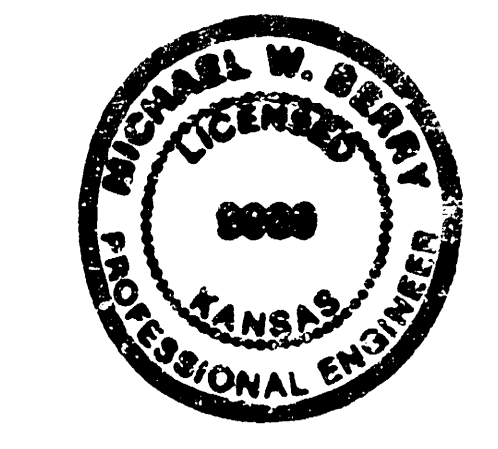

SURVEYED UNDER PROJECT NO. 472-76-245-81507-000-000-001

UTILITY SERVICE LINES, POLES, VALVE BOXES, METERS, AND ETC. ARE TO BE ADJUSTED AS NECESSARY BY OTHERS PRIOR TO OR DURING CONSTRUCTION UNLESS THE PLANS SPECIFICALLY CALL FOR THEIR ADJUSTMENT BY THE CONTRACTOR. EXISTING UTILITIES AND THEIR LOCATION, AS SHOWN ON THE PLANS, REPRESENT THE BEST INFORMATION OBTAINABLE FOR DESIGN. LOCATION INFORMATION HAS BEEN OBTAINED FROM VARIOUS UTILITY COMPANIES AND IS EITHER FROM COMPANY RECORD DRAWINGS OR COMPANY PROVIDED FIELD LOCATIONS. THE PLAN LOCATIONS SHOWN ARE NOT GUARANTEED. ADDITIONAL EXISTING UTILITIES MAY ALSO BE ENCOUNTERED. THE CONTRACTOR WILL BE REQUIRED TO WORK AROUND EXISTING UTILITIES WITHIN THE RIGHT-OF-WAY WHICH DO NOT CONFLICT WITH PROPOSED CONSTRUCTION.

THE CONTRACTOR SHALL NOTIFY K. G. & E. AND/OR SOUTHWESTERN BELL AT LEAST 24 HOURS IN ADVANCE OF COMMENCEMENT OF WORK ADJACENT TO ANY OF THEIR UNDERGROUND FACILITIES.

PRIOR TO COMMENCING WORK, THE CONTRACTOR SHALL UNEARTH THE EXISTING TELEPHONE CONDUIT(S) AT LINE NO. 1 STA. 0+15, LINE NO. 1A STA. 0+20, LINE NO. 1C STA. 0+45, LINE NO. 1D STA. 0+45, AND LINE NO. 1E STA. 0+42 TO VERIFY THE ELEVATION OF THE CONDUIT(S) AT EACH LOCATION. IF THE ACTUAL ELEVATION VARIES BY MORE THAN 0.5 FOOT, THE CONTRACTOR SHALL NOTIFY THE ENGINEER TO DETERMINE IF ADJUSTMENTS IN LOCATION OR ELEVATION OF THE PROPOSED IMPROVEMENTS WILL BE REQUIRED TO AVOID CONFLICT WITH THE TELEPHONE CONDUIT(S). ANY ALIGNMENT RELOCATION(S) IN PLAN OR PROFILE DIRECTED BY THE ENGINEER TO AVOID CONFLICT WITH THE TELEPHONE CONDUIT(S) SHALL BE PERFORMED AT NO ADDITIONAL COST.

ALL DISTURBED AREAS WITHIN THE PERMANENT DRAINAGE EASEMENT AT CENTRAL AVENUE STA 36+14 SHALL BE SEEDED, FERTILIZED AND MULCHED IN ACCORDANCE WITH CITY OF WICHITA STANDARD SPECIFICATIONS.

MATERIALS FOR ALL RIPRAP FOR THIS PROJECT SHALL BE NATURAL STONE CONFORMING TO THE REQUIREMENTS OF THE CITY OF WICHITA STANDARD SPECIFICATIONS. GROUTING OF STONE RIPRAP SHALL NOT BE PERFORMED. WITHIN THE BROKEN CONCRETE, FABRIC ENVELOPE, NOR THE PRE-MIXED DRY PACKAGED CONCRETE BAG ALTERNATES WILL BE ALLOWED.

EXCESS EXCAVATED MATERIAL FROM CHANNEL AND/OR STORM SEWER EXCAVATION SHALL BE STOCKPILED AT LOCATIONS WITHIN THE CENTRAL AVENUE RIGHT-OF-WAY OR TEMPORARY EASEMENTS AS DESIGNATED BY THE ENGINEER TO BE USED IN CONSTRUCTION OF THE STREET IMPROVEMENTS.

RUBBLE FROM THE REMOVAL OF MISCELLANEOUS STRUCTURES AND PAVEMENT REMOVAL WHICH IS TO BE WASTED SHALL BE DISPOSED ON SITES TO BE PROVIDED BY THE CONTRACTOR. THESE SITES SHALL BE APPROVED BY THE ENGINEER AS TO SUITABILITY, APPEARANCE, AND SITE LOCATION. THE CONTRACTOR SHALL, IN THE OPINION OF THE ENGINEER, WILL LEAVE AN UNSIGHTLY APPEARANCE WILL NOT BE APPROVED.

ALL ENTRANCE AND CROSS ROAD PIPE CONFLICTING WITH CONSTRUCTION SHALL BE REMOVED BY THE CONTRACTOR AND AS OTHERWISE NOTED ON THE PLANS. REMOVAL OF SUCH PIPES SHALL CONFORM TO THE APPLICABLE SECTION OF THE STANDARD SPECIFICATIONS. SUCH PIPE SHALL BE REPLACED WHERE NECESSARY TO MAINTAIN DRAINAGE.

THE CONTRACTOR SHALL BE RESPONSIBLE FOR PRESERVING PROPERTY IRONS. THE CONTRACTOR WILL BE REQUIRED TO RE-ESTABLISH ANY PROPERTY IRONS WHICH ARE DAMAGED OR DESTROYED BY HIS CONSTRUCTION OPERATIONS. SUCH IRONS SHALL BE RE-ESTABLISHED BY A LICENSED LAND SURVEYOR OR A LICENSED PROFESSIONAL ENGINEER IN ACCORDANCE WITH STATE LAWS.

TREES AND SHRUBS IN PUBLIC RIGHT-OF-WAY OR EASEMENTS WHICH ARE IN DIRECT CONFLICT WITH PROPOSED NEW CONSTRUCTION SHALL BE REMOVED AND DISPOSED OF BY THE CONTRACTOR WITH THE ENGINEER'S APPROVAL. TREES AND SHRUBS WHICH ARE NOT IN CONFLICT WITH PROPOSED NEW CONSTRUCTION SHALL BE SAVED AND PROTECTED FROM DAMAGE.

THE STORM WATER SEWER CONTRACTOR SHALL SO SCHEDULE THIS WORK SO AS TO MAINTAIN A MEANS OF ACCESS FOR LOCAL TRAFFIC AT ALL TIMES TO GOLDEN HILLS ON THE NORTH AND KARREN LANE TO THE SOUTH, AS WELL AS TO RESIDENCES AT 1506 W. CENTRAL AND AT THE SE CORNER OF KARREN AND CENTRAL. ALSO, ACCESS SHALL BE PROVIDED AT EITHER COVINGTON (N) OR SHEFFORD AT ALL TIMES.

CONSTRUCTION TRAFFIC CONTROL DEVICES, INCLUDING SIGNS, BARRICADES AND/OR CHANNELIZING DEVICES, SHALL BE MAINTAINED BY THE CONTRACTOR ADJACENT TO HIS WORK AREA(S) IN ACCORDANCE WITH THE WICHITA BARRICADE MANUAL.

UTILITIES

KANSAS GAS & ELECTRIC
1900 E. CENTRAL - 67214
DON MORGAN - 261-6434

SOUTHWESTERN BELL TELEPHONE
154 W. BROADWAY 67202
BOB ALLEY - 268-2245


WICHITA WATER DEPARTMENT
455 W. MAIN - 67202
F. E. WITHER, JR. - 268-4217

WICHITA SEWER MAINT. DIV.
455 W. MAIN - 67202
DARRELL BREWER - 268-4210

MULTIMEDIA CABLEVISION
701 E. DOUGLAS - 67202
DON SHUE - 269-2336

KPL GAS SERVICE
1021 E. 26TH ST. NO. 67219
JAMES SHIMP - 263-7511

ARKLA GAS CO.
1630 S. BAHR - 67209
JERRY WATKINS - 942-8350


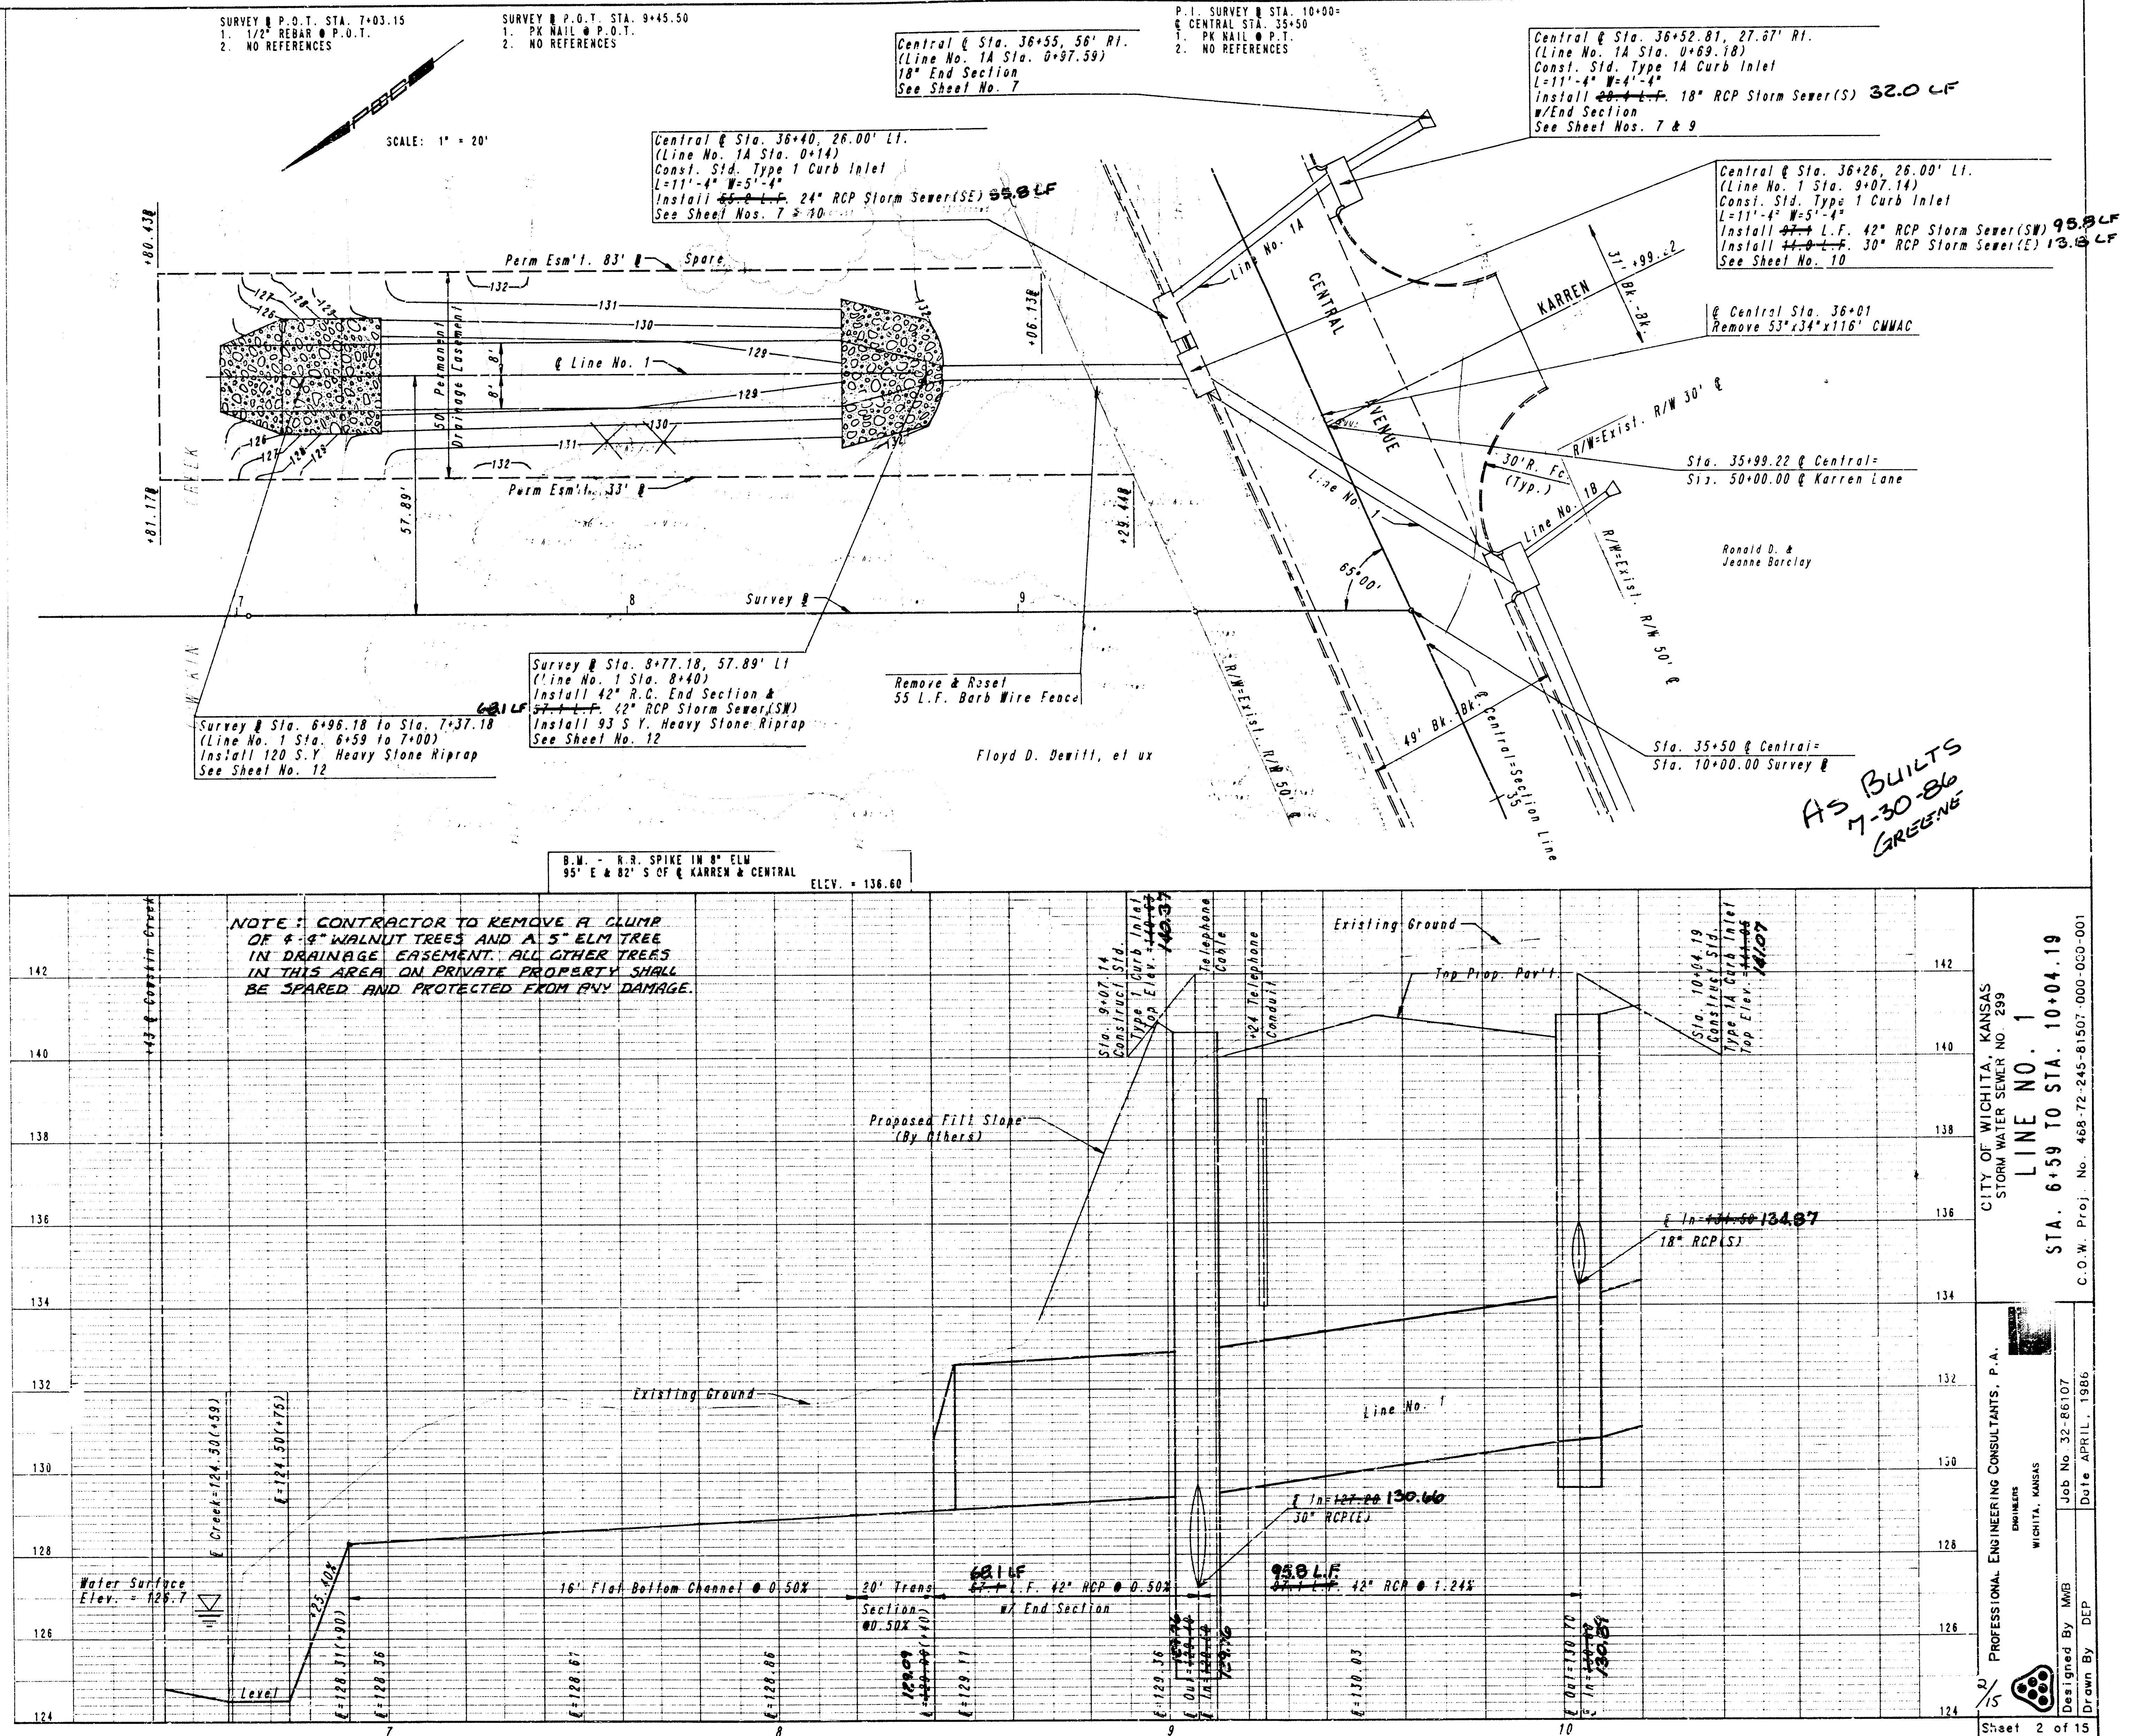



AS BUILTS
7-30-86
GREENE

NOTE: CONTRACTOR TO REMOVE A CLUMP OF 4-6" WALNUT TREES AND A 5" ELM TREE IN DRAINAGE EASEMENT. ALL OTHER TREES IN THIS AREA ON PRIVATE PROPERTY SHALL BE SAVED AND PROTECTED FROM ANY DAMAGE.










CITY OF WICHITA, KANSAS
STORM WATER SEWER NO. 239
LINE NO. 1
STA. 6+59 TO STA. 10+04.19
C.O.W. Proj. No. 488-72-245-81507-000-000-001

PROFESSIONAL ENGINEERING CONSULTANTS, P.A.
DESIGNERS
WICHITA, KANSAS
Job No. 32-86107
Designed By: MMB
Drawn By: DEP
Date: APRIL, 1986
Sheet 2 of 15

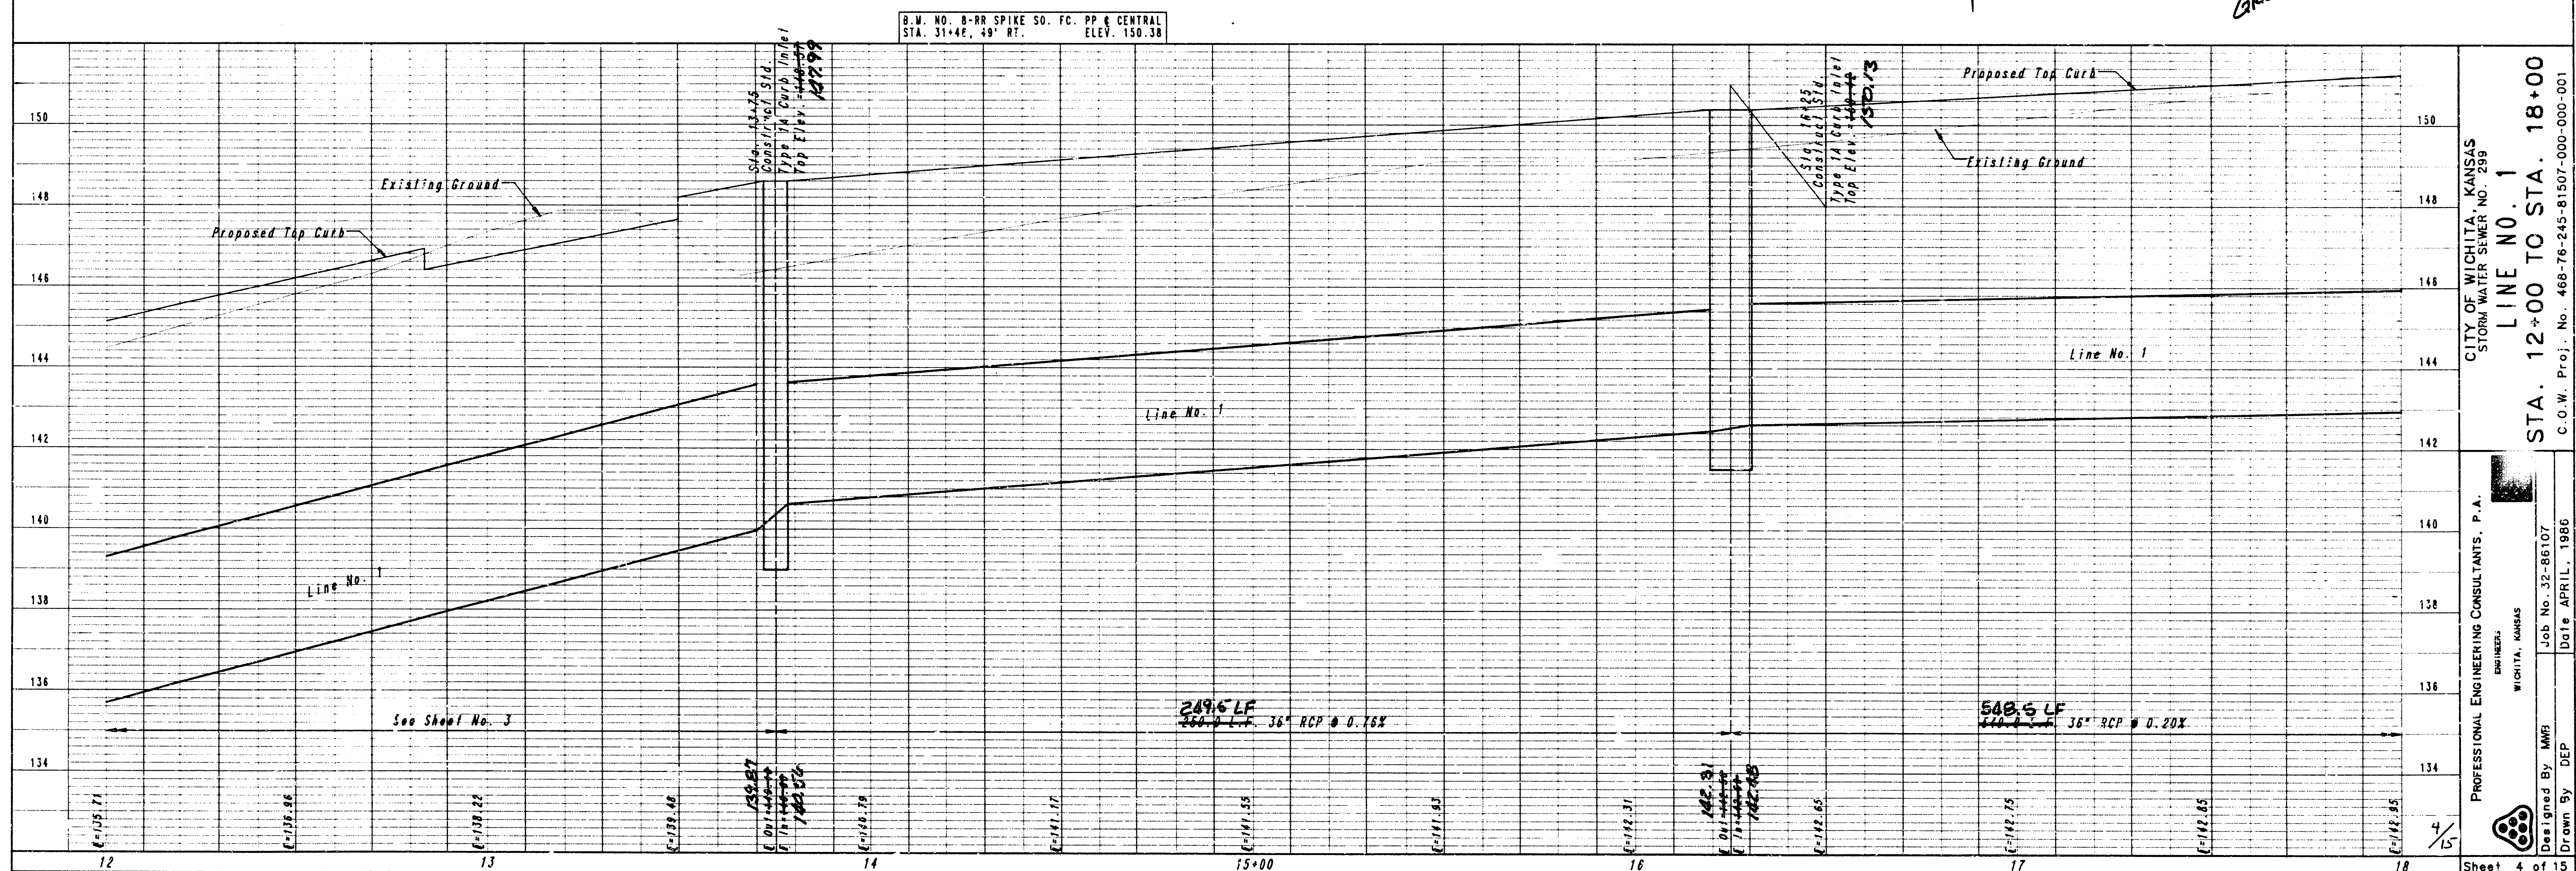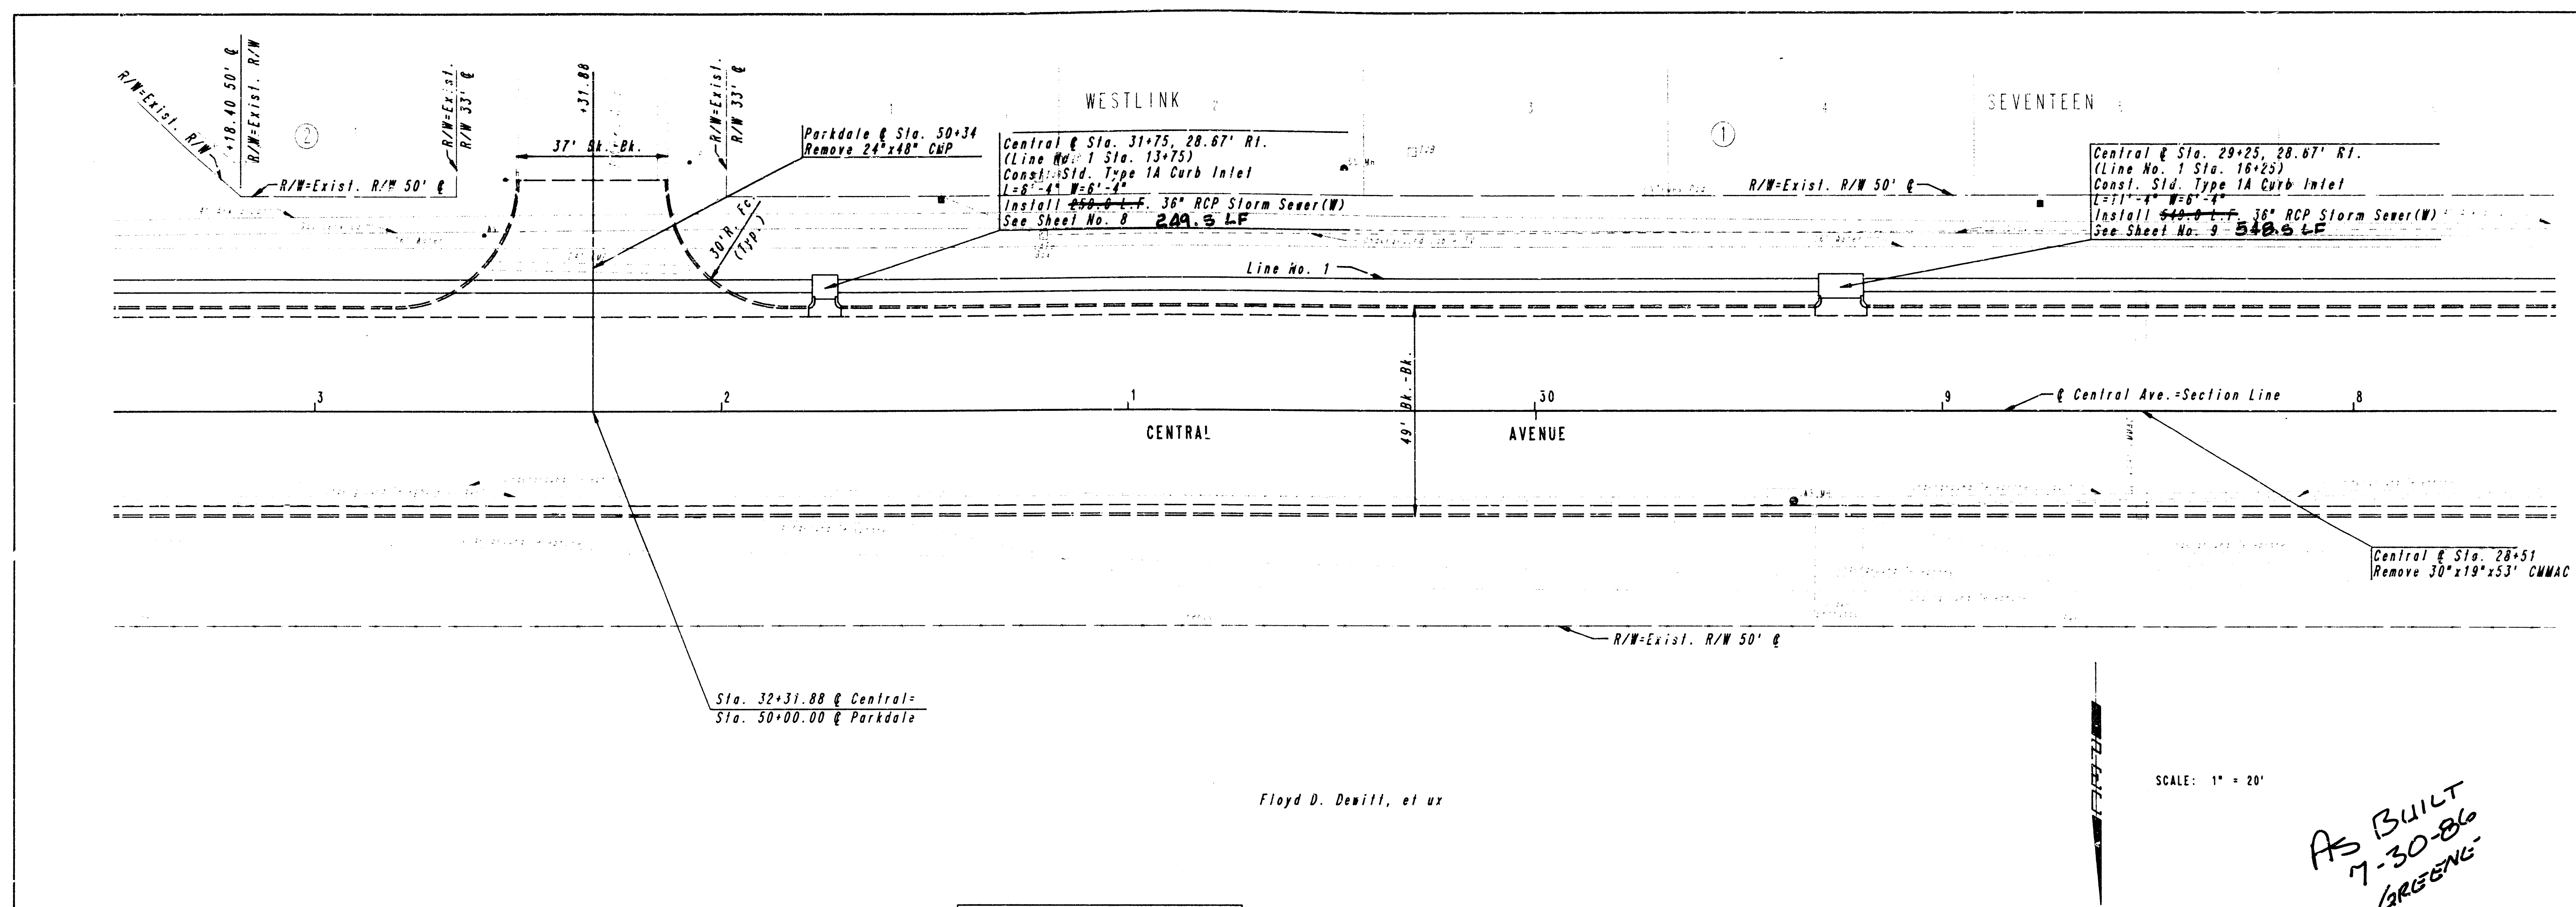

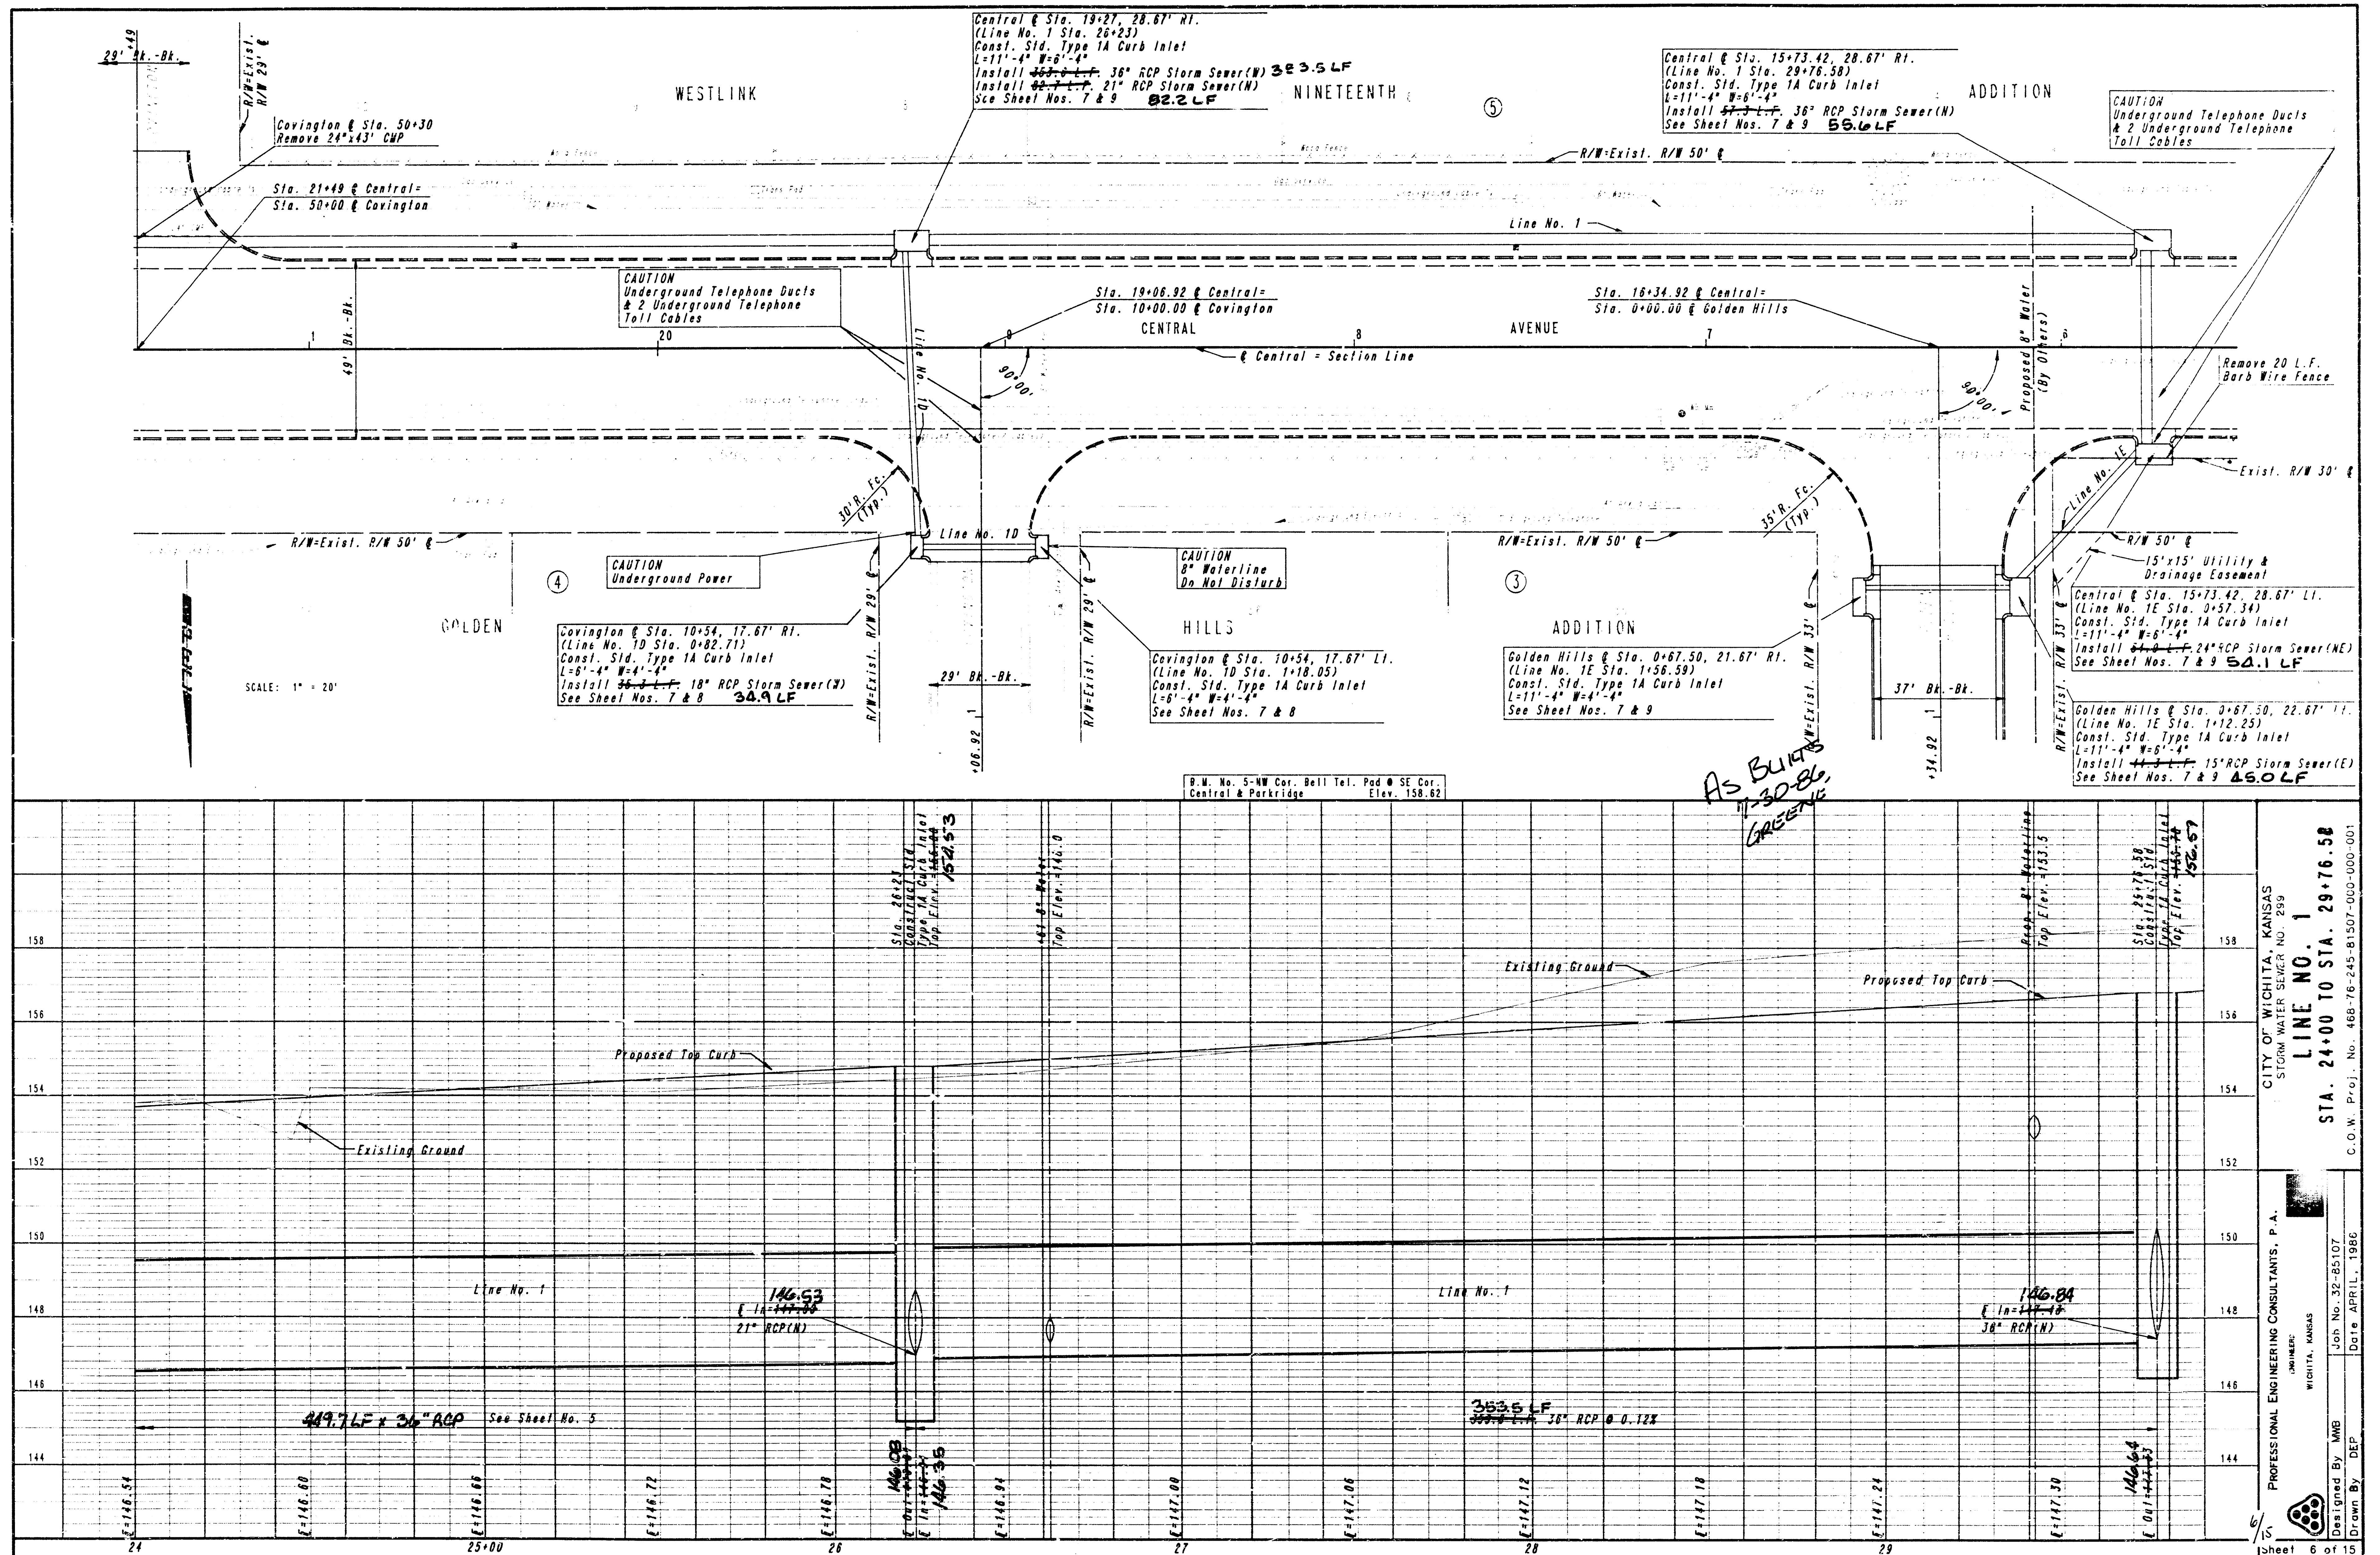

PROJECT NO.	SHEET NO.	TOTAL SHEETS
488-76-245-B1507-000-001	9	15

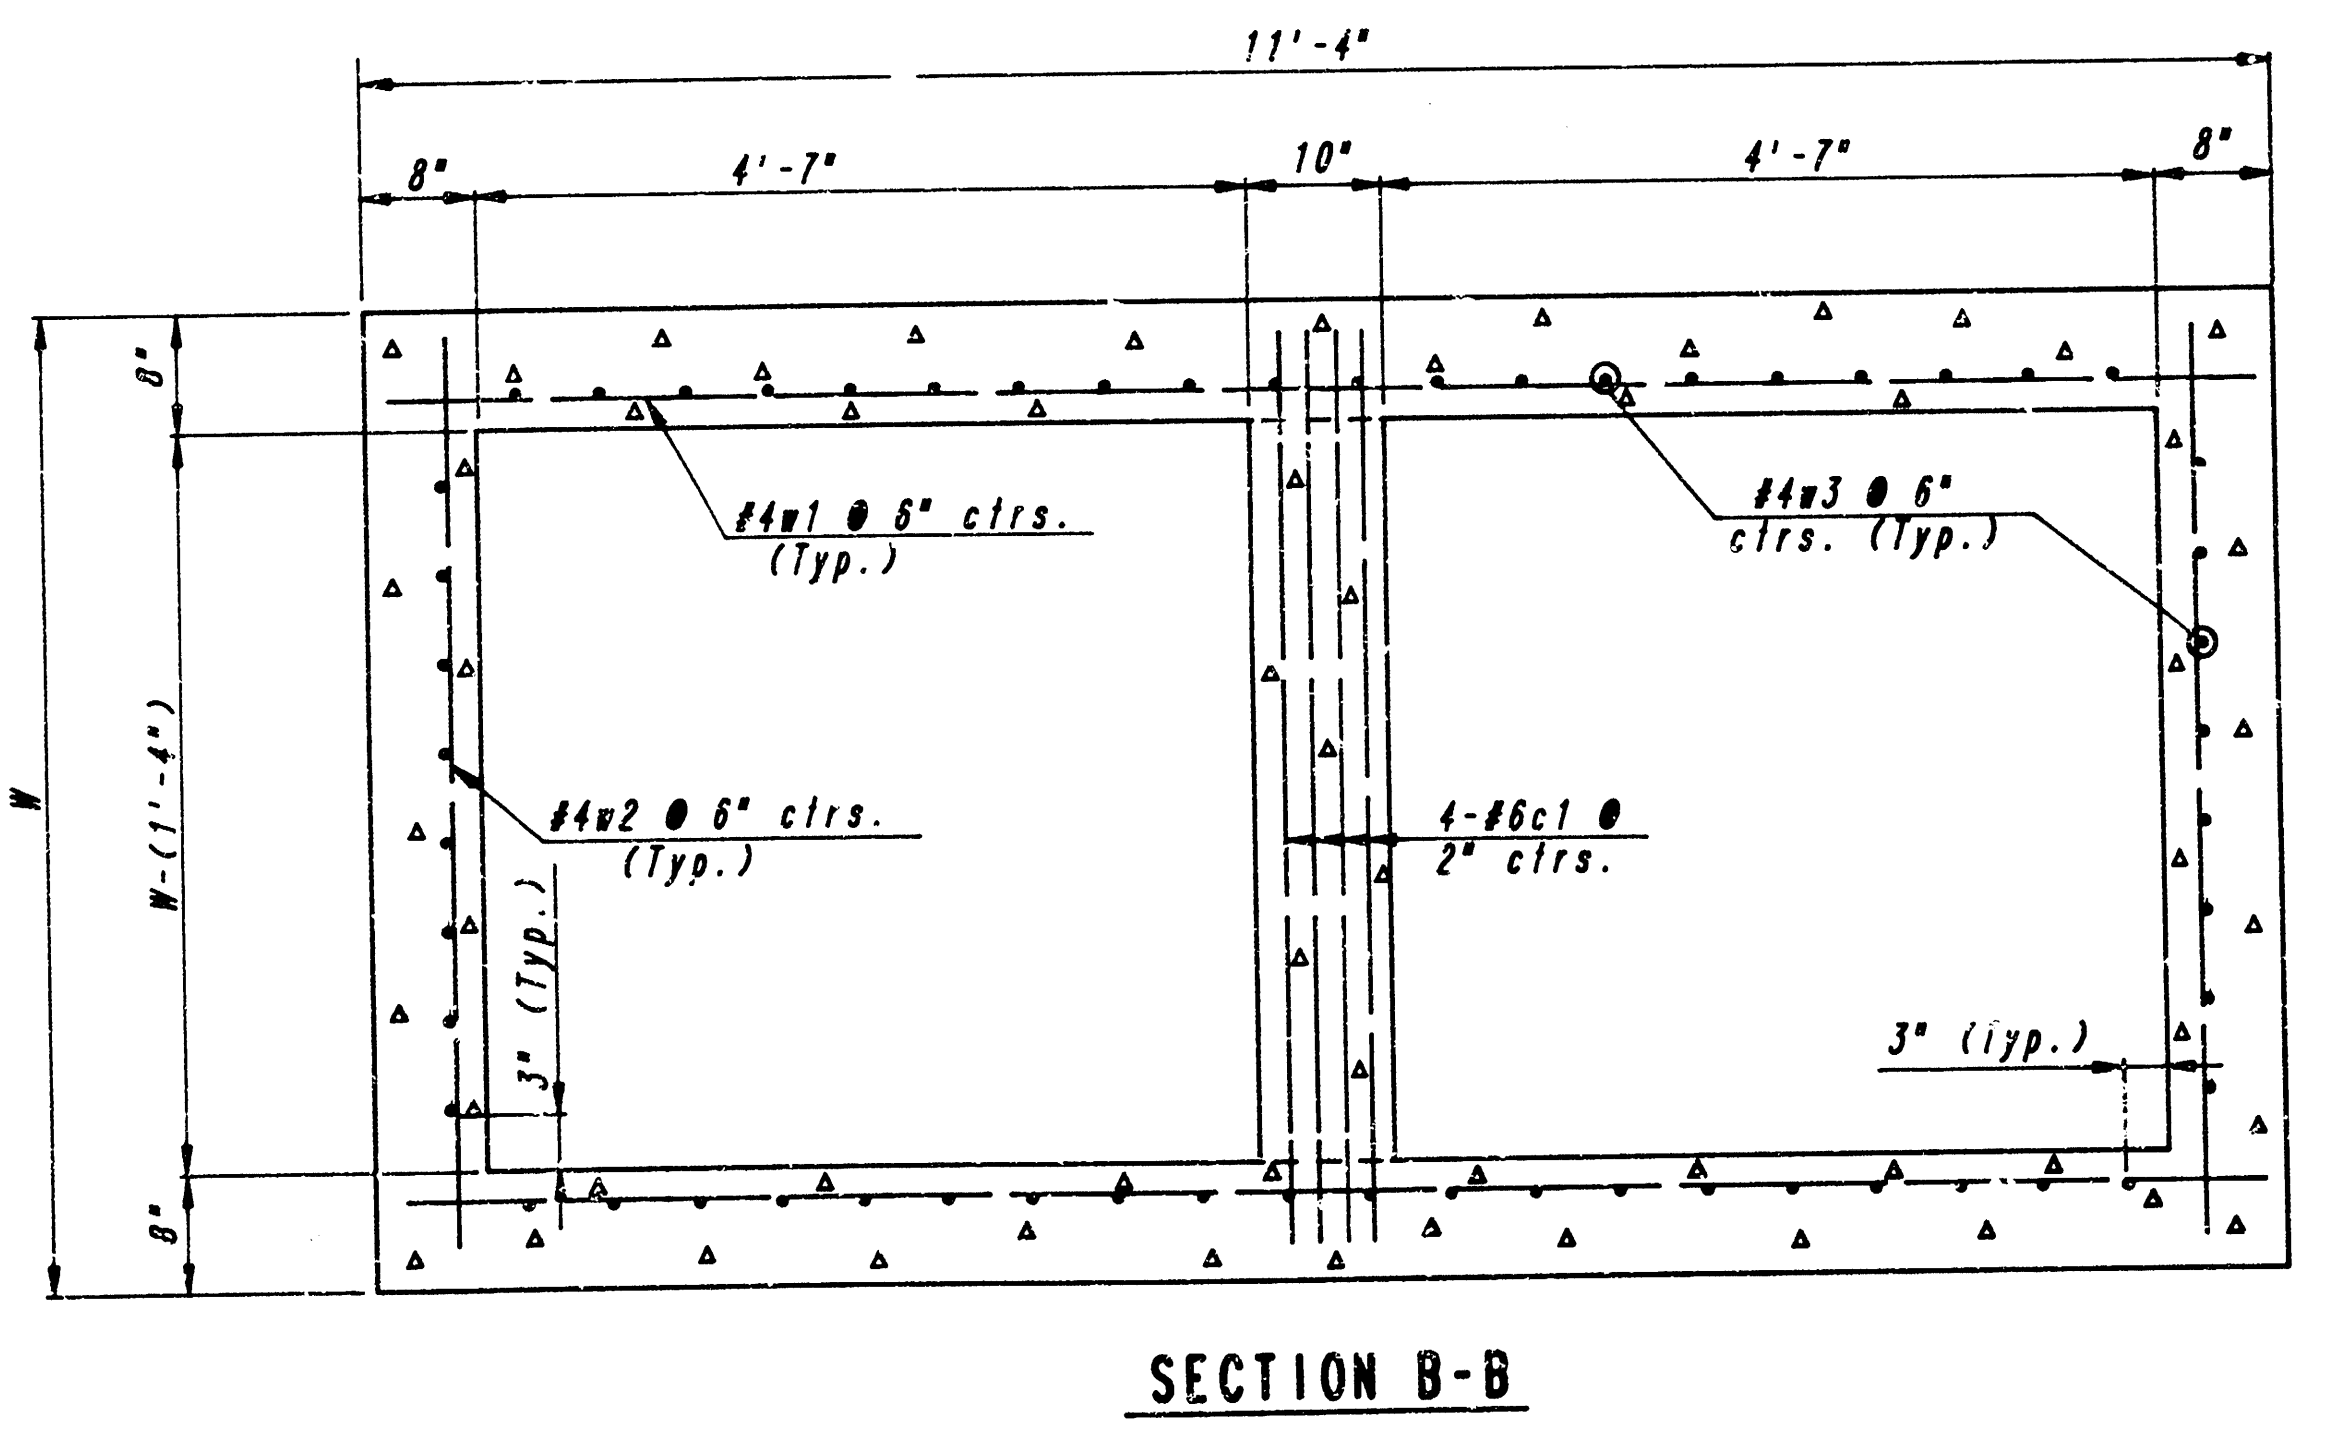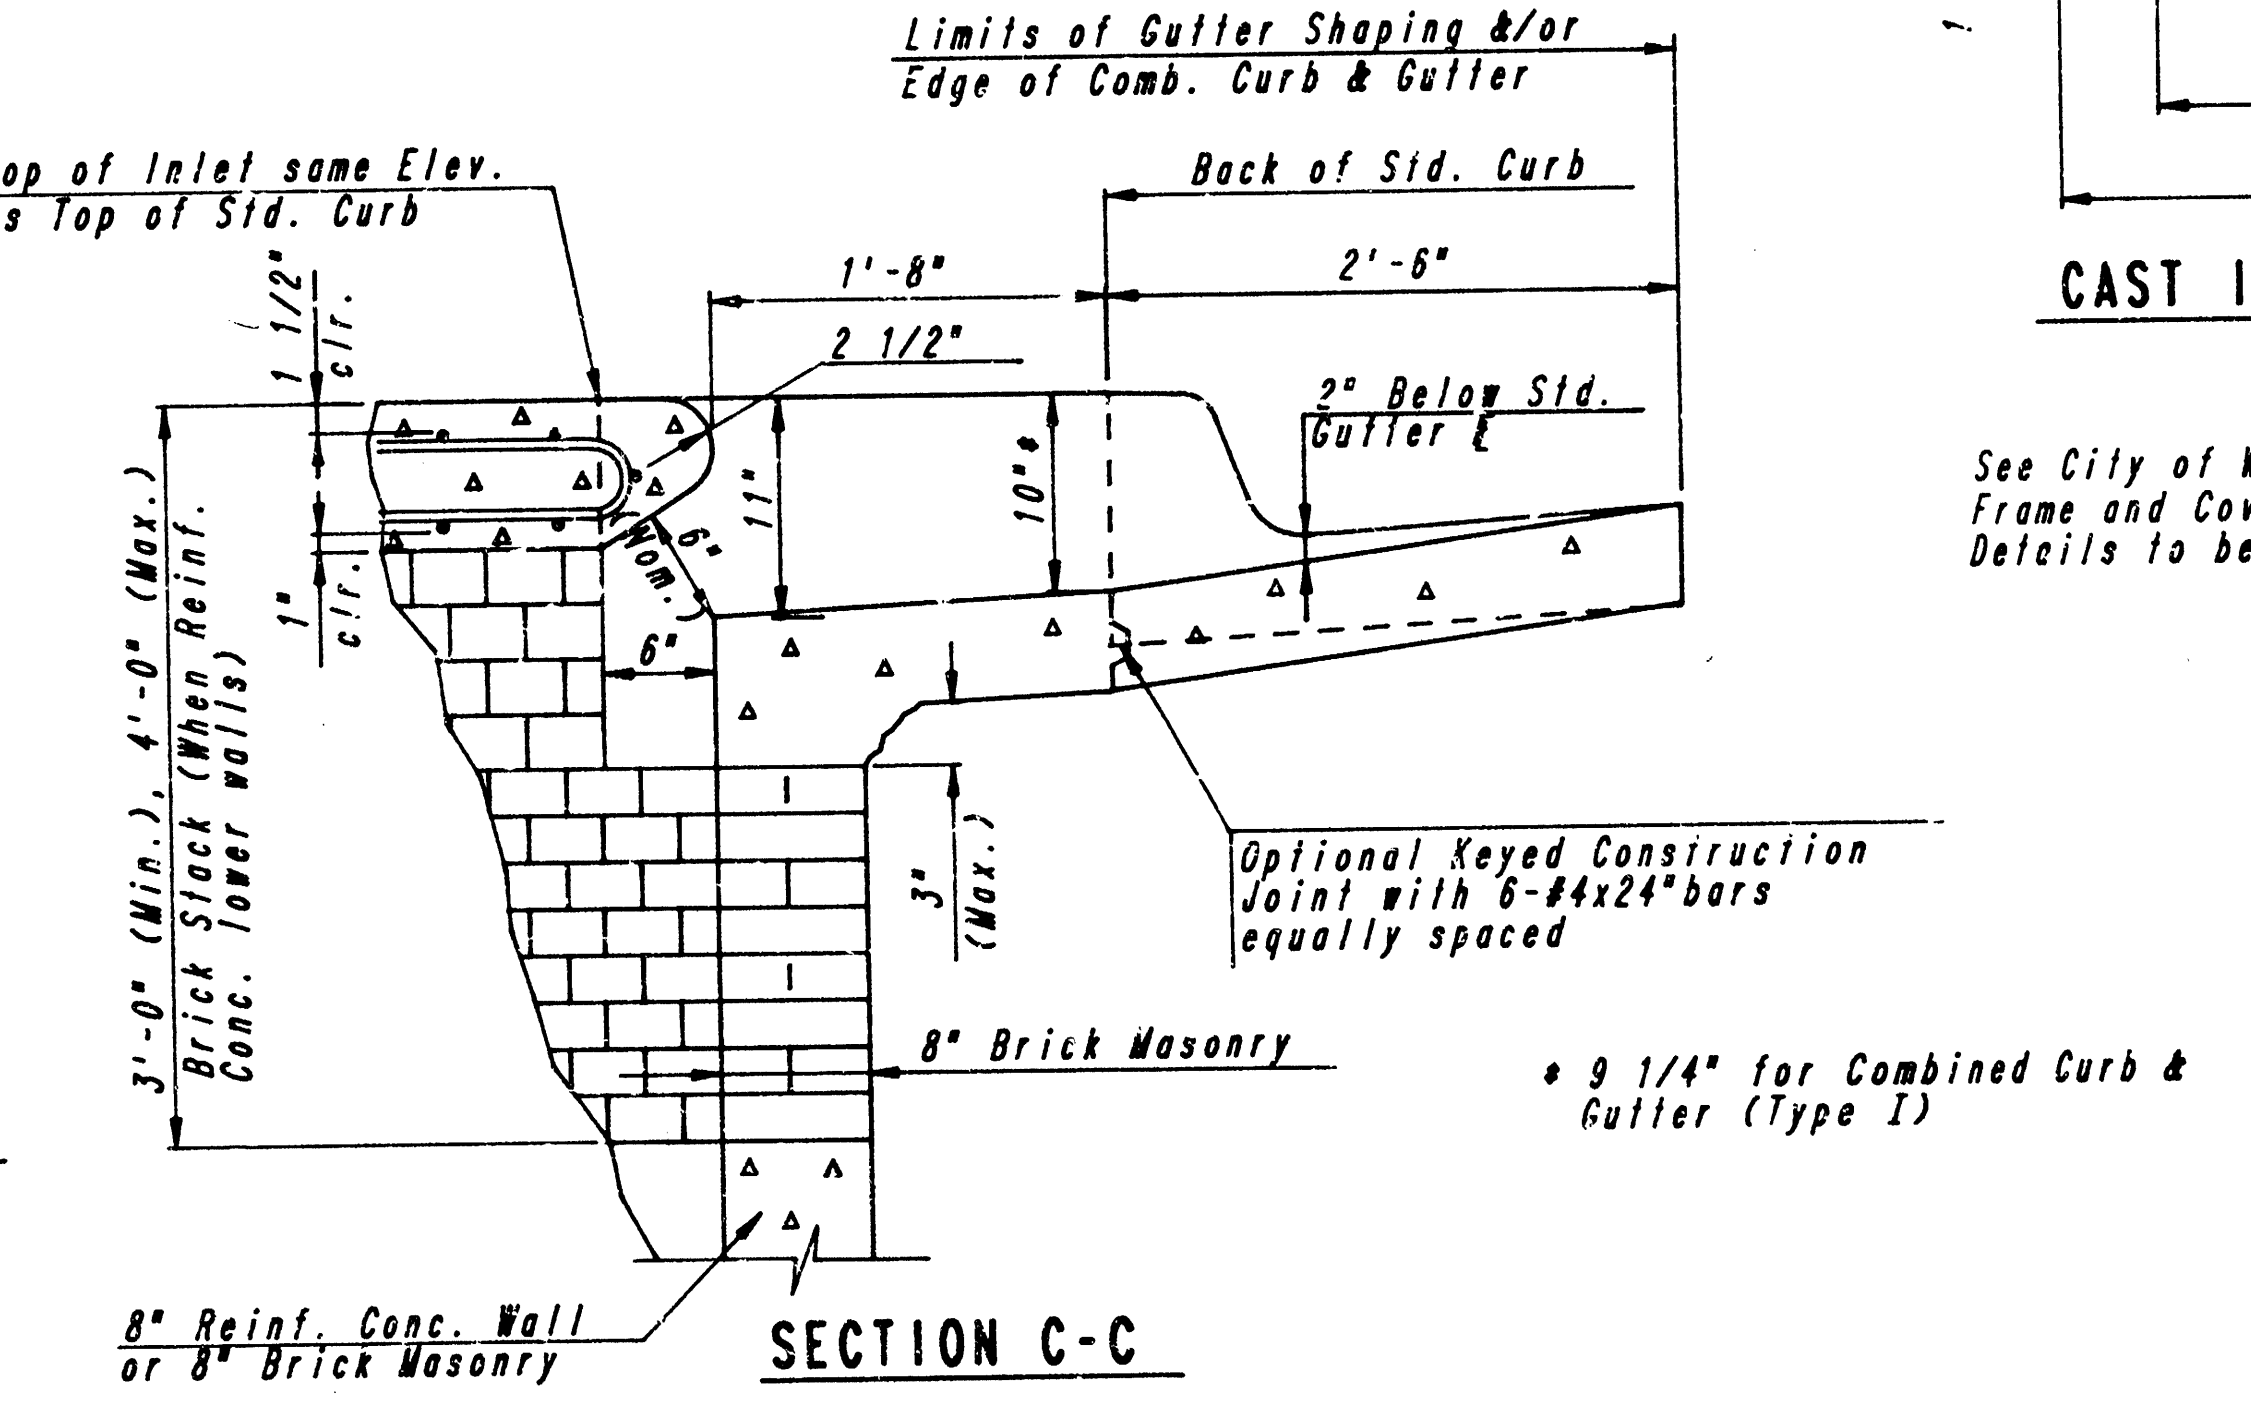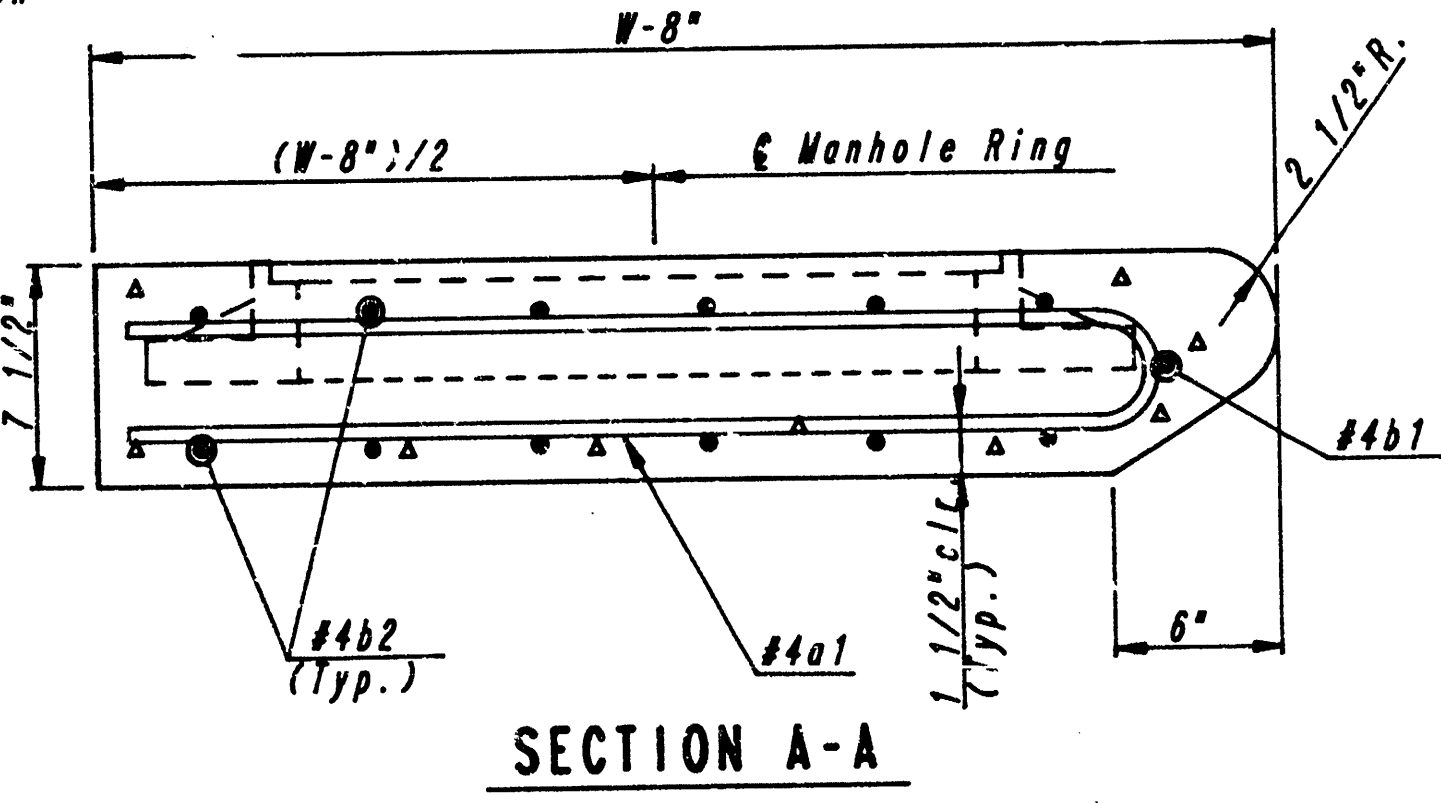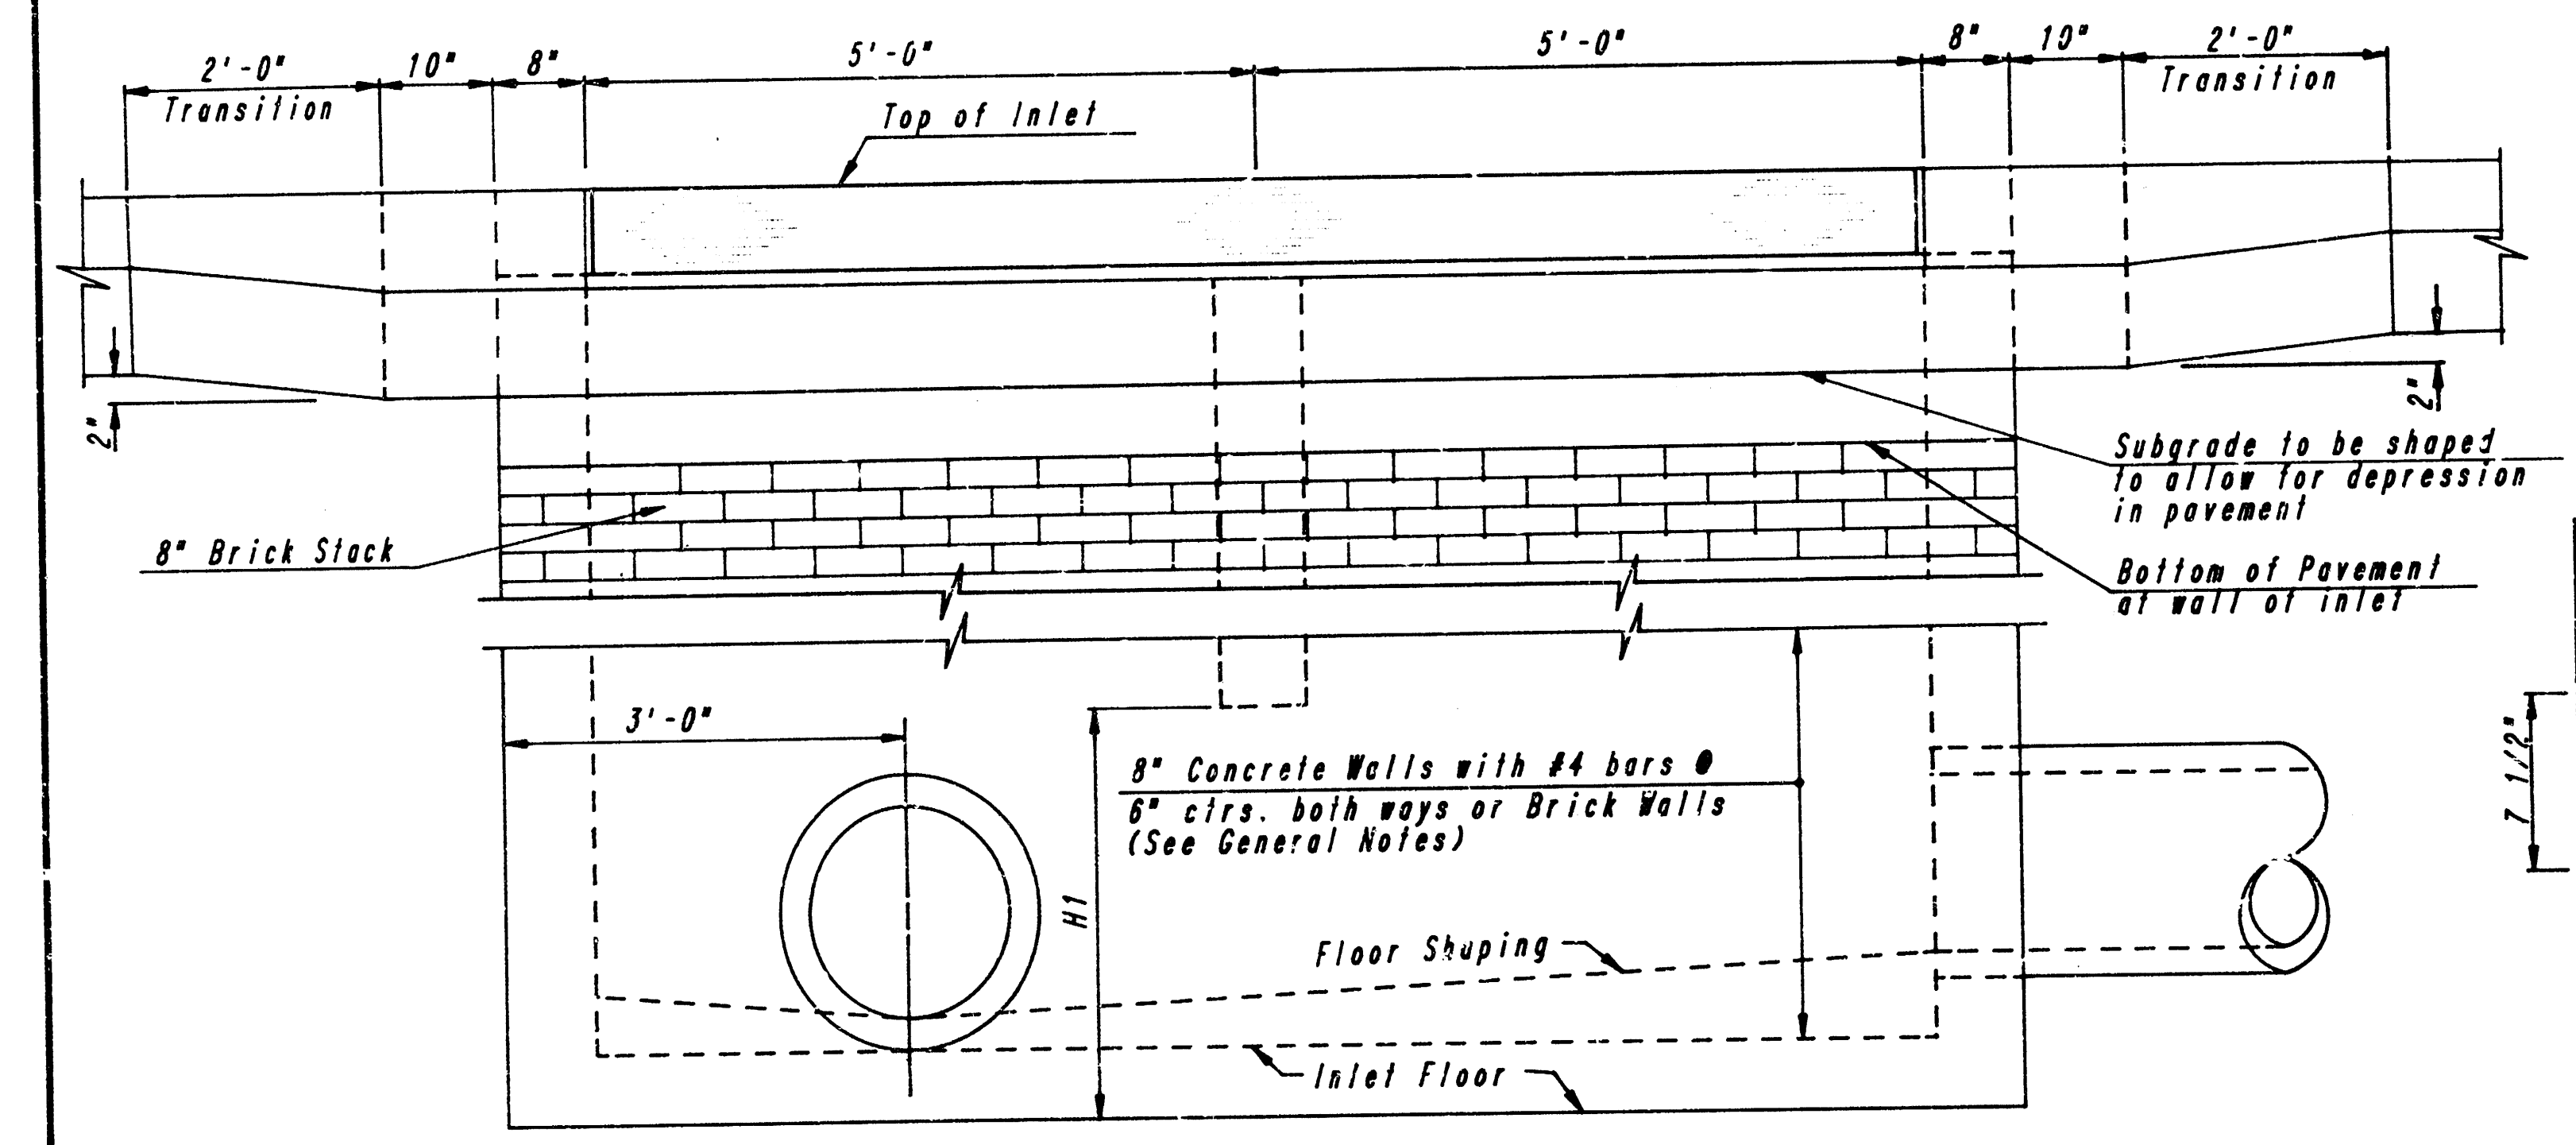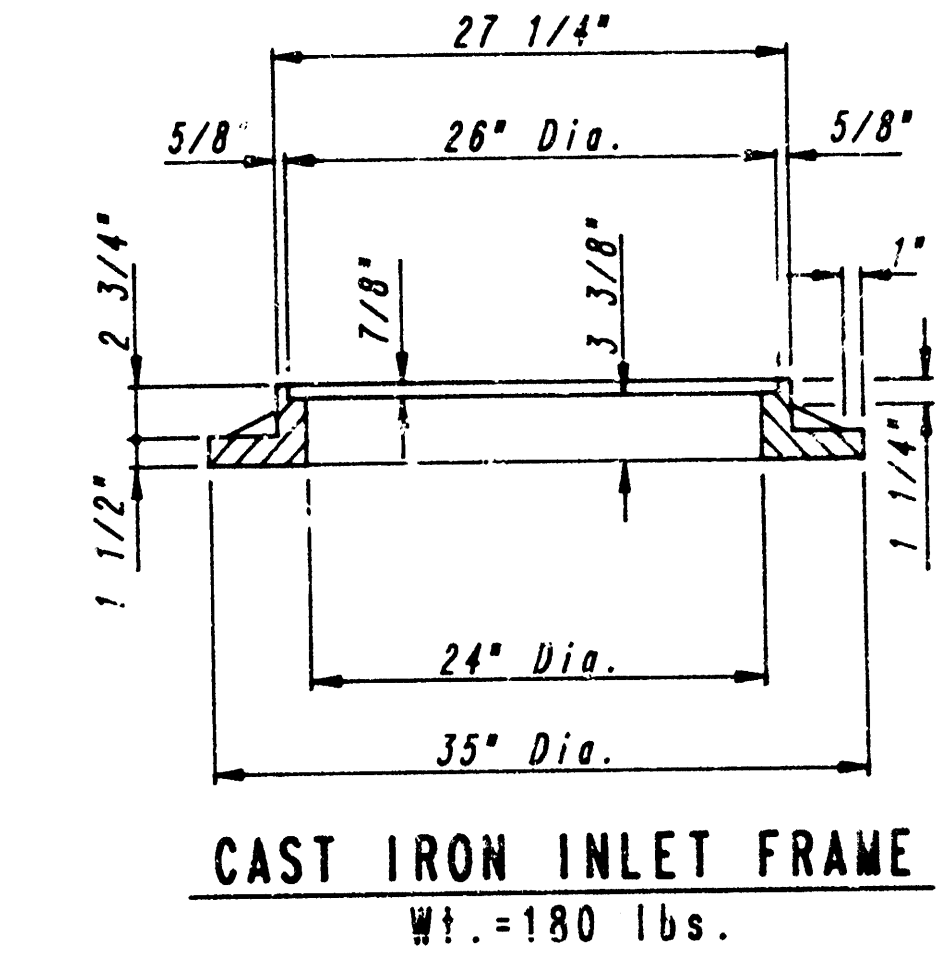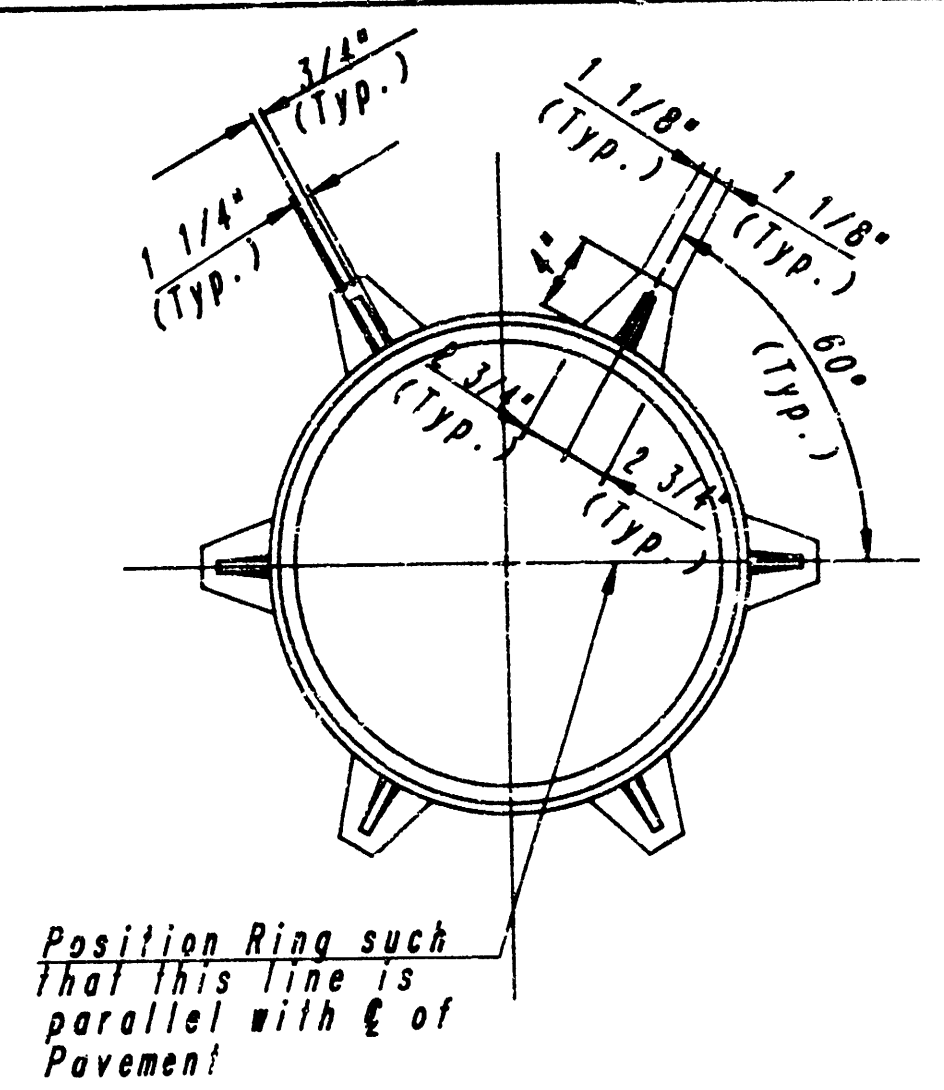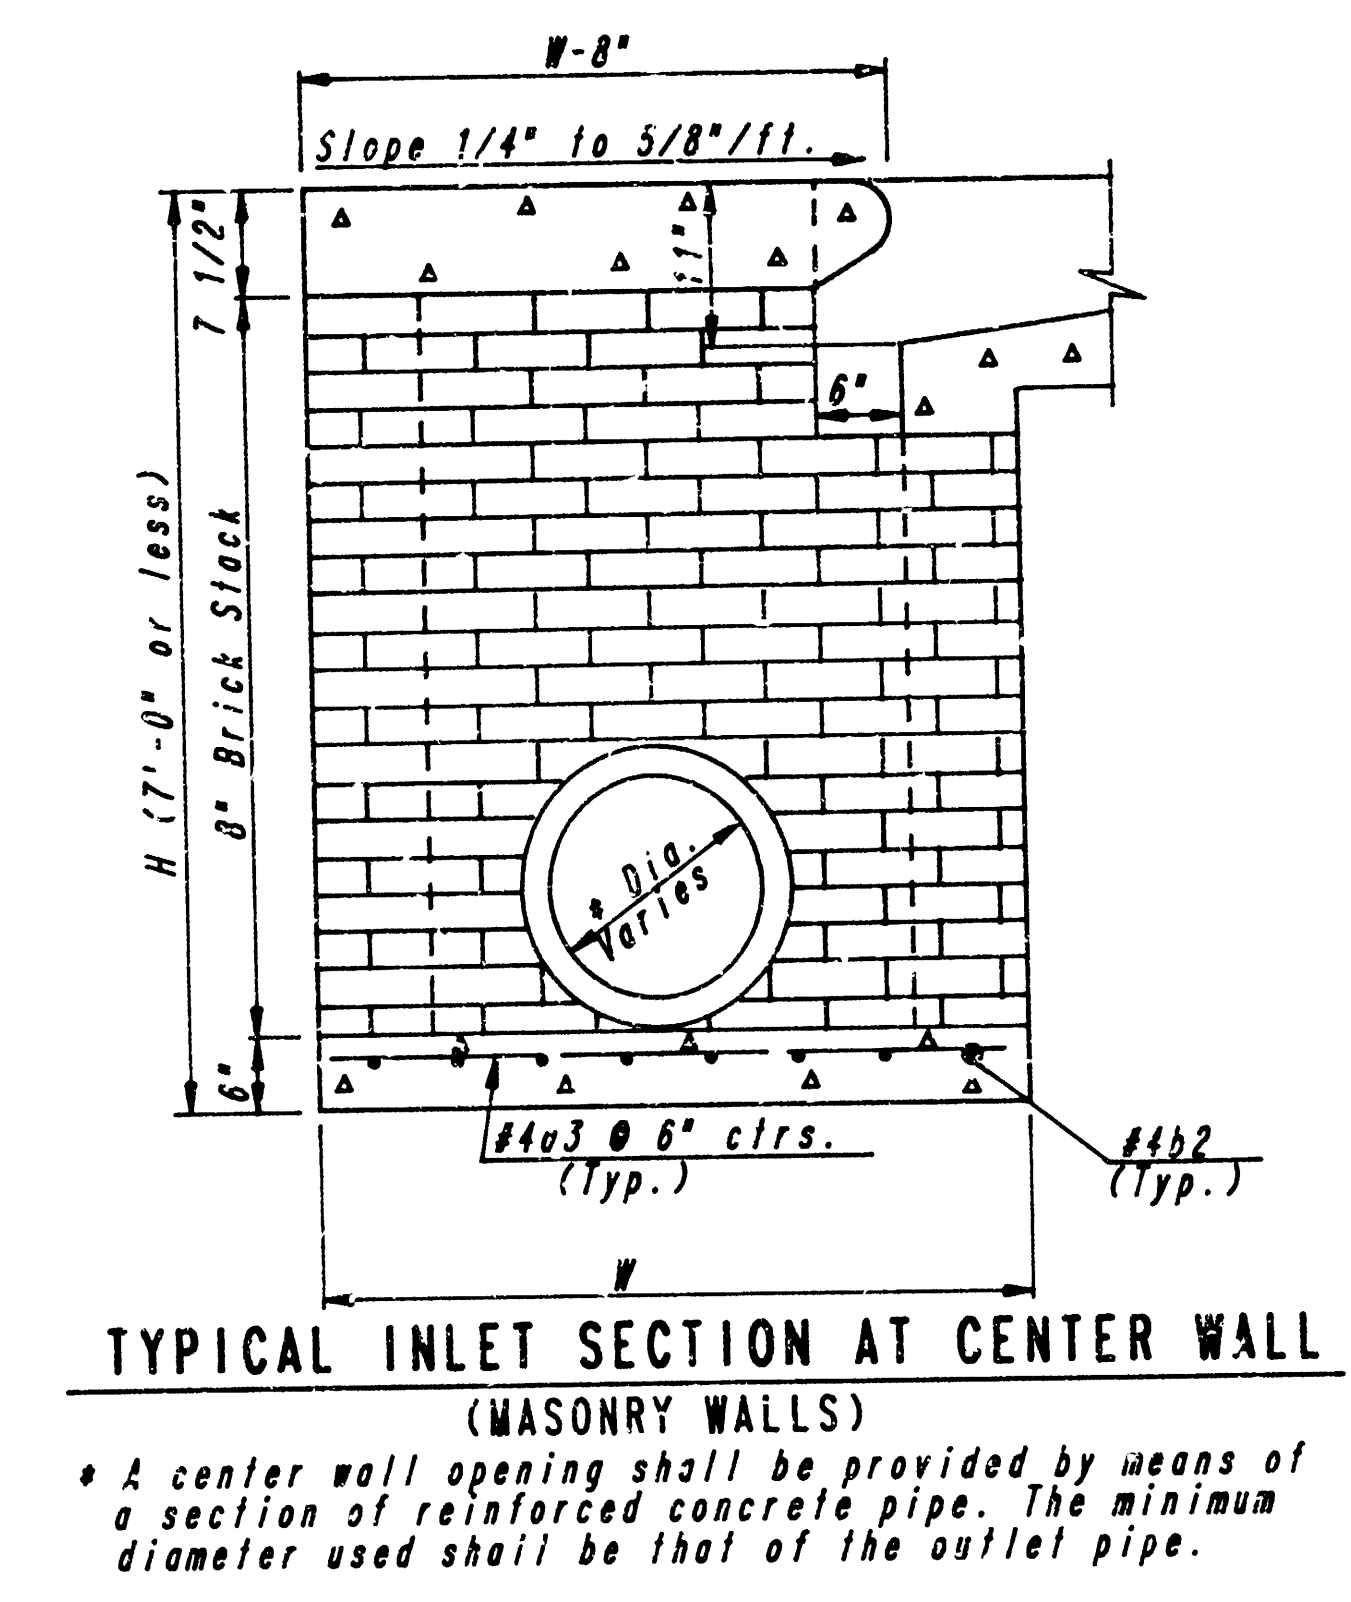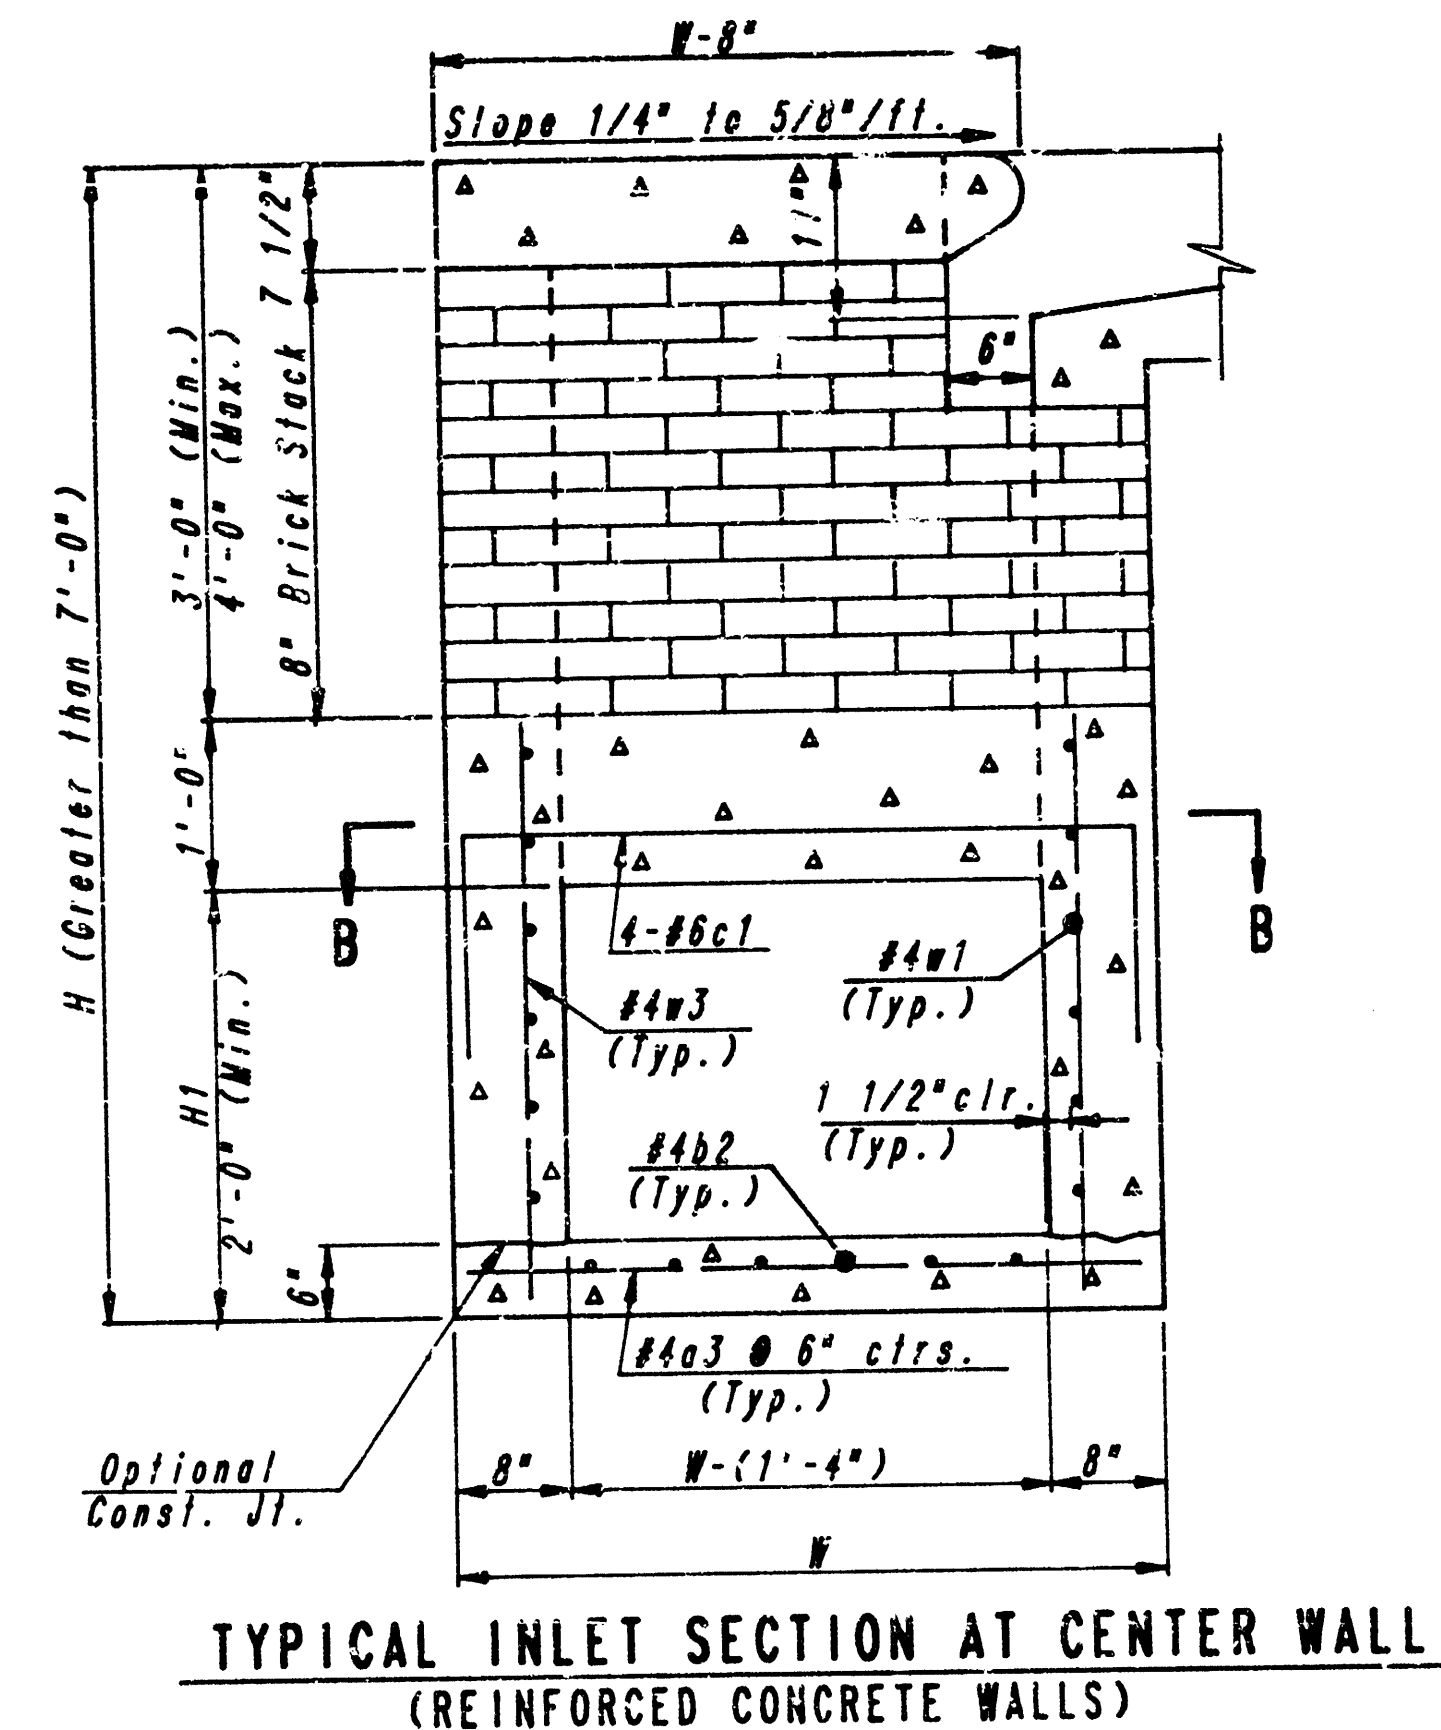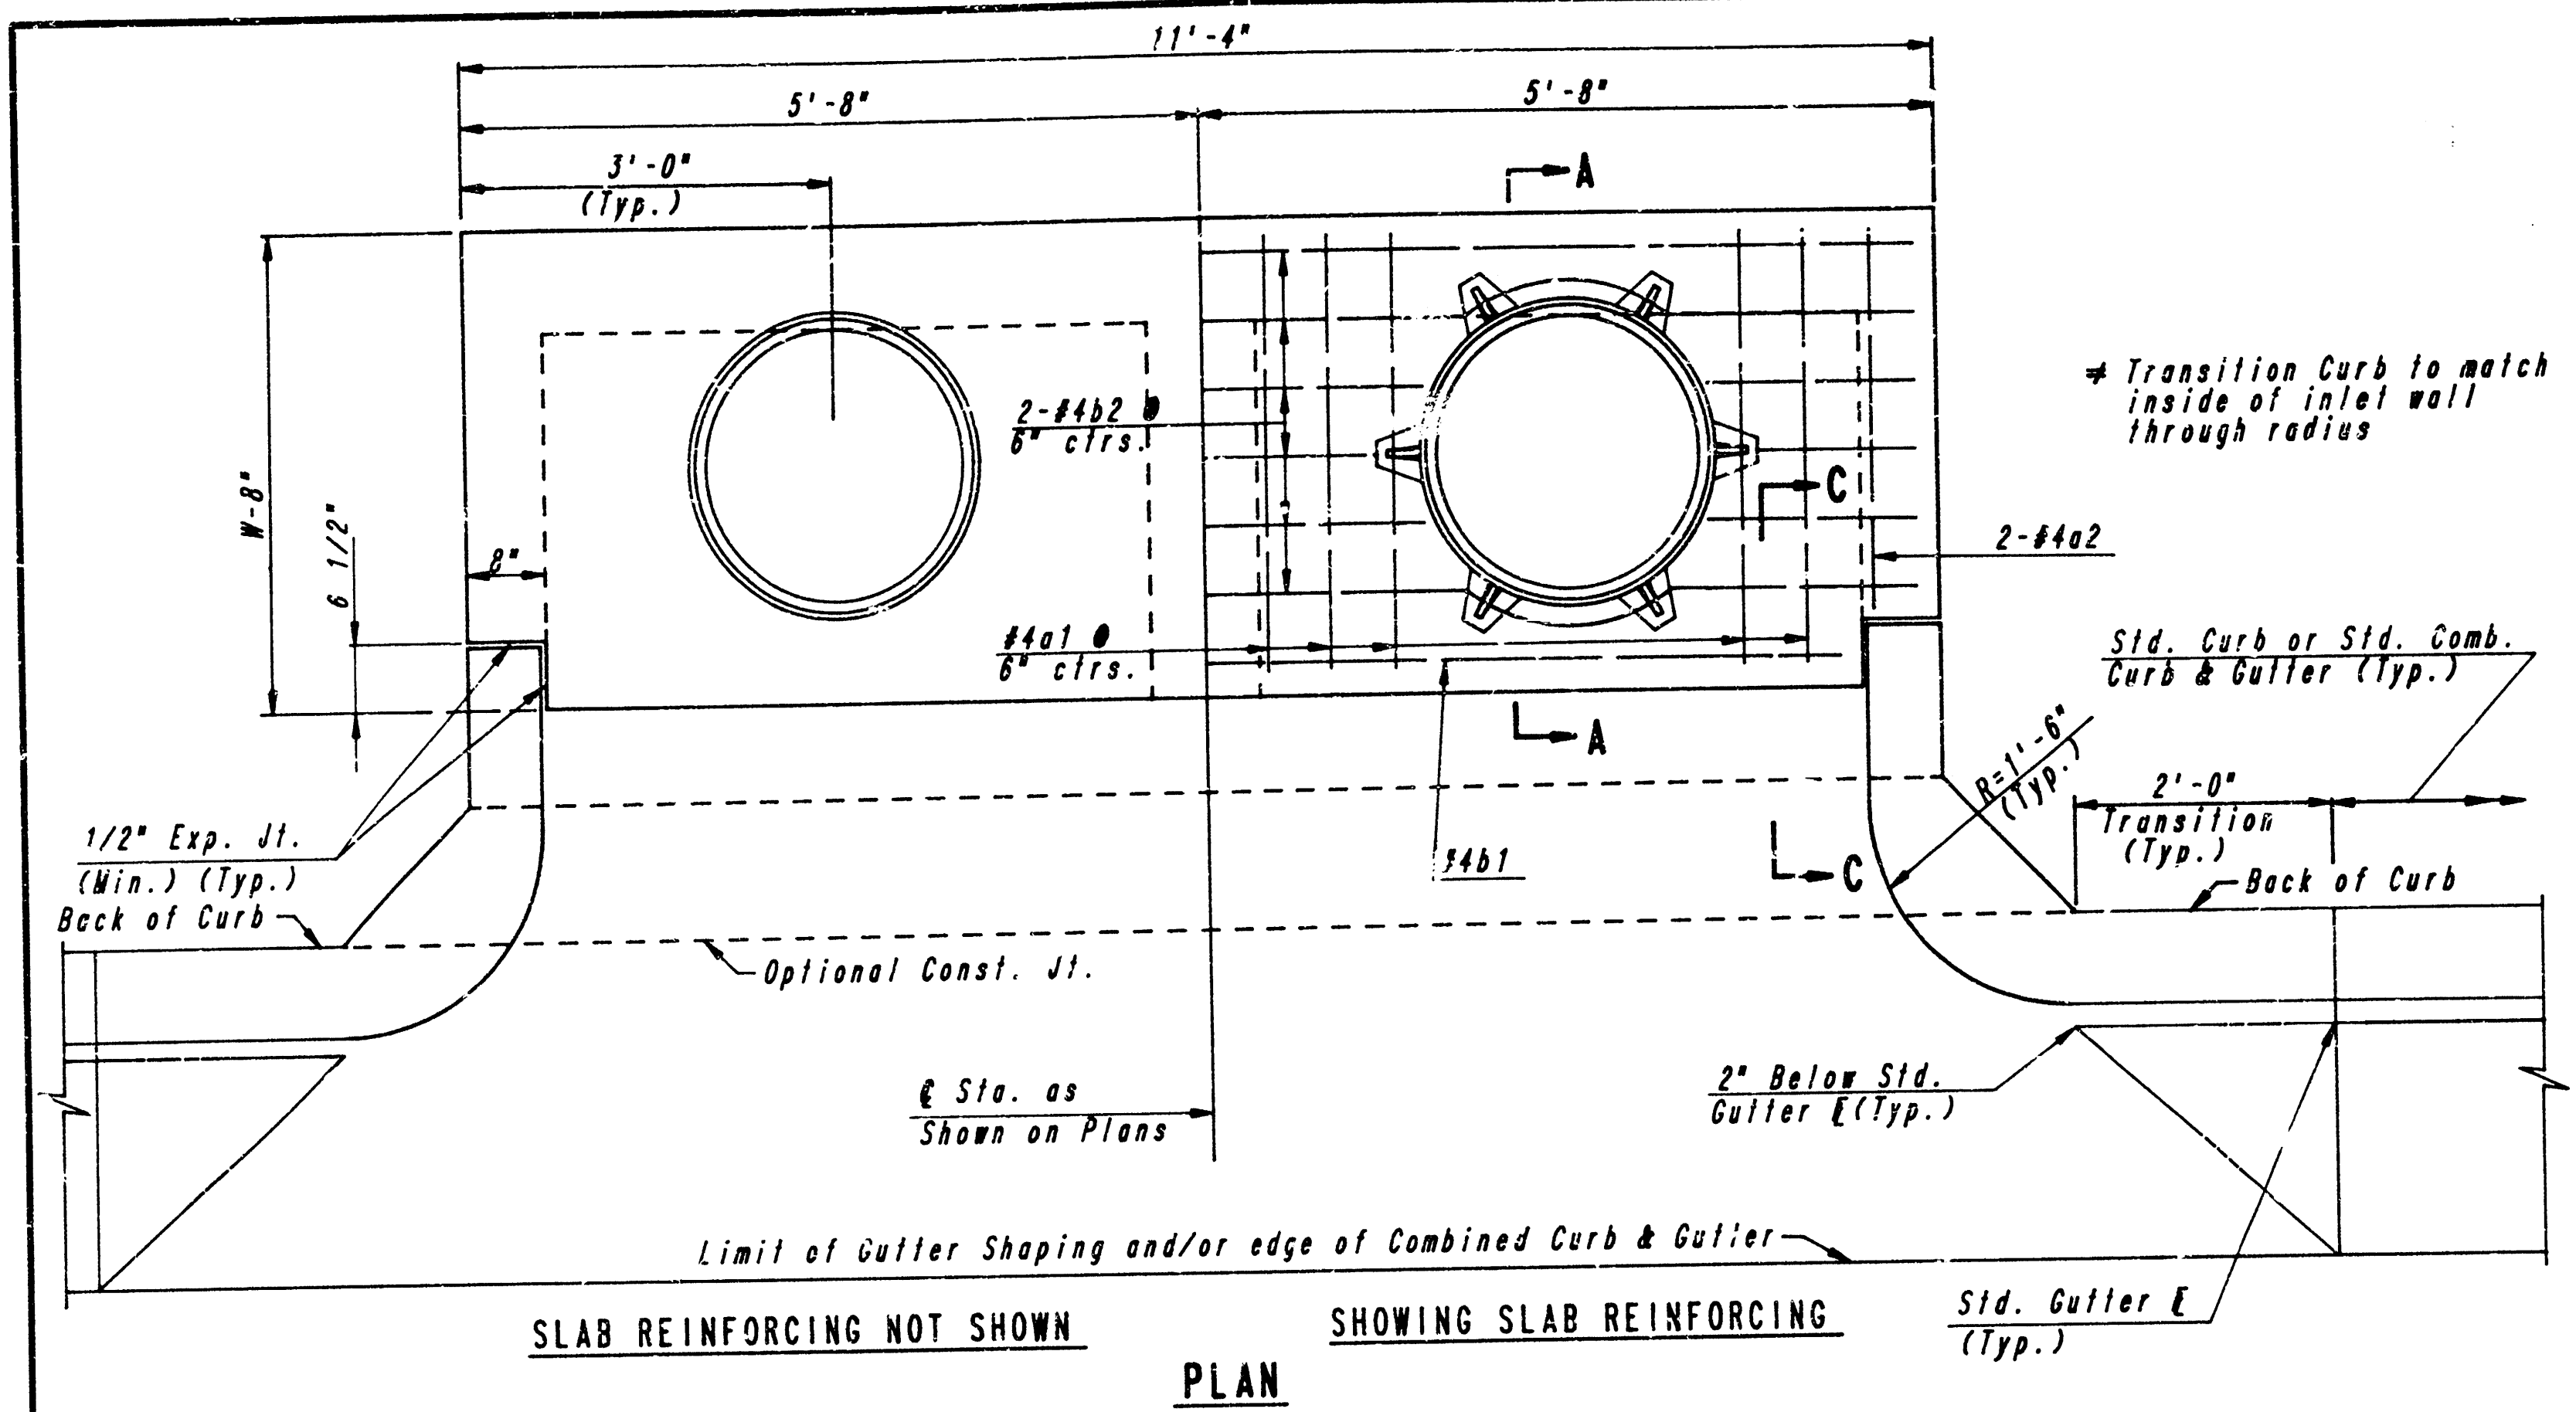


SLAB AND FLOOR REINFORCING											
		W=4'-4"		W=5'-4"		W=6'-4"		W=7'-4"		W=8'-4"	
MARK	SIZE	NO.	LENGTH	NO.	LENGTH	NO.	LENGTH	NO.	LENGTH	NO.	LENGTH
a1	#4	13	6'-7 1/4"	13	8'-7 1/4"	13	10'-7 1/4"	13	12'-7 1/4"	13	14'-7 1/4"
a2	#4	2	5'-0"	2	8'-0"	2	10'-0"	2	12'-0"	2	14'-0"
a3	#4	20	4'-1"	20	5'-1"	20	6'-1"	20	7'-1"	20	8'-1"
b1	#4	1	9'-8"	1	8'-8"	1	9'-8"	1	9'-8"	1	9'-8"
b2	#4	18	11'-1"	24	11'-1"	30	11'-1"	36	11'-1"	42	11'-1"

WALL REINFORCING											
		W=4'-4"		W=5'-4"		W=6'-4"		W=7'-4"		W=8'-4"	
MARK	SIZE	NO.	LENGTH	NO.	LENGTH	NO.	LENGTH	NO.	LENGTH	NO.	LENGTH
c1	#6	4	6'-1"	4	7'-1"	4	8'-1"	4	9'-1"	4	10'-1"
w1	#4	1	11'-1"	1	11'-1"	1	11'-1"	1	11'-1"	1	11'-1"
w2	#4	1	4'-1"	1	5'-1"	1	6'-1"	1	7'-1"	1	8'-1"
w3	#4	2	5'-1"	2	6'-1"	2	7'-1"	2	8'-1"	2	9'-1"


* Field bend or cut Reinforcing as required for clearance
① 4(HI-6")x4 (HI-6") Rounded down to nearest 0.5'
② 40x4(W-16") ③ HIx(8")

GENERAL NOTES
THE CONTRACTOR WILL BE REQUIRED TO CONSTRUCT 8" BRICK MASONRY WALLS BETWEEN THE CONCRETE INLET BASE AND TOP ON THIS INLET WHEN W=6'-4" OR LESS AND W=7'-0" OR LESS. WHEN W IS GREATER THAN 6'-4" AND W IS LESS THAN 7'-0", THE OUTSIDE WALLS BELOW THE BRICK STACK SHALL BE REINFORCED CONCRETE CONSTRUCTION AND THE CENTER WALL SHALL BE OF MASONRY CONSTRUCTION AS SHOWN FOR THE MASONRY WALL OPTION.
INLET INVERT SHALL BE SHAPED WITH A SACK SAND MIX CONCRETE TO CREATE FLOW CHANNELS AND TO INCREASE HYDRAULIC EFFICIENCY SUCH THAT THE INLET WILL BE SELF-CLEANING BETWEEN ALL INLET AND/OR OUTLET PIPES.
CONCRETE SHALL BE CITY OF WICHITA STANDARD PAVING MIX. ALL EXPOSED EDGES SHALL BE FINISHED WITH AN EDGING TOOL. INLET TOPS ARE TO BE PLACED ON A THIN MORTAR CUSHION TO INSURE FULL SUPPORT ALONG BRICK WALLS. CONCRETE TOPS MAY BE PRECAST OR CAST IN PLACE. INLET TOPS SHALL BE NOTCHED OUT AS INDICATED TO FACILITATE CONSTRUCTION OF CURBS.
UNLESS OTHERWISE NOTED, ALL BARS ARE #4 ON 6" MAX. CENTERS AND SHALL HAVE A MINIMUM CLEARANCE OF 1-1/2". BARS SHALL BE FIELD BENT OR CUT TO CLEAR MANHOLE RINGS AND PIPE OPENINGS.
THE ENDS OF ALL PIPES INSTALLED IN INLETS SHALL BE CUT OFF FLUSH WITH THE INSIDE FACE OF THE INLET WALL.
ADDITIONAL CURB AND/OR CURB AND GUTTER CONSTRUCTION NECESSARY TO CONNECT SET-BACK INLET TO PAVEMENT WILL BE PAID FOR AT THE UNIT PRICE BID PER EACH FOR "INLET HOOKUP".

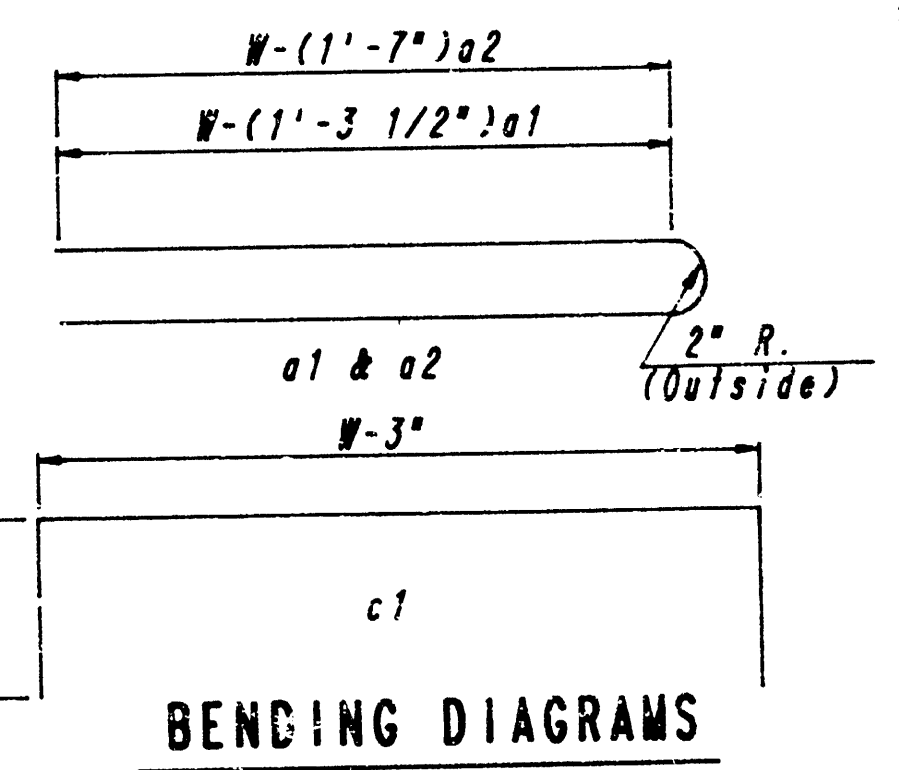


CITY OF WICHITA, KANSAS
STORM WATER SEWER NO. 299
**DETAIL STANDARD
TYPE 1A CURB INLET**
INLET OPENING - 24" X 24"
C.O.W. Proj. No. 488-76-245-B1507-000-000-001
PROFESSIONAL ENGINEERING CONSULTANTS, P.A.
ENGINEERS
WICHITA, KANSAS
Designed by _____ Checked by _____
Drawn by _____ Date April, 86 Job No. 86107


PROJECT NO.	SHEET NO.	TOTAL SHEETS
448-76-245-81507-000-000-001	10	15

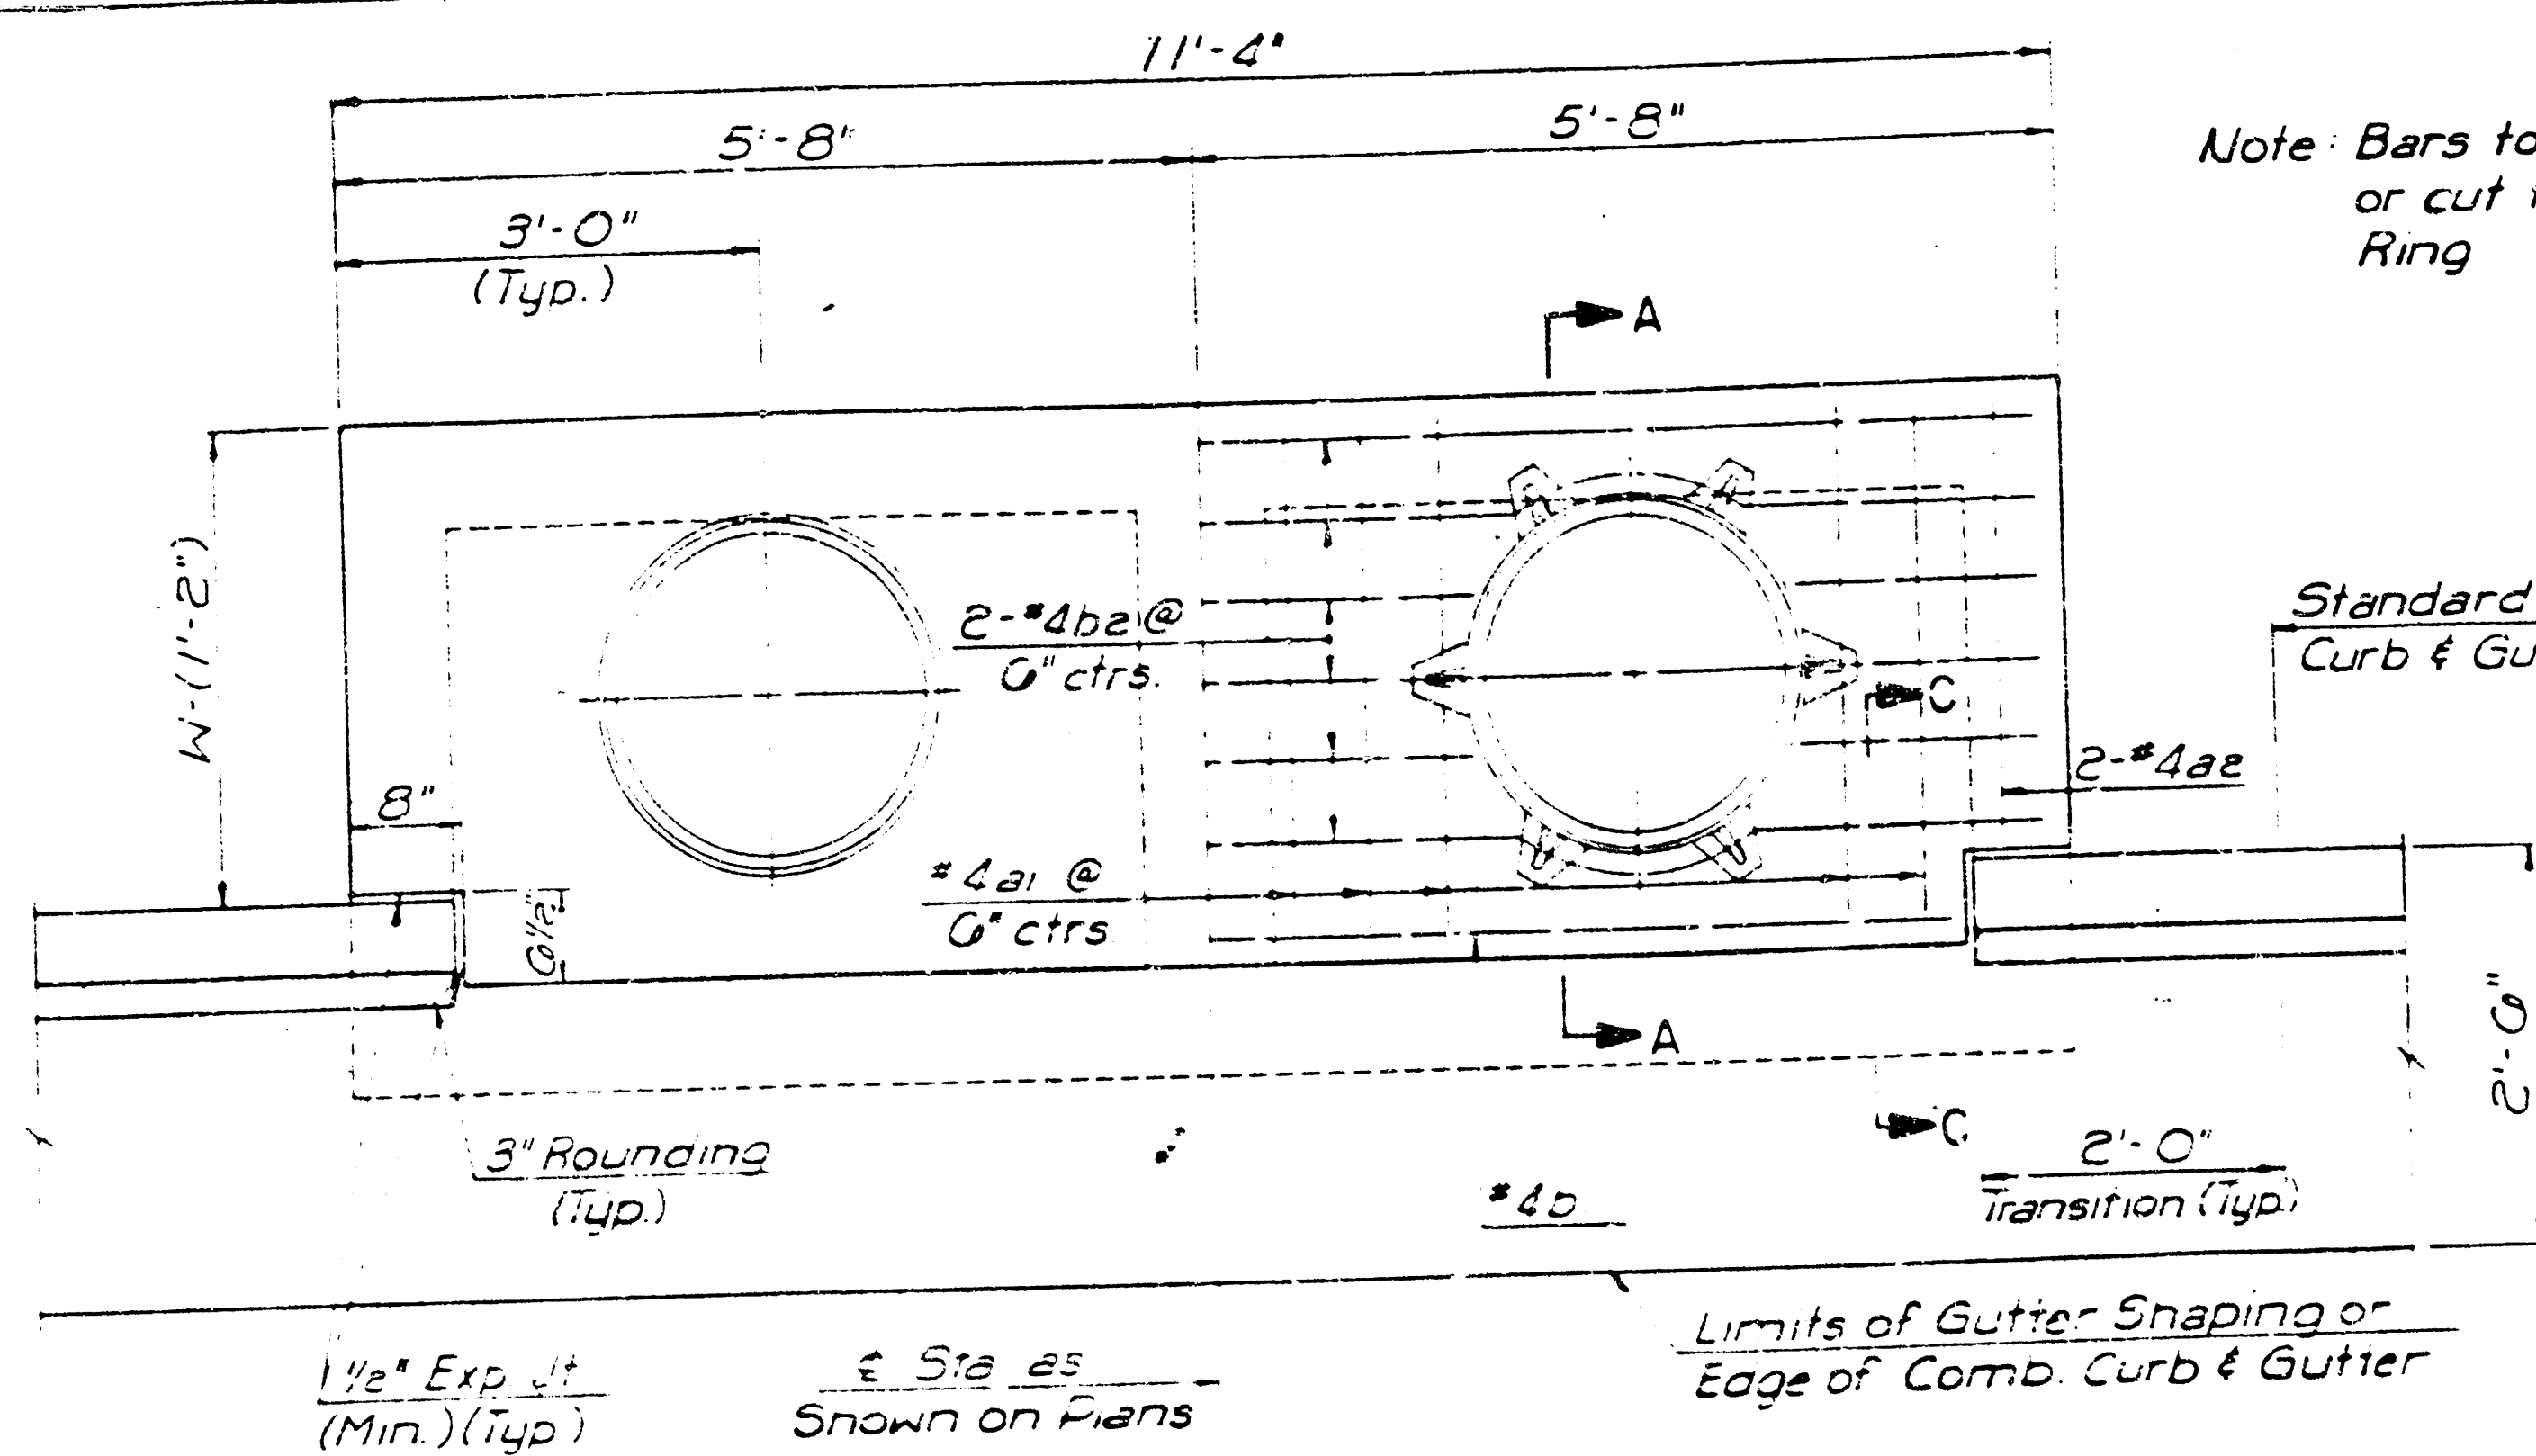

SLAB REINFORCING NOT SHOWN
SHOWING SLAB REINFORCING
PLAN

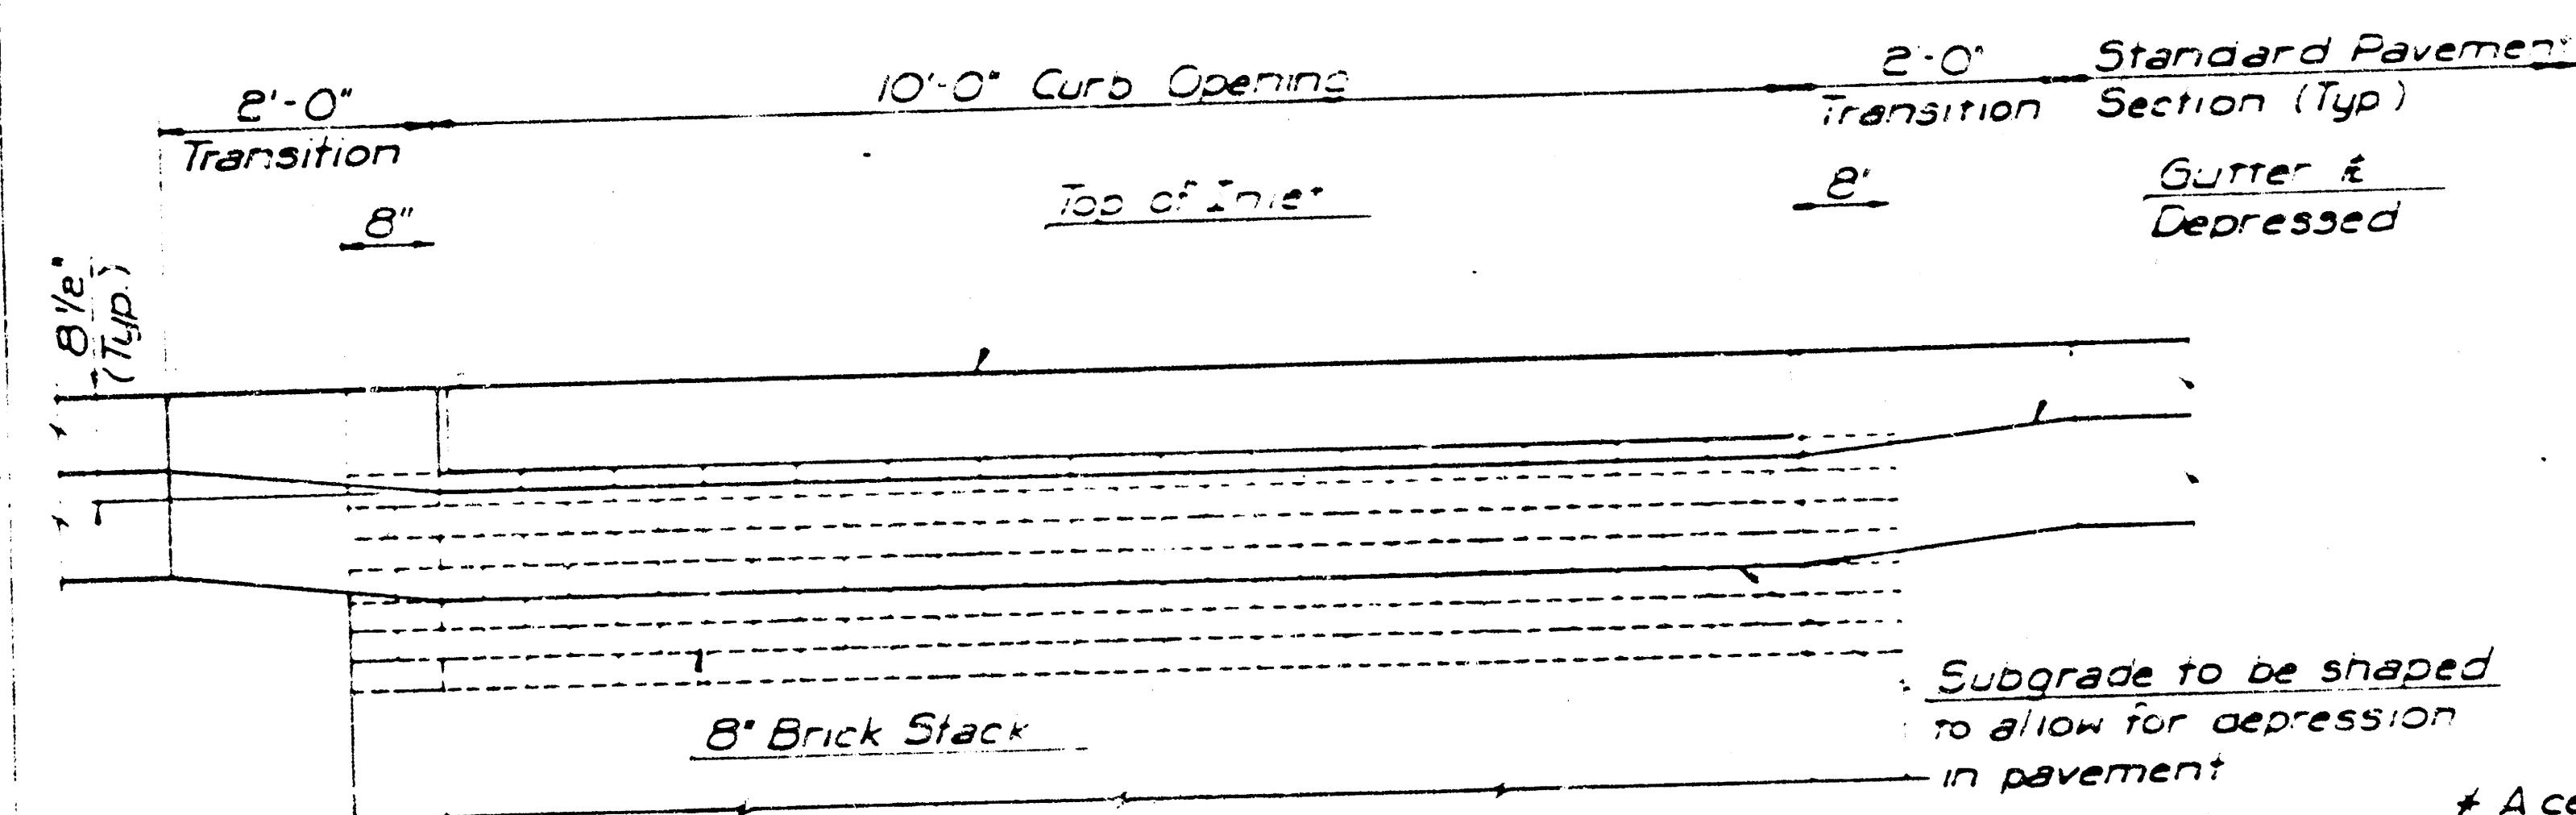


ELEVATION

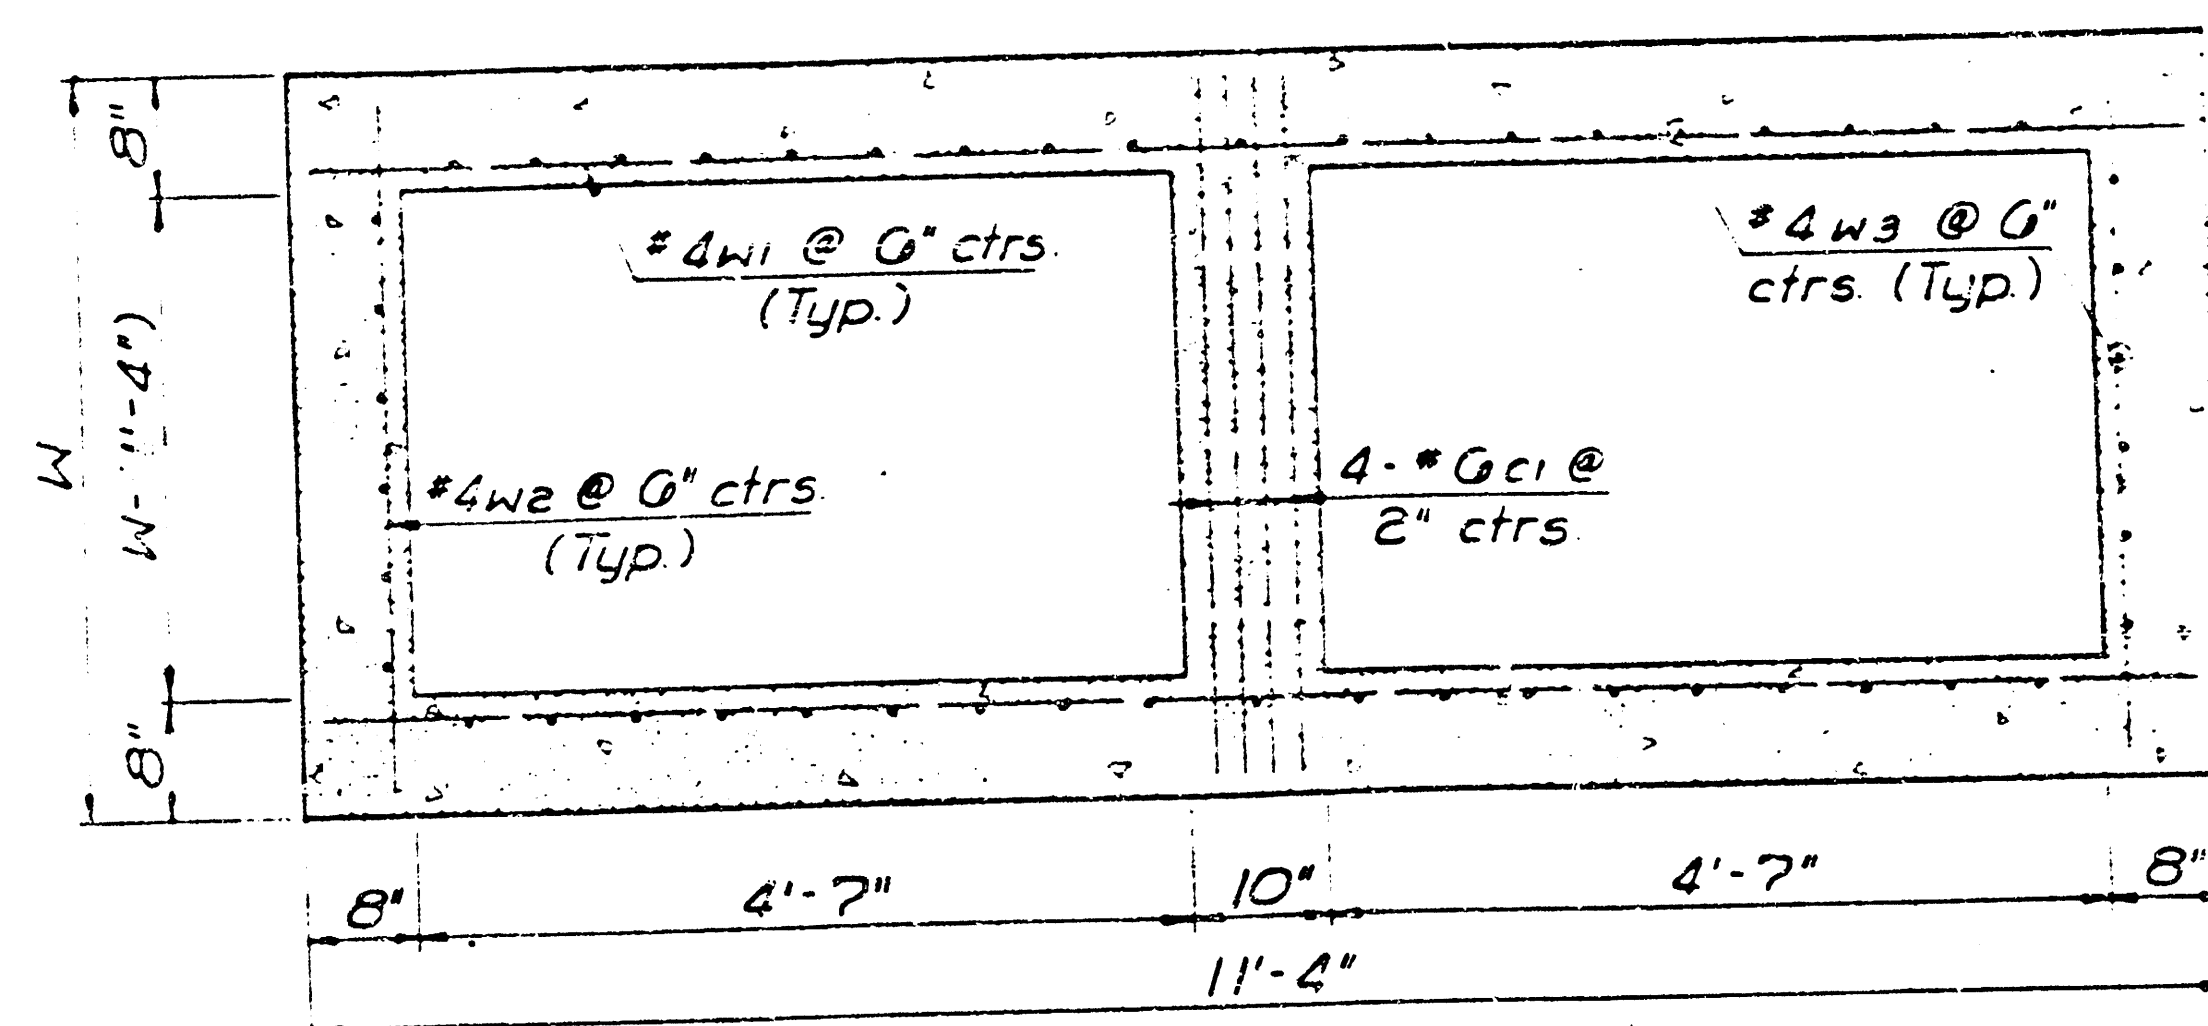


SECTION B-B

Note: Bars to be field bent or cut to clear Manhole Ring

Standard Combined Curb & Gutter (Typ)

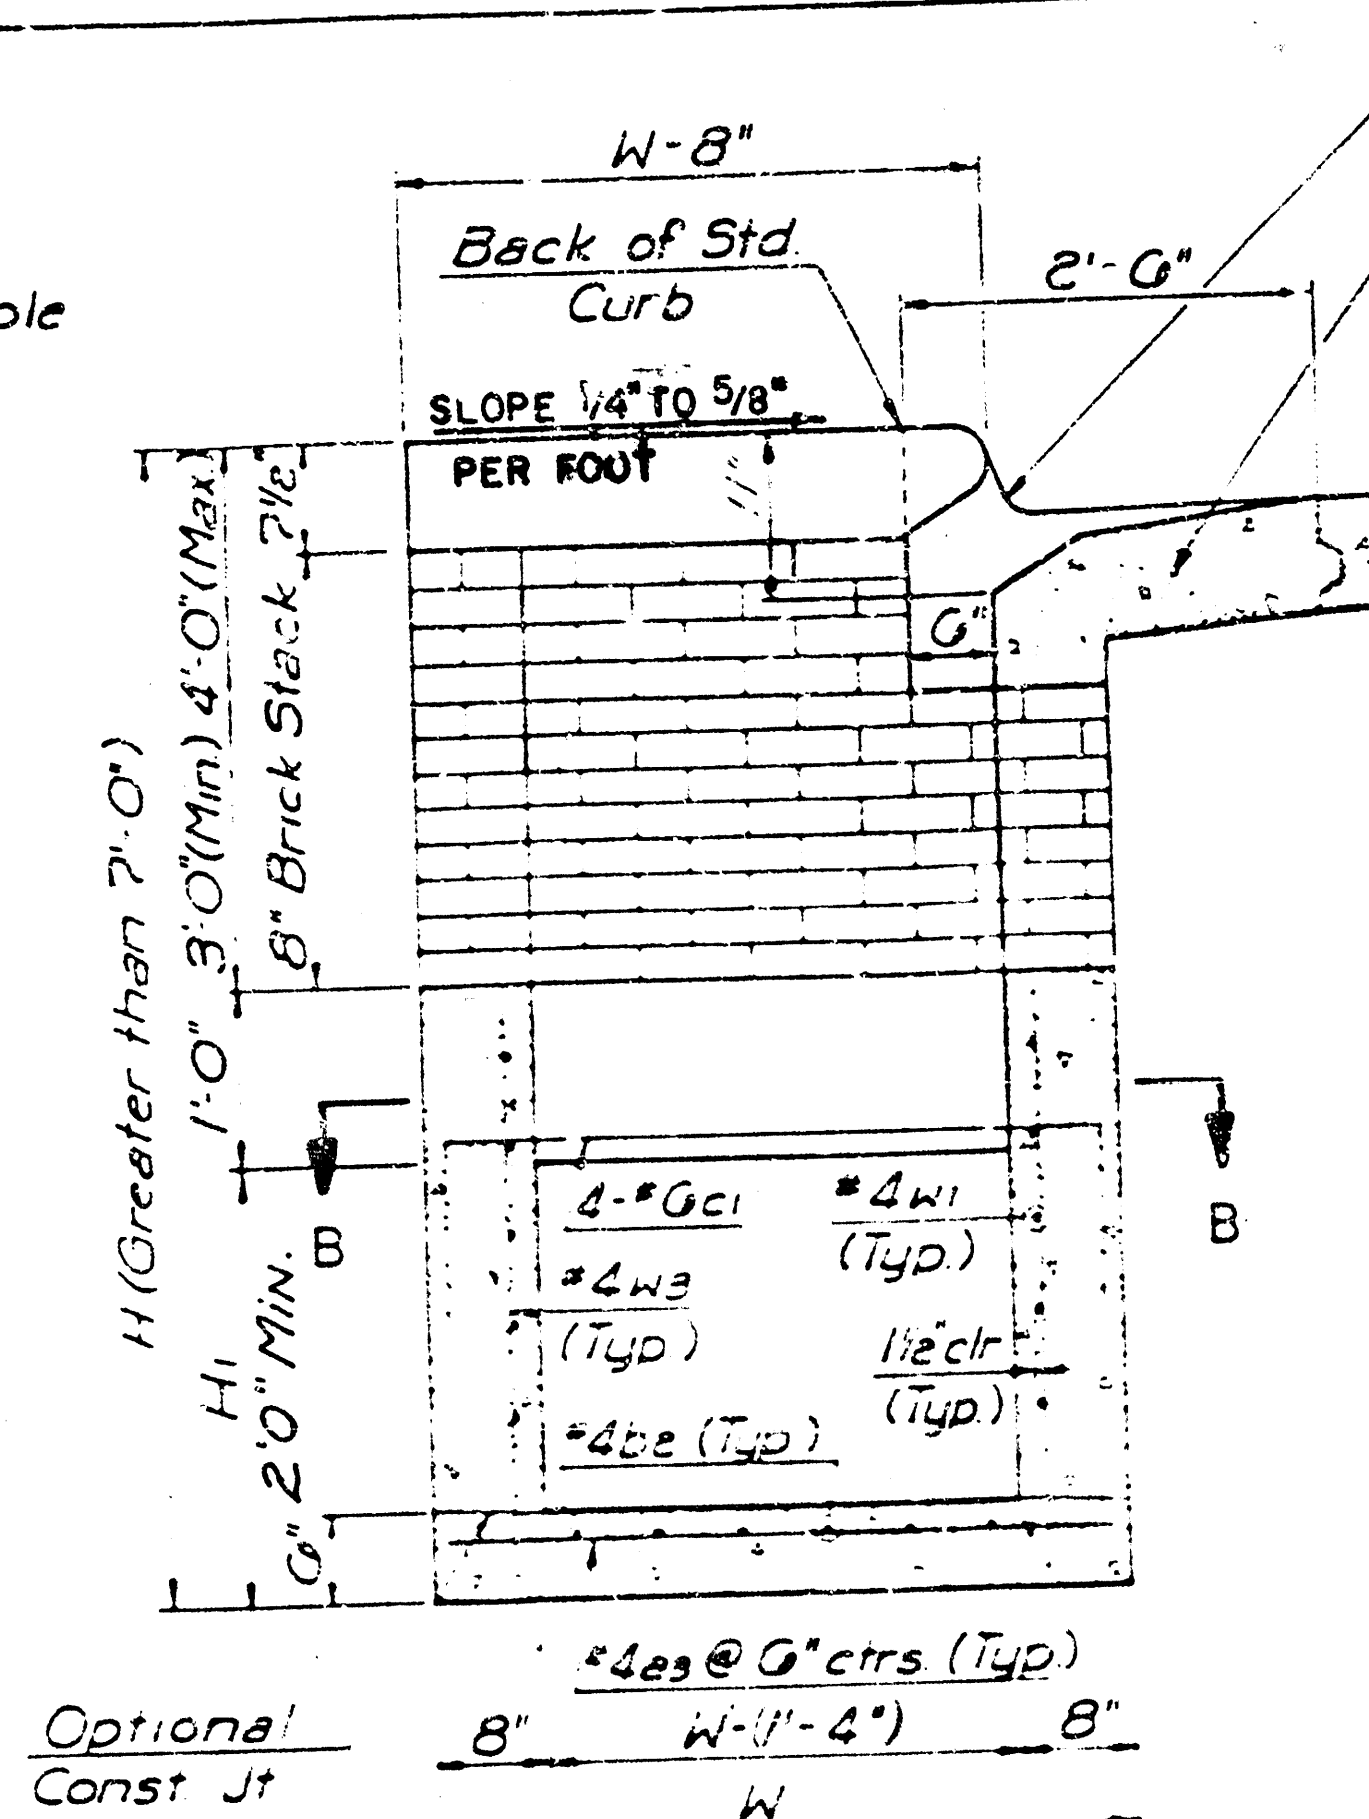

TYPICAL INLET SECTION AT CENTER WALL
(Reinforced Concrete Walls)

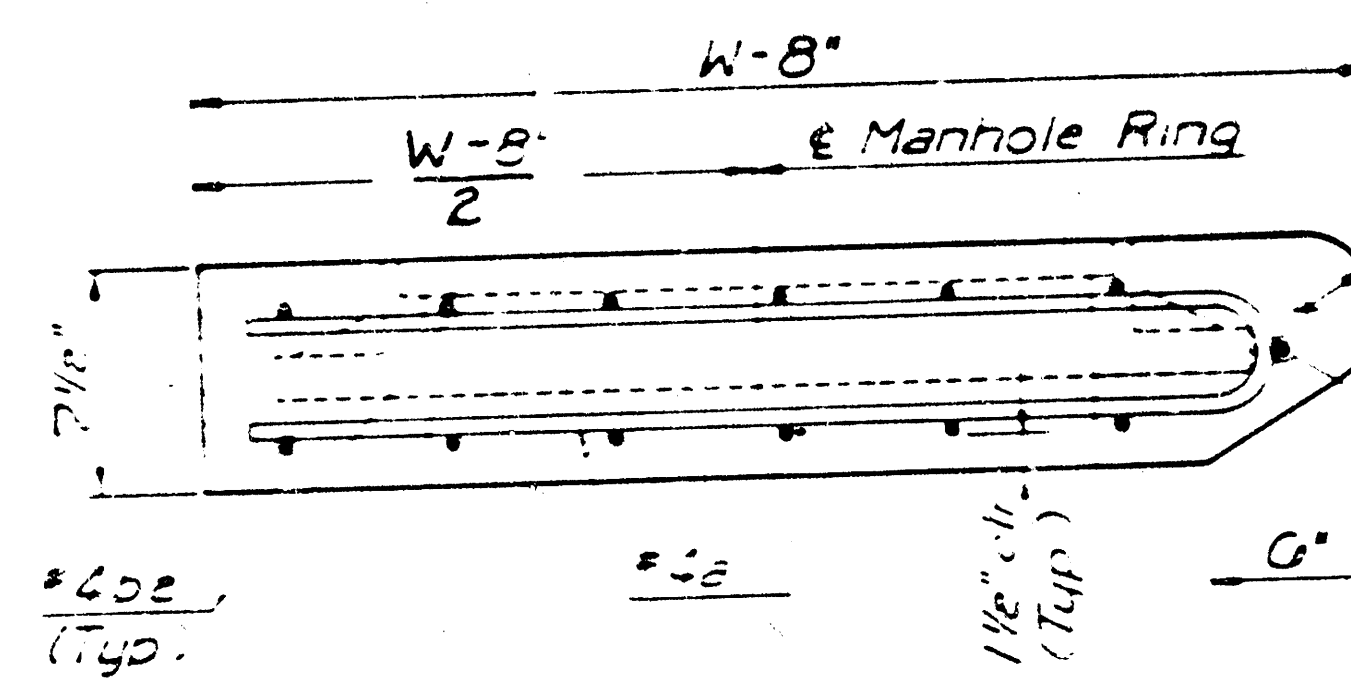

SECTION A-A

* A center wall opening shall be provided by means of a section of reinforced concrete pipe. The minimum diameter used shall be that of the outlet pipe

Note Concrete top to be installed on thin mortar cushion to insure full support along walls


SLAB AND FLOOR REINFORCING									
Mark	Size	No	Length	No	Length	No	Length	No	Length
a1	#4	13	6'-7 1/4"	13	8'-7 1/4"	13	10'-7 1/4"	13	12'-7 1/4"
a2	#4	2	6'-0"	2	8'-0"	2	10'-0"	2	12'-0"
a3	#4	20	4'-1"	20	5'-1"	20	6'-1"	20	7'-1"
b1	#4	1	9'-8"	1	9'-8"	1	9'-8"	1	9'-8"
b2	#4	18	11'-1"	24	11'-1"	30	11'-1"	36	11'-1"

WALL REINFORCING									
Mark	Size	No	Length	No	Length	No	Length	No	Length
c1	#4	4	6'-1"	4	7'-1"	4	8'-1"	4	9'-1"
w1	#4	1	11'-1"	1	11'-1"	1	11'-1"	1	11'-1"
w2	#4	1	4'-1"	1	5'-1"	1	6'-1"	1	7'-1"
w3	#4	2	3	2	3	2	3	2	3


* Field bend or cut Reinforcing as required for clearance

① 4 (H-10") ② 40 + 4 (W-1) ③ H-10"


3" R Shaping on Curb Ends for Full Height of Opening
Gutter Pan by Paving Contractor (Unless Otherwise Noted) (Typ)

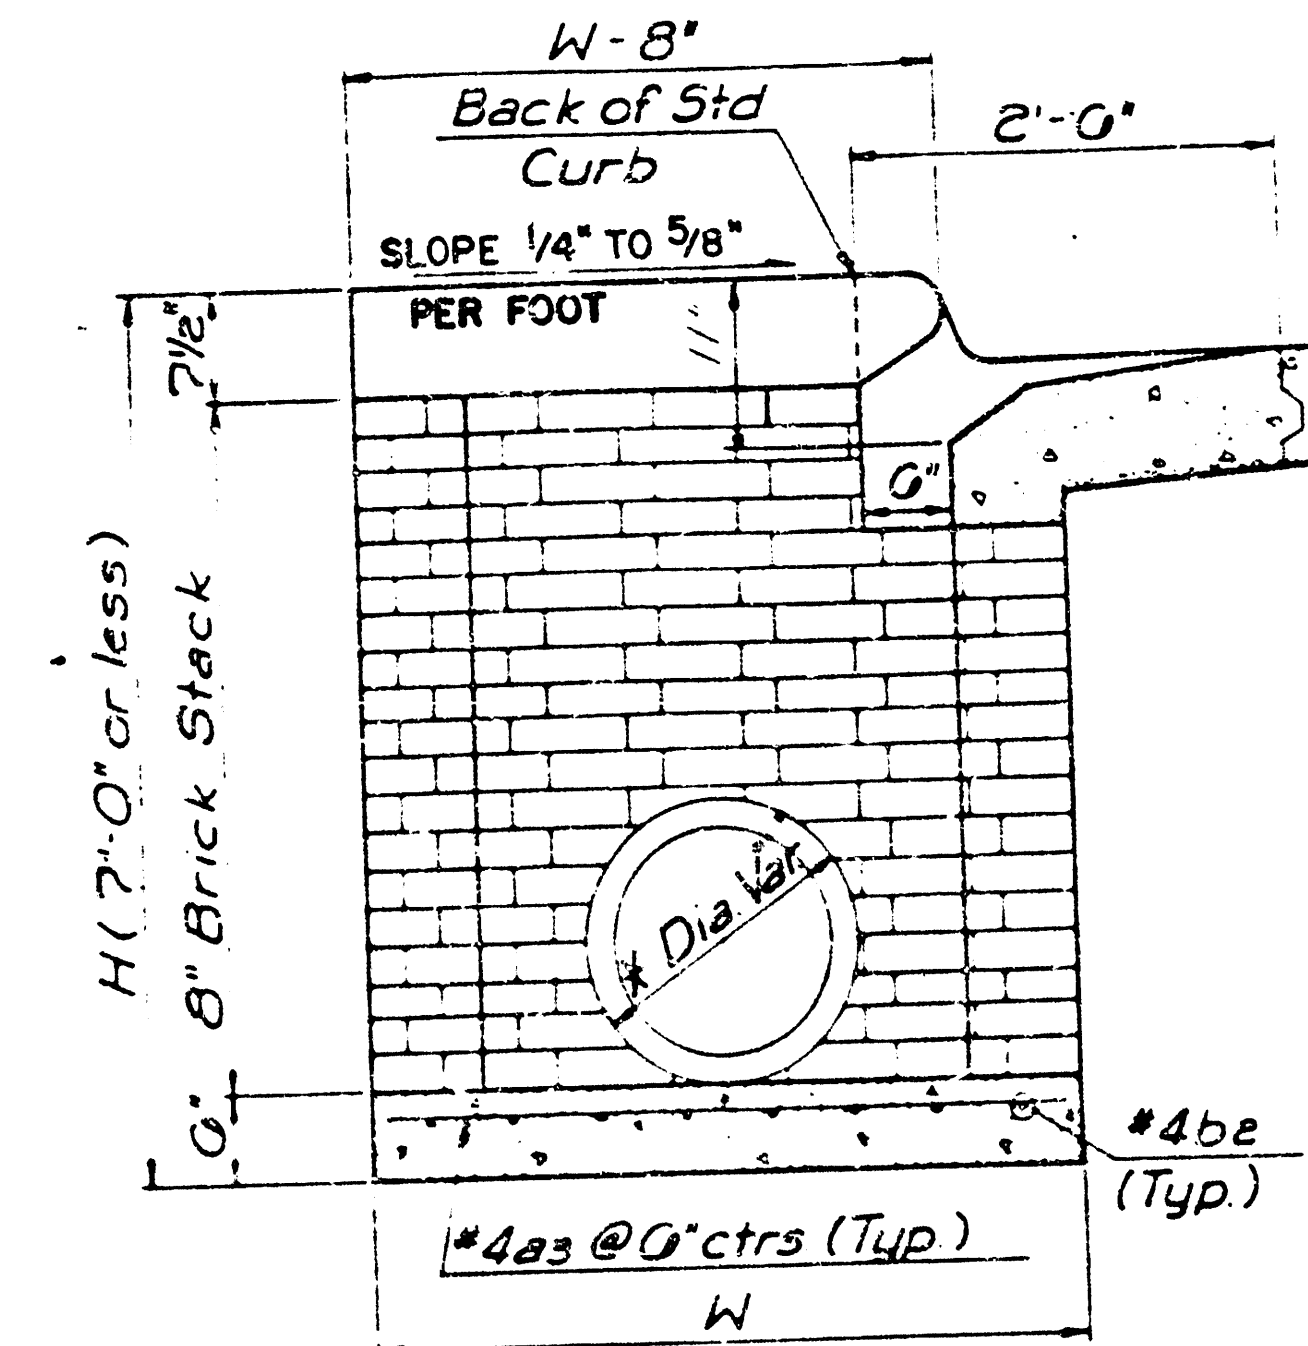


TYPICAL INLET SECTION AT CENTER WALL
(Masonry Walls)

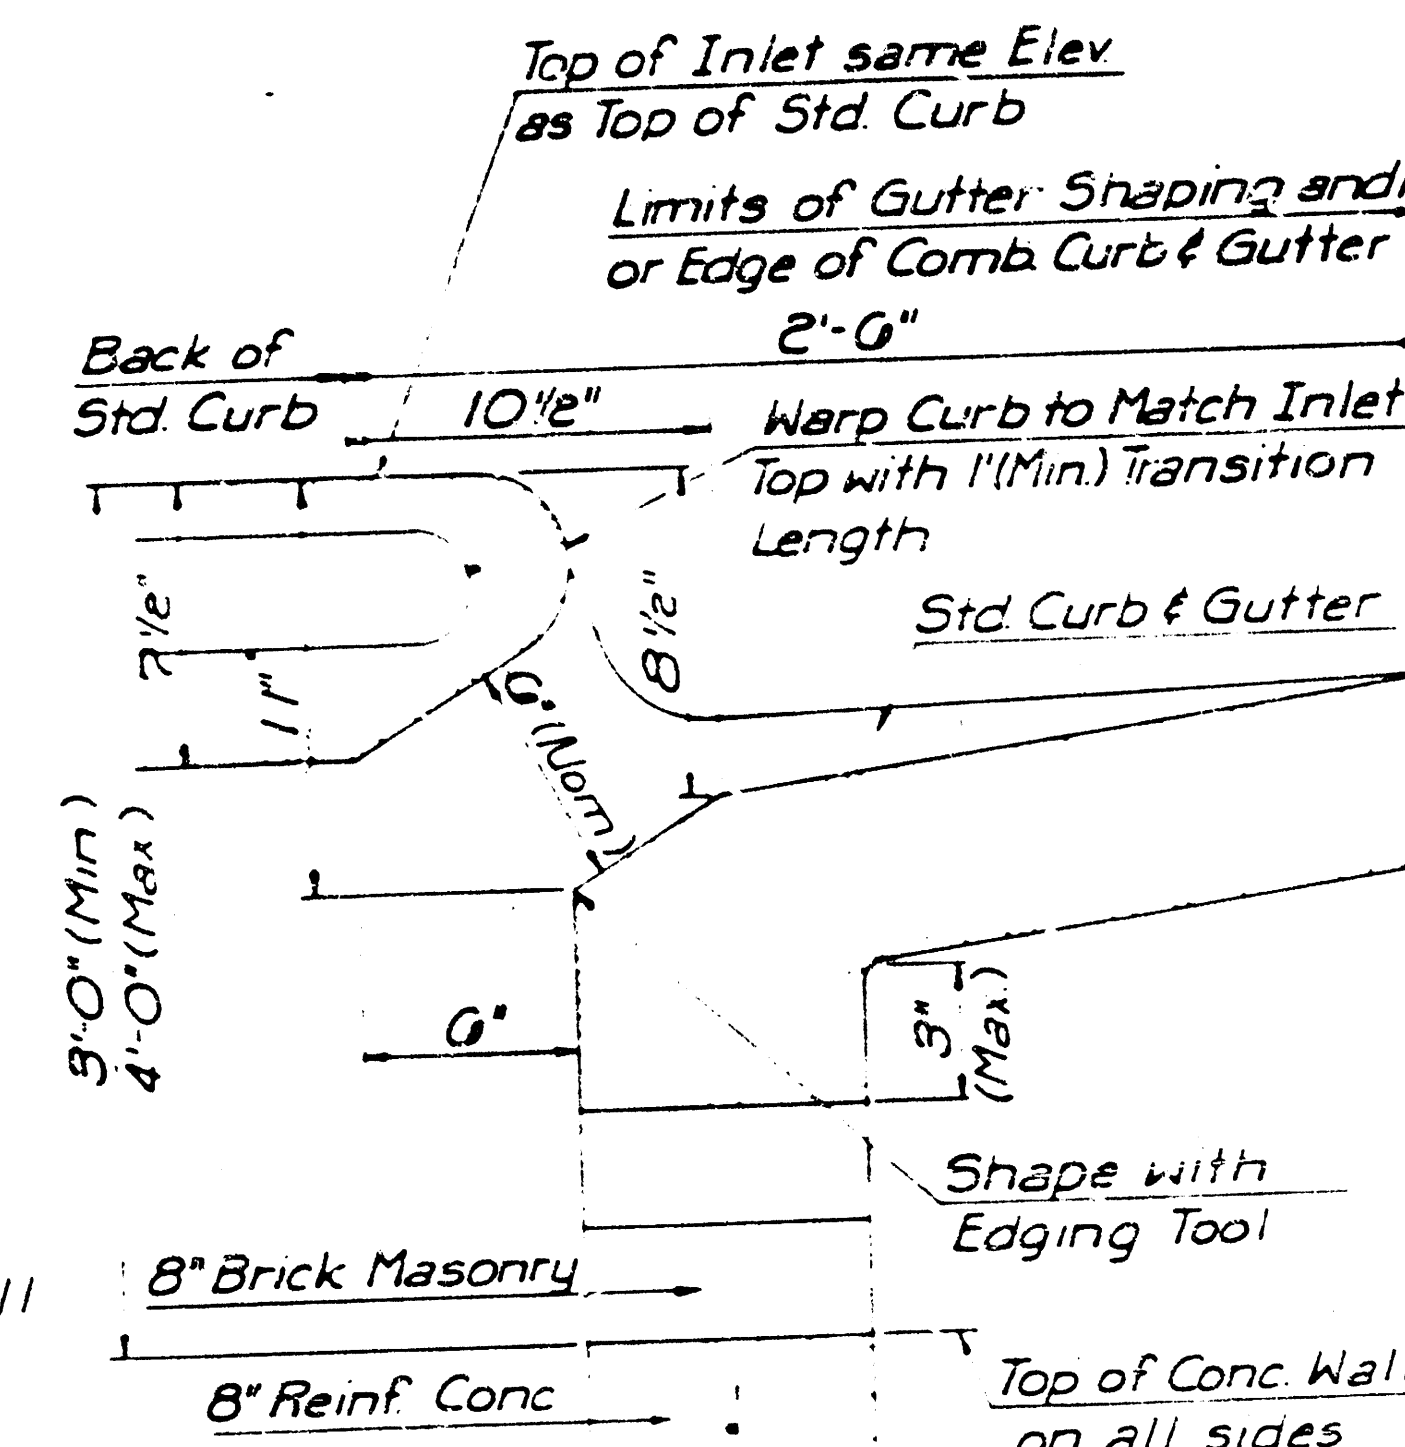

SECTION C-C

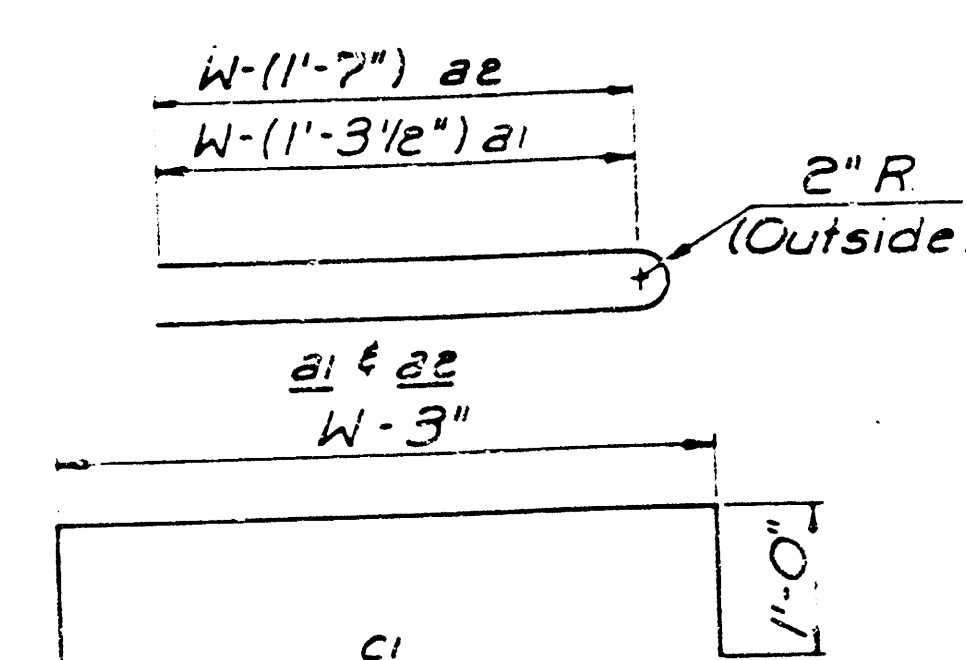

BENDING DIAGRAMS

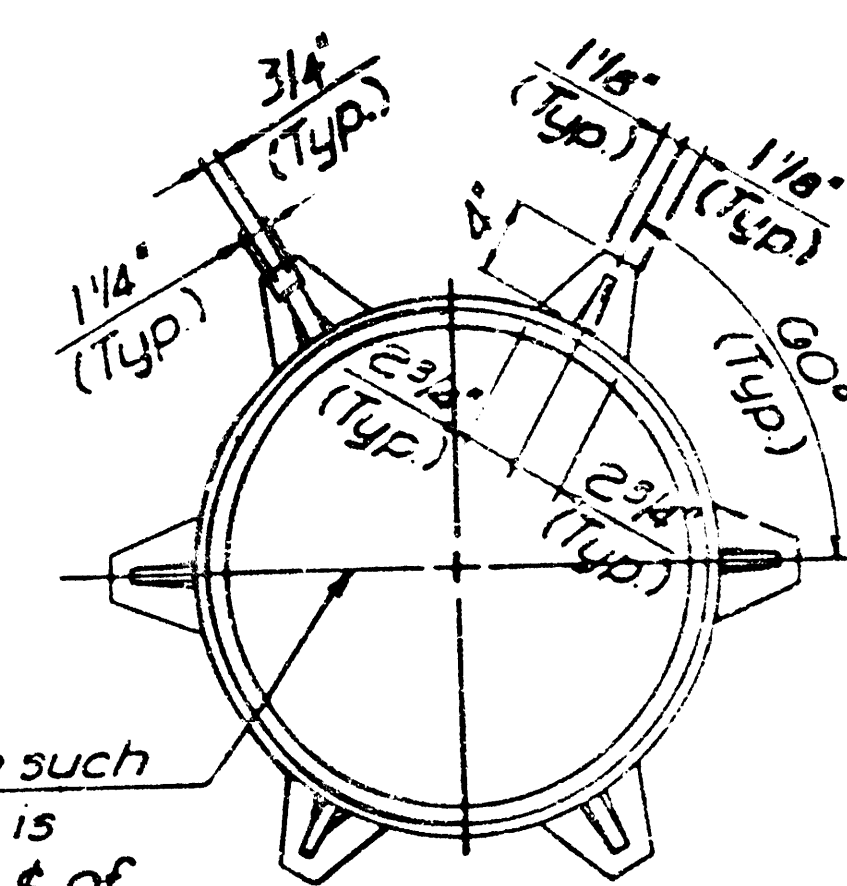

INLET FRAME (Weight = 180 LBS.)

SEE CITY OF WICHITA STANDARD MANHOLE FRAME AND COVER DETAIL SHEET FOR COVER DETAILS TO BE USED WITH INLET FRAME.

GENERAL NOTES

Concrete shall be COW Standard Paving Mix. All exposed edges shall be finished with an edging tool. Reinforcing bars shall be field bent or cut to clear pipes. All bars are #4 bars at 6" spacing and shall have a minimum clearance of 1 1/2" unless otherwise noted. Floors of inlet shall be shaped with 55ack Sand Mix Concrete to increase drainage efficiency such that the inlet will be self cleaning between all inlet and/or outfall pipe(s). The Contractor will be required to construct 8" Brick Masonry Walls between the concrete inlet base and top on this inlet when H=7'-0" or less and W=6'-4" or less.

THE ENDS OF ALL PIPES INSTALLED IN INLETS SHALL BE CUT OFF FLUSH WITH THE INSIDE FACE OF THE INLET WALL.

REVISED 12-21-1984

DETAIL STANDARD TYPE I CURB INLET

INLET OPENING = 6" x 10'-0"

CITY OF WICHITA

M. E. LINDEBAK, CITY ENGINEER

OCTOBER 1984

10/15

MANHOLE FRAME AND COVER DETAIL

ADOPTED AS STANDARD DESIGN


BY

City of Wichita, Kansas


PROJECT NO.	SHEET NO.	TOTAL SHEETS
448-76-245-81507-000-000-001	11	15

MANHOLE COVER

Weight: 180 Lbs.

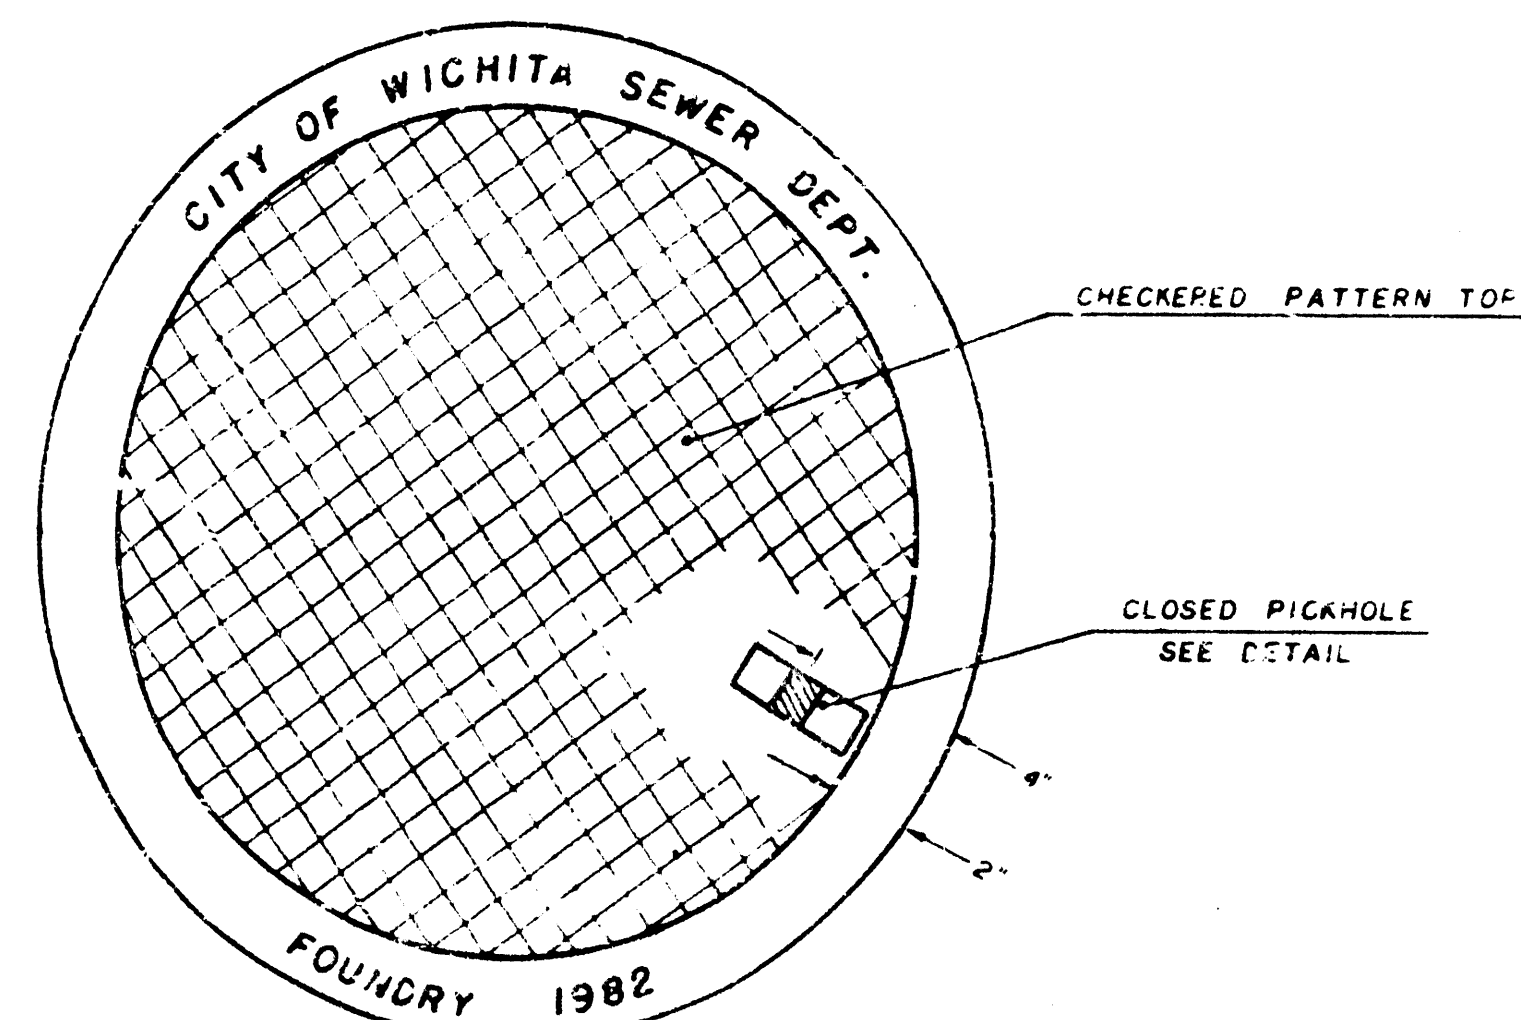


TOP VIEW

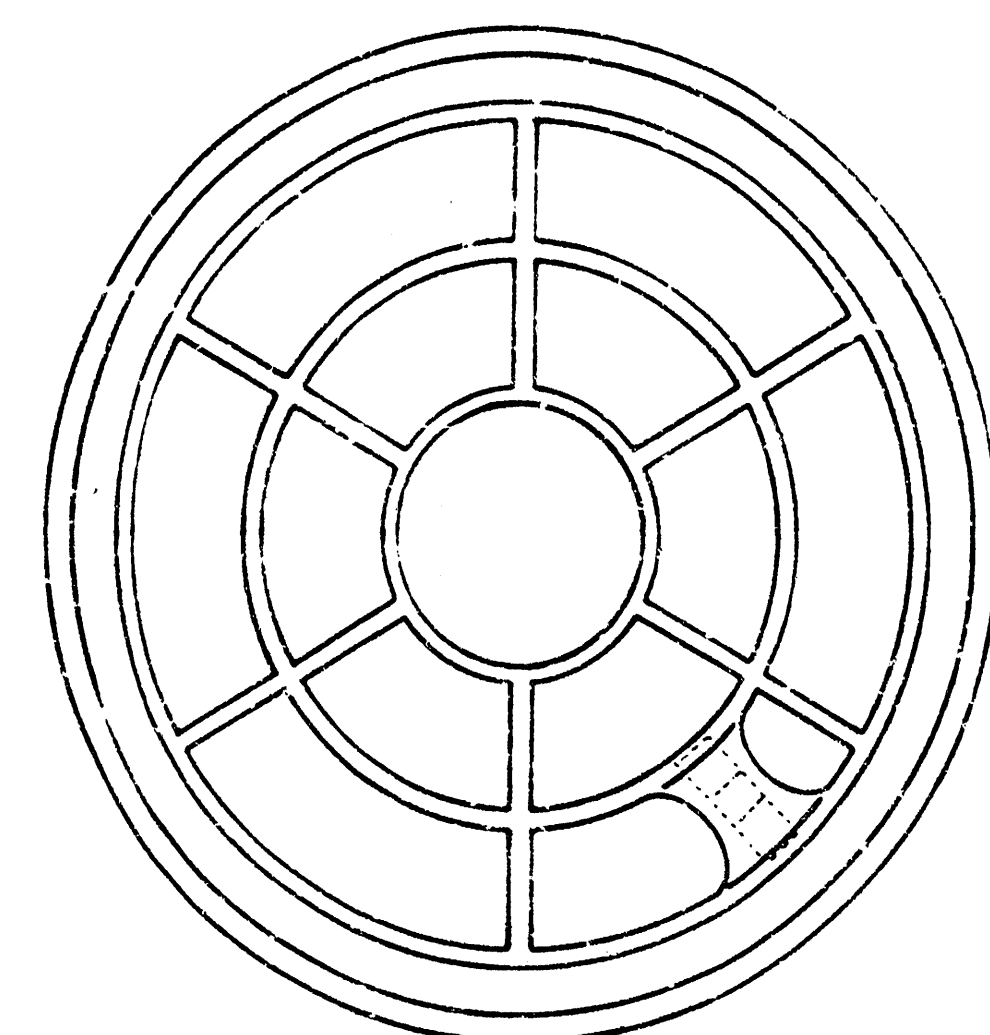


BOTTOM VIEW

PICKHOLE DETAIL

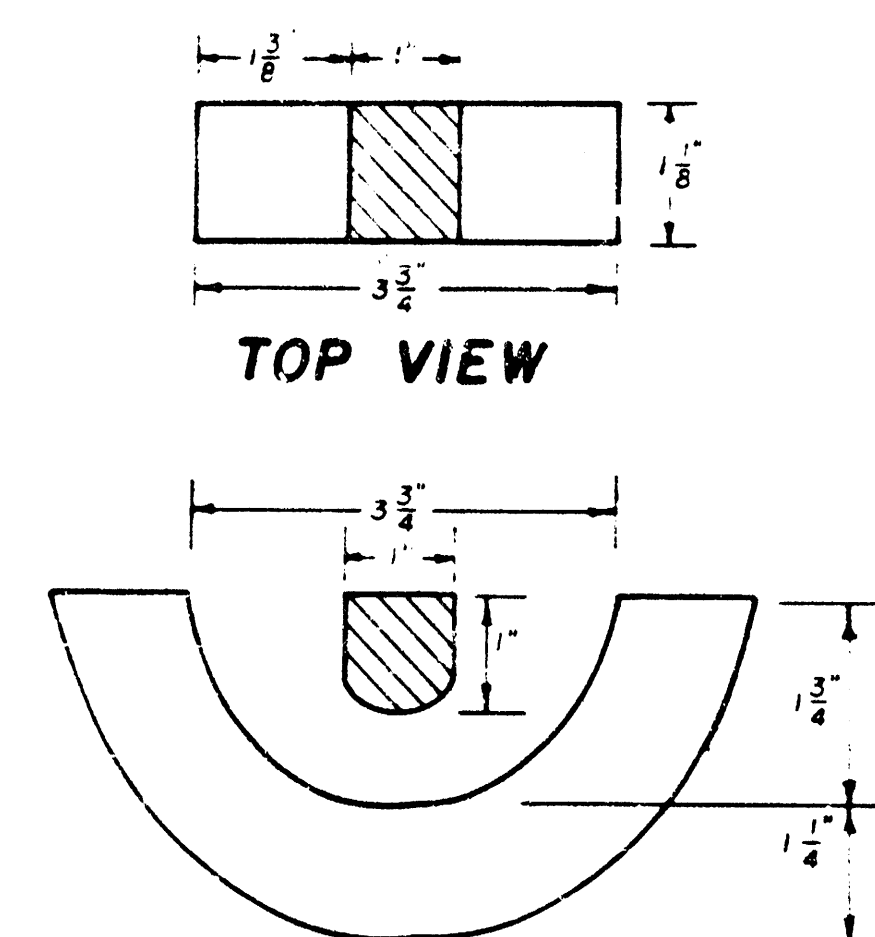

SECTION VIEW

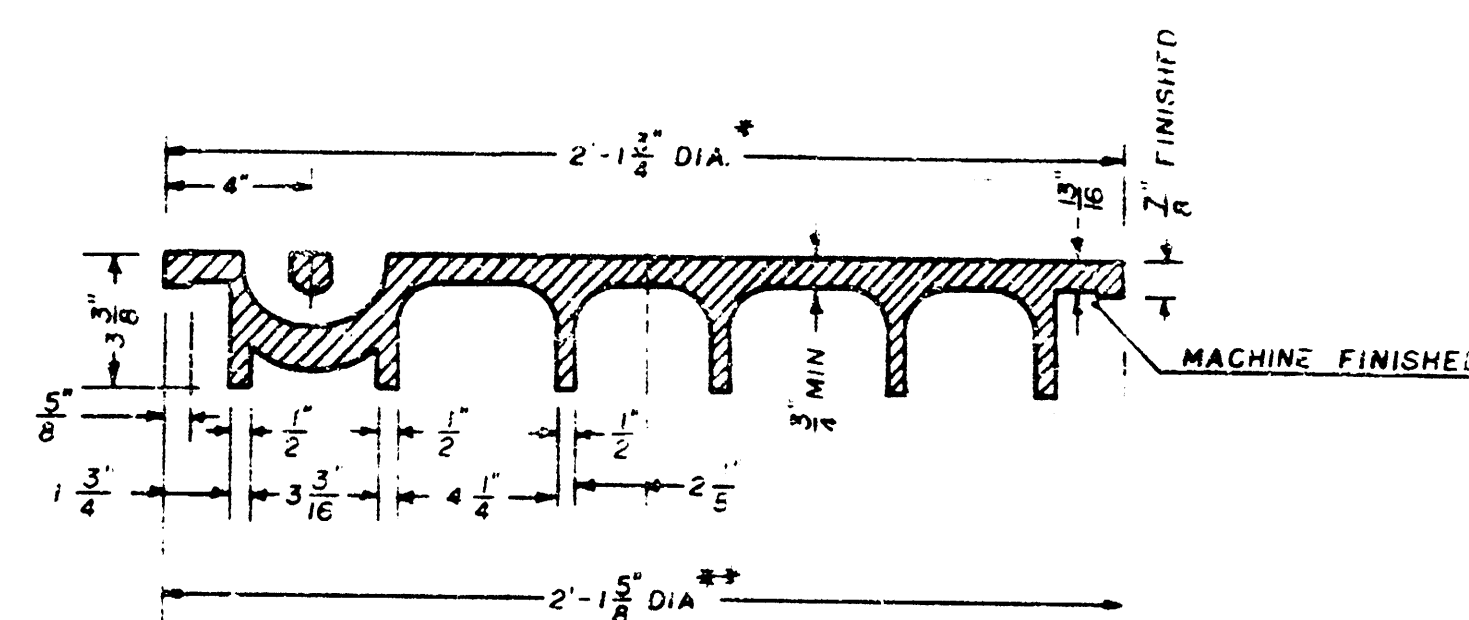


SECTION VIEW


* OUTSIDE DIA. TOP OF COVER
** OUTSIDE DIA. BOTTOM OF COVER

MANHOLE FRAME

Weight: 240 Lbs.

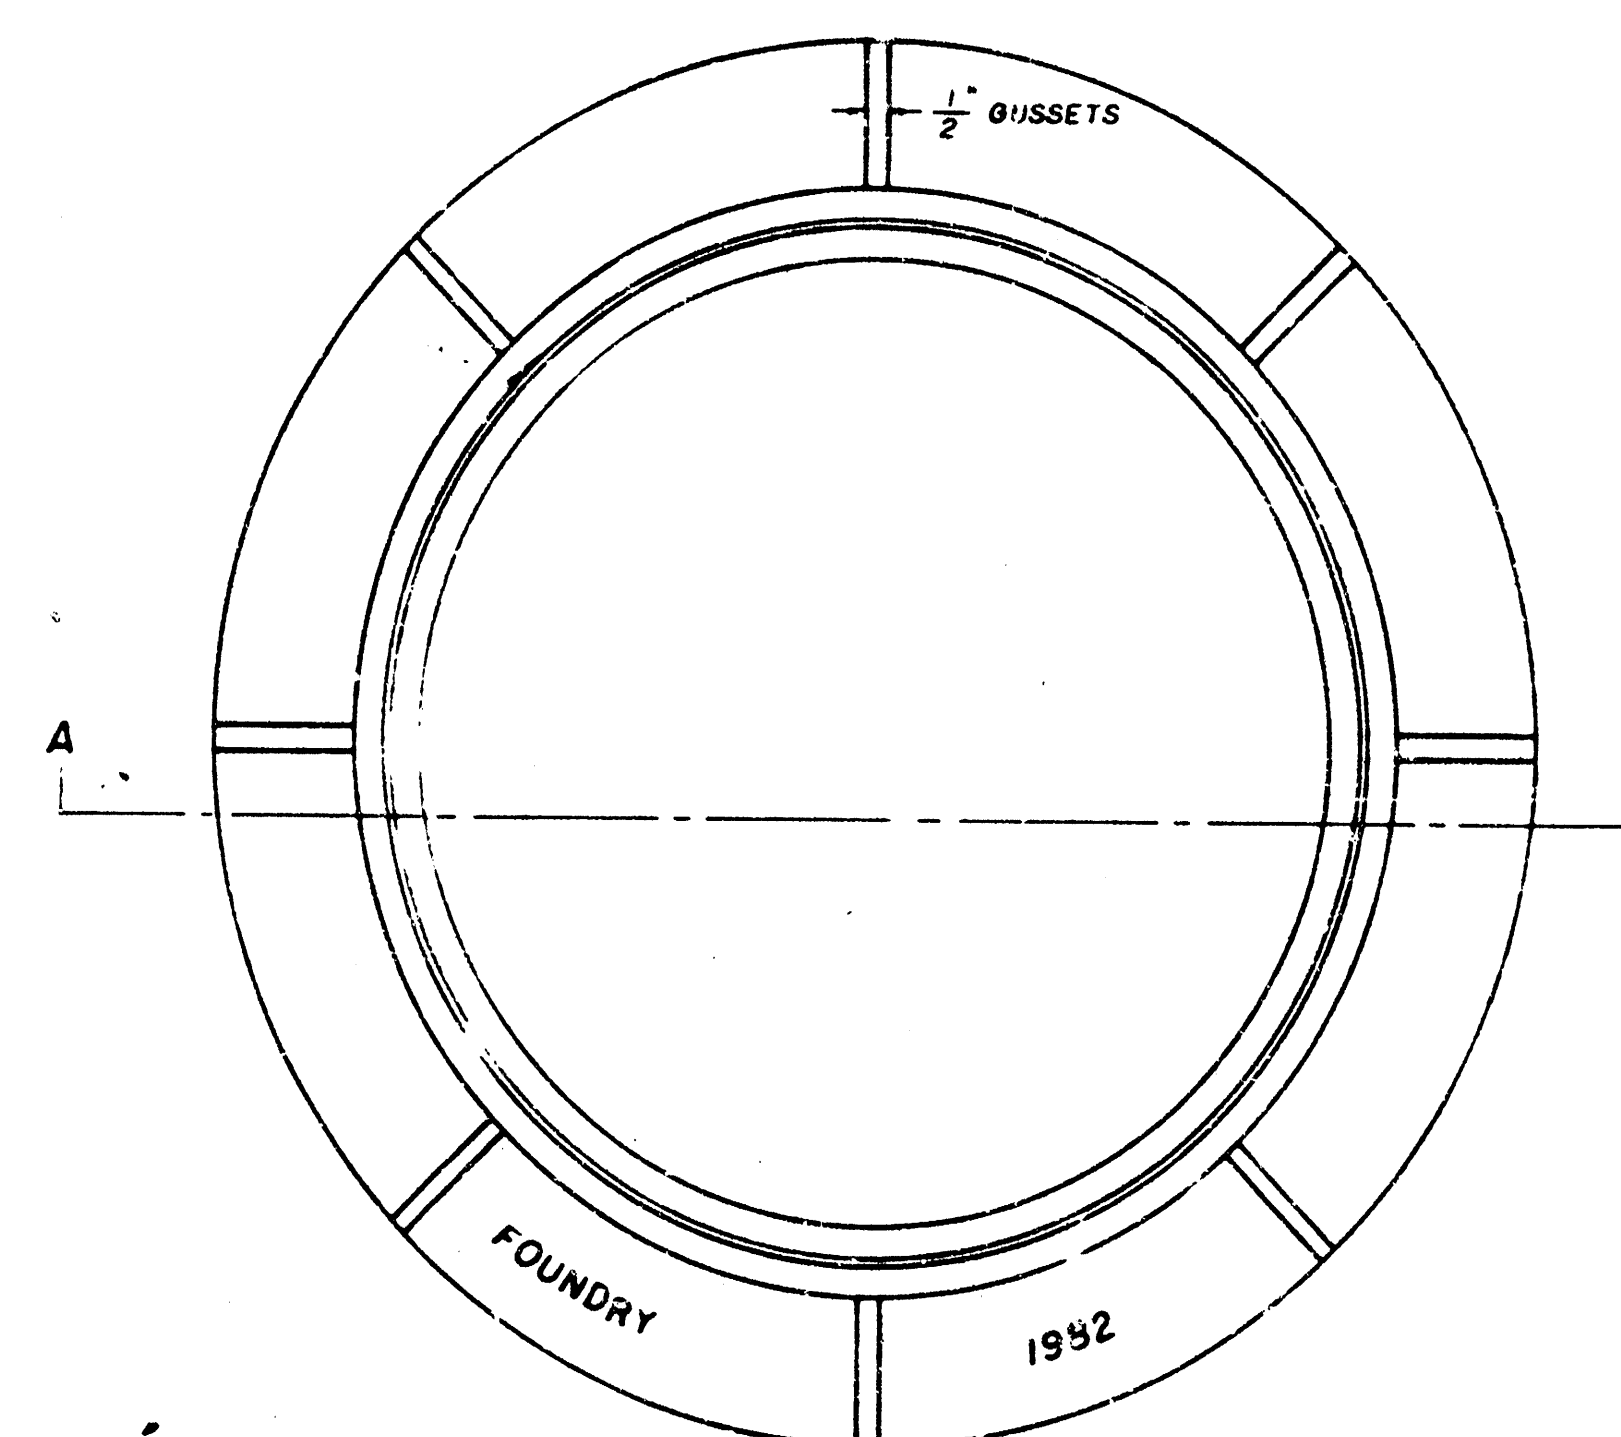




TOP VIEW

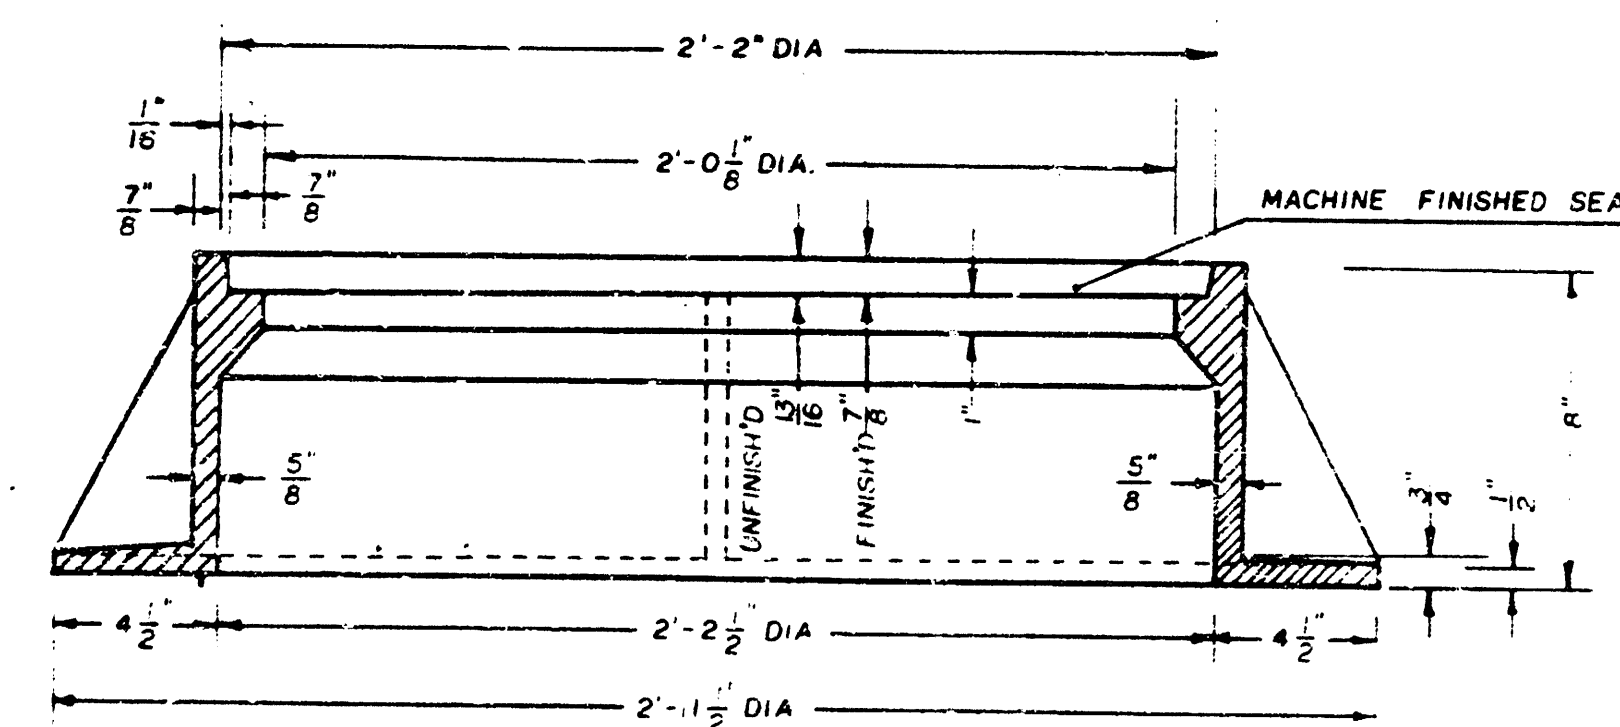

SECTION A-A


GENERAL NOTES

1. MANHOLE CASTINGS SHALL BE MANUFACTURED USING GOOD QUALITY GRAY IRON CONFORMING TO CLASS 30 OF A S.T.M. DESIGNATION A-48. DIMENSIONS AND WEIGHTS SHOWN ON THE DETAILED DRAWINGS SHALL BE CONSIDERED AS MINIMUM REQUIREMENTS AND ANY DEVIATIONS FROM THE DIMENSIONS SHOWN MUST BE SPECIFICALLY APPROVED. THE FINISHED CASTINGS SHALL BE OF UNIFORM QUALITY, FREE FROM BLOWHOLES, POROSITY, HARD SPOTS, SHRINKAGE DISTORTIONS OR OTHER DEFECTS.
2. MANHOLE CASTINGS SHALL BE COATED WITH AN ASPHALT PAINT RESULTING IN A SMOOTH, TOUGH AND TENACIOUS COATING WHICH IS NOT BRITTLE OR TACKY.
3. MANHOLE CASTINGS SHALL BE MANUFACTURED SUCH THAT A COVER MANUFACTURED BY ANY ONE FOUNDRY WILL FIT INTERCHANGEABLY INTO A FRAME MANUFACTURED BY ANOTHER FOUNDRY AND STILL MEET ALLOWABLE CLEARANCES AND NON-ROCKING REQUIREMENTS. THIS WILL REQUIRE MANUFACTURING OF THE MATCHING FACES ON THE COVER AND THE FRAME TO CLOSE TOLERANCES.
4. THE OUTSIDE CIRCUMFERENCE OF THE VERTICAL FACE OF THE COVER AND THE INSIDE CIRCUMFERENCE OF THE VERTICAL FACE IN THE FRAME RECESS SHALL BE MANUFACTURED TO TOLERANCES SUCH THAT THE CLEARANCE BETWEEN THE COVER AND FRAME WILL NOT EXCEED 1/8" AT ANY POINT AROUND THE CIRCUMFERENCE OF THE COVER. THE SEATING SURFACES BETWEEN THE COVER AND FRAME SHALL BE MACHINED SUCH THAT THESE SURFACES SHALL MAKE FULL CONTACT FOR THEIR FULL CIRCUMFERENCE TO PRECLUDE THE COVER FROM ROCKING IN THE FRAME.
5. THE MANHOLE FRAME AND COVER SHALL BE MARKED WITH LETTERING INDICATING THE NAME OF THE MANUFACTURER AND THE YEAR WHEN THE COVER OR FRAME WAS CAST. THE COVER SHALL BE FURTHER IDENTIFIED WITH REGARDS TO OWNERSHIP USING LETTERS AT LEAST 1" IN HEIGHT. THIS IDENTIFICATION SHALL BE "CITY OF WICHITA SEWER DEPARTMENT". THE WORD DEPARTMENT MAY BE ABBREVIATED. THE TEXTURE OF THE TOP SURFACE OF THE COVER SHALL BE MANUFACTURED IN A CHECKERED PATTERN DESIGN AS INDICATED ON THE DRAWINGS. SMOOTH BLOCKOUTS SHALL BE UTILIZED TO HIGHLIGHT THE LETTERING ON THE COVER SURFACE. THE TOTAL AREA OF SMOOTH SURFACE BLOCKOUT SHALL NOT EXCEED THE AREA AS INDICATED ON THE DRAWING. POSITIONING OF SMOOTH BLOCKOUTS AND LETTERING MAY VARY FROM THAT SHOWN ON THE DETAILED DRAWING.

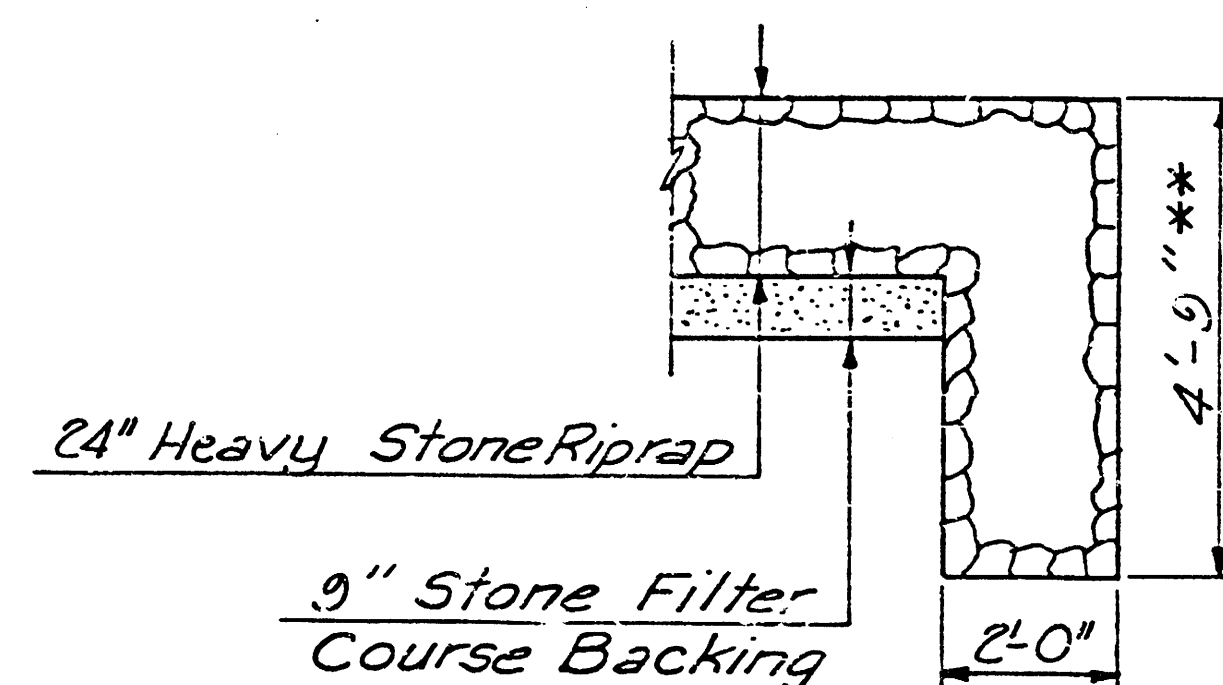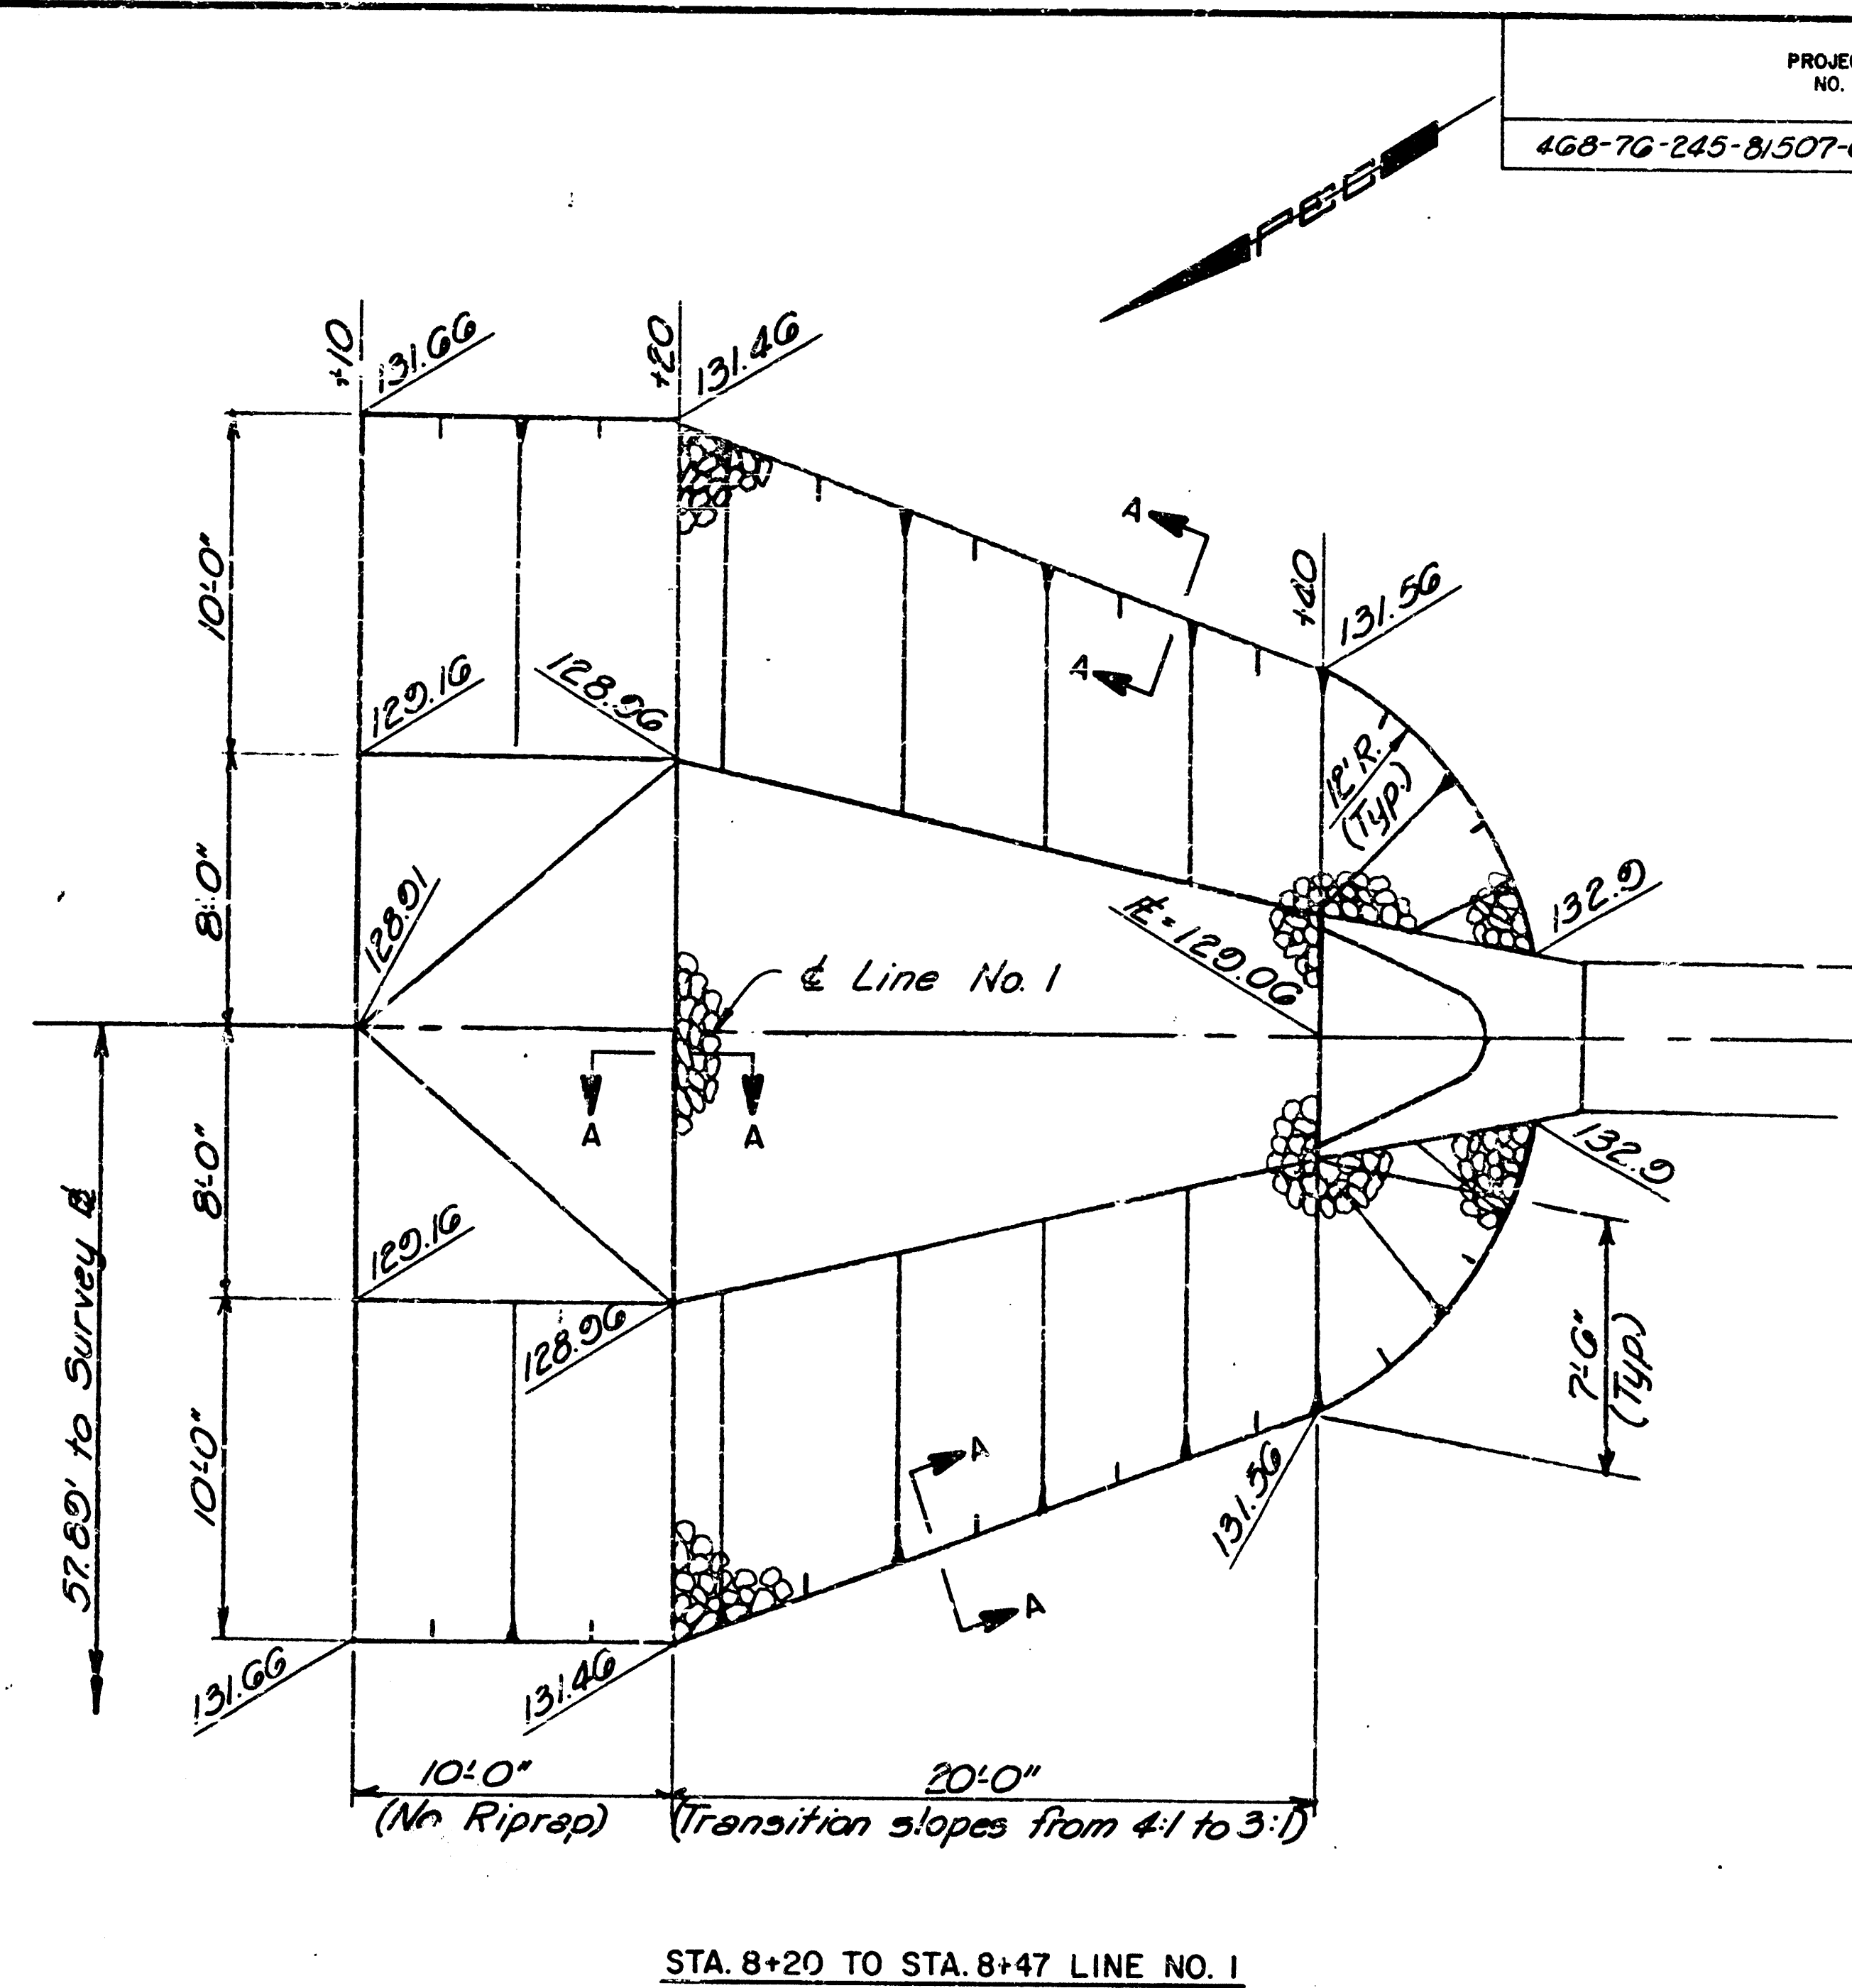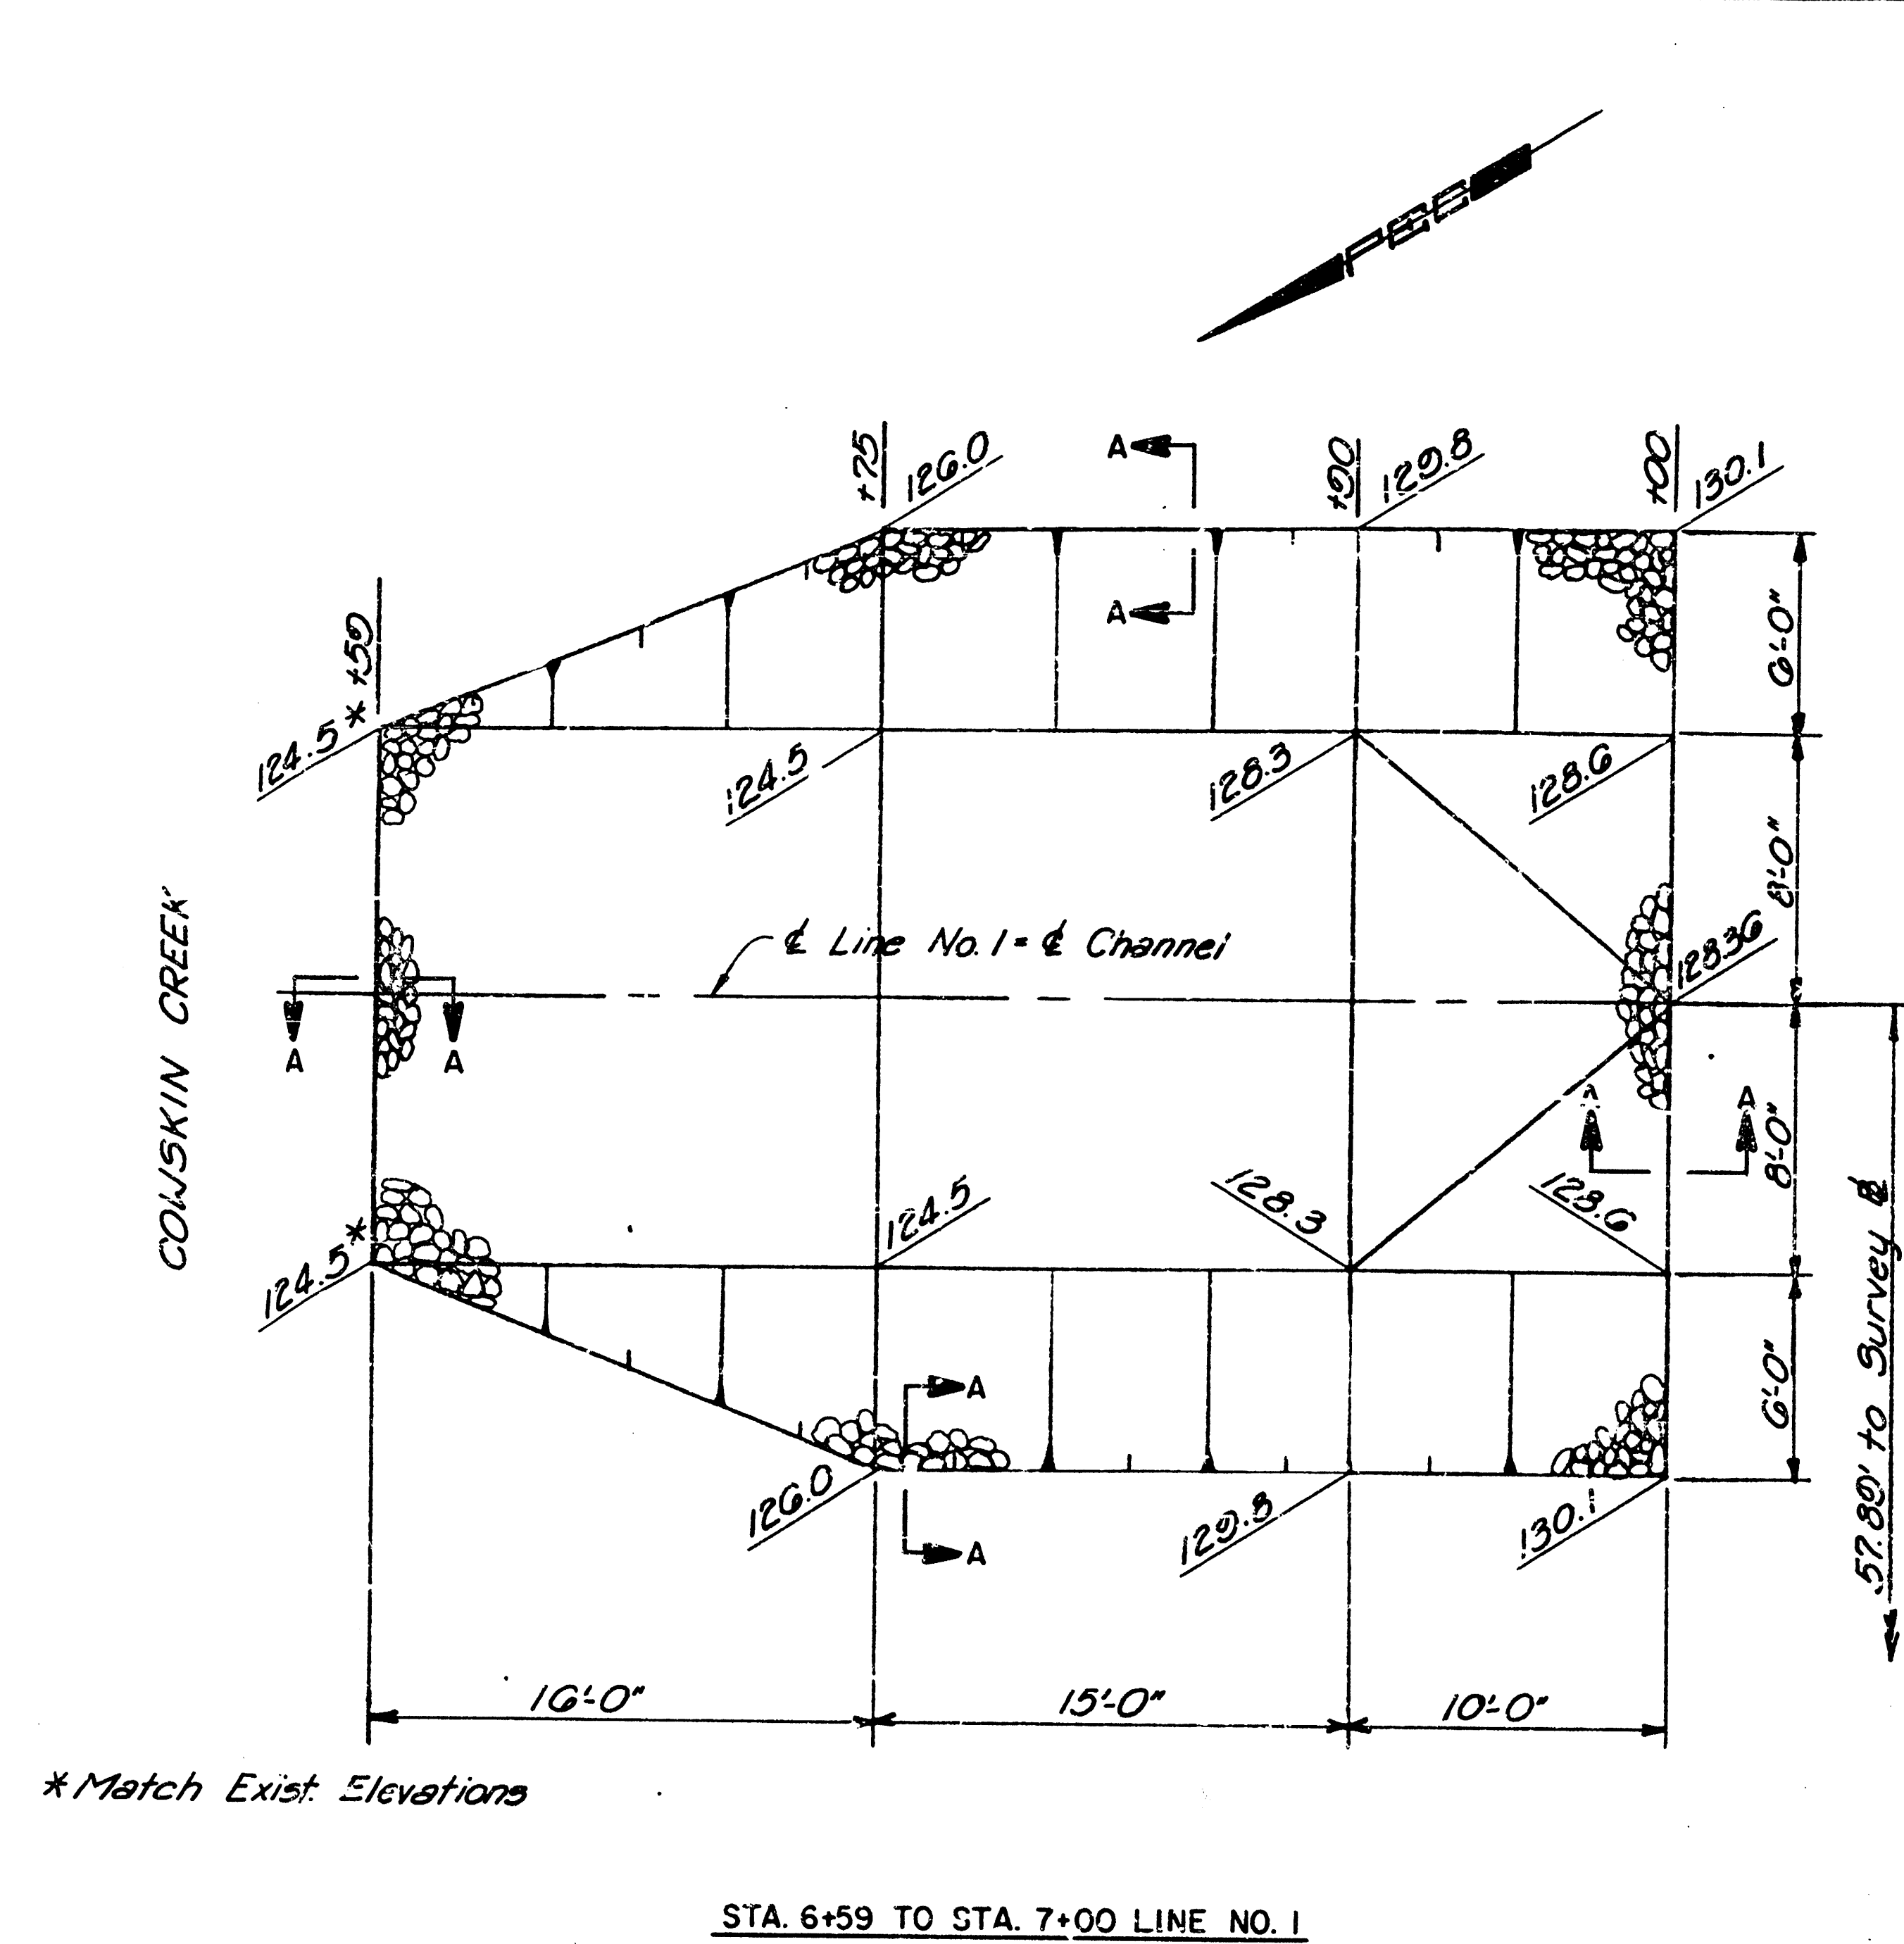

SECTION A-A
(TYPICAL)

** No additional payment will be made for additional thickness for toe walls.

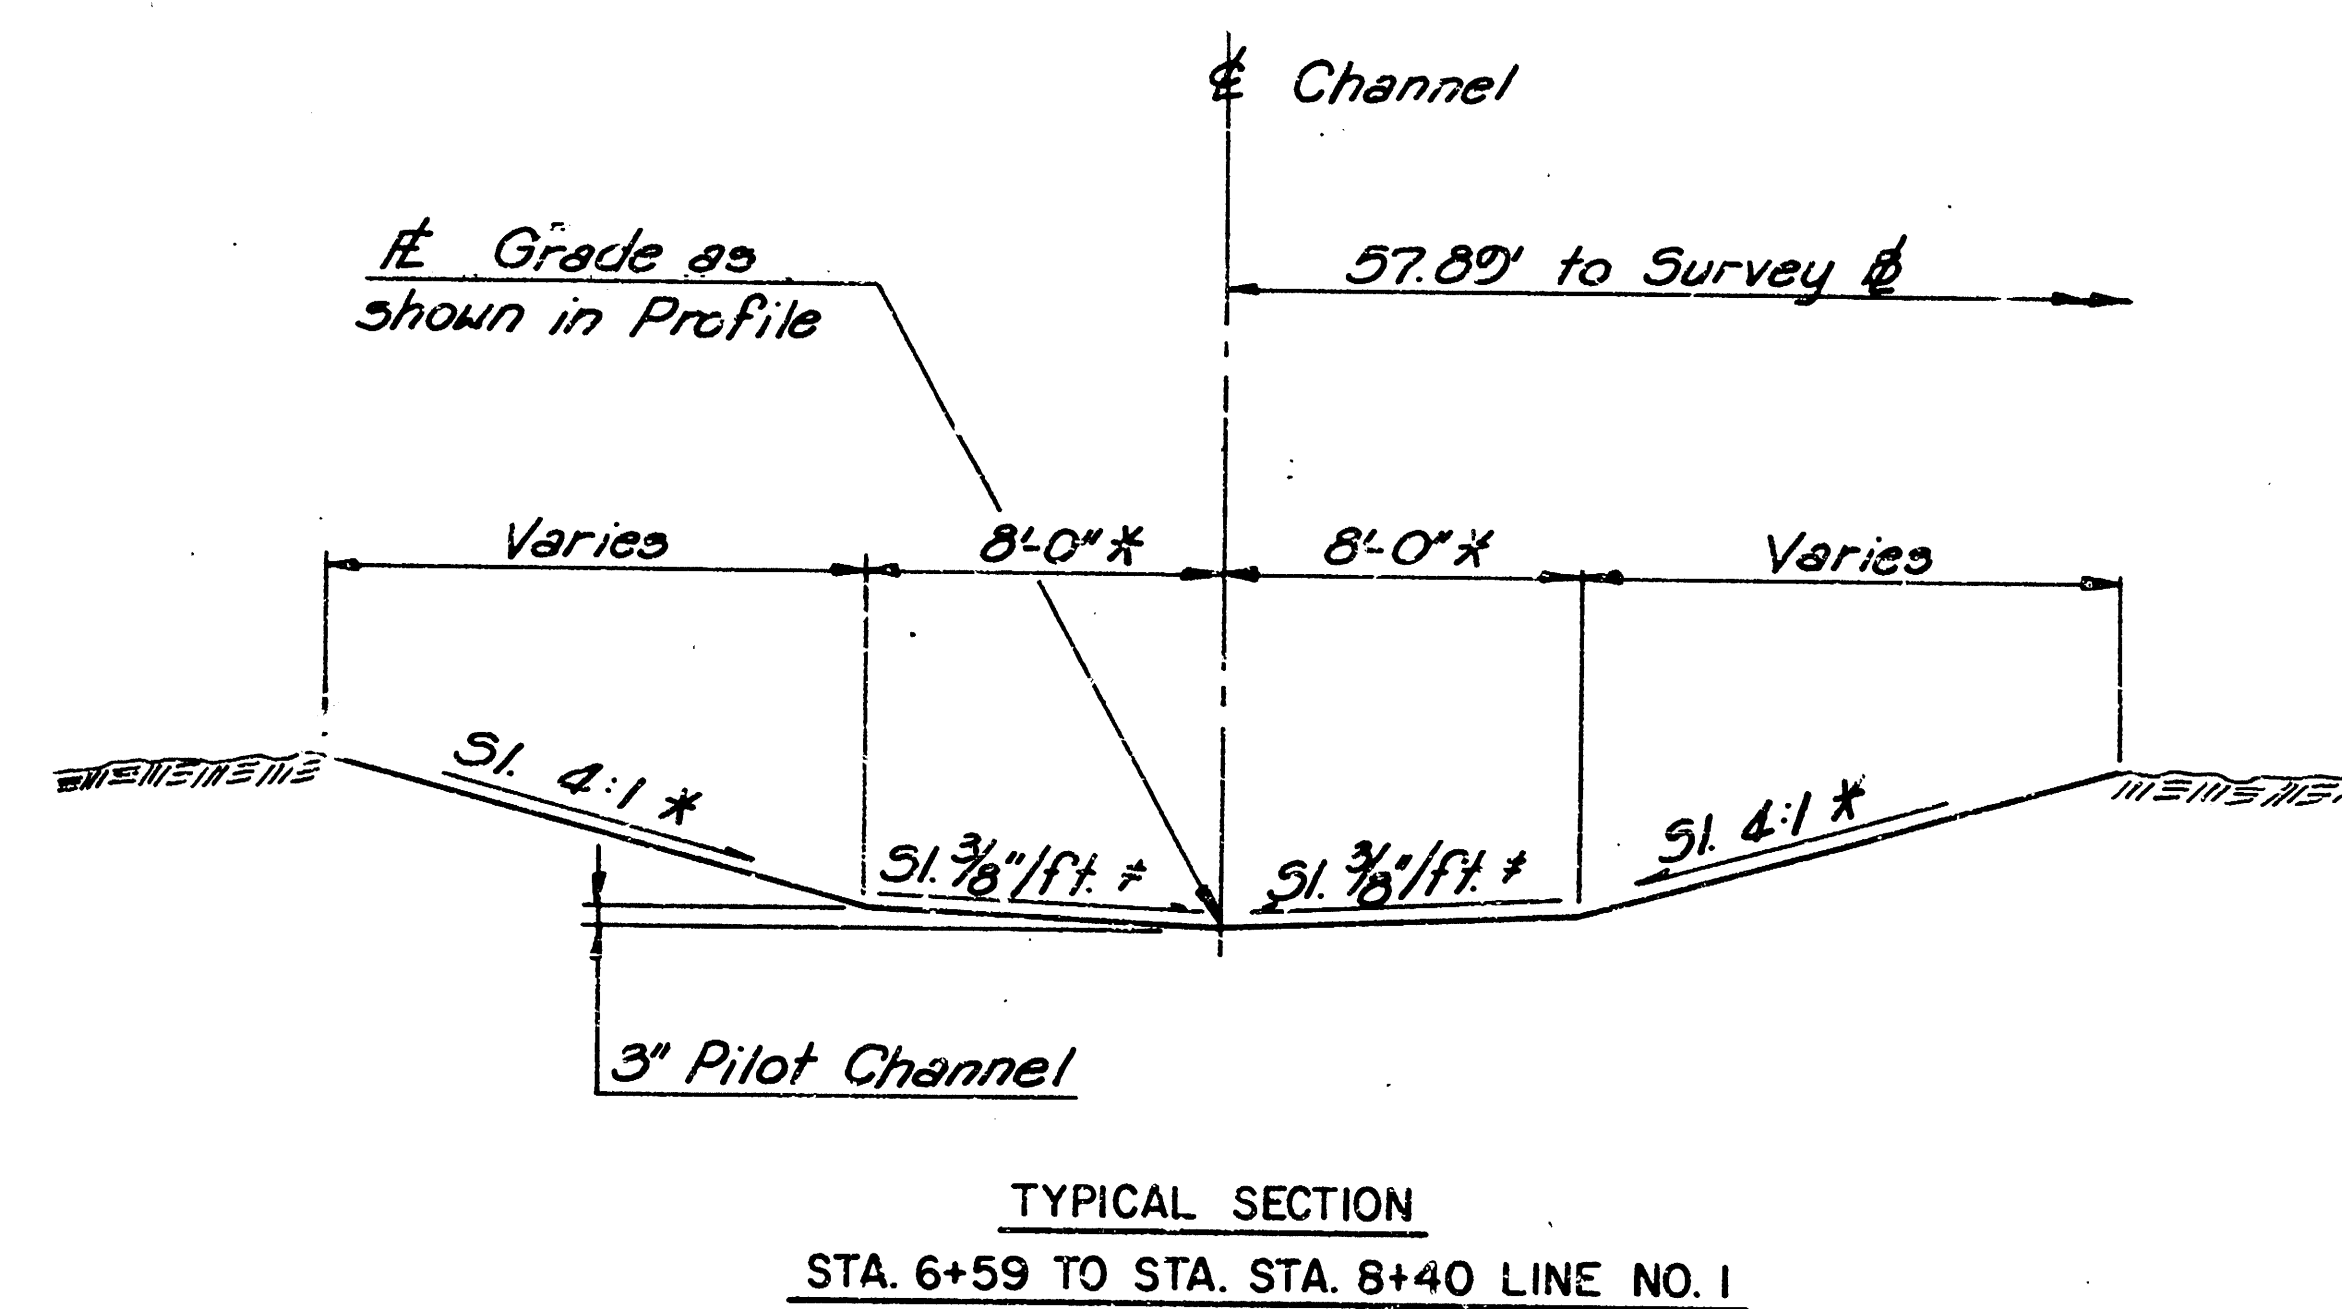


* Varies thru transition section
Sta. 8+20 to Sta. 8+40.

* Level Sta. 6+59 to Sta. 6+90 &
Sta. 8+20 to Sta. 8+40.
Varies Sta. 6+90 to Sta. 7+00 &
Sta. 8+10 to Sta. 8+20.

CHANNEL AND
RIPRAP DETAILS

PROJECT NO.					
468-76-245-81507-000-000-001					
SHEET NO.		TOTAL SHEETS			
12		13			
DESIGNED BY M.W.B.					
DRAWN BY V.J.K.					
DATE April, 1986					
JOB NO. 86107					

PROJECT CONSTRUCTION SIGN LAY-OUT DETAILS		
CITY OF WICHITA, KANSAS		
M. E. LINDEBAK CITY ENGINEER	DATE: 8/3/88 DRAWN BY: SPAL	13/15 NO SCALE

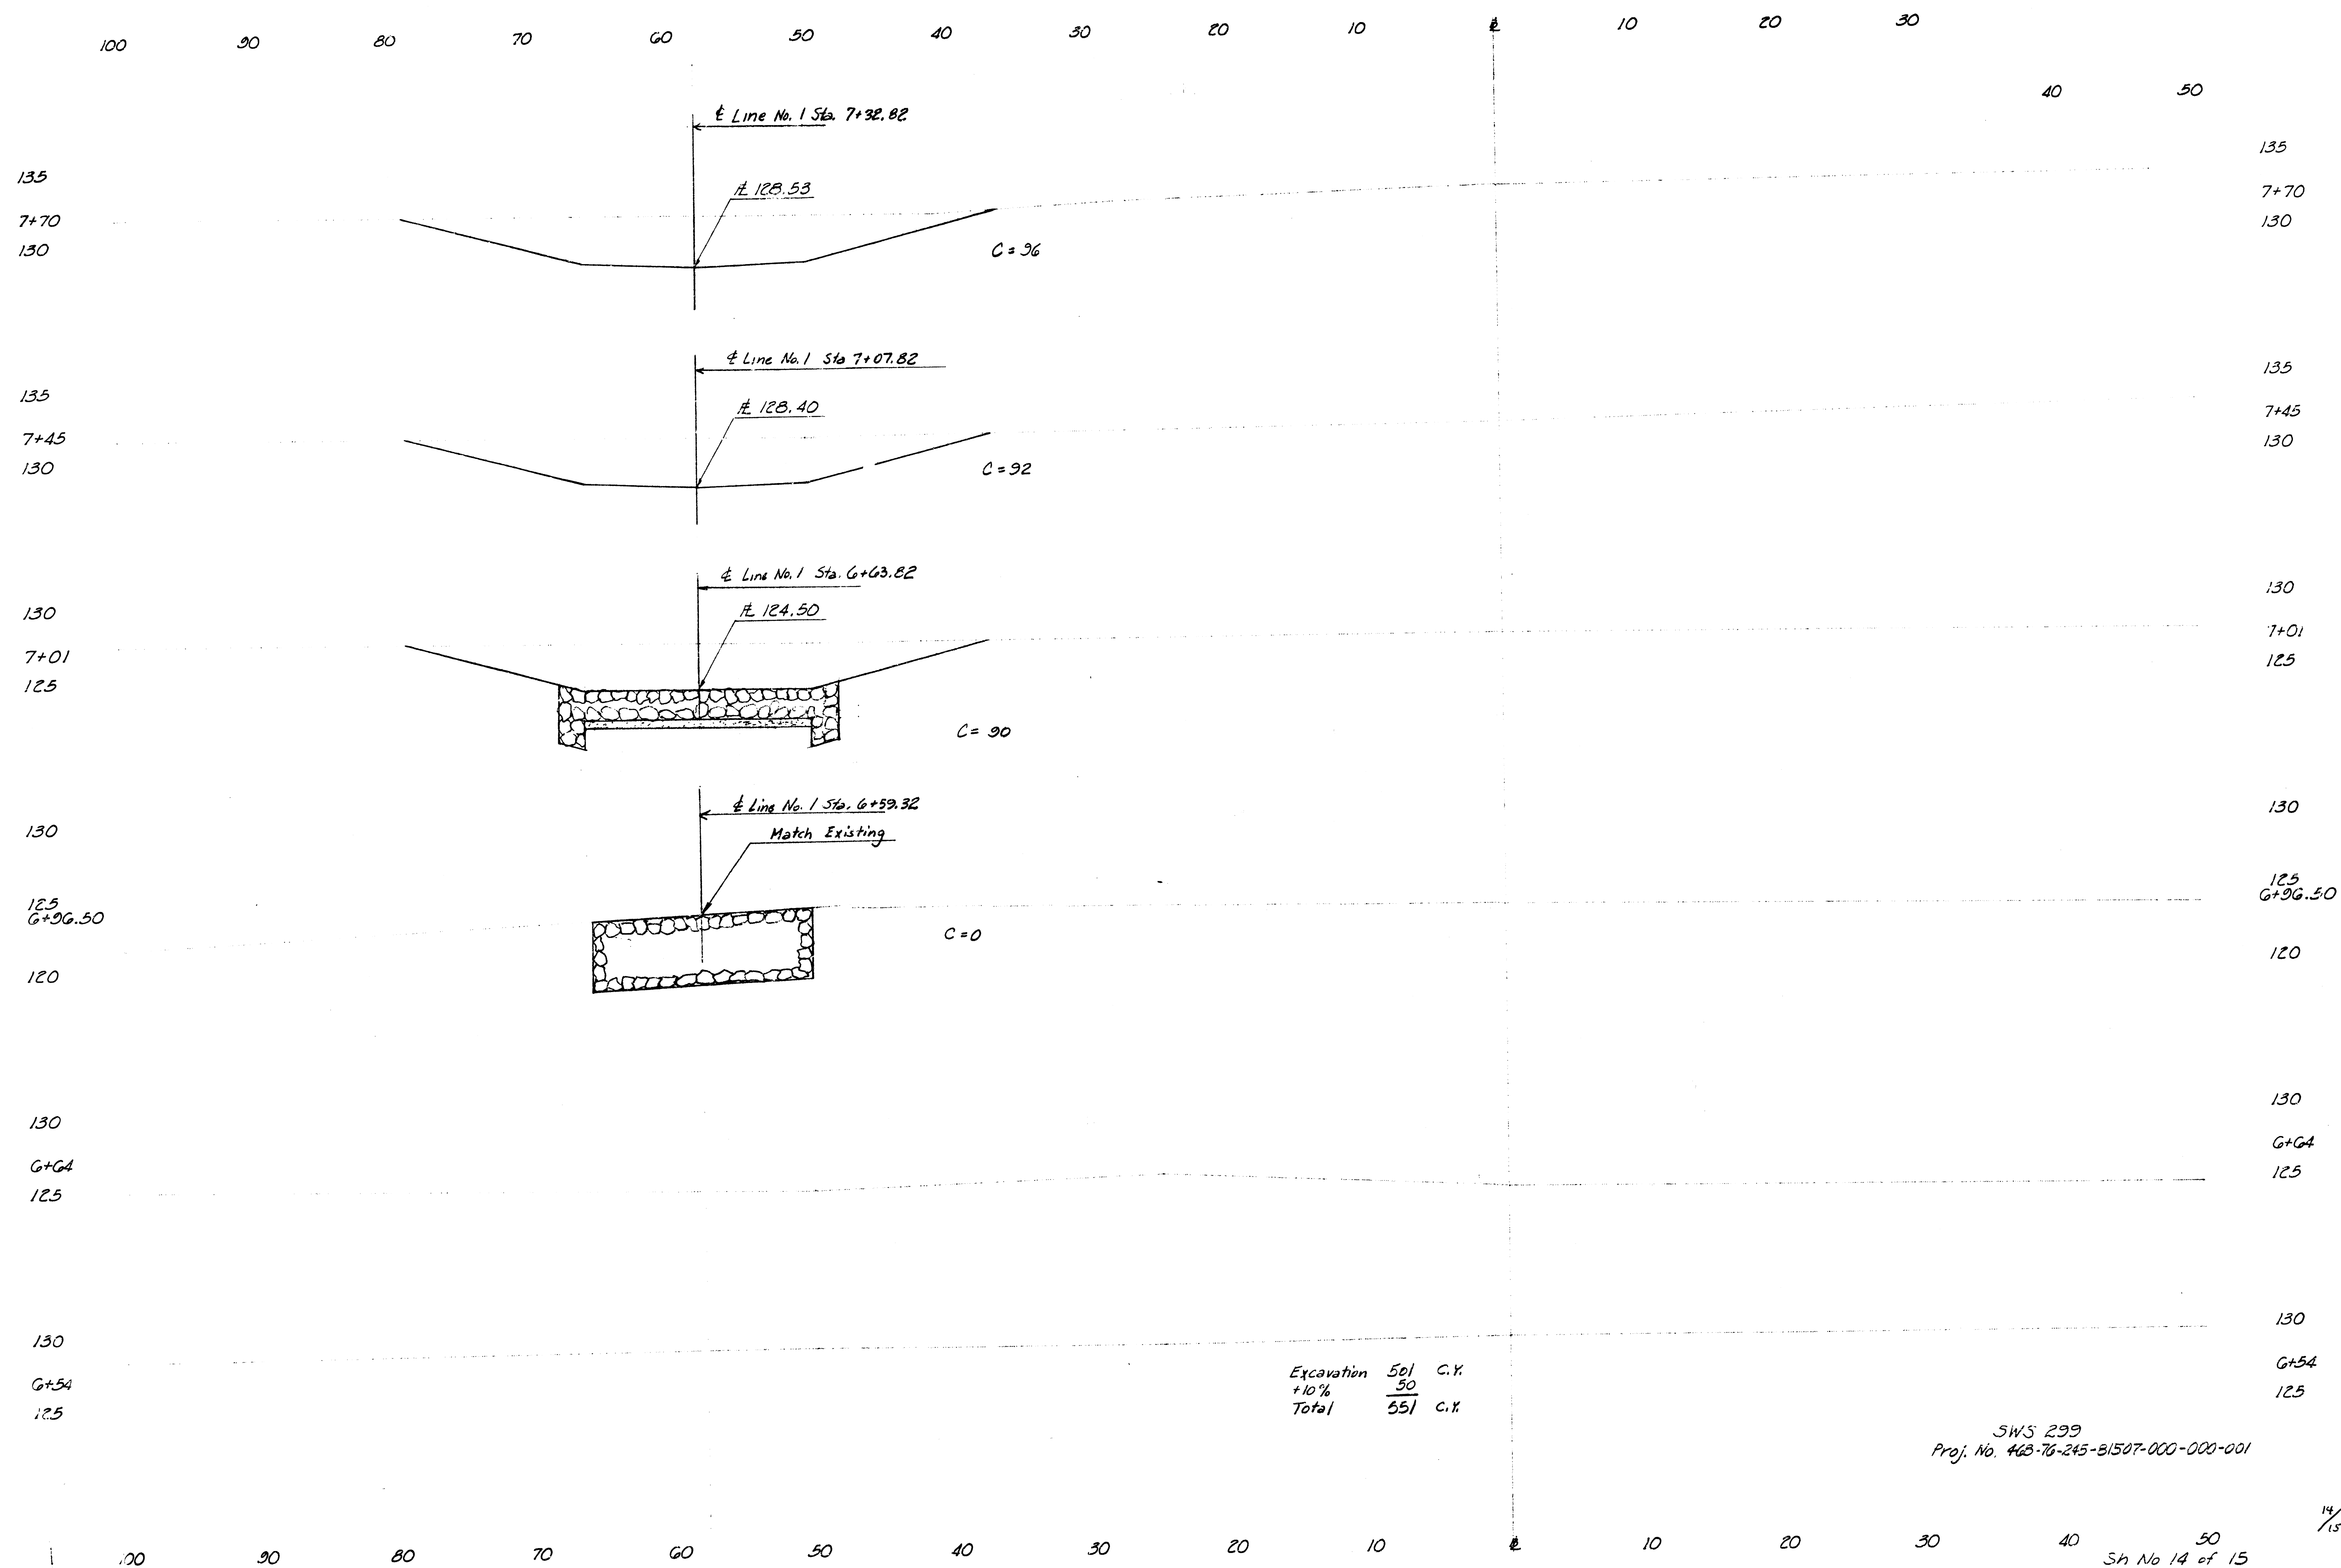

SW5 299
Proj. No. 468-76-245-B/507-000-000-001

$$\frac{14}{15}$$

