

CITY OF WICHITA, KANSAS

MICHAEL E. LINDEBAK, P.E., CITY ENGINEER

STORM WATER SEWER NO. 332

TALLGRASS EAST ADDITION

CITY OF WICHITA PROJECT NO. 468-76-245-81661-000-000-001

INDEX OF SHEETS

1. TITLE SHEET
2. PLAN
- 3.-7. PLAN AND PROFILE SHEETS
8. TYPICAL DITCH SECTIONS AND RIPRAP DETAILS
9. DETAIL STANDARD TYPE 1A CURB INLET (L-111'-4")
10. DETAIL STANDARD TYPE 1A CURB INLET (L-6'-4")
11. MANHOLE FRAME AND COVER DETAIL
- 12.-13. DITCH CROSS SECTIONS AND DETAIL


PROJECT SURVEY CONTROL

- VERTICAL DATUM: CITY OF WICHITA DATUM
- DATUM BENCH MARK: C.O.W. DISC 44' SOUTH AND 40' EAST OF
E WEBB RD. AND 21ST STREET NORTH. ELEV. +205.24
- BENCH MARK NO. 1: CHISELED "D" N.E. CORNER HEADWALL R.C.B. APPROX.
1050' EAST OF WEBB ROAD ON 21ST STREET NORTH. ELEV. +202.55
- BENCH MARK NO. 2: CHISELED "D" TOP OF CURB AT EAST END OF E MEDIAN
ISLAND AT PLUMTHICKET CIRCLE AND WEBB ROAD. ELEV. +228.75
- BENCH MARK NO. 3: C.O.W. DISC 32' NORTH AND 28' EAST OF W. 1/4 COR.
SEC. 4, T27S, R2E AT WEBB ROAD AND 25TH STREET
NORTH. ELEV. +225.05
- BENCH MARK NO. 4: R.R. SPIKE IN N.E. FACE 12' OSAGE ORANGE APPROX.
150' LT. CLUBHOUSE DRIVE STA. 4+00. ELEV. +229.92
- BENCH MARK NO. 5: R.R. SPIKE IN EAST FACE 10' ASH APPROX. 90' RT.
CLUBHOUSE DRIVE STA. 13+80. ELEV. +214.54
- BENCH MARK NO. 6: STEP-NAIL IN SOUTH FACE LAMINATED H.L.P. APPROX.
275' EAST AND 30' NORTH OF N.E. CORNER OF
LOT 36, BLOCK 1. ELEV. +207.69

EARTHWORK

EXCAVATION	
X-SECTIONS	2,410 CU. YDS.
10X	241 CU. YDS.
TOTAL	2,651 CU. YDS.

COMPACTED FILL	
X-SECTIONS	281 CU. YDS.
10X	28 CU. YDS.
TOTAL	309 CU. YDS.

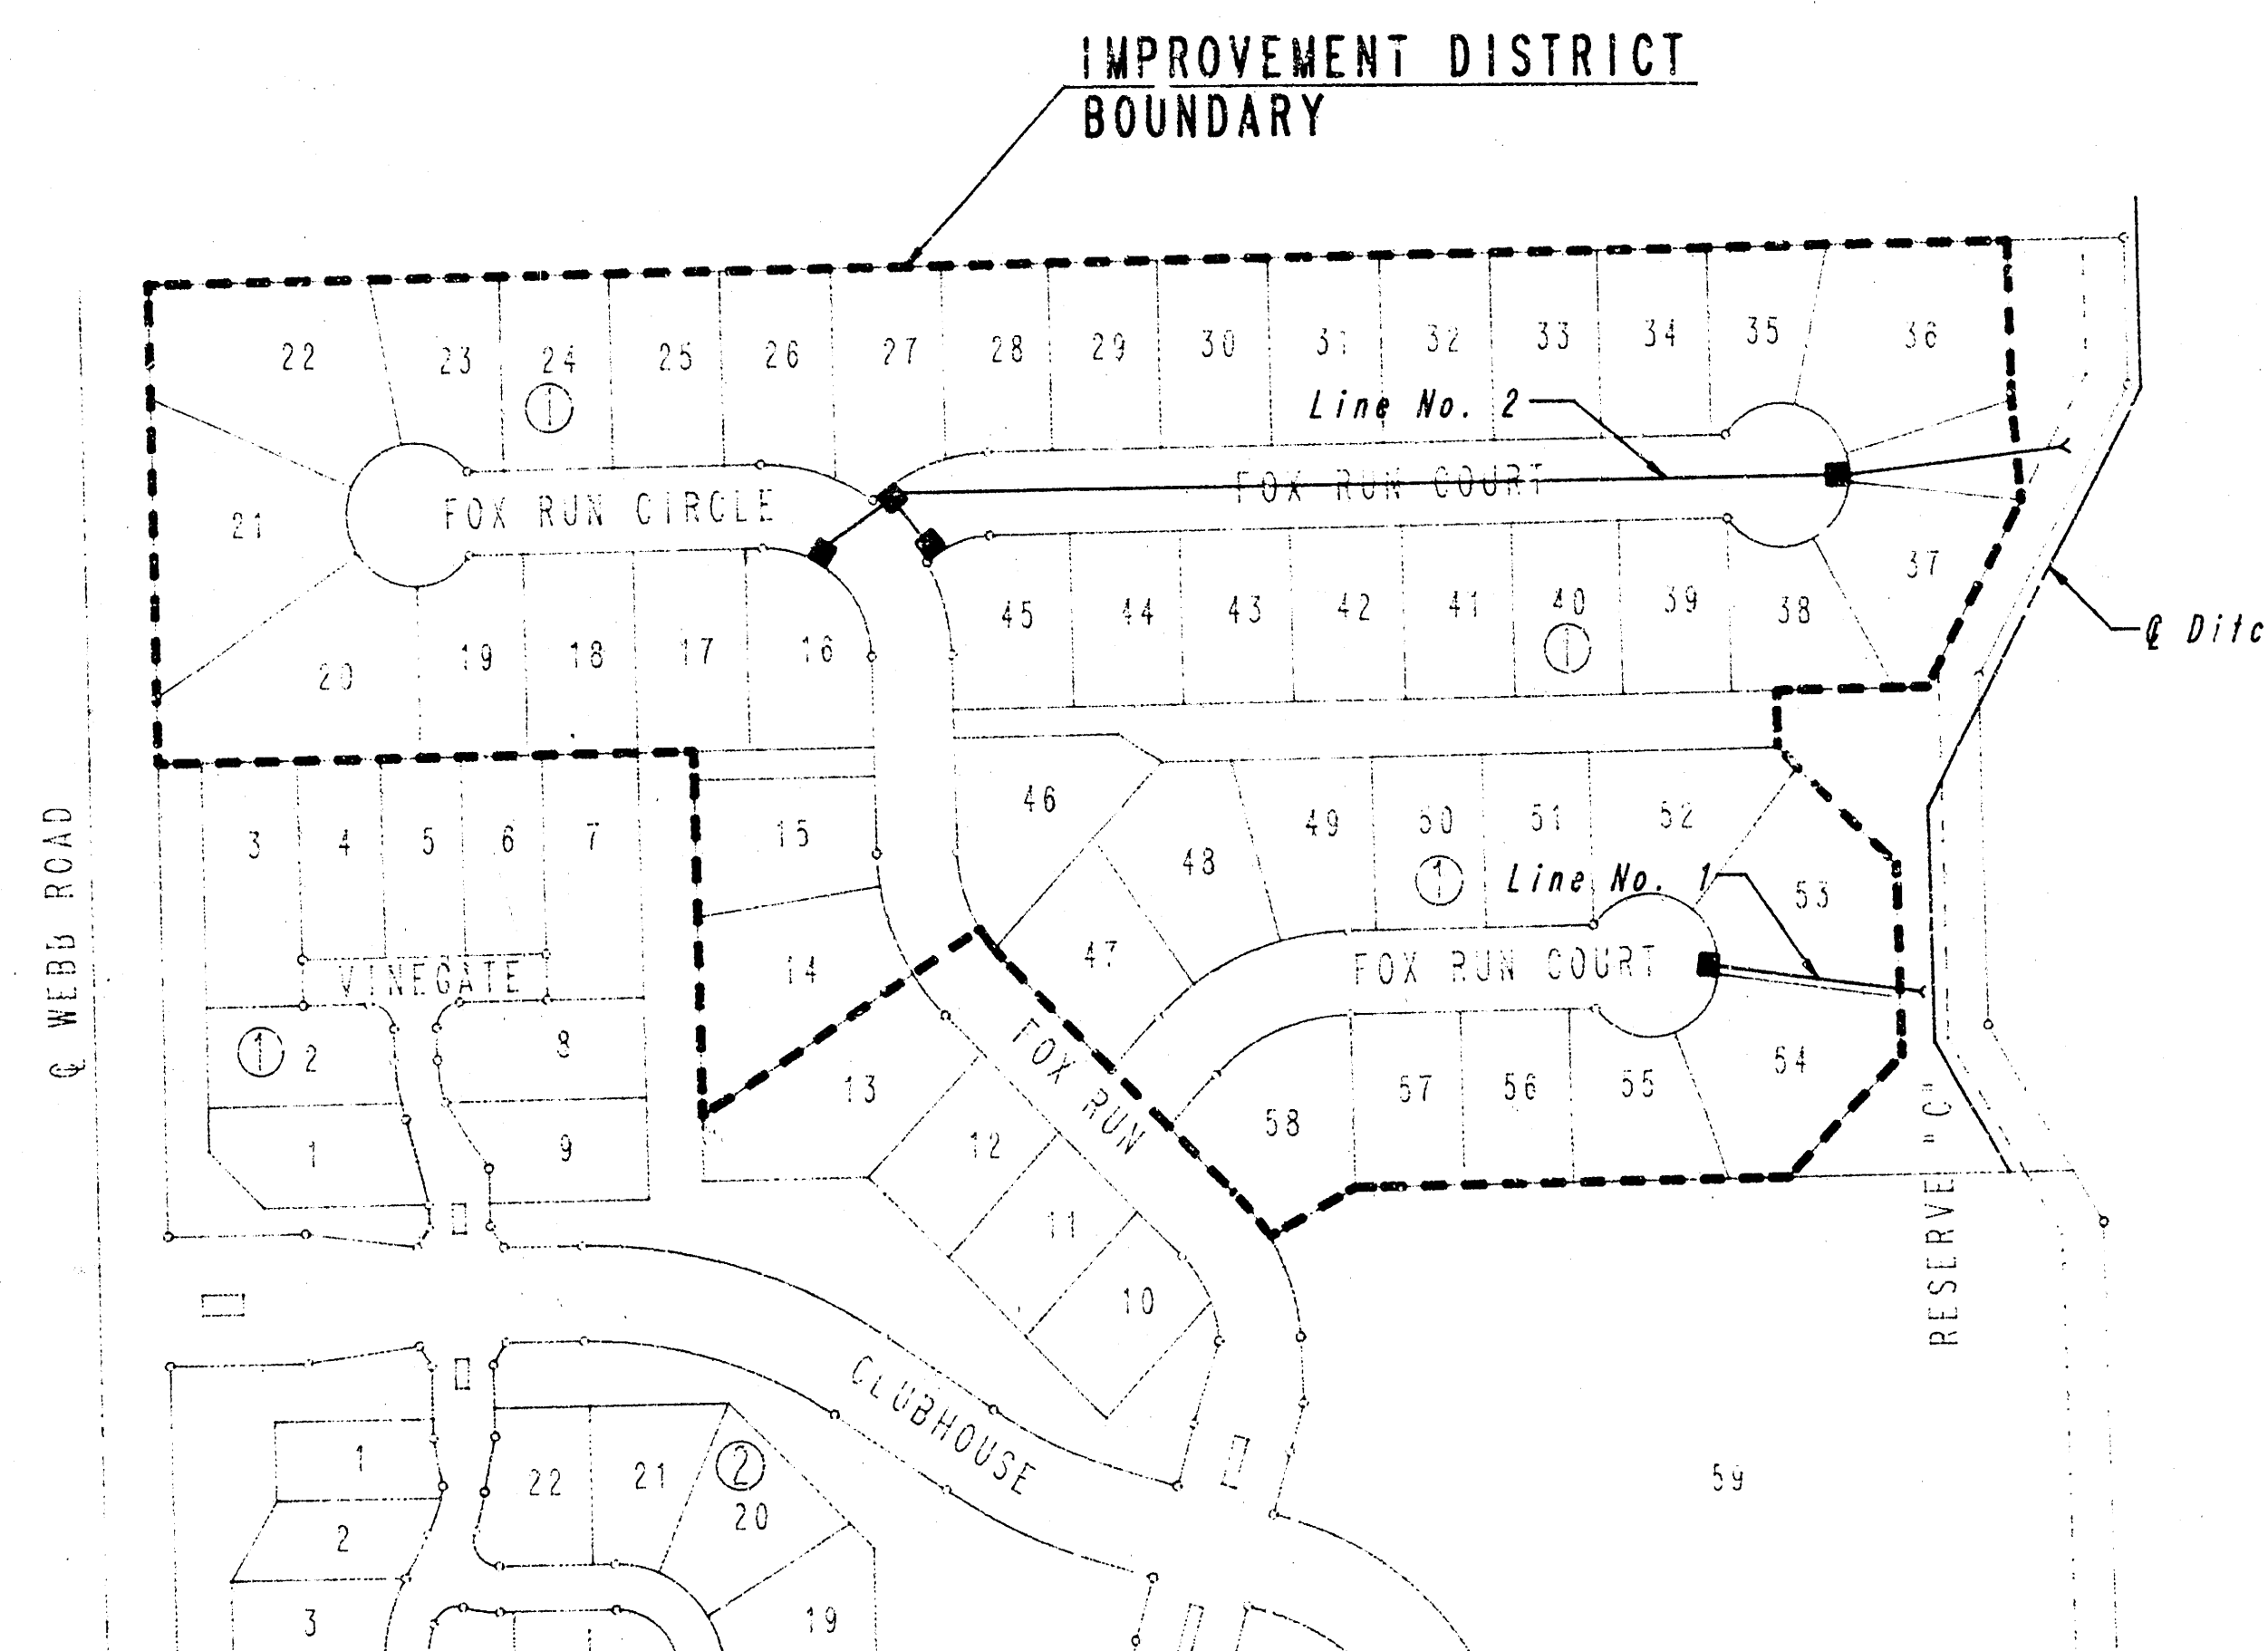

GENERAL NOTES

UNDERGROUND UTILITY SERVICE LINES AND OVERHEAD UTILITY POLE LINES ARE TO BE ADJUSTED AS NECESSARY BY OTHERS PRIOR TO CONSTRUCTION UNLESS THE PLANS SPECIFICALLY CALL FOR THEIR ADJUSTMENT BY THE CONTRACTOR. EXISTING UTILITIES AND THEIR LOCATION, AS SHOWN ON THE PLANS, REPRESENT THE BEST INFORMATION OBTAINABLE FOR DESIGN. LOCATION INFORMATION HAS BEEN OBTAINED FROM THE VARIOUS UTILITY COMPANIES AND IS EITHER FROM COMPANY RECORD DRAWINGS OR COMPANY PROVIDED FIELD LOCATIONS. THE CONTRACTOR WILL BE REQUIRED TO WORK AROUND EXISTING UTILITIES WITHIN THE RIGHT-OF-WAY WHICH DO NOT CONFLICT WITH PROPOSED CONSTRUCTION.


THE CONTRACTOR SHALL FERTILIZE, SEED AND MULCH THE DRAINAGE DITCH WITHIN RESERVE "C" AND ADJACENT DRAINAGE EASEMENT AS DIRECTED BY THE ENGINEER. THIS WORK SHALL BE PAID FOR AT THE UNIT PRICES BID FOR "FERTILIZING AND SEEDING" AND "MULCHING". SAID PRICES SHALL BE CONSIDERED FULL COMPENSATION FOR ALL MATERIALS, LABOR, TOOLS, EQUIPMENT, AND INCIDENTALS NECESSARY TO COMPLETE THE WORK IN ACCORDANCE WITH C.O.W. STANDARD SPECIFICATIONS. THE APPROXIMATE QUANTITY FOR THIS WORK IS 1.1 ACRE.


THE CONTRACTOR SHALL BE RESPONSIBLE FOR PRESERVING PROPERTY IRONS. THE CONTRACTOR WILL BE REQUIRED TO RE-ESTABLISH ANY PROPERTY IRONS WHICH ARE DAMAGED OR DESTROYED BY HIS CONSTRUCTION OPERATIONS. SUCH IRONS SHALL BE RE-ESTABLISHED BY A LICENSED LAND SURVEYOR OR A LICENSED PROFESSIONAL ENGINEER IN ACCORDANCE WITH STATE LAWS.

*As Built
1/88
MEG*

JUNE, 1987

PLANS PREPARED BY
PROFESSIONAL ENGINEERING CONSULTANTS, P.A.
ENGINEERS
WICHITA, KANSAS

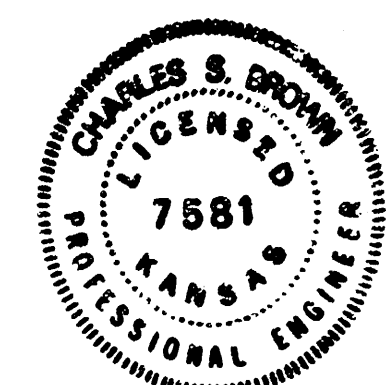

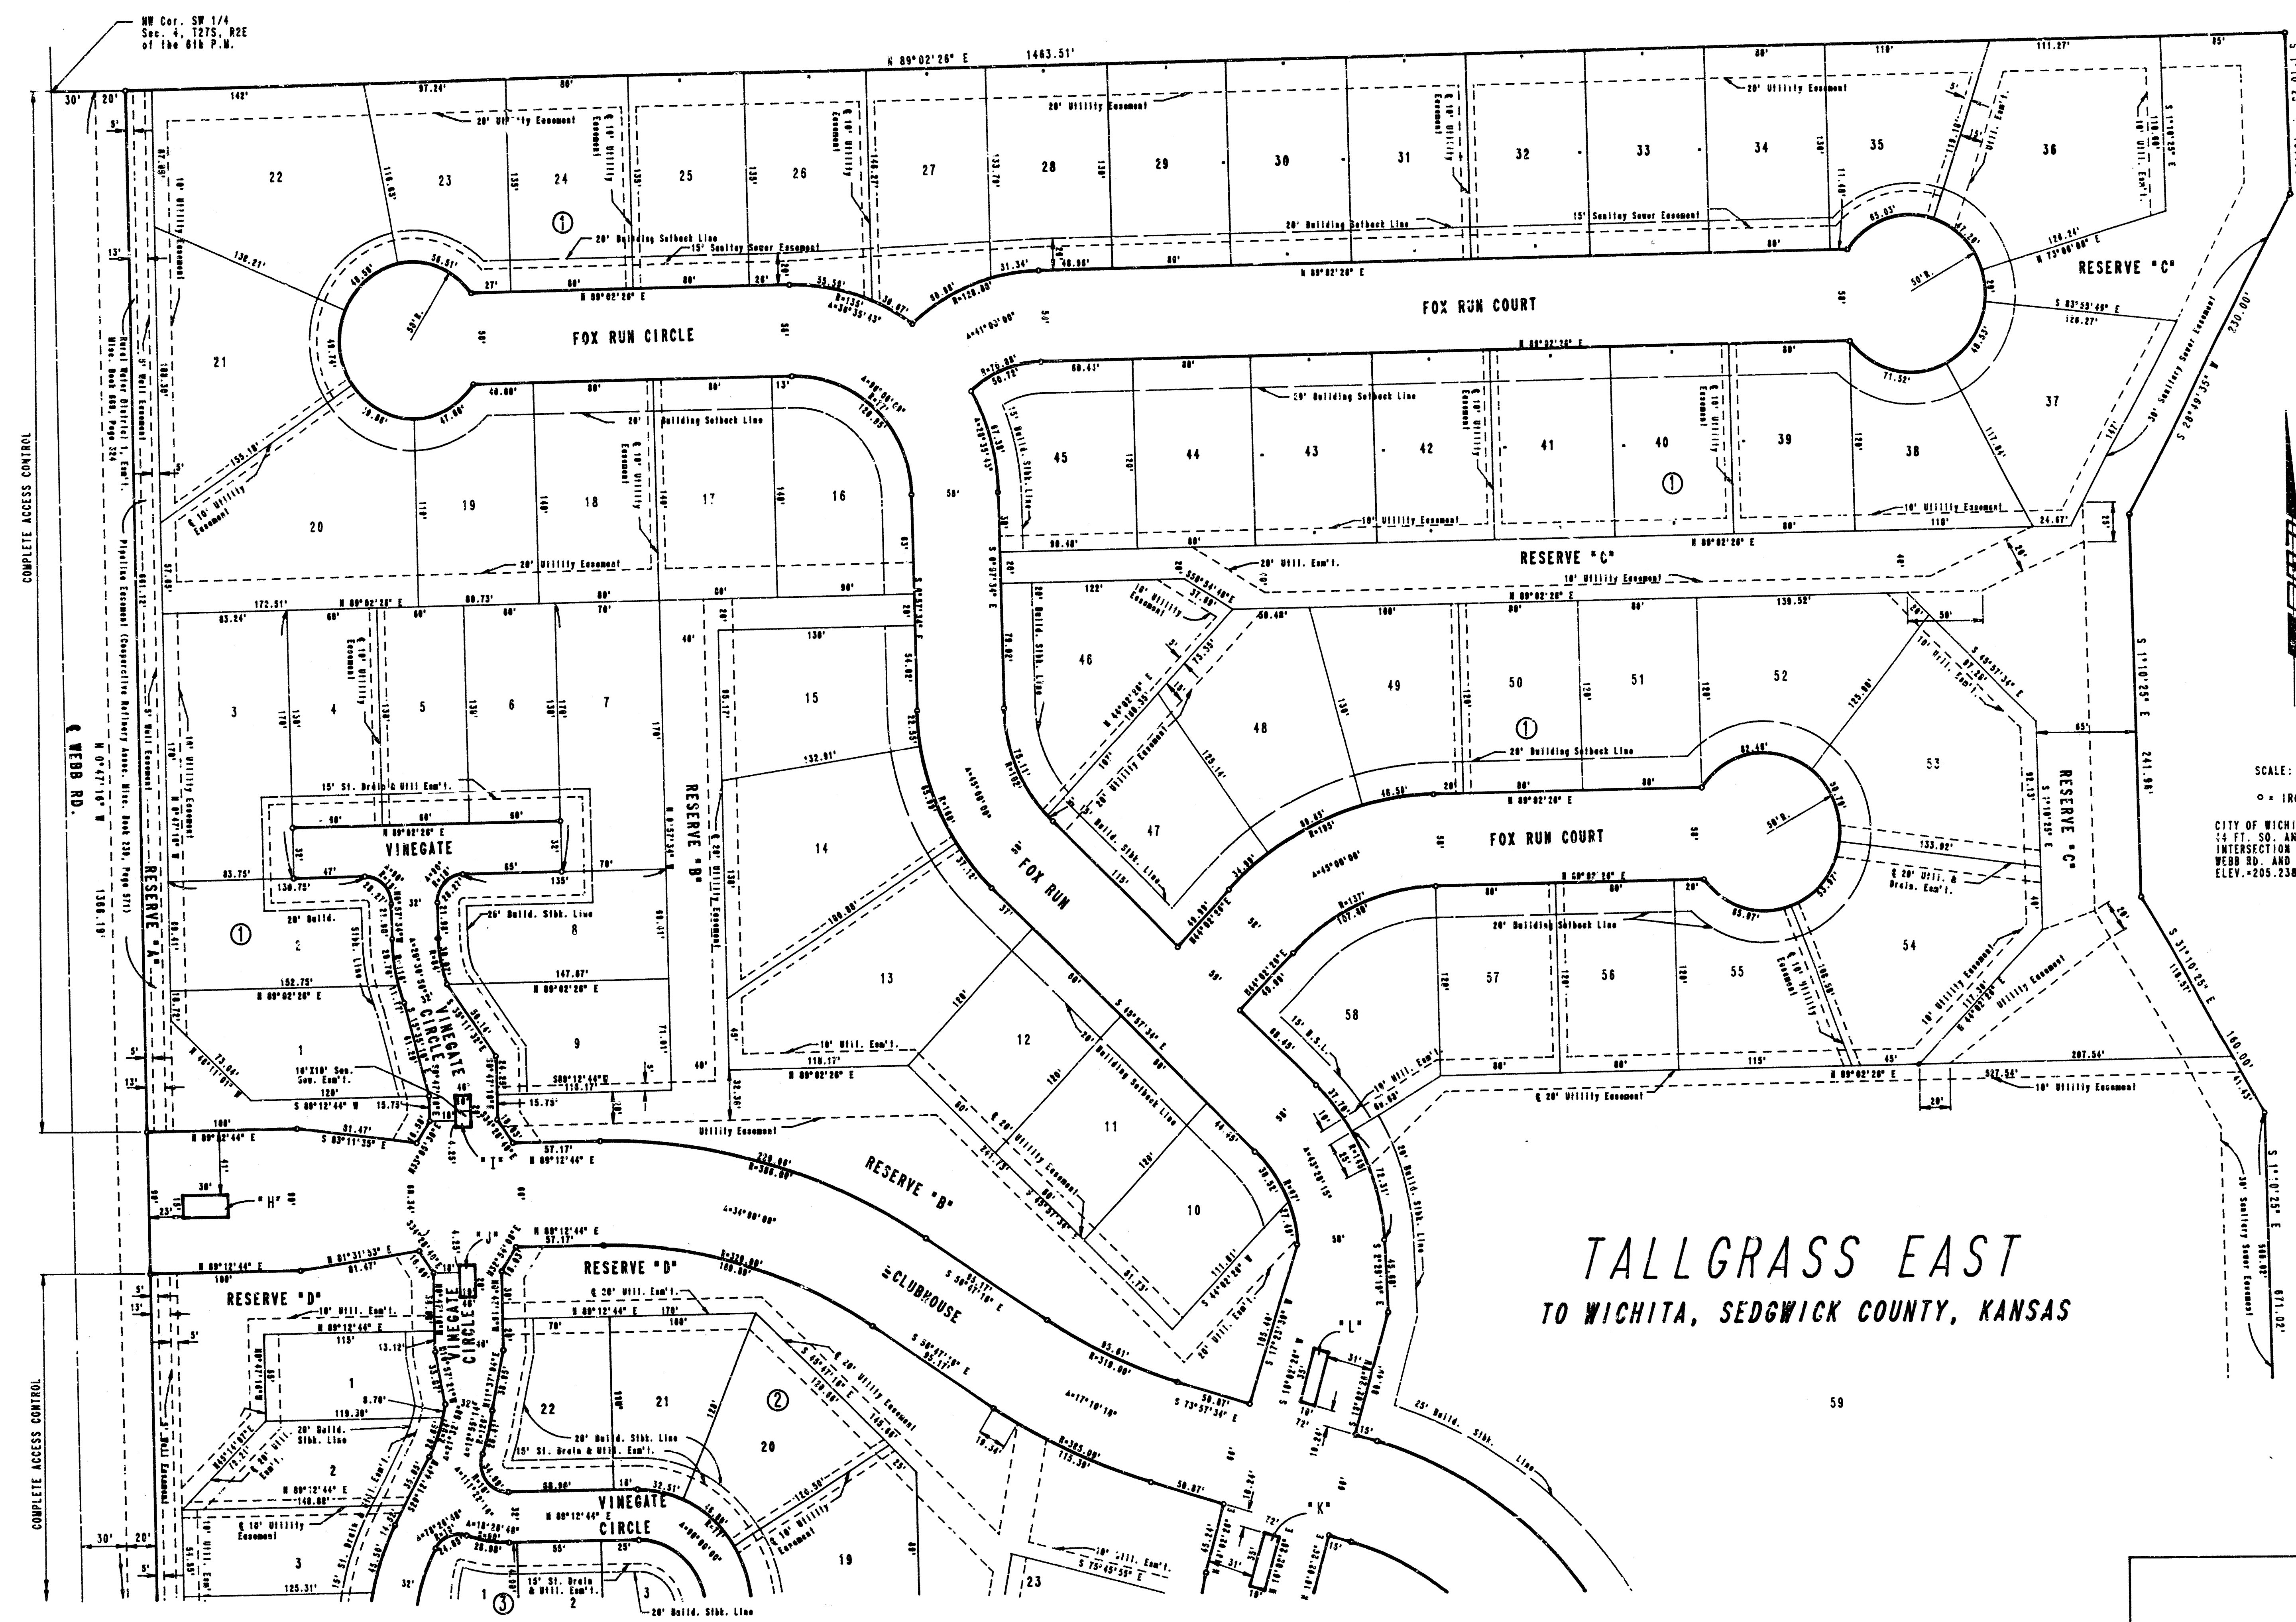


SCALE: 1"=60'
 O = IRON SET
 CITY OF WICHITA B.M. DISC
 54 FT. S.D. AND 48 FT. EAST OF
 INTERSECTION OF CENTERLINE OF
 WEBB RD. AND 21ST ST.
 ELEV. = 205.230 CITY DATUM

TALLGRASS EAST TO WICHITA, SEDGWICK COUNTY, KANSAS

PLAT



PROFESSIONAL ENGINEERING CONSULTANTS, P.A.
 ENGINEERS
 WICHITA, KANSAS

Designed by	Checked by
Drawn by DEP	Date MAR., 1987 Job No. 86475-5

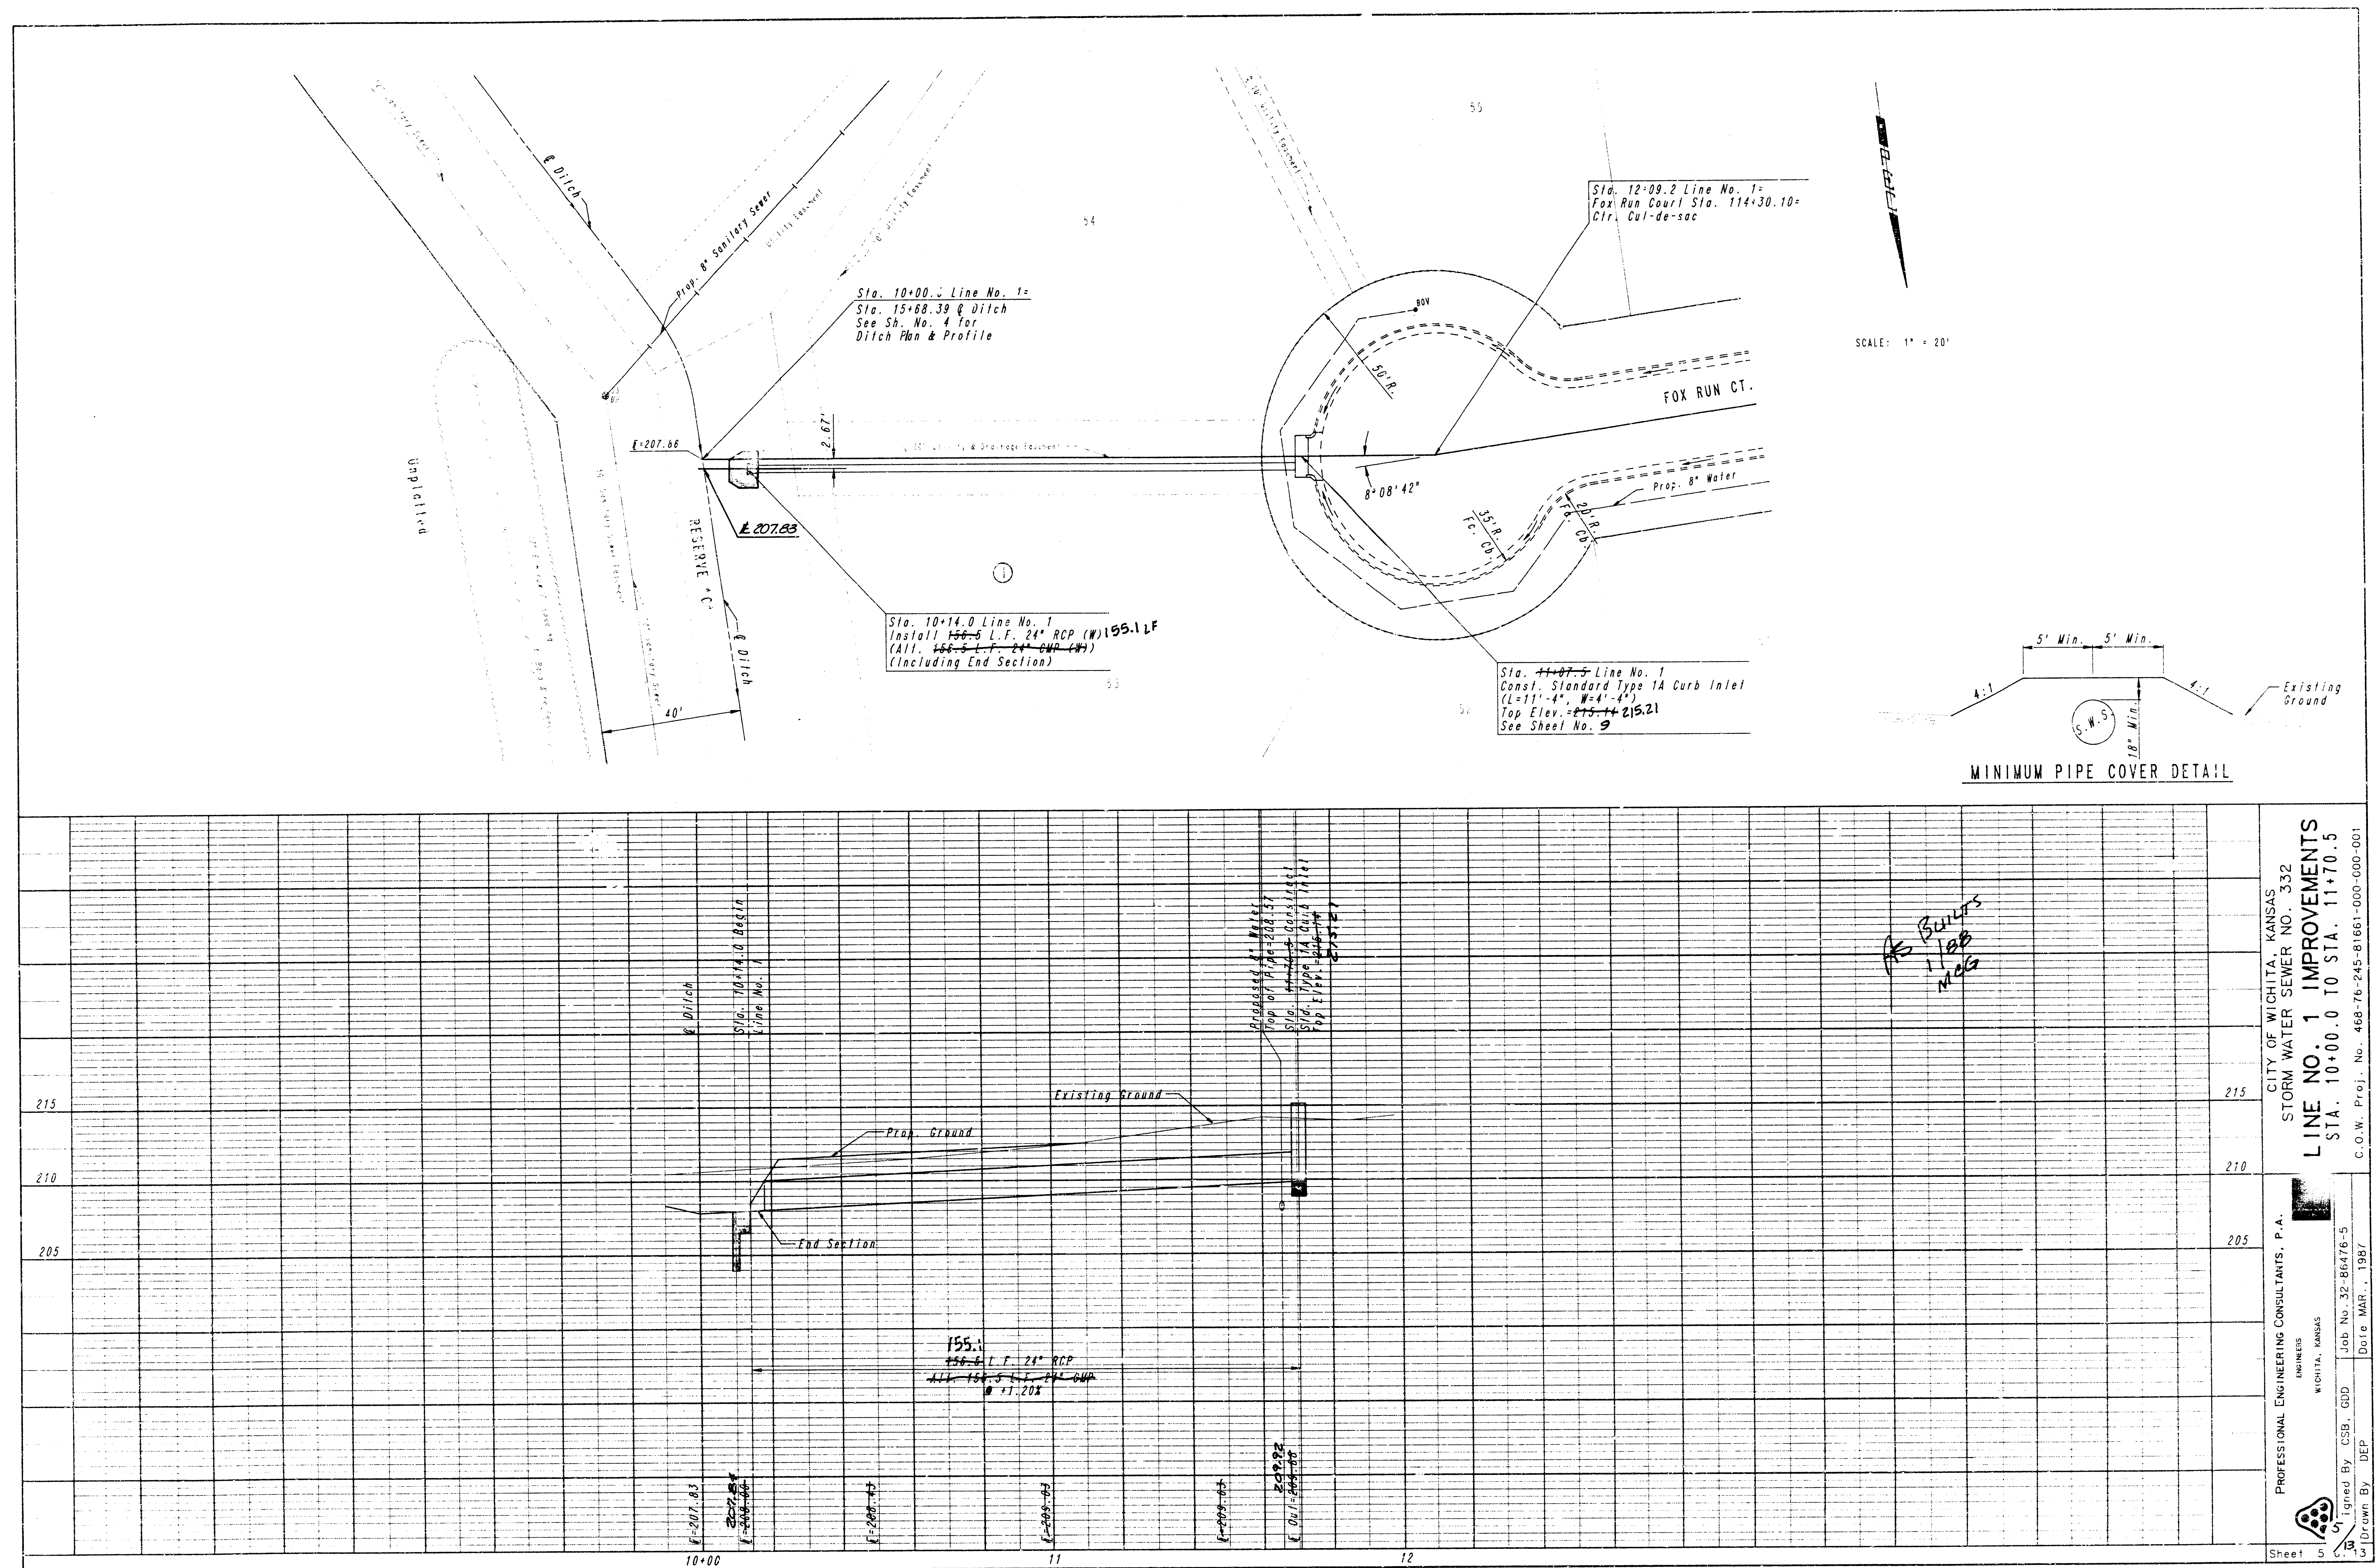


FILMED FROM THE BEST AVAILABLE COPY.....



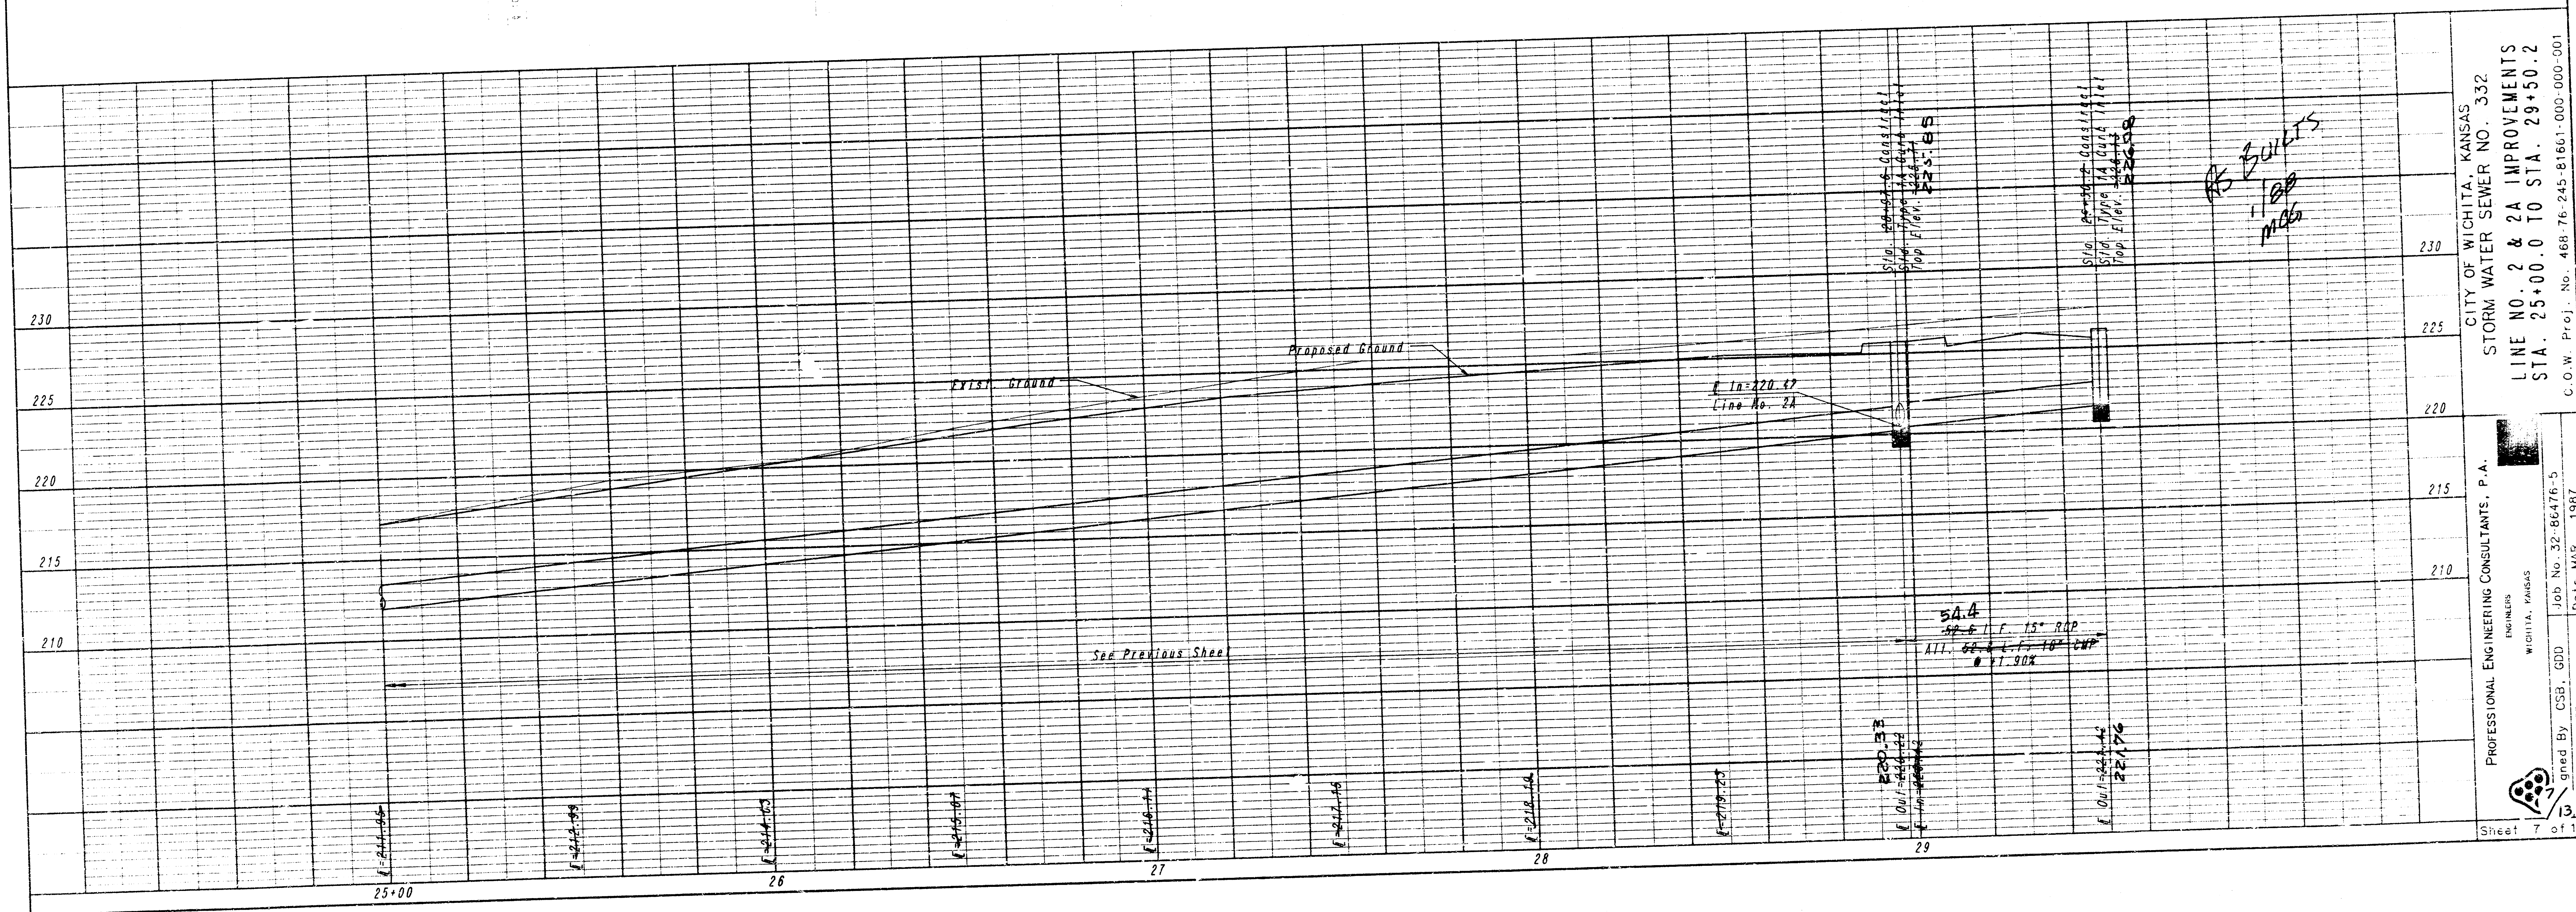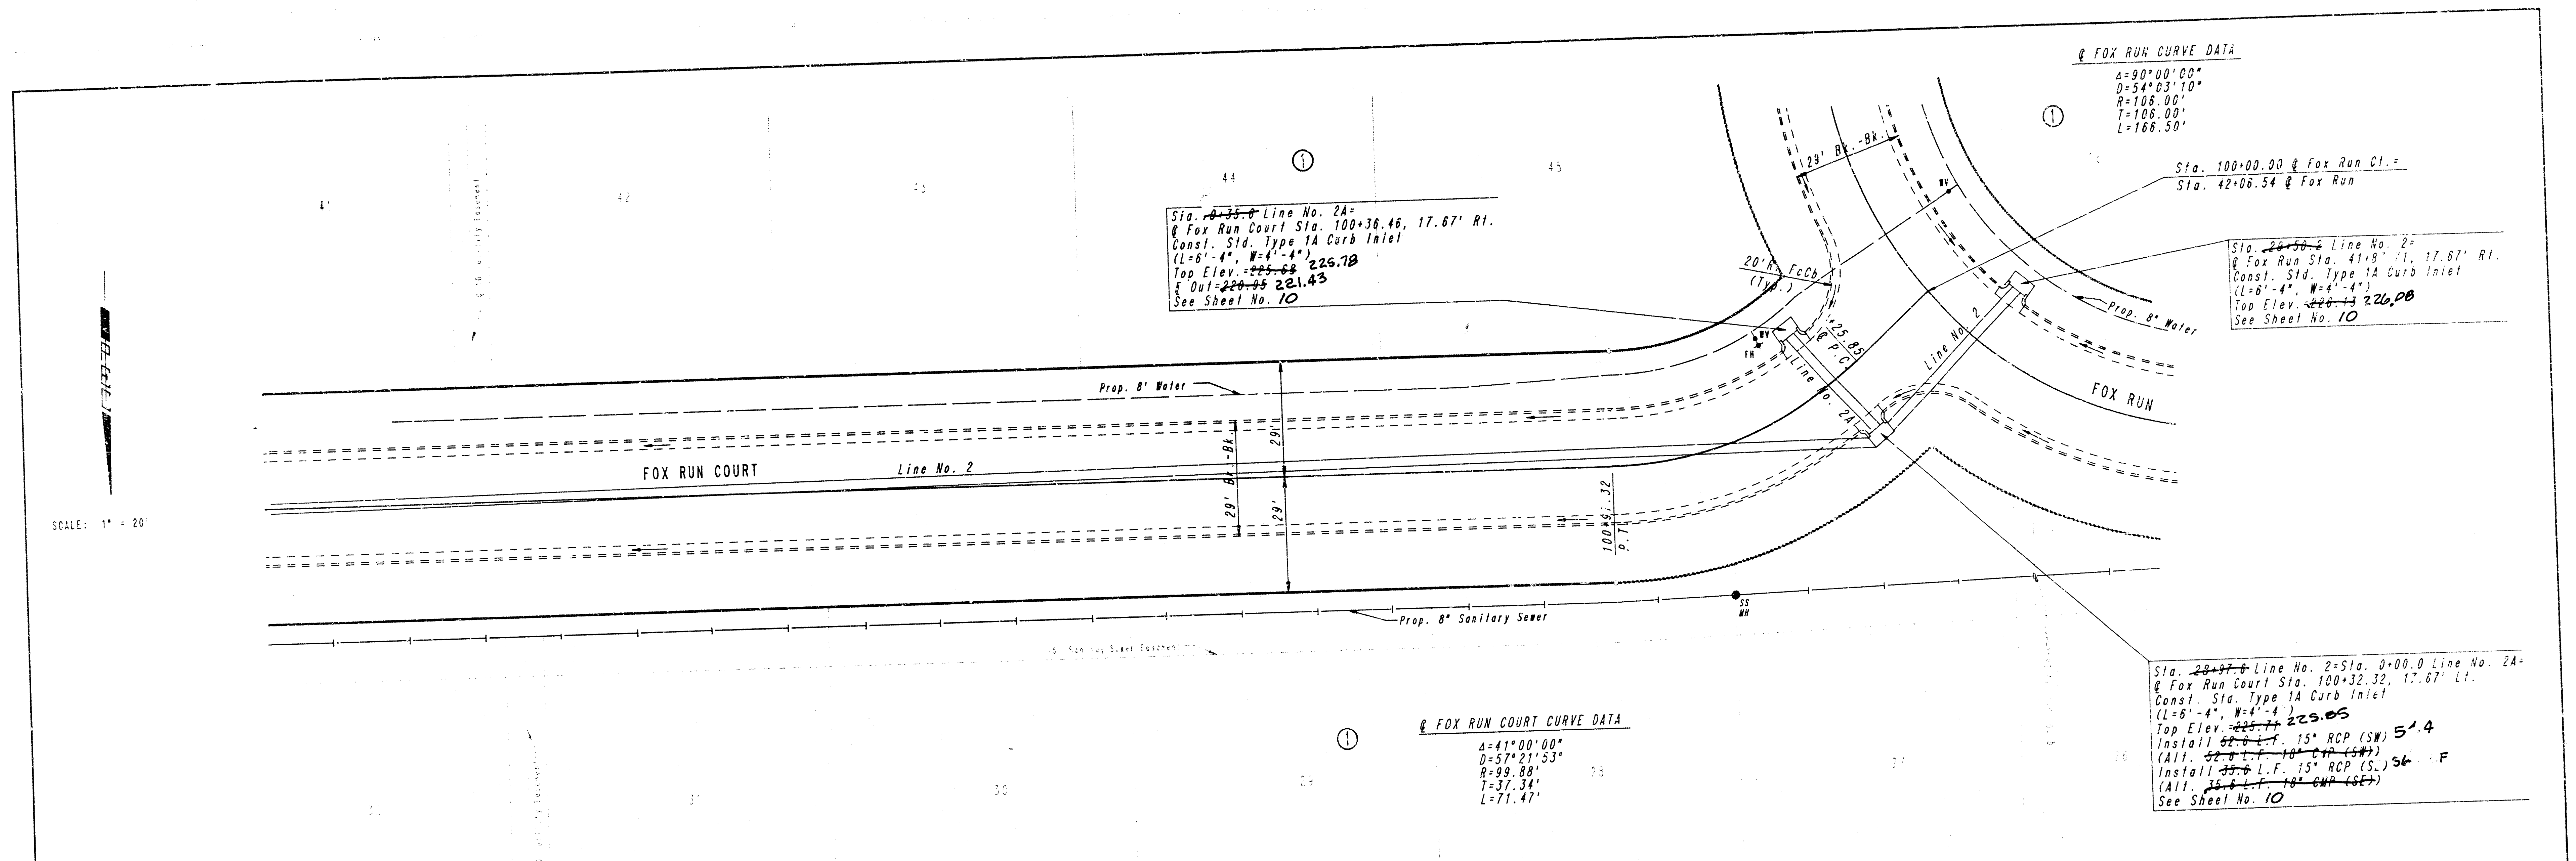


FILMED FROM THE BEST
AVAILABLE COPY.....

PROJECT NO.	SHEET NO.	TOTAL SHEETS
468-76-245-81861-000-000-001	8	13

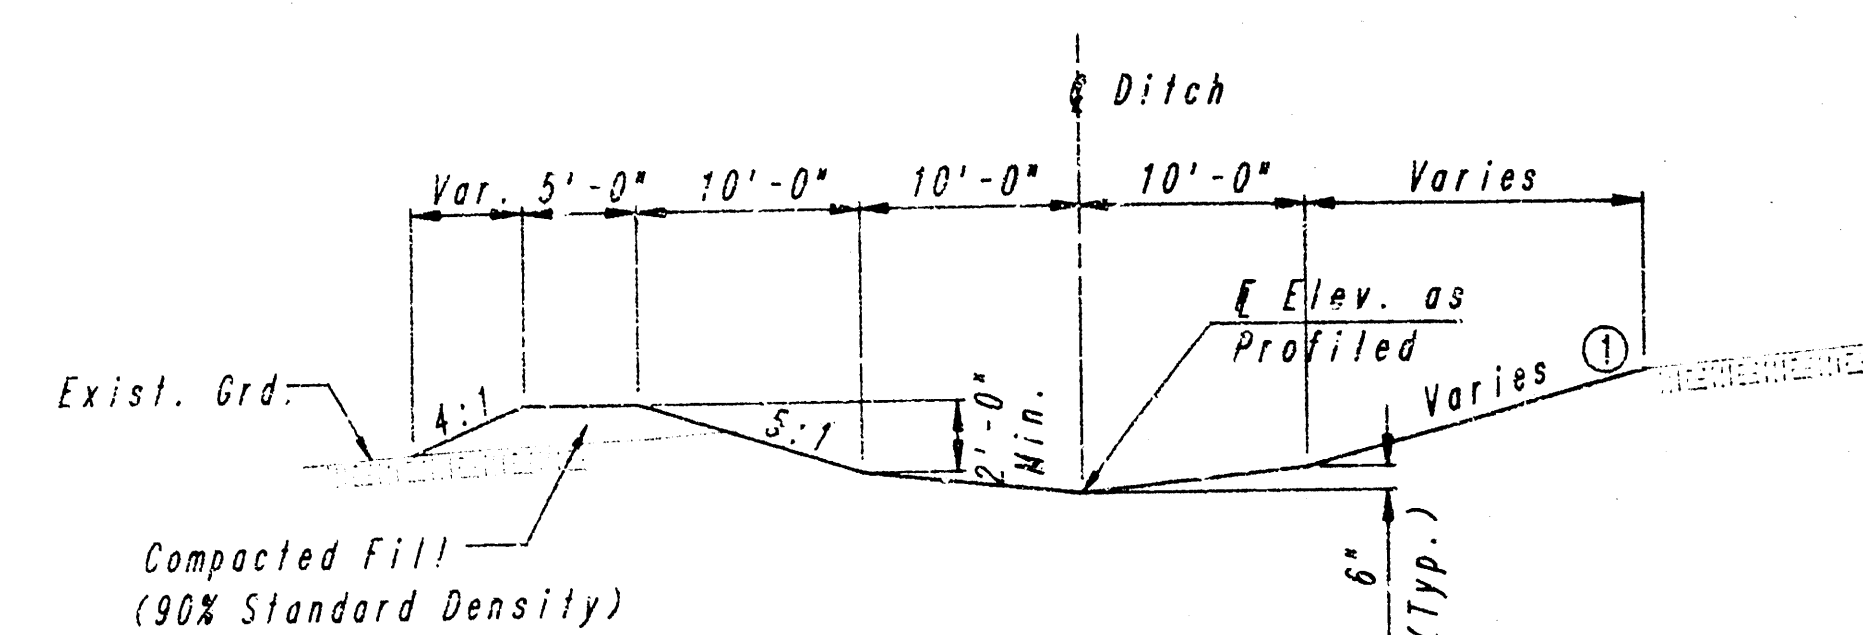


TYPICAL DITCH SECTION

Sta. 10+00 Lt. to Sta. 11+84 Lt.
Sta. 10+00 Rt. to Sta. 10+84 Rt.
Sta. 15+76 Lt. to Sta. 17+12 Lt.
Sta. 15+76 Rt. to Sta. 16+95 Rt.

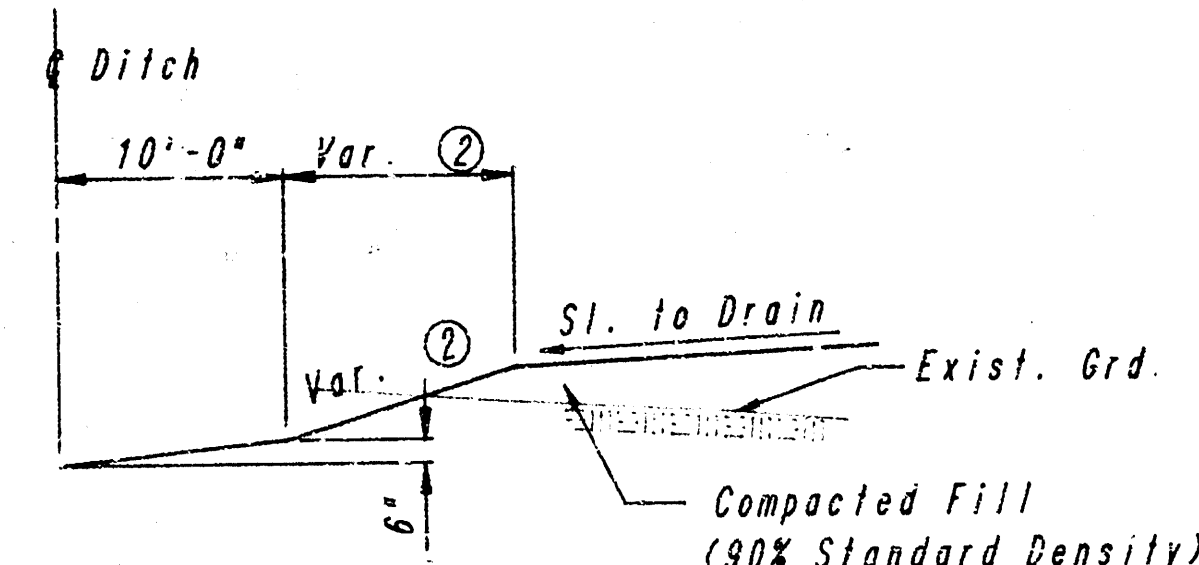


TYPICAL DITCH SECTION

Sta. 10+84 Rt. to Sta. 11+84 Rt.

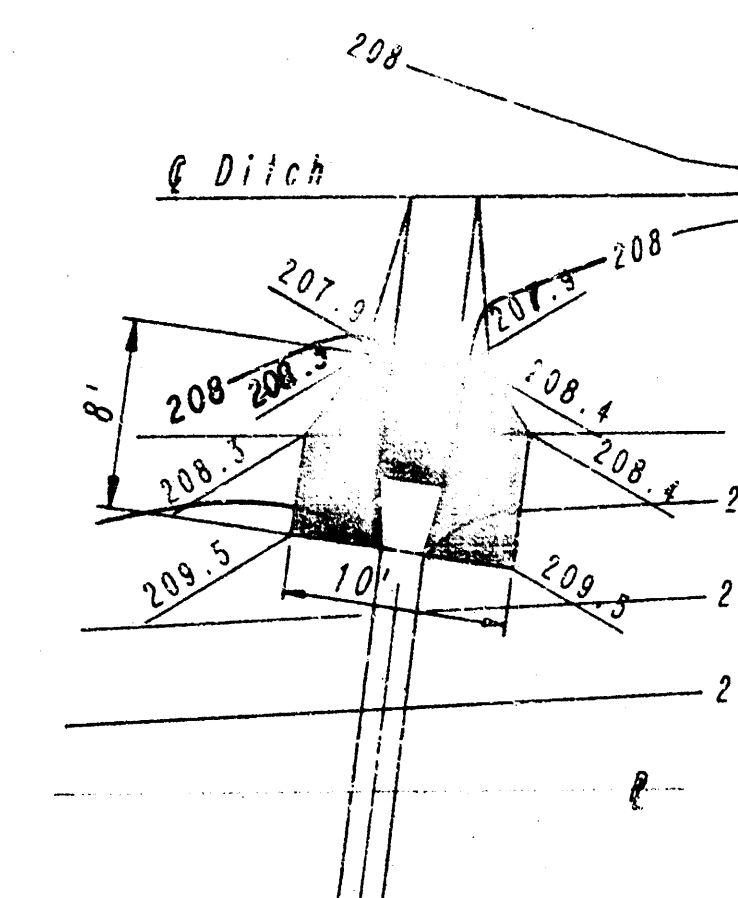


RIPRAP DETAIL 1"=10'
STA. 10+09

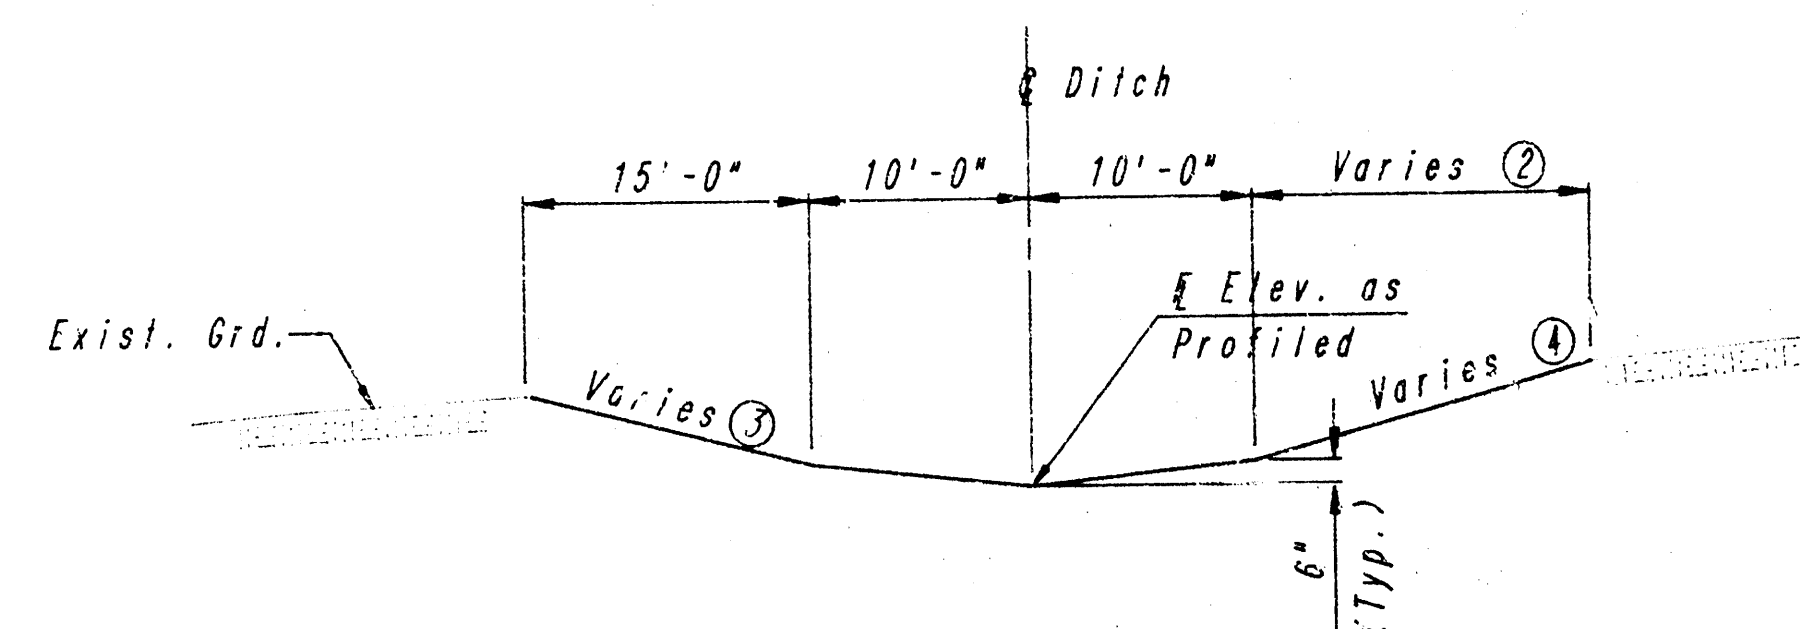


TYPICAL DITCH SECTION

Sta. 9+60 to Sta. 10+00
Sta. 11+84 to Sta. 15+76


- ① 5:1 Sta. 10+00 to Sta. 10+84 Varies from 4:1 at Sta. 15+76 to 6:1 at Sta. 16+15. 6:1 from Sta. 16+15 to Sta. 16+95±.
- ② See Plan Sheet and Cross Sections.
- ③ 5:1 from Sta. 9+60 to Sta. 10+00. 4:1 from Sta. 13+52± to Sta. 14+53±.
- ④ 5:1 from Sta. 9+60 to Sta. 10+00. 4:1 from Sta. 13+00 to Sta. 15+76.

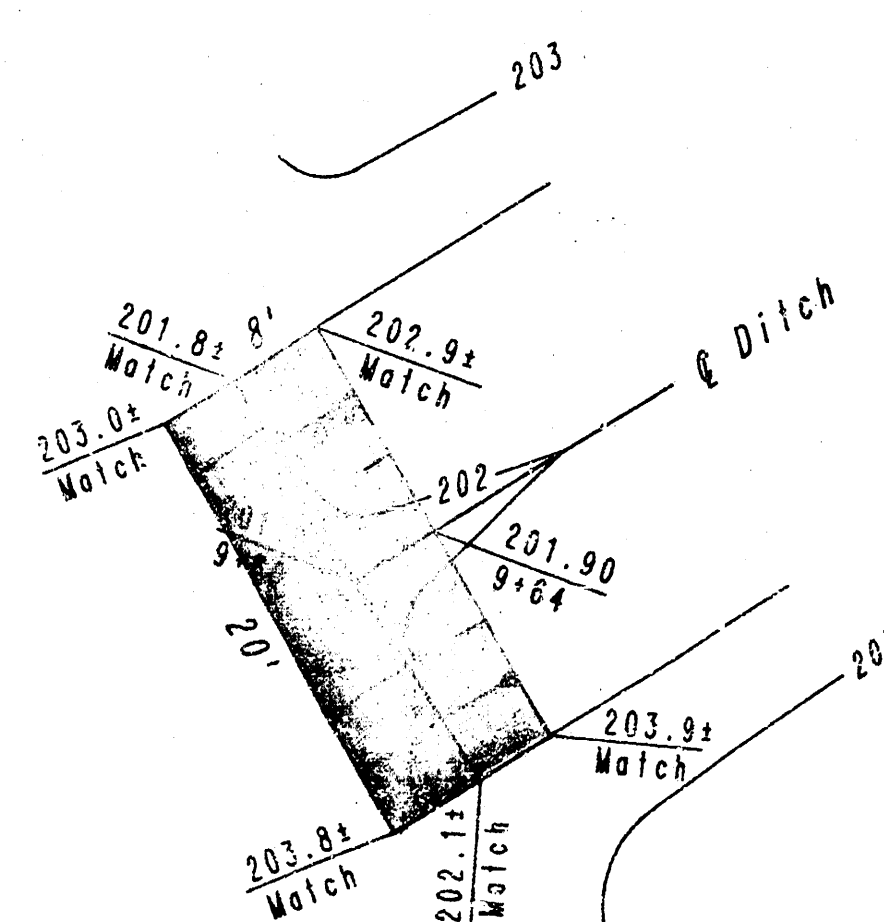

RIPRAP DETAIL 1"=10'
DITCH

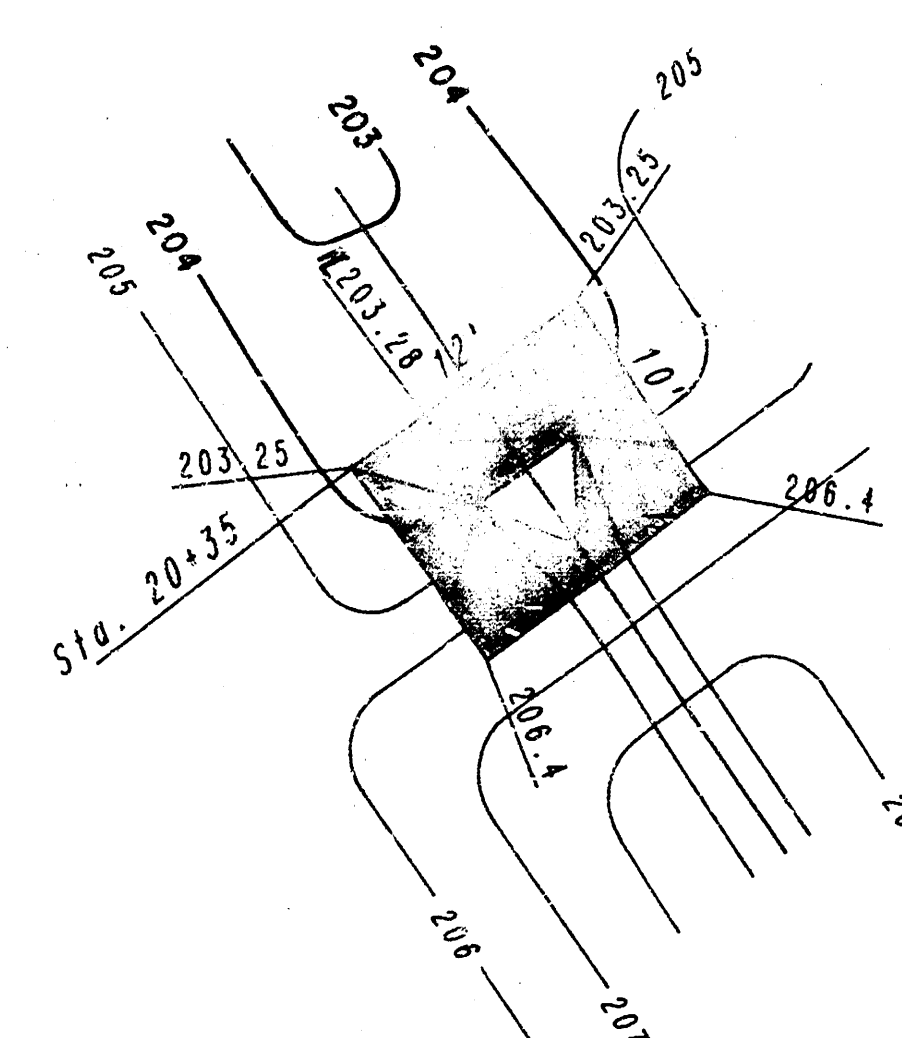

RIPRAP DETAIL 1"=10'
LINE NO. 2
STA. 20+35

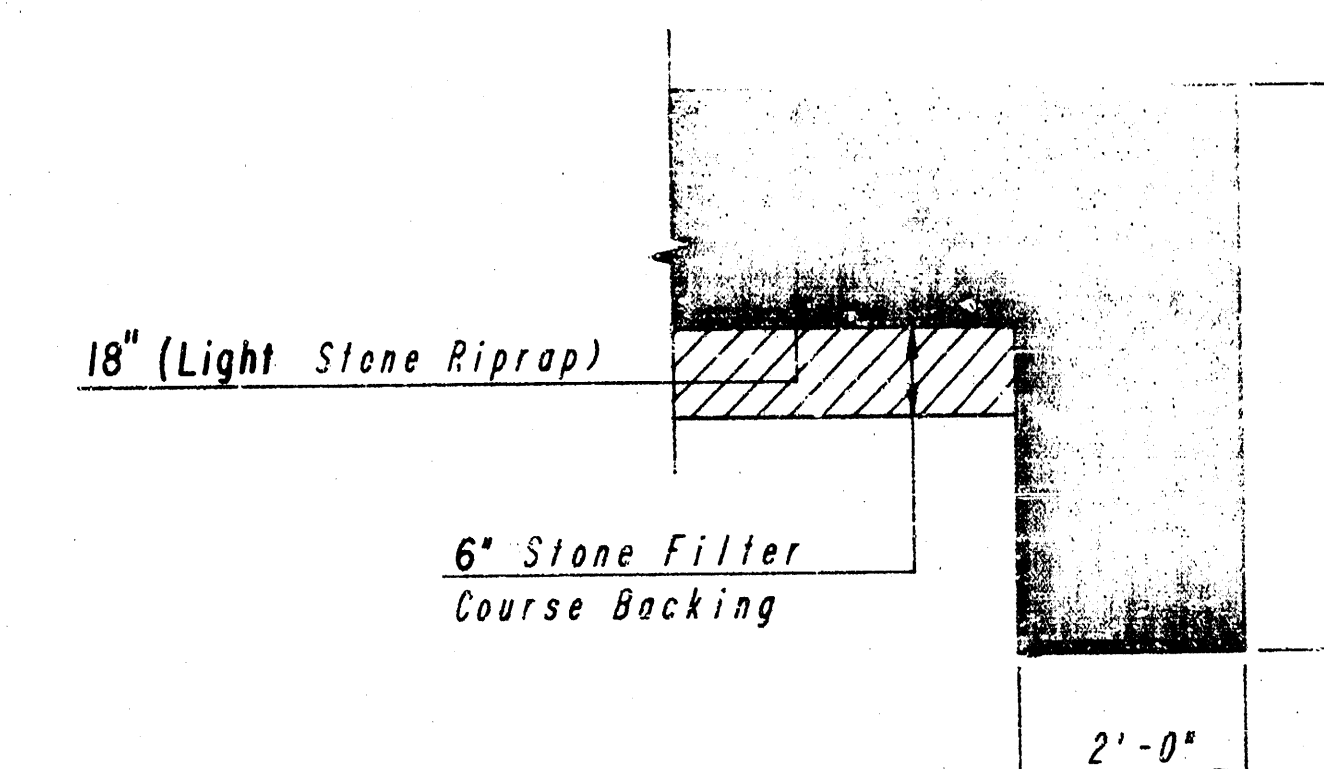

TYPICAL SECTION THRU TOEWALL
NO SCALE


- NOTES
1. ALL RIPRAP FOR THIS PROJECT SHALL BE NATURAL STONE. GROUTING OR RIPRAP SHALL NOT BE PERFORMED. NEITHER TE BROKEN CONCRETE, THE FABRIC ENVELOPE, NOR THE PREMIXED DRY PACKAGED CONCRETE BAG ALTERNATES WILL BE ALLOWED.
 2. TOEWALLS SHALL BE INSTALLED ALONG ALL UNPROTECTED EDGES OF STONE RIPRAP.

TYPICAL DITCH SECTIONS AND RIPRAP DETAILS

PROFESSIONAL ENGINEERING CONSULTANTS, P.A.
ENGINEERS
WICHITA, KANSAS

Designed by CSB, GDD Checked by 8/13
Drawn by DEP Date MAR., 1987 Job No. 86476-5


FILMED FROM THE BEST
AVAILABLE COPY.....

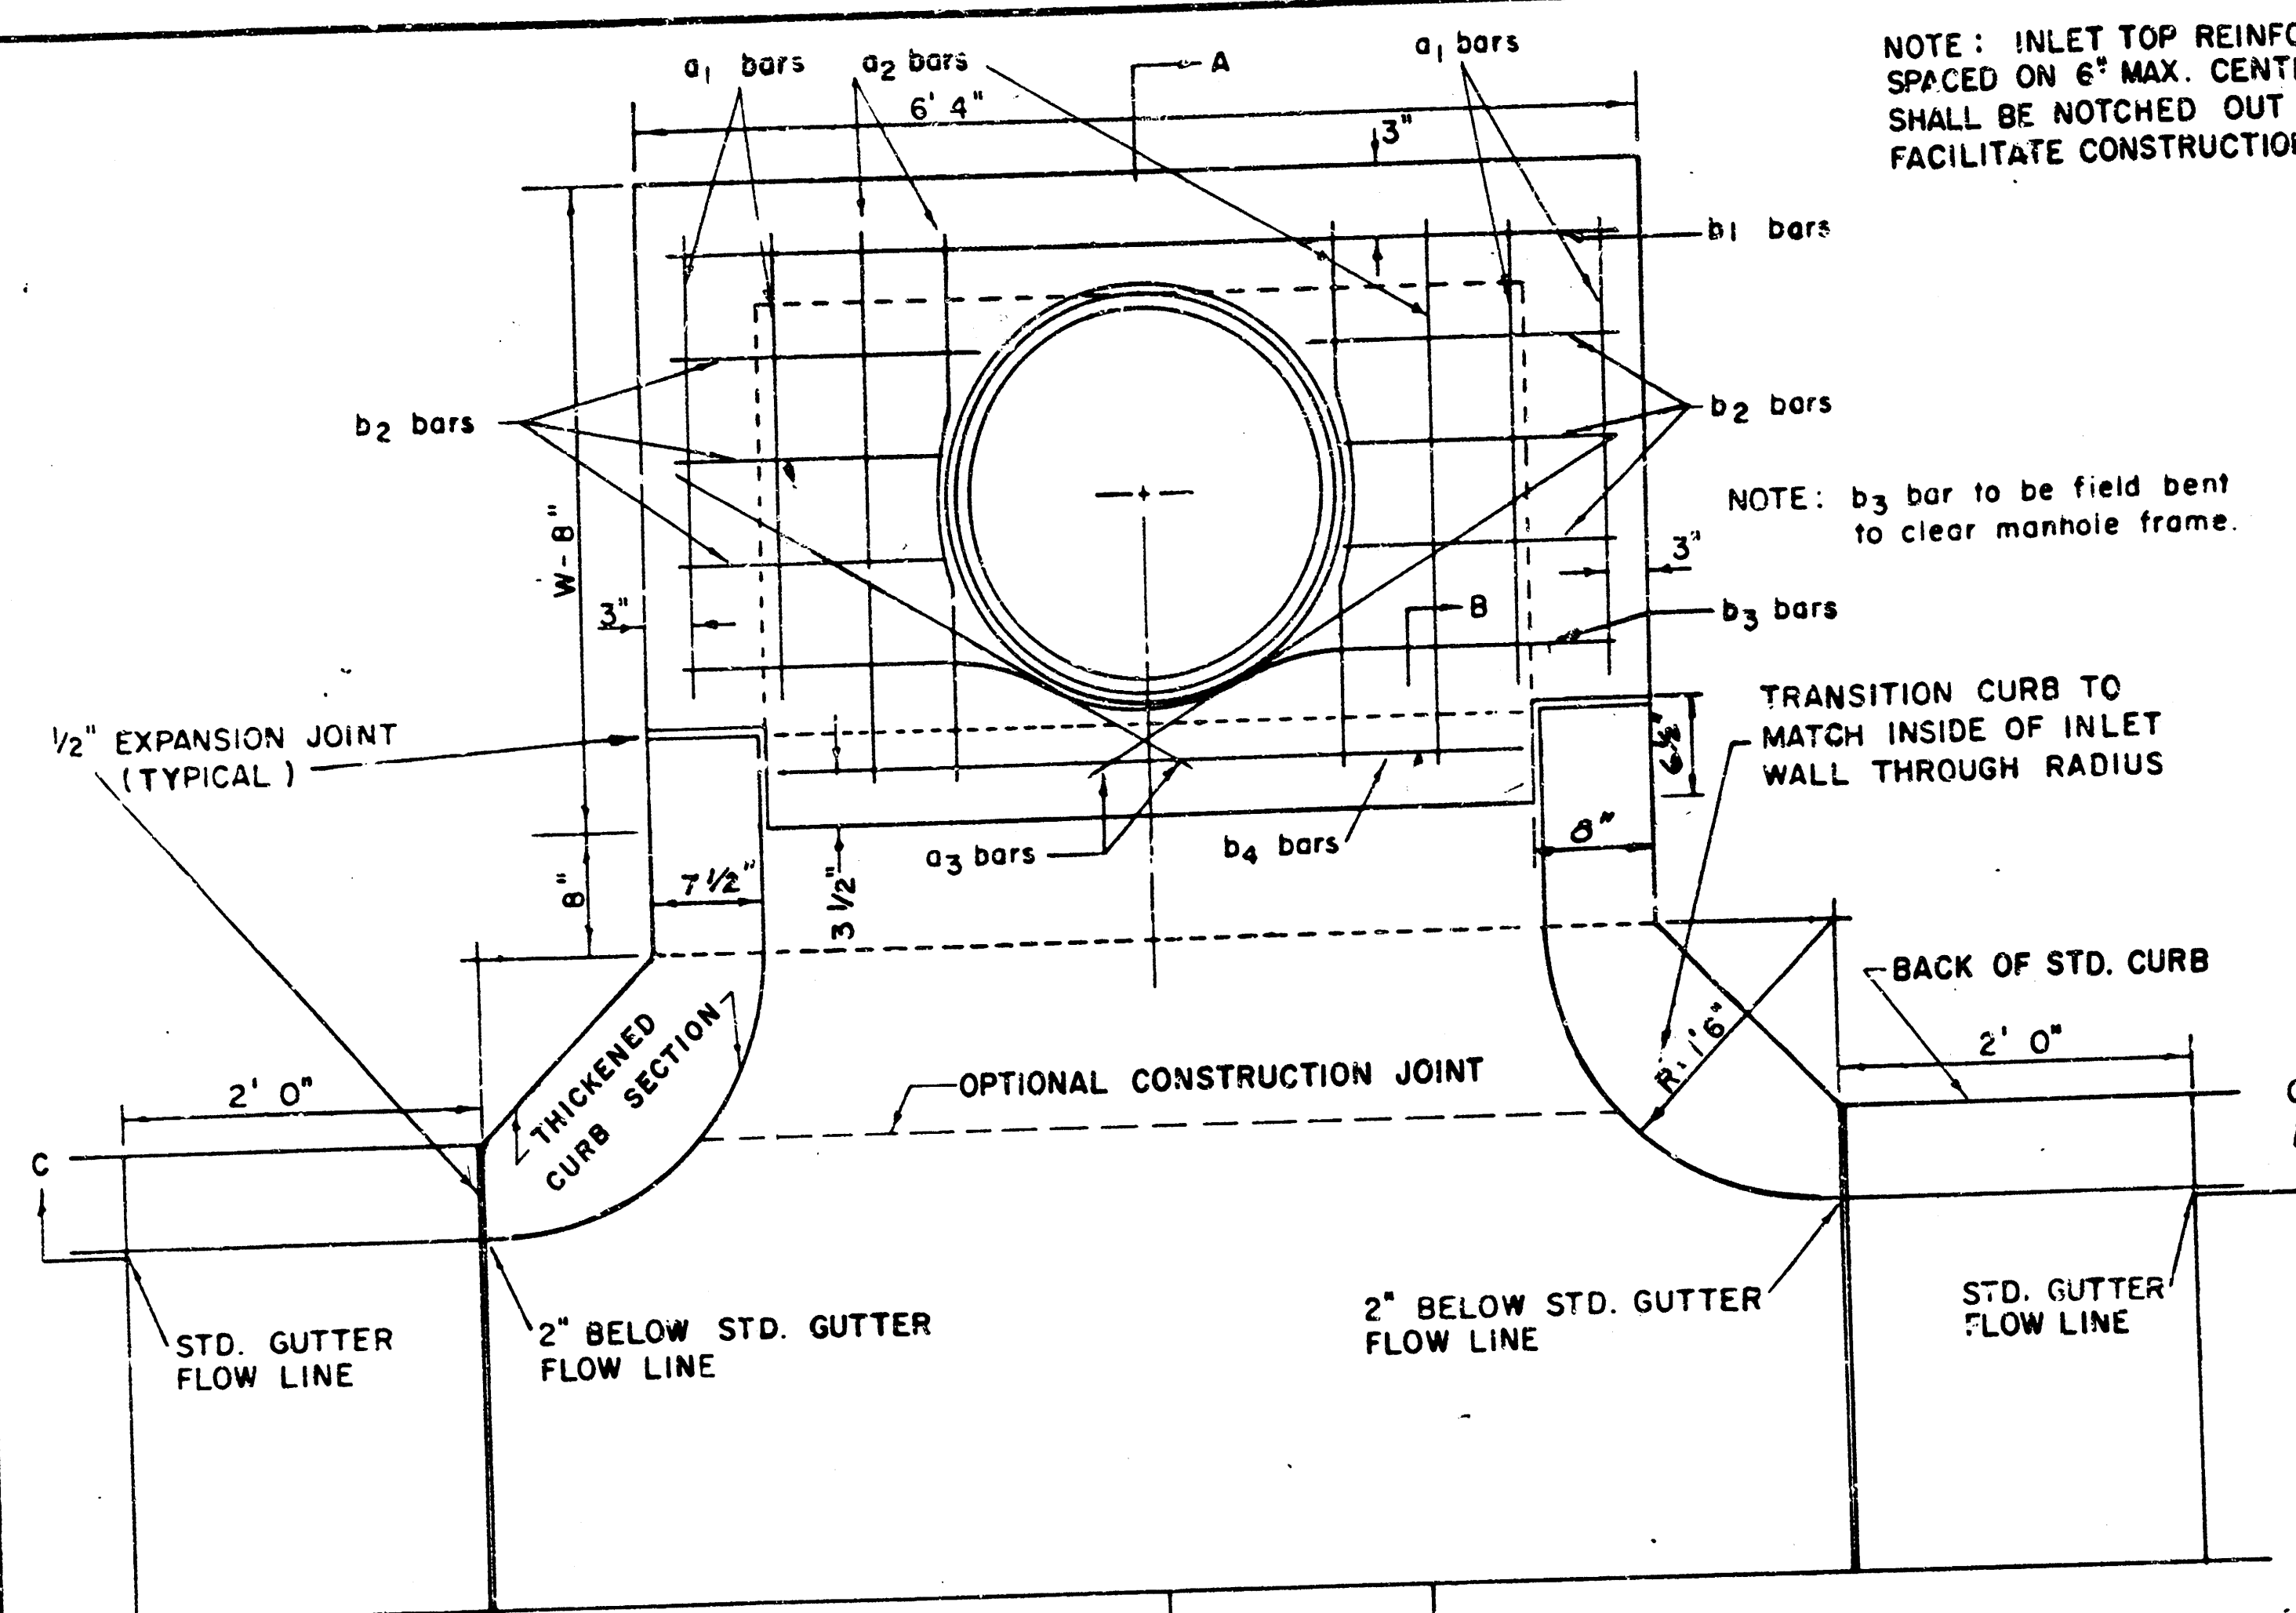

STEEL SCHEDULE

BAR	a ₁	a ₂	a ₃	b ₁	b ₂	b ₃	b ₄	WT. LBS.
NUMBER	4	4	2	1	3	5	7	9
SIZE	*4	*4	*4	*4	*4	*4	*4	*6
W=4'4"	5'7"	6'7"	4'0"	6'1"	-	-	-	1'9"
W=5'4"	7'7"	8'7"	5'0"	6'1"	-	-	-	1'9"
W=6'4"	9'7"	10'7"	6'0"	6'1"	-	-	-	1'9"
W=7'4"	11'7"	12'7"	7'0"	6'1"	-	-	-	1'9"
W=8'4"	13'7"	14'7"	8'0"	6'1"	-	-	-	1'9"



NOTE: a₃ BARS TO BE PLACED APPROX. 2" BELOW TOP OF INLET COVER

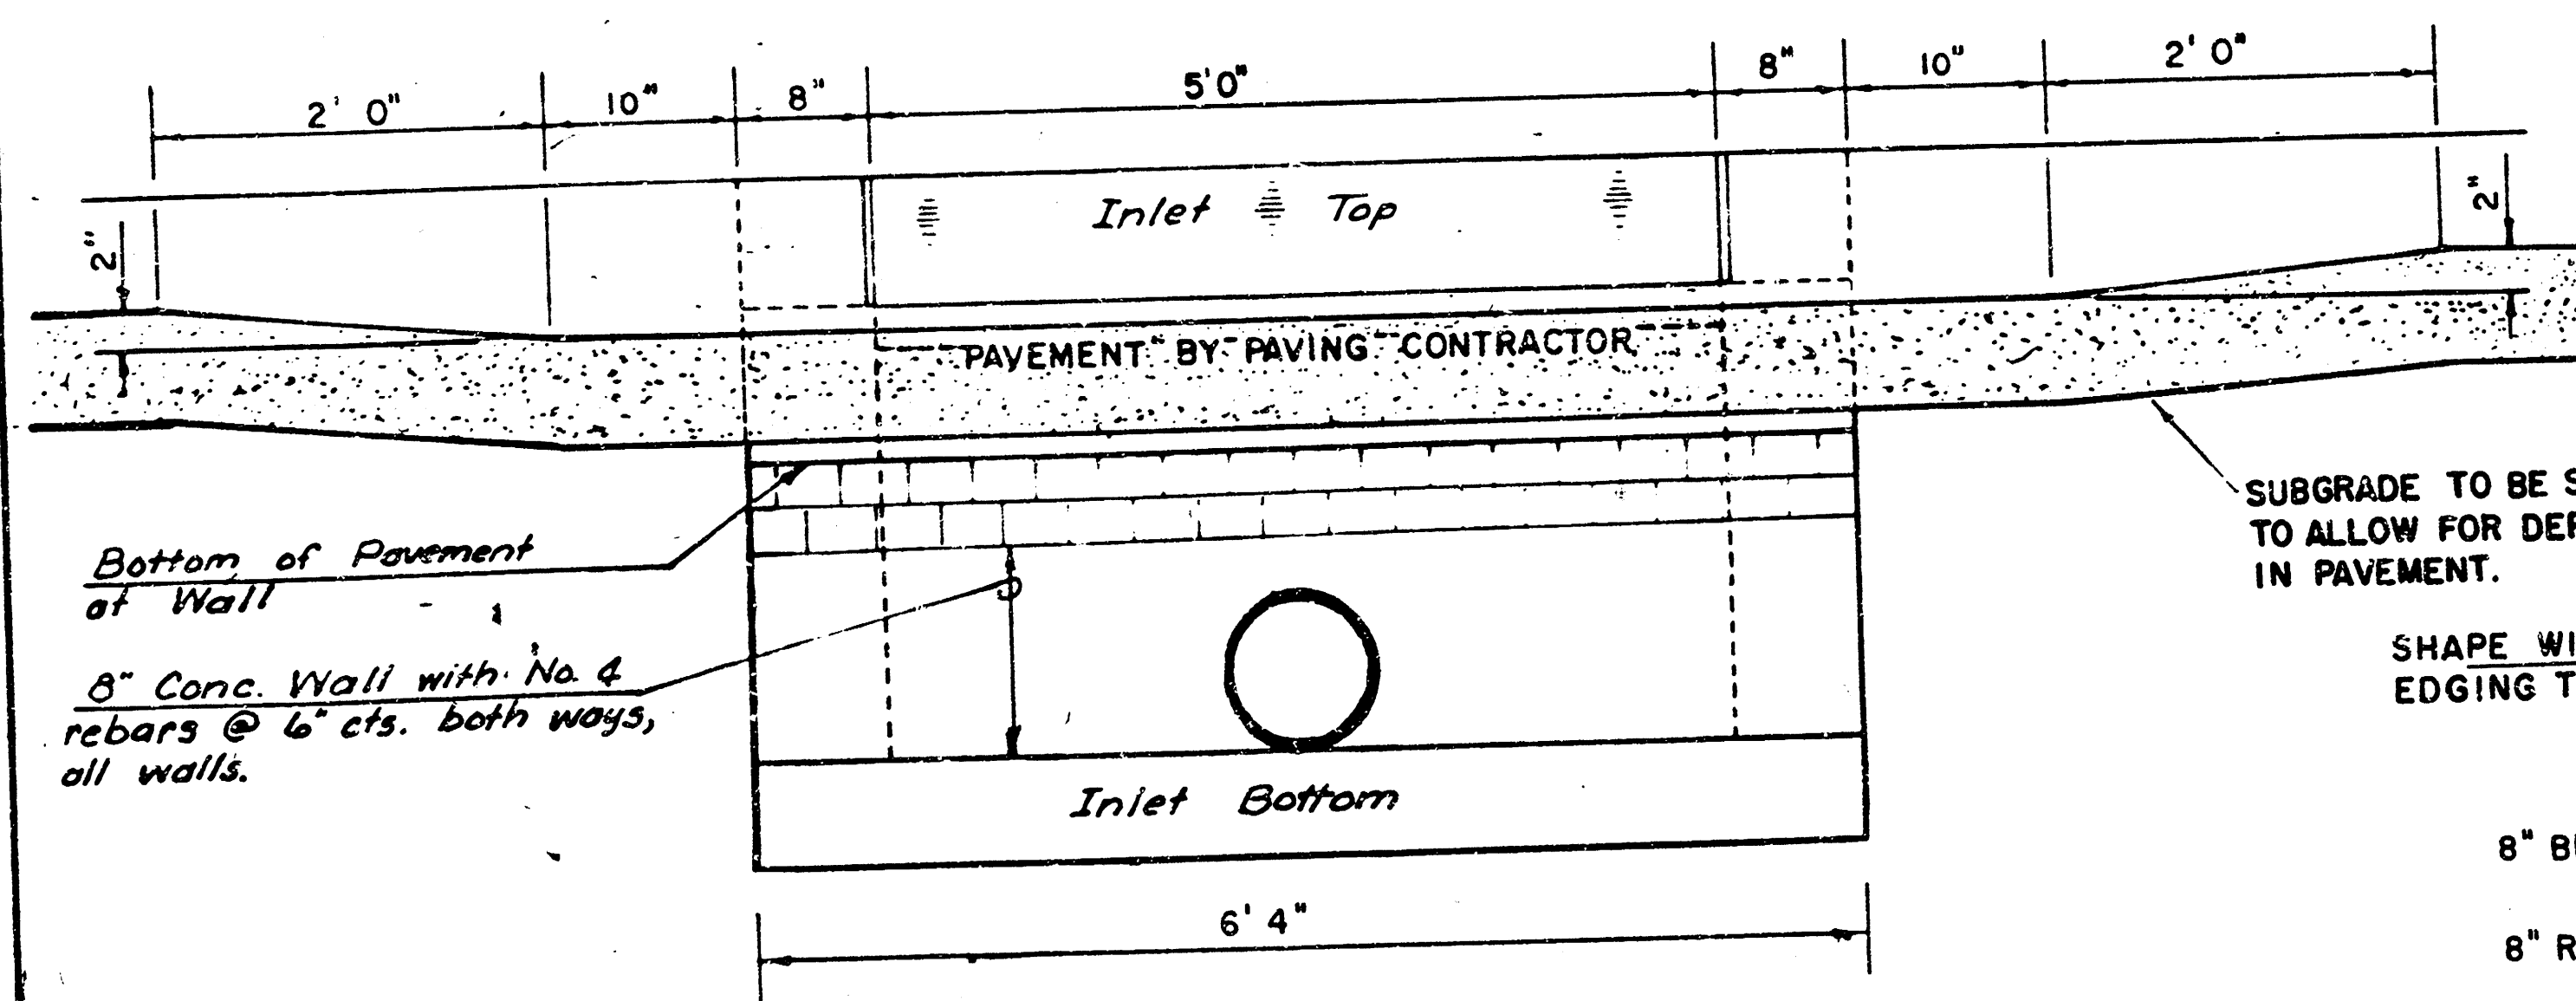

BENDING DIAGRAM

STANDARD CURB INLET PRECAST TOPS

W	PRE-CAST TOP SIZE	PIPE SIZE	CU. YD. CONC.
4' 4"	3' 8" x 6' 4" x 7 1/2"	21" & SMALLER	0.38 ±
5' 4"	4' 8" x 6' 4" x 7 1/2"	24" & 30"	0.51 ±
6' 4"	5' 8" x 6' 4" x 7 1/2"	36" & 42"	0.64 ±
7' 4"	6' 8" x 6' 4" x 7 1/2"	48" & 54"	0.77 ±
8' 4"	7' 8" x 6' 4" x 7 1/2"	60" & 66"	0.90 ±

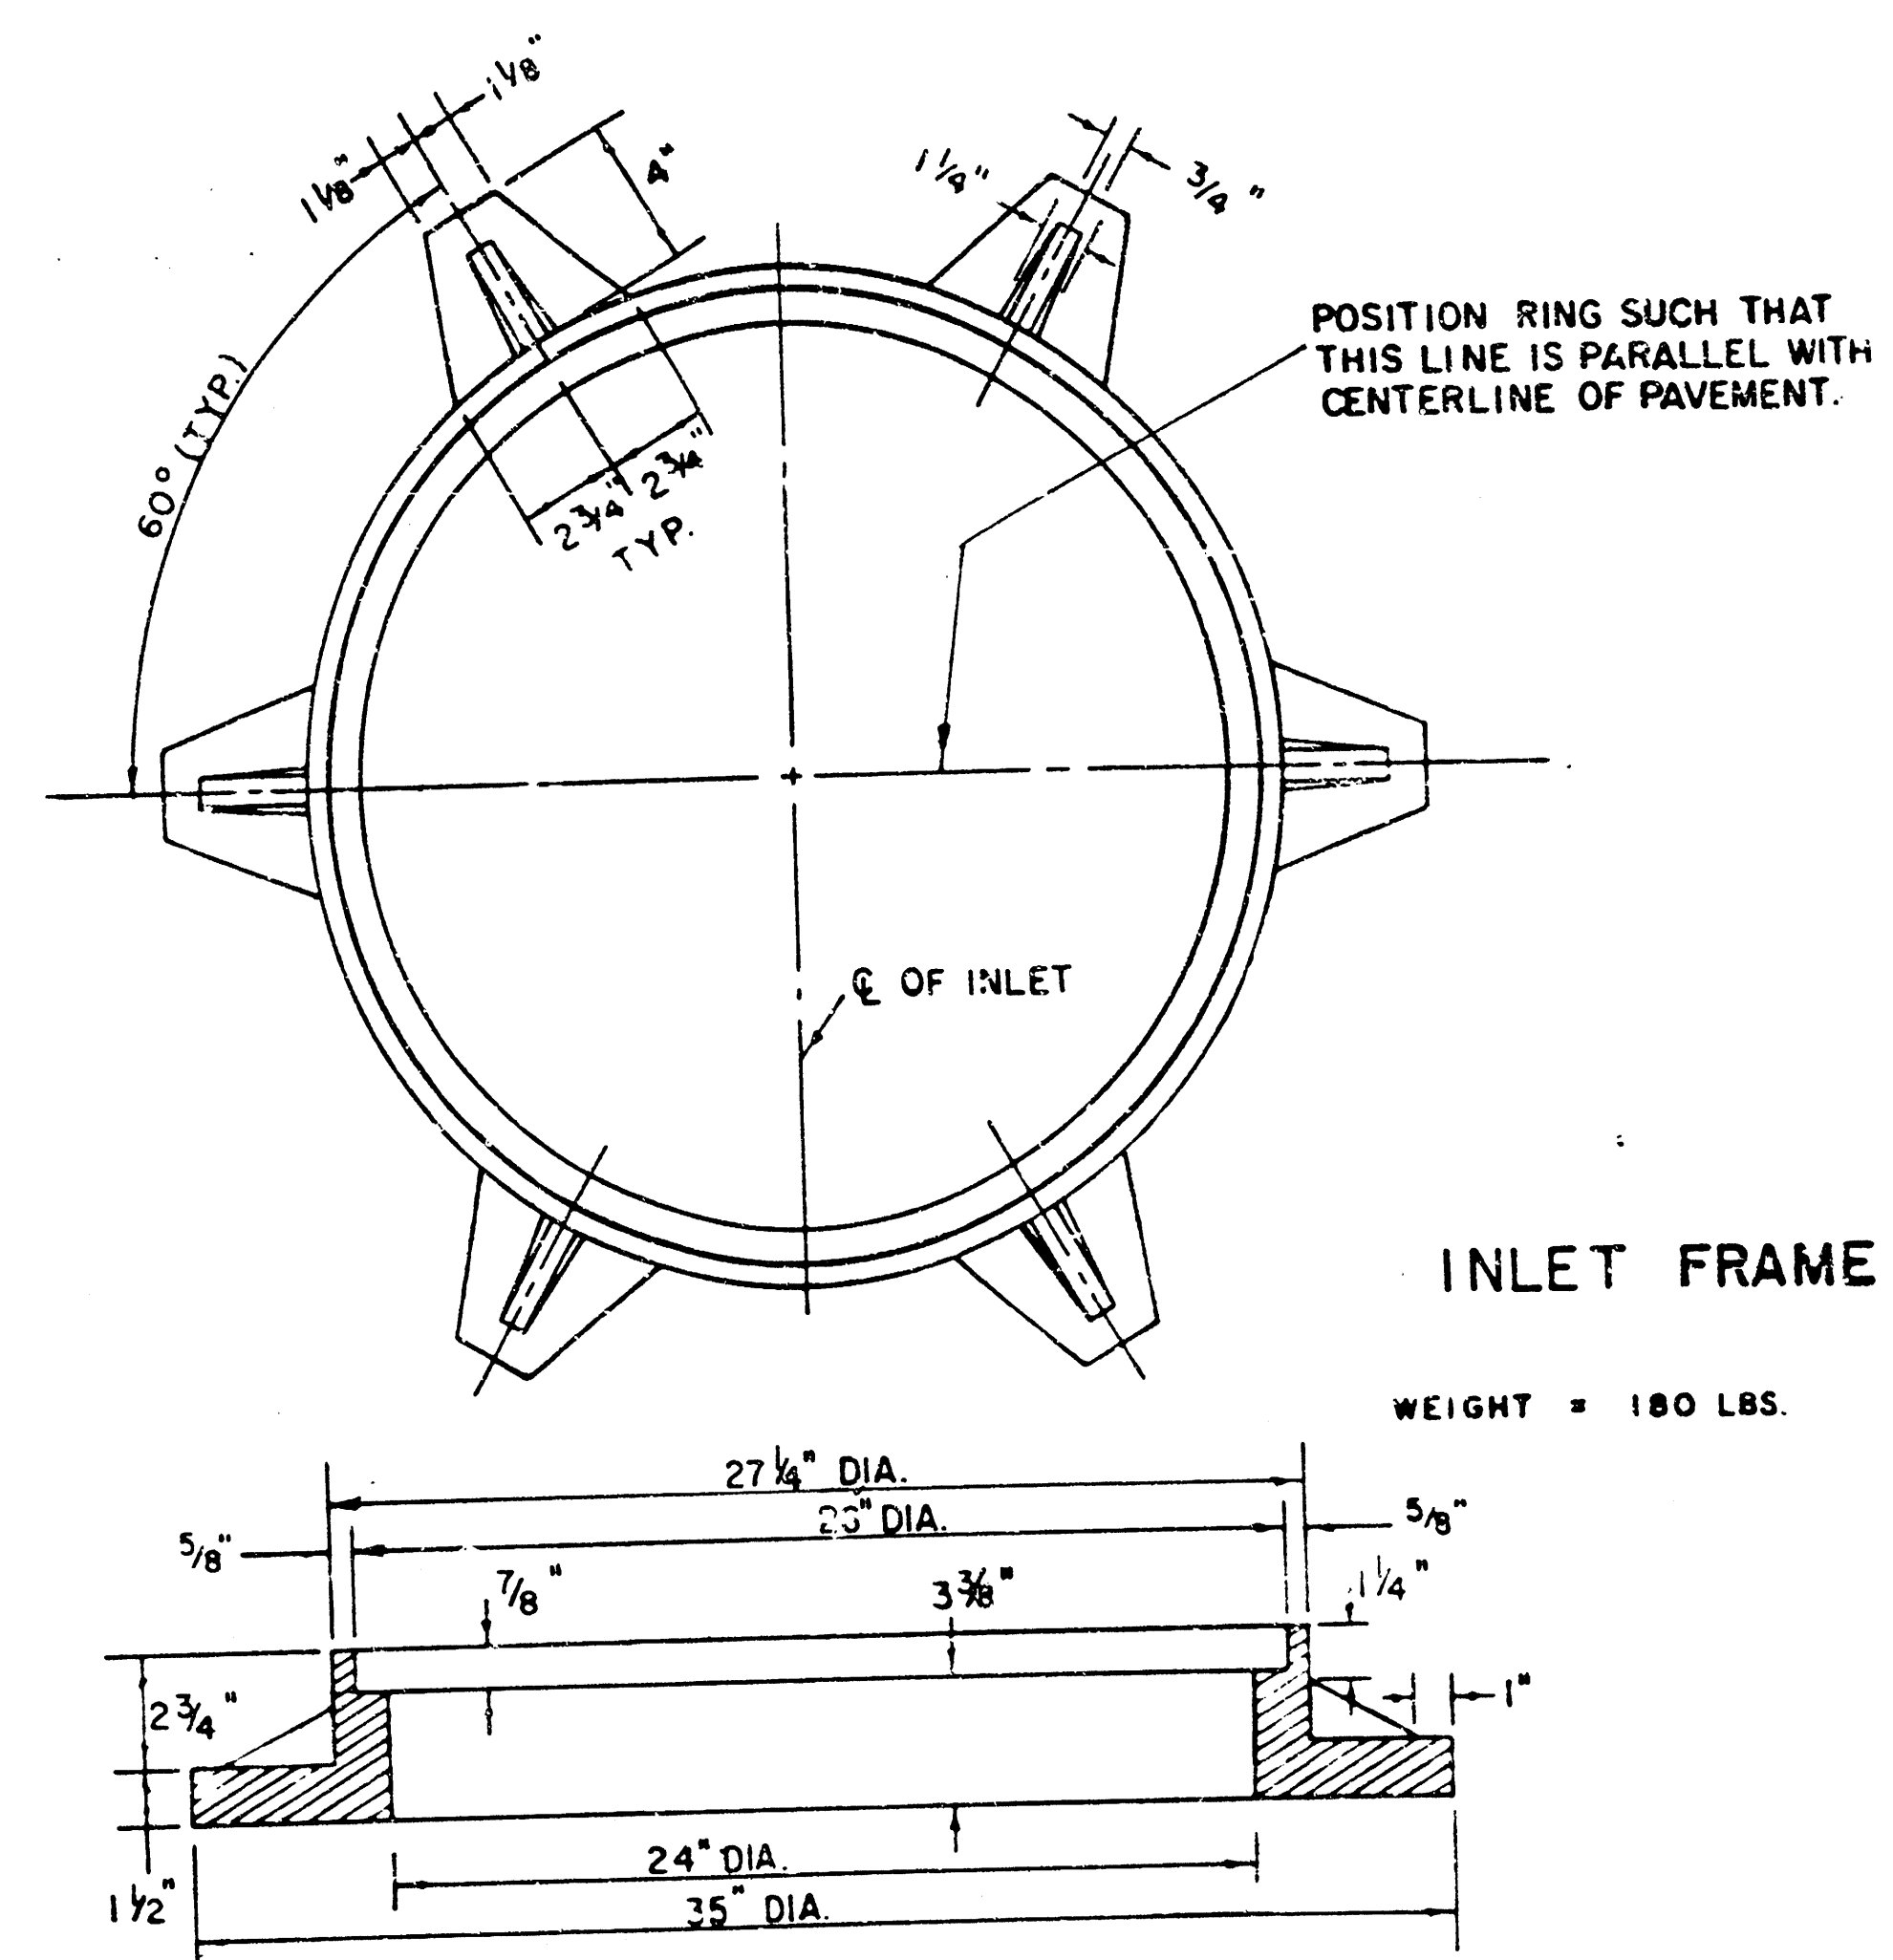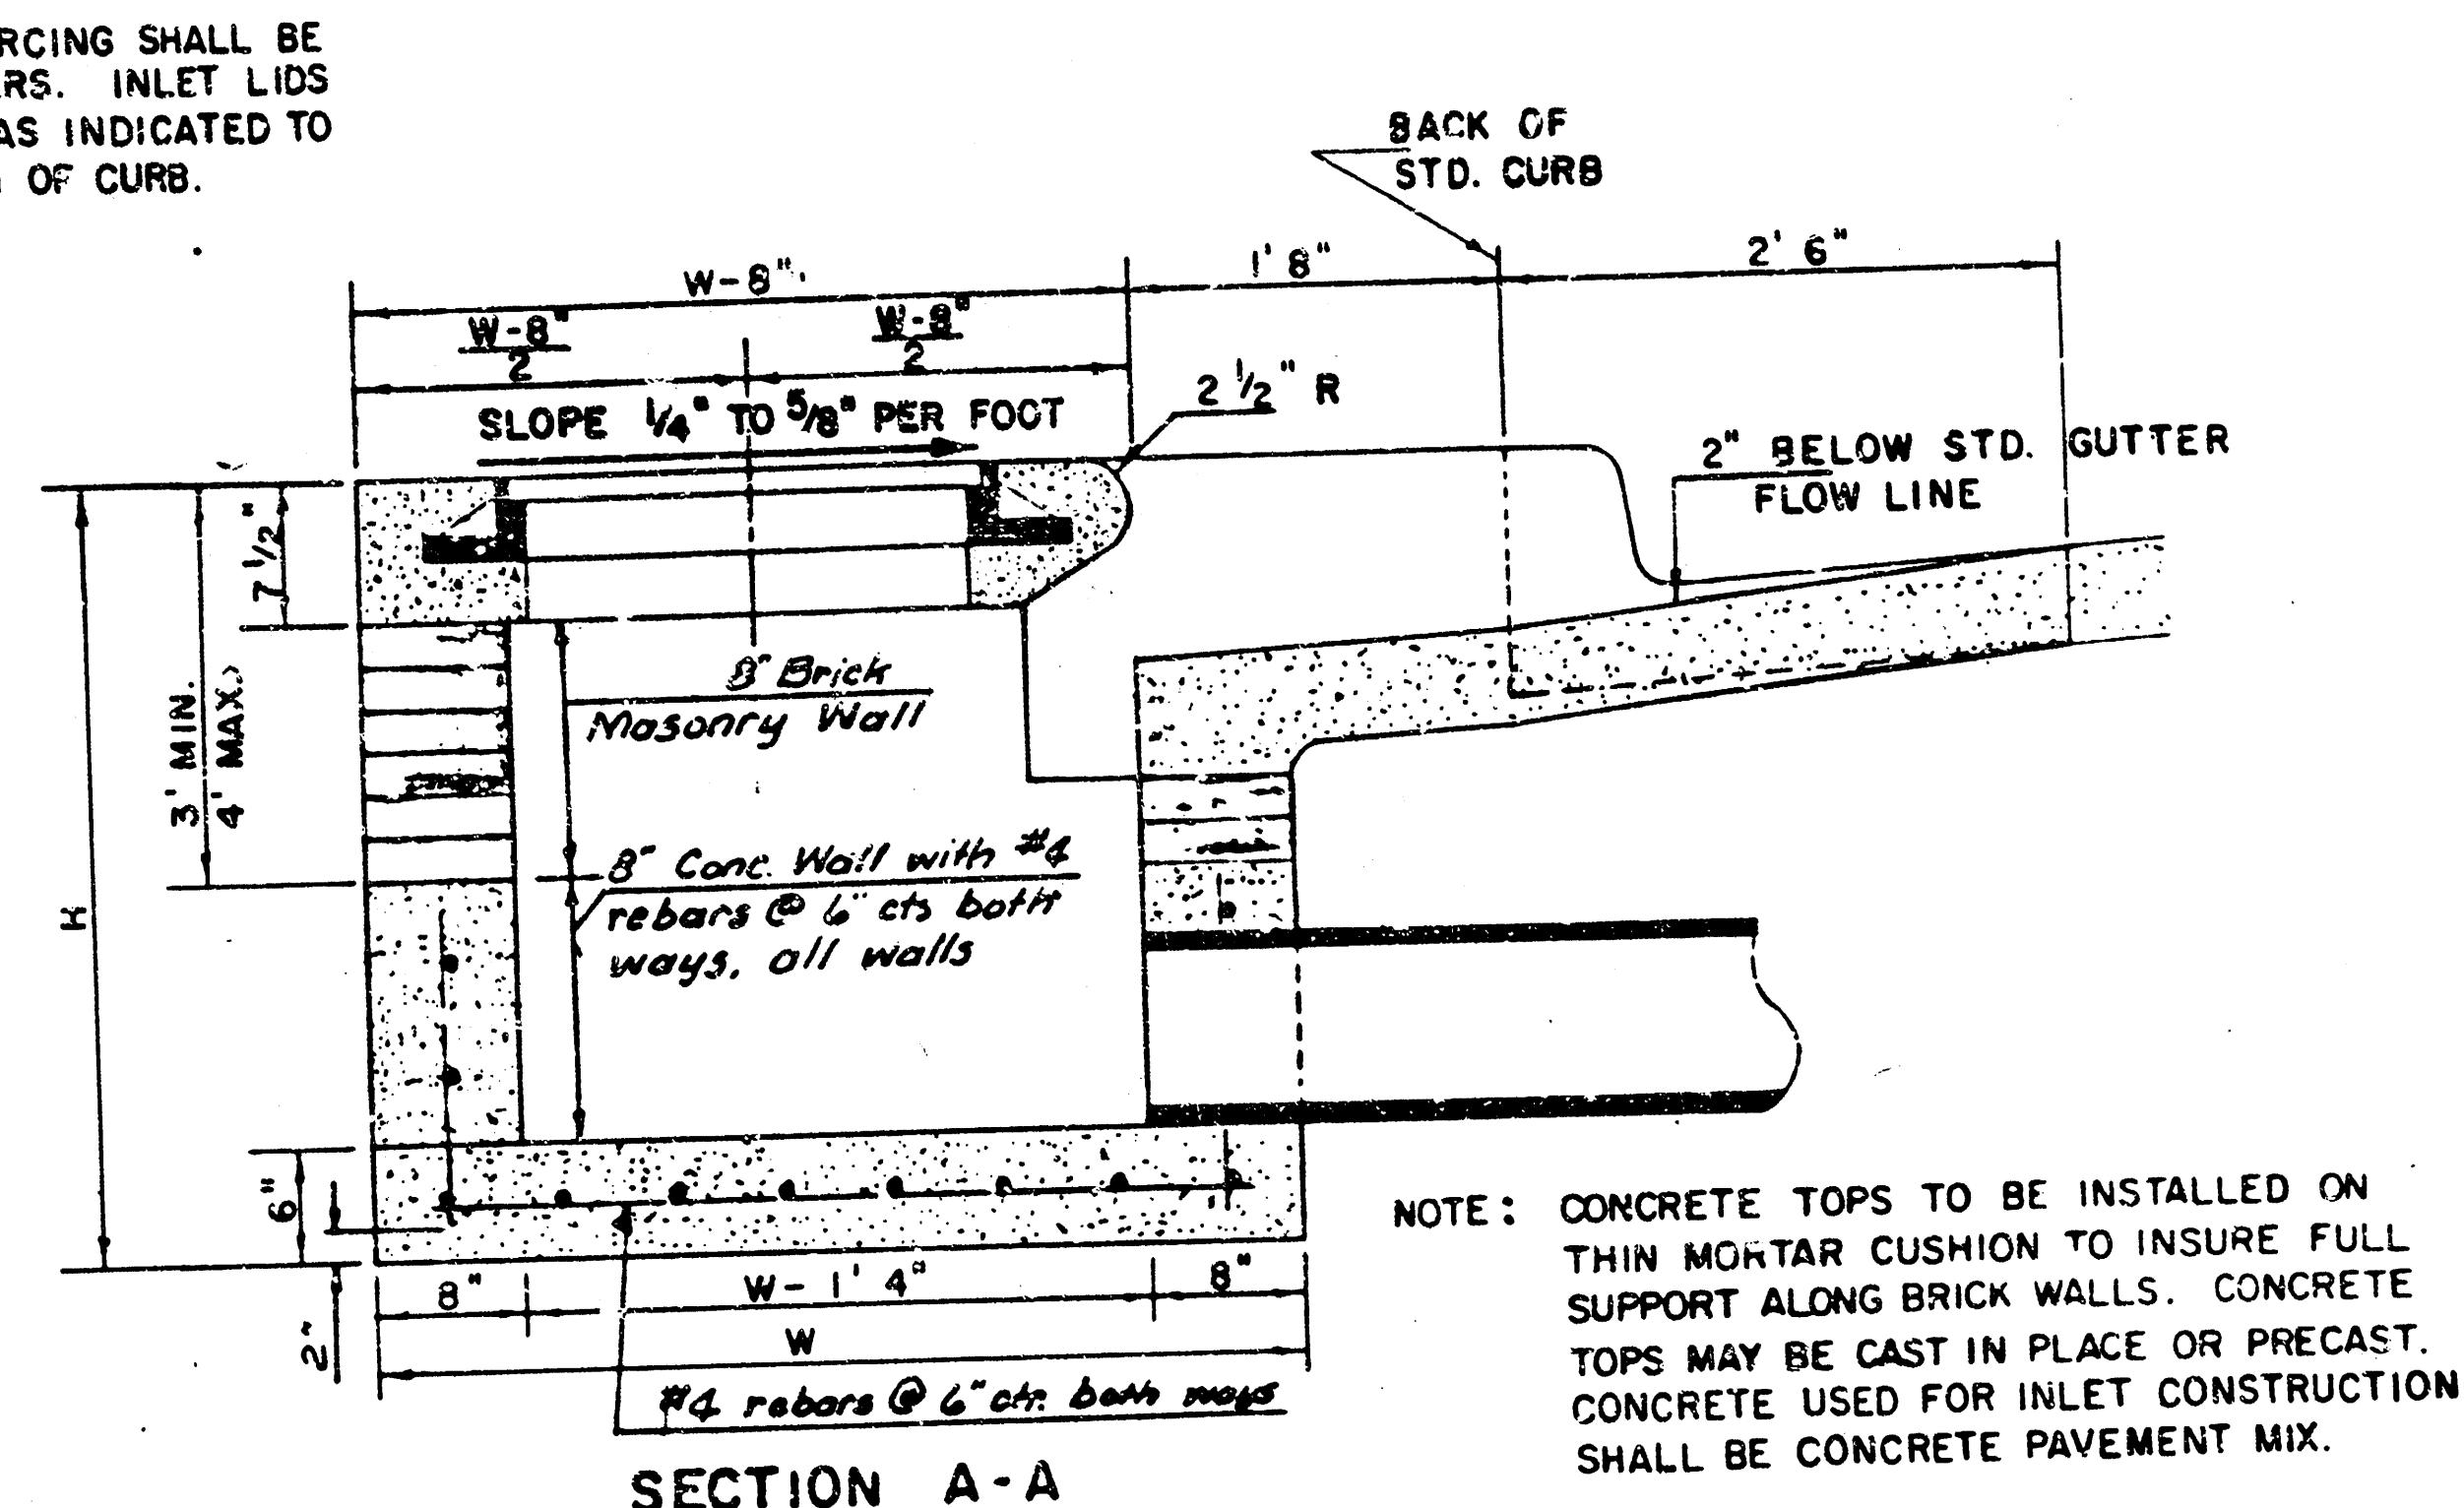


NOTE: CONTRACTOR SHALL HAVE THE OPTION OF CONSTRUCTING 8" BRICK MASONRY WALLS BETWEEN THE CONCRETE INLET BASE AND TOP ON THIS INLET WHEN W = 6'4" AND H = 7'0" OR LESS.

ADDITIONAL CURB AND GUTTER CONSTRUCTION NECESSARY TO CONNECT SET-BACK INLET TO PAVEMENT WILL BE PAID FOR AT THE UNIT PRICE BID FOR EACH INLET HOOKUP.

INLET INVERT SHALL BE SHAPED WITH 8 SACK SAND MIX CONCRETE TO CREATE FLOW CHANNELS AND TO INCREASE HYDRAULIC EFFICIENCY SUCH THAT THE INLET WILL BE SELF CLEANING BETWEEN ALL INLET AND/OR OUTLET PIPES.

THE ENDS OF ALL PIPES INSTALLED IN INLETS SHALL BE CUT OFF FLUSH WITH THE INSIDE FACE OF THE INLET WALL.

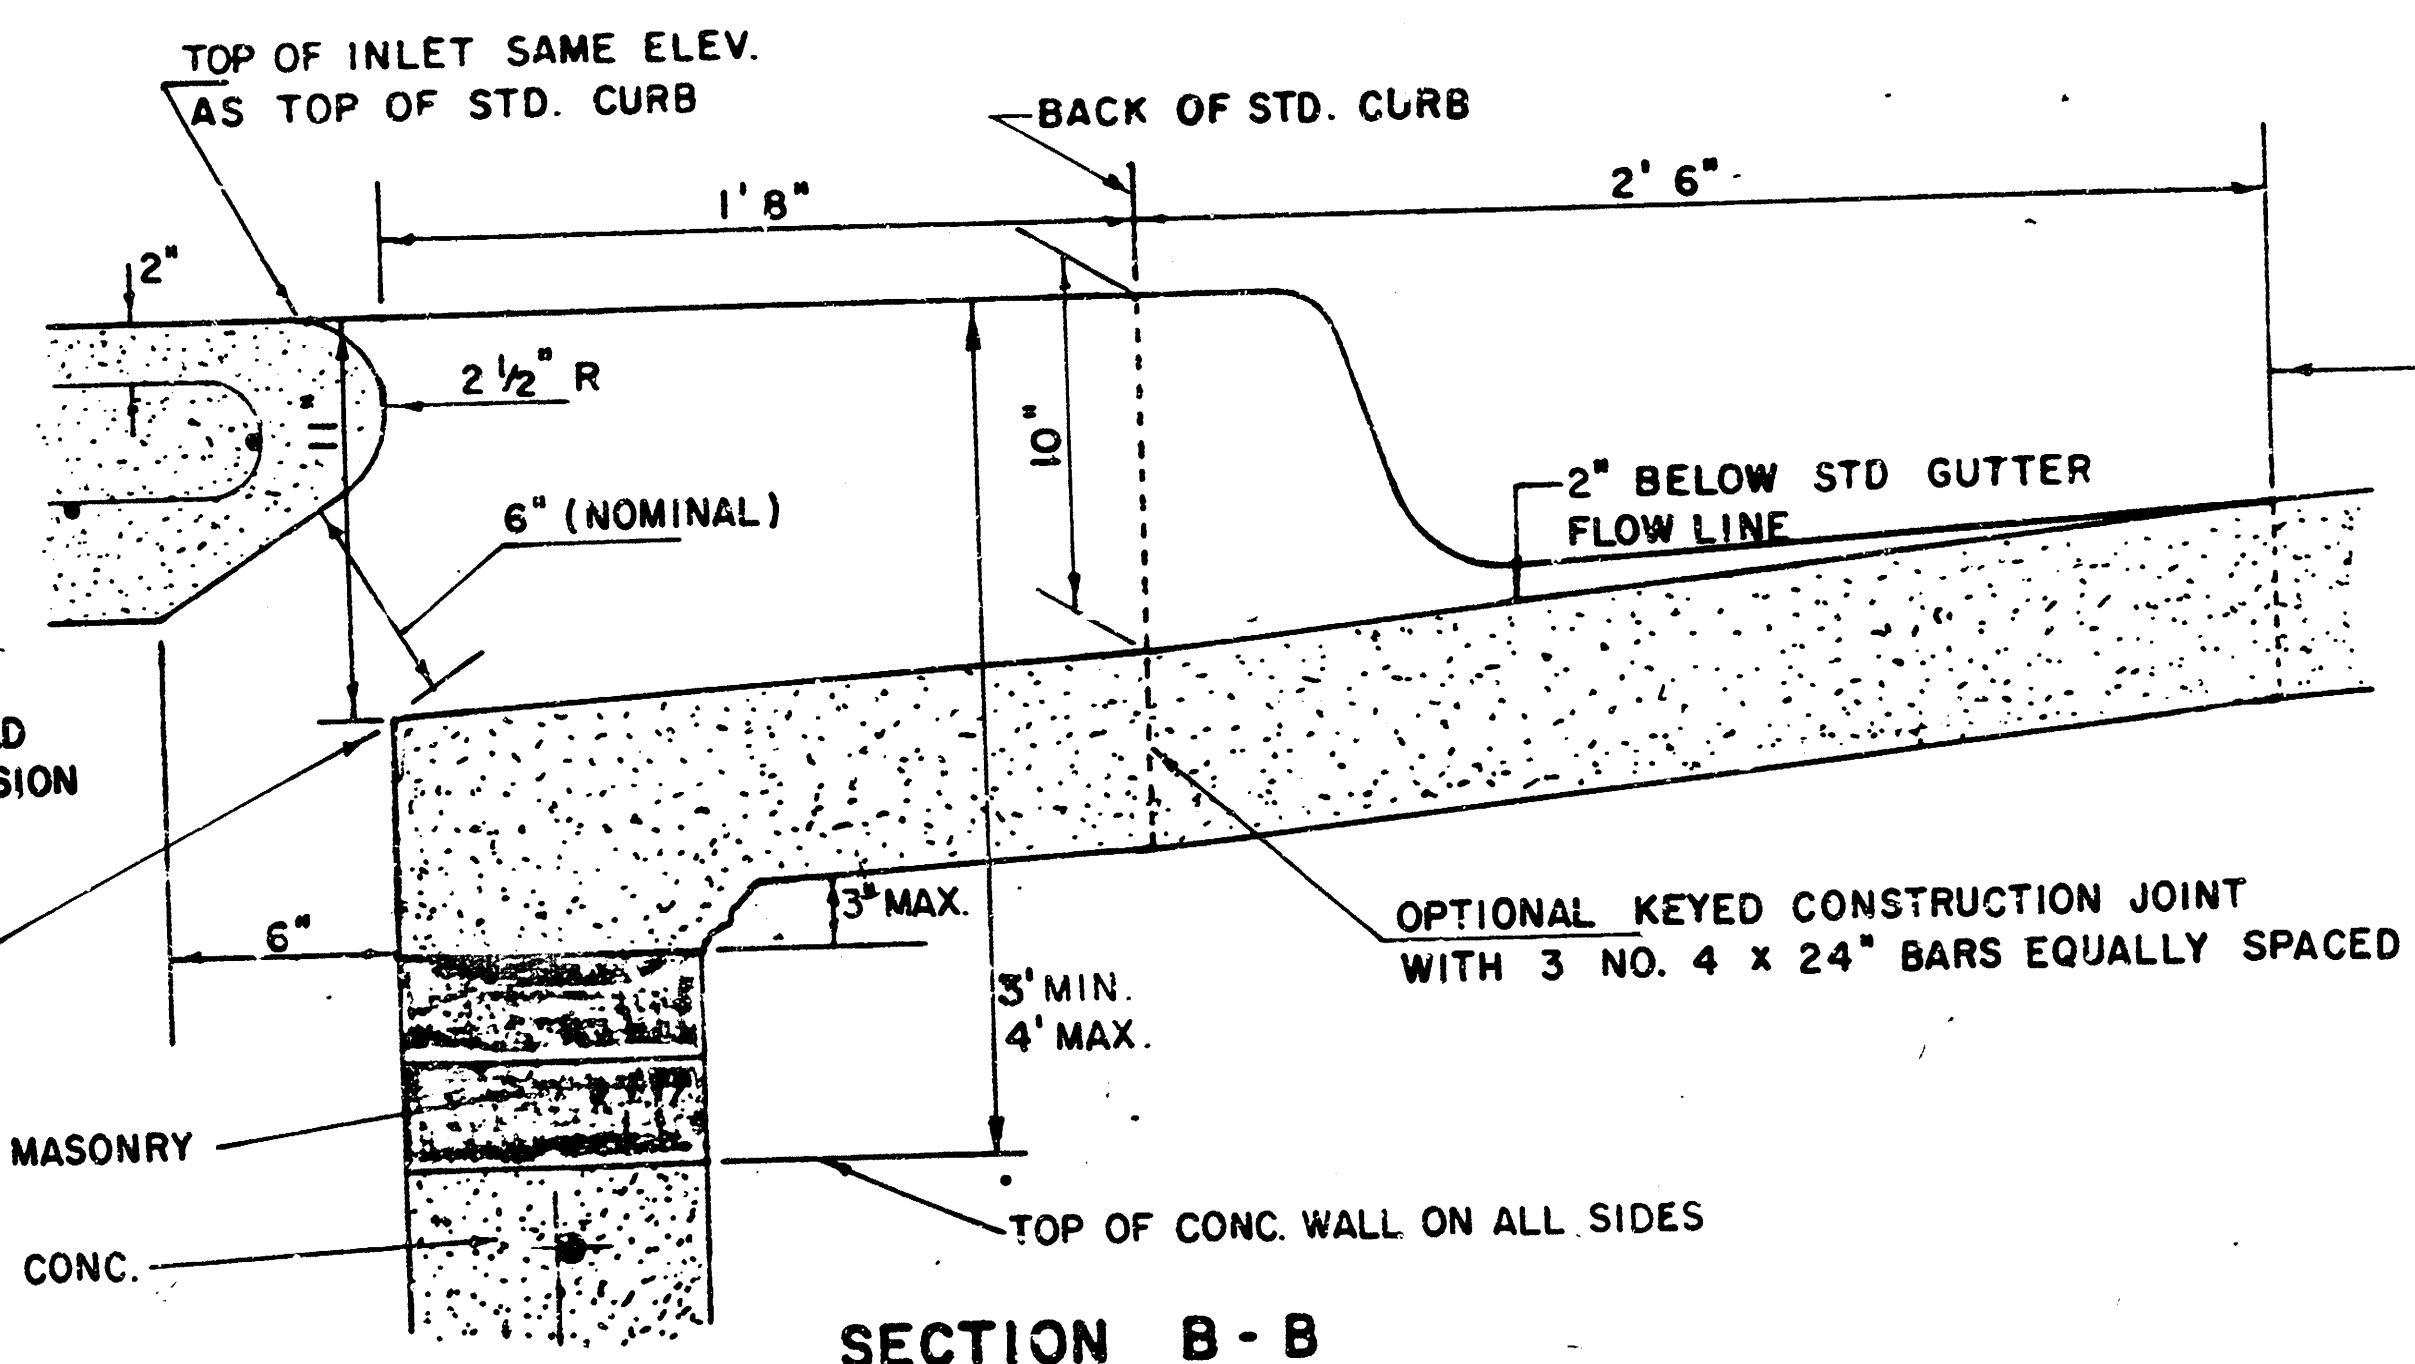

REVISED 12-21-1984 Proj. No. 468 T6 245 8/661 000 000 001

DETAIL STANDARD TYPE 1A CURB INLET

CITY OF WICHITA, KANSAS

INLET OPENING = 6" x 5'0"

JUNE 1984 Sheet No. 10 of 13

MANHOLE FRAME AND COVER DETAIL


ADOPTED AS STANDARD DESIGN

BY

City of Wichita, Kansas


MANHOLE COVER

Weight: 180 Lbs.

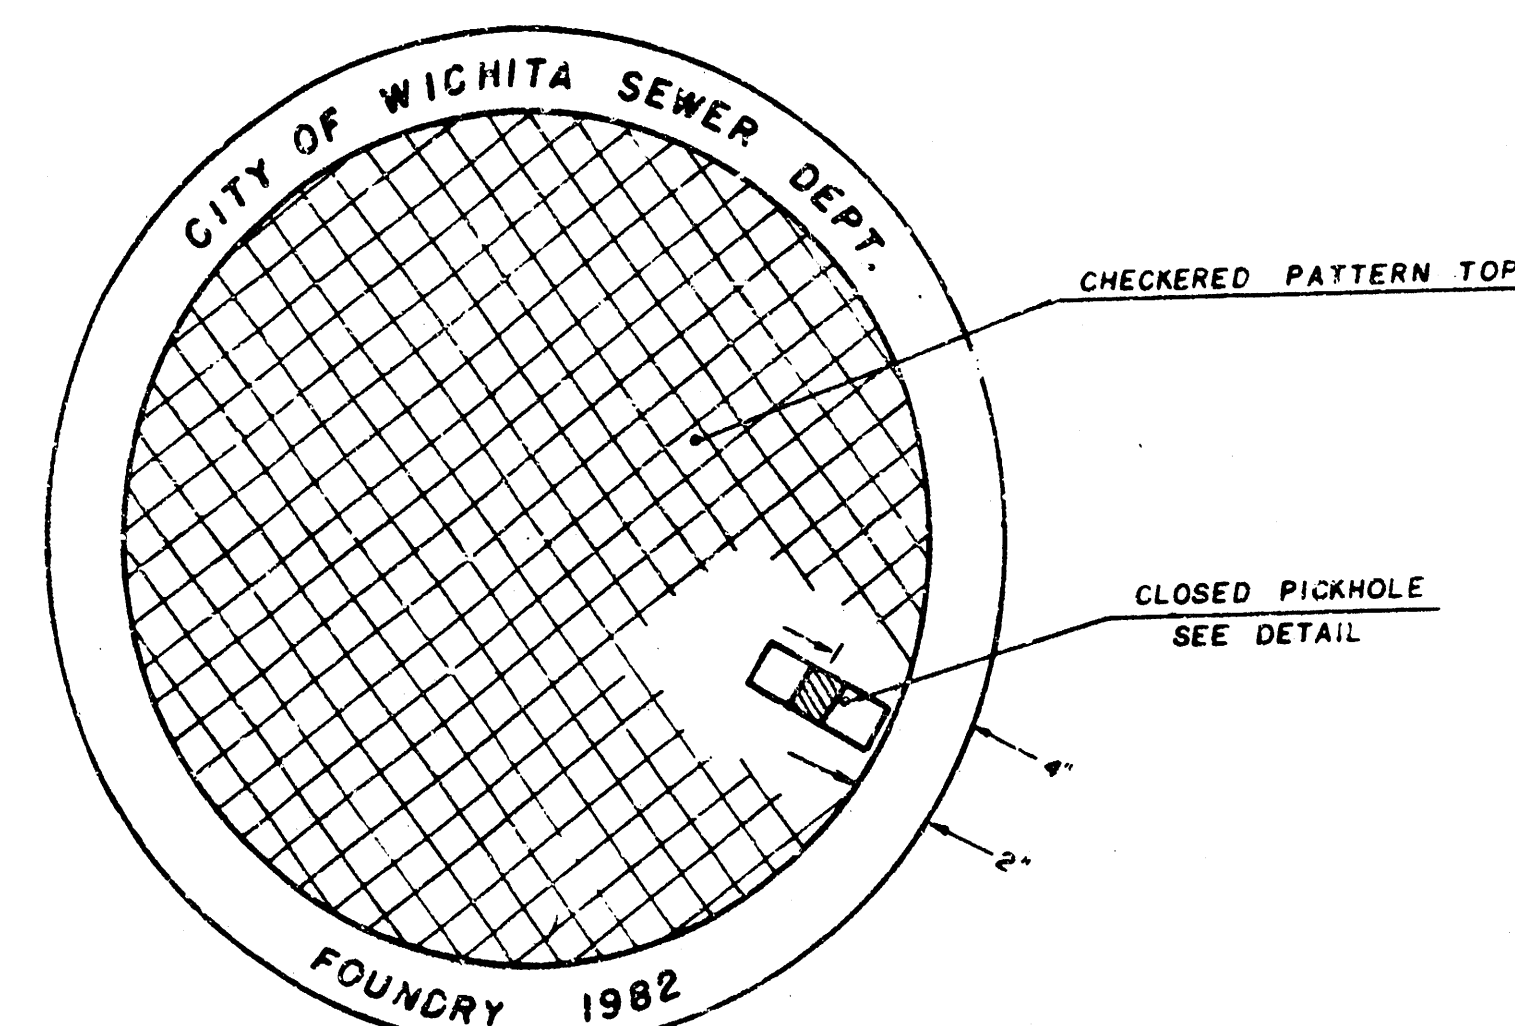


TOP VIEW


PICKHOLE DETAIL

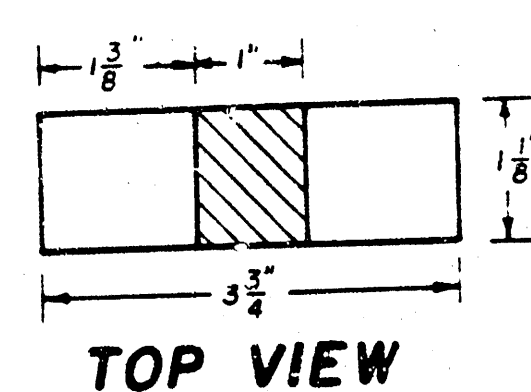


TOP VIEW

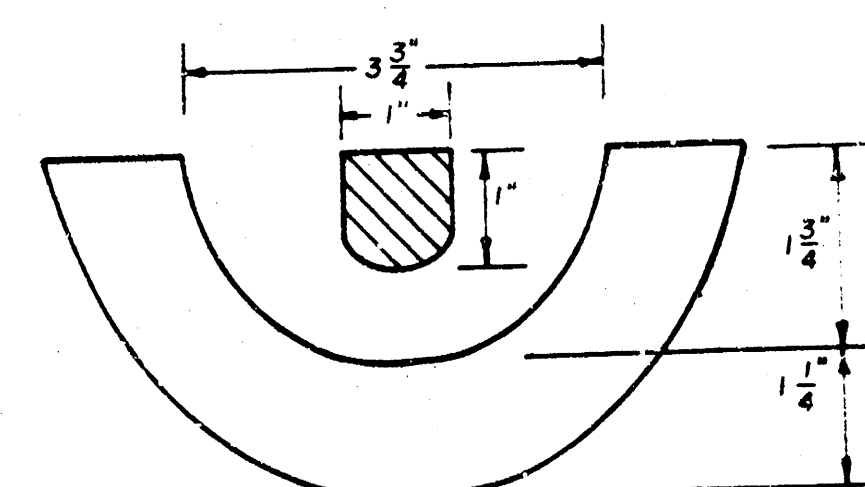

SECTION VIEW

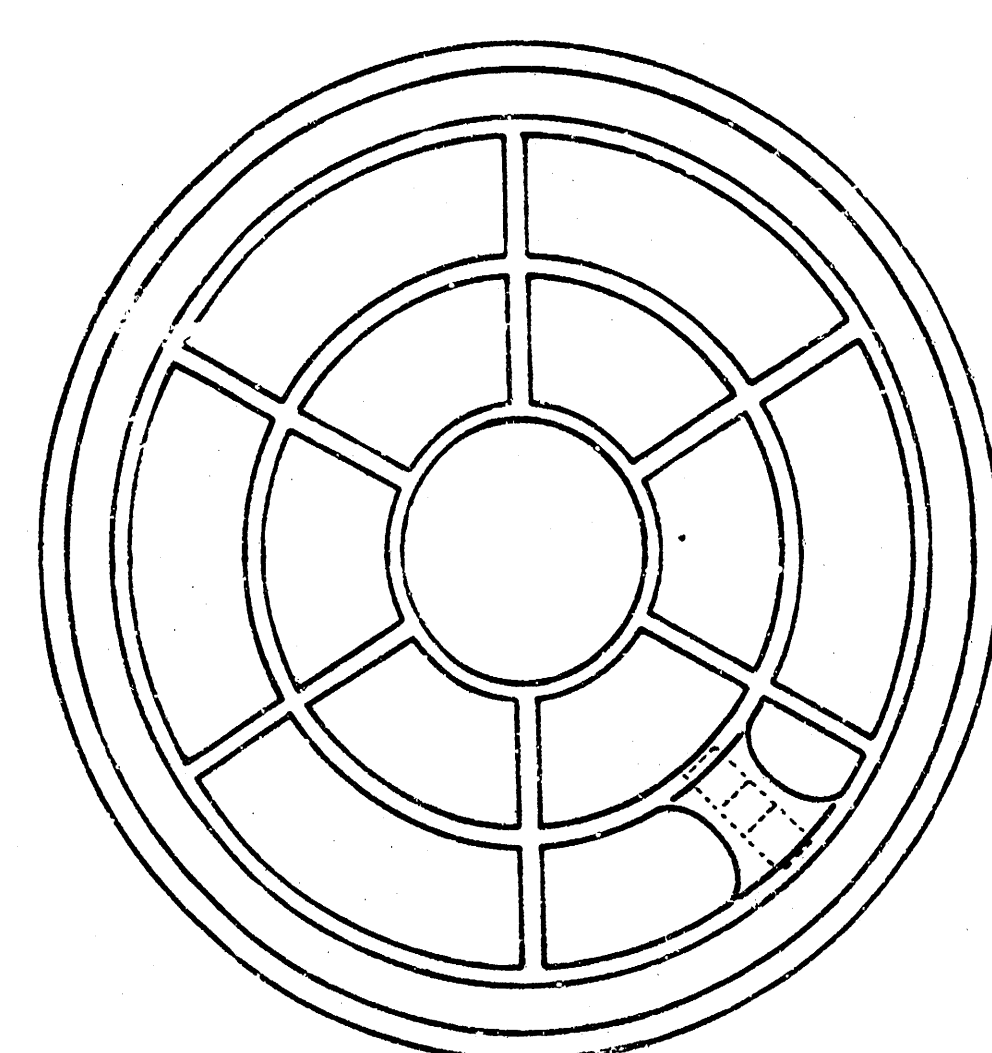

BOTTOM VIEW

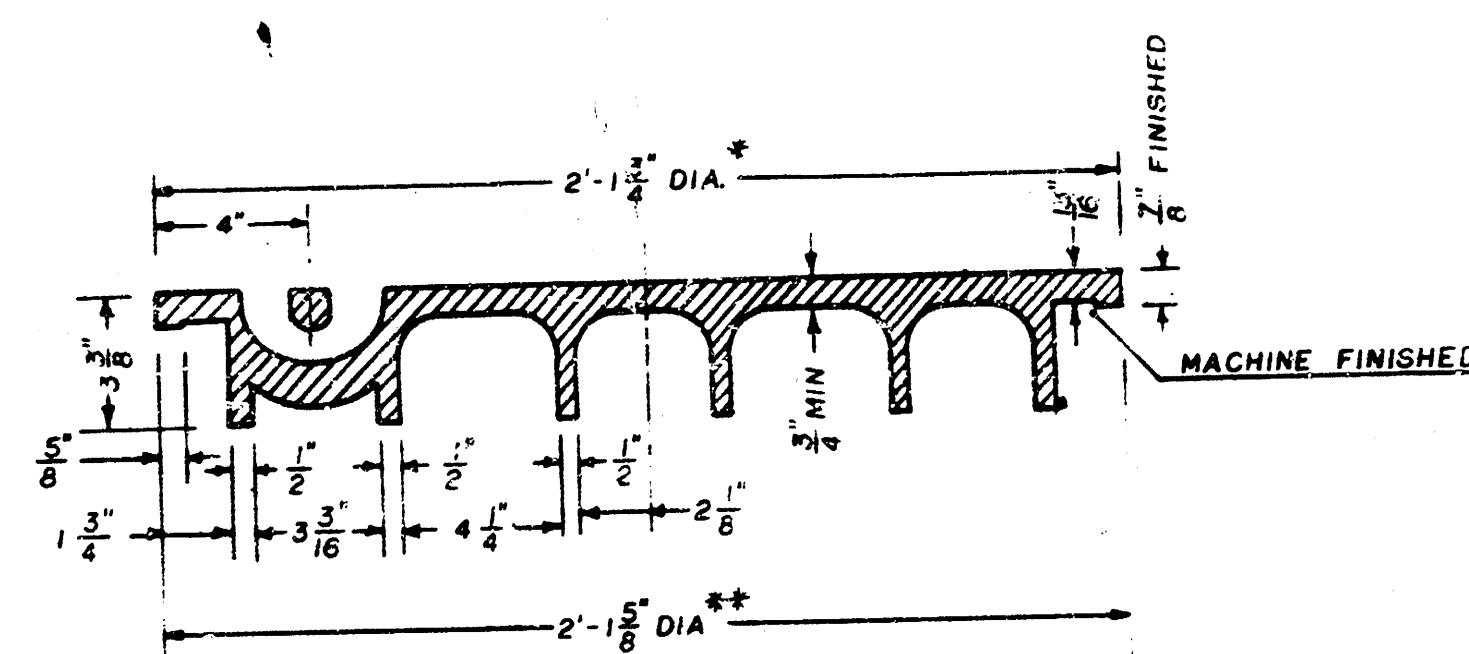


SECTION VIEW


* OUTSIDE DIA. TOP OF COVER
** OUTSIDE DIA. BOTTOM OF COVER

MANHOLE FRAME

Weight: 240 Lbs.

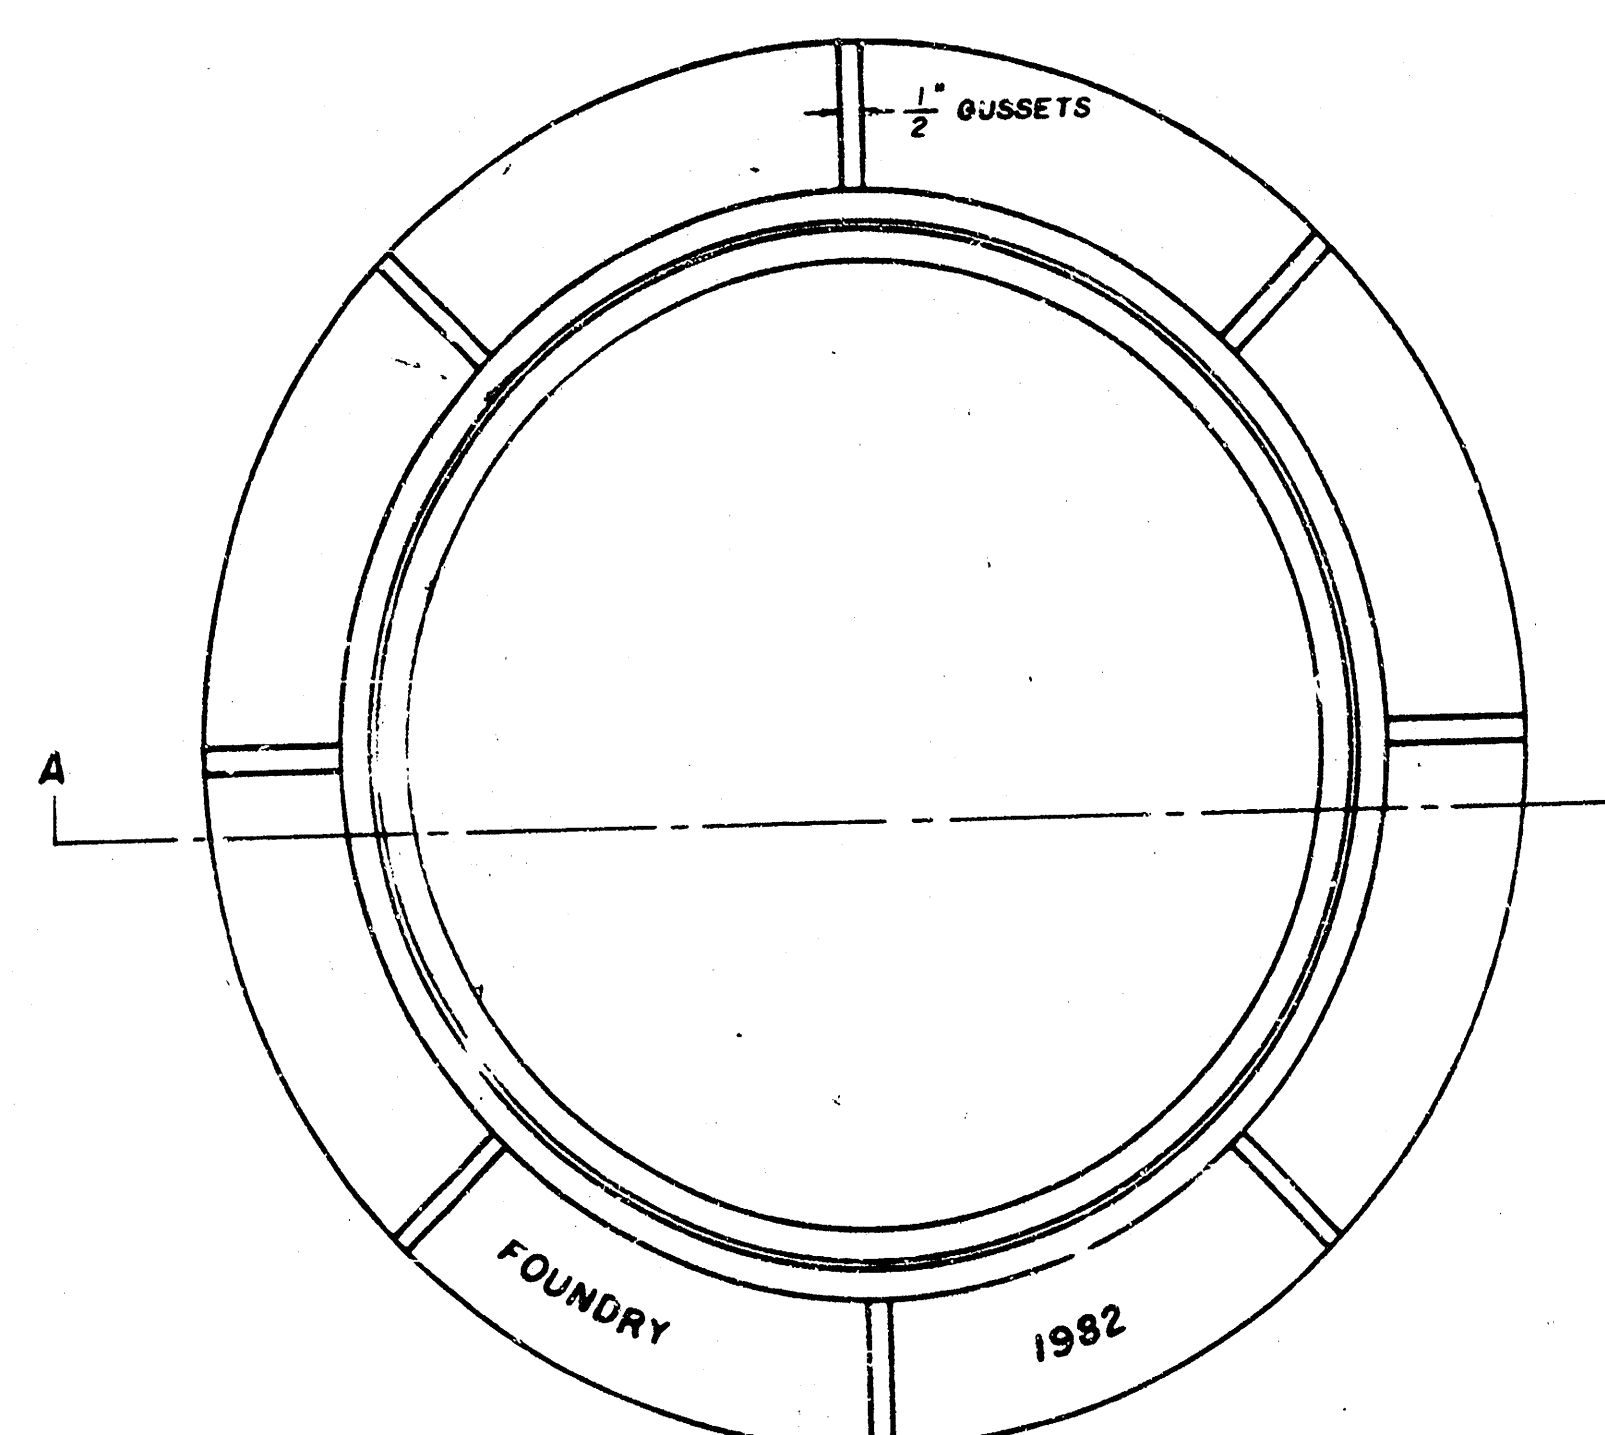

TOP VIEW

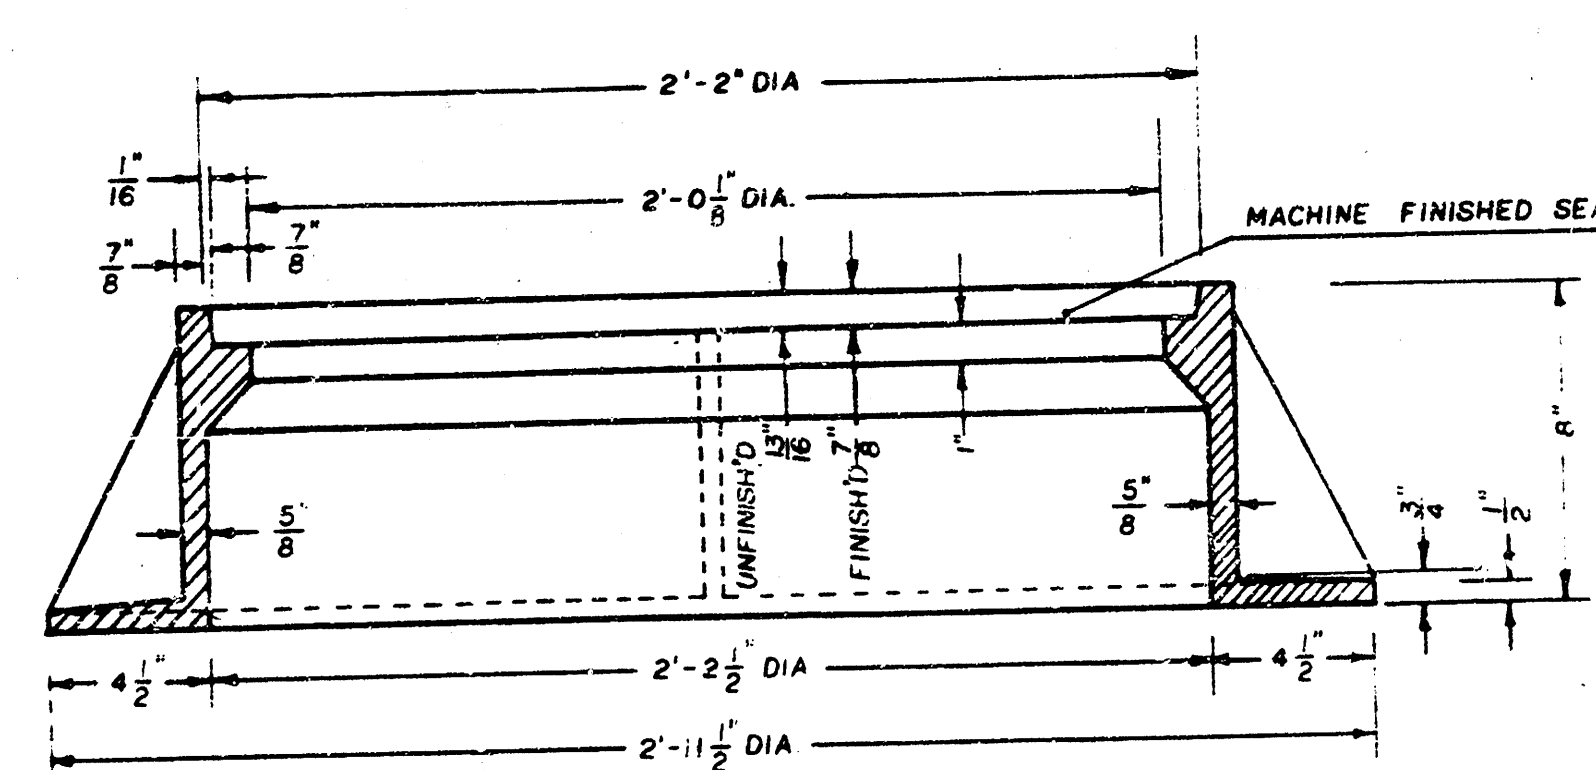


SECTION A-A

GENERAL NOTES

1. MANHOLE CASTINGS SHALL BE MANUFACTURED USING GOOD QUALITY GRAY IRON CONFORMING TO CLASS 30 OF A.S.T.M. DESIGNATION A-48. DIMENSIONS AND WEIGHTS SHOWN ON THE DETAIL DRAWINGS SHALL BE CONSIDERED AS MINIMUM REQUIREMENTS AND ANY DEVIATIONS FROM THE DIMENSIONS SHOWN MUST BE SPECIFICALLY APPROVED. THE FINISHED CASTINGS SHALL BE OF UNIFORM QUALITY, FREE FROM BLOWHOLES, POROSITY, HARD SPOTS, SHRINKAGE DISTORTIONS OR OTHER DEFECTS.
2. MANHOLE CASTINGS SHALL BE COATED WITH AN ASPHALT PAINT RESULTING IN A SMOOTH, TOUGH AND TENACIOUS COATING WHICH IS NOT BRITTLE OR TACKY.
3. MANHOLE CASTINGS SHALL BE MANUFACTURED SUCH THAT A COVER MANUFACTURED BY ANY ONE FOUNDRY WILL FIT INTERCHANGEABLY INTO A FRAME MANUFACTURED BY ANOTHER FOUNDRY AND STILL MEET ALLOWABLE CLEARANCES AND NON-ROCKING REQUIREMENTS. THIS WILL REQUIRE MANUFACTURING OF THE MATCHING FACES ON THE COVER AND THE FRAME TO CLOSE TOLERANCES.
4. THE OUTSIDE CIRCUMFERENCE OF THE VERTICAL FACE OF THE COVER AND THE INSIDE CIRCUMFERENCE OF THE VERTICAL FACE IN THE FRAME RECESS SHALL BE MANUFACTURED TO TOLERANCES SUCH THAT THE CLEARANCE BETWEEN THE COVER AND FRAME WILL NOT EXCEED 1/8" AT ANY POINT AROUND THE CIRCUMFERENCE OF THE COVER. THE SEATING SURFACES BETWEEN THE COVER AND FRAME SHALL BE MACHINED SUCH THAT THESE SURFACES SHALL MAKE FULL CONTACT FOR THEIR FULL CIRCUMFERENCE TO PRECLUDE THE COVER FROM ROCKING IN THE FRAME.
5. THE MANHOLE FRAME AND COVER SHALL BE MARKED WITH LETTERING INDICATING THE NAME OF THE MANUFACTURER AND THE YEAR WHEN THE COVER OR FRAME WAS CAST. THE COVER SHALL BE FURTHER IDENTIFIED WITH REGARDS TO OWNERSHIP USING LETTERS AT LEAST 1" IN HEIGHT. THIS IDENTIFICATION SHALL BE "CITY OF WICHITA SEWER DEPARTMENT". THE WORD DEPARTMENT MAY BE ABBREVIATED. THE TEXTURE OF THE TOP SURFACE OF THE COVER SHALL BE MANUFACTURED IN A CHECKERED PATTERN DESIGN AS INDICATED ON THE DRAWINGS. SMOOTH BLOCKOUTS SHALL BE UTILIZED TO HIGHLIGHT THE LETTERING ON THE COVER SURFACE. THE TOTAL AREA OF SMOOTH SURFACE BLOCKOUT SHALL NOT EXCEED THE AREA AS INDICATED ON THE DRAWING. POSITIONING OF SMOOTH BLOCKOUTS AND LETTERING MAY VARY FROM THAT SHOWN ON THE DETAILED DRAWING.

50 40 30 20 10 0 10 20 30 40 50

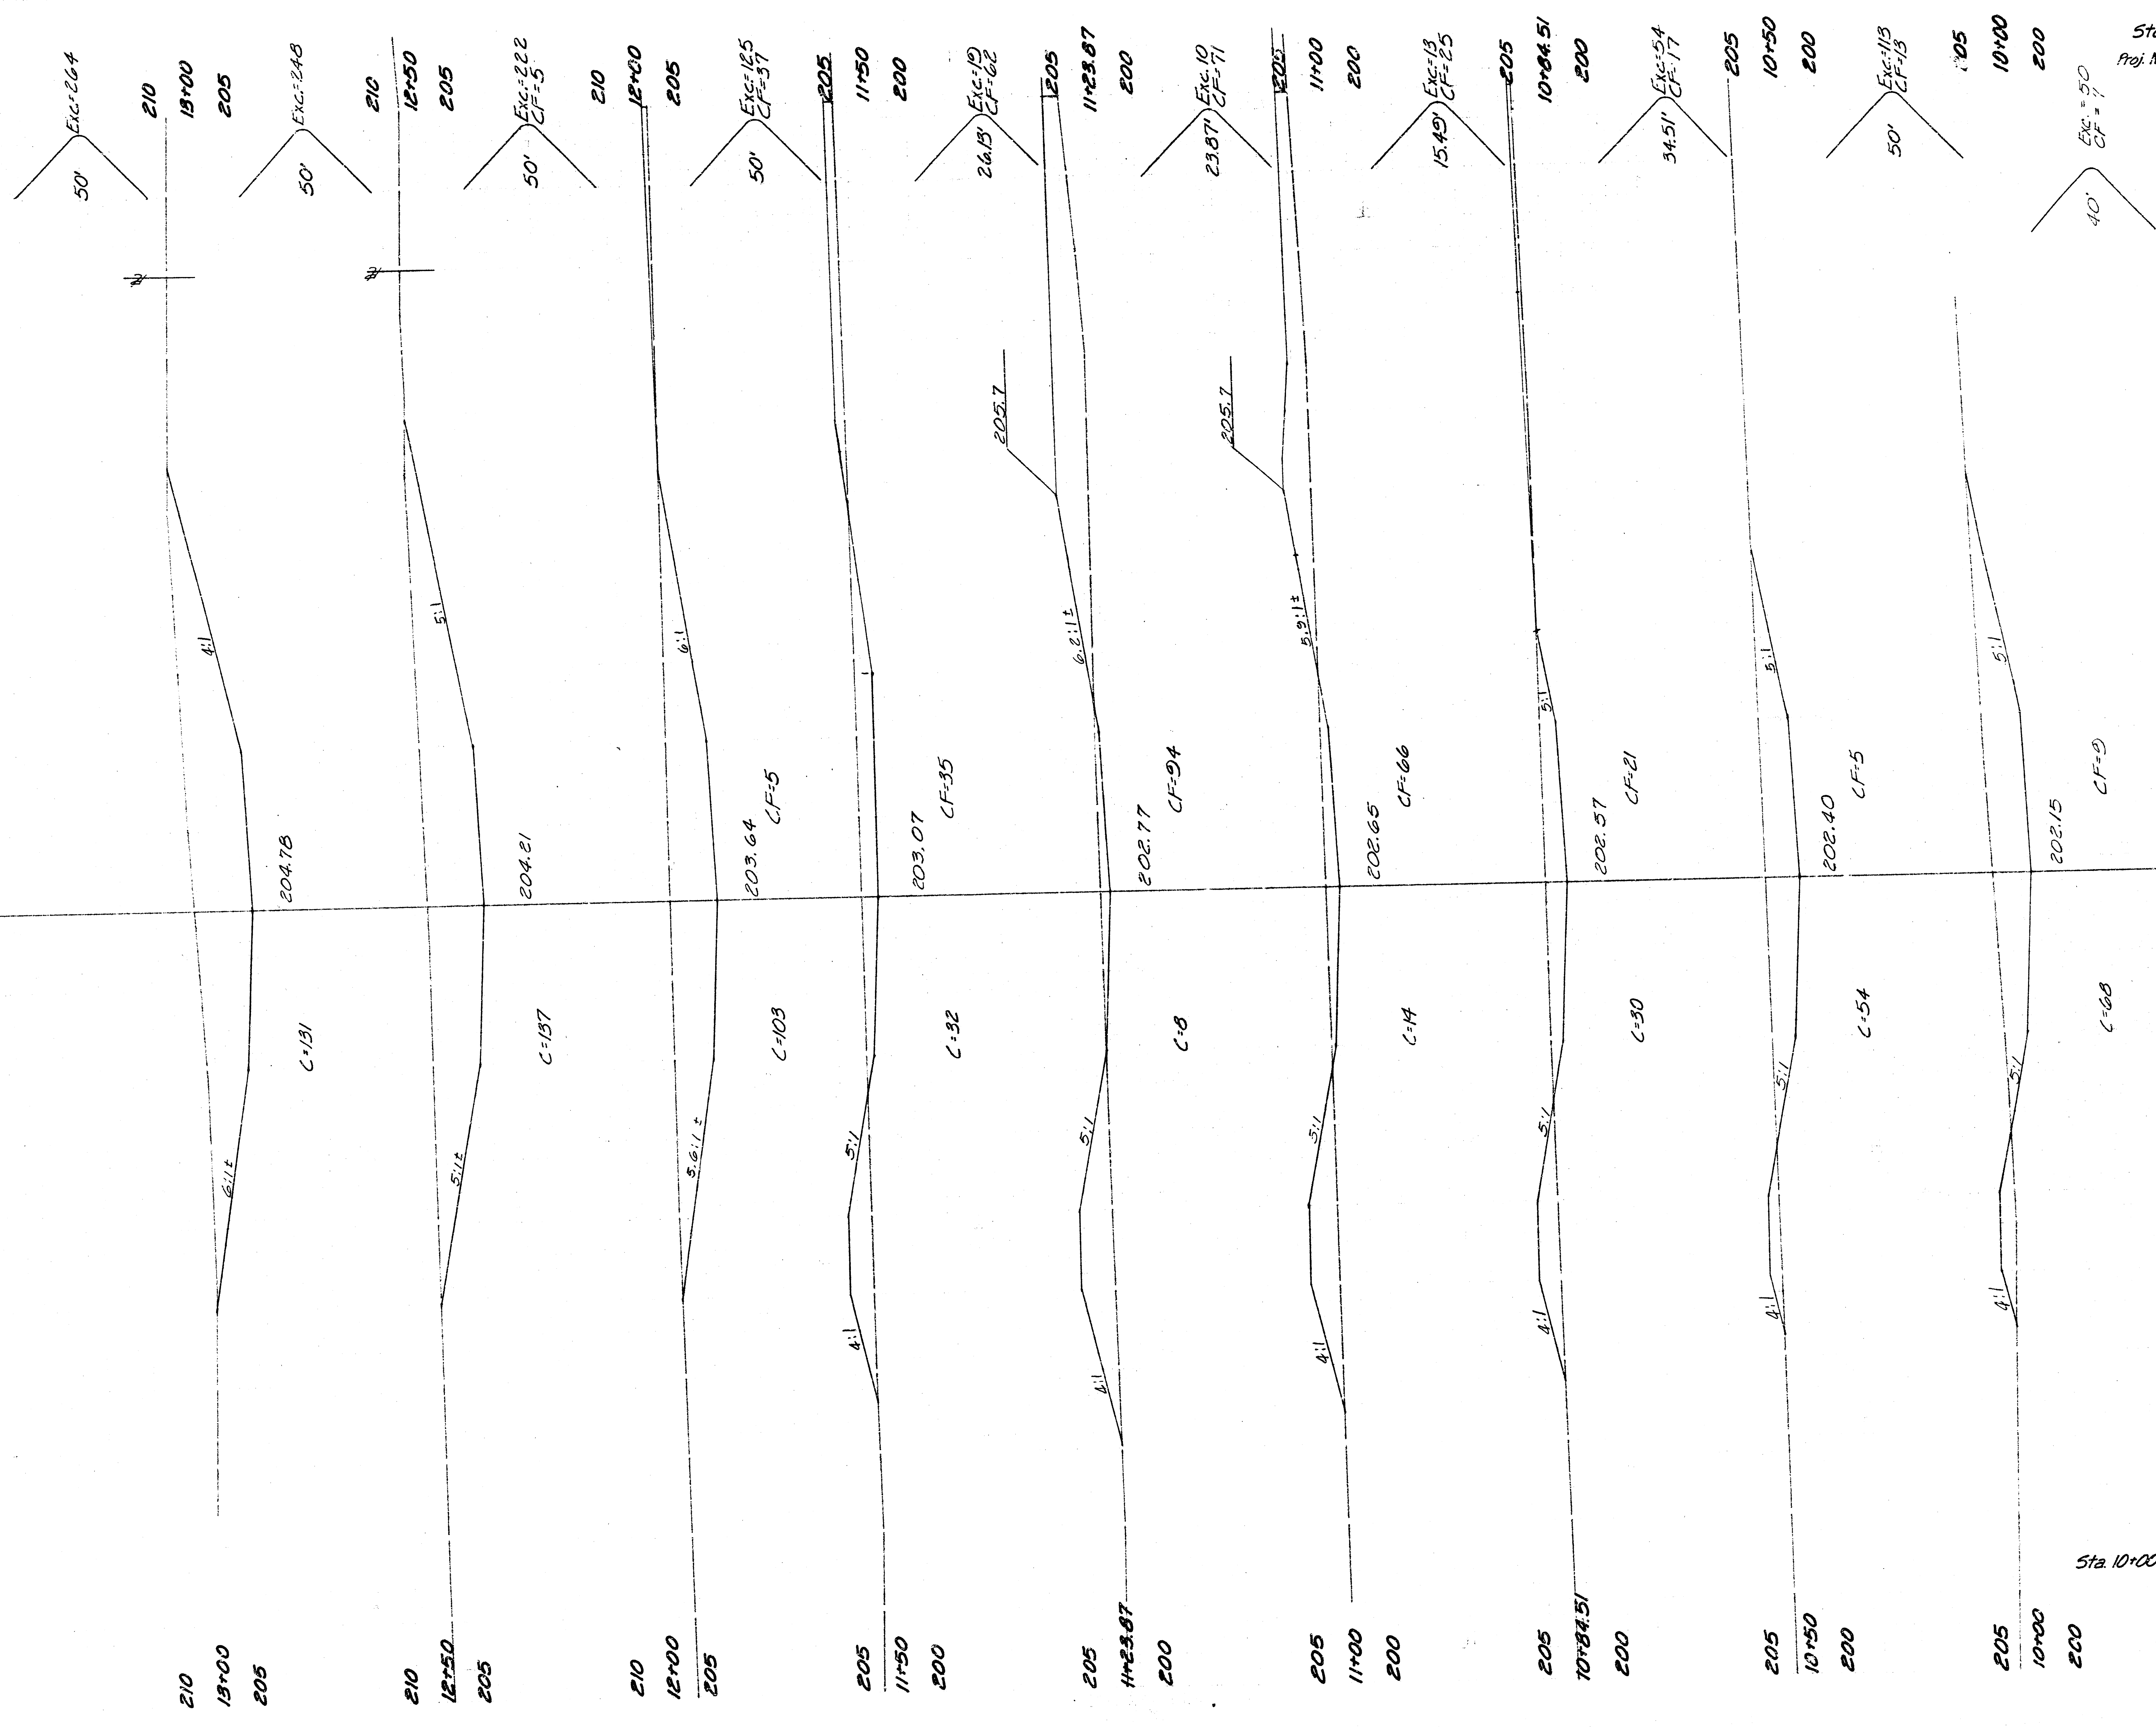

Tallgrass Ph. II
Storm Water Sewer No. 332
Proj. No. 46-B-76-245-81661 000-000-001

Total
Exc=6100 C.Y.
CF=237

Sta. 10+00 to Sta. 13+00

Sheet 12 of 13

Total
Exc=6100 C.Y.
CF=237

12/13

