
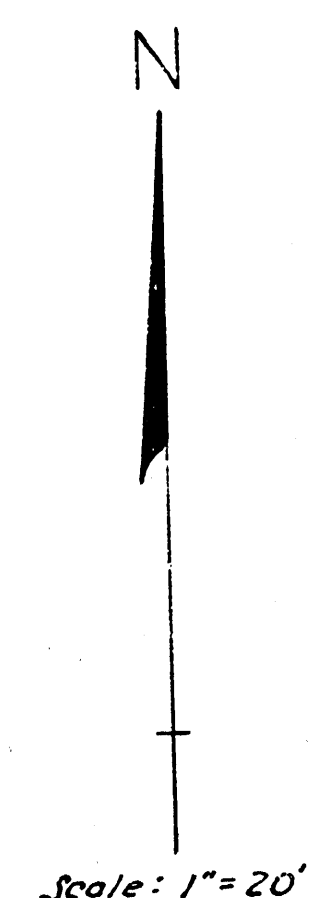


Survey JFG
JLA
G.D. 1963

B.M. 114.02 "X" cut top N. End 6" Conc. Ref. Wall
on S.W. corner Water & First Street.

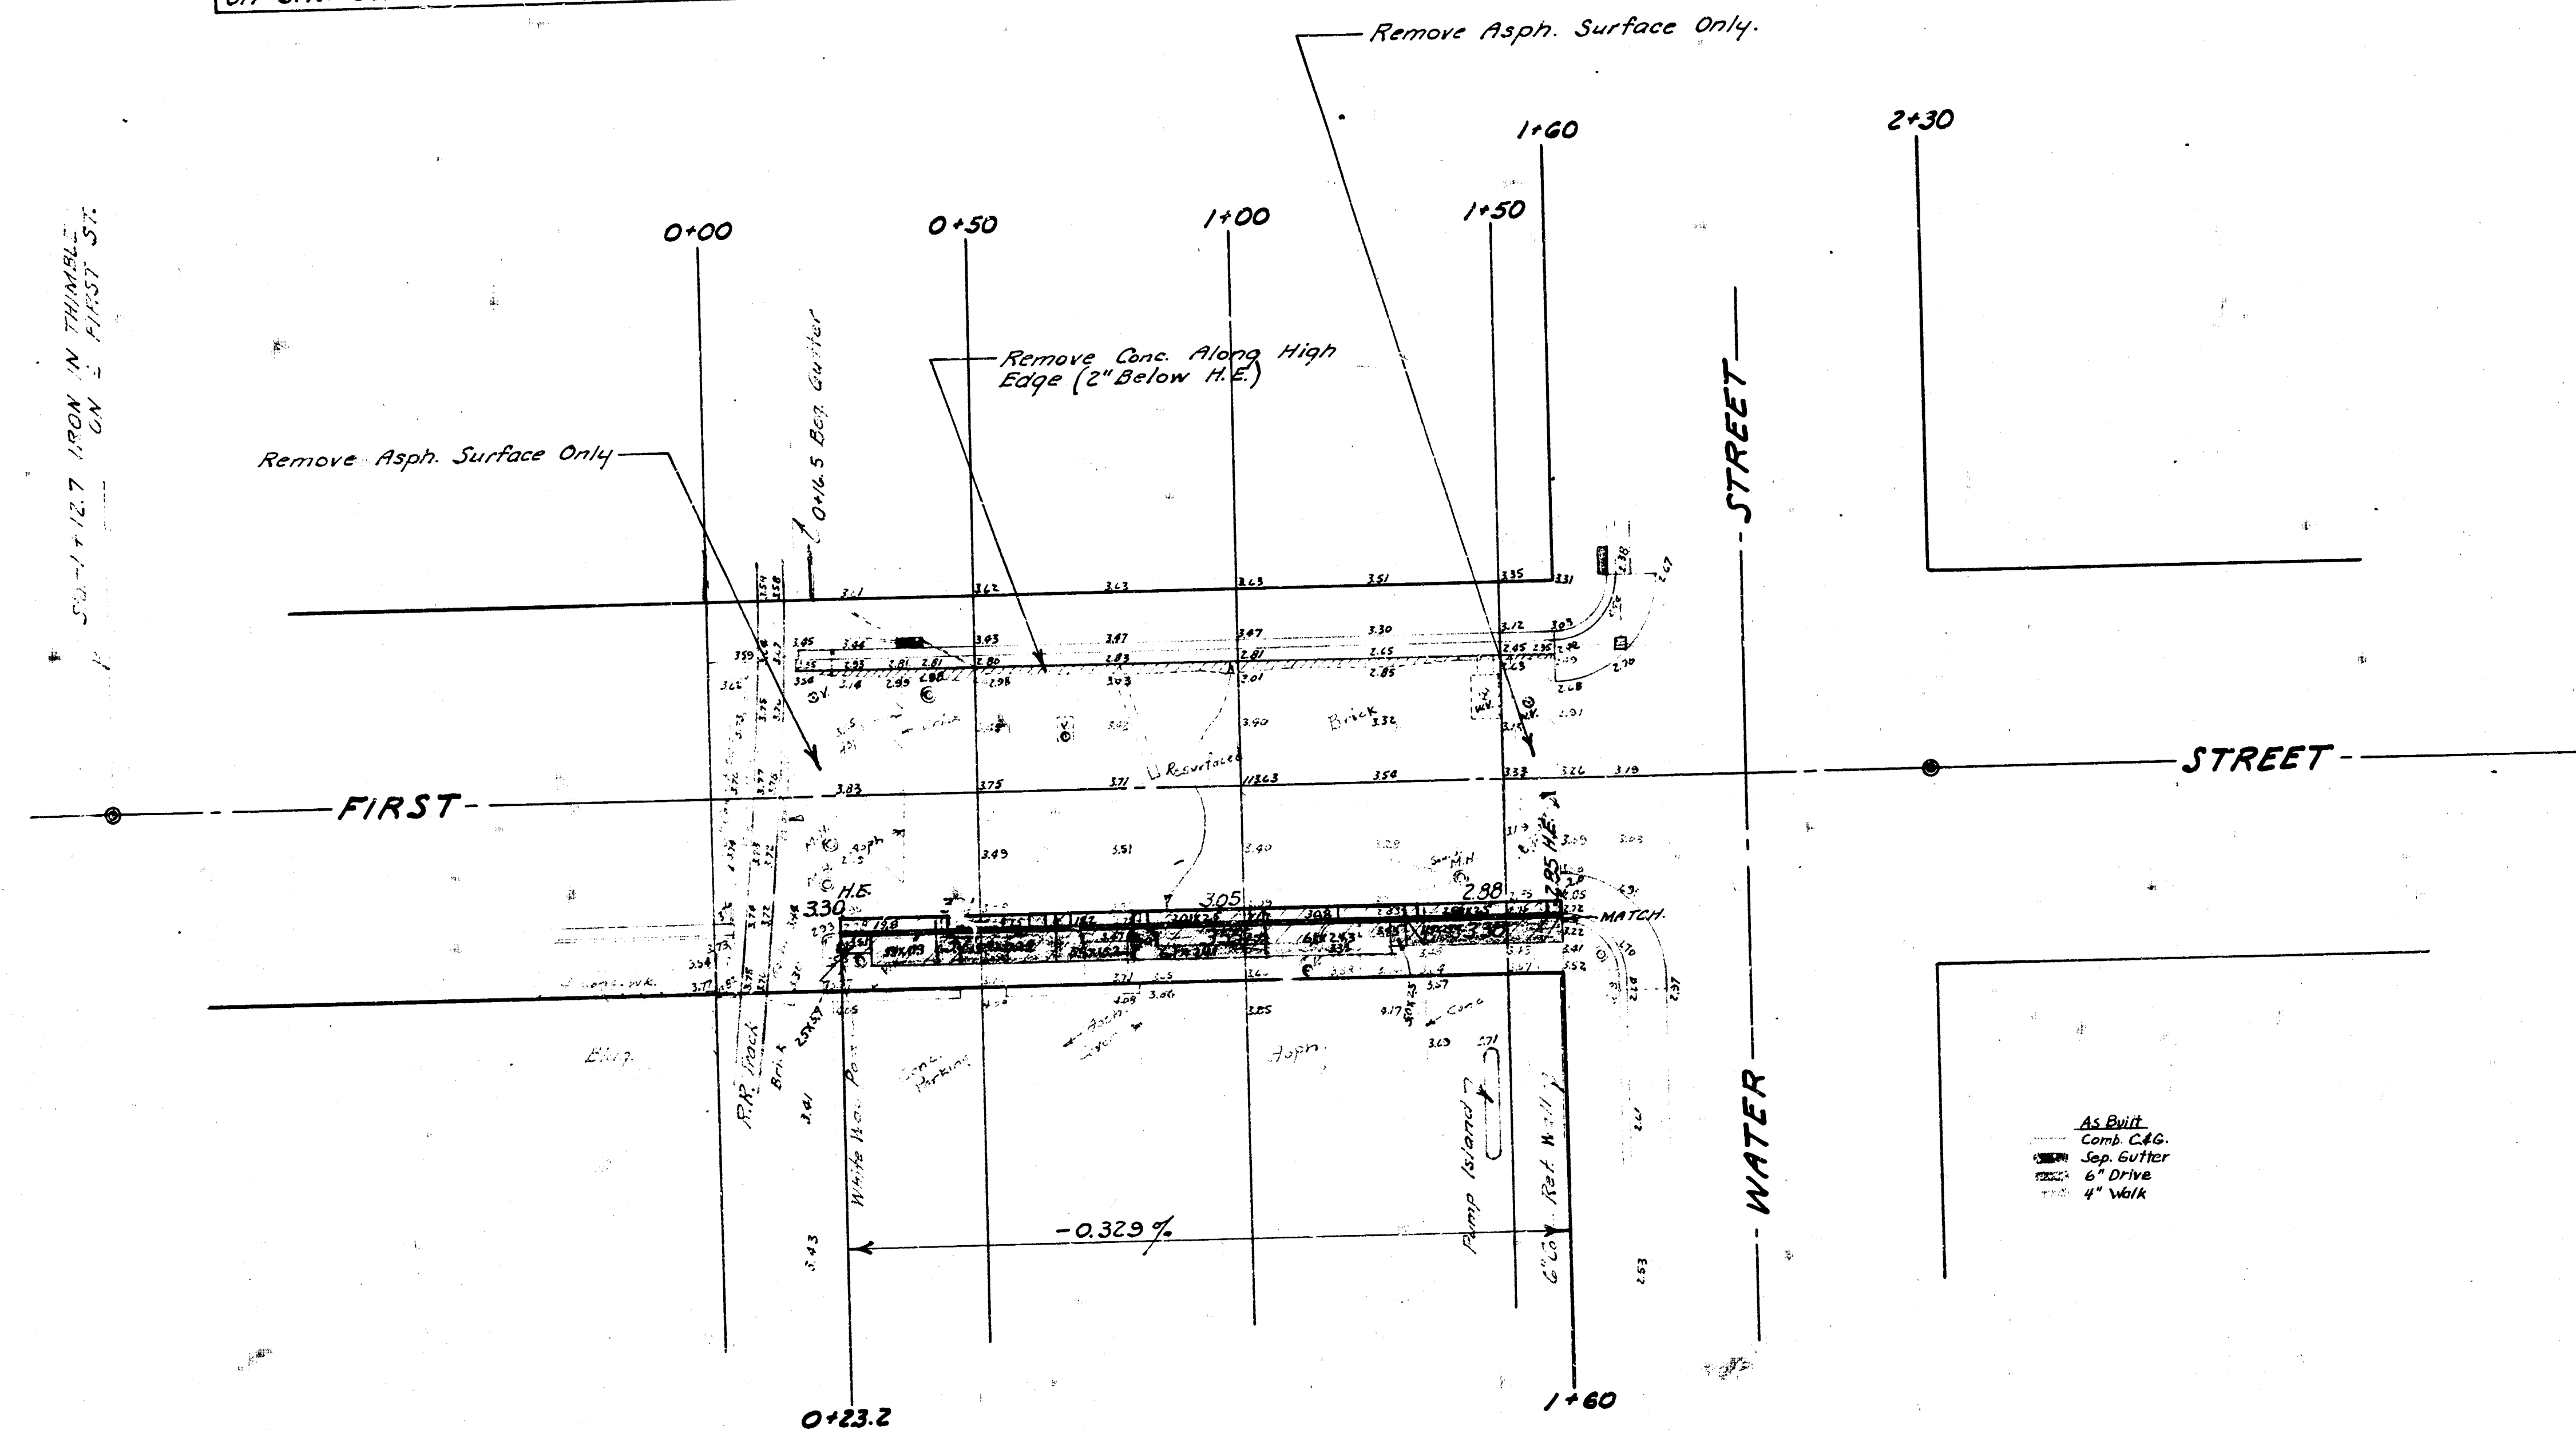

NOTE: Walk & Drive Removal South of
South Curb to be held to a minimum.

As Built
Comb. C&G.
Sep. Gutter
6" Drive
4" Walk



FIRST STREET
FROM 160' W. of W.L. WATER ST.
to the W.L. WATER STREET
Comb. Curb & Gutter-2" Asph.
Surface Improve & Re-improve.
B.E. SMITH CITY ENGINEER
CITY OF WICHITA, KANSAS
SEPT. 1963 Project No. T16-33