


total 1149.2
114.9
1264.1 cu yds excv.


10th ST
E.L. YALE TO W.L. ROOSEVELT
30' CONCRETE & CB.
CITY OF WICHITA, KANS.
L.K. WHITE CITY ENGINEER
1947

30 pages


B.M. 17433 STEP BENCH IN COR. FENCE POST S.W. COR. 10TH + YALE
 +0.538%
 R.C.

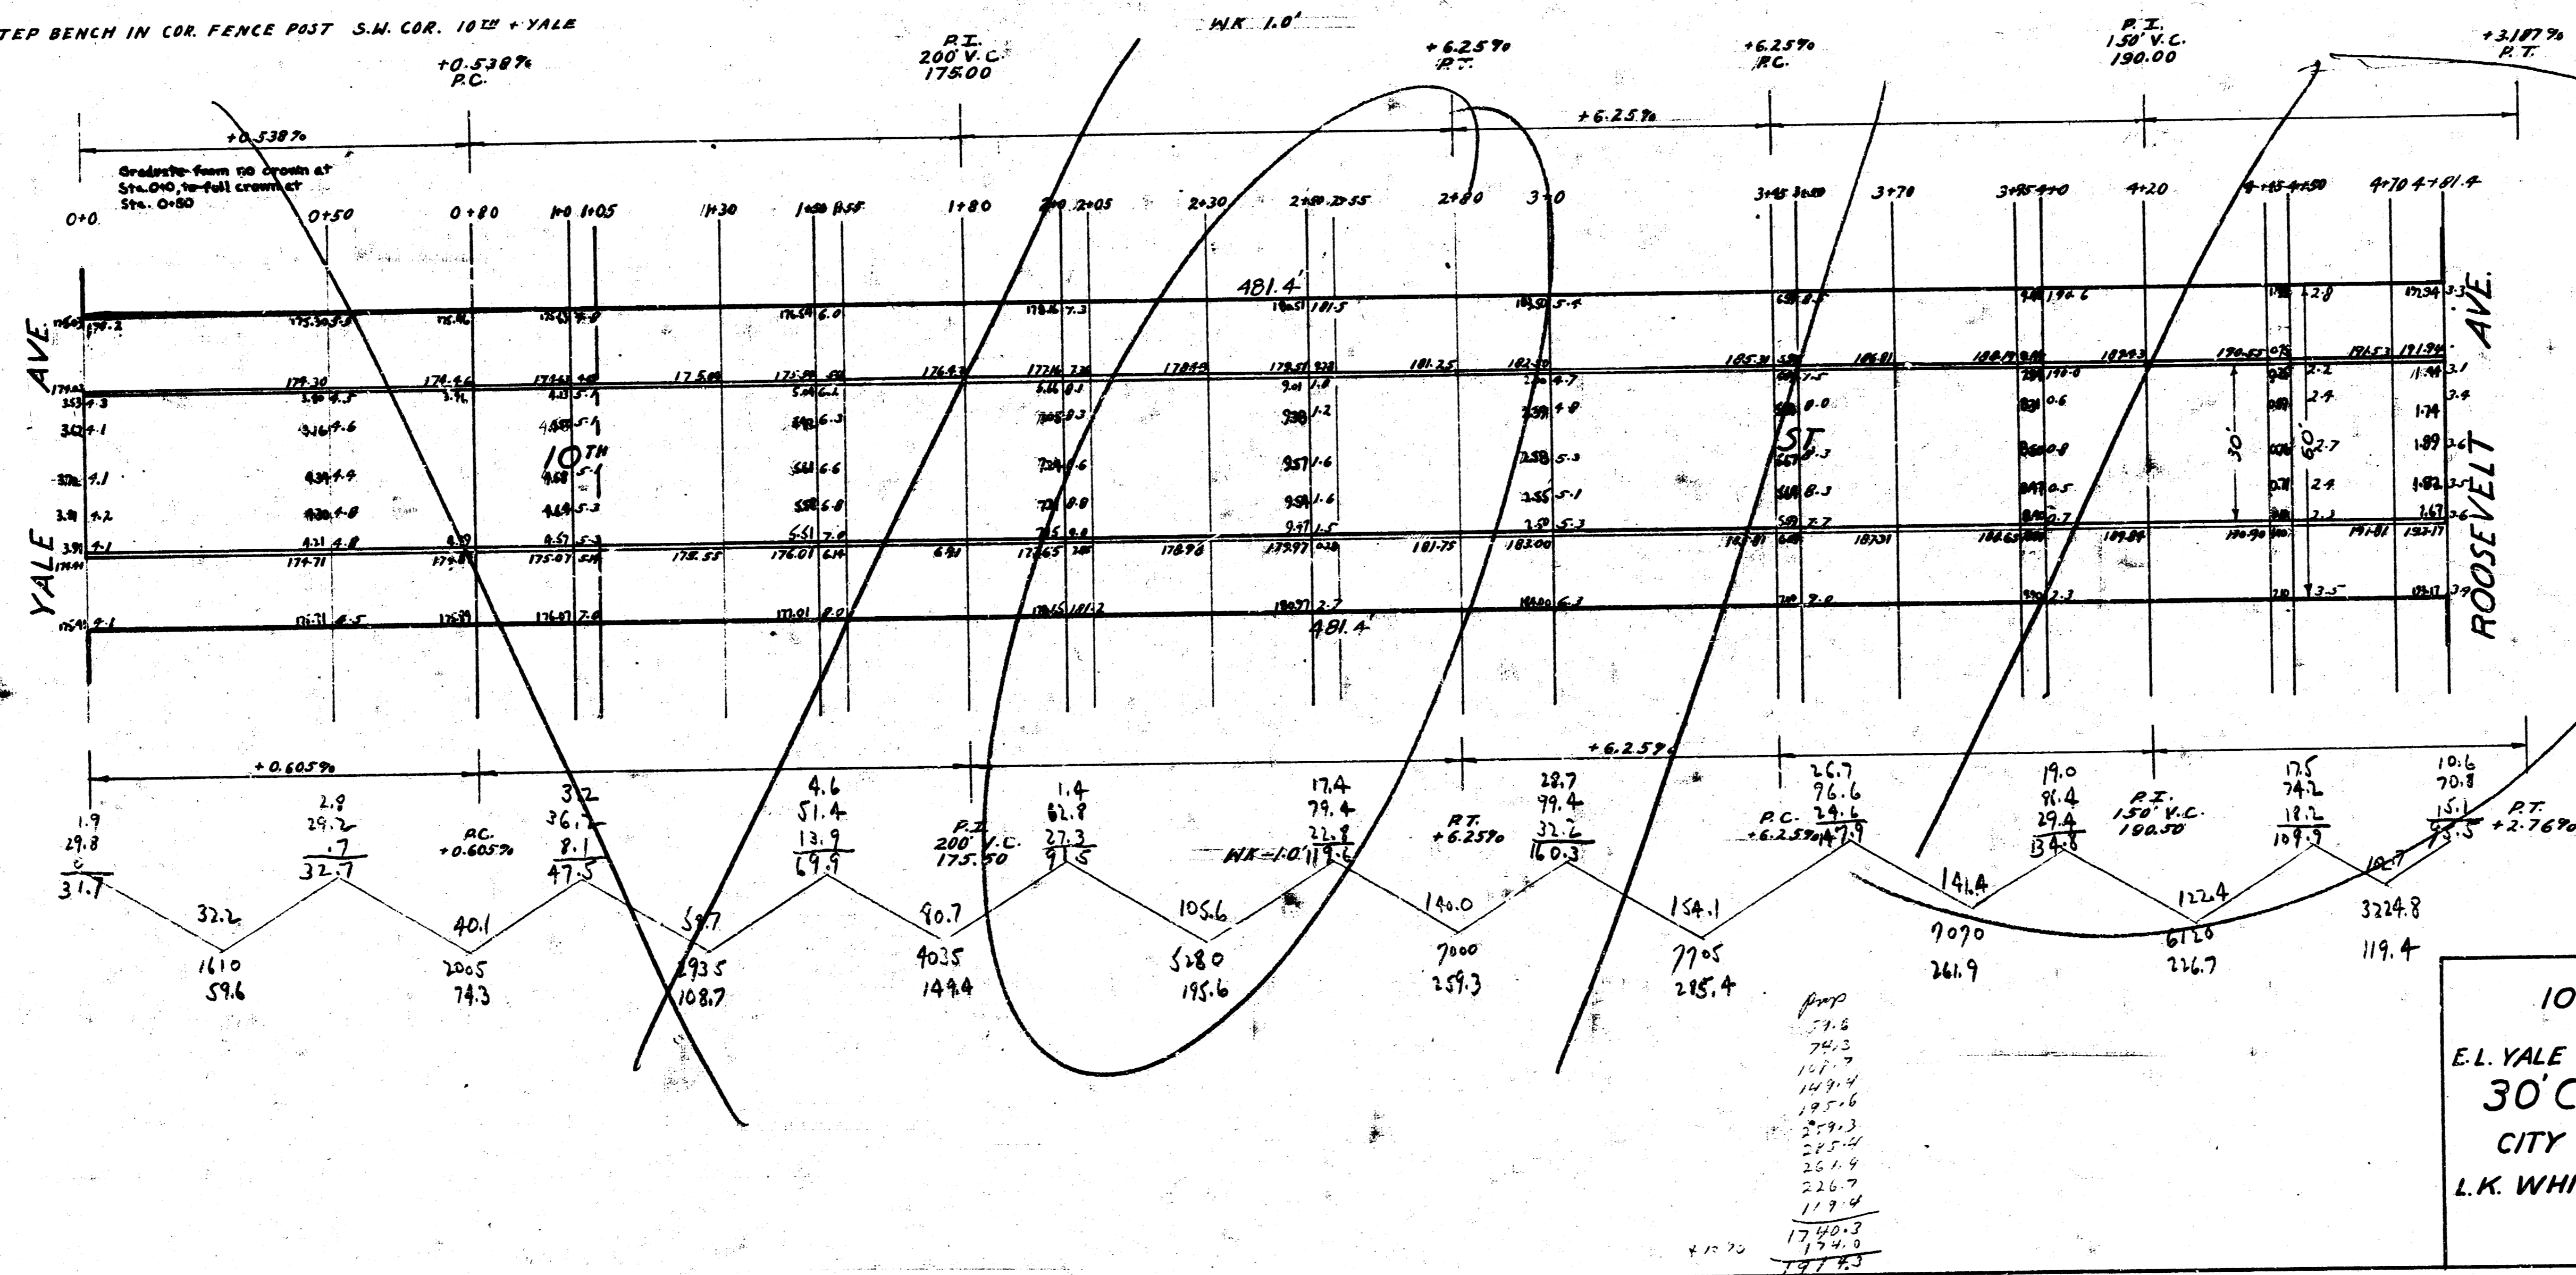

10TH ST.
 E.L. YALE TO WL. ROOSEVELT
 30' CONCRETE & CB.
 CITY OF WICHITA, KANSAS
 L.K. WHITE CITY ENGINEER
 JULY 1946

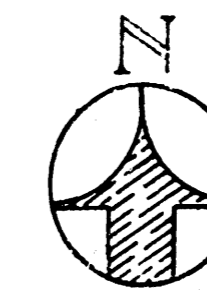

O. 9282
O. 4 WK.
B.M. 17202 Top Cone. Mon. S.L. 10th E.L. Frisco.
O. 11123 ST. & 10th W.L. FRISCO POST & 10th ST. W.L. FRISCO.
P.C.

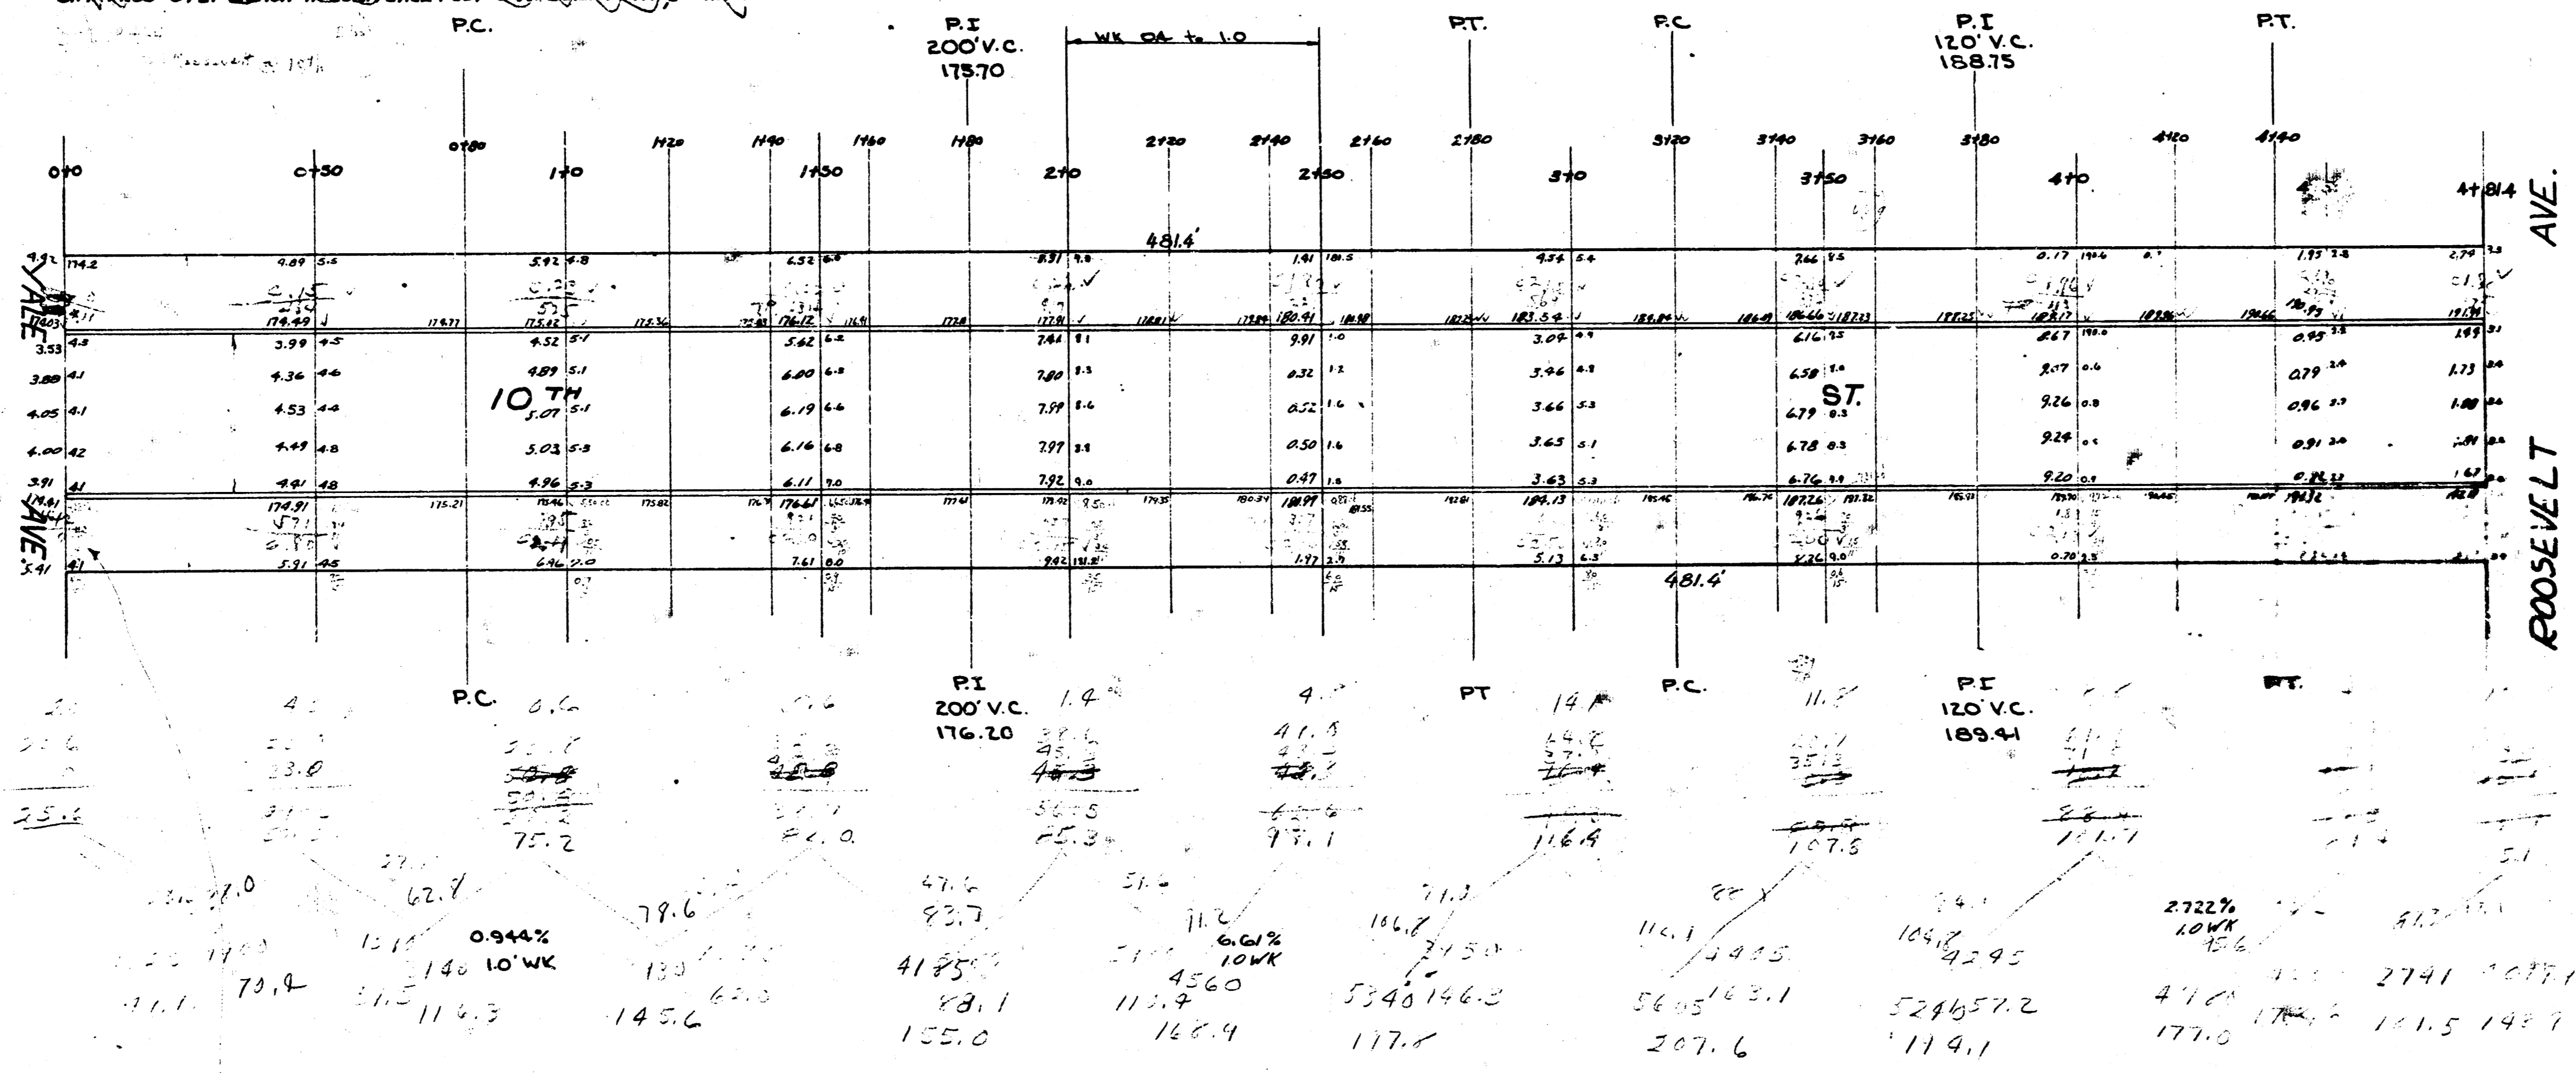

10TH ST.
E.L. YALE TO W.L. ROOSEVELT
30' CONCRETE & C.B.
CITY OF WICHITA, KANS.
L.K. WHITE CITY ENGINEER
1947