


B.M. 13045 S.F. on conc. porch, H.O. #1653 Sabin.
Baseline & stationing on north property line.

Note:
Existing surface shall be removed separately and
paid as sq yds. of surface removed. Volume of
surface is included in excavation quantities.


NOTE:
Install 1" Premolded
Expansion Joints at
60' intervals.

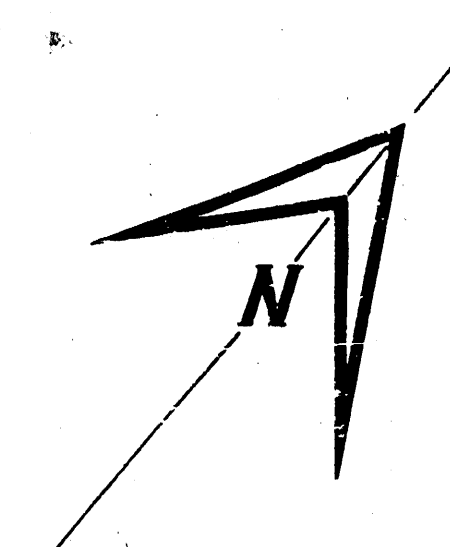

CURVE DATA						
Length = 156.54' on N.E. R = 222.56'						
Δ = 40° 18' 00" Min. per R = 7,723.7						
Sta	ARC	Chord N.E.	Chord S.W.	Chord E.W.	Defl.	E Defl.
4+30						
4+50	44.2	44.5	42.74	33.62	5° 41' 22"	5° 41' 22"
5+00	50	49.09	44.33	33.01	6° 26' 10"	12° 07' 32"
5+62.54	62.54	62.44	60.10	47.34	5° 01' 28"	20° 09' 00"

Excavation	
Prop.	7.2
429.5	16.1
46.9	1.4
476.3	24.7

CHM. 10. 20

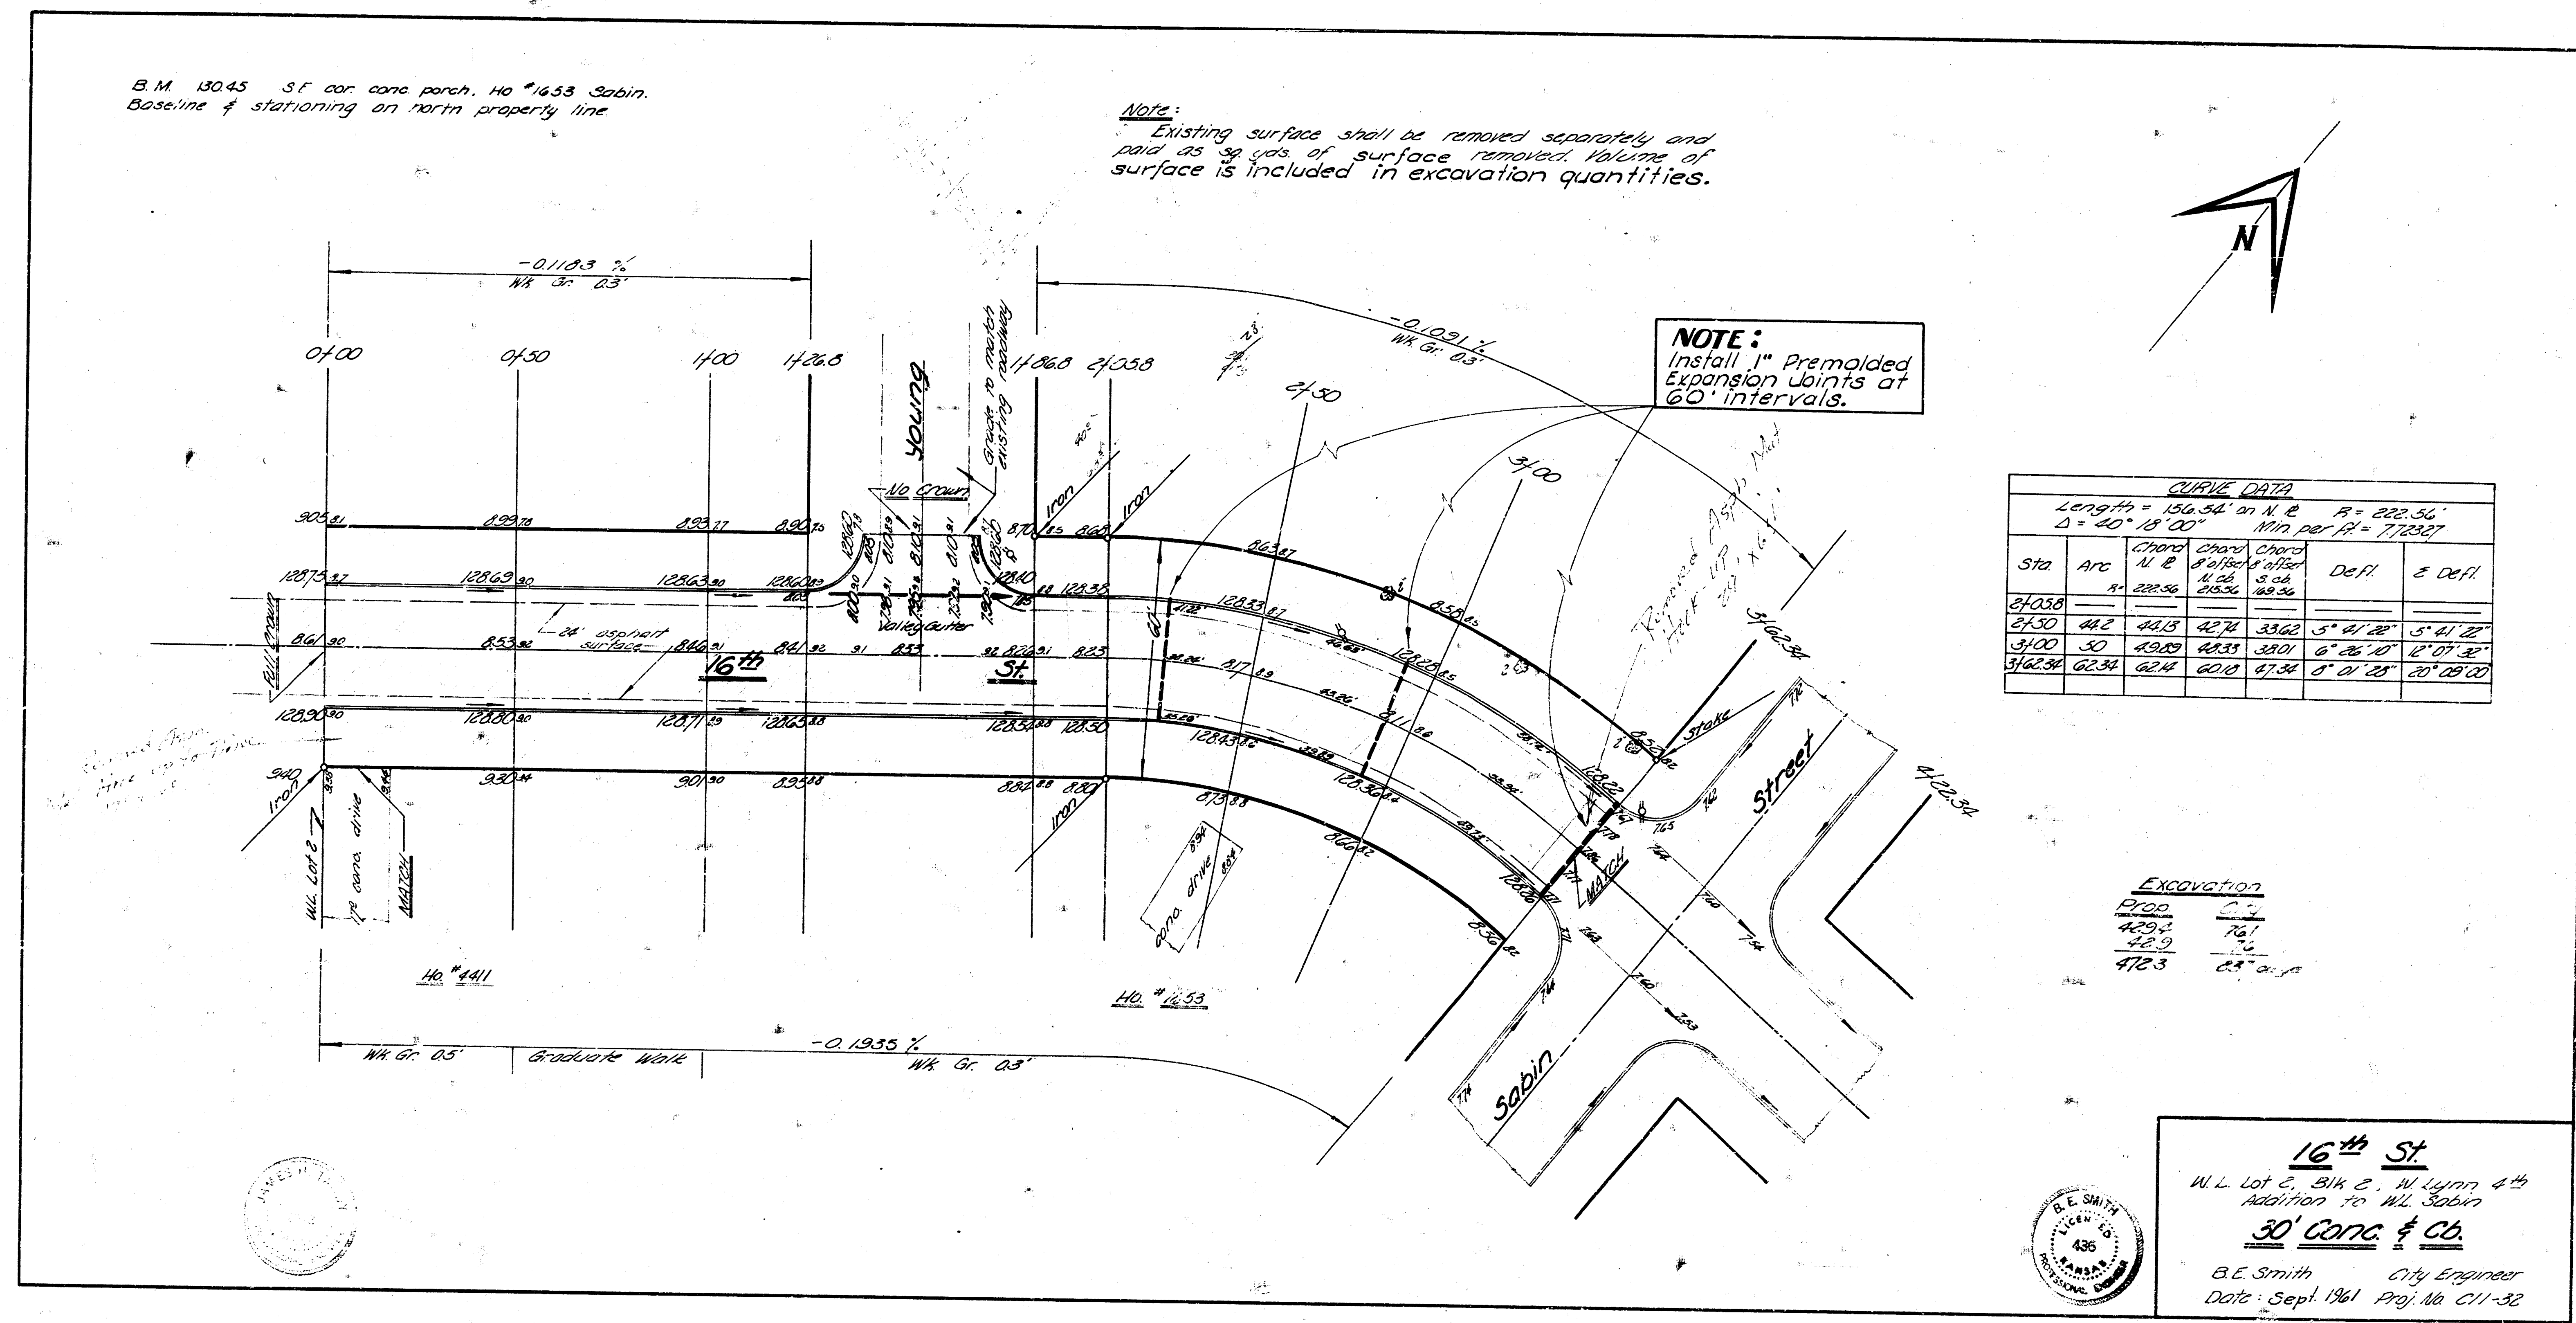

16th St
W.L. Lot 2, Blk 2, W. Lynn 4th
Addition to W.L. Sabin
30' CONC. & CB.
B.E. Smith City Engineer
Date: Sept. 1961 Proj. No. C11-32