


Note: Adjust work on north side to match exist. ground if driveways are not constructed.

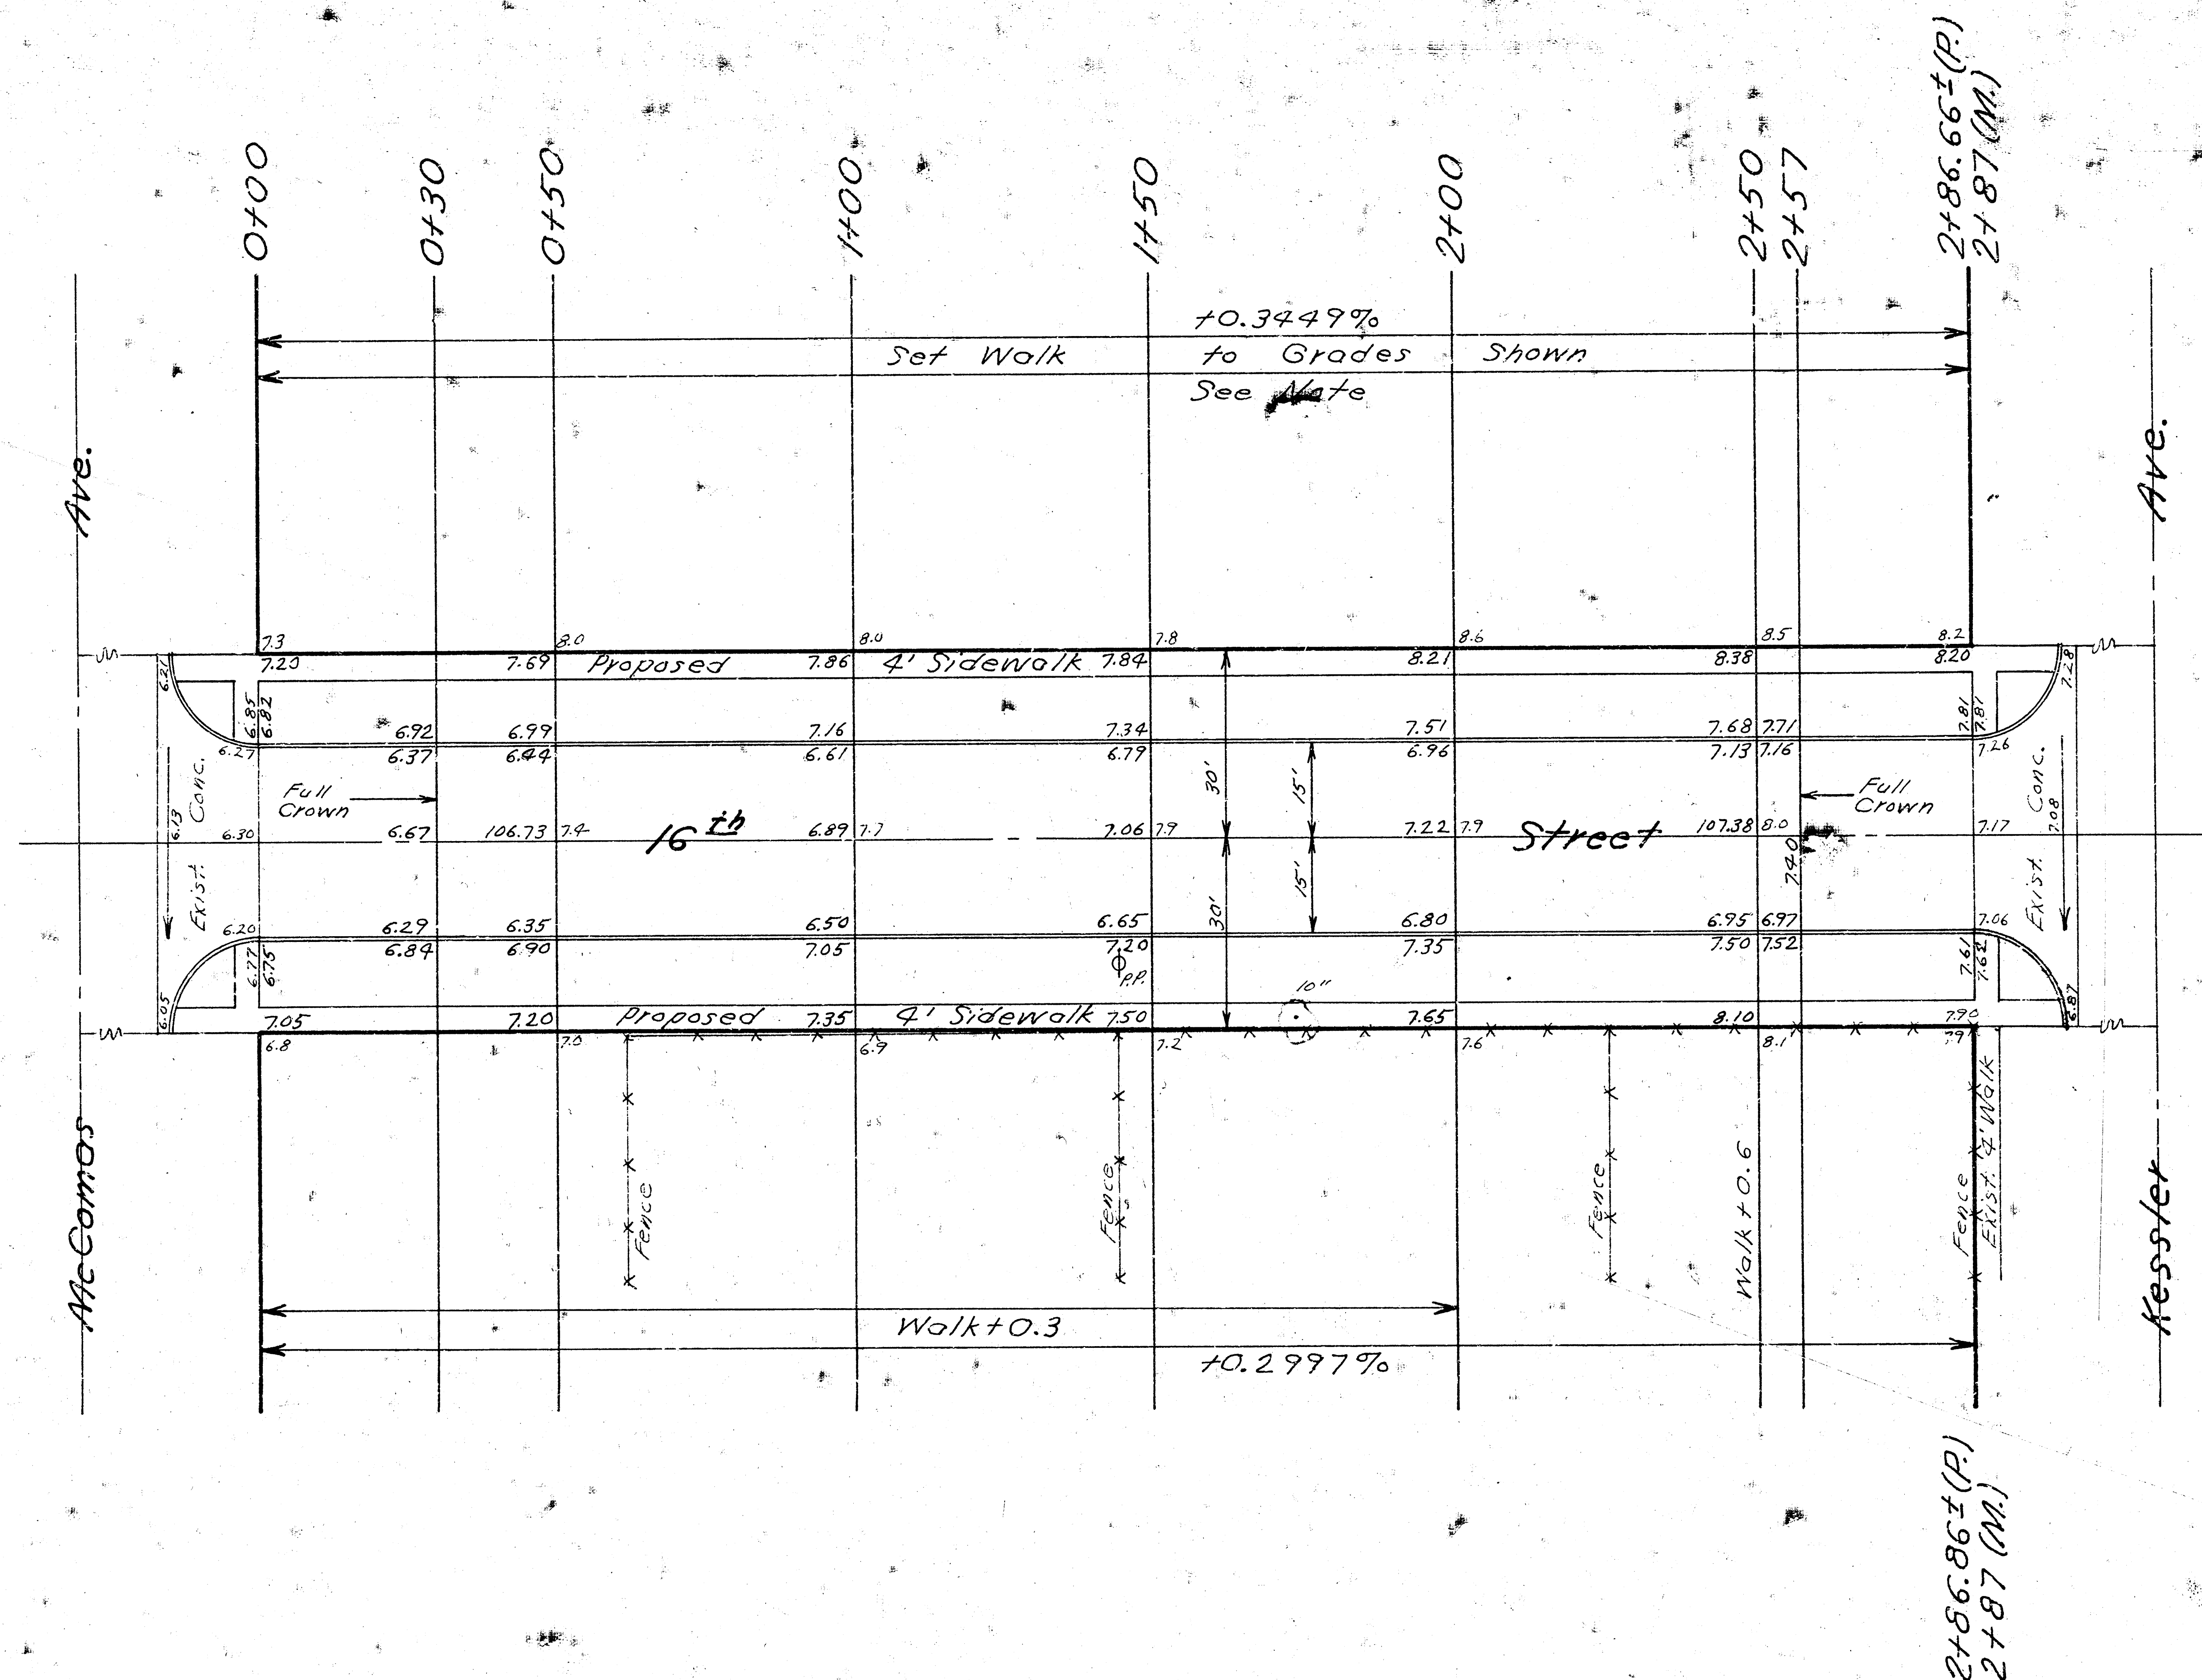

Earthwork
Property

412.4 ~~219.7~~ + 21.4 = 235.3 C.Y. Excavation
11.8 ~~5.8~~ + 0.6 = 6.4 C.Y. Comp. Fill
175.3 175.4 C.Y. Comp. Fill S.G.M. for Pavement Subgrade

16th. STREET
E. L. McComas to
W. L. Kessler
30' CONCRETE
CITY OF WICHITA, KANSAS
B. E. SMITH, CITY ENGINEER
PROJ. NO. C 10-26
DATE: Sept. 1970

 $\frac{1}{2}$