




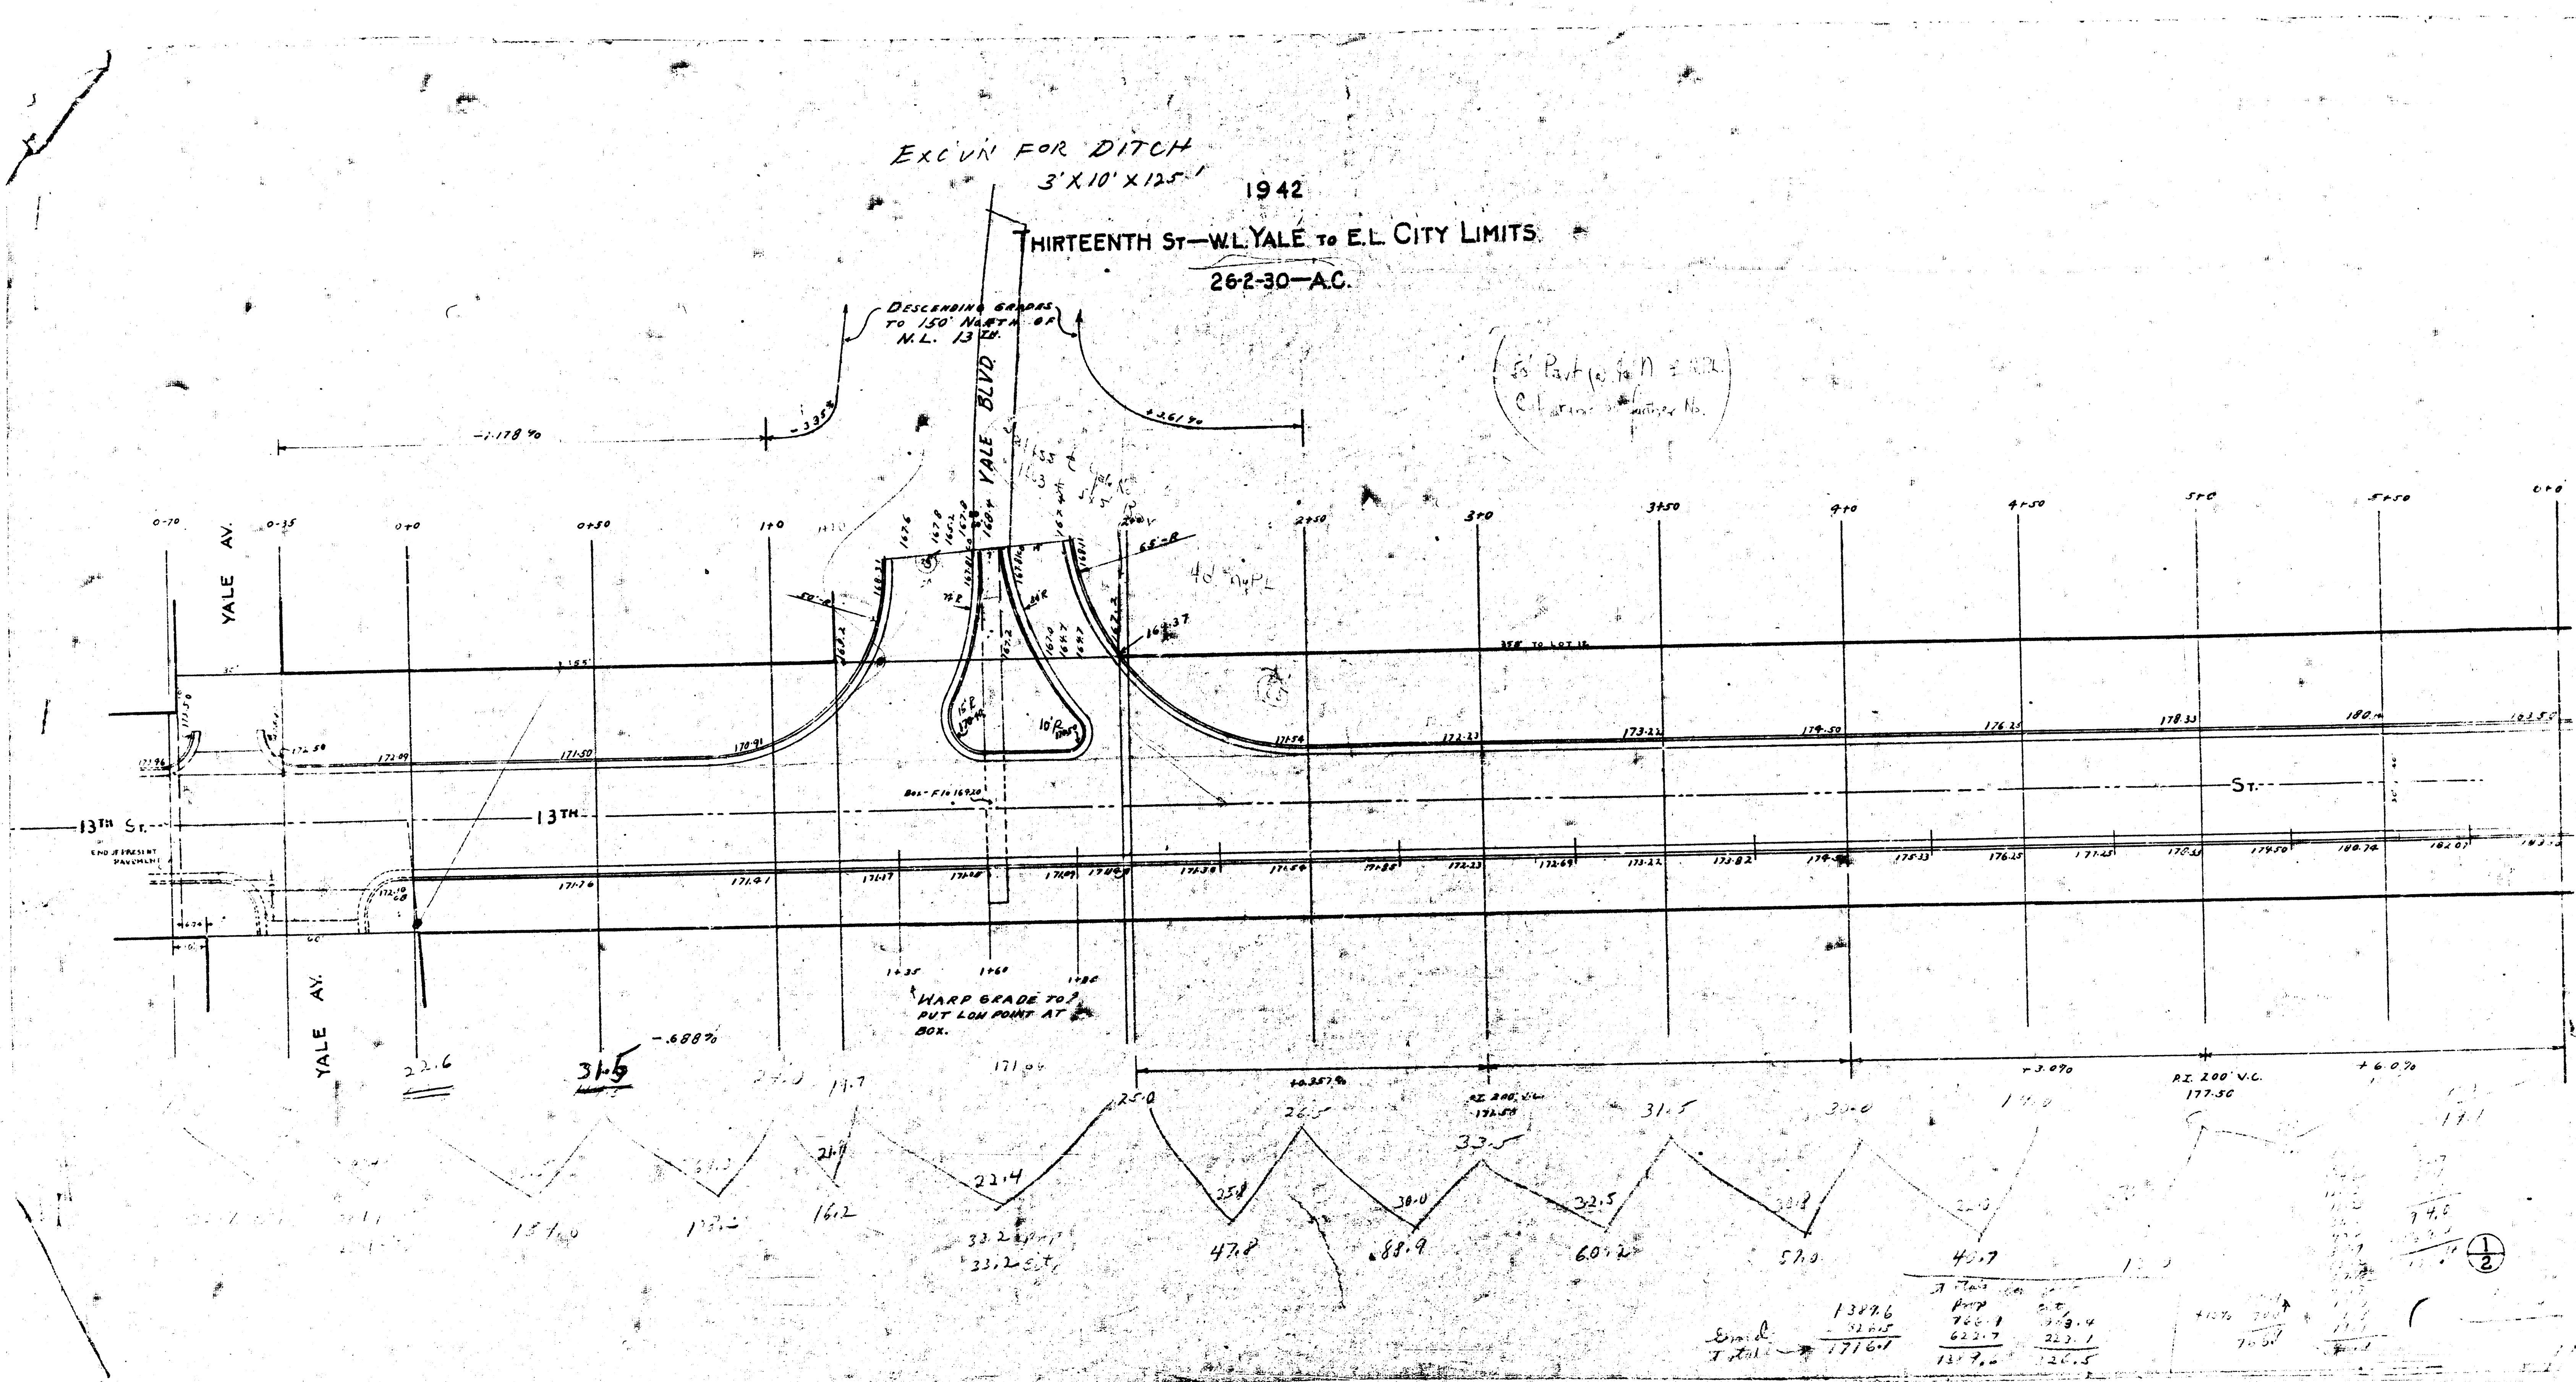

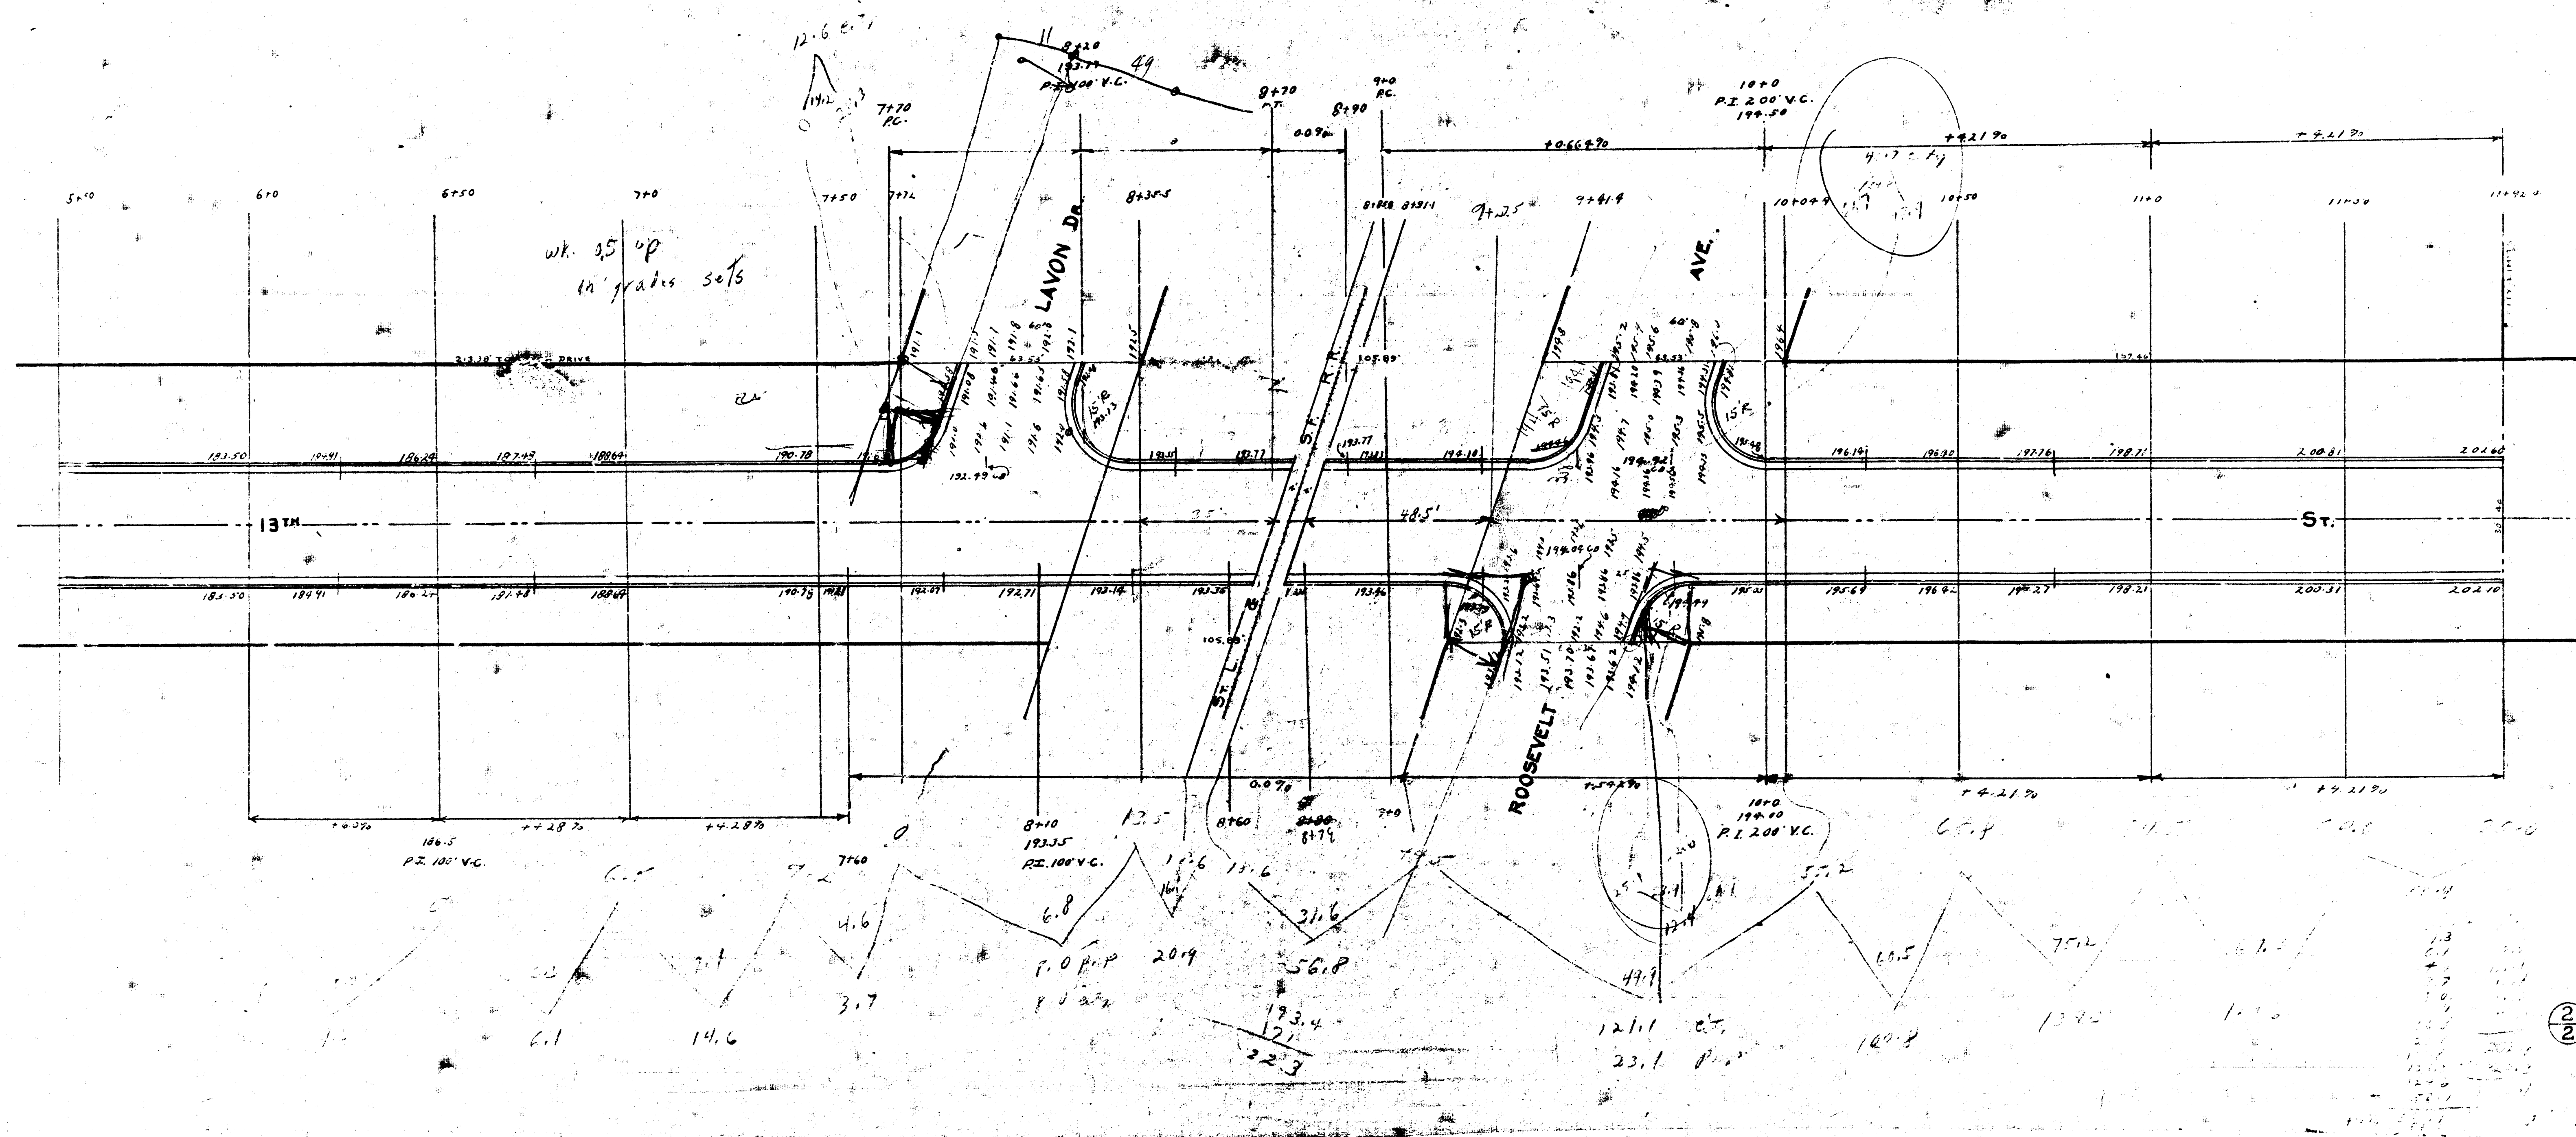


BK 017

BM. 195.07 60" Spike Southeast side Guy pole North side 13th & East line Exisco R/W.

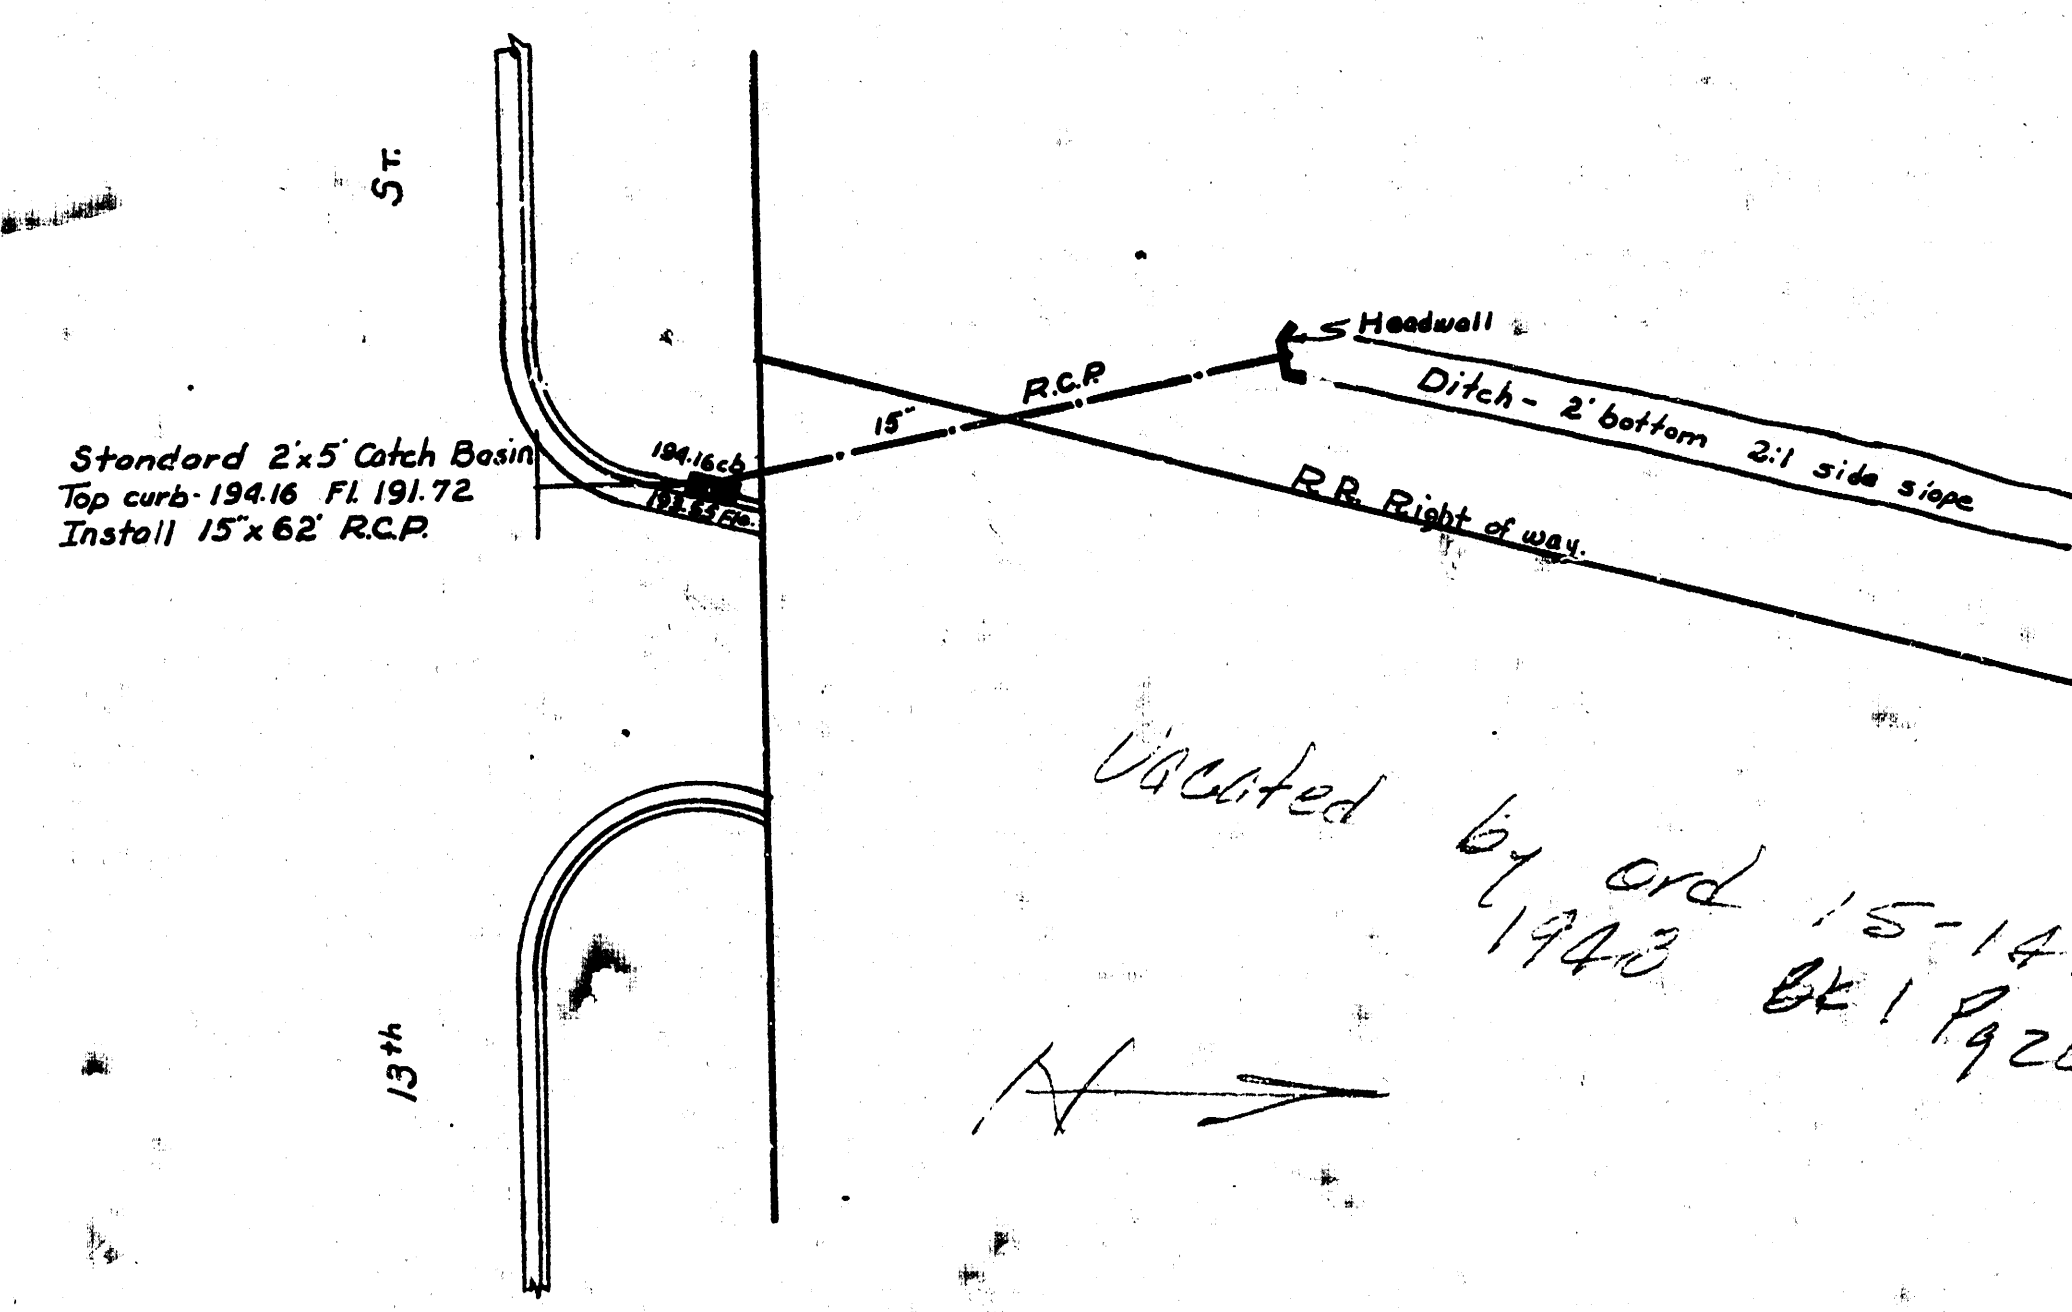


Uncovered by Ord 15-147
1943 BK 19204


Existing culvert under railroad tracks

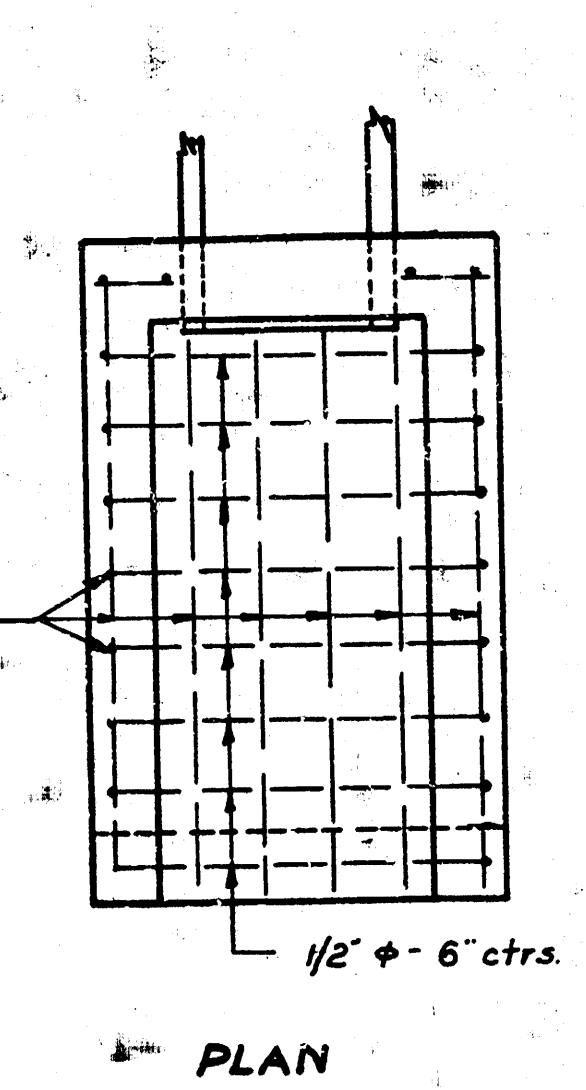

PLAN

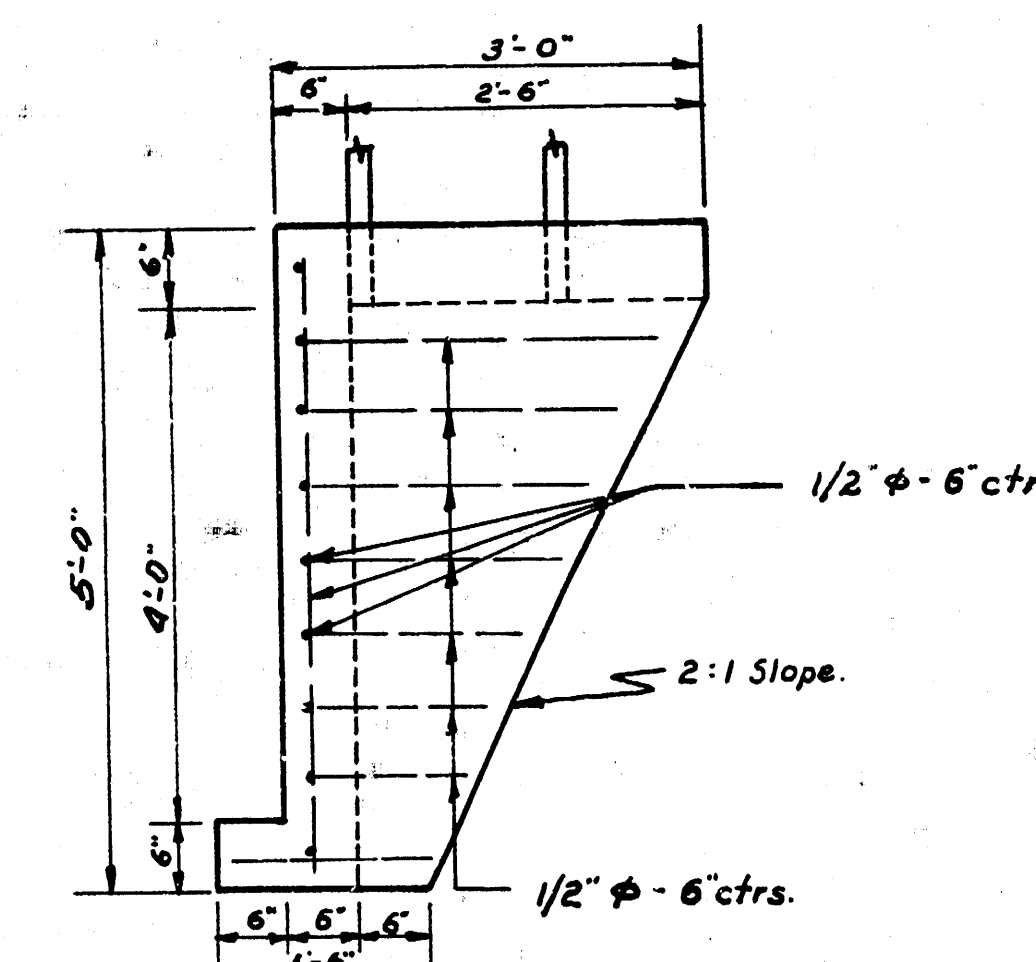



PROFILE

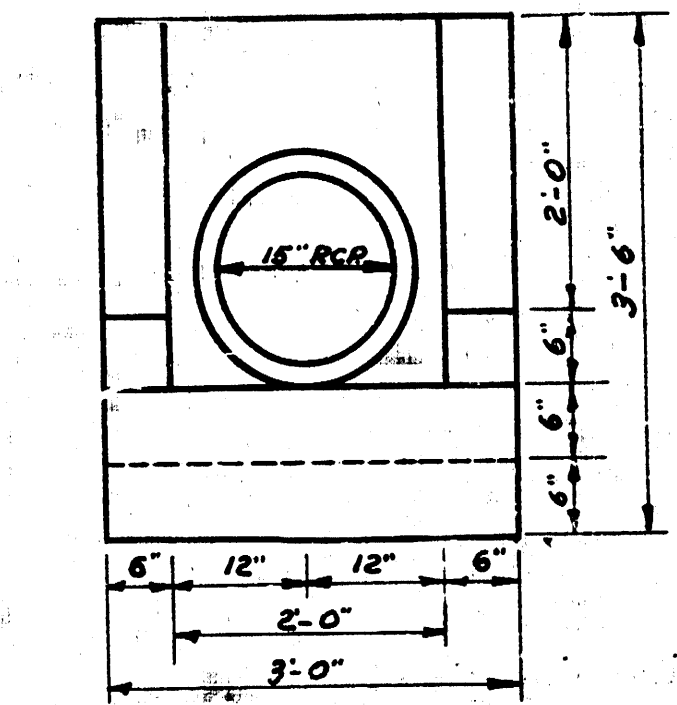

END VIEW

DETAILS OF HEADWALL
Showing dimensions & steel placement
Scale 3/4" = 1'

NOTE: Headwall may be constructed of brick.

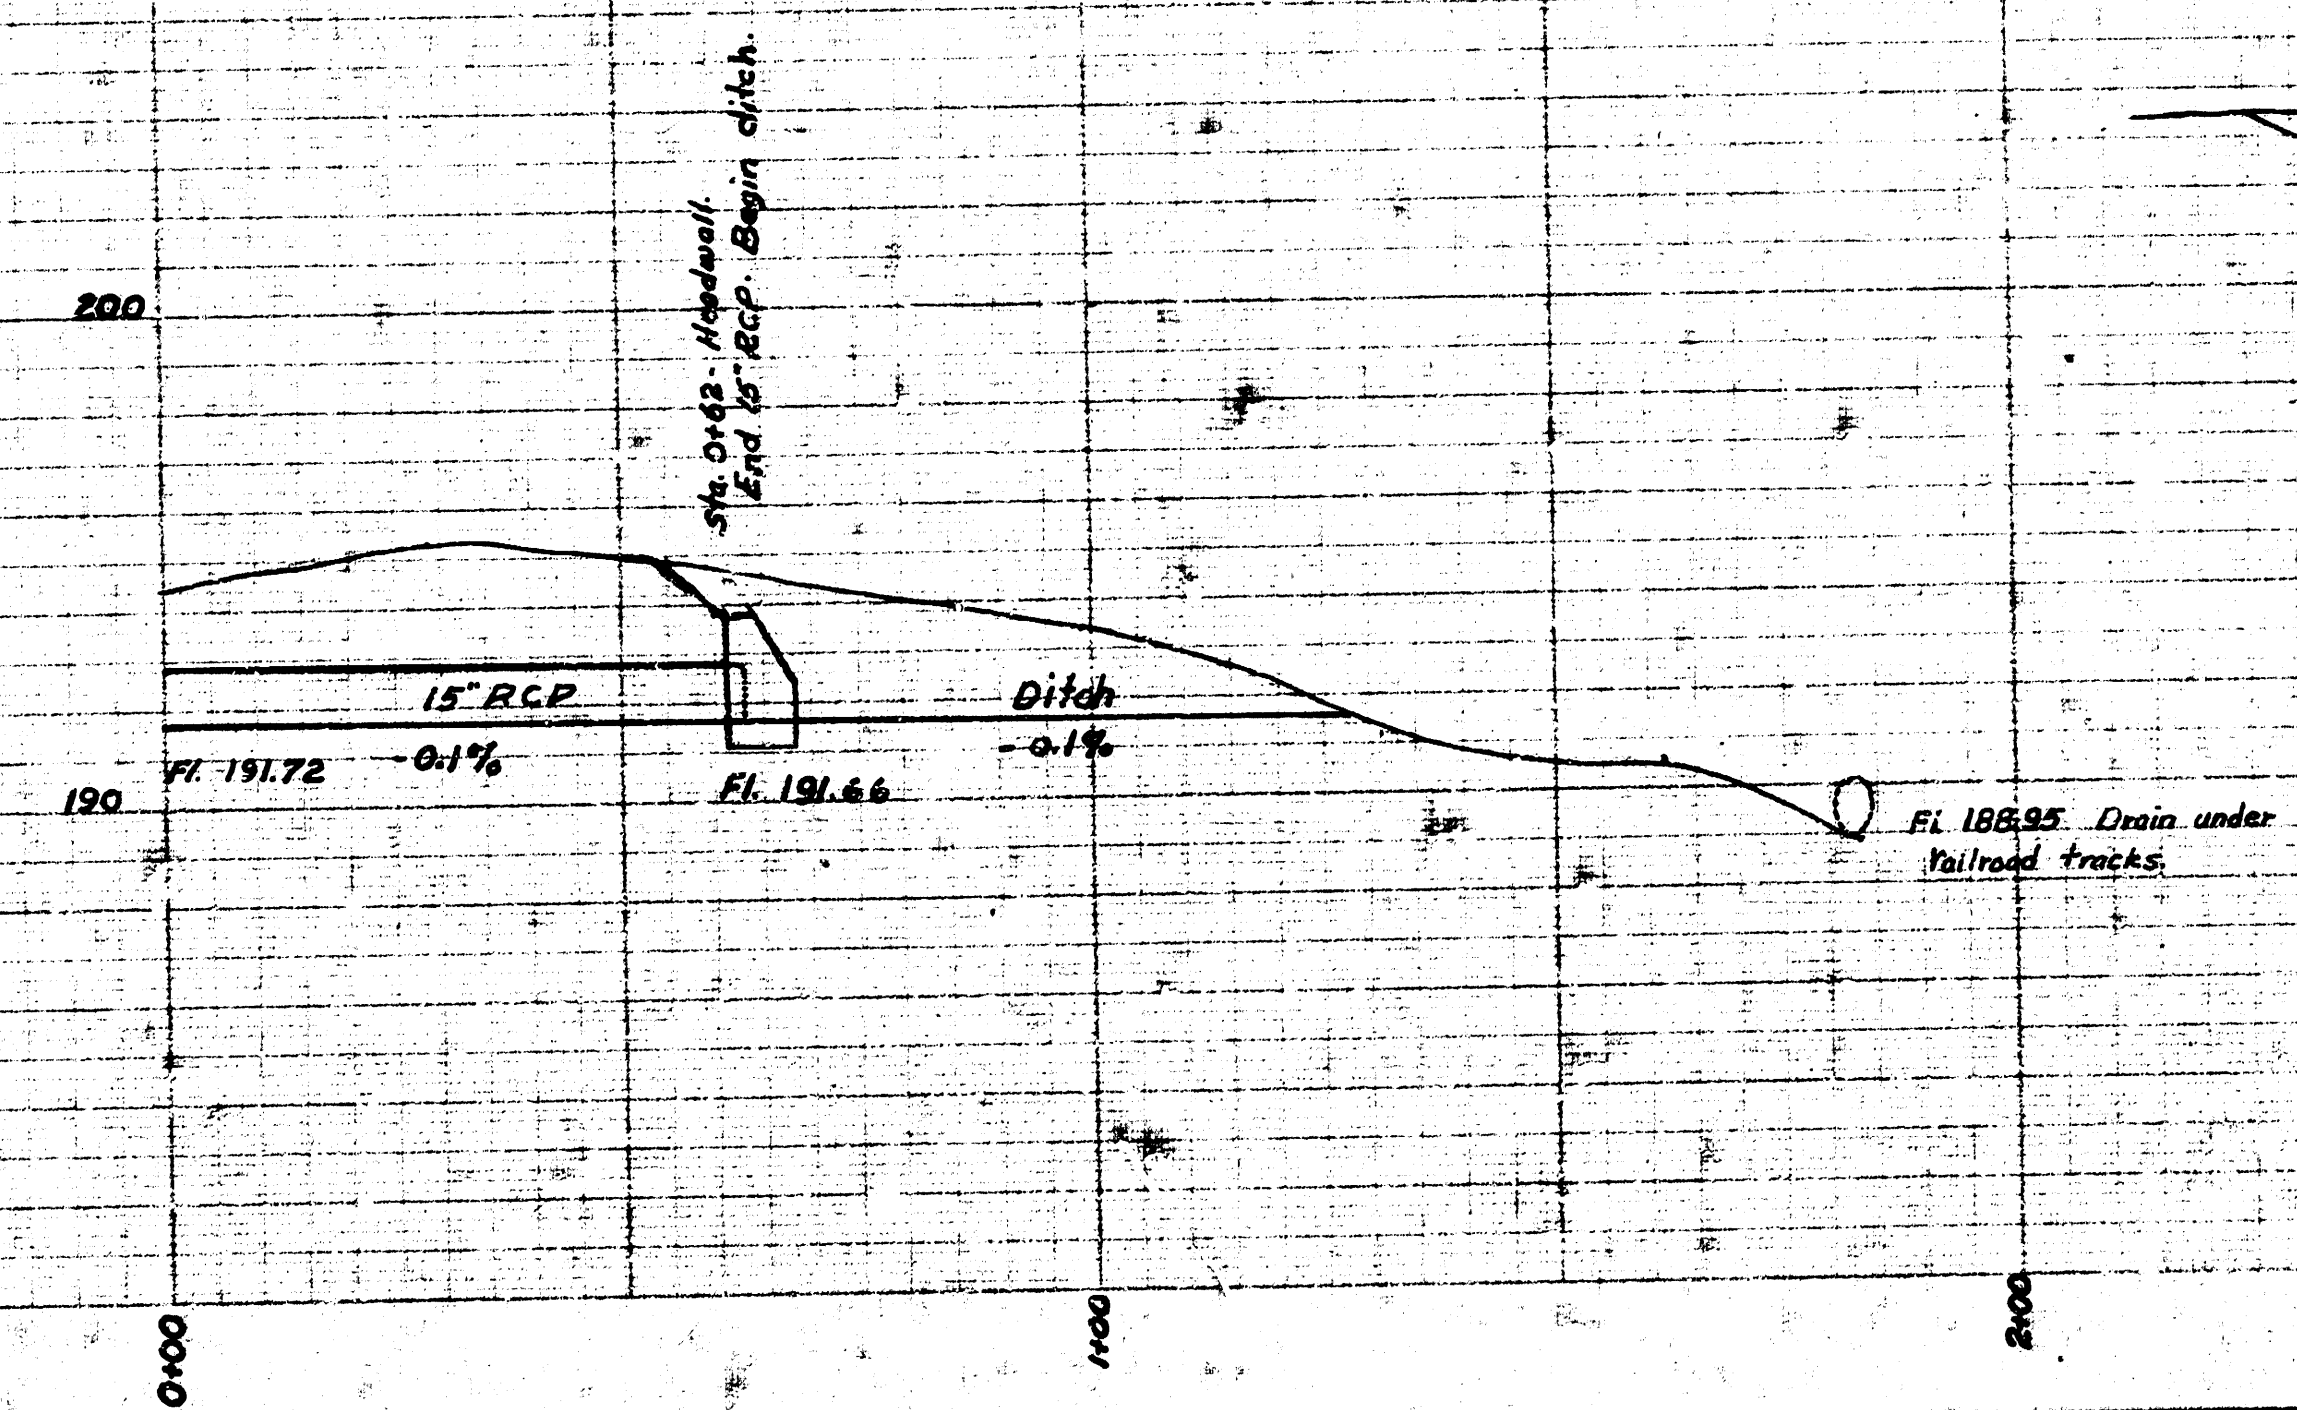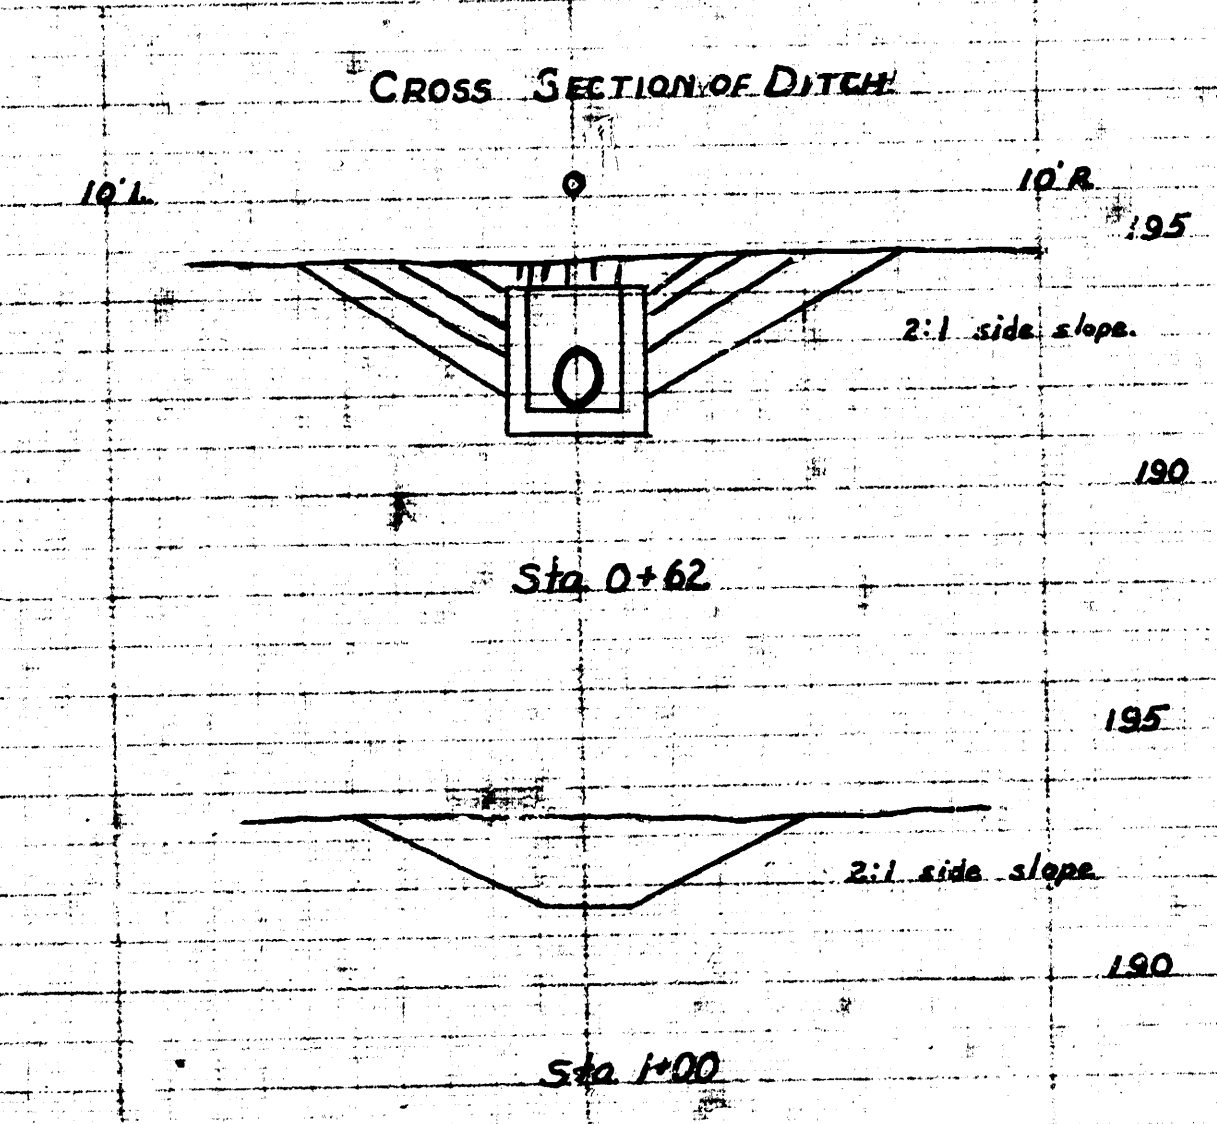

Attached to 13th St
in the drainage
DRAINAGE 13th & ROOSEVELT
City of Wichita, Kansas
L. R. White City Engineer
January 1931
Proj. No.

