
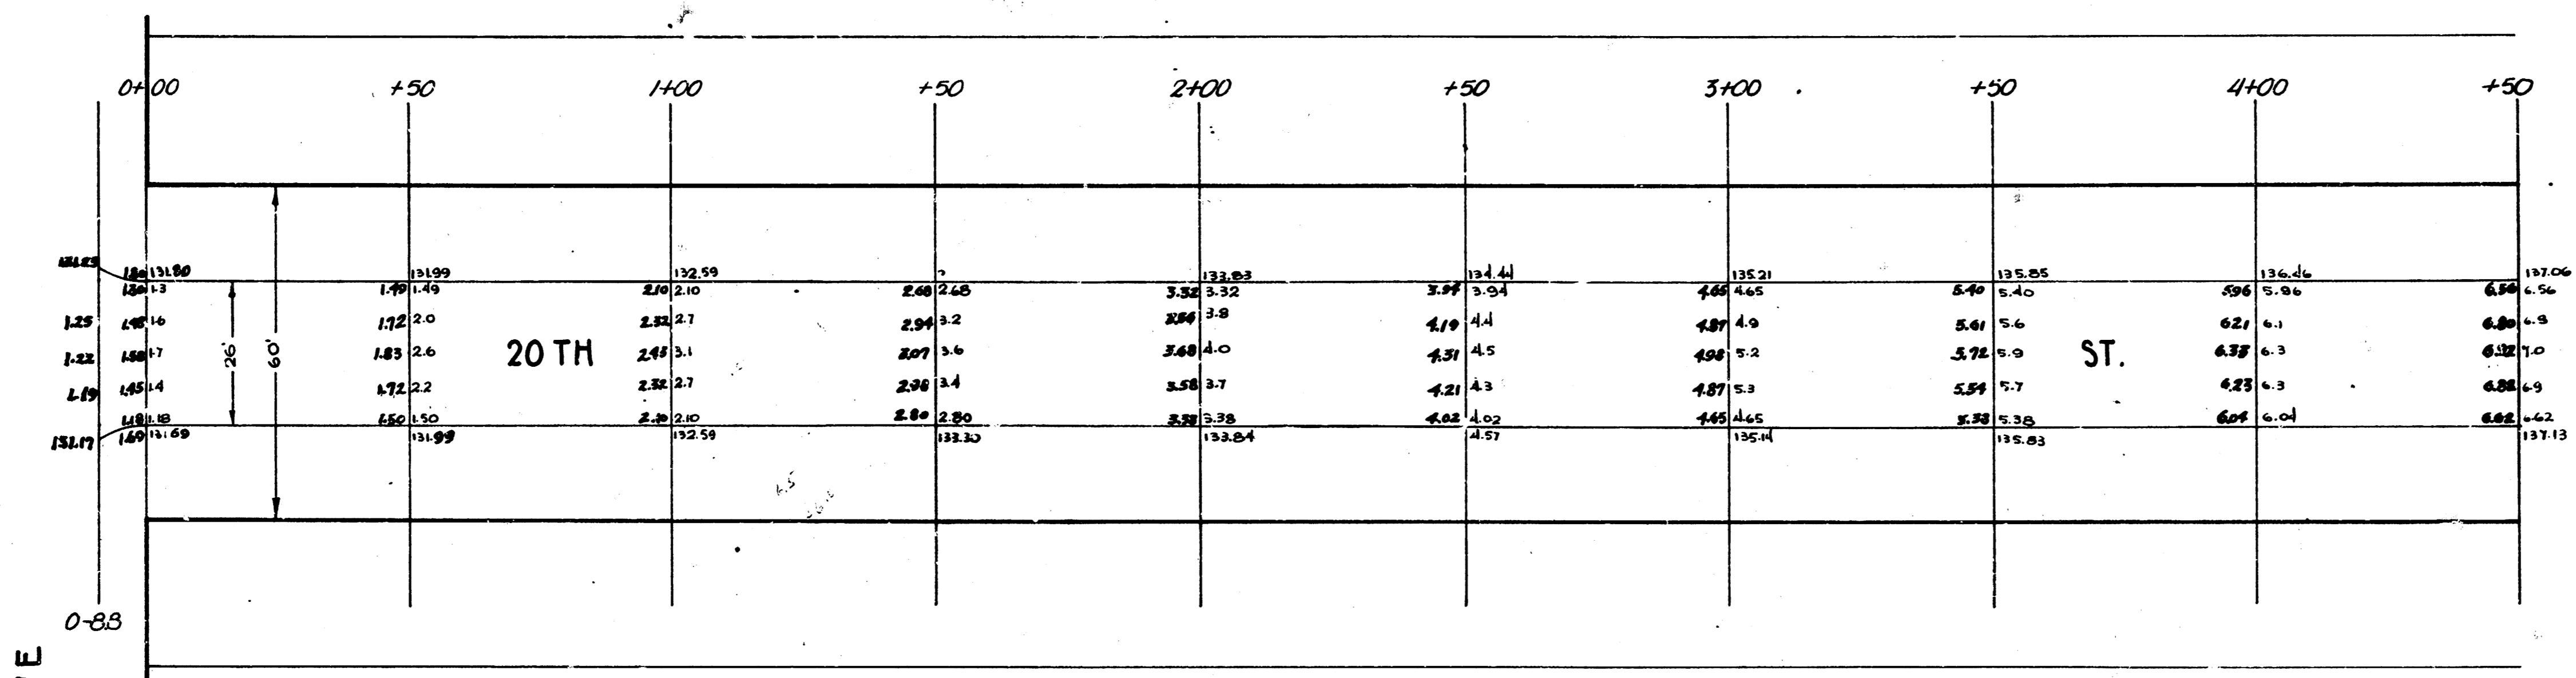



41 Y

B.M. 13371 S.E. Cor. Conc. Porch. Ho. No. 2324 E. 20th.
B.M. 14347 T in Troy Fire Hyd. S.W. Cor. Shadybrook f 20th.
NOTE: Stations shown are on North curb line.


ST. 0-88 E. edge Valley gutter N/S

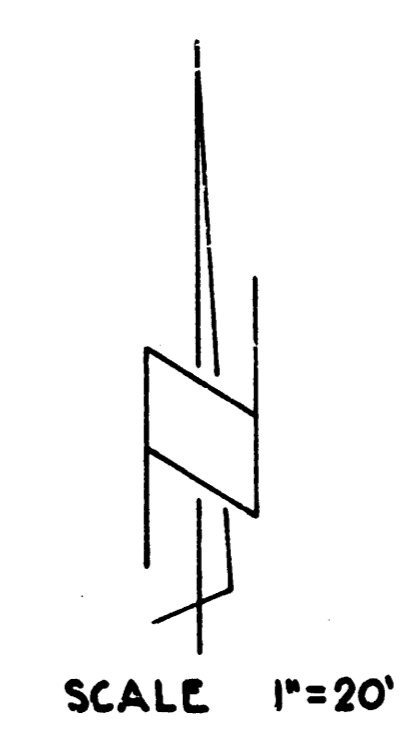

GROVE

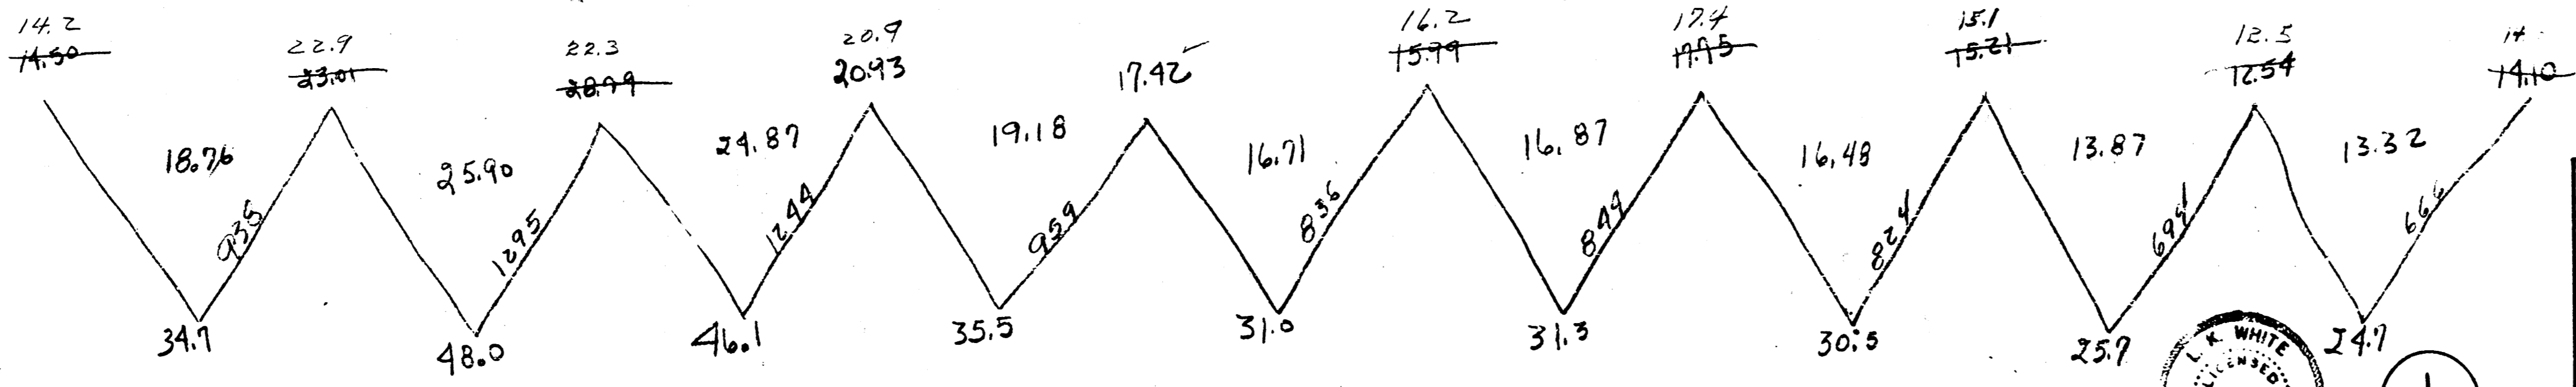

20TH ST.
E. GROVE ST. TO N.L. SHADYBROOK L.
26' Conc.
CITY OF WICHITA, KANSAS
L.K. WHITE CITY ENGINEER
SEPT. 1951 PROJ. NO. C11-126

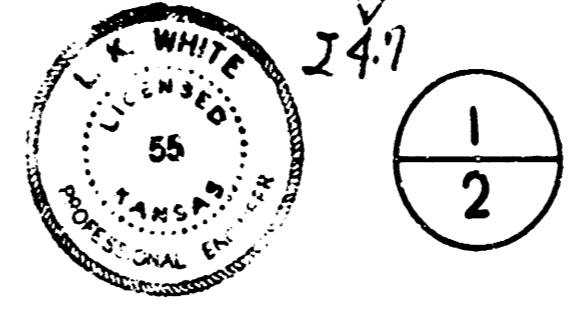

1/2

117

NOTE:
Stations shown are on North curb line.

