


7

FLEMING'S FIRST ADDITION
(Drainage)

T. L. DANIEL LAND SURVEYOR
1811 EAST CENTRAL, WICHITA, KANSAS 67214
TELEPHONE (316) 267-2348

DRAINAGE CONCEPT
"FLEMING'S FIRST ADDITION"
Wichita, Sedgewick County, Kansas.

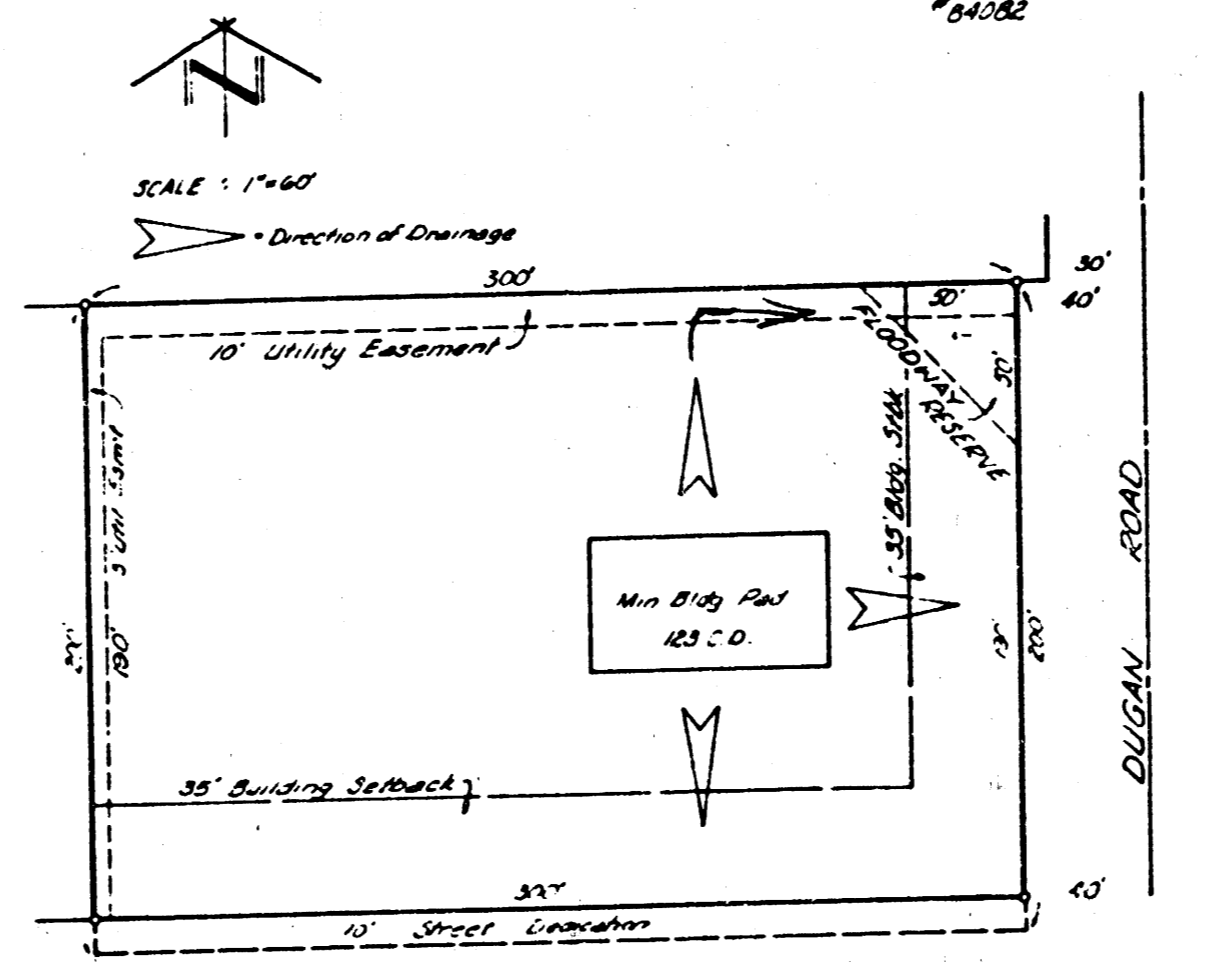

KELLOGG DRIVE

Approved
draining to
streets
SML