

SKETCH PLAT

HARP'S ADDITION

A TRACT OF LAND IN THE S.E. 1/4 OF SEC. 1, TWP. 2 S R-2-W, OF THE 6TH P.M., SEDGWICK COUNTY, KANSAS.


OWNERS: LLOYD L. AND KAREN L. HARP

1" = 40'

BENCH MARK:
CITY STANDARD DISC, 67 FEET
SOUTH AND 46 FEET EAST
OF CENTERLINES OF 21ST ST. &
119TH ST. WEST.
ELEV. = 172.08 CITY DATUM

Sanitary sewer?
Some of the existing
sanitary sewer lines
are shown in red
= 15" dia. sewer

20' UTIL. EASEMENT
60" raw water

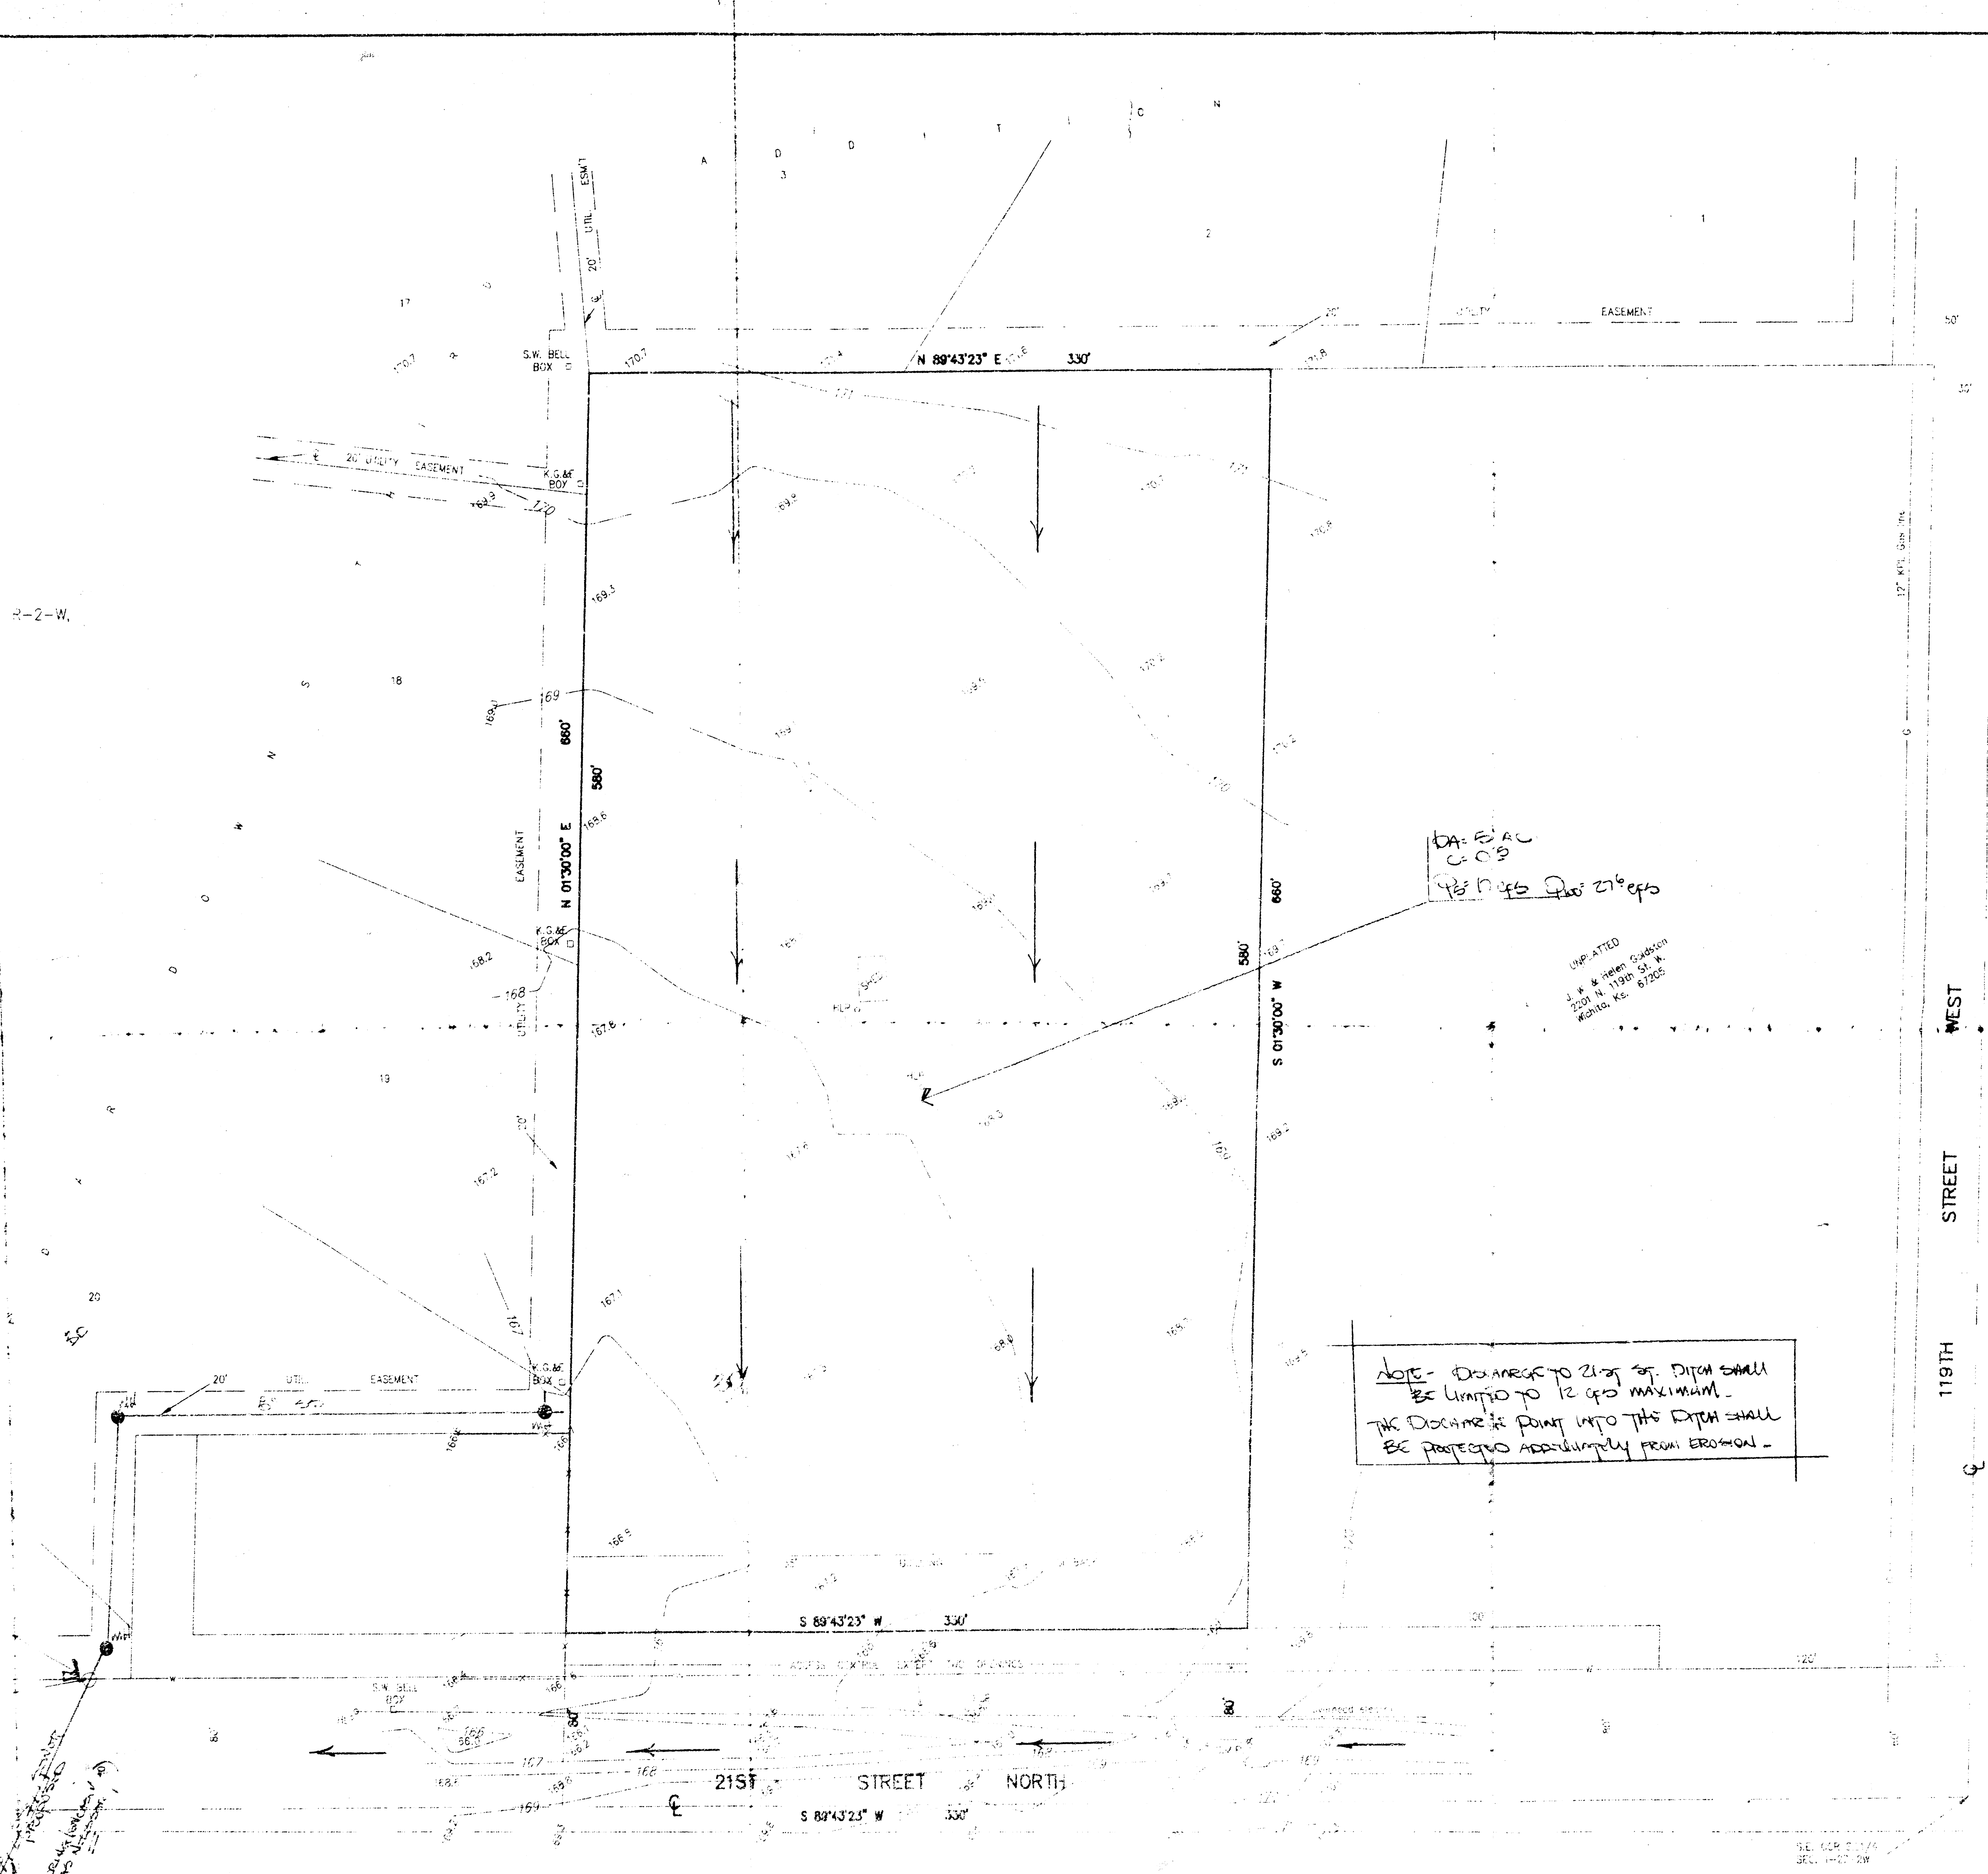

Sanitary sewer plan &
DRAINAGE PLAN

BAUGHMAN COMPANY
ENGINEERS & ARCHITECTS
1111 N. 10TH ST.
TOPEKA, KANSAS 66602