
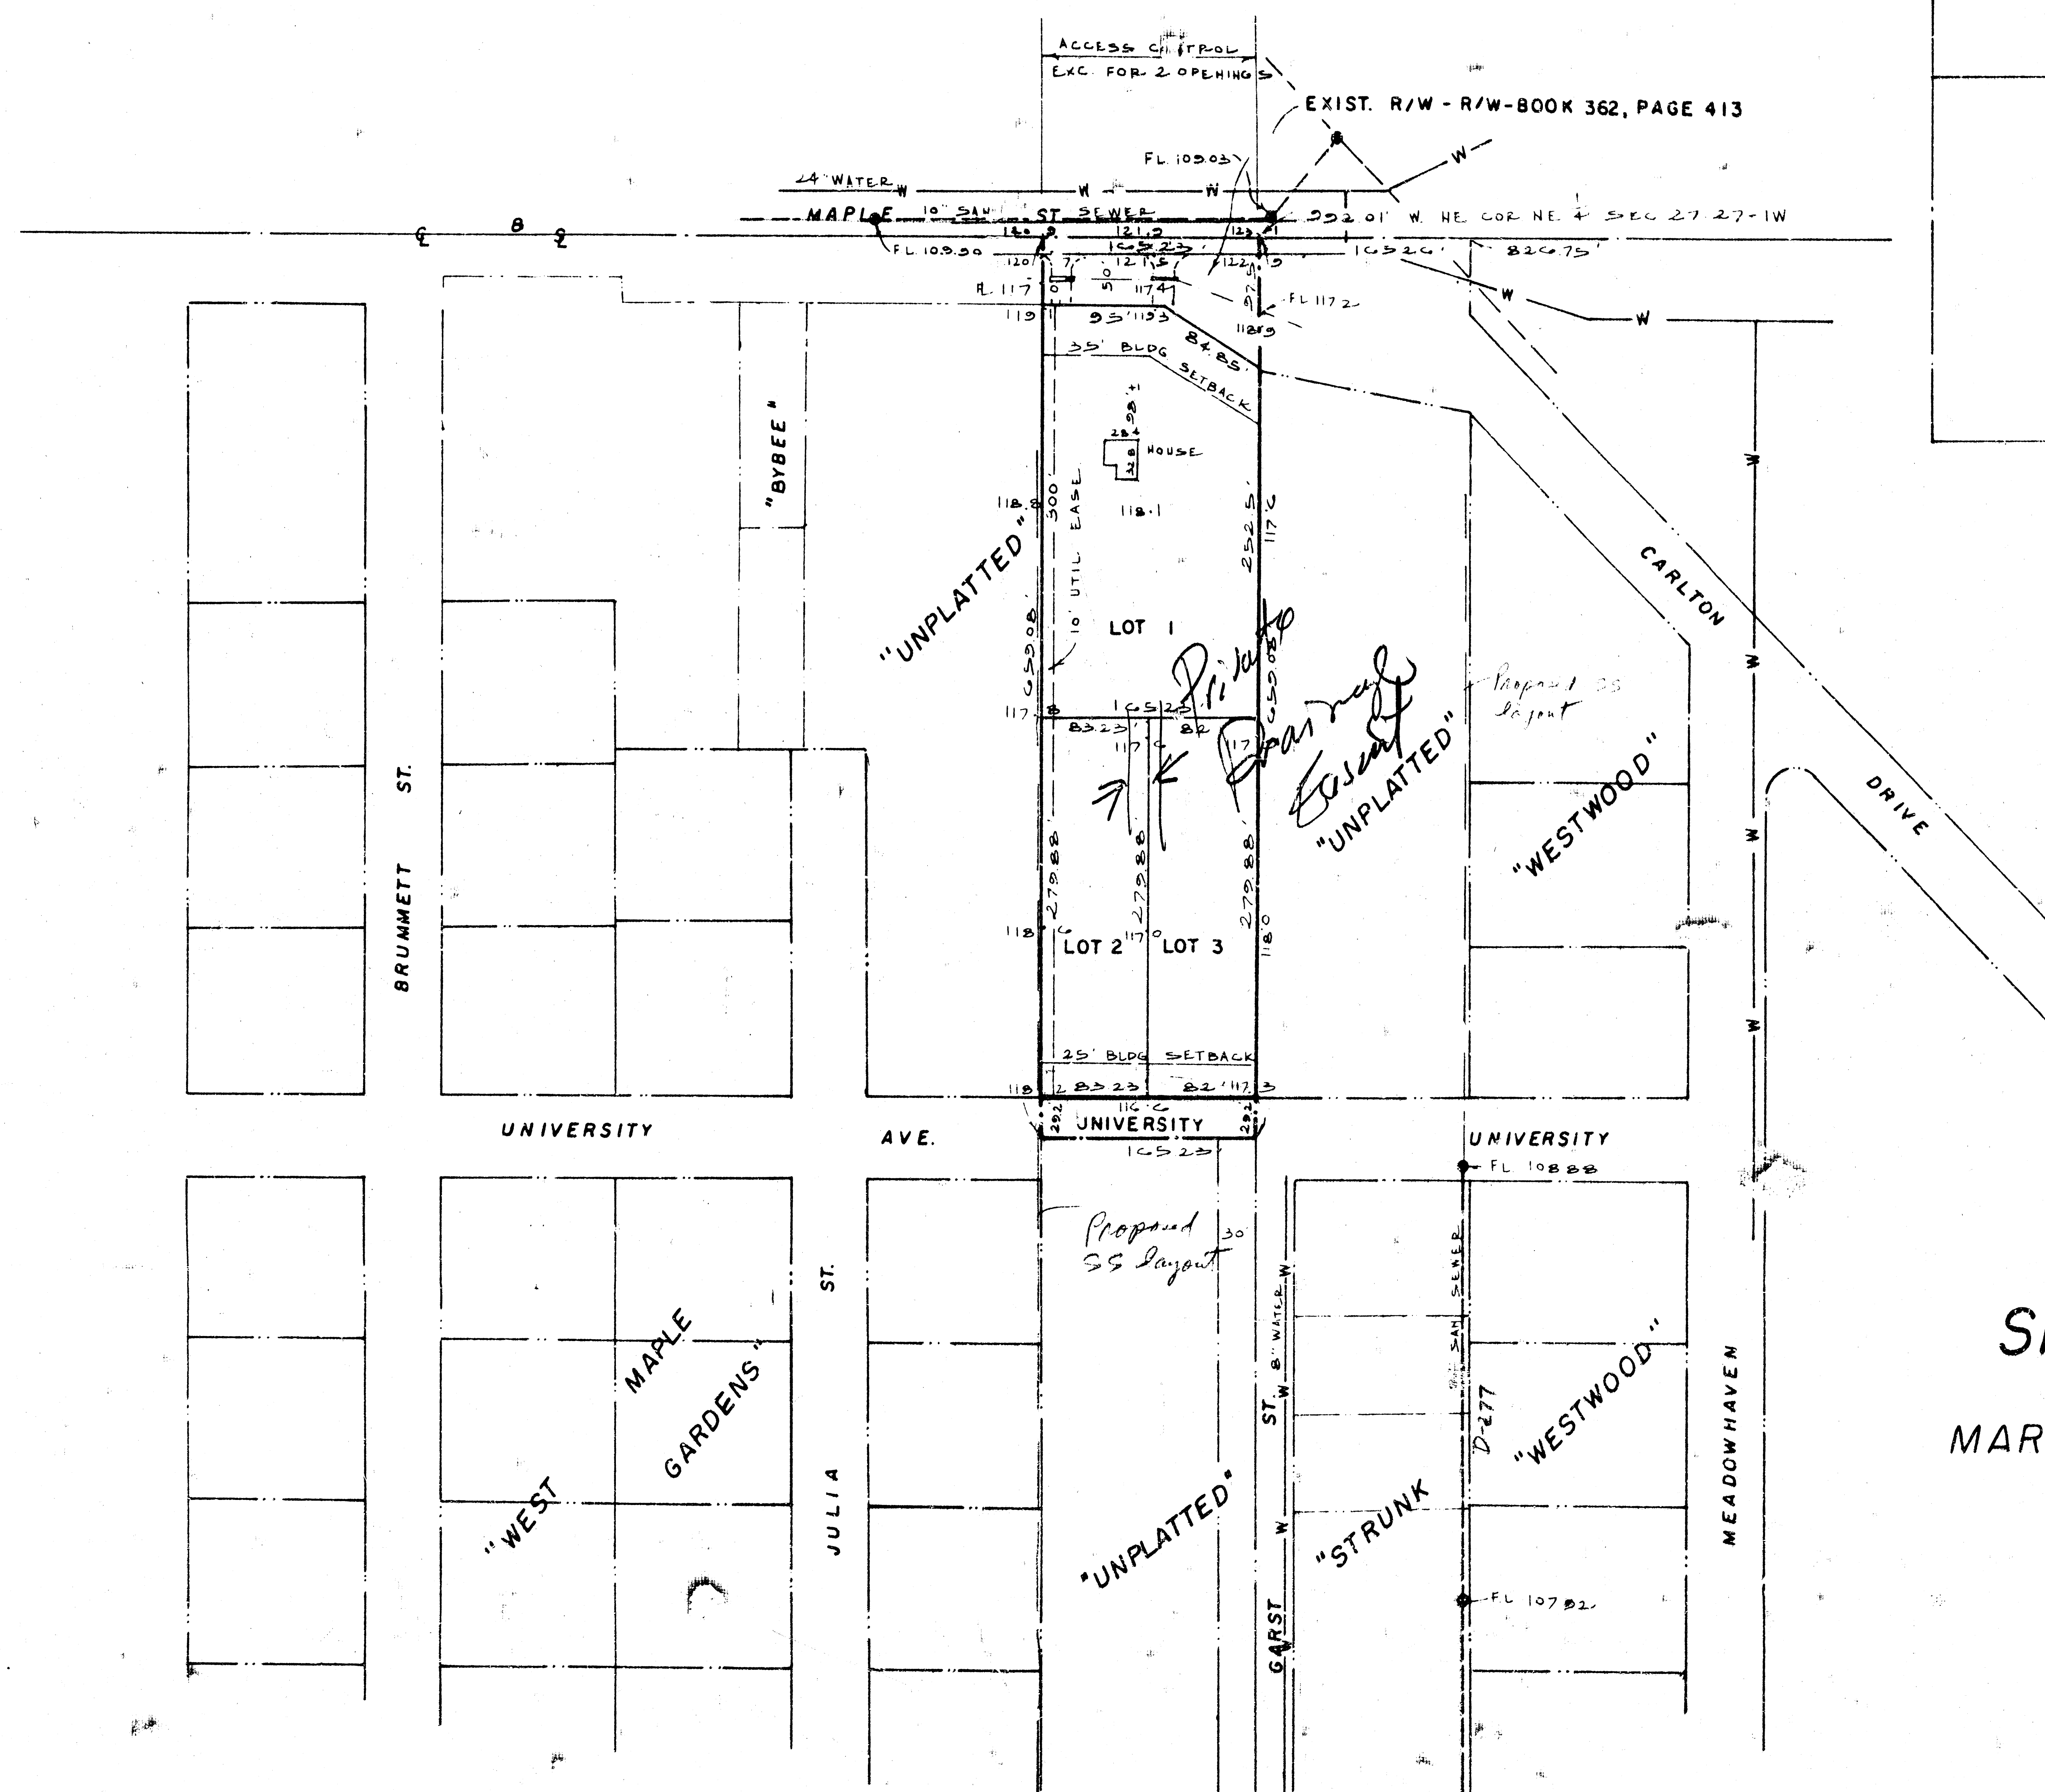


TOPO MADE DEC. 1984

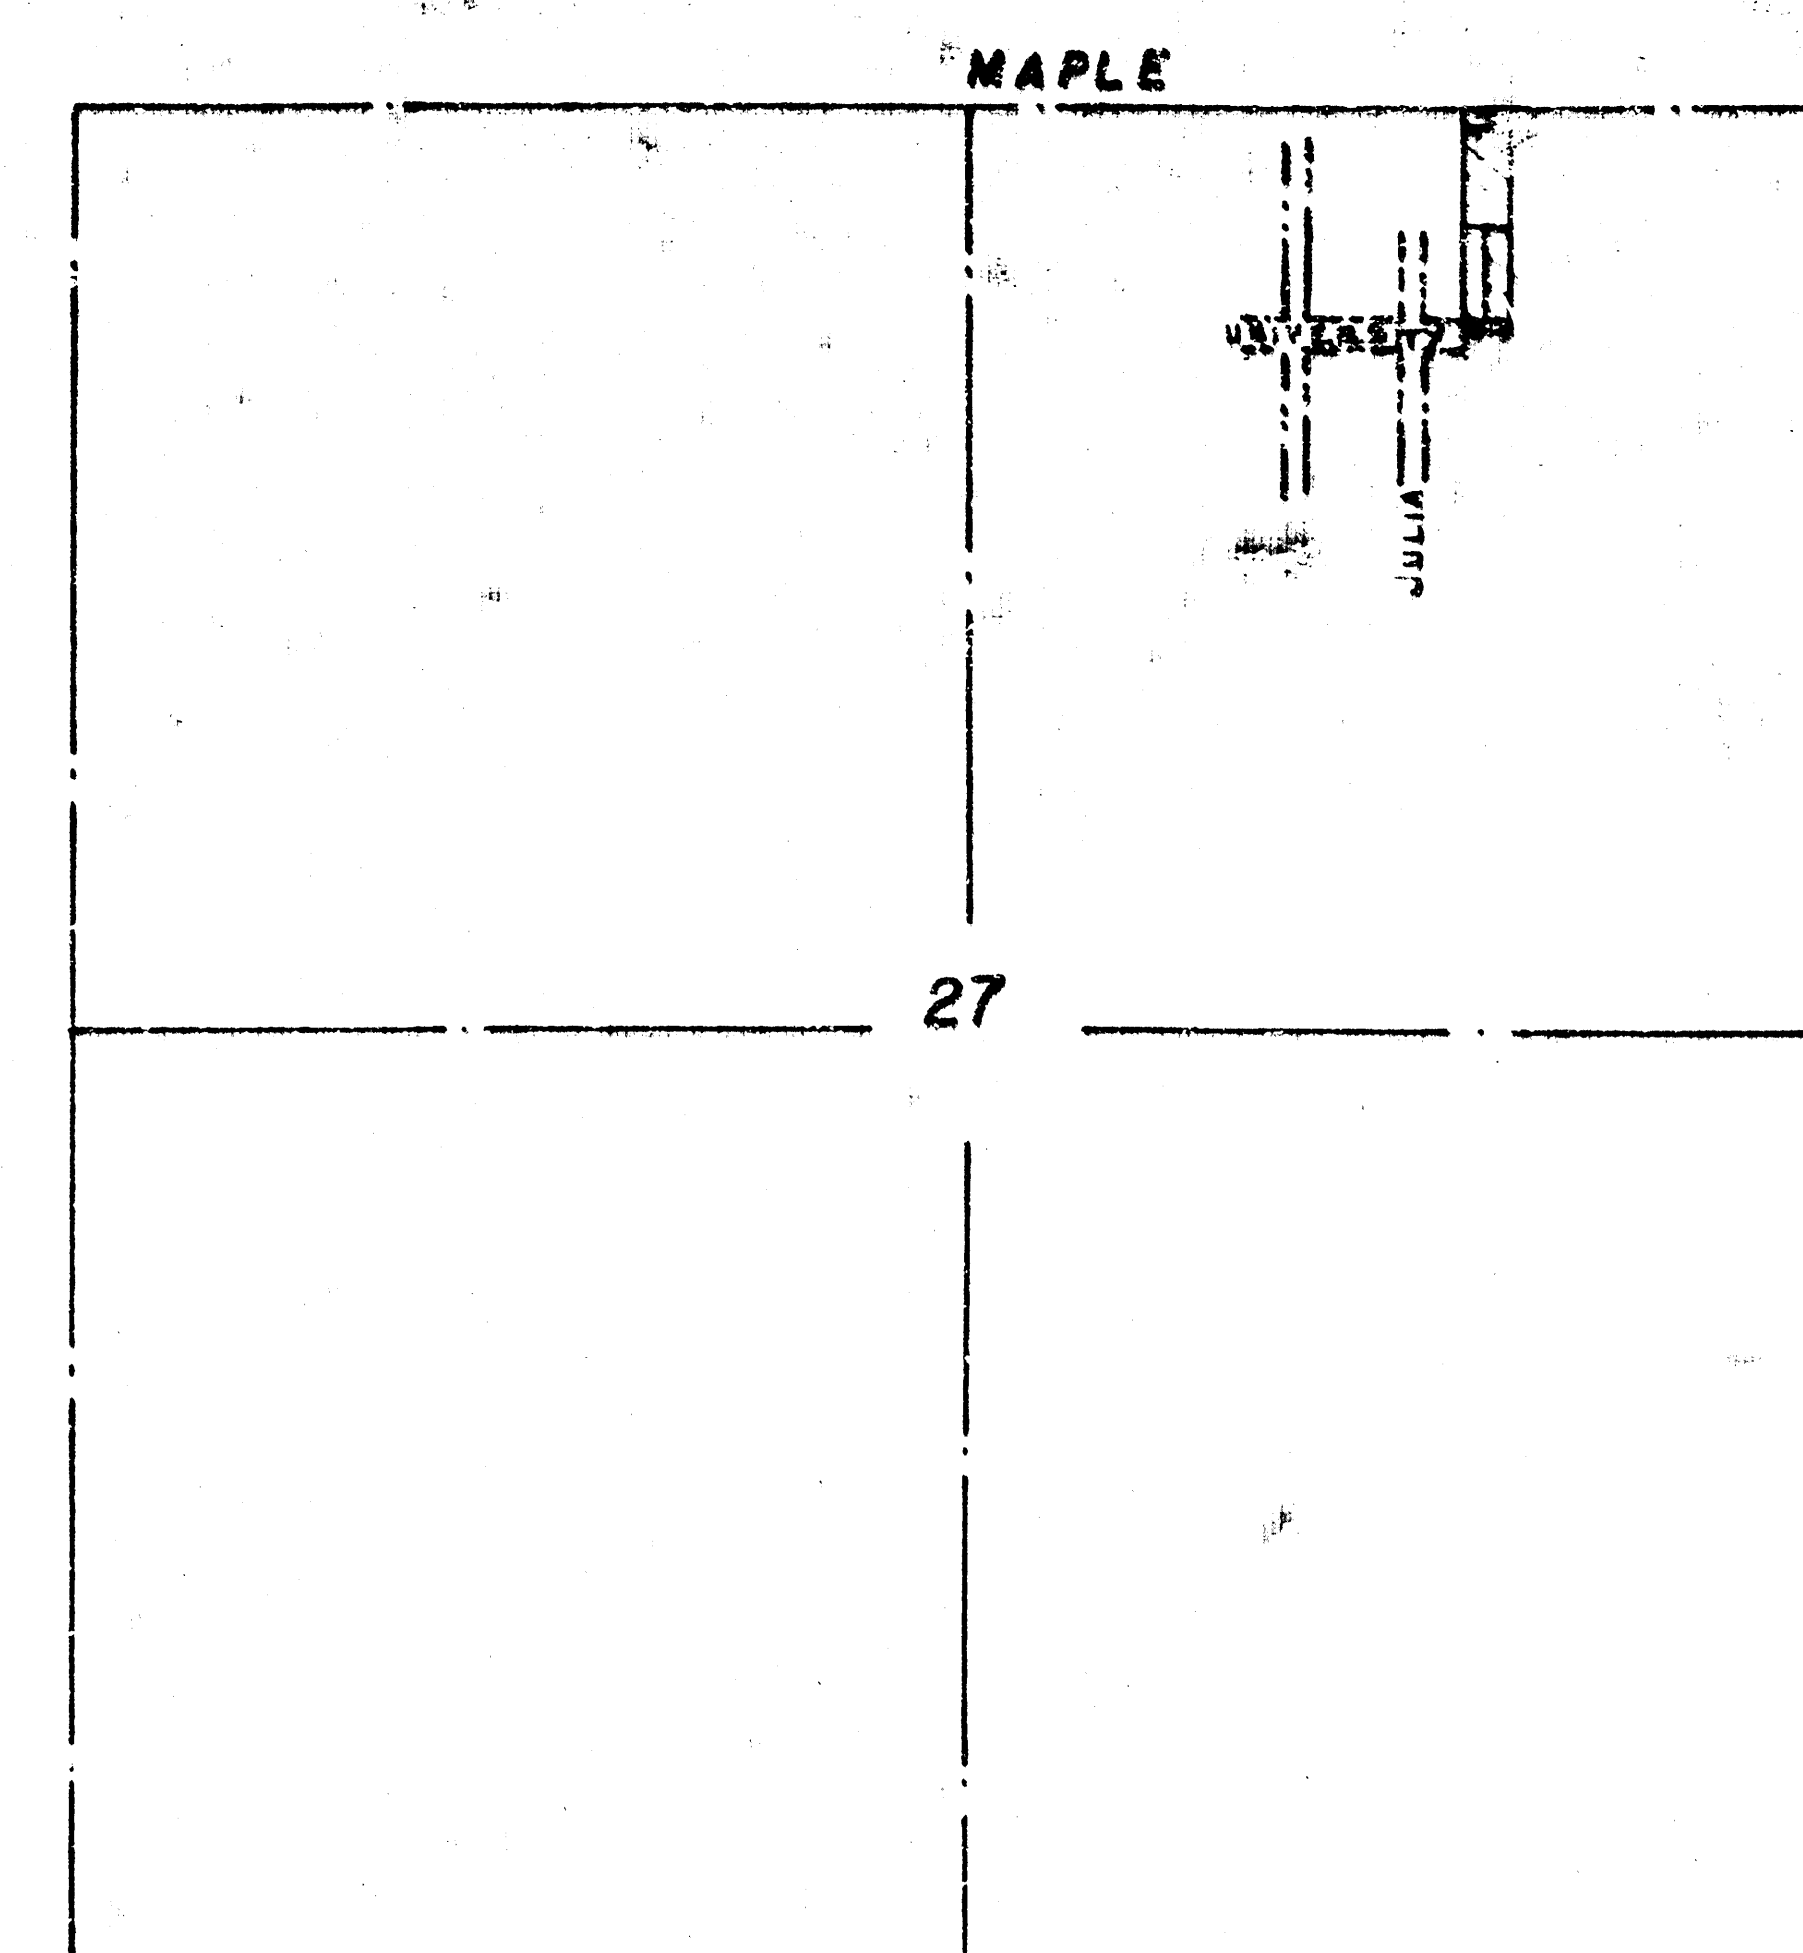

SKETCH PLAT

MARCUS & LOGAN ADDITION

FOR:
MARK MOORE
4024 W. 11TH

LOWELL D. HIGH, LS.
DEC. 5, 1984