


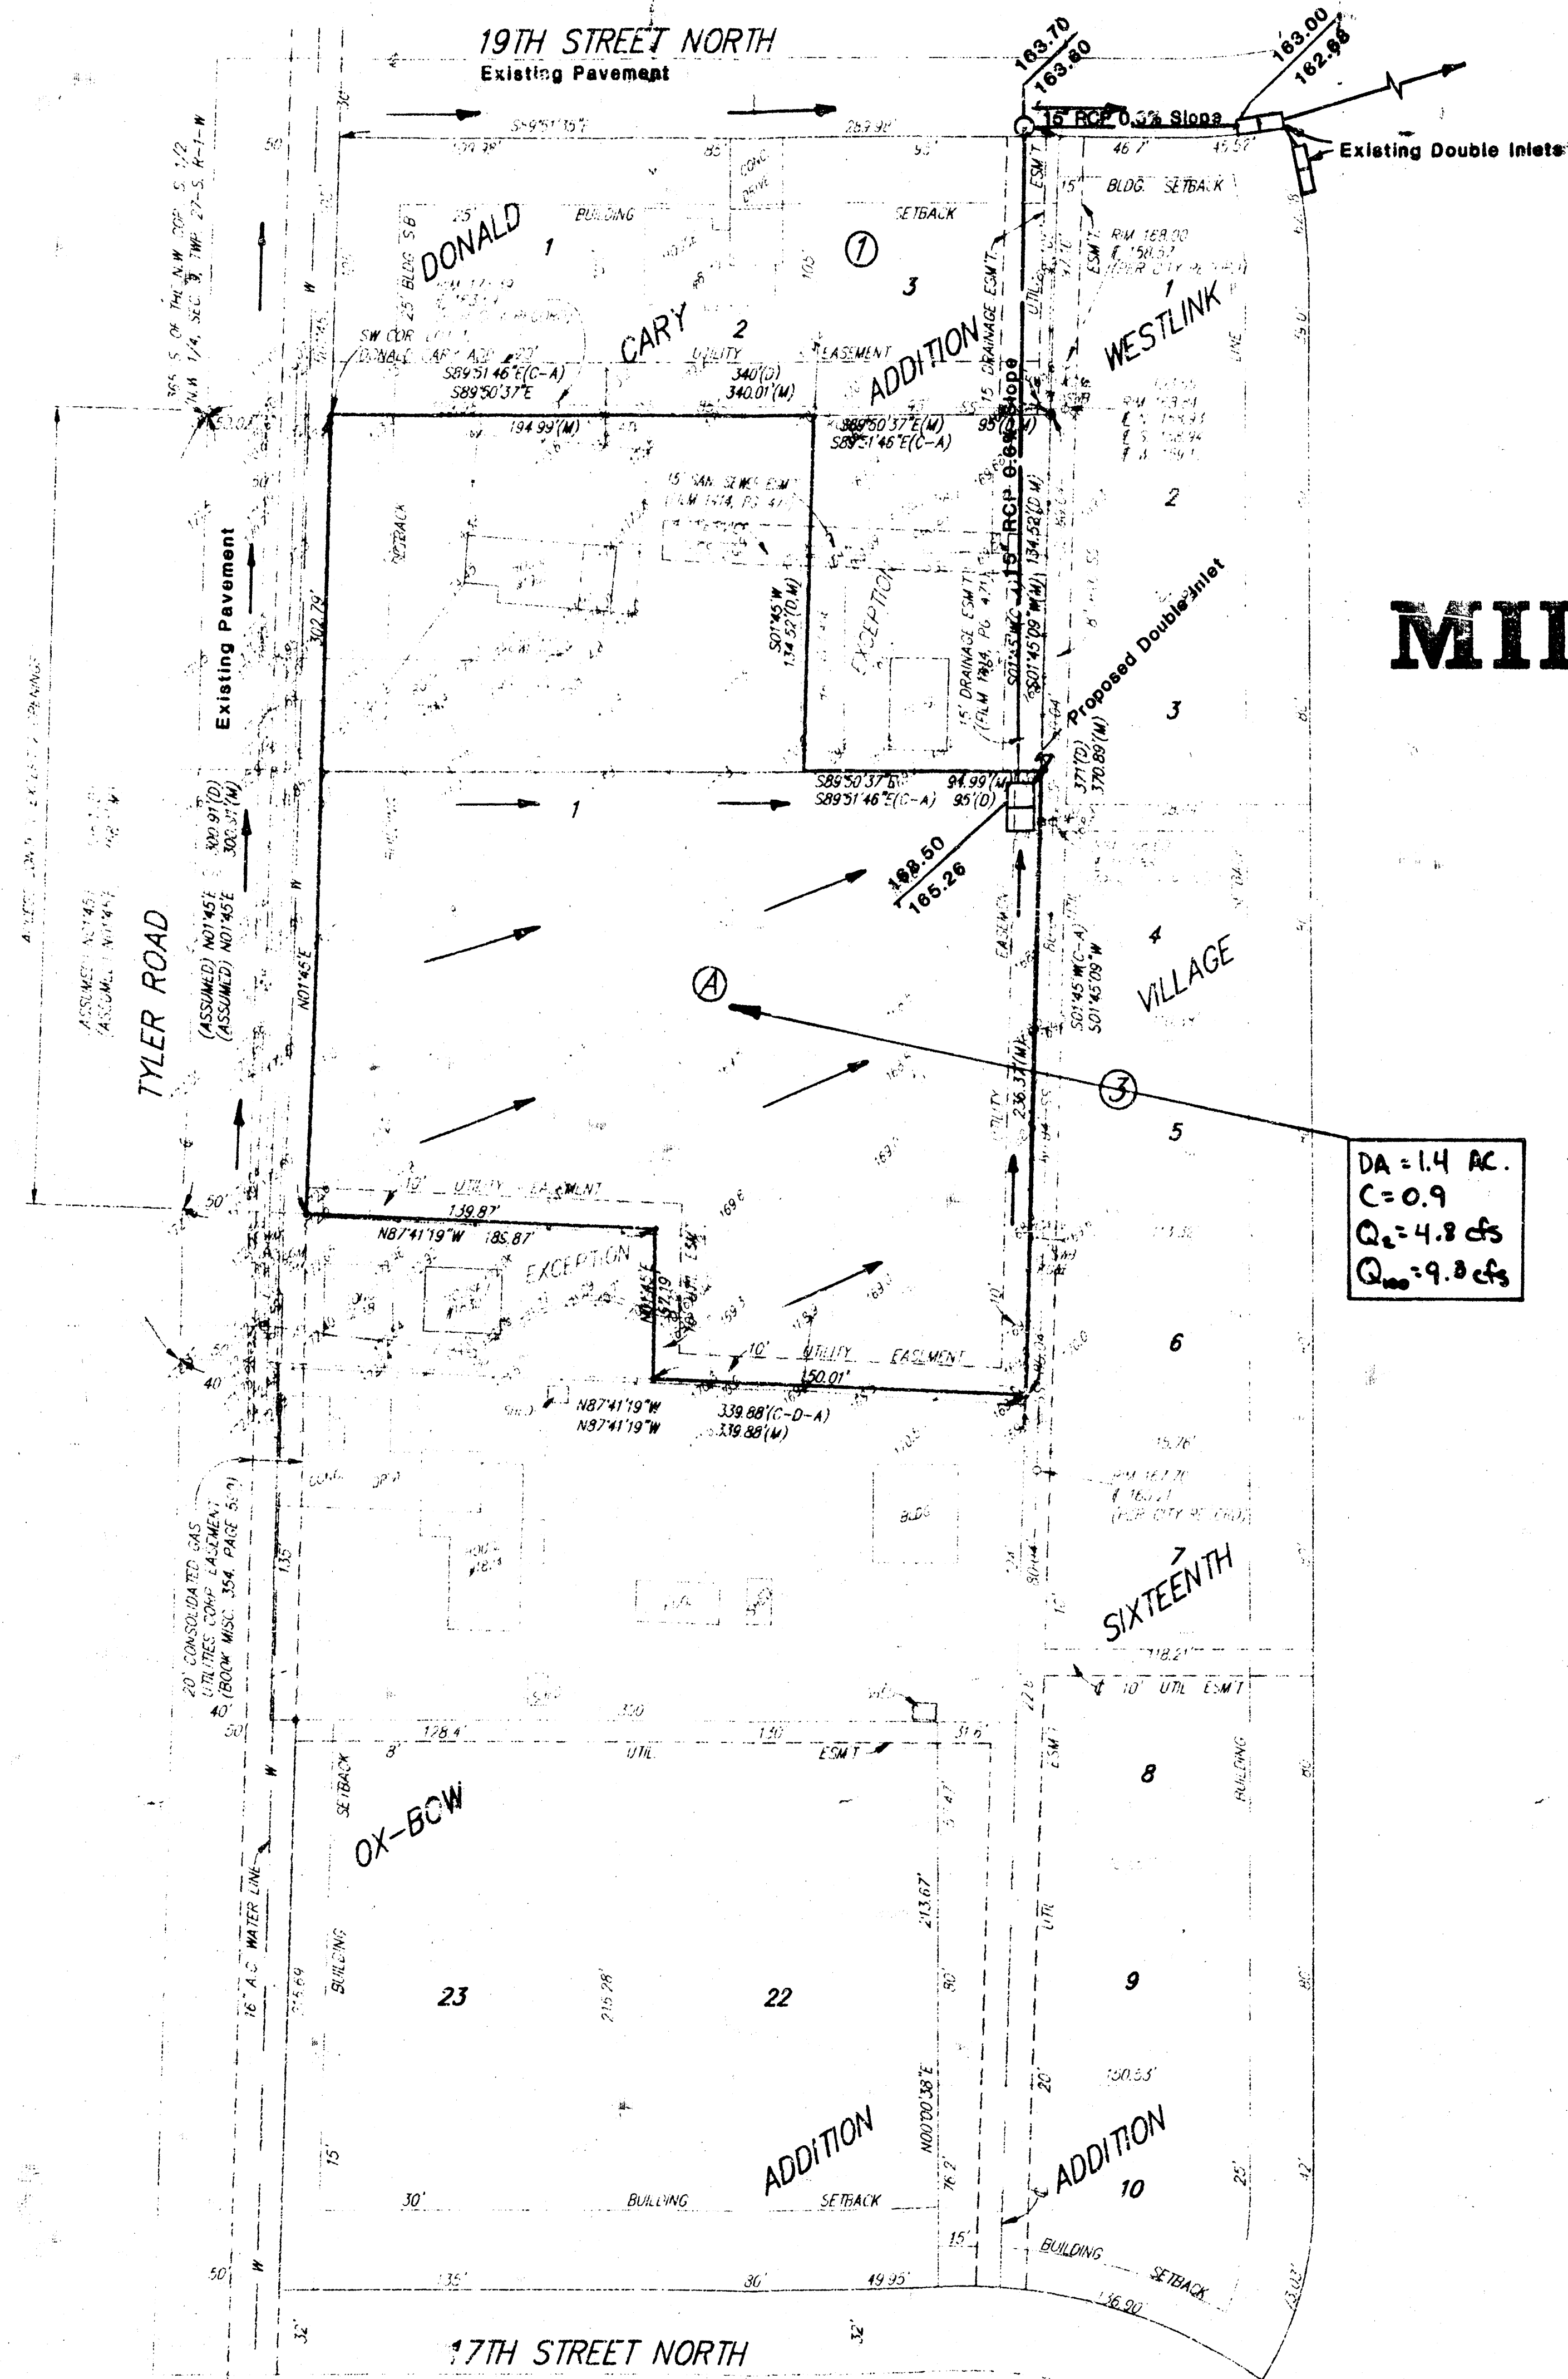

SKETCH PLAT MIDLAND BAPTIST CHURCH ADDITION

WICHITA, SEDGWICK COUNTY, KANSAS

MIDLAND BAPTIST CHURCH
ATTN: DALE HEFFERMAN
1354 LEECREST
WICHITA, KS 67209
PH: 316-721-1860


Beginning at a point on the west line of the NW 1/4 of Sec. 9, Twp. 27-S, R-1-W of the 6th P.M., said point being 365 feet south of the N.W. Cor. of the S 1/2 of said NW 1/4, thence east parallel with the north line of the S 1/2 of said NW 1/4, 340 feet; thence south parallel with the west line of said NW 1/4, 371 feet; thence westerly on a line which intersects the west line of said NW 1/4, 723.1 feet south of the N.W. Cor. of the S 1/2 of said NW 1/4, a distance of 150.01 feet; thence north parallel with the west line of said NW 1/4, 57.19 feet; thence westerly 189.87 feet to a point on the west line of said NW 1/4, said point being 665.91 feet south of the N.W. Corner of the S 1/2 of said NW 1/4; thence north 300.91 feet to the point of beginning, EXCEPT, the north 134.52 feet of the east 95 feet thereof.

SCALE: 1" = 50'

BENCHMARK:
RR SPIKE IN E. FACE
OF R.R. 21 S. & 41 E. OF
N 1/4 COR. SEC. 9, T27S, R1W
ELEV. = 172.73

DRAINAGE PLAN

2/14/94

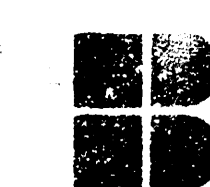

BAUGHMAN COMPANY P. A.
SURVEYING & ENGINEERING

316/252-7271 • 315 ELLIS • WICHITA, KANSAS 67211 11 FEB 1994